


NO.	DESCRIPTION	DATE
1	100% SCHEDULE DESIGN SUBMITTAL	04/28/09
2	50% DESIGN DEVELOPMENT SUBMITTAL	06/25/09
3	100% DESIGN DEVELOPMENT SUBMITTAL	07/29/09
4	0% MECHANICAL CALCULATION	08/26/09
5	INCIDENTAL 20% REVIEW	09/02/09
6	PERMANENT 20% REVIEW	11/11/09
7	0% MECHANICAL 20% REVIEW	11/19/09
8	0% MECHANICAL 20% CHECK	11/19/09
9	0% MECHANICAL 20% REVIEW	12/09/09
10	0% MECHANICAL 20% REVIEW	02/04/10
11	0% MECHANICAL 20% CHECK	02/19/10
12	0% MECHANICAL 20% CHECK	02/23/10
13	PROJECT RECORD SET	03/21/11

**PROJECT RECORD SET**

**SKYLINE COLLEGE  
 CIP2 DESIGN-BUILD  
 BUILDING 4N**

GENERAL

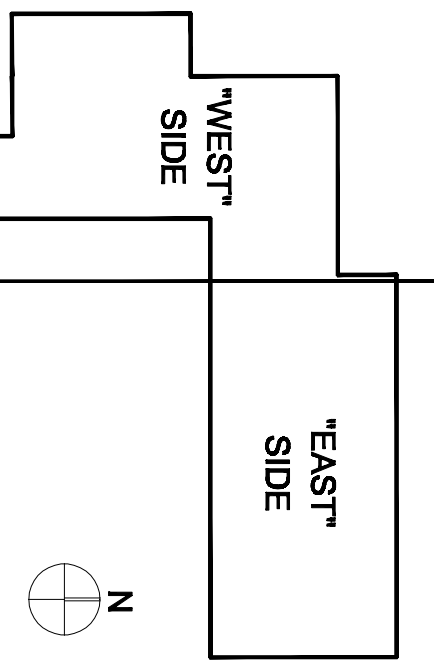


PROJECT NO. 0901200  
 DATE 01/31/11  
 SCALE AS NOTED  
 SHEET TITLE

DESIGN BY SEC. ML  
 CHECKED BY CM

**ACAMS  
 POINT-TO-POINT  
 WIRING DIAGRAM**

SHEET NO. **SEC-101**

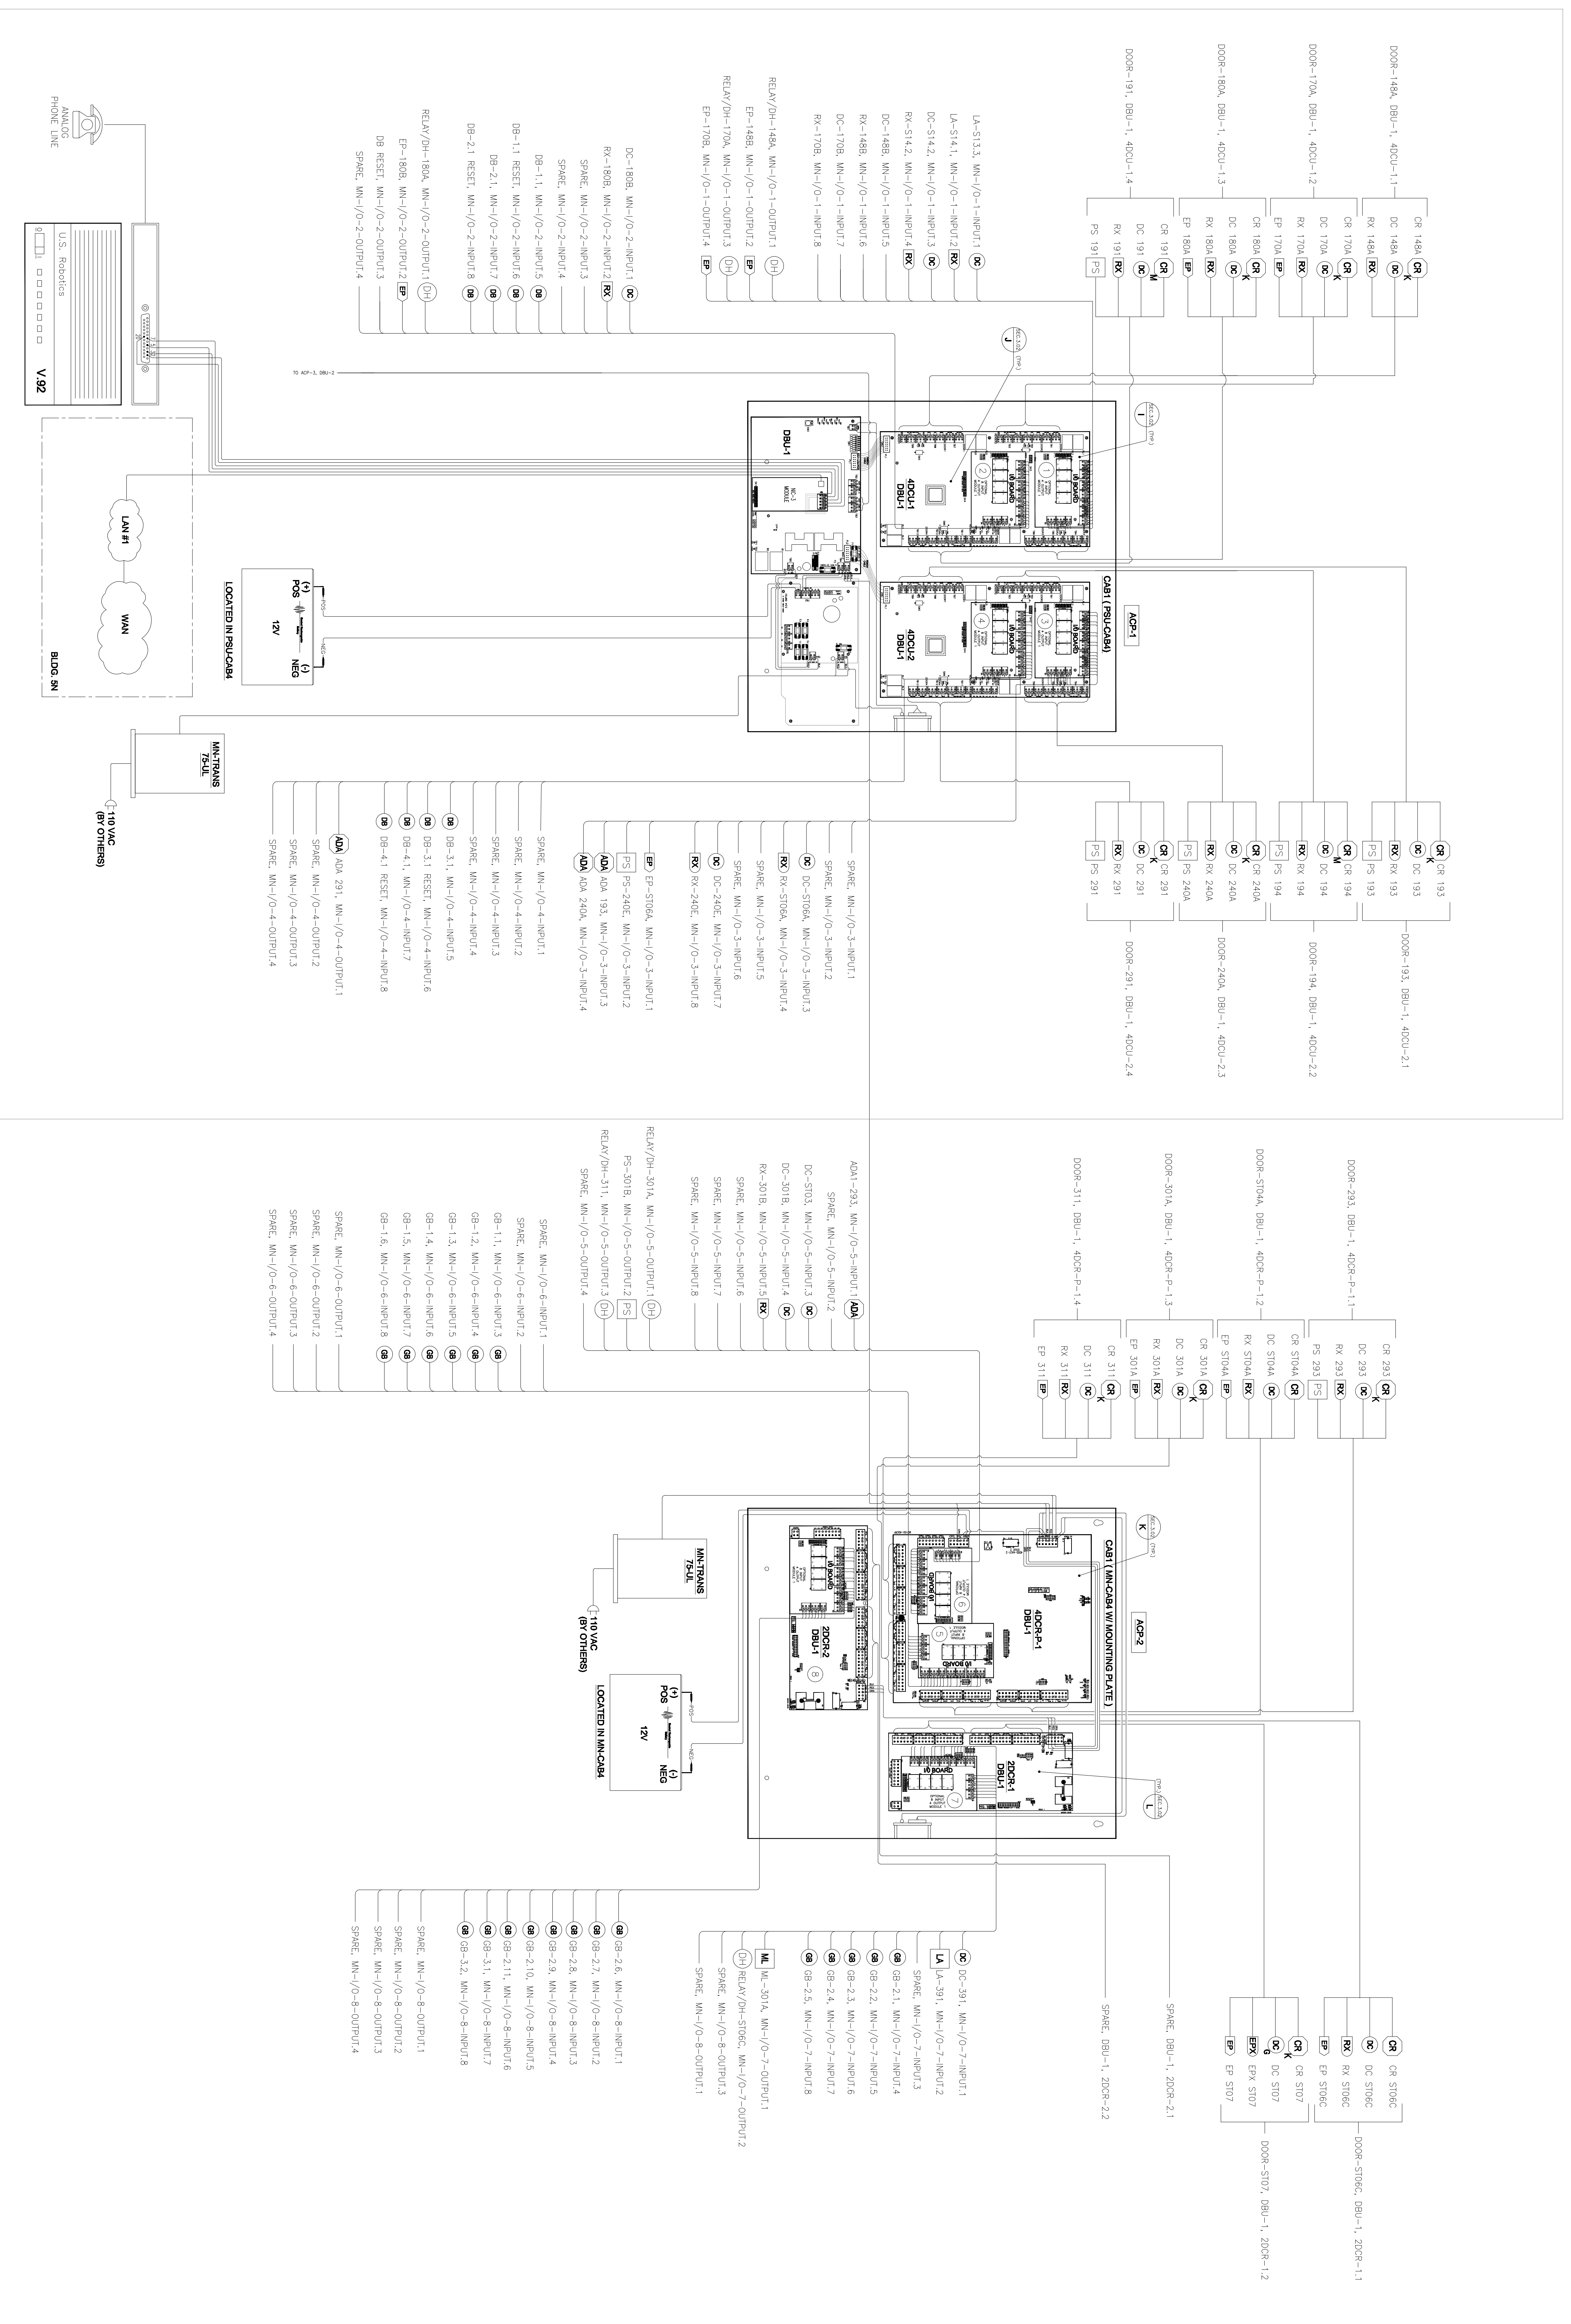

**1 ACAMS POINT-TO-POINT WIRING DIAGRAM**

SCALE: N.T.S.

All drawings and contents are the property of WRNSSTUDIO and shall remain the property of WRNSSTUDIO. No part of this drawing may be reproduced or transmitted in any form or by any means, electronic, mechanical, photocopying, recording, or by any information storage and retrieval system, without the prior written permission of WRNSSTUDIO.

This drawing is not to scale. All dimensions shall be taken from the original files. Minor deviations shall be indicated. This line should be equal to one foot.