


CABLE SCHEDULE CCTV			
TYPE	DESCRIPTION	MANUFACTURER	PART #
6	625 CAT5EUTP 24PAIR UTP/STP/SHIELD	BELDEN	100000000
6	1827A CAT5EUTP 24PAIR UTP/STP/SHIELD	BELDEN	100000000


SECURITY SHEET NOTES:

- [S-1] PUNCHED DOWN CAT-6 CABLES TO JACKS, INSERTED JACKS INTO PATCH PANEL.
- [S-2] INSTALLED WIRE MANAGER AND PATCH CORDS.
- [S-3] S.M.C.C.D. PROVIDED P.O.E. SWITCH.

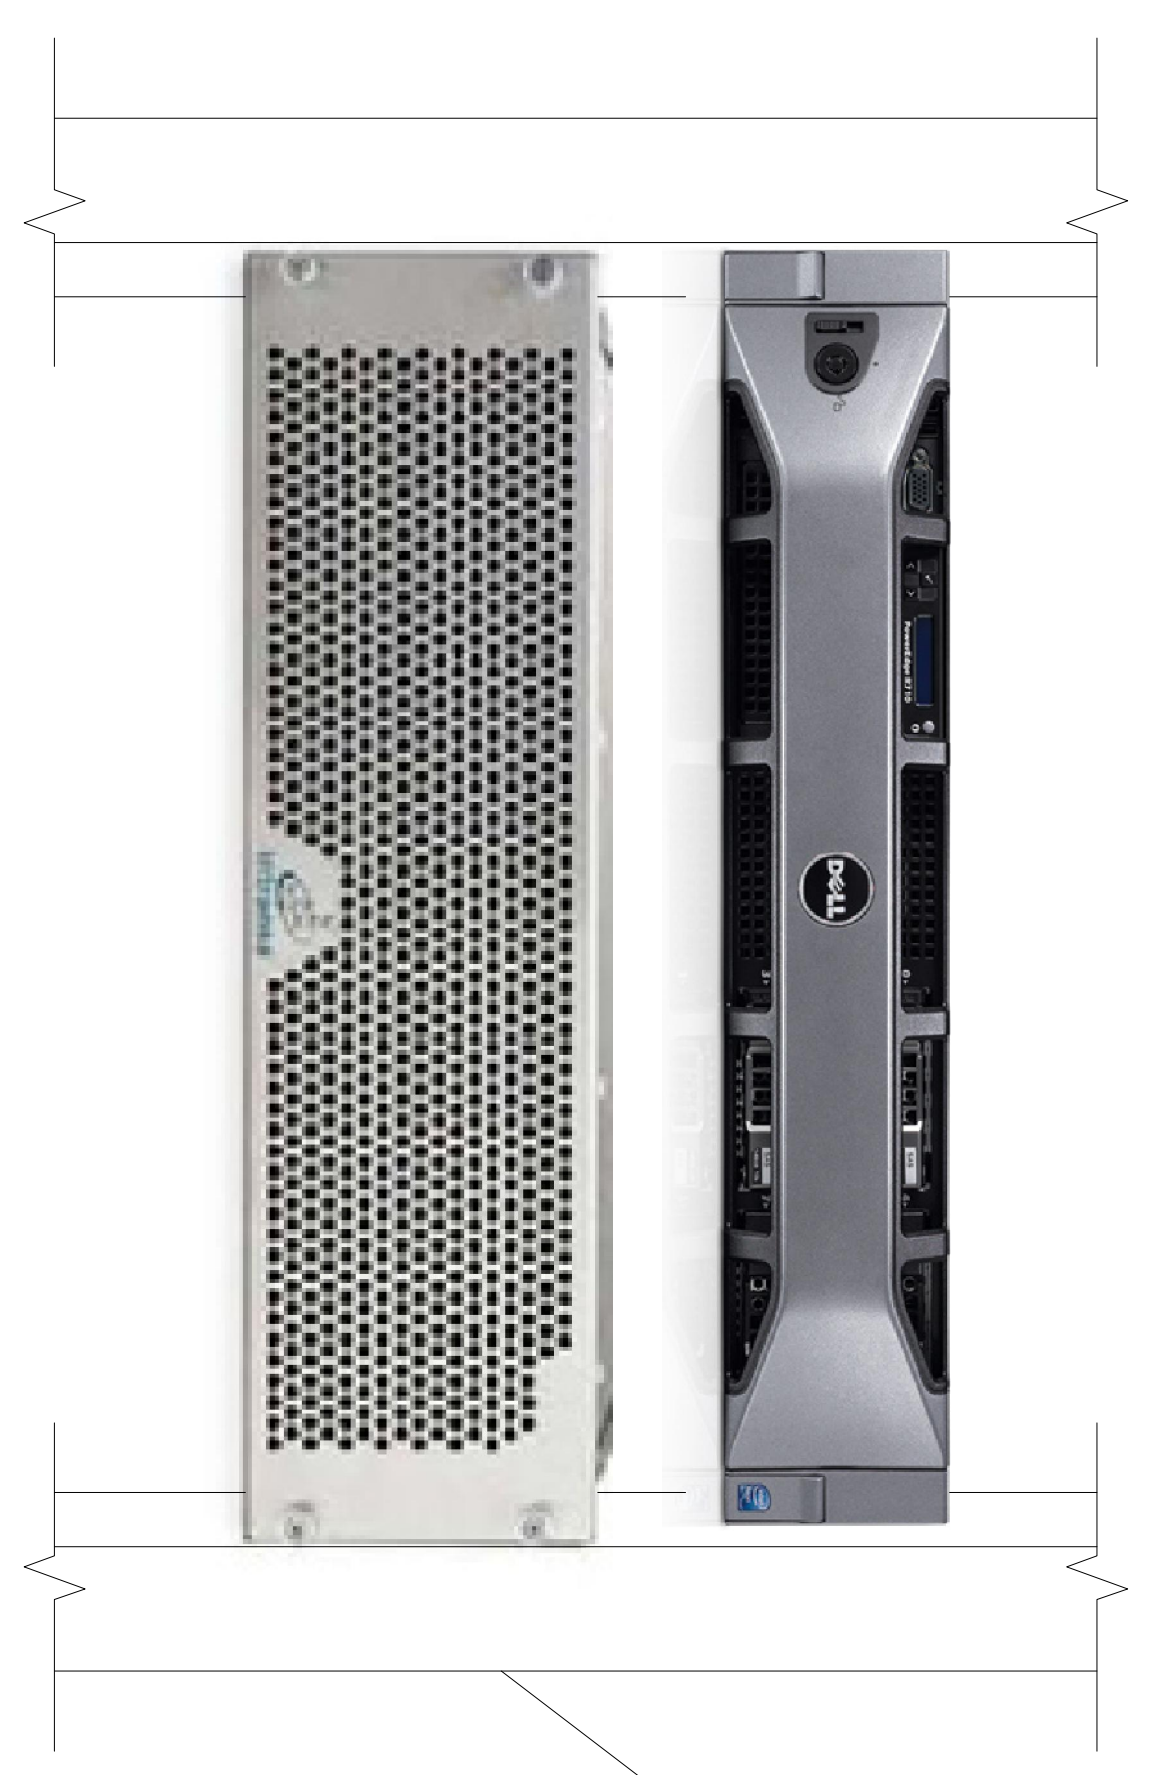


INSTALL NETWORK VIDEO RECORDER AND STORAGE UNIT IN BLDG. 1, FIRST FLOOR M.P.O.E. IN AN EXISTING RACK.

1 NVR AND STORAGE
SCALE: NTS

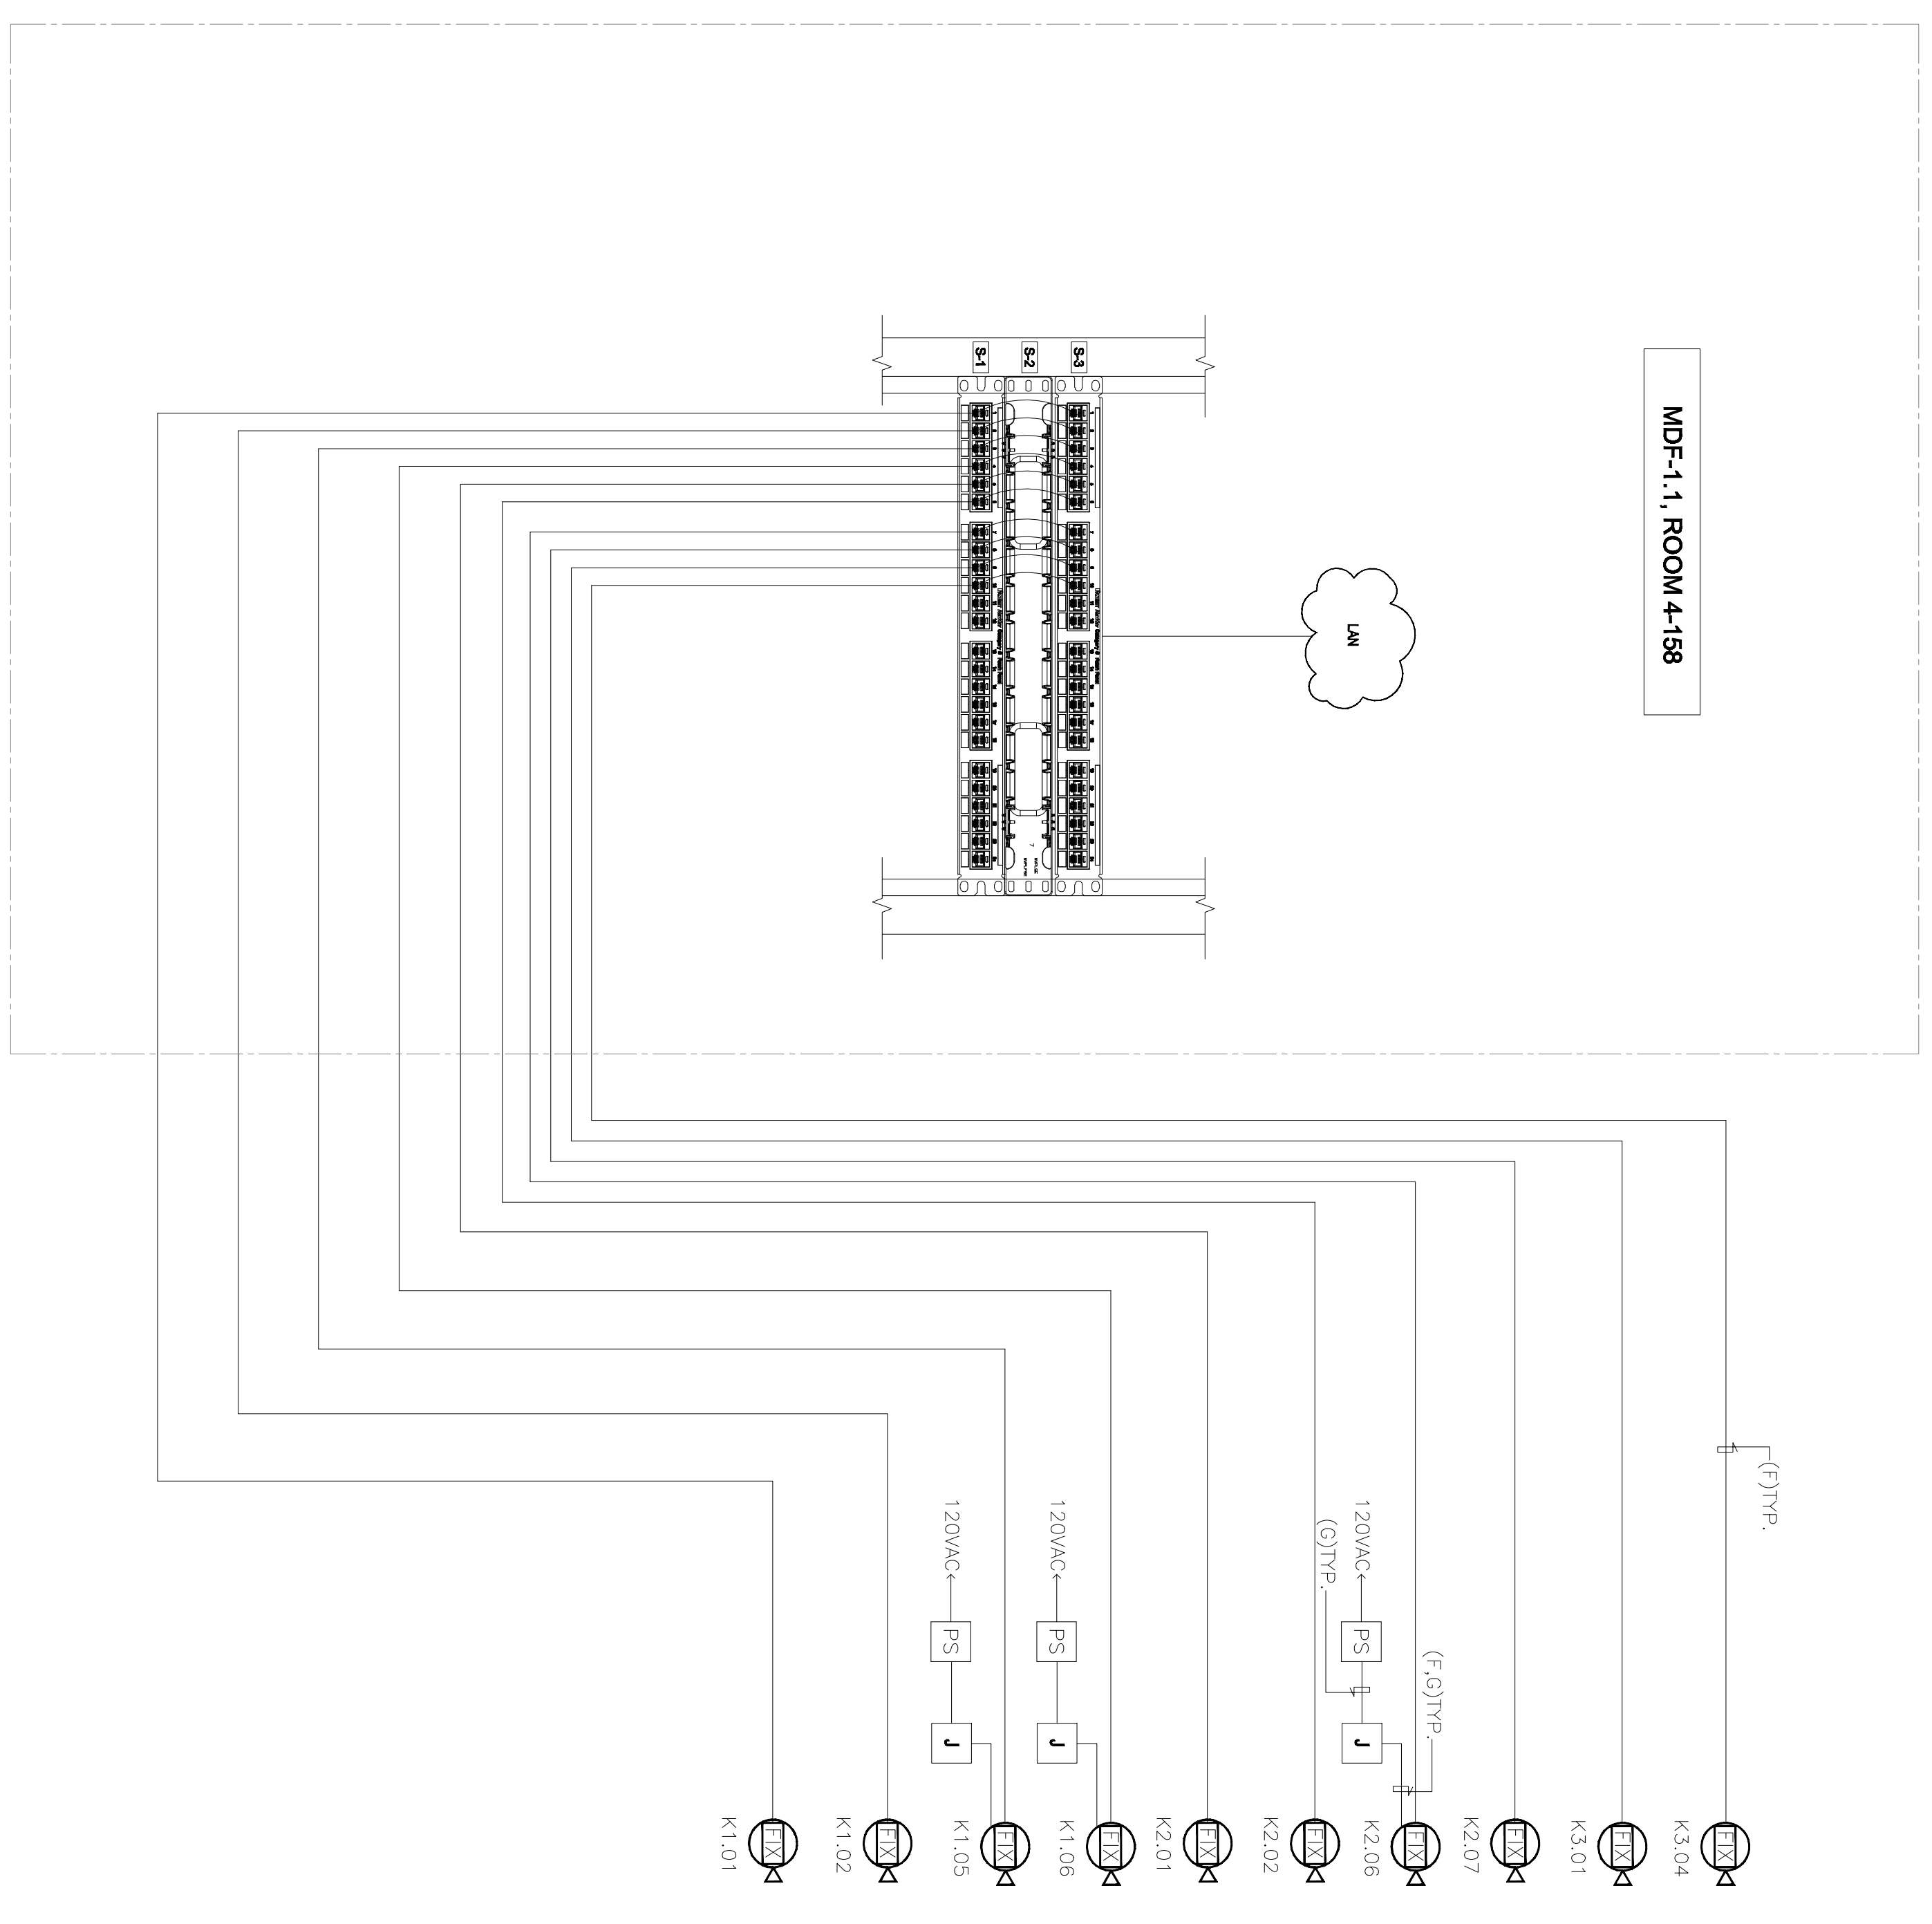

2 CCTV POINT-TO-POINT WIRING DIAGRAM
SCALE: NTS

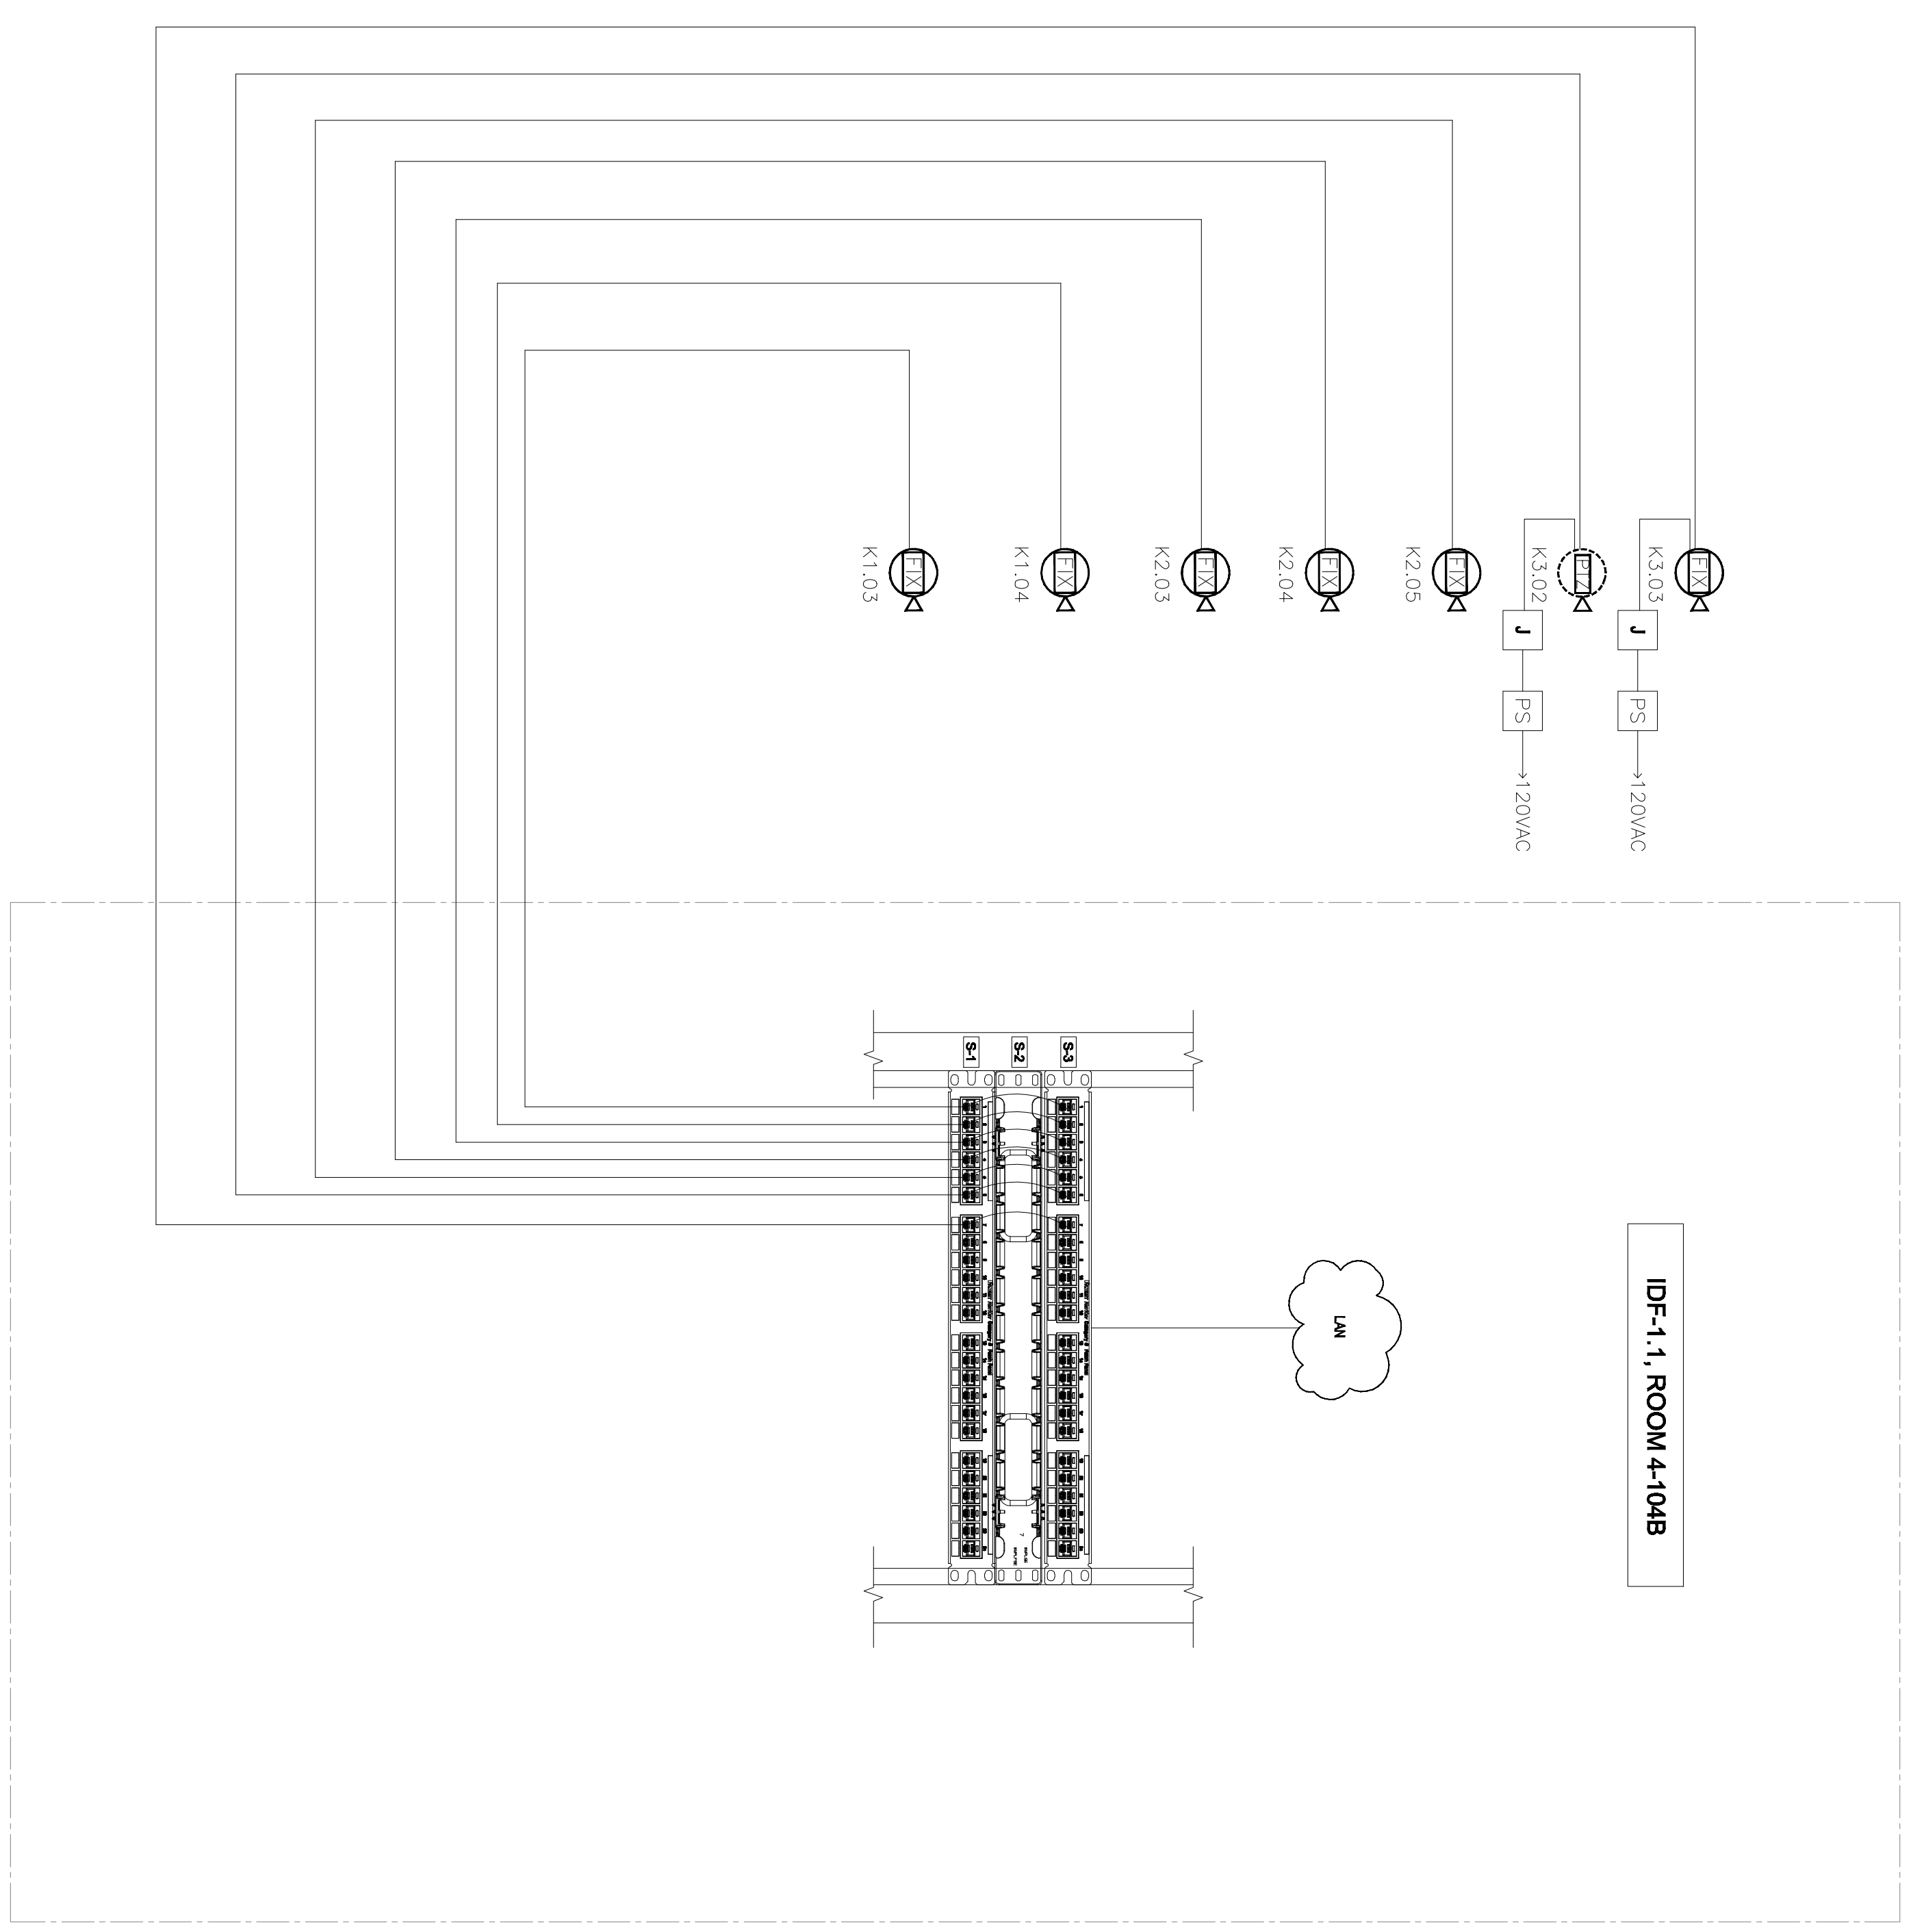

NETVERSANT
Inspiring Technology Solutions

NO.	ISSUE/REVISIONS	DATE
1	100% SCHEMATIC DESIGN SUBMITTAL	04/28/08
2	90% DESIGN DEVELOPMENT SUBMITTAL	06/12/08
3	100% DESIGN DEVELOPMENT SUBMITTAL	06/25/08
4	00% MECHANICAL DEVELOPMENT SUBMITTAL	07/25/08
5	00% MECHANICAL DEVELOPMENT SUBMITTAL	08/25/08
6	00% MECHANICAL DEVELOPMENT SUBMITTAL	09/25/08
7	00% MECHANICAL DEVELOPMENT SUBMITTAL	10/25/08
8	00% MECHANICAL DEVELOPMENT SUBMITTAL	11/11/08
9	00% MECHANICAL DEVELOPMENT SUBMITTAL	12/15/08
10	00% MECHANICAL DEVELOPMENT SUBMITTAL	01/20/09
11	00% MECHANICAL DEVELOPMENT SUBMITTAL	02/11/09
12	00% MECHANICAL DEVELOPMENT SUBMITTAL	03/12/09
13	PROJECT RECORD SET	03/31/11

PROJECT RECORD SET

**SKYLINE COLLEGE
CIP2 DESIGN-BUILD
BUILDING 4N**

PROJECT NO: 0707200
DATE: 01/31/11
SCALE: AS NOTED
SHEET TITLE: NVR AND STORAGE CCTV POINT-TO-POINT WIRING DIAGRAM

All drawings and specifications shall be subject to the original and master copy of the Architect's drawings and specifications. No part of this drawing shall be reproduced without the consent of the Architect/Engineer.

This drawing is not for construction. The drawings have been prepared from the original. No part of this drawing shall be reproduced without the consent of the Architect/Engineer.