



SECURITY SHEET NOTES:

- [S-1] COPY CABINET IS DEMONSTRATION ONLY. PROVIDED AND INSTALLED BY S&M CO. SECURITY CONTRACTOR FOR PROVIDED PATCH PANEL, WIRE MANAGER, AND WIRE MANAGER. S&M CO. PROVIDED, INSTALLED AND CONFIGURED P.O.E. SWITCH TYPICAL FOR MDF-1.1, PANEL AND WIRE MANAGER.
- [S-2] TWO, 2" CONDUITS FOR FIRST FLOOR.
- [S-3] 2" CONDUITS FOR SECOND AND THIRD FLOOR S&M.
- [S-4] SEE ELECTRICAL DRAWINGS FOR 120VAC CIRCUITING INFORMATION.

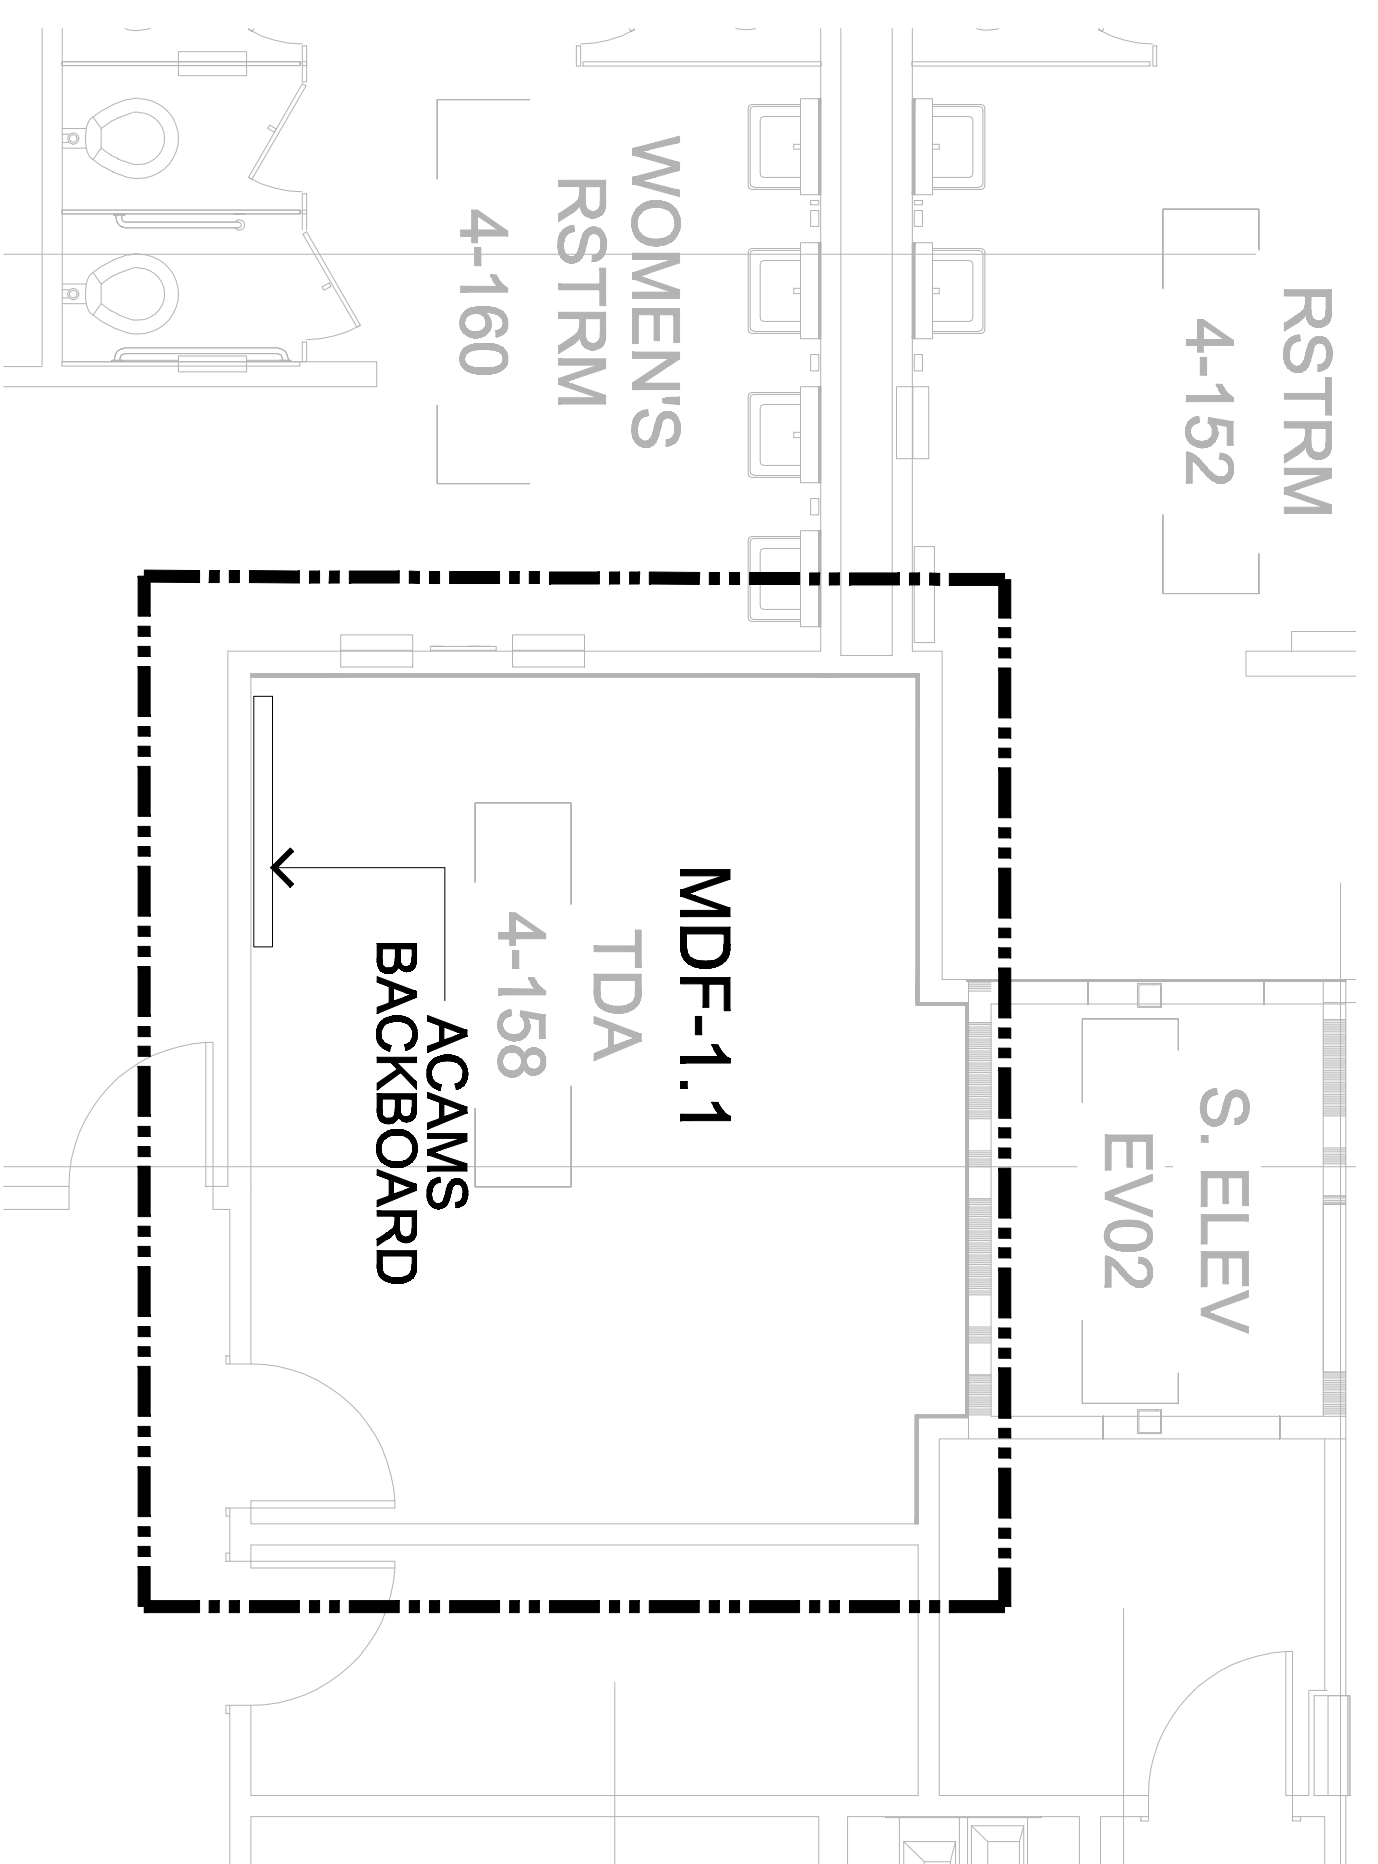

1 SECURITY SYSTEM MDF ROOM PLAN

SCALE: 1/4"=1'-0"

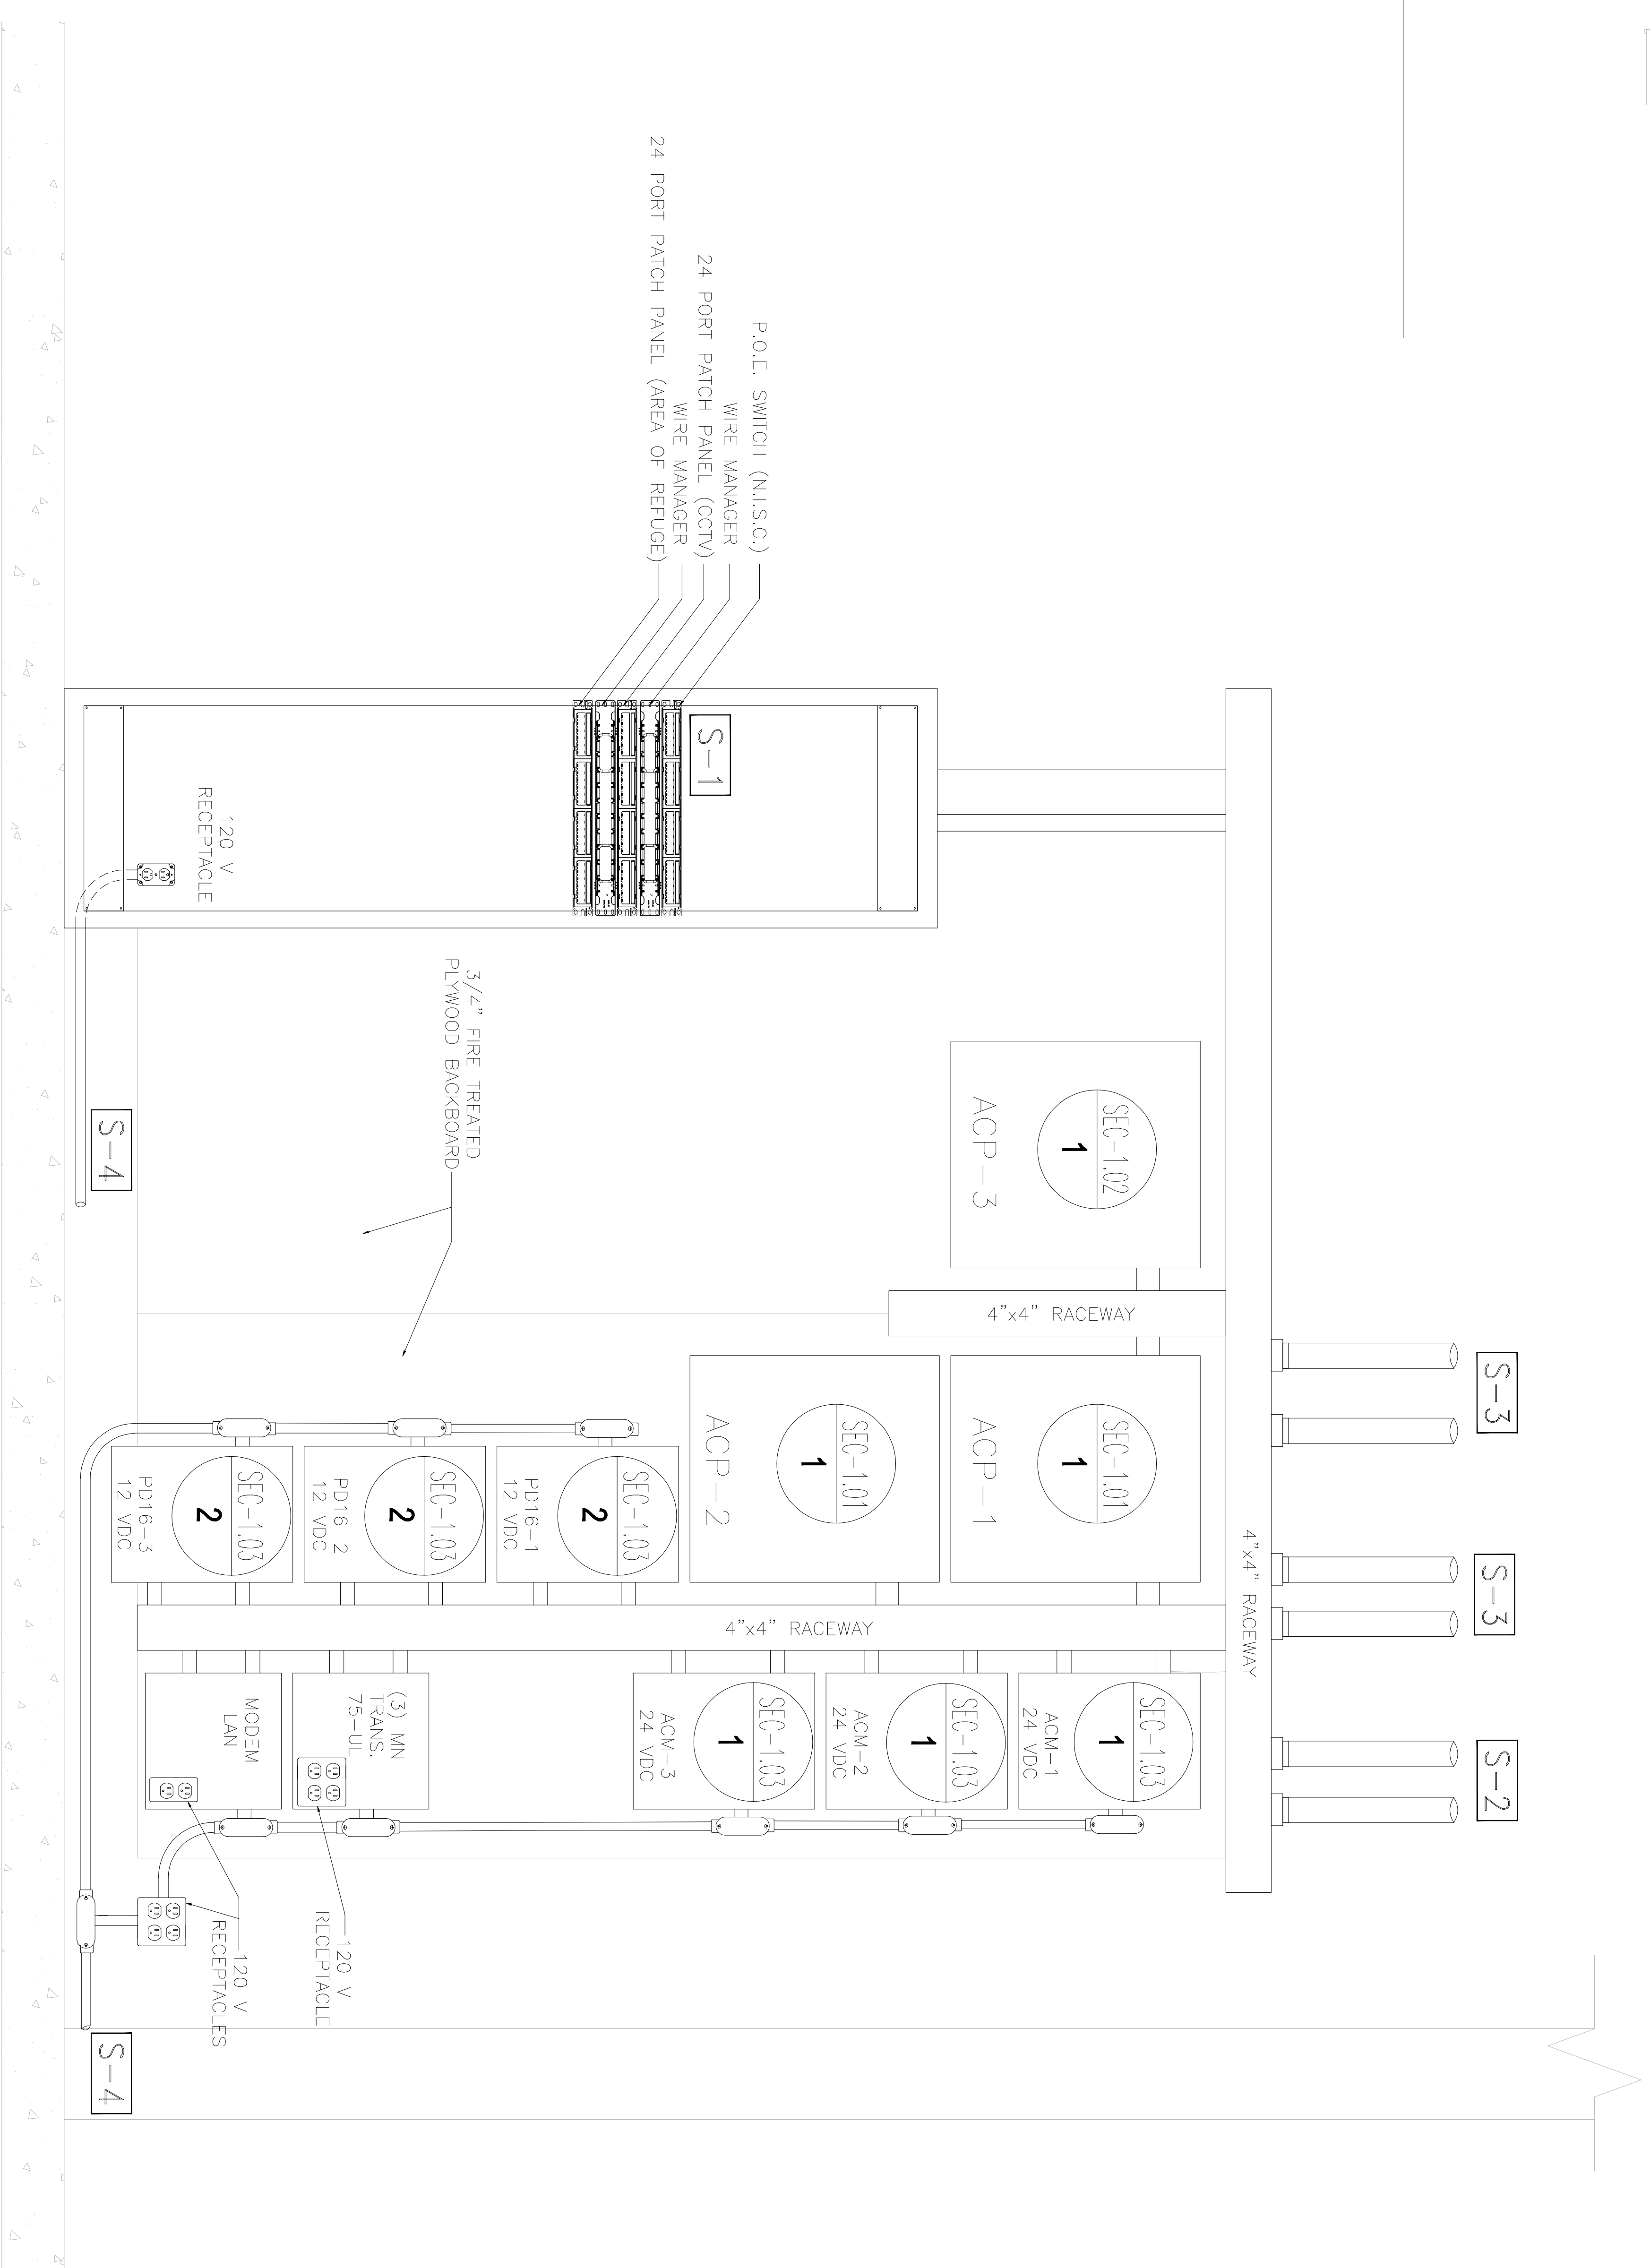

2 SECURITY SYSTEM MDF ROOM ELEVATION

SCALE: 1/2"=1'-0"

NETVERSANT
Inspiring Technology Solutions

NO.	DESCRIPTION	DATE
1	10% SCHEMATIC DESIGN SUBMITTAL	04/28/09
2	50% DESIGN DEVELOPMENT SUBMITTAL	06/18/09
3	100% DESIGN DEVELOPMENT SUBMITTAL	07/28/09
4	DATA ACQUISITION FOR NETWORKING	08/25/09
5	INSPECTOR 200% REVIEW	09/09/09
6	CONSTRUCTION & OFFICE PACKAGES	11/11/09
7	DATA ACQUISITION FOR 50% REVIEW	11/11/09
8	DATA ACQUISITION FOR 50% REVIEW	11/11/09
9	DATA ACQUISITION FOR 50% REVIEW	12/18/09
10	DATA ACQUISITION FOR 50% REVIEW	02/05/10
11	DATA ACQUISITION FOR 50% REVIEW	06/11/10
12	DATA ACQUISITION FOR 50% REVIEW	06/11/10
13	PROJECT RECORD SET	01/31/11

PROJECT RECORD SET

**SKYLINE COLLEGE
 CIP2 DESIGN-BUILD
 BUILDING 4N**

PROJECT NO. 07012-00
 DATE 01/31/11
 SCALE AS NOTED
 SHEET TITLE

MDF EQUIPMENT LAYOUT

SEC-3.01

All drawings and other technical documents herein constitute original and unpublished work of the Architect/Engineer and may not be duplicated, used or disclosed without consent of Architect/Engineer. If this drawing is not 100% complete, the drawing has been reduced from its original size. Noed content must be indicated. This line should be equal to one inch.