

NETVERSANT
Inspiring Technology Solutions

NO.	DESCRIPTION	DATE
1	ISSUE/REVISIONS	
1	10% OPERATIONAL DESIGN SUBMITTAL	04/08/08
2	50% DESIGN DEVELOPMENT SUBMITTAL	06/10/08
3	100% DESIGN DEVELOPMENT SUBMITTAL	07/29/08
4	DESIGN DEVELOPMENT #1 EVALUATION	08/28/08
5	DESIGN DEVELOPMENT #2 EVALUATION	09/24/08
6	IMPLEMENT 2 80% REVIEW	10/20/08
7	IMPLEMENT 2 80% REVIEW	11/17/08
8	IMPLEMENT #1: BLOCK CHECK	11/18/08
9	IMPLEMENT #2: 80% REVIEW	12/29/08
10	IMPLEMENT #3: 80% REVIEW	02/09/09
11	IMPLEMENT #4: 80% REVIEW	03/11/09
12	IMPLEMENT #5: BLOCK CHECK	06/12/09
13	IMPLEMENT #6: BLOCK CHECK	08/12/09
14	IMPLEMENT #7: BLOCK CHECK	09/15/09
15	IMPLEMENT #8: BLOCK CHECK	09/15/09

PROJECT RECORD SET



**SKYLINE COLLEGE
 CIP2 DESIGN-BUILD
 BUILDING 4N**

PROJECT NO: 0707200
 DATE: 01/29/11
 SCALE: AS NOTED


OWNER: MJC
 CHECKED BY: CM/CG

PROJECT NO: 0707200
 DATE: 01/29/11
 SCALE: AS NOTED



OWNER: MJC
 CHECKED BY: CM/CG

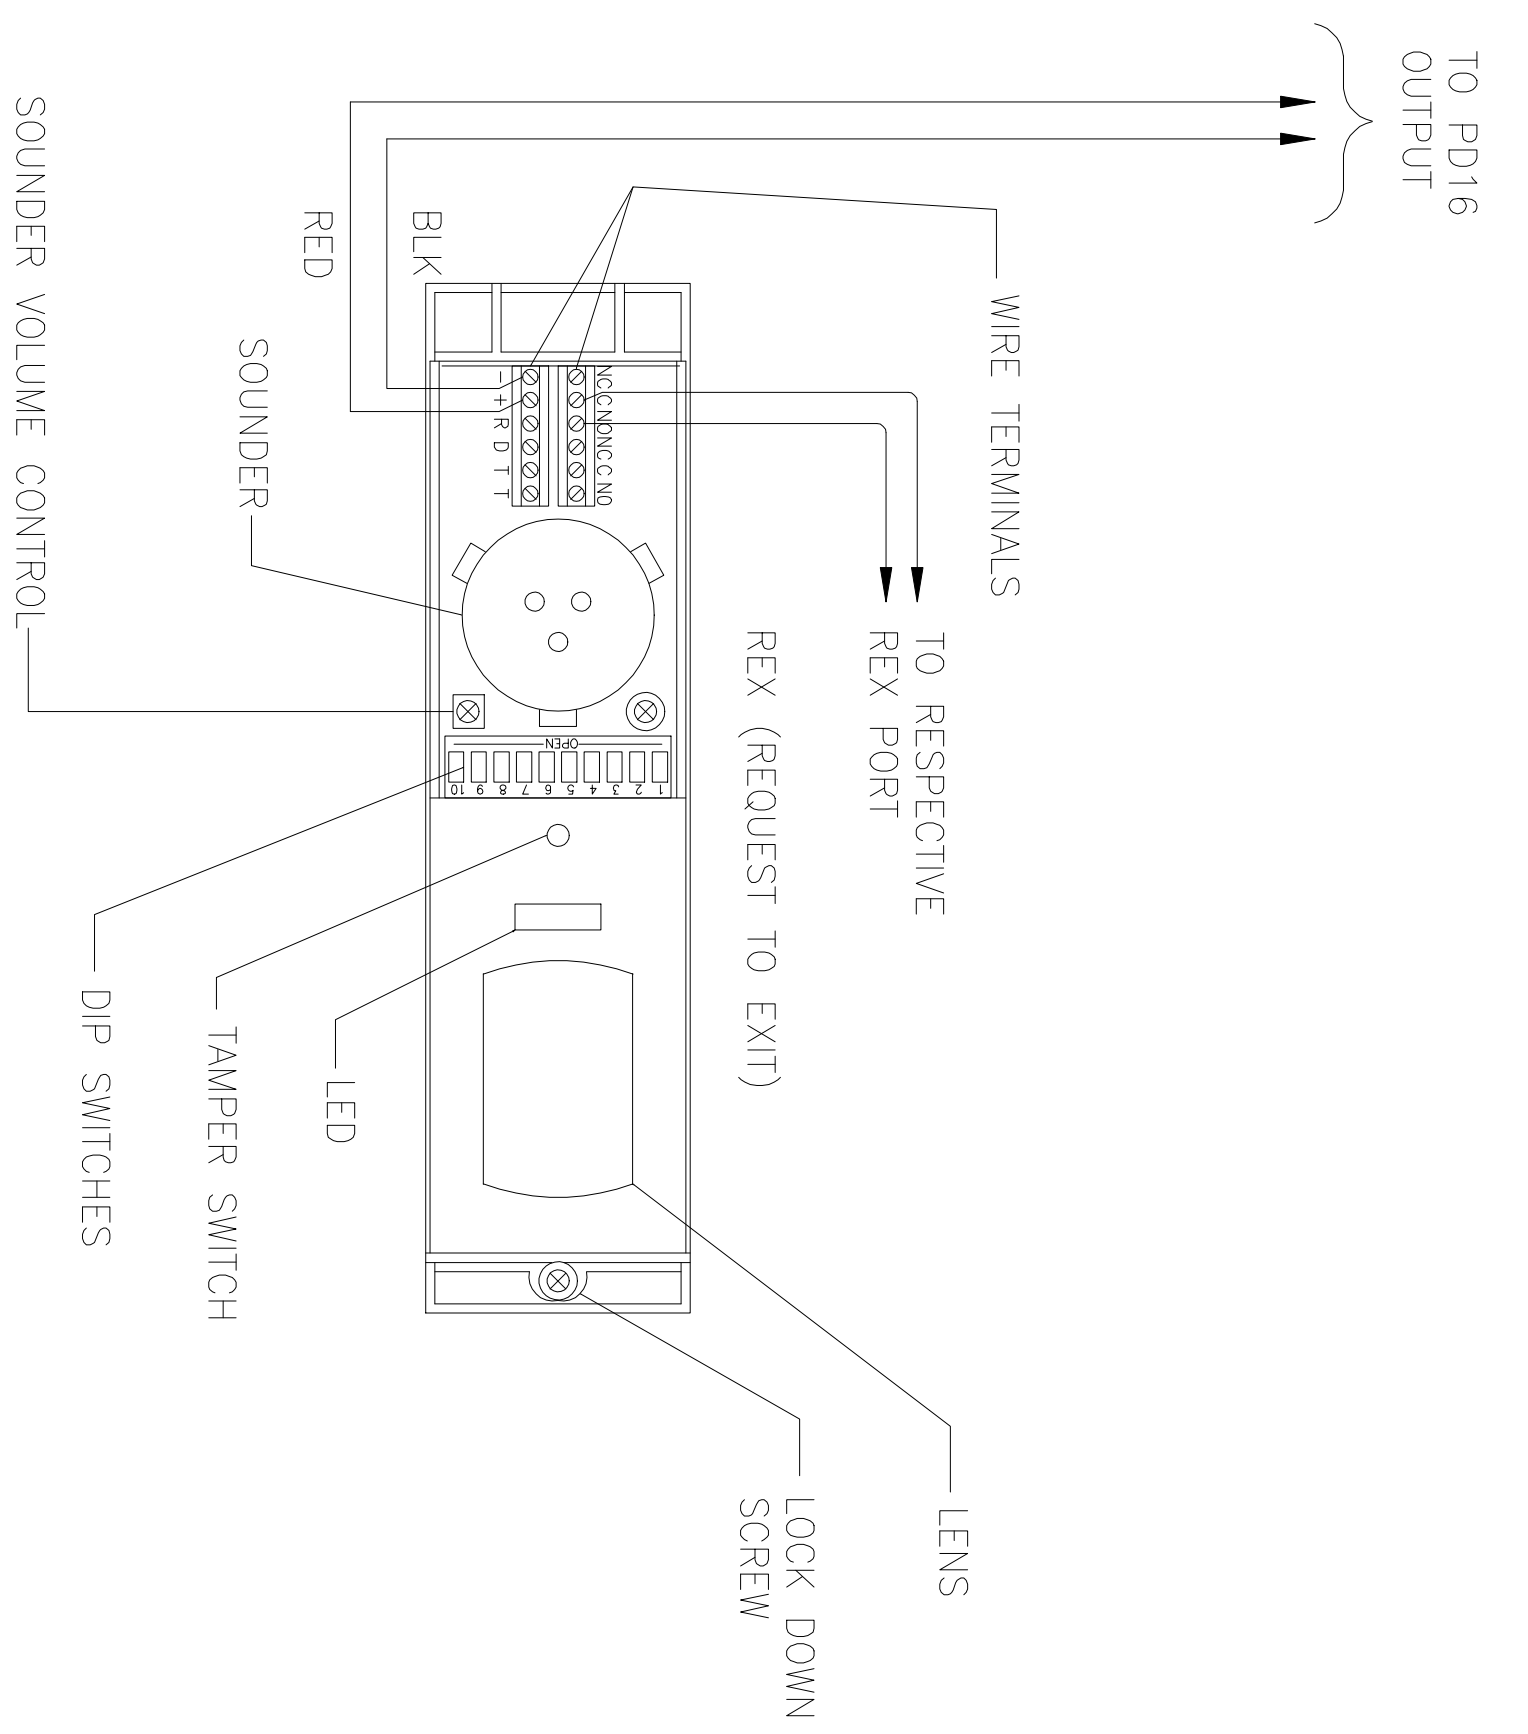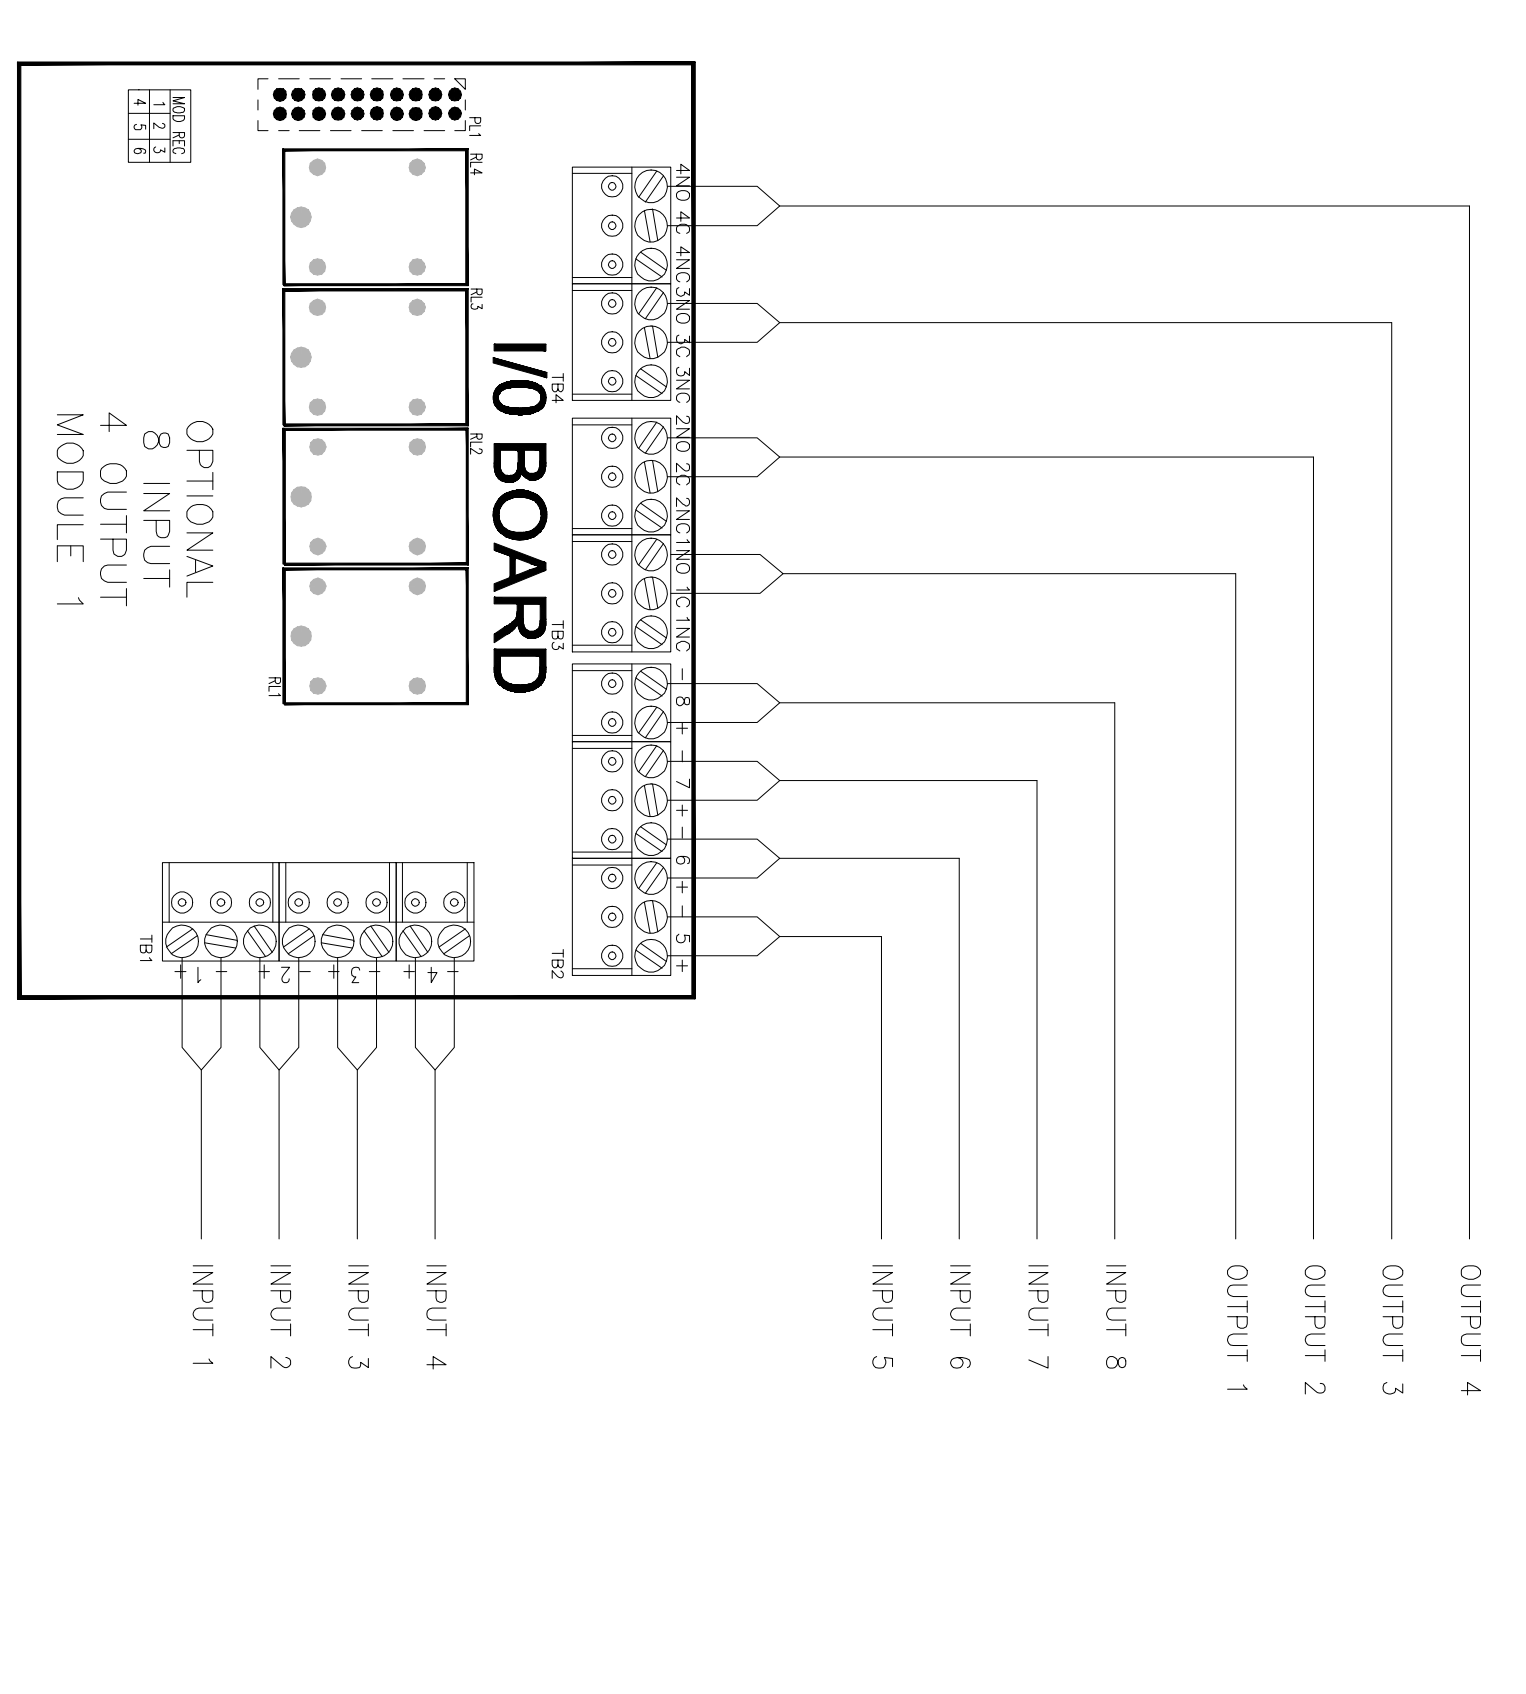


G KEYPAD CARD READER, CARD READER
 SCALE: N.T.S.

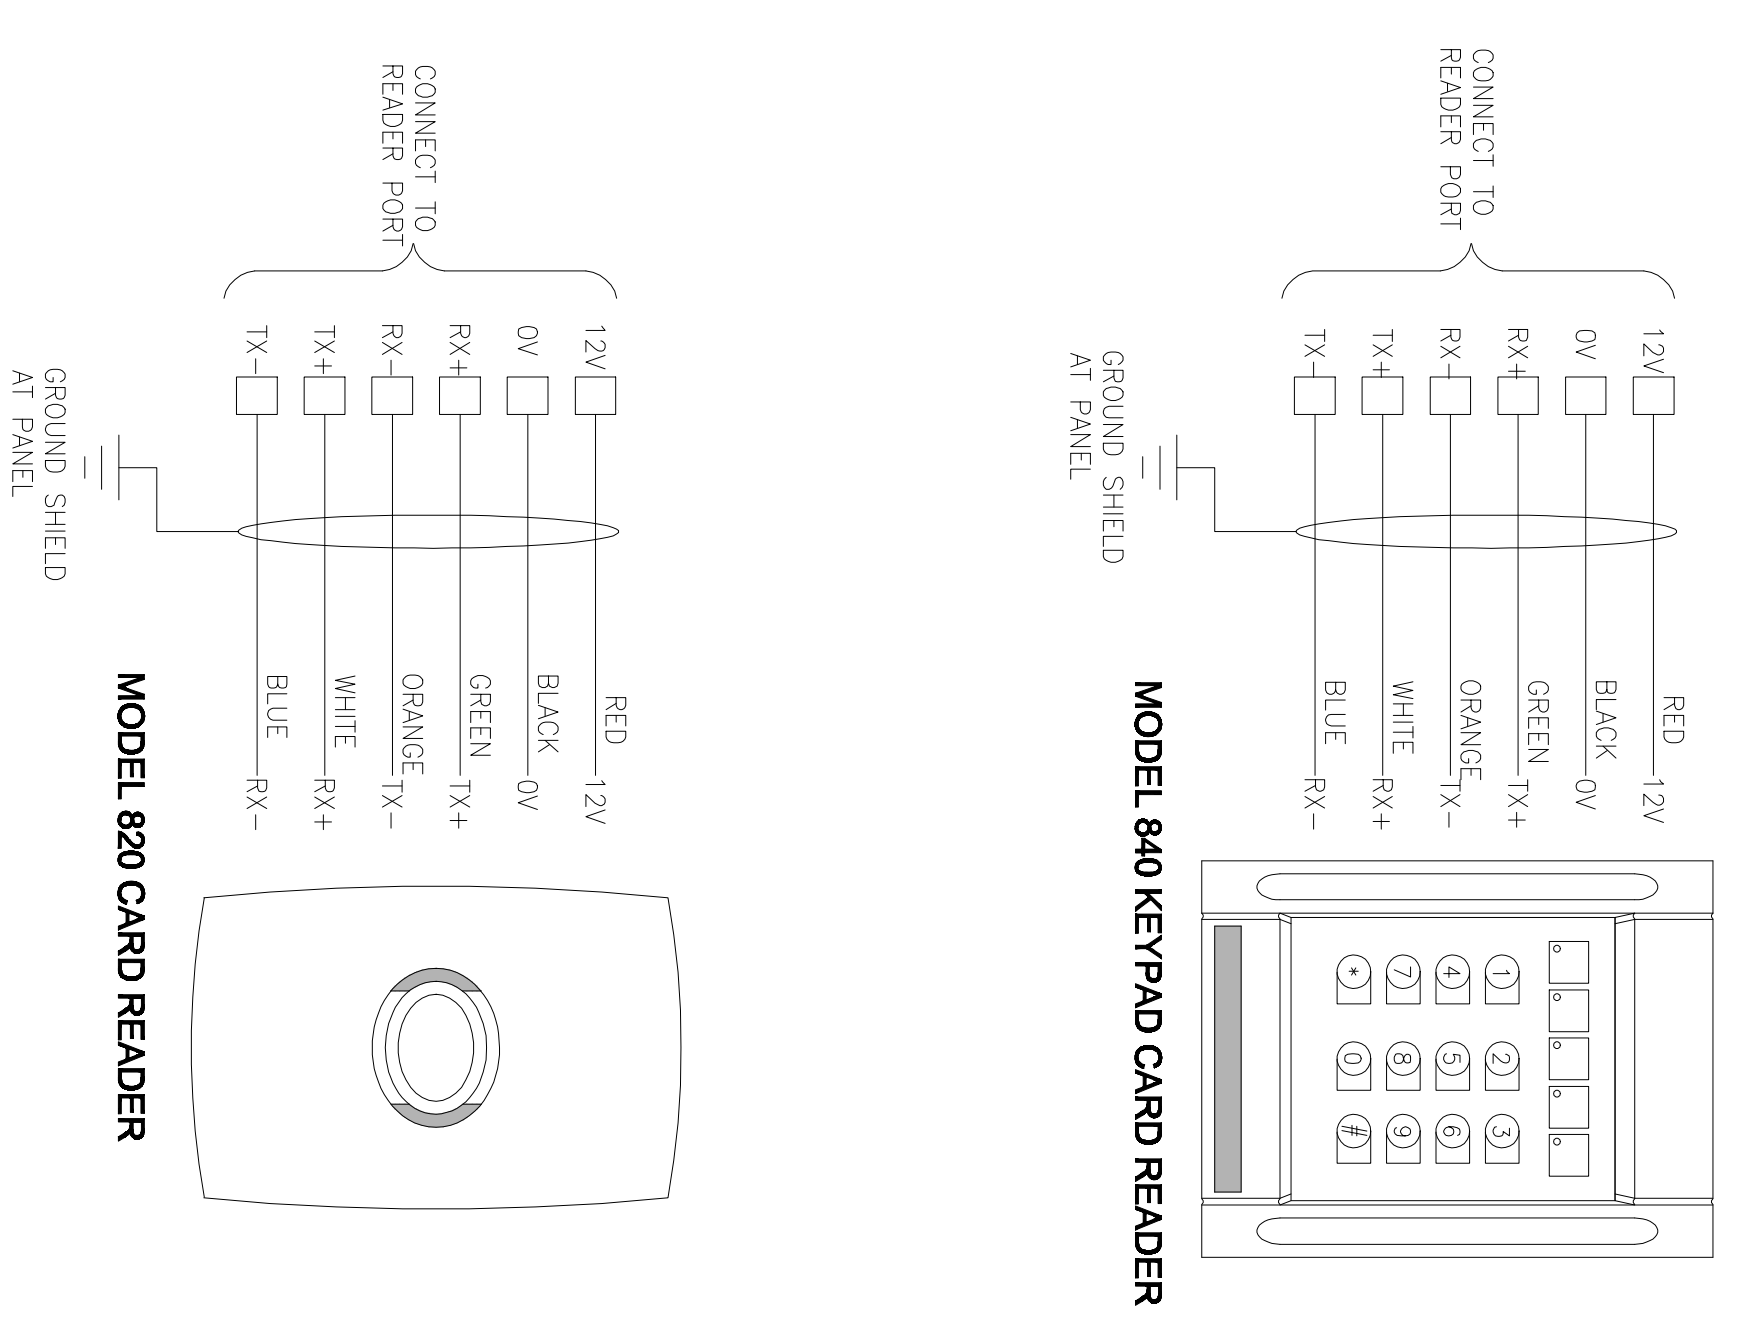


H REQUEST TO EXIT
 SCALE: N.T.S.

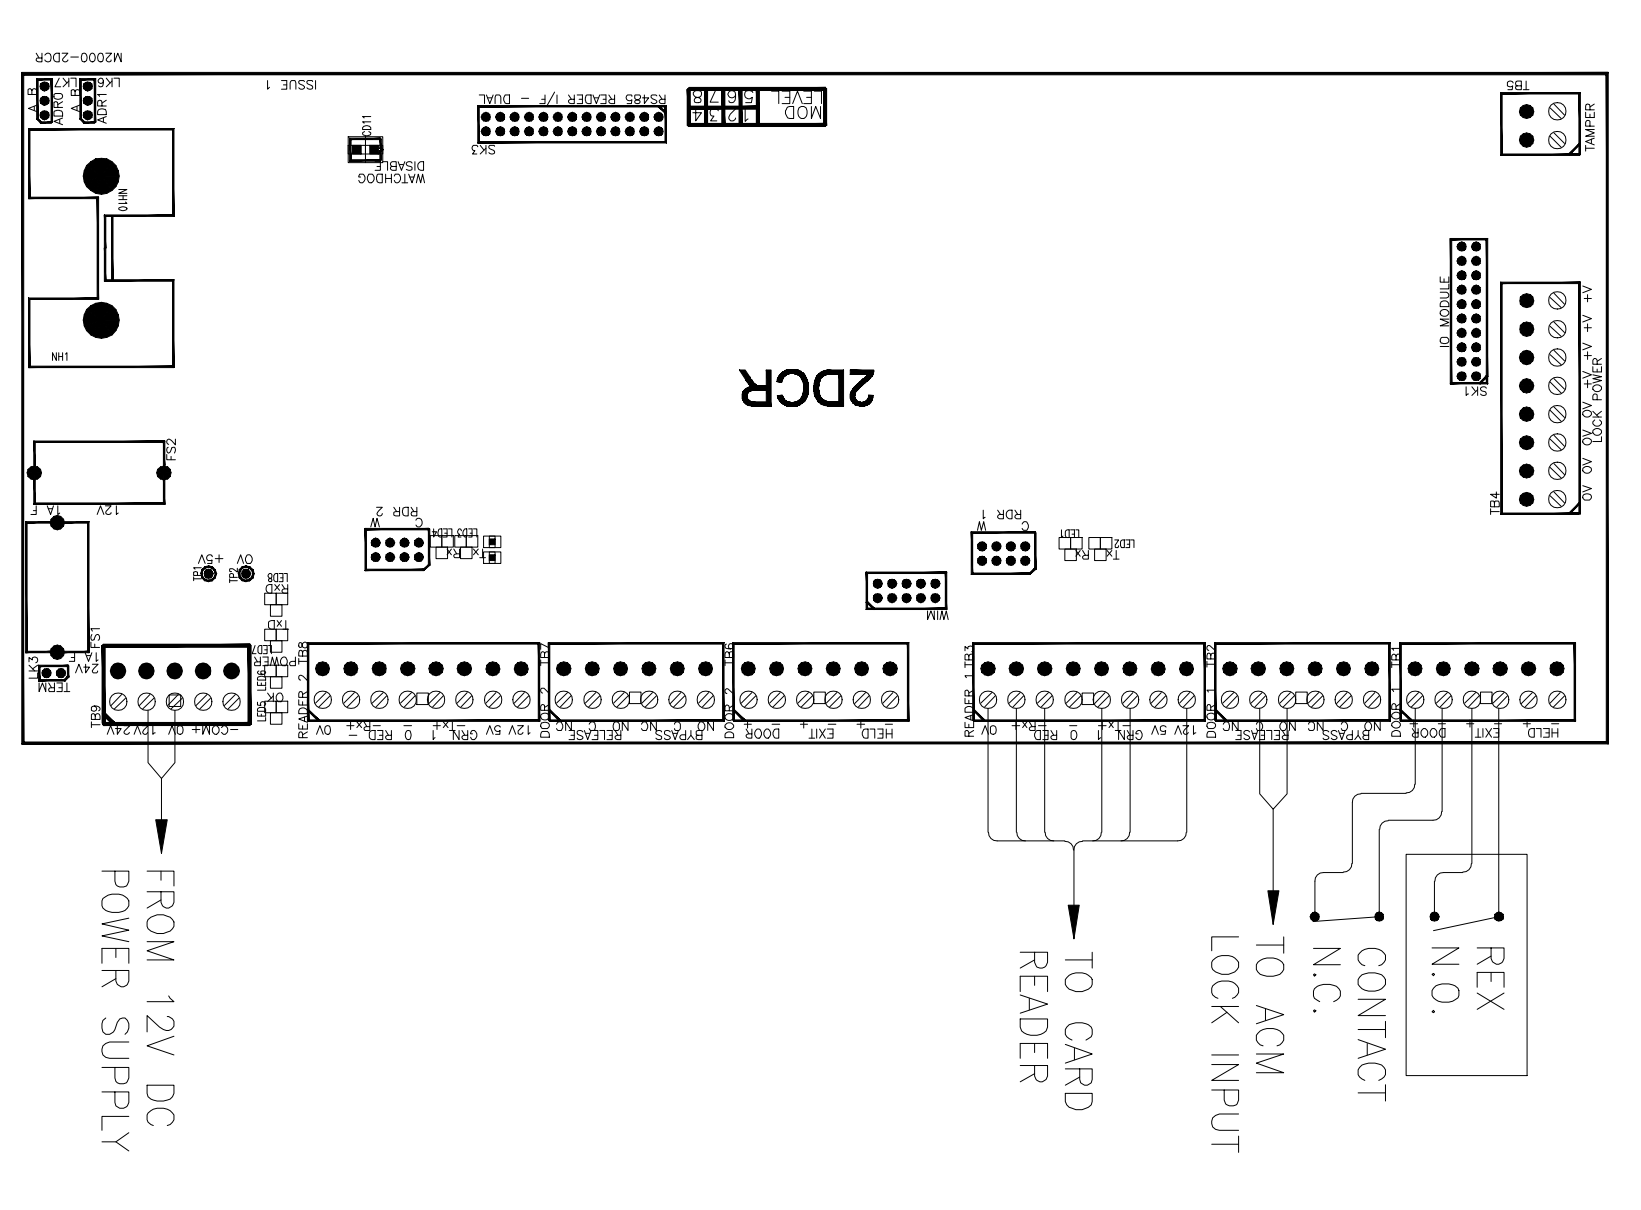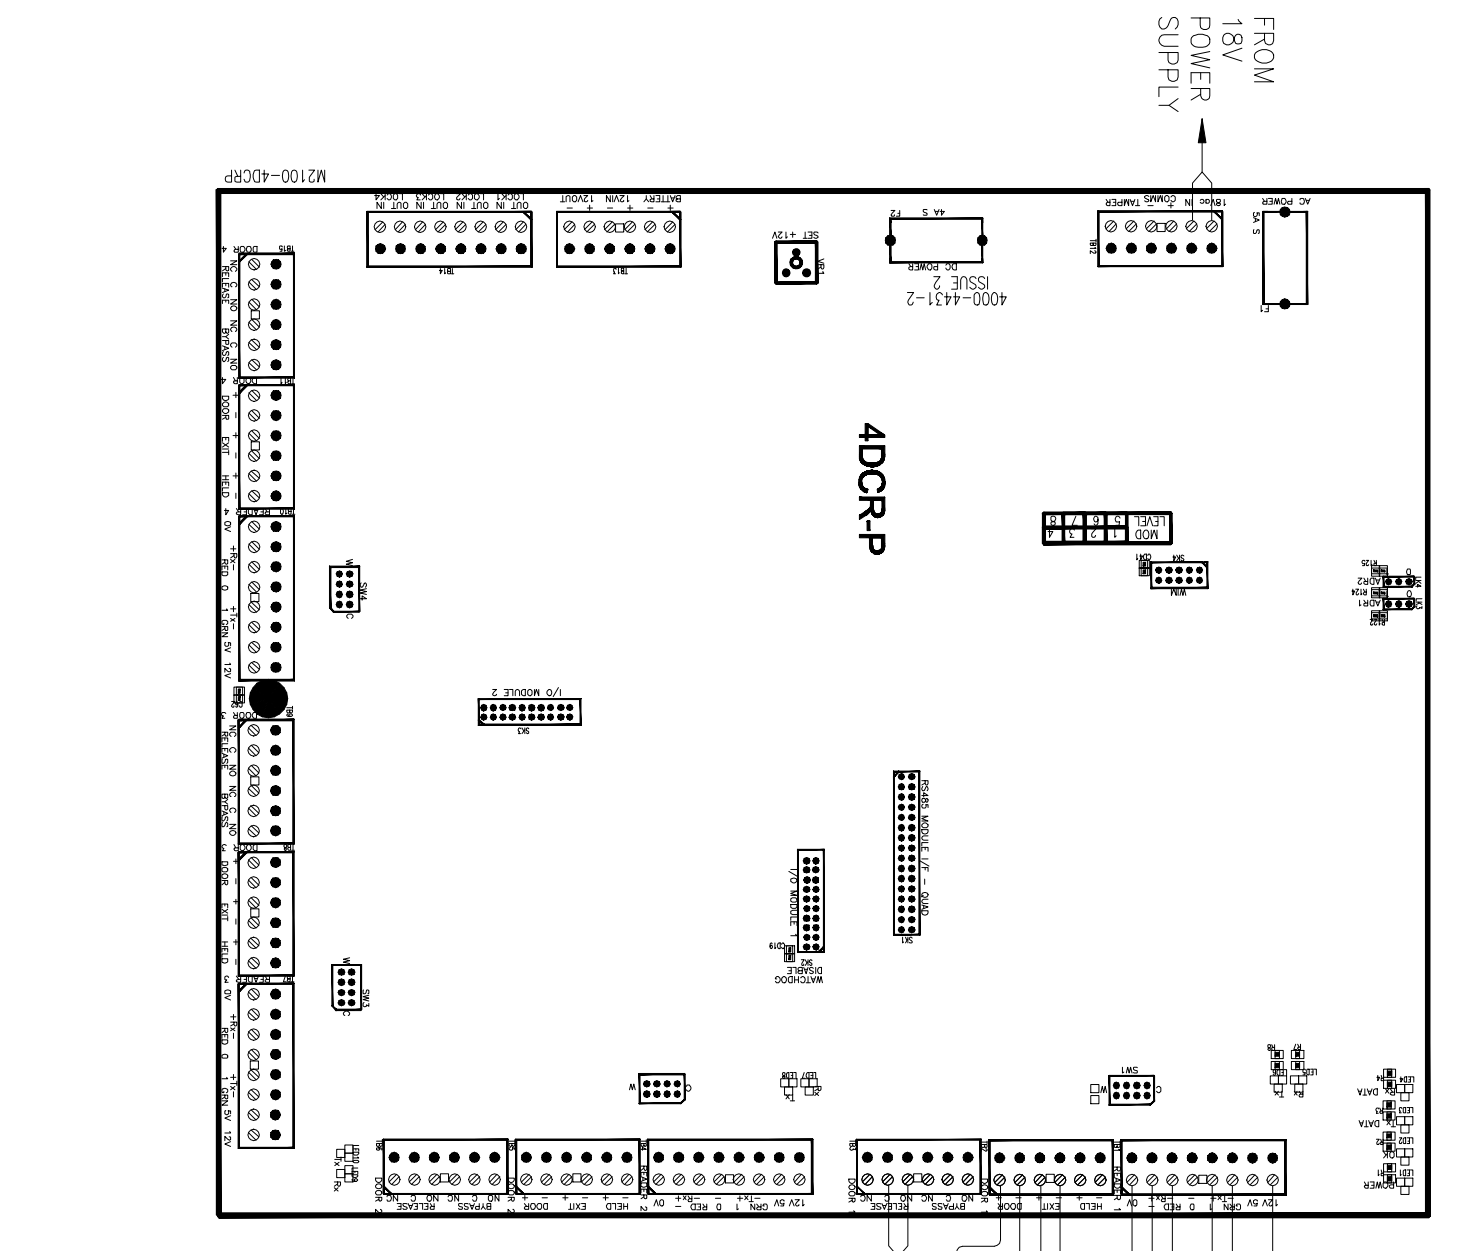


I INPUT/OUTPUT MODULE
 SCALE: N.T.S.

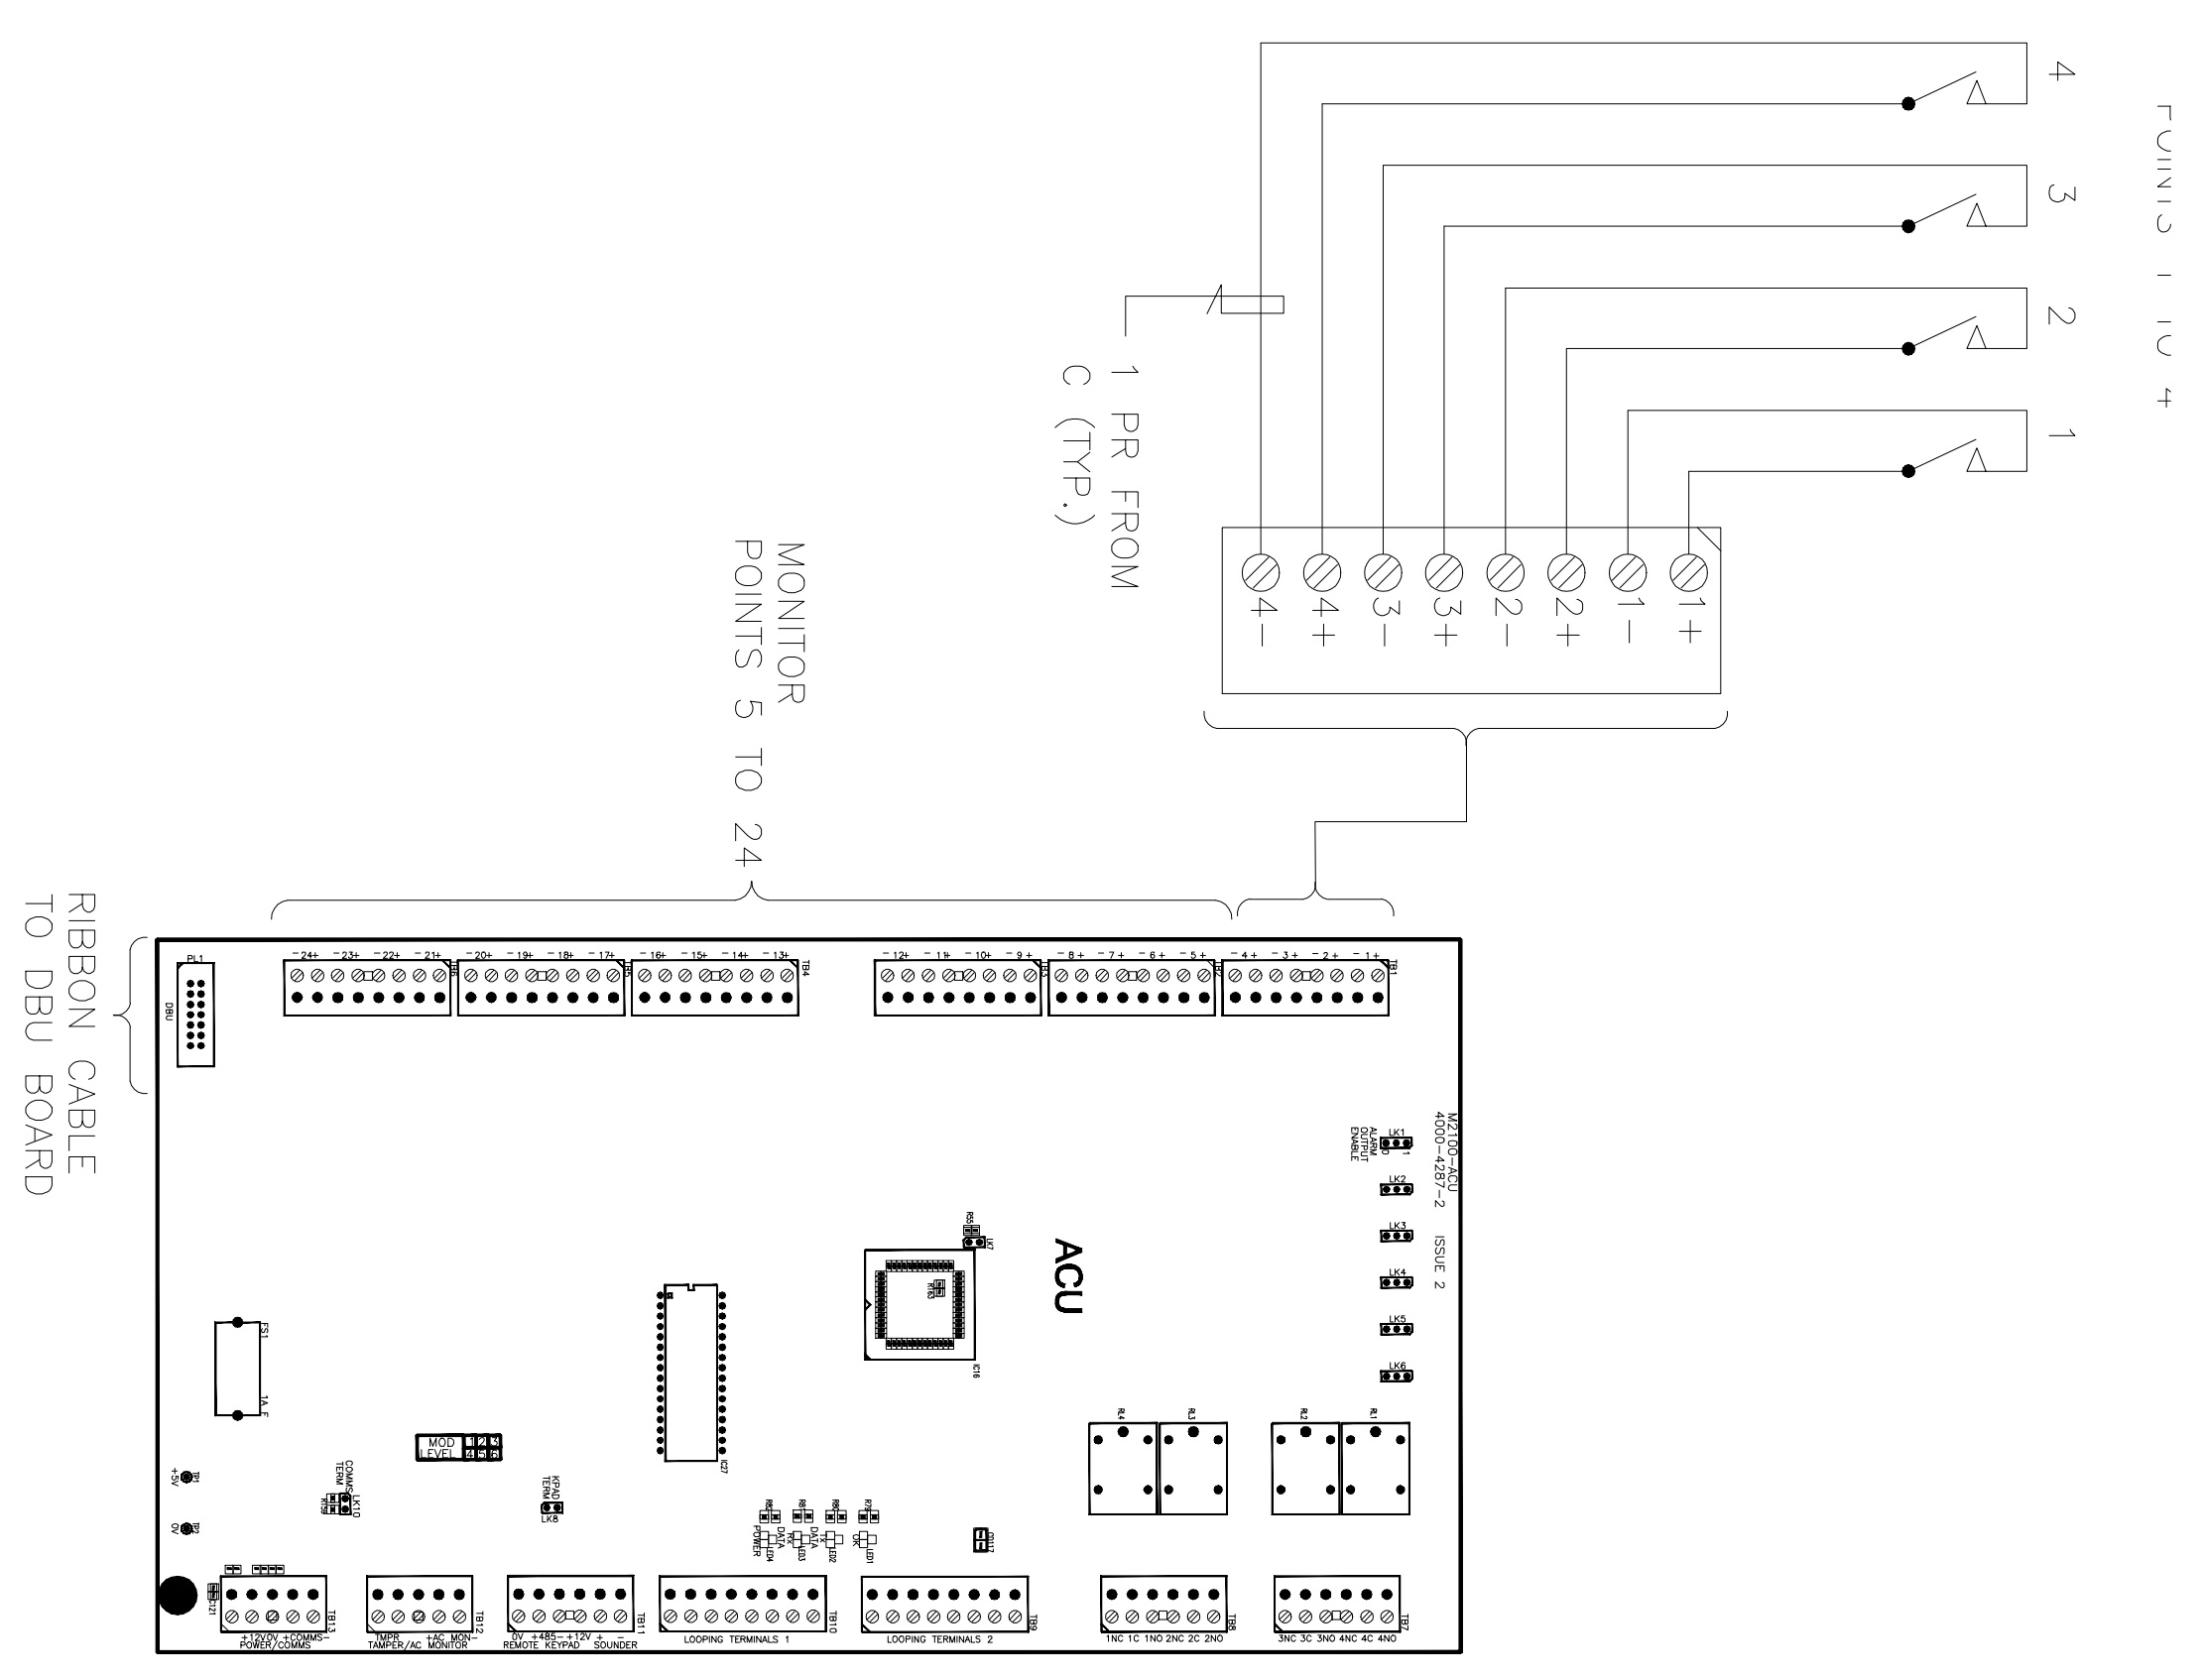


J FOUR DOOR CONTROLLER (TYP.)
 SCALE: N.T.S.

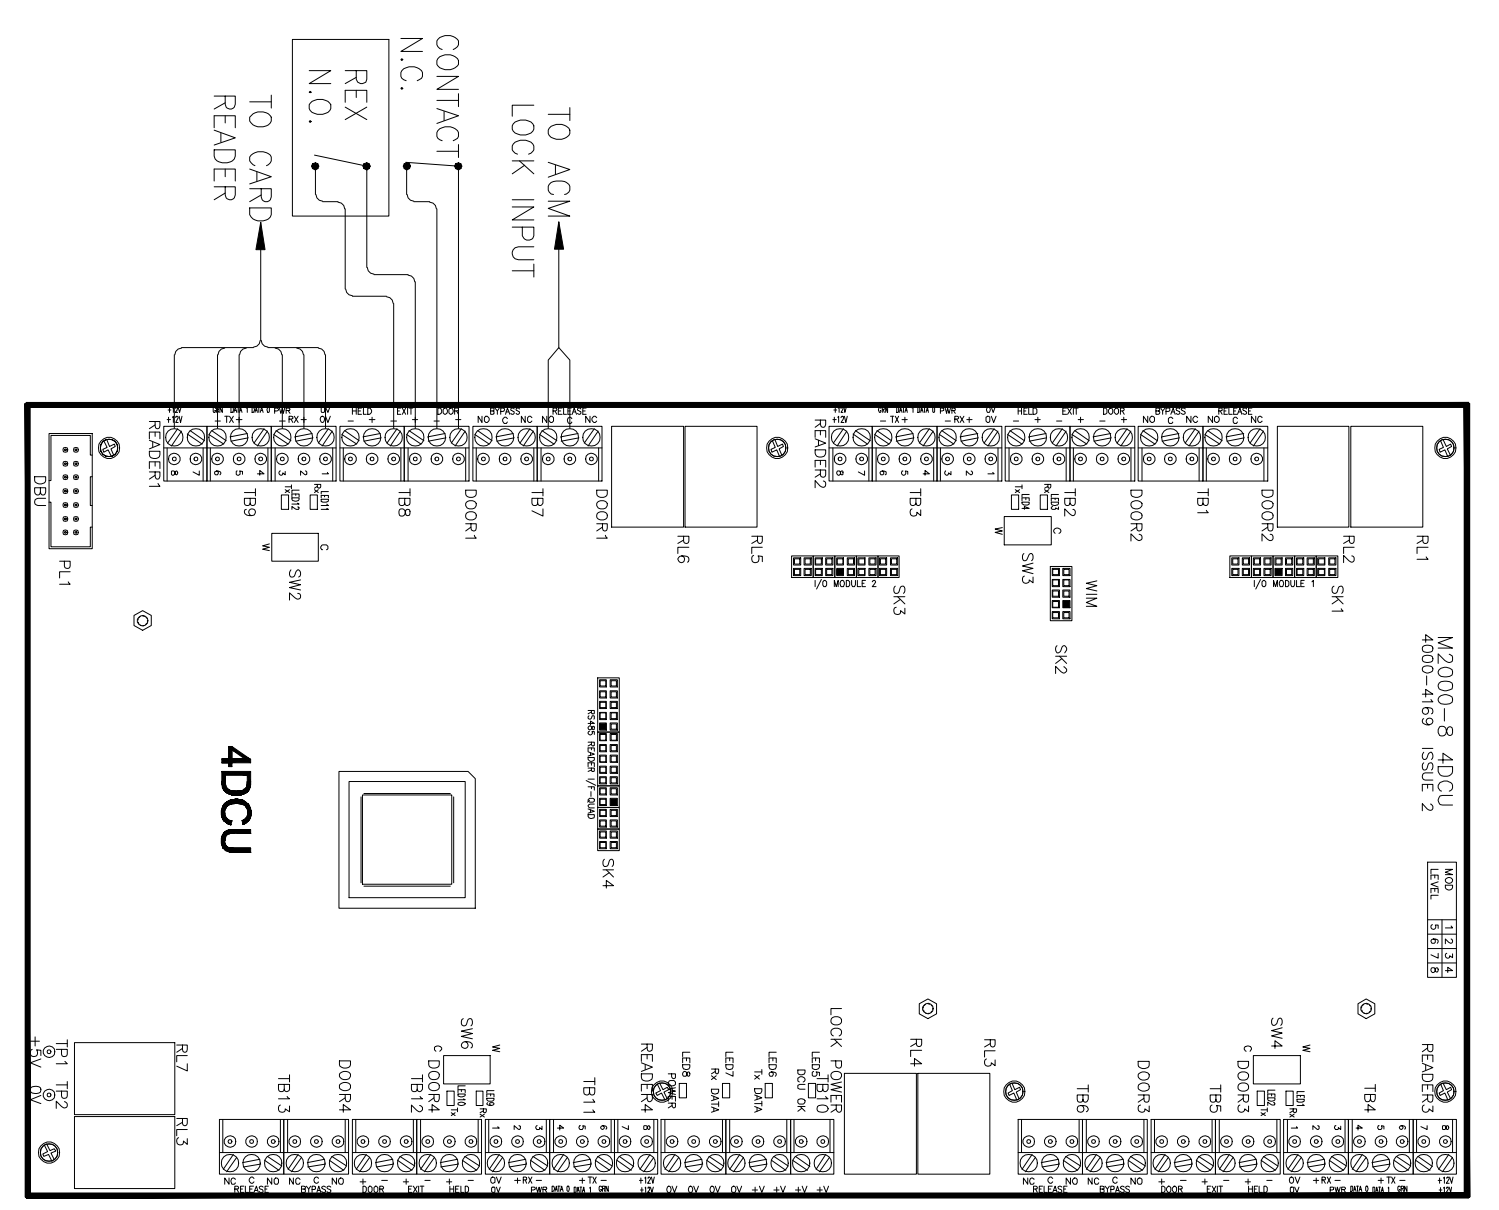

K FOUR DOOR CONTROLLER (REMOTE) (TYP.)
 SCALE: N.T.S.

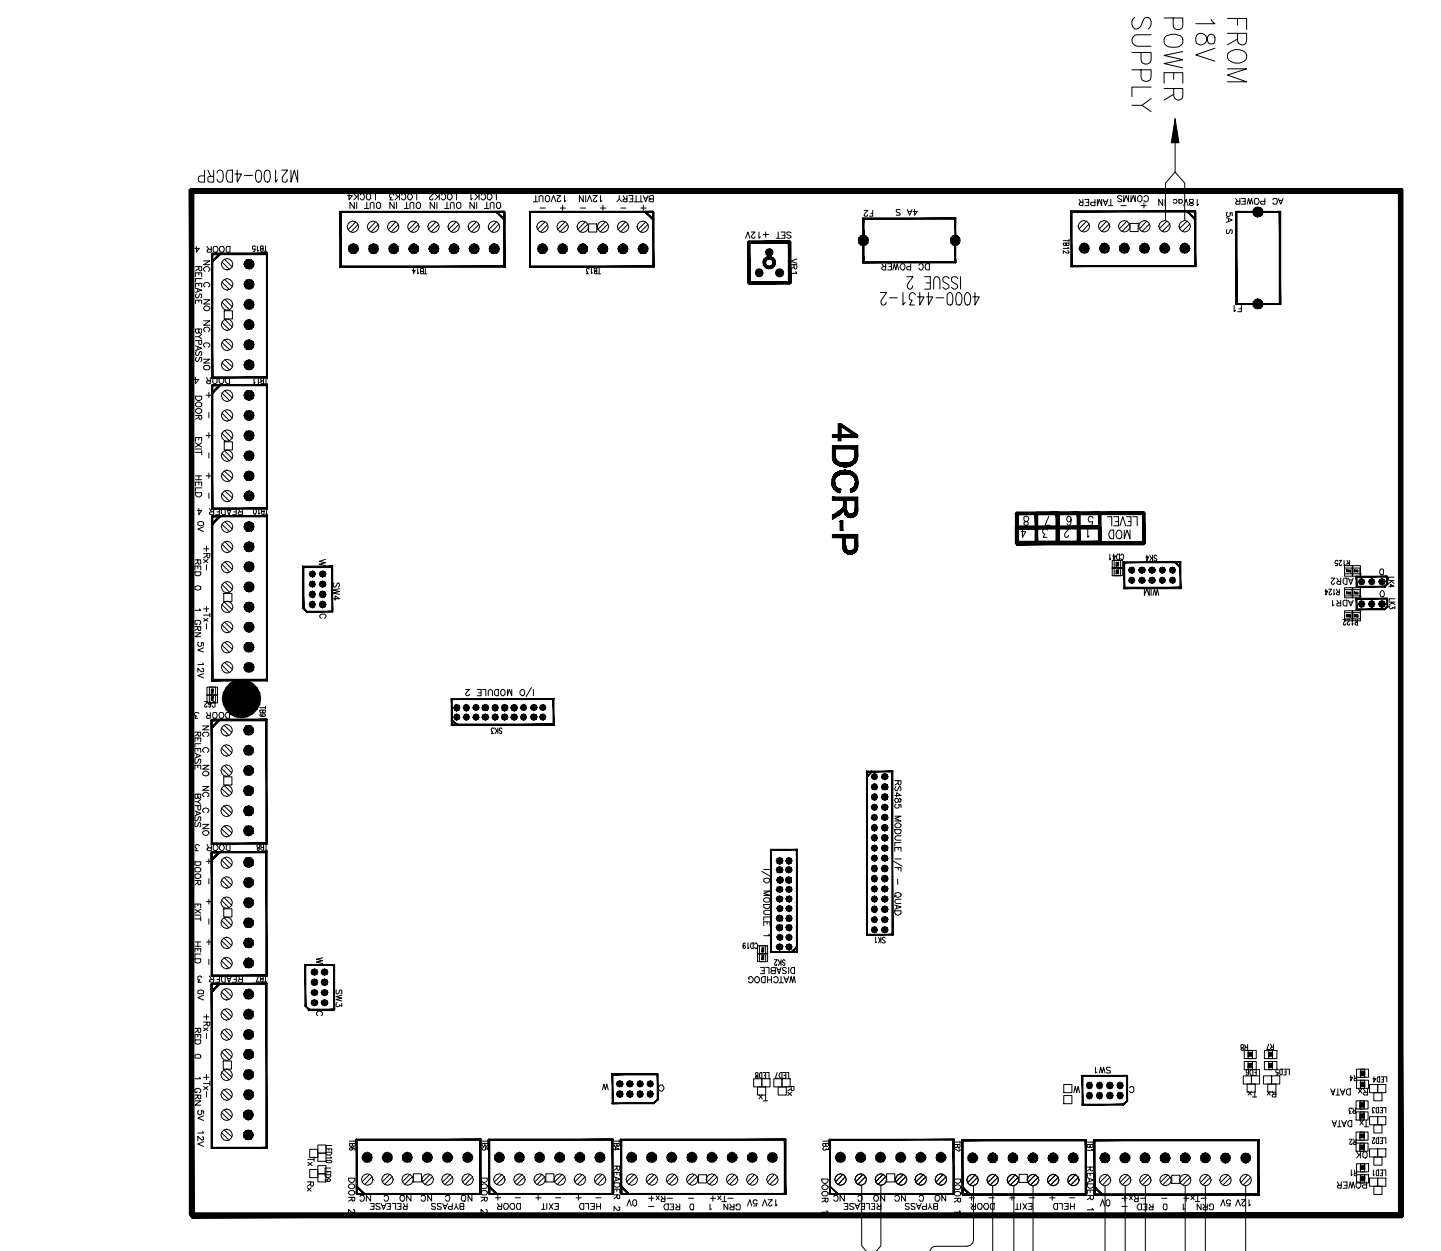

L TWO DOOR CONTROLLER (REMOTE) (TYP.)
 SCALE: N.T.S.

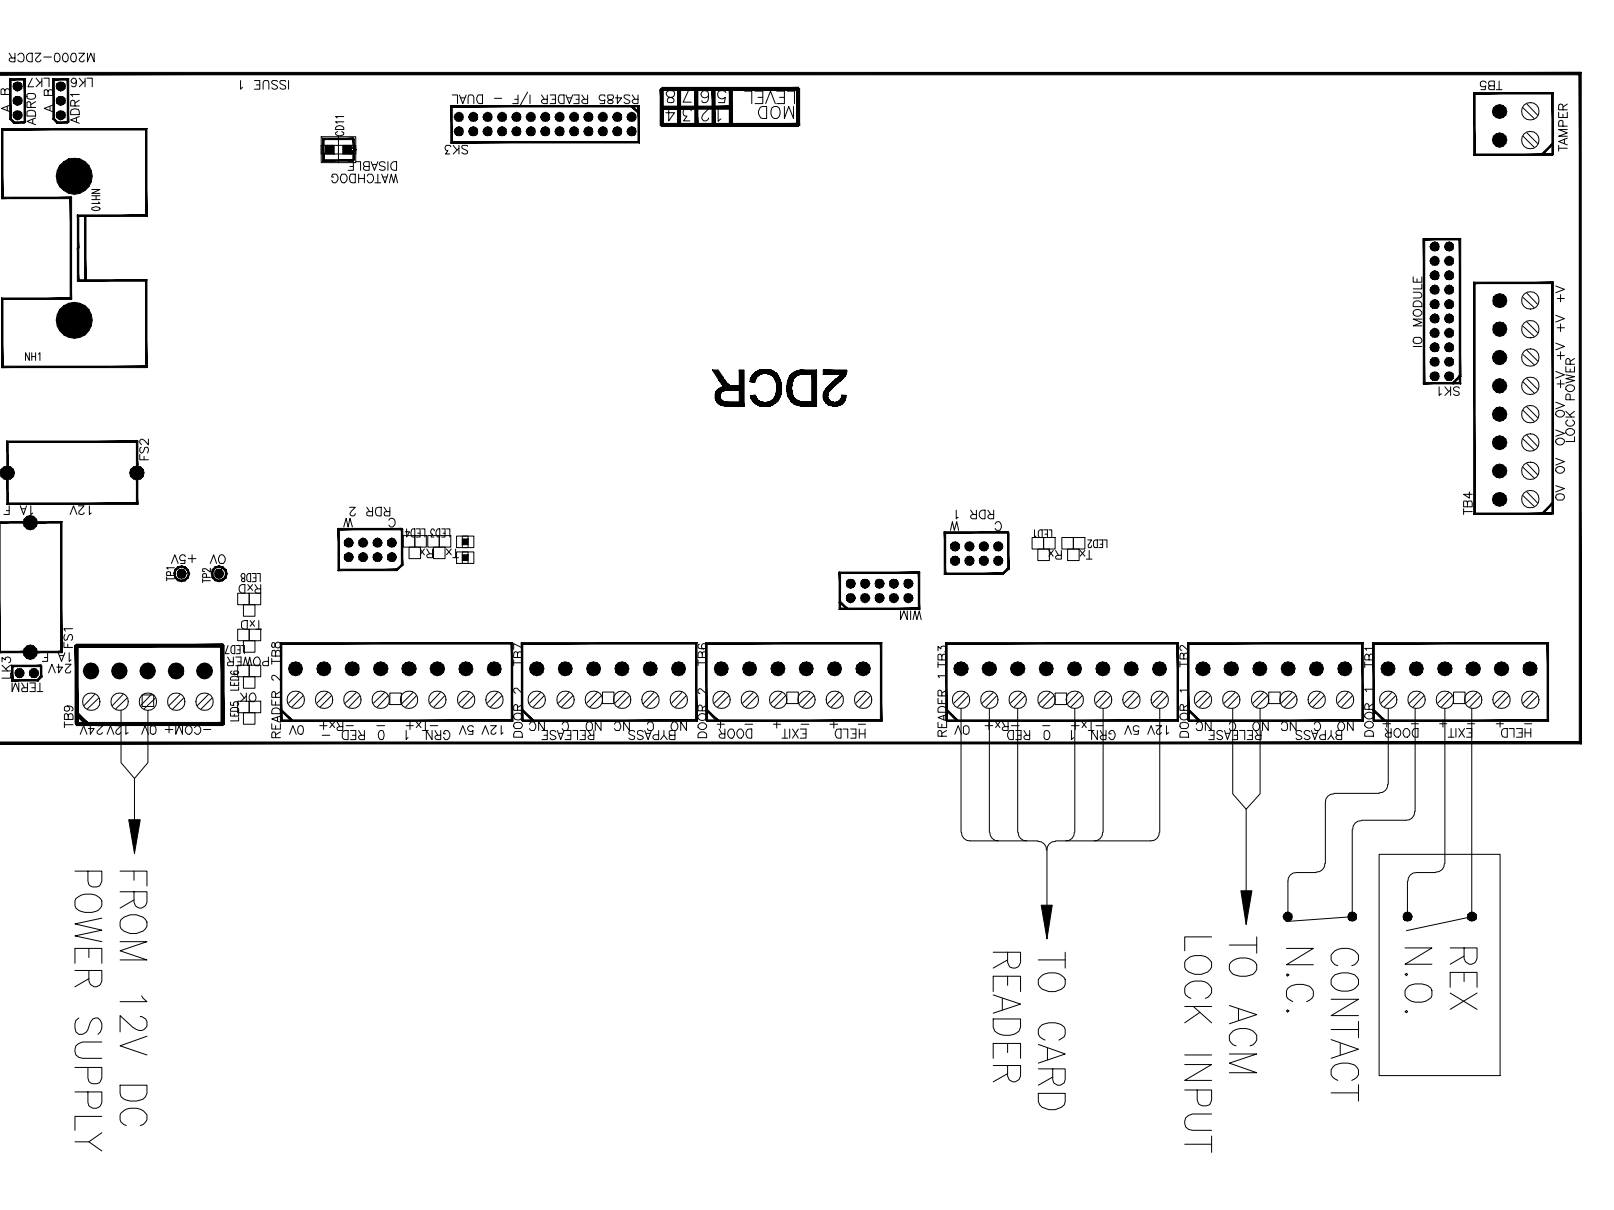

M ALARM CONTROL UNIT
 SCALE: N.T.S.

