

NETVERSANT
Inspiring Technology Solutions

NO.	DESCRIPTION	DATE
1	10% SCHEMATIC DESIGN SUBMITTAL	04/20/09
2	50% DESIGN DEVELOPMENT SUBMITTAL	06/15/09
3	100% DESIGN DEVELOPMENT SUBMITTAL	07/29/09
4	DETAILED DESIGN DEVELOPMENT SITE DEVELOPMENT EVALUATION	08/20/09
5	PERMITTING & PERMITS REVIEW	10/20/09
6	CONSTRUCTION & OFFICE PANELS	11/11/09
7	DEAN INCUMBENT RE. 50% REVIEW	11/11/09
8	DEAN INCUMBENT RE. BACK CHECK	11/19/09
9	DEAN INCUMBENT RE. 50% REVIEW	12/09/09
10	DEAN INCUMBENT RE. 50% REVIEW	02/26/10
11	NOI/PAID ENTRY	03/11/10
12	DEAN INCUMBENT RE. BACKCHECK	06/13/10
13	PROJECT RECORD SET	01/31/11


**PROJECT
 RECORD SET**

**SKYLINE COLLEGE
 CIP2 DESIGN-BUILD
 BUILDING 4N**
GENERAL

PROJECT NO.	07071200	DRAWN BY	ML
DATE	01/31/11	CHECKED BY	CM/CG
SCALE	AS NOTED		
SHEET TITLE			

**AREA OF REFUGE
 DETAILS**

SHEET NO. **SEC-3.05**

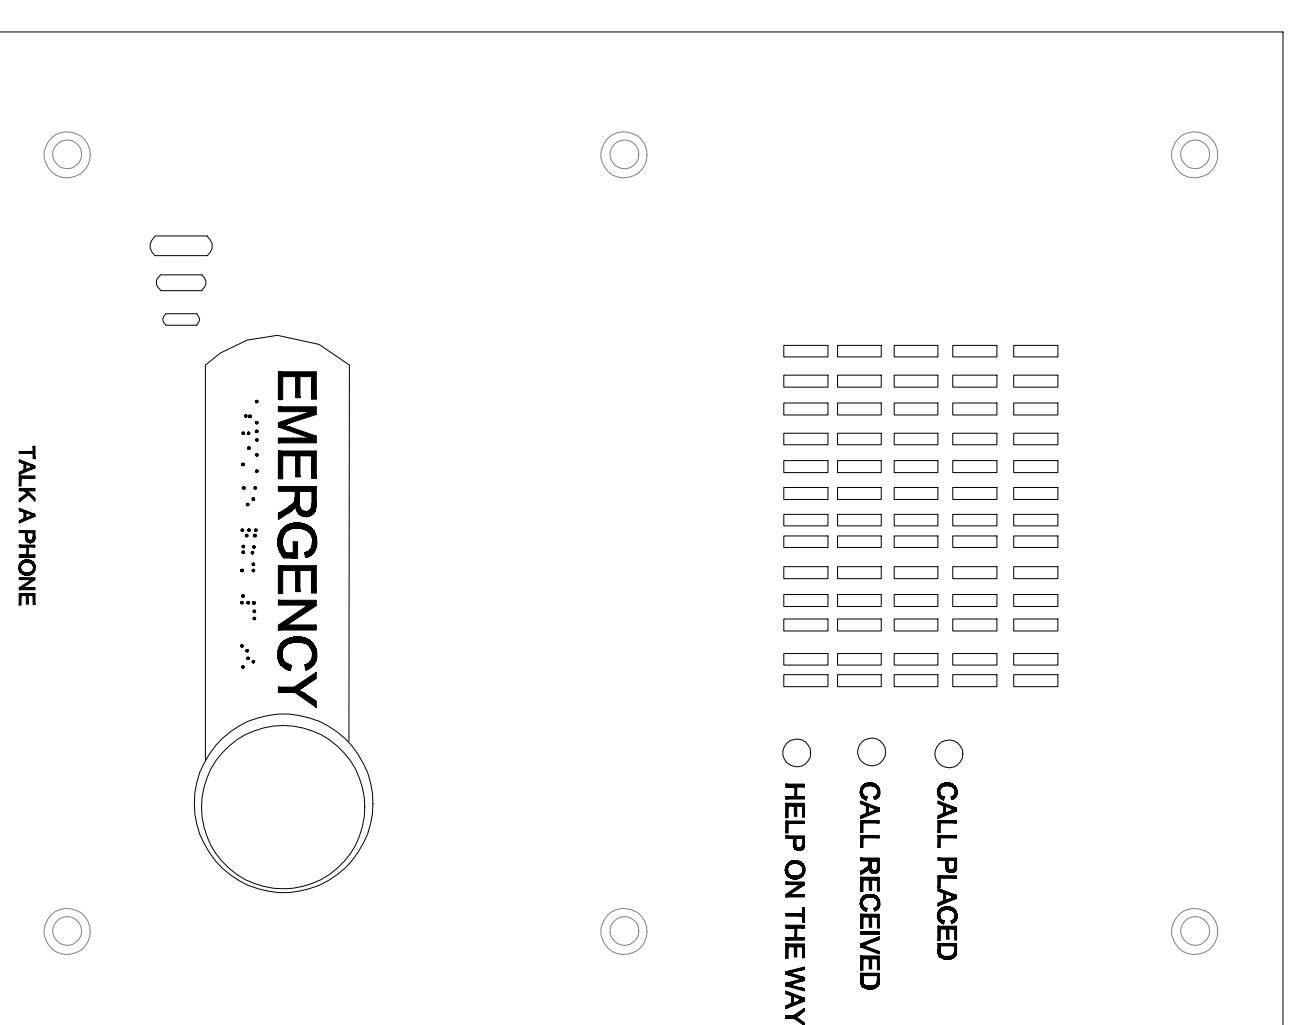


A VOIP-500 EMERGENCY PHONE
 SCALE: N.T.S.

B NOT USED
 SCALE: N.T.S.

C NOT USED
 SCALE: N.T.S.

D NOT USED
 SCALE: N.T.S.

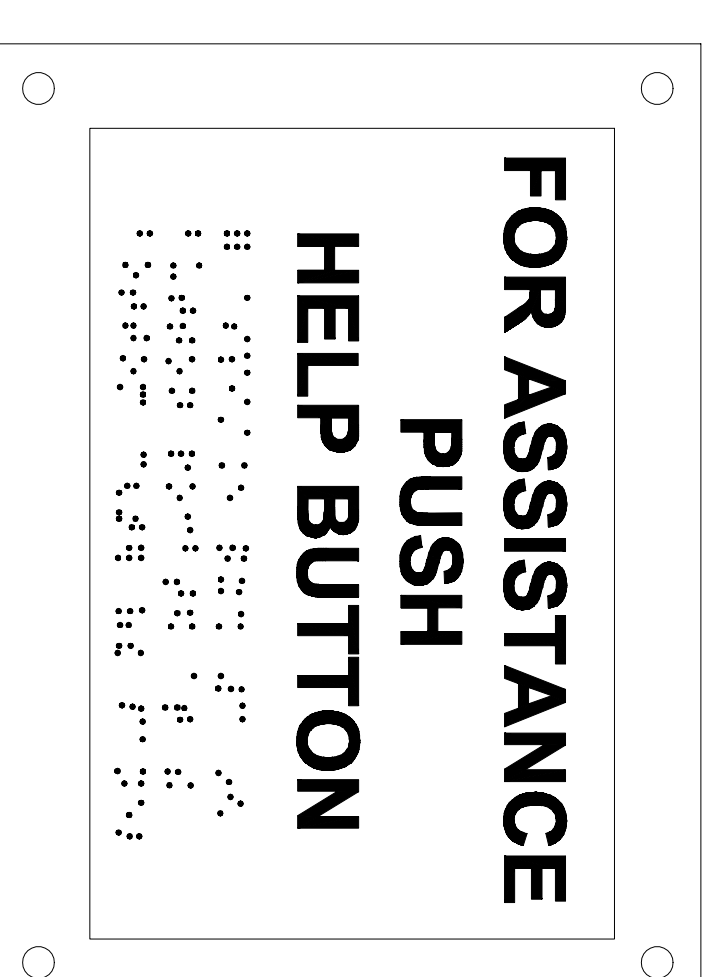

NOTE: SIGNAGE BY OTHERS, COORDINATE WITH
 S.A.I.C.C.O. FOR REQUIREMENTS.
 ASSISTANCE SIGN AND S FOR
 REFERENCE ONLY.

G ASSISTANCE SIGNAGE DETAIL, BY OTHERS
 SCALE: N.T.S.

E NOT USED
 SCALE: N.T.S.

F NOT USED
 SCALE: N.T.S.

All drawings and utility material prepared under the authority of the Architect/Engineer and may not be duplicated, used or otherwise without consent of Architect/Engineer.

This drawing is not to scale. Any dimensions that have not been indicated on this drawing shall be indicated. This line should be equal to one inch.