
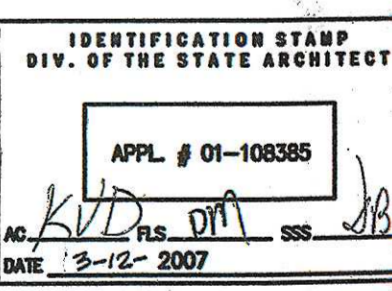


- SHEET NOTES:**
- 1. EXISTING WORKSTATION WITH EXISTING WIREWAY HOUSING DATA AND RECEPTACLES RECONNECT TO CIRCUITS SHOWN. REUSE EXISTING CONDUITS IN FLOOR AND CONNECT TO WIREWAY.
  - 2. PROVIDE NEW 2 COMPARTMENT WIREMOLD 5400B RACEWAY FOR DATA AND DUPLEX RECEPTACLES FED FROM FLOOR BELOW. SEE DETAIL 5/16.01.
  - 3. REMOVE EXISTING POWER AND DATA CONDUITS FROM FLOOR BELOW AND RELOCATE AS NEEDED TO FEED INSTRUCTORS WORK BENCH WIREMOLD. SEE SHEET NOTE 13. INSTALL RECEPTACLES AND CONNECT TO CIRCUITS SHOWN.
  - 4. PROVIDE 3/4" BAYWOOD WITH 15" SWING OUT RAC. PROVIDE SEPARATE 110 PUNCH DOWN FOR VOICE & DATA, AND DOUBLE DUPLEX RECEPTACLE. PROVIDE 3/4" C-1#6 COPPER GROUND WIRE TO BUILDING STEEL OR COLD WATER. CONNECT EXISTING FIBER OPTIC CABLES WITH SPLICE BOX AS REQUIRED.
  - 5. PROVIDE A/V BOX. SEE DETAIL 6/16.01. INSTALL AS DIRECTED BY A/V CONSULTANT/TEECOM. COORDINATE LOCATION ON SITE.
  - 6. PROVIDE 3/4" C FROM JUNCTION BOX AND TERMINATE AT TELEPHONE RISER FOR BURGLER ALARM.
  - 7. PROVIDE 120V CEILING MOUNTED RECEPTACLE FOR PROJECTOR. PROVIDE FOR DATA AS PER TEECOM DRAWINGS.

AS-BUILT

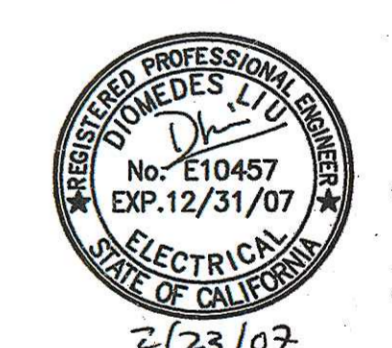


02.27.07	DSA BACK CHECK	
11.02.06	DSA SUBMITTAL	
10.13.06	75% CD	
09.12.06	10% PROGRESS	
rev.	date	issue

**1 THIRD FLOOR POWER AND SIGNAL PLAN**  
1/8" = 1'-0"

**SHEET NOTES**

- 1. RECEPTACLE FOR PROJECTOR. MOUNT ON CEILING 15'-0" FROM SCREEN. PROVIDE SINGLE GANG, 4" SQUARE JUNCTION BOX FOR TELECOM INTERFACE.
- 2. SINGLE GANG, 4" SQUARE BOX FOR WIRELESS ACCESS POINT WIRING. REFER TO TELECOM DRAWINGS FOR EXACT LOCATION AND SIZE.
- 3. TWO-GANG JUNCTION BOX MOUNTED +18" AFF FOR INSTRUCTIONAL PATHWAY. PROVIDE 2" C UP TO 6" ABOVE ACCESSIBLE CEILING SPACE. REFER TO TELECOM DWGS. FOR EXACT LOCATION AND SIZE.
- 4. (2) 4" SLEEVES. REFER TO TELECOM DRAWINGS FOR EXACT LOCATION AND SIZE.
- 5. (1) 2" SLEEVE. REFER TO TELECOM DRAWINGS FOR EXACT LOCATION AND SIZE.
- 6. NOT USED.
- 7. TELECOM GROUND BUSBAR.
- 8. (2) 4" C UP FROM FIRST FLOOR IT ROOM.
- 9. ALL 120V. CIRCUITS FOR MISC. RECEPTACLES, EQUIPMENT, ETC. SHALL BE CONNECTED FROM PANEL "7R3B" U.O.N.
- 10. ALL 120V. CIRCUITS FOR MISC. RECEPTACLES, EQUIPMENT, ETC. SHALL BE CONNECTED FROM PANEL "7R3A" U.O.N.
- 11. ALL 480V/3Ø CIRCUITS FOR MECHANICAL EQUIPMENTS ETC. SHALL BE CONNECTED FROM "MCCB".

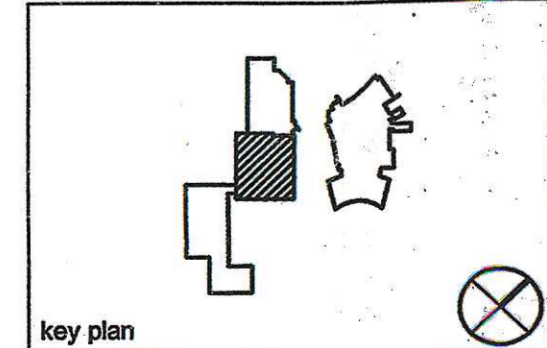

STEINBERG ARCHITECTS

project no: 06015 date: 02.27.07  
drawn by: MAMP checked by: VB  
scale: 1/8" = 1'-0"