

1 HOUR ENCLOSURE DETAIL FOR PANEL BOARD
NOT TO SCALE

① ACTUAL ARRANGEMENT MAY VARY FROM DETAIL SHOWN. PROVIDE REQUIRED SECTIONS PER THE SUPPLIER OF THE MCC.

"MCCA" ELEVATION
NOT TO SCALE



② ACTUAL ARRANGEMENT MAY VARY FROM DETAIL SHOWN. PROVIDE REQUIRED SECTIONS PER THE SUPPLIER OF THE MCC.

"MCCB" ELEVATION
NOT TO SCALE

③ FLOOR MOUNTED PANEL ANCHORAGE DETAIL
NOT TO SCALE

④

AS-BUILT

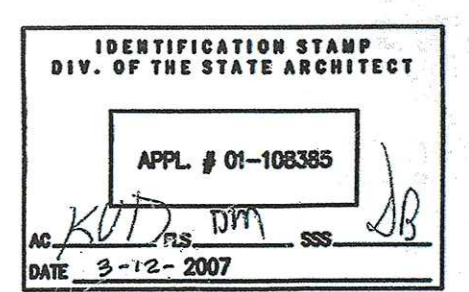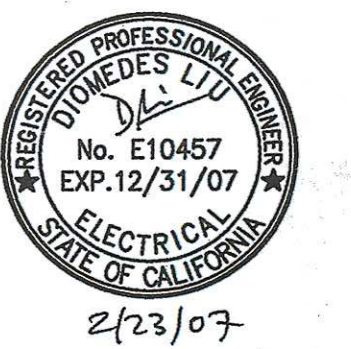

02.27.07	DSA BACK CHECK
11.02.06	DSA SUBMITTAL
10.13.06	75% CD
09.12.06	40% PROGRESS
REV.	DATE

