


SITE GRADING PLAN NOTES

1. GENERAL CONTRACTOR SHALL HAVE A PIPE FINDING FIRM LOCATE ALL EXISTING UNDERGROUND UTILITIES AND SUBMIT DRAWING TO ARCHITECT FOR REVIEW PRIOR TO START OF WORK.
2. CIVIL ENGINEER SHALL VERIFY ALL ELEVATIONS AND LOCATIONS OF STORM PIPES AND UTILITIES TO BE CONNECTED PRIOR TO START OF WORK. INDICATE ALL INFORMATION ON AS-BUILT DRAWINGS.
3. IT SHALL BE CONTRACTOR'S RESPONSIBILITY TO OBTAIN ALL PERMITS AND/OR CLEARANCES REQUIRED BY GOVERNMENTAL AGENCIES HAVING JURISDICTION AND CONTROL OVER DUST, GRADING AND STORM WATER CONTAINMENT DURING CONSTRUCTION OPERATIONS.
4. LINE OF PHASE I AND PHASE II WORK WILL BE FINALIZED AFTER AWARD OF CONTRACT AND AS MAY BE MUTUALLY AGREED UPON BETWEEN CONTRACTOR AND OWNER.

* VERIFY IN FIELD

NO.	DATE	REASON	BY
1	10/15/01	ADDENDUM#1	
2	10/26/01	ADDENDUM#2	
3	02/28/03	ADDENDUM#2	
4	3/17/03	CR #19	
5	5/20/03	CR #20	

ISSUE FOR PROGRESS REVIEW 01/15/01
 ISSUE FOR PLAN CHECK 01/25/01
 ISSUE FOR FINAL REVIEW 05/09/01
 ISSUE FOR BID
 ISSUE FOR CONSTRUCTION

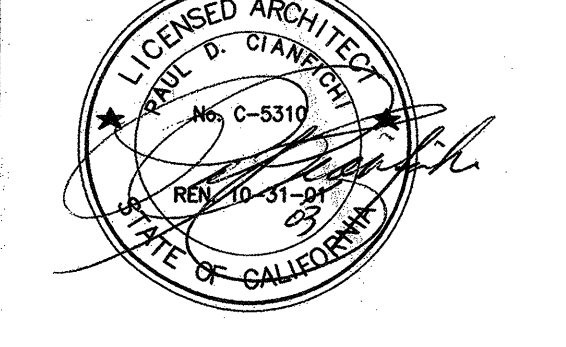

CONSULTANT:
 ARCHITECT:
 CIANFICHI
 ARCHITECTURE + PLANNING
 30 ANNE COURT
 WALNUT CREEK, CA 94598
 TEL.: (925) 256-8838
 FAX.: (925) 256-8852

PROJECT:
 CHILD DEVELOPMENT
 CENTER
 CAÑADA COLLEGE
 4200 FARM HILL BLVD.
 REDWOOD CITY, CA 94061
 SAN MATEO COUNTY COMMUNITY
 COLLEGE DISTRICT

STAMP:
 APPROVED
 DIV. OF THE STATE ARCHITECT
 A.C. A.G. PLS. ED. SS. SC
 APPL. NO. 102529 DATE 6/16/03

KEY PLAN:
 SHEET TITLE:
 SITE GRADING PLAN

DRAWN BY:
 CL
 PROJECT NO.:
 304.99
 CHECKED BY:
 BA
 DATE:
 03/17/03
 APPL. NO.:
 SHEET:
 DATA NO.:
 NO. OF:
SW1.1r

SITE GRADING PLAN LEGEND

- 686 — (E) CONTOUR TO REMAIN
- - - 686 - - - (E) CONTOUR TO BE REVISED
- 686 — (N) CONTOUR