


NO.	DATE	REASON	BY
1	10/15/01	ADDENDUM #1	
2	10/26/01	ADDENDUM #2	
3	3/17/03	CP #19	

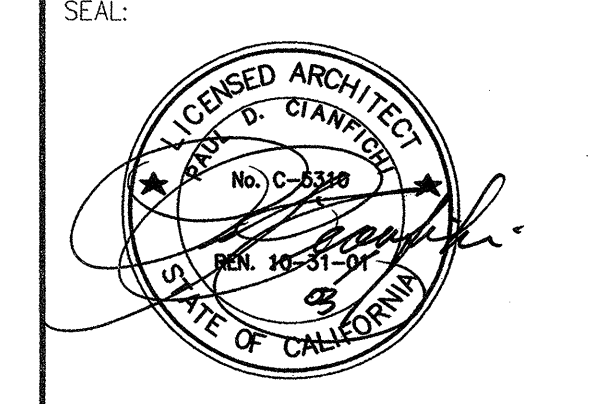

ARCHITECT:
 CONSULTANT:
 ARCHITECT
 CONSULTANT

PROJECT:
CHILD DEVELOPMENT CENTER
CAÑADA COLLEGE
 4200 FARM HILL BLVD.
 REDWOOD CITY, CA 94061

APPROVED
 DIV. OF THE STATE ARCHITECT
 AC. *ML* FLS. *ES* SS. *PA*
 APPL. NO. *103579* DATE *9/23/03*

APPL. NUMBER:
 KEY PLAN:
BUILTS

SHEET TITLE:	
SITE DETAILS	
DRAWN BY: CG	PROJECT NO.: 304.99
CHECKED BY: JC	DATE: 3-14-03
APPL. NO.:	SHEET: SW2.1f
DATA NO.:	NO. OF: