


REVISIONS: (A) INDICATES REVISIONS MADE TO THIS SHEET

NO.	DATE	REASON	BY
1	10/15/01	ADDENDUM#1	
2	10/26/01	ADDENDUM#2	
3	3/17/03	CP #19	

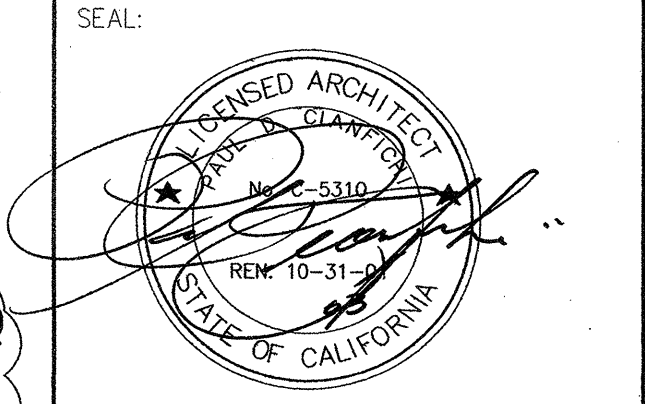

CONSULTANT:

ARCHITECT:

CONSULTANT:

ARCHITECT:

C I A N F I C H I
ARCHITECTURE • PLANNING

30 ANNE COURT
WALNUT CREEK, CA 94598
TEL: (925) 256-8638
FAX: (925) 256-8652

PROJECT:

**CHILD DEVELOPMENT CENTER
CANADA COLLEGE**

4200 FARM HILL BLVD.
REDWOOD CITY, CA 94061

SAN MATEO COUNTY COMMUNITY COLLEGE DISTRICT

STAMP:

APPL. NUMBER:

KEY PLAN:

AS-BUILTS

SHEET TITLE:

SITE DETAILS

DRAWN BY: CO	PROJECT NO.: 304.99
CHECKED BY: JC	DATE: 3-14-03
APPL. NO.:	SHEET: SW2.2r
DATA NO.:	NO. OF: