



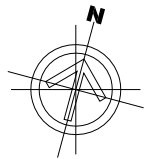

- Legend:**
- CEILING CLEARED
  - FLOOR REPLACED
  - CEILING CLEARED  
FLOOR REPLACED
  - AREA NOT SURVEYED  
OR NOT ACCESSIBLE

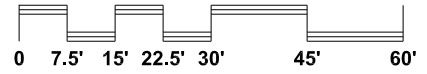

**Skyline Community College - Building 1, First Floor**  
**Field Survey of (E) Modifications - Sheet 1/3**  
**4/07/08**

FIRST FLOOR - FINE ARTS CENTER