

ABBREVIATIONS

Table with 2 columns: Abbreviation and Full Name. Includes terms like @ AND, ABV ANCHOR BOLTS, AD ADDITIONAL CONCRETE, etc.

REINFORCEMENT DEVELOPMENT LENGTHS & SPLICE TABLES


Table with columns: REINFORCED CONCRETE, REINFORCEMENT SIZE, and various rebar sizes (#3 to #11).

REINFORCEMENT LAP SPLICES (LENGTH IN INCHES)

Table with columns: REINFORCED CONCRETE, REINFORCEMENT SIZE, and various rebar sizes (#3 to #11).

Table with columns: REINFORCED CONCRETE, REINFORCEMENT SIZE, and various rebar sizes (#3 to #11).

Table with columns: REINFORCED CONCRETE, REINFORCEMENT SIZE, and various rebar sizes (#3 to #11).

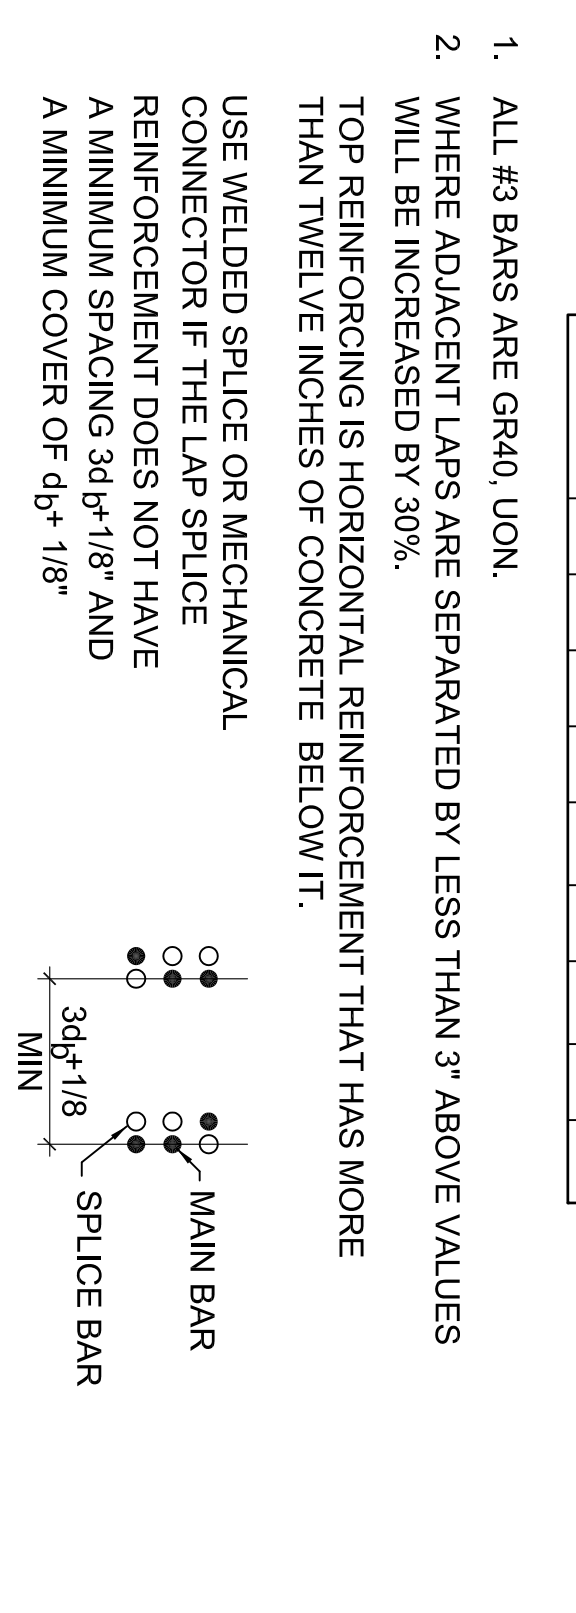

- 1. ALL #3 BARS ARE GR40, UO.N.
2. WHERE ADJACENT LAPS ARE SEPARATED BY LESS THAN 3 ABOVE VALUES WILL BE INCREASED BY 30%.

A. GENERAL

- 1. THE INTENT OF THESE DRAWINGS IS TO SHOW ALL ITEMS NECESSARY TO COMPLETE THE FOUNDATION, FOR ITEMS, METHODS AND/OR MATERIALS NOT SHOWN, THE MINIMUM REQUIREMENTS OF THE 2007 CBC SHALL GOVERN. ALL WORK AND CONSTRUCTION SHALL COMPLY WITH ALL OTHER APPLICABLE BUILDING CODES, SOIL REPORTS, REGULATIONS AND SAFETY REQUIREMENTS.

- 8. THE CONTRACTOR SHALL CHECK AND VERIFY ALL DIMENSIONS WITH THE ARCHITECTURAL, ELECTRICAL, AND MECHANICAL DRAWINGS BEFORE PREPARING SHOP DRAWINGS, FABRICATION OR CONSTRUCTION. SEE ARCHITECTURAL, ELECTRICAL, AND MECHANICAL DRAWINGS FOR SIZE AND LOCATIONS OF PIPES, SLEEVES, PITS, VENTS, DUCTS, ETC. AND DETAILS NOT SHOWN ON THE STRUCTURAL DRAWINGS.

- 9. OPENINGS, POCKETS, ETC., LARGER THAN 6" SHALL NOT BE PLACED IN CONCRETE SLABS, DECKS, WALLS, UNLESS SPECIALLY DETAILED ON THE STRUCTURAL DRAWINGS, NOTIFY THE STRUCTURAL ENGINEER WHEN DRAWINGS BY OTHERS SHOW OPENINGS, POCKETS, ETC., LARGER THAN 6" NOT SHOWN ON THE STRUCTURAL DRAWINGS, BUT WHICH ARE LOCATED IN STRUCTURAL MEMBERS, FOR ANY FURTHER RESTRICTIONS ON OPENINGS IN STRUCTURAL MEMBERS. SEE APPLICABLE SECTIONS BELOW.

- 10. REINFORCING STEEL SHALL NOT BE EMBEDDED IN CONCRETE UNLESS SPECIALLY DETAILED AND APPROVED. NO CONDUITS SHALL BE PLACED IN CONCRETE FILL OVER METAL DECKING.

C. DESIGN BASIS

- 1. REFERENCE CODE
2007 CALIFORNIA BUILDING CODE, VOLUME 2
ASCE 7-05, ASCE 380-05, ASCE 304-05, ACI 318-05
2. DESIGN LOADS:
DEAD LOADS: THE ACTUAL WEIGHT OF ALL PERMANENT CONSTRUCTION AND FIXED EQUIPMENT, INCLUDING 2 PSF FOR FIRE SPRINKLER SYSTEM.
OFFICE AREAS/ CLASSROOMS 50 PSF
HIGH DENSITY STORAGE & FILE ROOMS 125 PSF
CORRIDORS, STAIRS AND ELEVATORS 100 PSF
PARTIAL FLOOR ALL ELEVATORS 15 PSF
PARTIAL FLOOR ALL AREAS 100 PSF
ASSEMBLY ROOMS/ AREAS, AUDITORIUMS 20 PSF
SLABS ON GRADE 80 PSF
BASEMENT WALLS:
SOIL
NOT TEST PRESSURE
SEISMIC INCREMENT 124 PSF
VOLCANIC ROCK FILL
AT REST PRESSURE 10 PCF + 4H PSF
SEISMIC INCREMENT 3H PSF
WIND LOADS: BASIC WIND SPEED 85 MPH
EXPOSURE CATEGORY C
IMPORTANT FACTOR 1.15

SEISMIC LOADS:

- SEISMIC LOADS ARE DETERMINED IN ACCORDANCE WITH 2007 CBC, GEOTECHNICAL REPORT BY TRC DATED JULY 17, 2008 AND ASCE 7-05 USING THE FOLLOWING DESIGN CRITERIA:
SITE CLASSIFICATION: CLASS D
DESIGN FACTORS: S<sub>MS</sub> = 1.0, F<sub>v</sub> = 1.5
S<sub>MS</sub> = 1.15, S<sub>MI</sub> = 0.98
OCCUPANCY CATEGORY III:
I = 1.25
R = 8 (SPECIAL CONCENTRIC BRACED FRAME); R = 5 (SPECIAL REINFORCED CONCRETE SHEARWALL)
SEISMIC DESIGN CATEGORY: E
REDUNDANCY FACTORS: SPECIAL CONCENTRIC BRACED FRAME φ = 1.3
SPECIAL REINFORCED CONCRETE SHEARWALL φ = 1.0
MAXIMUM STORY DRIFT: 1.5 INCHES

D. FOUNDATION

- 1. DESIGN OF BOTH STRUCTURES HAS BEEN BASED UPON THE GEOTECHNICAL INVESTIGATION AND SUPPLEMENTAL REPORT PERFORMED BY: TRC DATED JULY 17, 2008 (REPORT NO. 1620-46).
ALL CONSTRUCTION SHALL COMPLY WITH THE RECOMMENDATIONS OF THE SOIL REPORT. THE STRUCTURAL ENGINEER IS NOT RESPONSIBLE FOR ANY GEOTECHNICAL ASPECTS OF THIS PROJECT.
IT IS RECOMMENDED THAT SOIL ENGINEERS a) REVIEW THE FOUNDATION PLANS PRIOR TO CONSTRUCTION, AND b) OBSERVE THE INSTALLATION OF THE FOUNDATION.
ANY SLOPES SHALL BE CONSTRUCTED AT A MAXIMUM GRADE OF 2:1 (HORIZONTAL TO VERTICAL), FILL AND CUT SLOPES SHOULD BE VEGETATED AS SOON AS POSSIBLE TO MINIMIZE EROSION OF SOIL. SEE GEOTECHNICAL REPORT FOR ADDITIONAL INFORMATION. SEE CIVIL DWGS FOR BUILDING PAD SECTION.
ANY VERTICAL SOIL CUTS MUST BE PROVIDED WITH PROPER SHORING TO PROTECT THE WORKERS AND ADJACENT PROPERTY. THE CONTRACTOR SHALL BE SOLELY RESPONSIBLE FOR ALL EXCAVATION PROCEDURES INCLUDING LAGGING, SHORING AND THE PROTECTION OF ADJACENT PROPERTY, STRUCTURES, STREETS AND UTILITIES. ALL WORK AND CONSTRUCTION SHALL COMPLY WITH ALL APPLICABLE BUILDING CODES, CALIFORNIA OSHA REGULATIONS AND SAFETY REQUIREMENTS.

- 6. AN ADEQUATE DRAINAGE SYSTEM SHALL BE PROVIDED TO COLLECT AND TRANSPORT RUNOFF WATER TO THE DISCHARGE FACILITIES, ALL REMAINING WALLS SHALL HAVE AT THE BOTTOM, PERFORATED BACK-OF-WALL DRAINS AND WEEP HOLES AT 6" O.C. MAXIMUM.
7. ALL BUILDING PADS SHALL BE CONSTRUCTED IN ACCORDANCE WITH GEOTECHNICAL REPORTS REFERRED TO IN NOTE #1 ABOVE.
8. COMPACTION OF OVER EXCAVATION & FILL MATERIAL SHALL BE IN ACCORDANCE WITH THE GEOTECHNICAL REPORT REFERRED TO IN NOTE #1 ABOVE.
9. A) PASSIVE PRESSURES
ENGINEERED FILL ..... 3-80 psf/ft
NEGLECT THE UPPER 12 INCHES FOR DESIGN. UNLESS FOUNDATIONS ARE COMPAKED BY CONCRETE SLABS OR ASPHALT PAVEMENTS, FOR PIERS, APPLY VALUES OVER EFFECTIVE WIDTH OF TWO PIER DIAMETERS.
B) SOIL DESIGN CRITERIA USED FOR FOUNDATION DESIGN
SHALL BE AS FOLLOWS:

- FOUNDATIONS DESIGN PARAMETERS BUILDINGS WILL BE SUPPORTED ON A COMBINATION OF THE GEOTECHNICAL AND SPREAD FOOTINGS, AS RECOMMENDED IN THE GEOTECHNICAL INVESTIGATION. THE MINIMUM DEPTH OF FOOTINGS IS ANTICIPATED TO BE 18" BELOW THE LOWEST ADJACENT FINISHED GRADE TAKEN AS THE BOTTOM OF INTERIOR SLAB-ON-GRADE OR THE FINISHED EXTERIOR GRADE, WHICHEVER IS LOWER.
ALLOWABLE SOIL BEARING PRESSURES USED FOR PRELIMINARY DESIGN PURPOSES ARE AS FOLLOWS:
DEAD LOAD 3000 PSF
DEAD LOAD PLUS LIVE LOAD 4500 PSF
ALL LOADS, INCLUDING WIND OR SEISMIC LOADS 6000 PSF
THE SETTLEMENT HAS BEEN ESTIMATED AS FOLLOWS:
TOTAL SETTLEMENT 1"
DIFFERENTIAL SETTLEMENT 1/2"-3/4"
ALLOWABLE COEFFICIENT OF FRICTION = 0.30

E. REINFORCING STEEL

- 1. REINFORCING STEEL, DETAILING, FABRICATION, AND PLACEMENT SHALL CONFORM TO THE CALIFORNIA BUILDING CODE, CHAPTER 19A, "THE MANUAL OF STANDARD PRACTICE OF THE WESTERN CONCRETE REINFORCING STEEL INSTITUTE," LATEST EDITION, AND THE BUILDING CODE REQUIREMENTS FOR STRUCTURAL CONCRETE AND COMMENTARY", ACI 318-05, UNLESS NOTED OTHERWISE.

- 2. REINFORCING STEEL SHALL CONFORM TO THE FOLLOWING STANDARDS:
DEFORMED BARS, #3 ..... ASTM A615, GRADE 40
DEFORMED BARS, #4 AND LARGER ..... ASTM A615, GRADE 60
WELDED REINFORCEMENT, WHEN SPECIFIED ..... ASTM A706
WELDED WIRE FABRIC, W/WF (SMOOTH WIRE) ..... ASTM A185
SMOOTH WIRE, NOT IN W/WF ..... ASTM A187
DEFORMED WIRE FABRIC, D/WF (DEFORMED WIRE) ..... ASTM A496
DEFORMED WIRE, NOT IN W/WF ..... ASTM A496
SPRAL REINFORCEMENT SMOOTH ..... ASTM A615
SPRAL REINFORCEMENT DEFORMED ..... ASTM A615
EPOXY COATED REINFORCING, WHEN SPECIFIED ..... ASTM A775 and A615
BY ENGINEER

- 3. ALL BARS SHALL HAVE A MINIMUM "LAP SPLICE" OR "DEVELOPMENT LENGTH" PER APPROPRIATE TABLES ON S-001, U.O.N.
4. REINFORCING SPACING GIVEN ARE MAXIMUM ON CENTER AND ALL REINFORCING IS CONTINUOUS UNLESS OTHERWISE NOTED.
5. ALL REINFORCING STEEL SHALL BE SECURELY WIRED AND PROPERLY SUPPORTED ABOVE GROUND AND AWAY FROM THE FORM.
6. REINFORCING BAR FABRICATION LAPS AND PLACING SHALL CONFORM TO THE MANUAL OF STANDARD PRACTICE OF THE WESTERN CONCRETE REINFORCING STEEL INSTITUTE, UNLESS OTHERWISE NOTED ON DRAWINGS.
7. DOWN ALL VERTICAL REINFORCING IN WALLS AND COLUMNS FROM FOUNDATION WITH THE SAME SIZE REINFORCING. (U.O.N.)
8. SPLICES IN ADJACENT BARS SHALL BE NOT LESS THAN 2'-0" CLEAR DISTANCE.
9. SPLICE CONTINUOUS BARS IN SPANDRELS, GRADE BEAMS, WALL BEAMS, ETC. AS FOLLOWS:
TOP BARS AT MID-SPAN,
BOTTOM BARS AT CENTERLINE SUPPORT (U.O.N.)
DO NOT WELD STRUCTURAL REINFORCING STEEL UNLESS EXPLICITLY DIRECTED BY THE STRUCTURAL ENGINEER OF RECORD.

F. CONCRETE

- 1. THE MINIMUM 28 DAYS STRENGTH AND TYPE OF CONCRETE SHALL BE AS FOLLOWS:
A) SLABS ON GRADE ..... 150 PCF Fc=4000 PSI
B) FOUNDATIONS & GRADE BEAMS ..... 150 PCF Fc=4000 PSI
C) COLUMNS & RETAINING WALLS ..... 150 PCF Fc=4000 PSI
D) LIGHTWEIGHT CONCRETE TOPPING SLABS ..... 110 PCF Fc=3500 PSI
2. DIMENSIONS SHOWN FOR LOCATION OF REINFORCING ARE TO THE FACE OF MAIN BARS, TIES, ETC., AND DENOTE CLEAR COVERAGE. CONCRETE COVER SHALL BE AS FOLLOWS, U.O.N. ON DRAWINGS:
A) CONCRETE CAST AGAINST AND PERMANENTLY EXPOSED TO EARTH ..... 3"
B) CONCRETE EXPOSED TO EARTH OR WEATHER BUT PLACED IN FORMS:
#6 THROUGH #18 BARS ..... 2"
#5 BARS, W31 OR D31 WIRE, AND SMALLER ..... 1 1/2"
C) CONCRETE NOT EXPOSED TO WEATHER OR IN CONTACT WITH GROUND:
SLABS, WALLS OR JOISTS:
#14 OR #18 BARS ..... 1 1/2"
#11 BARS AND SMALLER ..... 3/4"
BEAMS AND COLUMNS:
PRIMARY REINFORCEMENT STRIPS, HOOPS, TIES, SPIRALS, .... 1 1/2"
SHELLS AND FOLDED PLATE MEMBERS:
#6 AND LARGER BARS ..... 3/4"
#6 BARS, W31 OR D31 WIRE, AND SMALLER ..... 1/2"
D) BARS, W31 OR D31 WIRE, AND SMALLER ..... 1/2"
3. NO PIPES OR DUCTS SHALL BE PLACED IN CONCRETE SLABS OR WALLS UNLESS SPECIFICALLY DETAILED.
4. REFER TO ARCHITECTURAL, STRUCTURAL, ELECTRICAL AND MECHANICAL DRAWINGS FOR ALL MOLD, GROOVES, ORNAMENTS, CLIPS AND GROUNDS TO BE CAST IN CONCRETE.
5. FORMS SHALL BE PROPERLY CONSTRUCTED CONFORMING TO CONCRETE SURFACE AS SHOWN ON THE DRAWINGS, SUFFICIENTLY TIGHT TO PREVENT LEAKAGE, SUFFICIENTLY STRONG AND BRACED TO MAINTAIN THEIR SHAPE AND ALIGNMENT UNTIL NO LONGER NEEDED TO SUPPORT THE CONCRETE.
6. HORIZONTAL CONSTRUCTION JOINTS SHALL BE LOCATED AS SHOWN ON THE DRAWINGS AND SHALL BE PROPERLY PREPARED AND FINISHED TO EXPOSE FINISH TO SANDBLASTING OR OTHER APPROVED MEANS TO EXPOSE FINISH TO EMBEDDED AGGREGATES PRIOR TO POURING ADDITIONAL CONCRETE IN CONTACT WITH THESE SURFACES. VERTICAL CONSTRUCTION JOINTS CONFORM TO ALL PLANS AND DETAILS.

- 7. FORMS AND SHORING SHALL NOT BE REMOVED UNTIL THE CONCRETE HAS ATTAINED SUFFICIENT STRENGTH TO WITHSTAND ALL LOADS TO BE IMPOSED WITHOUT EXCESSIVE STRESS, CREEP OR DEFLECTION.
8. ALL ITEMS TO BE CAST IN CONCRETE SUCH AS REINFORCING, DOWELS, BOLTS, ANCHORS, PIPES, SLEEVES, ETC. SHALL BE SECURELY POSITIONED IN THE FORMS BEFORE PLACING THE CONCRETE.
9. SEE ARCHITECTURAL, ELECTRICAL, AND MECHANICAL DRAWINGS FOR SIZE AND LOCATION OF PIPES, SLEEVES, PITS AND DETAILS NOT SHOWN ON THESE STRUCTURAL DRAWINGS. ALL DIMENSIONS ARE TO BE CHECKED AND VERIFIED WITH THE ARCHITECTURAL, ELECTRICAL, AND MECHANICAL DRAWINGS.
10. MINIMUM EMBEDMENT FOR ANCHOR BOLTS IN CONCRETE SHALL BE 8" U.O.N.
11. THE CONTRACTOR SHALL INFORM THE ARCHITECT/ENGINEER AT LEAST 2 DAYS PRIOR TO POURING ANY STRUCTURAL CONCRETE SO THAT HE MAY HAVE THE OPPORTUNITY OF REVIEWING THE WORK PRIOR TO PLACEMENT.
12. BARS SHALL CLEAN OF RUST, GREASE OR OTHER MATERIALS LIKELY TO IMPAIR BOND.
13. ALL REINFORCING BAR BENDS SHALL BE MADE AS INDICATED ON THE DRAWINGS. MINIMUM REINFORCING BAR SPLICES SHALL BE MADE AS INDICATED ON THE DRAWINGS. MINIMUM SPLICE LENGTH FOR REINFORCING STEEL BARS IN MASONRY SHALL BE 48 BAR DIAMETERS, 24" MIN. MINIMUM SPLICE LENGTH FOR REINFORCING STEEL BARS IN CONCRETE SHALL BE AS PER APPLICABLE TABLES ON THIS SHEET. LAP ALL HORIZONTAL BARS AT CORNERS AND INTERSECTIONS. STAGGER ALL SPLICES. U.O.N. ON PLANS.
14. ALL BARS SHALL BE MARKED SO THEIR IDENTIFICATION CAN BE MADE WHEN THE FINAL IN-PLACE INSPECTION IS MADE.

- 15. WHERE WELDING OF REINFORCING IS APPROVED BY THE STRUCTURAL ENGINEER, IT SHALL BE DONE BY AWS CERTIFIED WELDERS USING E60XX OR APPROVED ELECTRODES. WELDING PROCEDURES SHALL CONFORM TO THE REQUIREMENTS OF STRUCTURAL WELDING CODE REINFORCING STEEL, AWS-D1.4, LATEST REVISION. REINFORCING BARS TO BE WELDED SHALL CONFORM TO THE REQUIREMENTS OF ASTM A706.
16. ALL CONSTRUCTION JOINTS SHALL BE CONSTRUCTED IN ACCORDANCE WITH CODE SECTION 1906.4 AND THE TYPICAL CONSTRUCTION JOINT DETAILS SHOWN ON THE STRUCTURAL DRAWINGS.
17. ALL SURFACES OF CONSTRUCTION JOINTS SHALL BE CLEANED TO REMOVE DUSTS, CHIPS, OR OTHER FOREIGN MATTER PRIOR TO PLACING THE ADJACENT CONCRETE. SURFACE SHALL BE ROUGHENED BY EXPOSING CLEAN AGGREGATE SOLIDLY EMBEDDED IN MORTAR MATRIX.
18. THE CONTRACTOR SHALL SUBMIT THE PROPOSED LOCATIONS OF THE CONSTRUCTION JOINTS TO THE ENGINEER FOR APPROVAL BY THE STRUCTURAL ENGINEER BEFORE STARTING CONSTRUCTION.
19. THE WATER / CEMENT RATIO FOR SLAB-ON-GRADE SHALL NOT EXCEED 0.45.

WRNS STUDIO logo and address: 501 SECOND STREET, 4TH FLOOR, STE. 402, SAN FRANCISCO, CALIFORNIA 94107

Steinberg Architects logo and address: 1435 CALIFORNIA STREET, SAN FRANCISCO, CALIFORNIA 94109

Hensel Phelps Construction Co. logo and address: 2200 MARKET STREET, SAN FRANCISCO, CALIFORNIA 94114

PROJECT RECORD SET logo and title: SKYLINE COLLEGE CIP2 DESIGN-BUILD PROJECT BUILDING 4

GENERAL STRUCTURAL NOTES logo and title: SKYLINE COLLEGE CIP2 DESIGN-BUILD PROJECT BUILDING 4

**PROJECT RECORD SET**

**SKYLINE COLLEGE**  
SAN MATEO COUNTY  
COMMUNITY COLLEGE  
DISTRICT

**CIP2 DESIGN-BUILD PROJECT BUILDING 4**

**GENERAL STRUCTURAL NOTES**

PROJECT NO.: 00712-00 DRAWN BY: AV  
DATE: 02/08/09 CHECKED BY: CB  
SCALE: AS NOTED

SHEET TITLE:

**S-002**

- I. HEADED STUDS**
- MATERIAL: AUTOMATIC END WELDED STUDS SHALL BE NELSON GRANULAR FLUXELLED SHEAR CONNECTOR OR ANCHOR STUDS (OR APPROVED EQUAL). STUDS SHALL BE MANUFACTURED OF C-1015 COLD ROLLED STEEL WHICH CONFORM TO ASTM SPECIFICATIONS A-108-58-1.
  - INSTALLATION: THE STUDS SHALL BE AUTOMATICALLY END WELDED IN ACCORDANCE WITH THE MANUFACTURER'S RECOMMENDATIONS IN SUCH A MANNER AS TO PROVIDE COMPLETE FUSION BETWEEN THE END OF THE STUD AND THE PLATE. THERE SHOULD BE NO POROSITY OR EVIDENCE OF LACK OF FUSION BETWEEN THE WELDED END OF THE STUD AND THE PLATE. THE STUD SHALL DECREASE IN LENGTH DURING END OF APPROXIMATELY 1/8" FOR 3/8" INCH AND UNDER, AND 3/16" FOR OVER 3/8" DIAMETER. WELDING SHALL BE DONE ONLY BY QUALIFIED WELDERS APPROVED BY THE WELDING INSPECTOR.
  - INSPECTION AND TESTS: INSPECTION, IN ACCORDANCE WITH TITLE 24, SECTION 170A.3, OF ALL THE SHOP AND FIELD WELDING OPERATIONS FOR THE AUTOMATIC END WELDED STUDS SHALL BE MADE BY A QUALIFIED WELDING INSPECTOR (APPROVED BY THE OFFICE OF THE STATE ARCHITECT). THE TYPE AND CAPACITY OF THE WELDING EQUIPMENT SHALL BE IN ACCORDANCE WITH THE MANUFACTURER'S RECOMMENDATIONS AND SHALL BE CHECKED AND APPROVED BY A WELDING INSPECTOR. AT THE BEGINNING OF EACH DAY'S WORK, A MINIMUM OF TWO TEST STUD WELDS SHALL BE MADE WITH THE EQUIPMENT TO BE USED TO METAL WHICH IS THE SAME AS THE ACTUAL WORK PIECE. THE TEST STUDS SHALL BE SUBJECTED TO A 90% BEND TEST BY STRIKING THEM WITH A HEAVY HAMMER. AFTER THE ABOVE TEST, THE WELD SECTION SHALL NOT EXHIBIT ANY TEARING OUT OR CRACKING. TESTING OF END WELDED STUDS SHALL BE IN ACCORDANCE WITH SECTION 170A.3 PART 2, TITLE 24. PER AWS D1.1, STUDS SHALL BE BENT 300° FROM PERPENDICULAR. STUDS MAY BE LEFT IN PLACE AFTER TESTING.
  - STEEL SHEAR STUDS MATERIAL WELDING AND INSPECTION SHALL BE IN ACCORDANCE WITH AWS STRUCTURAL WELDING CODE, AWS D1.1-98 SECTION 7. ALL STUDS SHALL BE 3/4" DIAMETER, SPACED AT 12" o.c. MAXIMUM, U.O.N. THE LENGTH SHALL BE AS INDICATED IN DETAIL 14/5-103.

**M. CURTAIN WALL DESIGN WINDOW SYSTEM**

- CURTAIN WALL DESIGN/BUILD SYSTEM
- DEFERRED APPROVAL - SEE INCREMENT 3.

- H. METAL DECKING**
- UNLESS OTHERWISE NOTED ON THE DRAWINGS DECKING SHALL BE AS MANUFACTURED BY VERCO MANUFACTURING INC. OR EQUAL AS APPROVED BY THE ENGINEER FOR METAL.
  - THE MINIMUM BASE THICKNESS OF METAL MATERIAL SHALL BE AS NOTED ON PLANS.
  - FINISH DECKING IN MINIMUM LENGTHS OF THREE SPANS EXCEPT WHERE SINGLE OR DOUBLE SPANS ARE INDICATED ON THE DRAWINGS.
  - STRUCTURAL PROPERTIES SHALL BE EQUAL TO THOSE OF THE DECKING TYPES INDICATED ON THE DRAWINGS AS APPROVED BY ICBO.
  - FURNISH ALL ACCESSORIES REQUIRED TO PROVIDE A COMPLETE INSTALLATION INCLUDING FILTERS FOR END PANELS, FRITTON CAPS FOR CLOSING SHOP FABRICATED ACCESS HOLES FOR WELDING, FLASHING AT COLUMNS AND CLOSURES FOR CELL ENDS, ROOF AND FLOOR DRAIN REGRESSES, AND OTHER ACCESSORIES AS REQUIRED. ACCESSORIES SHALL BE FORMED FROM GALVANIZED STANDARD COMMERCIAL GRADE STEEL OR BETTER.
  - WELDING MATERIALS: PER AWS D1.3 - SPECIFICATIONS FOR WELDING SHEET STEEL IN STRUCTURES.
  - SHEAR STUDS, INCLUDING INSTALLATION EQUIPMENT SHALL BE AS MANUFACTURED BY NELSON STUD WELDING DIVISION, GREGORY INDUSTRIES, LORAIN, OHIO. TYPES S3L OR H4L, OR EQUAL, AND SHALL CONFORM TO AWS D1.1 (LATEST EDITION). PERILLS SHALL BE SUITABLE FOR USE WITH GALVANIZED METAL DECK WHERE INDICATED.
  - WHERE LARGE PREDETERMINED OPENINGS FOR DUCTS AND SIMILAR ELEMENTS PASSING THROUGH THE PANEL UNITS OCCUR, FURNISH PREPARED UNITS TO FIT JOB CONDITIONS. WHERE OTHER HOLES OR OPENING ARE REQUIRED IN DECKING AFTER ERECTION, SUCH HOLES SHALL BE REINFORCED PER THE DRAWINGS.
  - PROVIDE ALL CLOSURES, END PLATES, PROFILE PLATES AND OTHER ACCESSORIES REQUIRED FOR A COMPLETE INSTALLATION, WELD IN PLACE.
  - SUPPORT AT COLUMNS: WHERE DUE TO CUTTING OF DECK UNITS AT COLUMNS, BEARING SUPPORT IS NOT PROVIDED FOR THE END OF A WEB, SUCH WEB SHALL BE WELDED TO THE COLUMN OR STRUCTURAL STEEL MATERIAL AT THE COLUMN OR EQUIVALENT SUPPORT SHALL BE PROVIDED. THE WELDING OR EQUIVALENT SUPPORT SHALL BE SUFFICIENT FOR THE SUPPORT OF THE DECK, CONSTRUCTION LOADS. PROVIDE 1.3x3x1/4 MINIMUM WITH A 3/16" CONTINUOUS FILLET WELD FOR SUPPORT AT SUCH LOCATIONS, AND SUBJECTED TO THE S.E.O.R. APPROVAL.
  - SUBMIT SHOP DRAWINGS FOR THE FABRICATION AND ERECTION OF ALL ASSEMBLIES IN ACCORDANCE WITH THE SPECIFICATIONS.
  - NO WORK OF FABRICATION SHALL BE COMMENCED OR MATERIAL DELIVERED TO THE JOB UNTIL THE ENGINEER HAS REVIEWED AND APPROVED THE SHOP DRAWINGS.
  - ALL CONCRETE AND METAL DECK ASSEMBLES SHALL BE REINFORCED WITH A MINIMUM OF WELDED WIRE FABRIC 6x6 W2.9 x W2.9, U.O.N.
  - SEE ROOF FRAMING PLANS & DETAILS FOR EXTENT OF DECK TYPES.
  - DECK SIDE SEAMS SHALL BE CRIMPED TOGETHER AT WELD POINTS BEFORE MAKING TOP OR SIDE SEAM WELDS.
  - WELDS AT DECK LAPS SHALL BE MADE THROUGH BOTH SHEETS TO STRUCTURAL STEEL.
  - SEE TYPICAL DETAIL S SHEETS FOR REINFORCEMENT REQUIRED FOR OPENINGS IN THE DECK SEE ARCHITECTURAL, MECHANICAL AND ELECTRICAL DRAWINGS FOR MAJOR OPENING SIZES AND LOCATIONS. OTHER SMALLER OPENINGS ARE NOT SHOWN AND ARE SUBJECT TO REVIEW AND APPROVAL BY THE STATE REPRESENTATIVE.
  - NEW DECK SHALL BE WELDED TO ALL ROOF BEAMS, ANGLES, ETC. PER 9/8-103.
  - DECK DIMENSIONS AT MECHANICAL EQUIP. AND SHAFT OPENINGS ARE TO BE PROVIDED BY THE MECHANICAL SUBCONTRACTOR COORDINATION WITH THE DECK SUBCONTRACTOR. RESPONSIBILITY OF THE GENERAL CONTRACTOR.
  - ALL DECKS WITH CONCRETE FILL SHALL BE VENTED.
  - ALL METAL DECKING SHALL BEAR A MINIMUM OF 2" ON ALL STRUCTURAL STEEL SUPPORT MEMBERS.
- I. CONSTRUCTION JOINTS**
- ALL CONSTRUCTION JOINTS SHALL BE CONSTRUCTED IN ACCORDANCE W/ CBC SECTION 1906A.4 AND THE TYPICAL CONSTRUCTION JOINT DETAILS SHOWN ON THE STRUCTURAL.
  - ALL SURFACES OF CONSTRUCTION JOINTS SHALL BE CLEANED TO REMOVE DUST, CHIPS, OR OTHER FOREIGN MATTER PRIOR TO PLACING THE ADJACENT CONCRETE. THE SURFACES SHALL BE ROUGHENED BY EXPOSING CLEAN AGGREGATE SOLIDLY EMBEDDED IN MORTAR MATRIX. THE CONTRACTOR SHALL SUBMIT THE PROPOSED LOCATIONS OF CONSTRUCTION JOINTS TO THE ENGINEER FOR APPROVAL BY THE STRUCTURAL ENGINEER BEFORE STARTING CONSTRUCTION.

**J. STATEMENT OF SPECIAL INSPECTION**















- SPECIAL INSPECTION IN CONFORMANCE W/ CHAPTER 17A OF THE 2007 CBC IS REQUIRED AND SHALL BE PROVIDED FOR THE FOLLOWING WORK UNDER SUPERVISION OF AN OUTSIDE SPECIAL INSPECTION TESTING AGENCY EMPLOYED BY THE OWNER. SEE PROJECT SPECIFICATIONS FOR REQUIREMENTS IN ADDITION TO THOSE LISTED BELOW:
    - DURING THE TAKING OF TEST SPECIMENS AND PLACING OF STRUCTURAL CONCRETE WITH AN FC GREATER THAN 2500 PSI.
    - ALL STRUCTURAL STEEL WELDING.
    - REINFORCING STEEL (WHERE FC GREATER THEN 2500 PSI) OR REINFORCEMENT IS WELDED.
    - WELDED REINFORCING BARS: CBC SECTION 1903A.4 & ACI 318
    - USE OF STRUCTURAL EPOXIES
    - USE OF A325 OR A325-S.C., A490-SC BOLTS
    - USE OF A325 OR A325-S.C., A490-SC BOLTS
    - BOLTS EMBEDDED IN CONCRETE OR MASONRY
    - SOIL COMPACTION REQUIREMENTS
    - ADHESIVE AND DRILLED-IN EXPANSION ANCHORS
    - ERCO TYPE "S4" REINFORCING AND COUPLERS. SEE 65-601. TEST 10% OF EACH TYPE TO THE REQUIREMENTS OF A TYPE 2 CONNECTION PER ACI
- THE SPECIAL INSPECTION REQUIREMENTS FOR THE SEISMIC-FORCE-RESISTING SYSTEM SHALL BE PER THE CBC 2007 AND ARE LISTED IN THE TABLE BELOW:




TASK	DESCRIPTION	INSPECTION FREQUENCY	CODE REFERENCE
STRUCTURAL STEEL WELDING	• SINGLE-PASS FILET NOT EXCEEDING 1/8" IN SIZE	PERIODIC	CBC 2007 TABLE 170A.3 & AWS D1.1 & MSC 341
	• ROOF AND DECK WELDING		CBC 2007 TABLE 170A.3 & AWS D1.3
	• ALL OTHER WELDING	CONTINUOUS	CBC 2007 TABLE 170A.3 & AWS D1.1 & MSC 341

**G. STRUCTURAL STEEL**

- ALL FABRICATION AND ERECTION SHALL CONFORM TO THE AISC SPECIFICATIONS AND AMERICAN IRON AND STEEL SPECIFICATION MANUAL (LATEST EDITION). THE DESIGN AND ERECTION SHALL CONFORM TO THE AISC SPECIFICATIONS AND THE CALIFORNIA AND THE SEISMIC DESIGN REQUIREMENTS AS SPECIFIED IN THE CALIFORNIA BUILDING CODE. WELDING SHALL CONFORM TO THE AISC SPECIFICATIONS.
- WORKMANSHIP SHALL BE IN ACCORDANCE WITH THE BEST PRACTICE AND WITHIN THE TOLERANCES SPECIFIED IN THE AISC SPECIFICATIONS FOR STRUCTURAL STEEL. IT IS SPECIFICALLY NOTED THAT BURNED HOLES ARE NOT ACCEPTABLE UNLESS SPECIAL PERMISSION IS GIVEN BY ENGINEER.
- ALL SHOP FABRICATED WORK SHALL BE DONE IN A SHOP APPROVED BY THE INSPECTION AGENCY. FABRICATOR SHALL SUBMIT PROGRAM OF WELDING INSPECTION TO ENGINEER FOR APPROVAL.
- ALL STRUCTURAL STEEL SHALL BE AS FOLLOWS: UNO:
  - ALL WF - SHAPES: A992 GRADE 50
  - CONNECTION PL & MSC STEEL (UNO): ASTM A36
  - GUSSET & COLLECTOR PLATES: ASTM A572 GRADE 50
  - STRUCTURAL TUBING: ASTM A500 GRADE B.
  - ANGLE, CHANNELS: ASTM A36
- ALL HIGH STRENGTH BOLTS SHALL BE ASTM A325-N TYPE UNLESS OTHERWISE NOTED.
- ALL BOLTS USED FOR ERECTION SHALL BE ASTM A325 TYPE WITH THREADS EXCLUDED FROM SHEAR PLANES.
- ALL PLAIN ANCHORS SHALL BE A36. ALL ANCHOR BOLTS SHALL COMPLY WITH ASTM F1554 GRADE 10S. MINIMUM CONCRETE COVER WILL BE FLEDED AROUND ALL ANCHOR BOLTS EXPOSED TO THE WEATHER, U.A.O.
- WELDING MATERIALS: PER AWS D1.1, TYPE REQUIRED FOR MATERIALS BEING WELDED.
- PROVIDE CONTINUOUS INSPECTION FOR ALL FABRICATION AND WELDING OF STRUCTURAL STEEL IN ACCORDANCE WITH CODE REQUIREMENTS. ALL COMPLETE PENETRATION GROOVE WELDS IN JOINTS AND SPICES SHALL BE TESTED 100 PERCENT IN ACCORDANCE WITH CBC. USE ONE OF THE APPROVED METHODS OF TIGHTENING HIGH STRENGTH BOLTS.
- A WELDING SEQUENCE SHALL BE PLANNED TO MINIMIZE RESIDUAL STRESSES AND DISTORTIONS OF INDIVIDUAL MEMBERS AND THE BUILDING FRAME. ALL DETAILING, FABRICATION, AND ERECTION SHALL COMPLY WITH AISC, LATEST EDITION.
- UNLESS OTHERWISE NOTED, ALL STIFFENER PLATES ARE 3/8" THICK MINIMUM AND ALL BUTT WELDS ARE FULL PENETRATION WELDS. ERECTION CLIPS, TEMPORARY BRACING, ETC., REQUIRED BY THE CONTRACTOR ARE NOT SHOWN.
- SUBMIT SHOP DRAWINGS FOR THE FABRICATION AND ERECTION OF ALL ASSEMBLES OF STRUCTURAL STEEL WORK. INCLUDE PLANS AND ELEVATIONS AT NOT LESS THAN 1" TO 1/4" SCALE, AND INCLUDE DETAILS OF SECTIONS AT NOT LESS THAN 3" TO 1/4" SCALE.
- NO FINISH FABRICATION SHALL BE COMMENCED OR MATERIAL DELIVERED TO THE JOB UNTIL THE ENGINEER HAS REVIEWED AND APPROVED THE SHOP DRAWINGS.
- ALL STRUCTURAL STEEL SHALL BE PAINTED WITH ONE SHOP COAT OF ZINC CHROMATE PRIMER OR EQUAL. AFTER ERECTION, FIELD CONNECTIONS SHALL BE TOUCHED UP. DO NOT PAINT PORTION OF STEEL TO BE EMBEDDED IN CONCRETE. HEADED ANCHOR STUDS OR AREAS TO RECEIVE FIRE PROOFING.
- WELD LENGTHS CALLED FOR ON PLANS ARE THE NET EFFECTIVE LENGTH REQUIRED. WHERE FILLET WELD SYMBOL IS GIVEN WITHOUT INDICATION OF SIZE, USE MINIMUM SIZE WELDS AS SPECIFIED IN AISC MANUAL OF STEEL CONSTRUCTION LATEST EDITION.
- THE USE OF E701-4 WELDING WIRE IS NOT ALLOWED FOR ANY APPLICATION.
- WRITTEN WELDING PROCEDURE SPECIFICATIONS (WPS) PER THE RECOMMENDATIONS OF THE AMERICAN WELDING SOCIETY (AWS) SHALL BE DEVELOPED BY THE FABRICATOR BEFORE AND SUBMITTED FOR REVIEW BY THE ENGINEER. THE WPS SHALL BE APPROVED BY THE ENGINEER. THE WELDING PROCEDURES SHALL INCLUDE ALL THE WELDED JOINTS AND CONFIGURATIONS TO BE USED ON THIS PROJECT. ONLY WPS WHICH ARE RELEVANT TO THIS PROJECT SHALL BE SUBMITTED. ALL WELDED JOINTS SHALL BE PRE-QUALIFIED PER AWS OR BE QUALIFIED BY TEST PER AWS. A PROCEDURE QUALIFICATION RECORD (PQR) SHALL BE INCLUDED WITH THE WPS IF THE WELDING PROCEDURE OR JOINT IS QUALIFIED BY TESTING. THE ELECTRODE MANUFACTURER AND PRODUCT TRADE NAME SHALL BE IDENTIFIED IN THE WPS IN ADDITION TO THE AWS ELECTRODE CLASSIFICATION NAME. A COPY OF THE ELECTRODE MANUFACTURER'S TECHNICAL DATA SHEETS WITH THE RECOMMENDED WELDING PARAMETERS SHALL BE SUBMITTED WITH THE WPS.
- DO NOT WELD ANY STRUCTURAL STEEL MEMBER OR CONNECTION UNLESS EXPLICITLY CALLED OUT IN THE CONTRACT DOCUMENTS.
- WELD SYMBOLS SHOW FINAL WELD REQUIRED. THE CHOICE TO WELD IN THE FIELD OR IN THE SHOP SHALL BE UP TO THE CONTRACTOR AND SHALL BE INDICATED IN THE FABRICATOR'S SHOP DRAWINGS.
- FOR ALL CJP & PJP WELDS AT LATERAL FORCE RESISTING ELEMENTS PROVIDE C/VN TOUGHNESS OF 20 FT. LB @ -20°F AND 40 FT. LB @ 70°F. FOR ALL FILLET WELDS PROVIDE C/VN TOUGHNESS OF 20 FT. LB @ 20°F.
- HOT ROLLED SHAPES WITH FLANGES 1 1/2 INCHES THICK AND THICKER SHALL PROVIDE A MINIMUM C/VN TOUGHNESS OF 20 FT. LB @ 70°F.
- THE LATER FORCE RESISTING ELEMENTS AS DEFINED IN NOTE 21 ABOVE SHALL INCLUDE A BRACED FRAME BEAMS, COLUMNS AND CONNECTION PLATES AS SHOWN ON SHEET S501 - S503 AND ALL COLLECTOR BEAMS AND THEIR ATTACHMENTS.



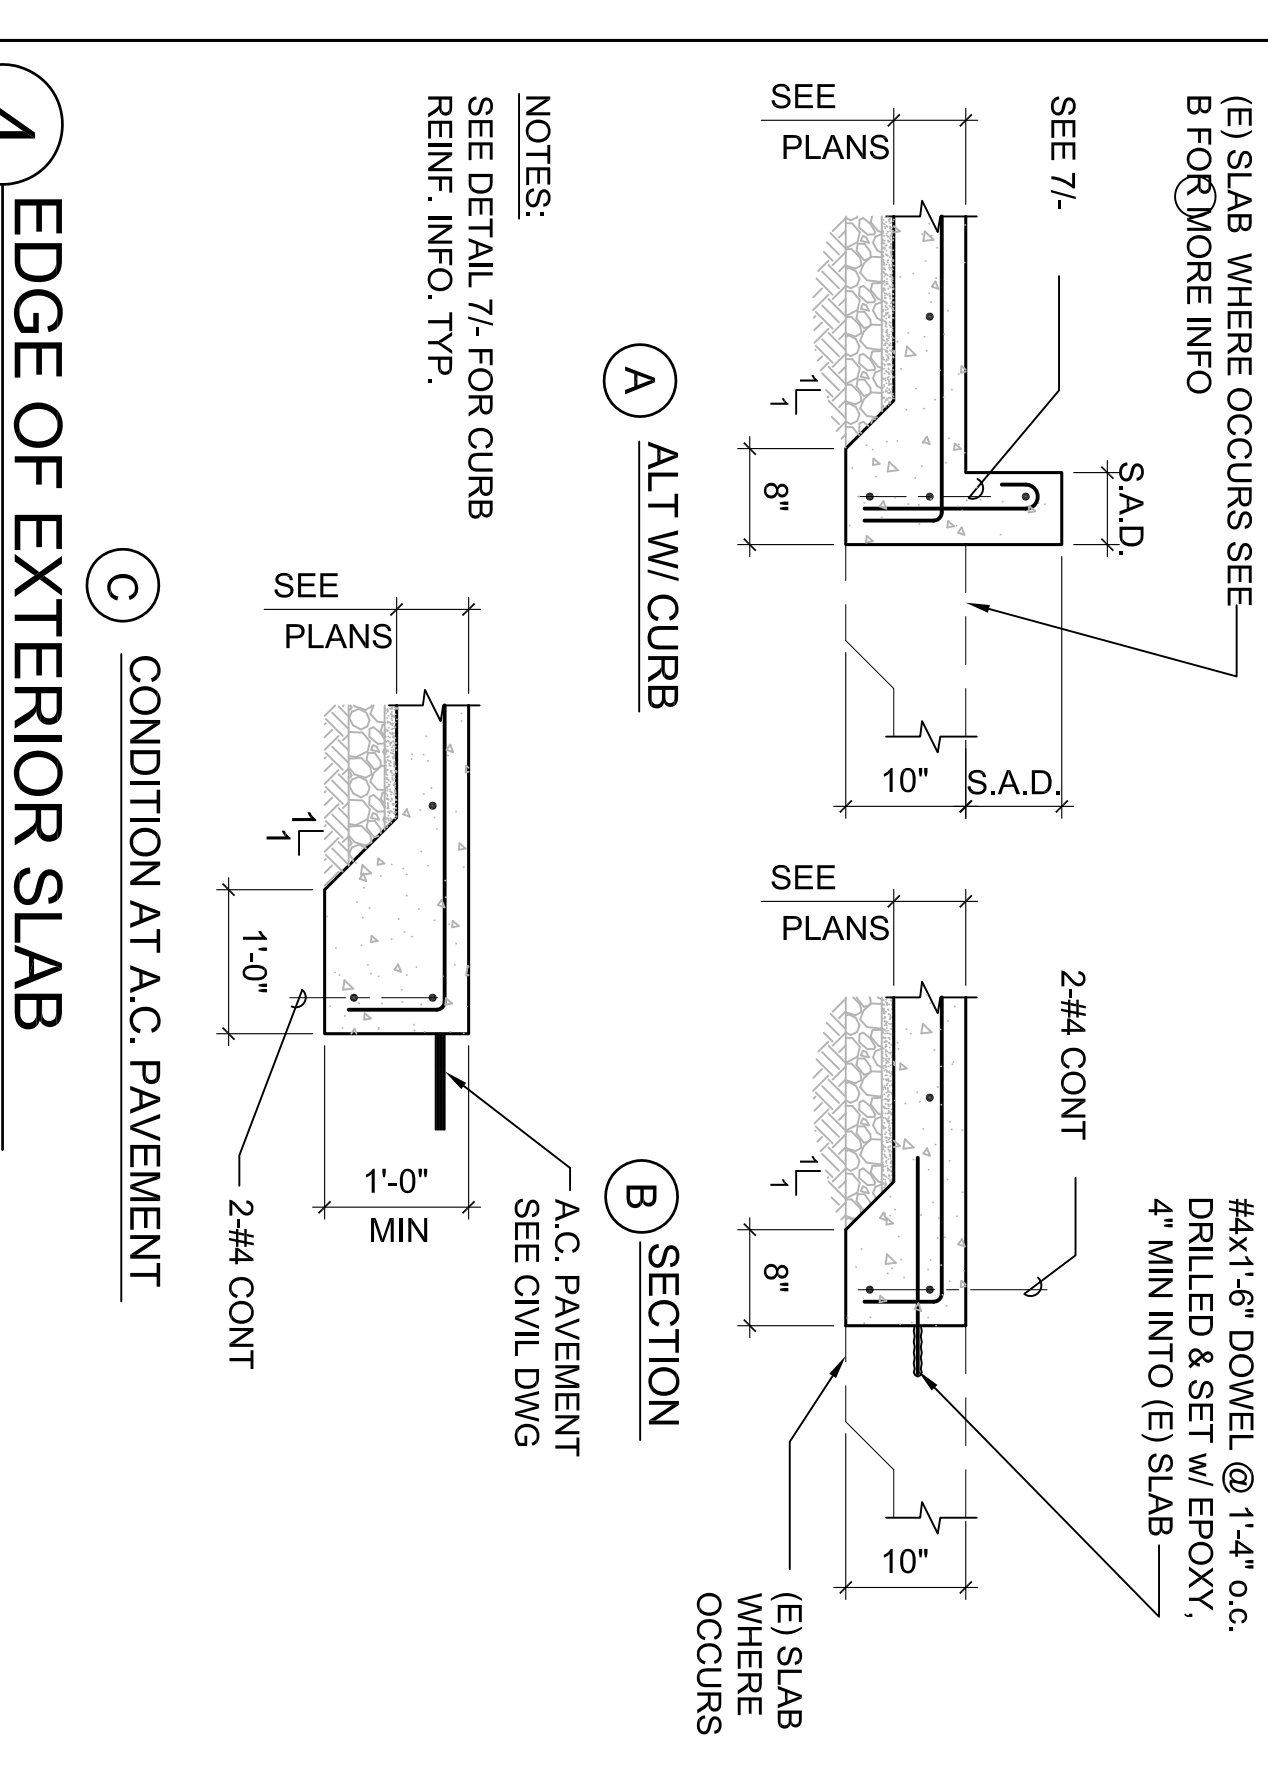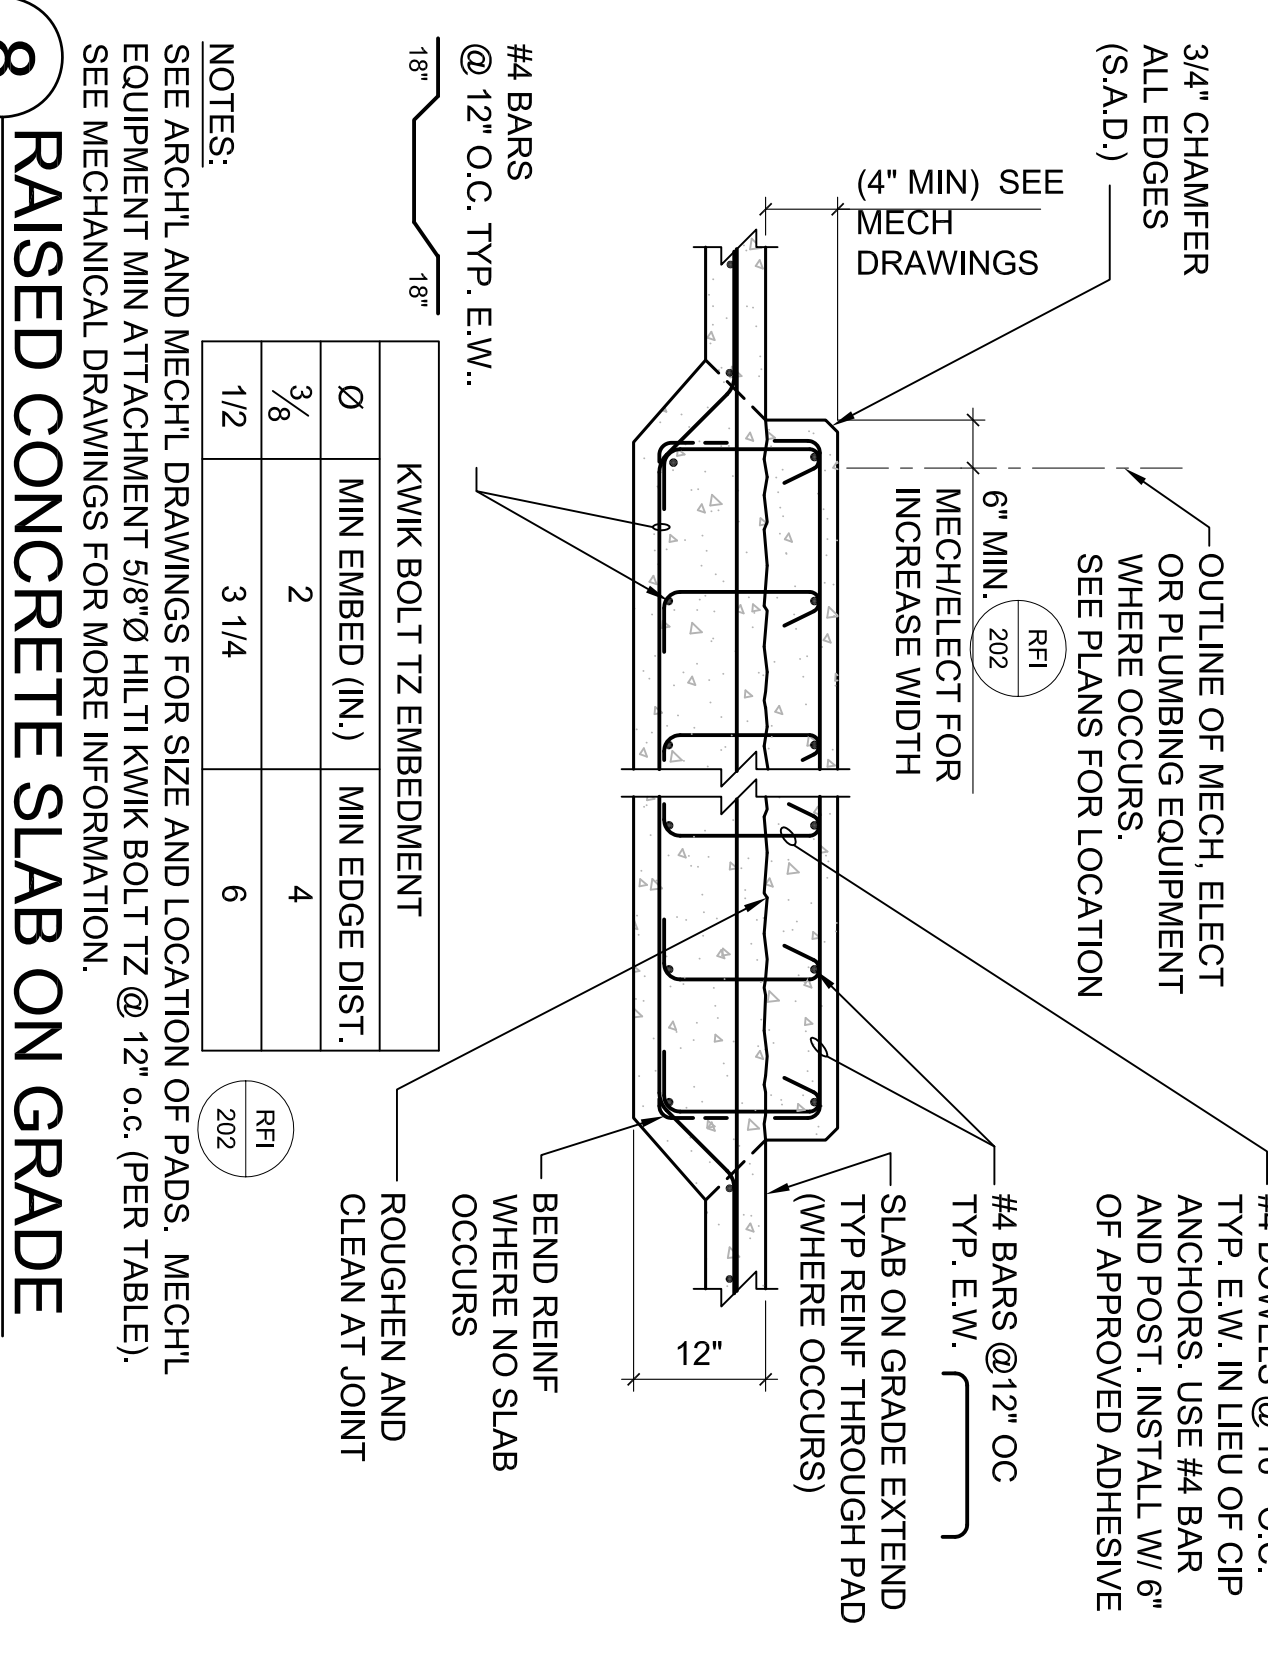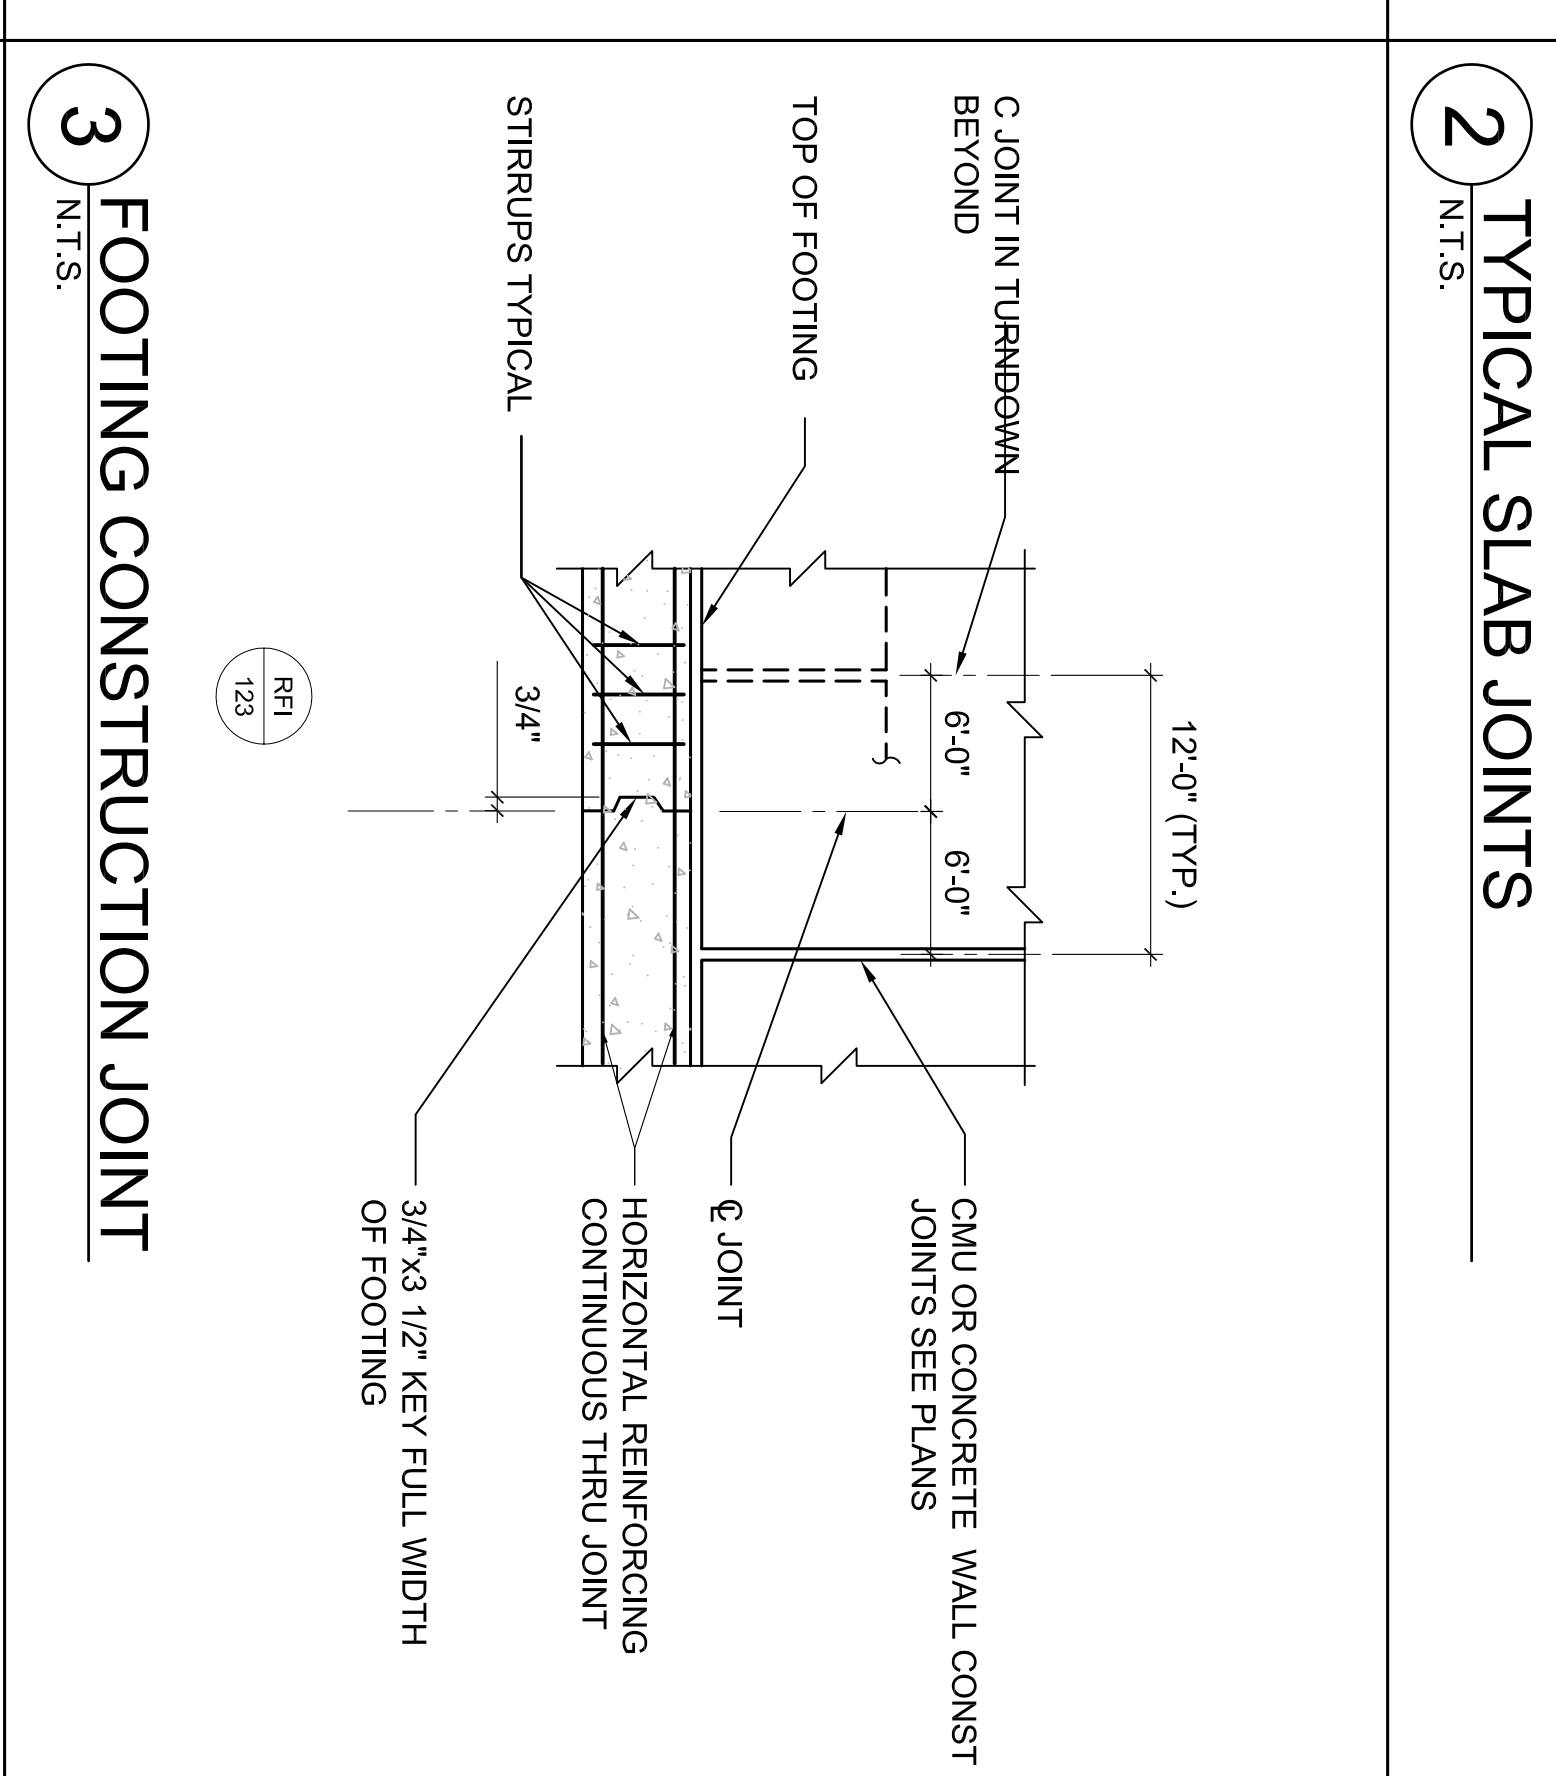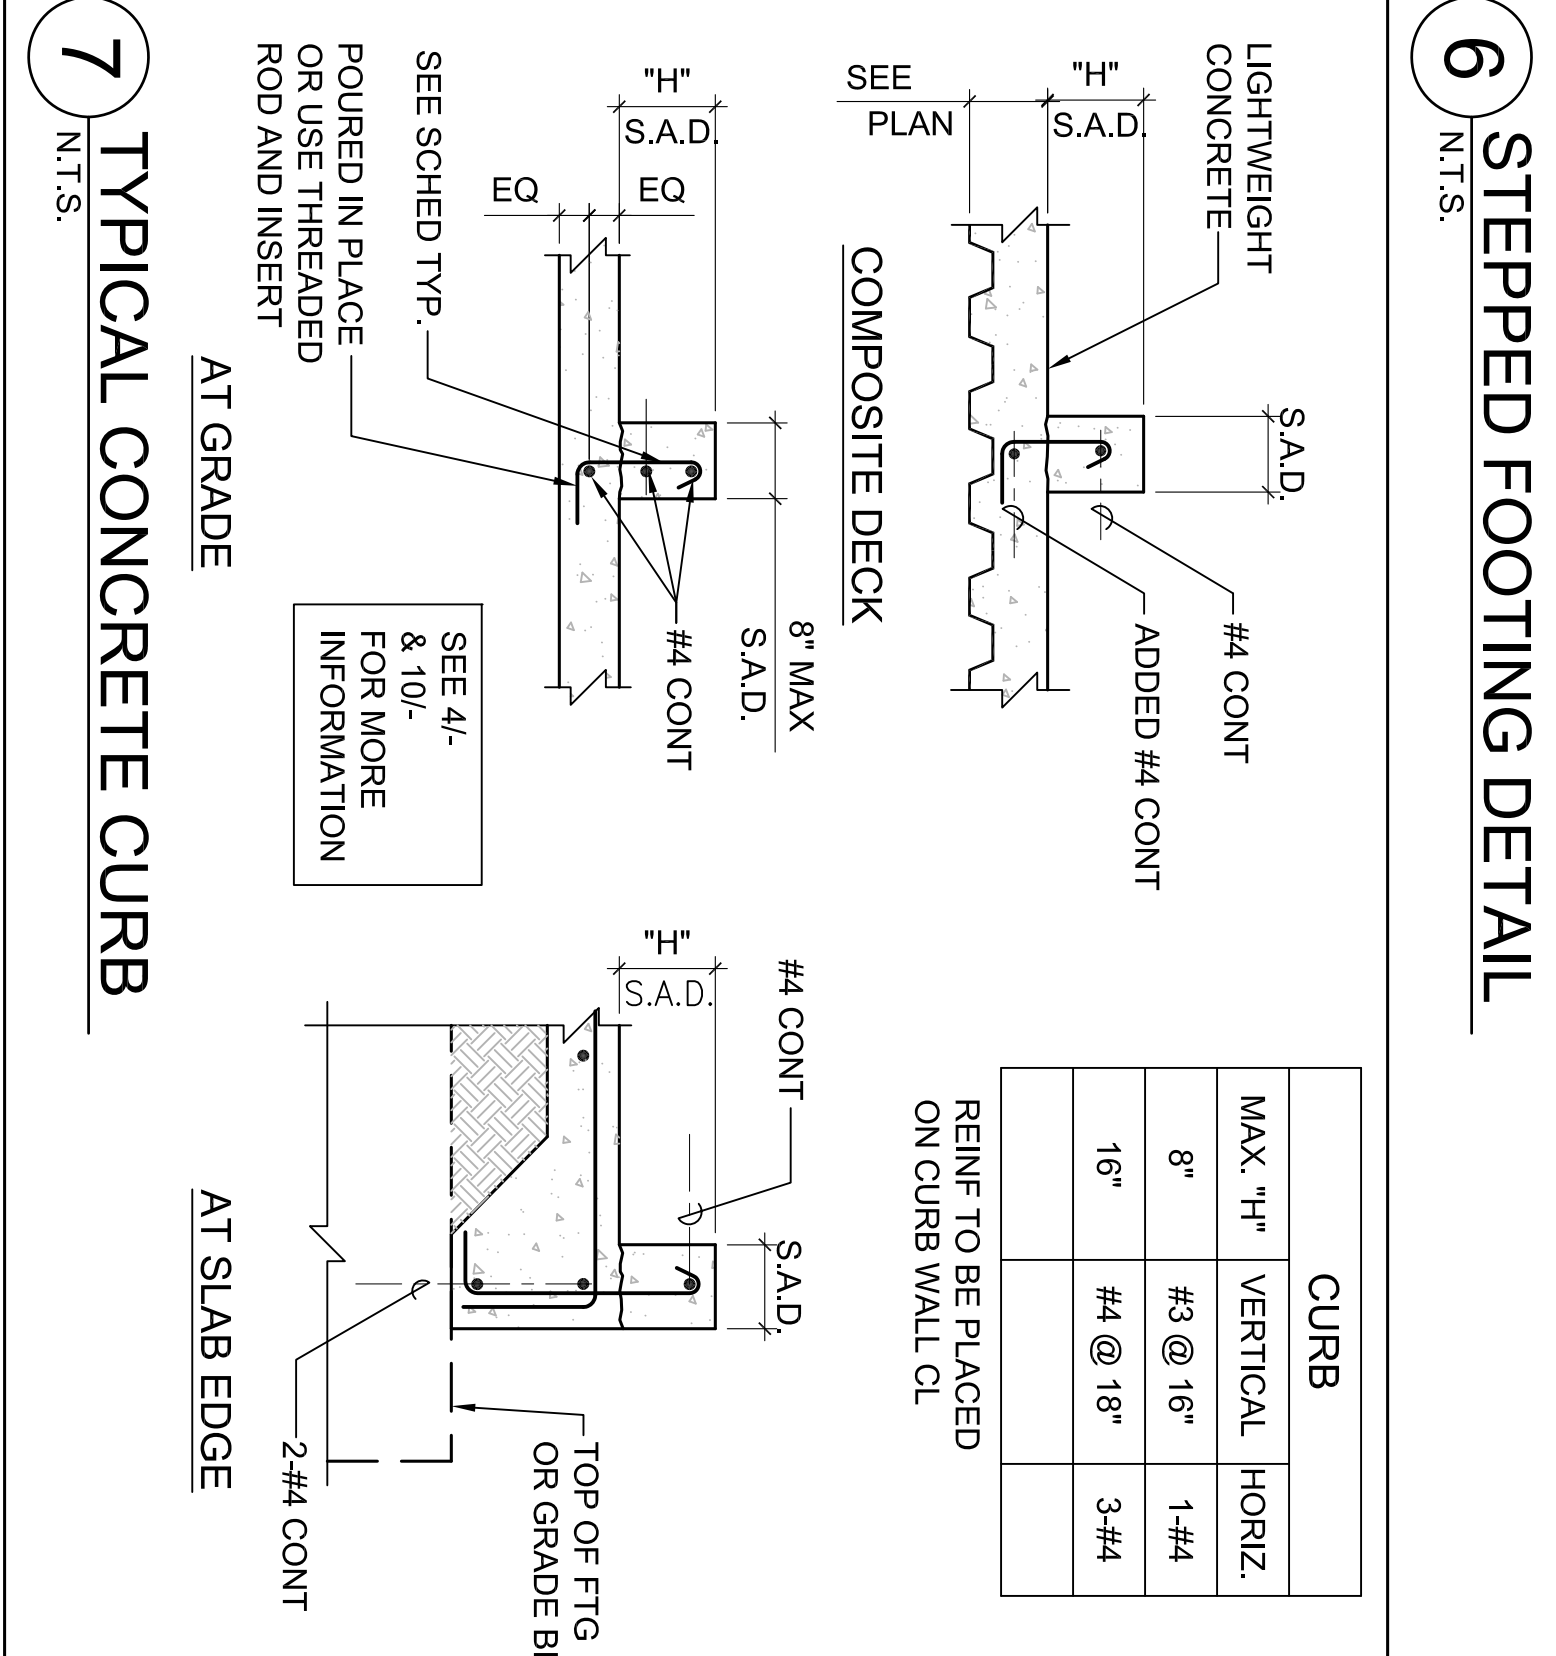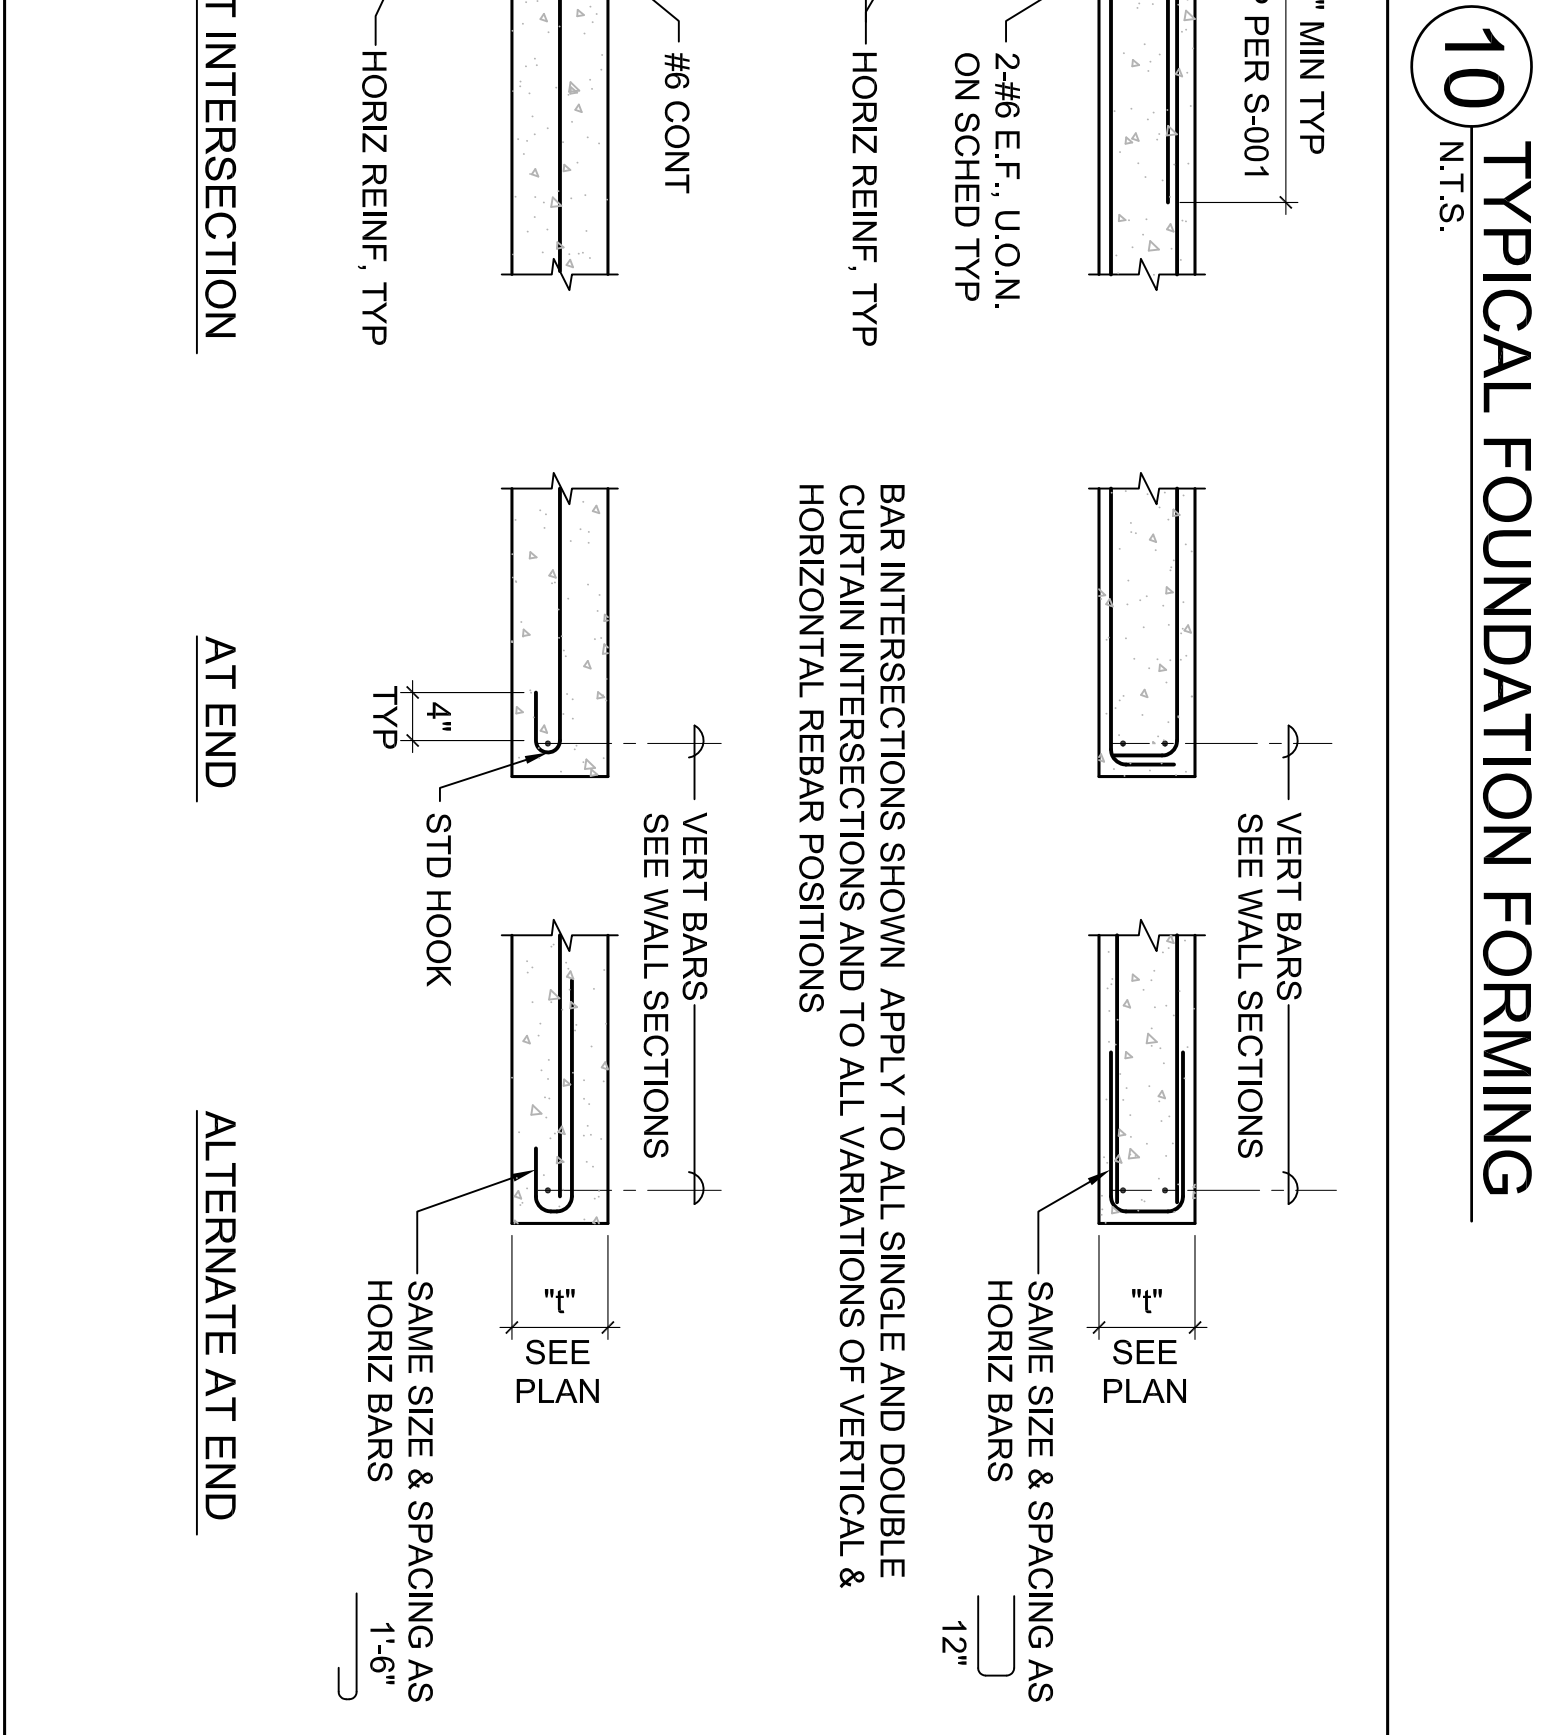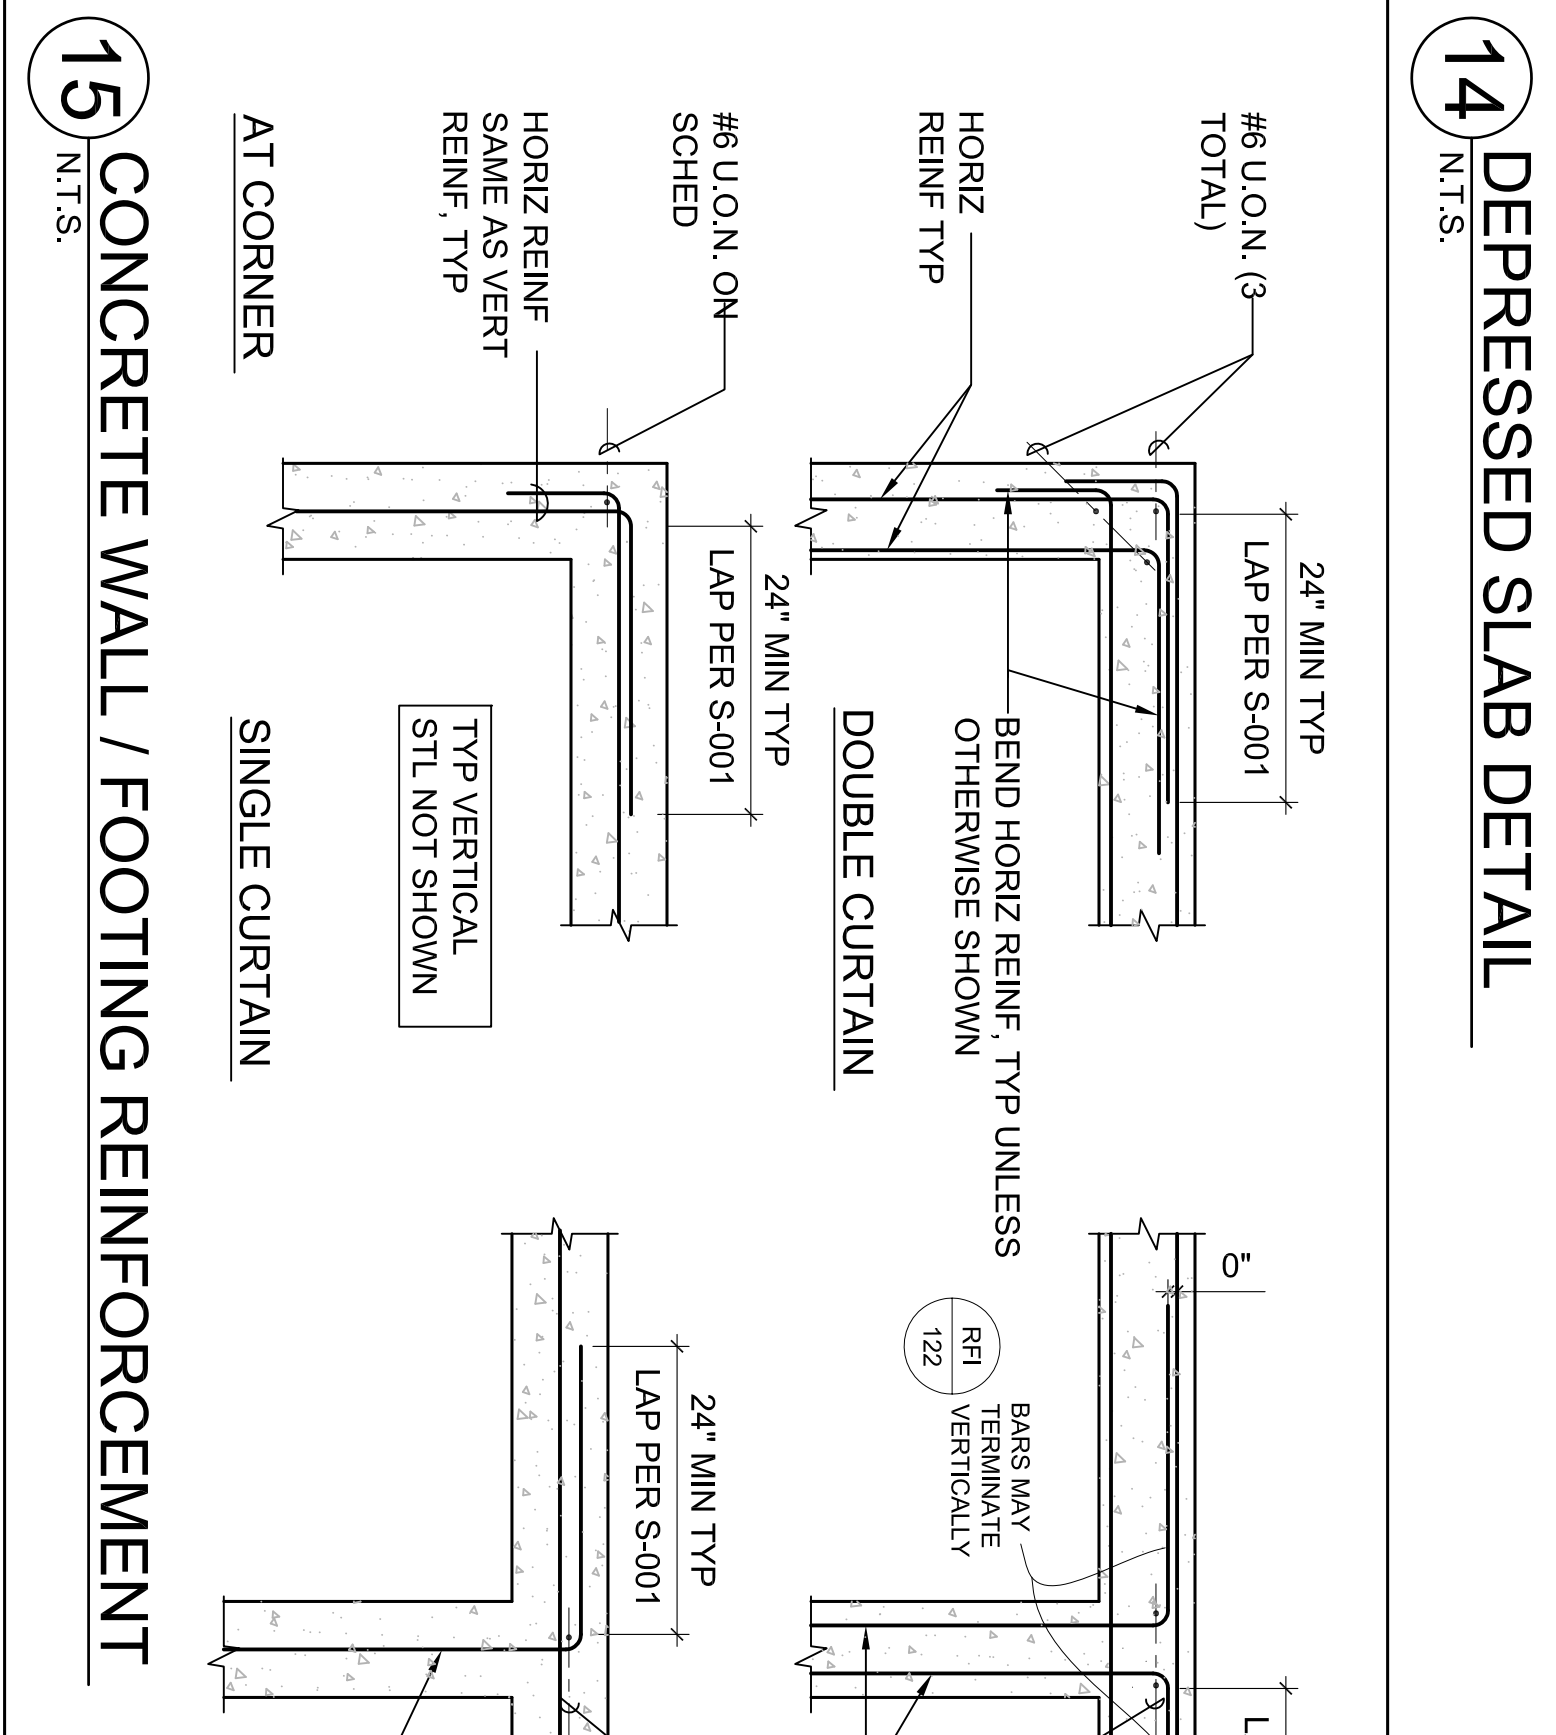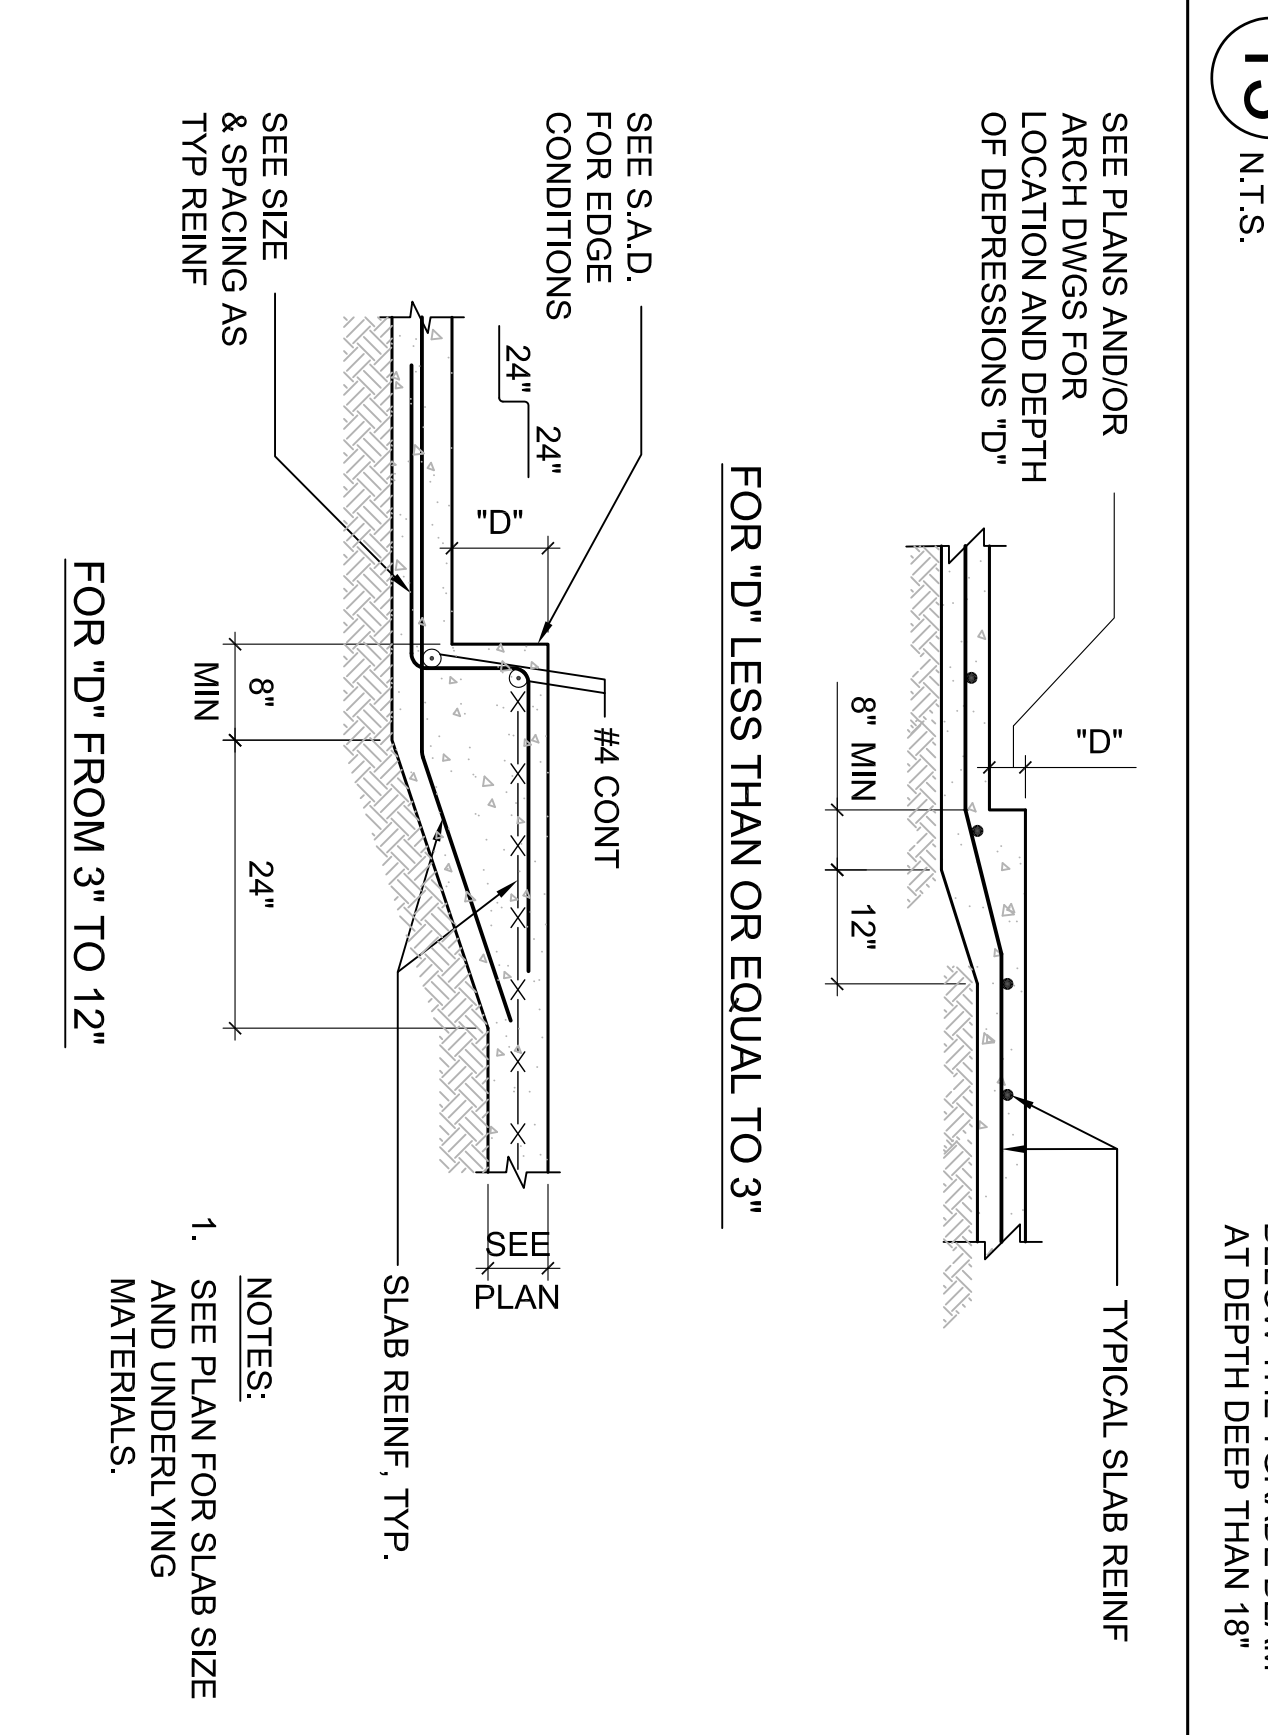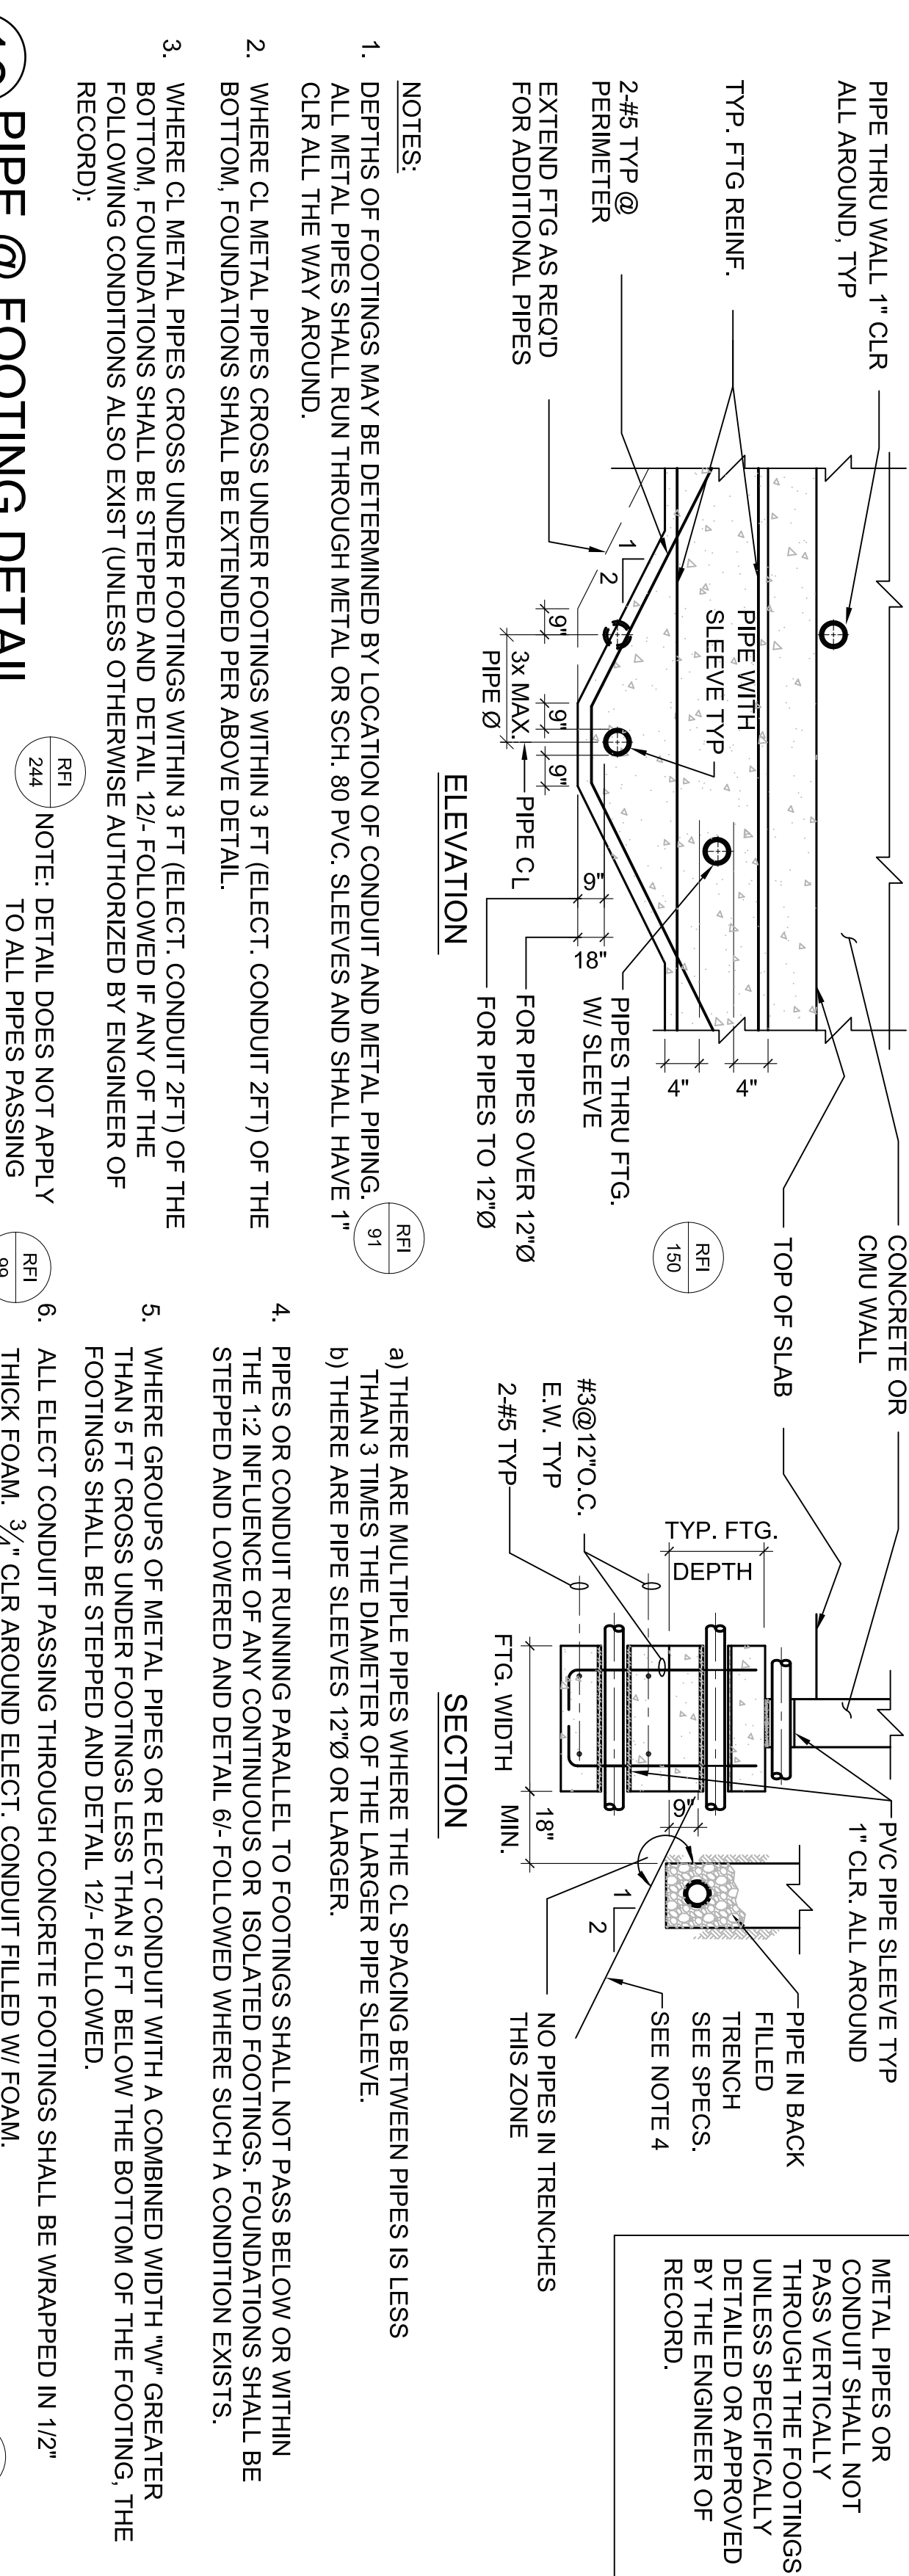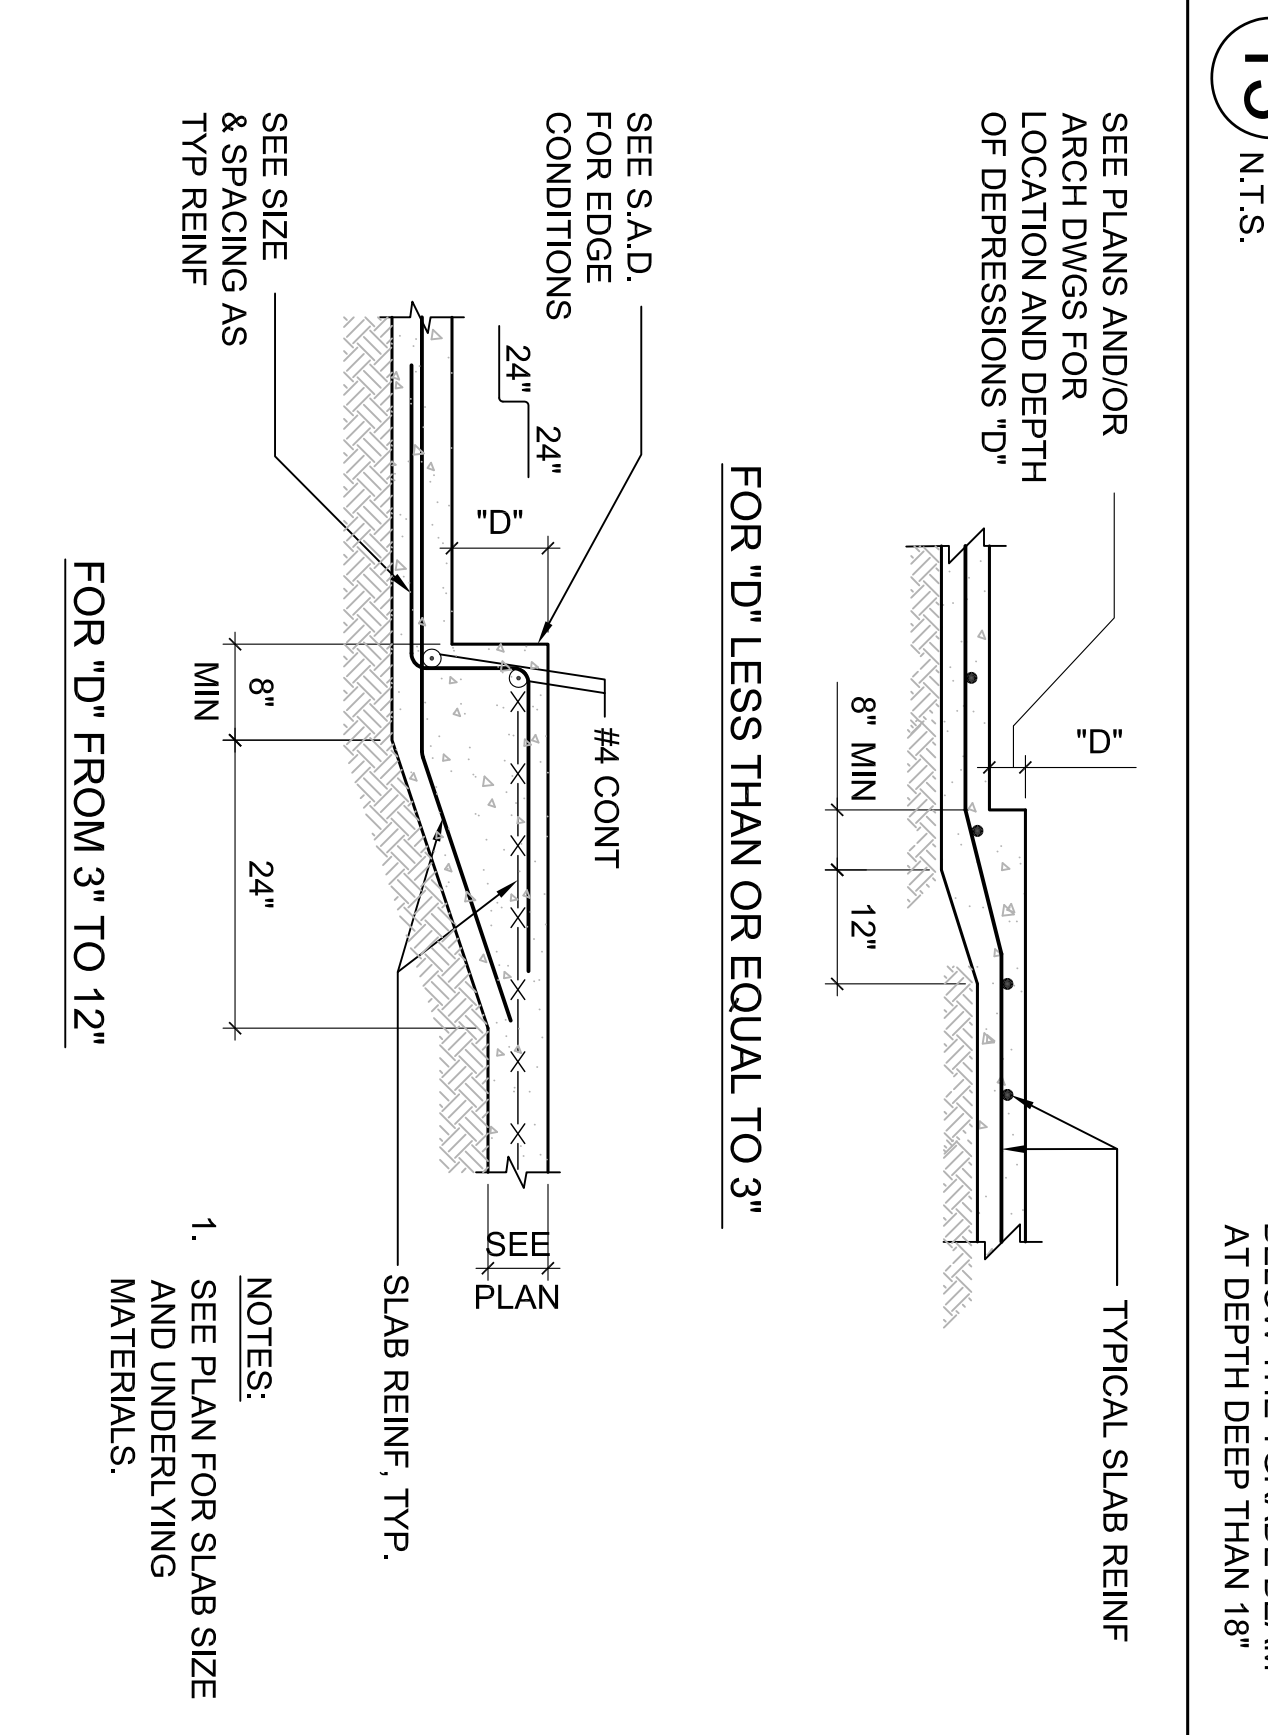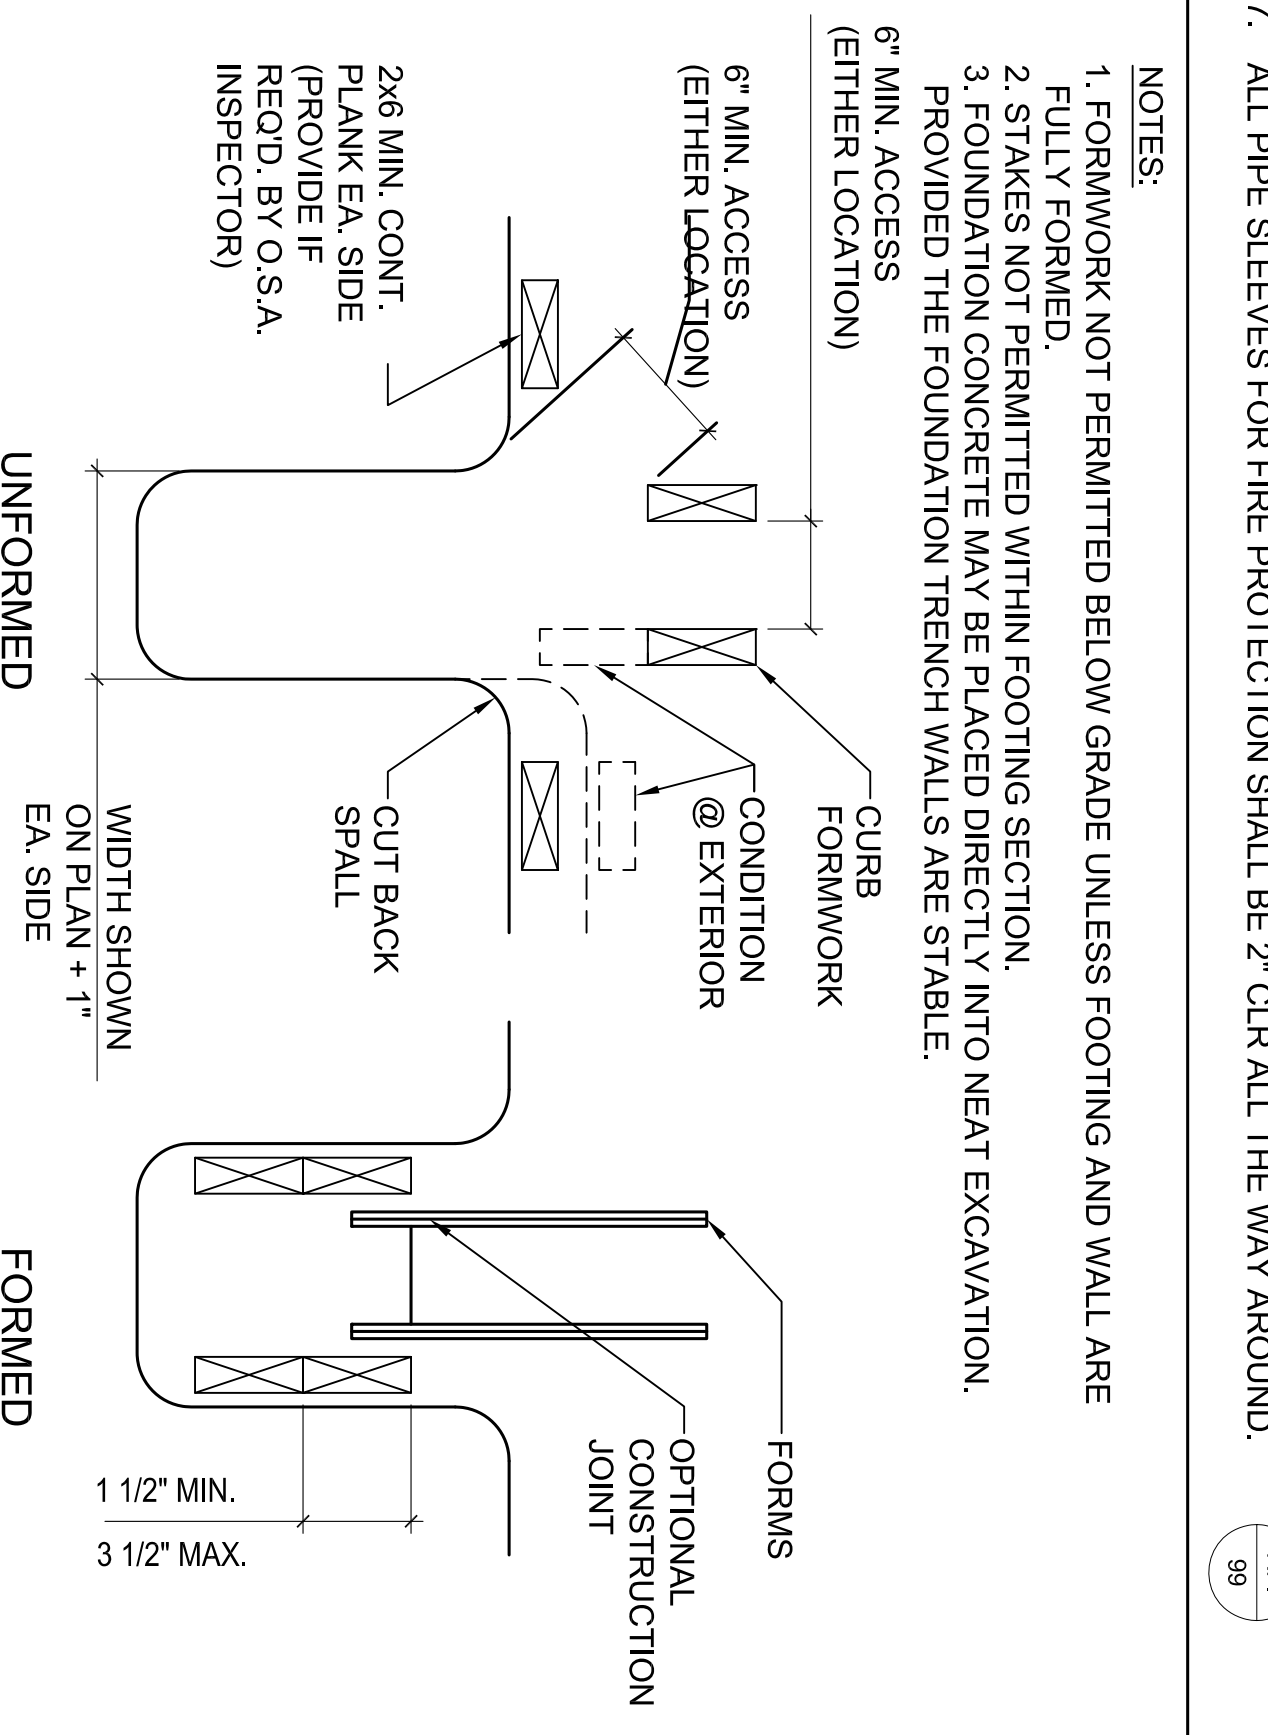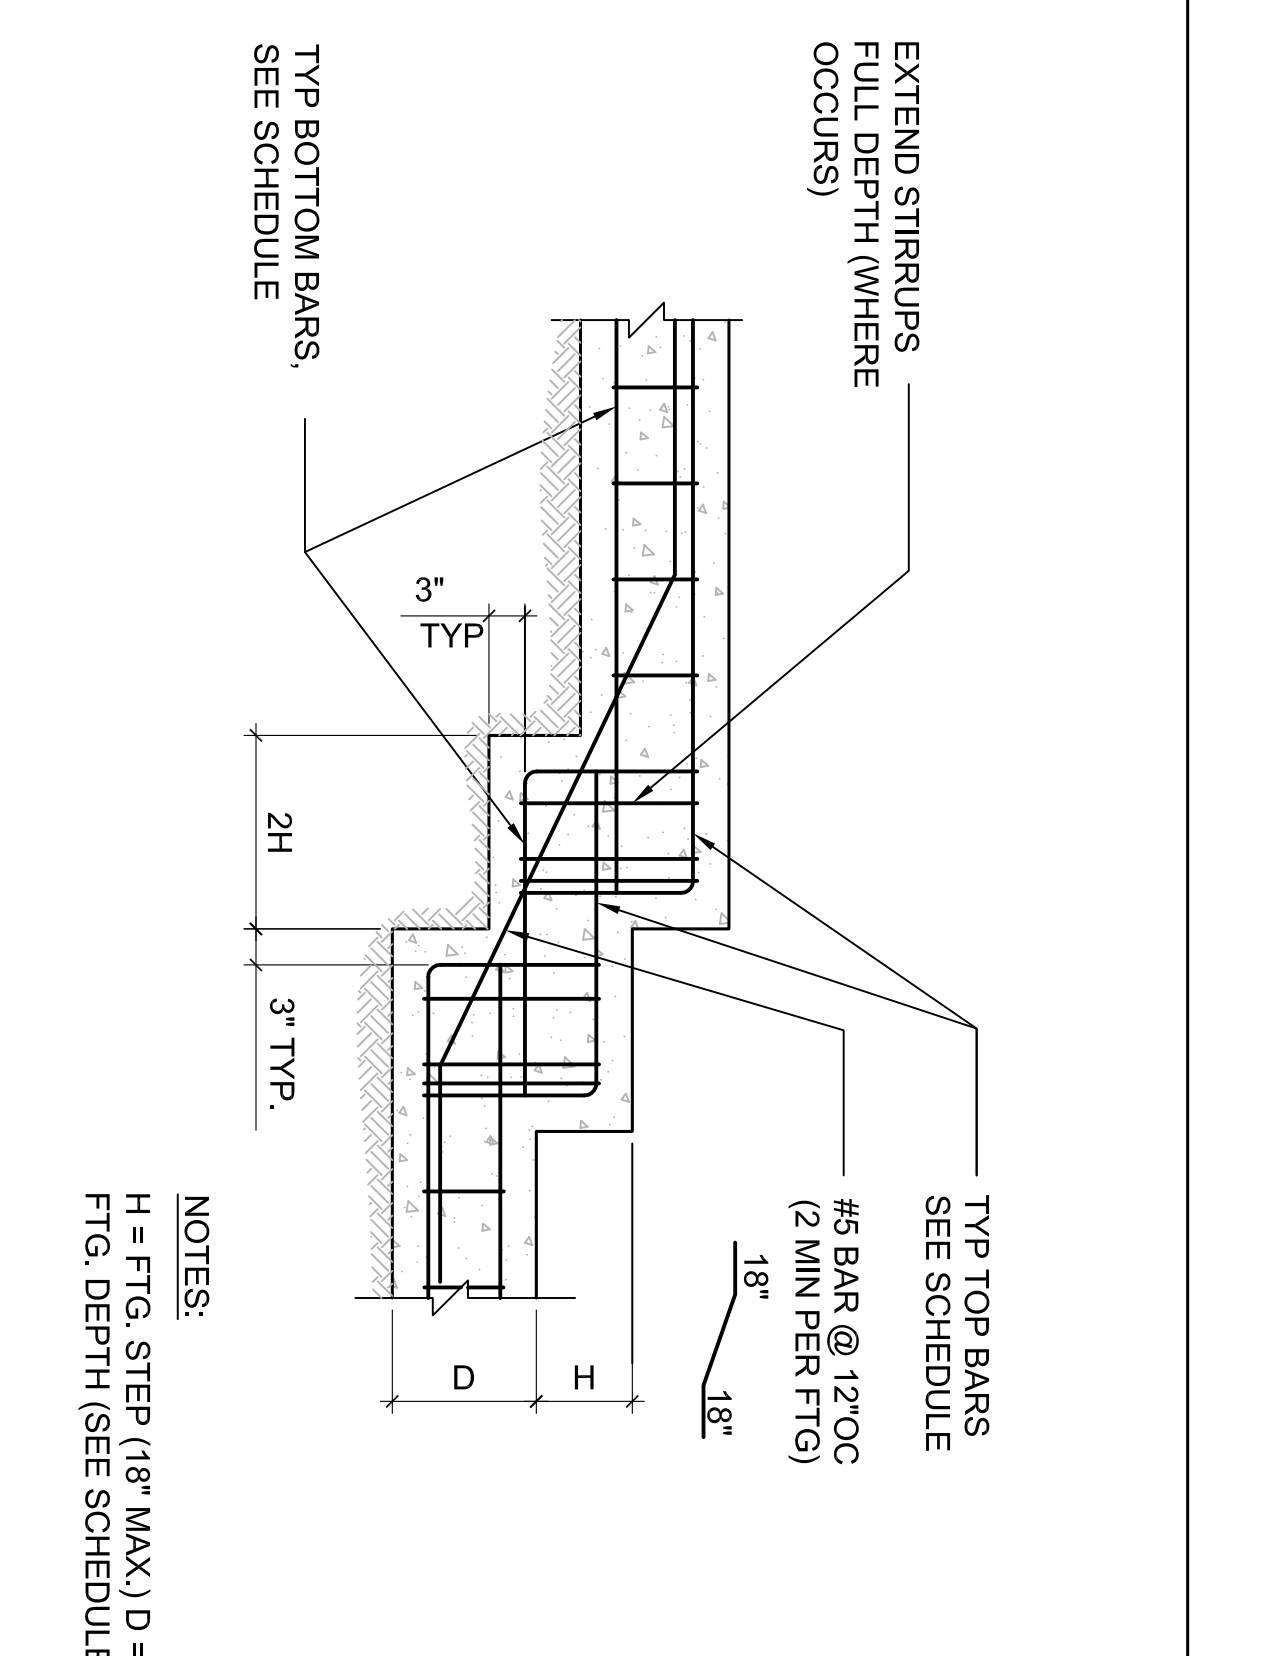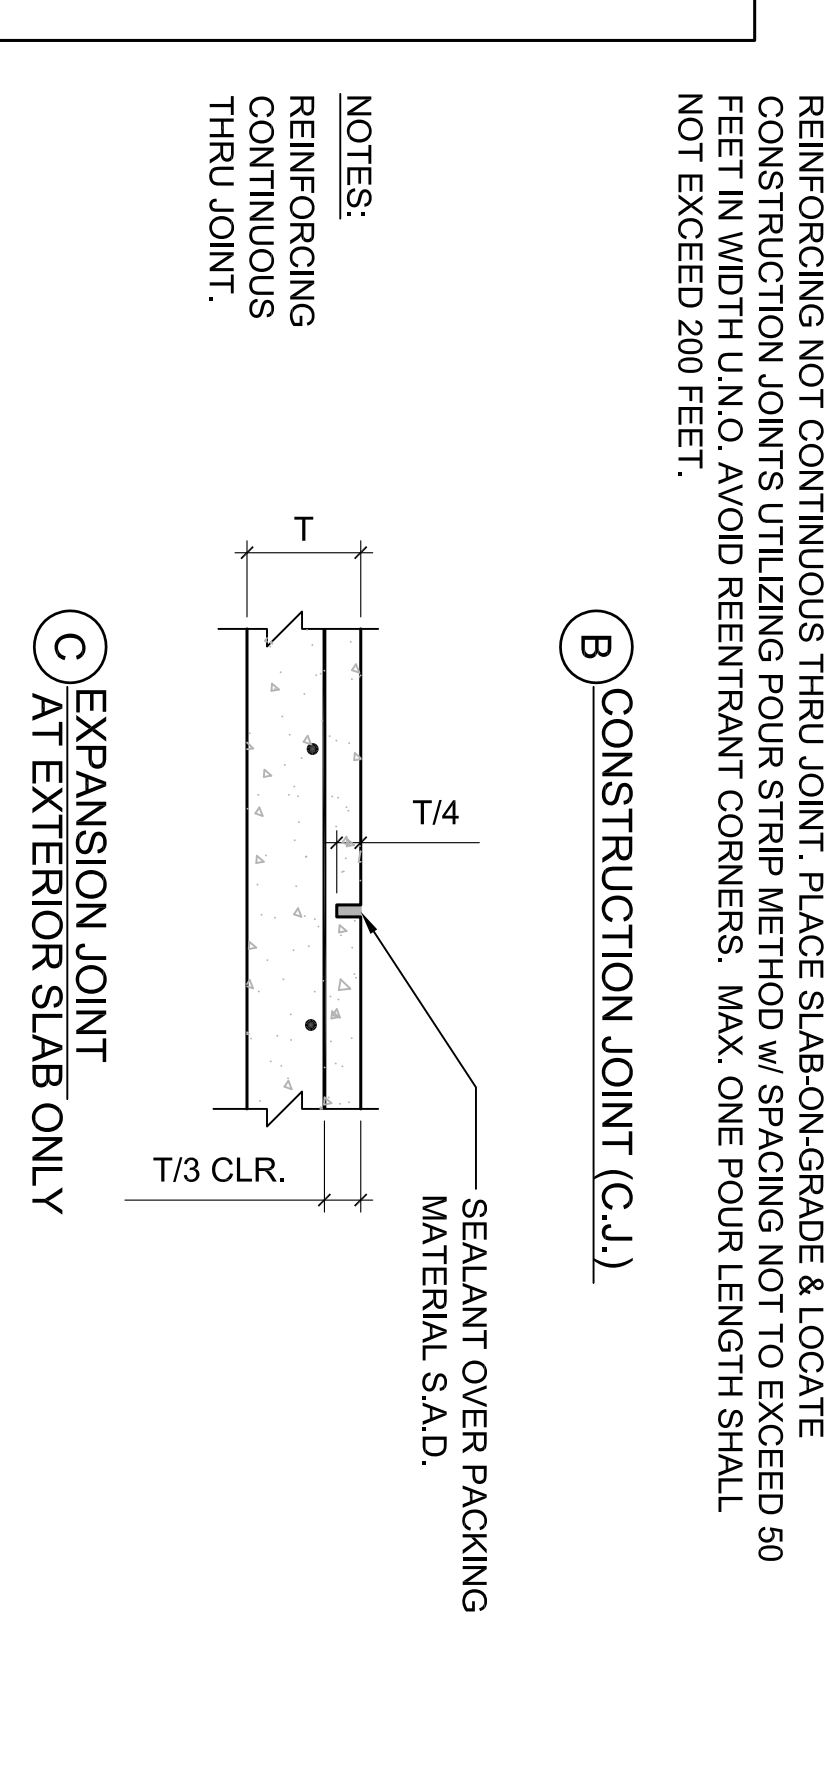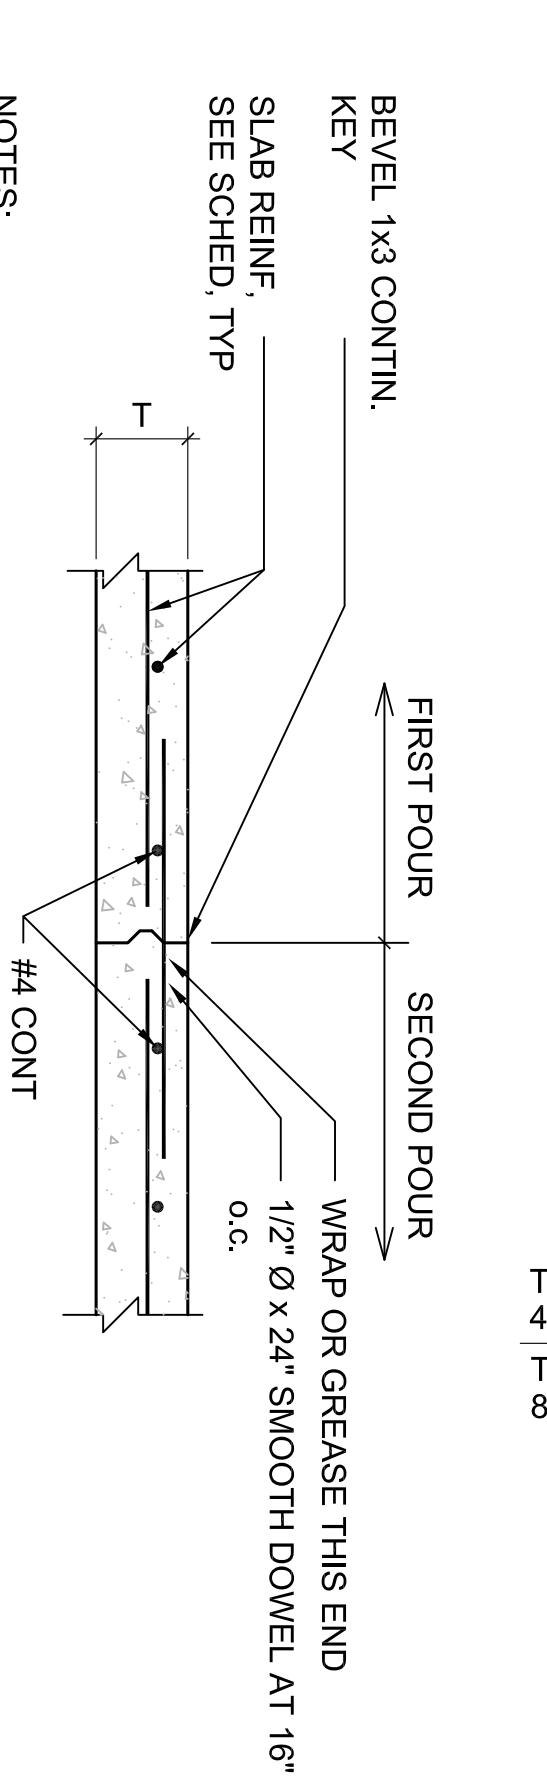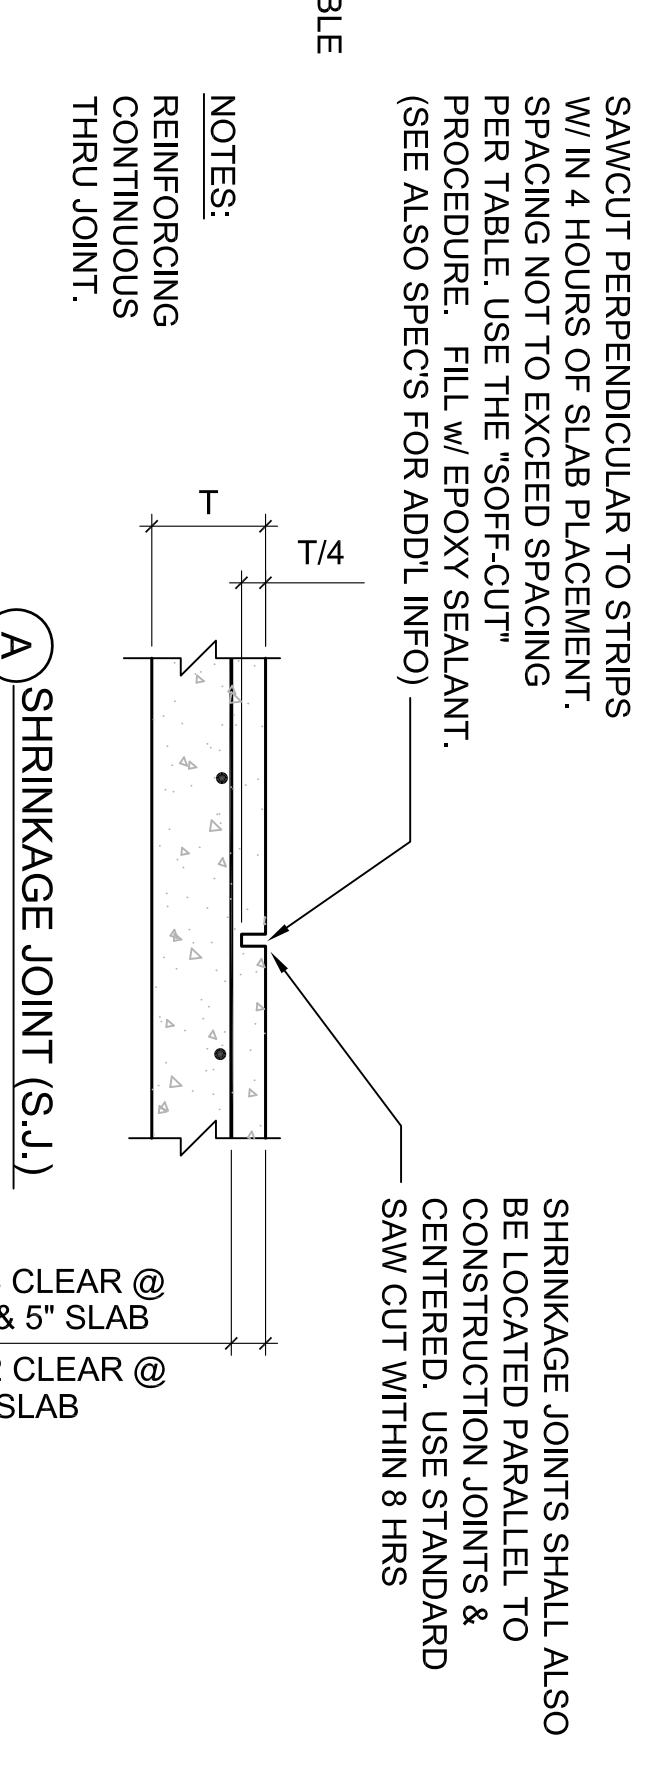







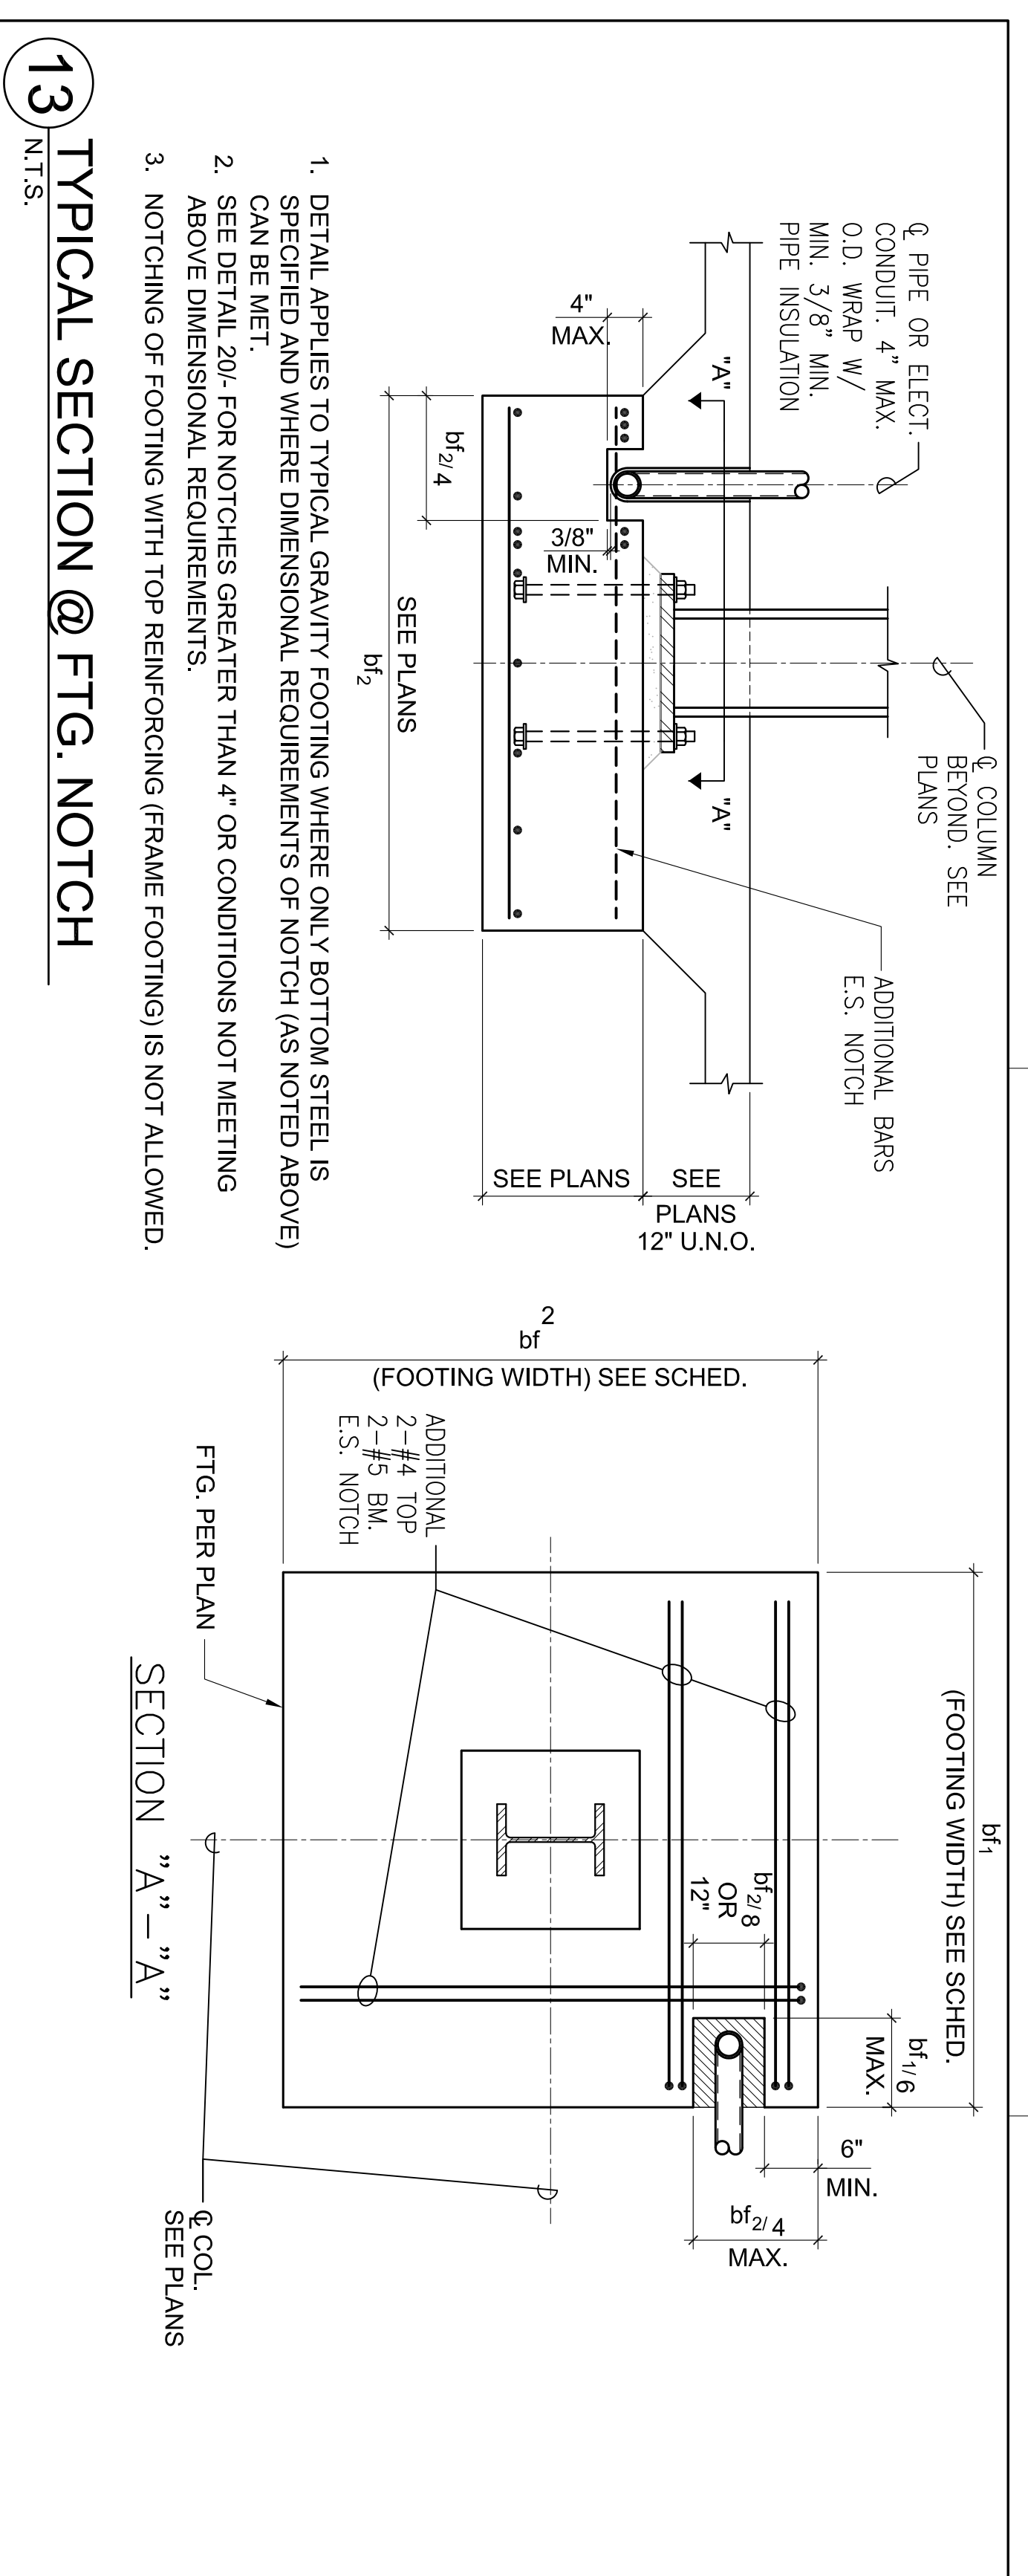
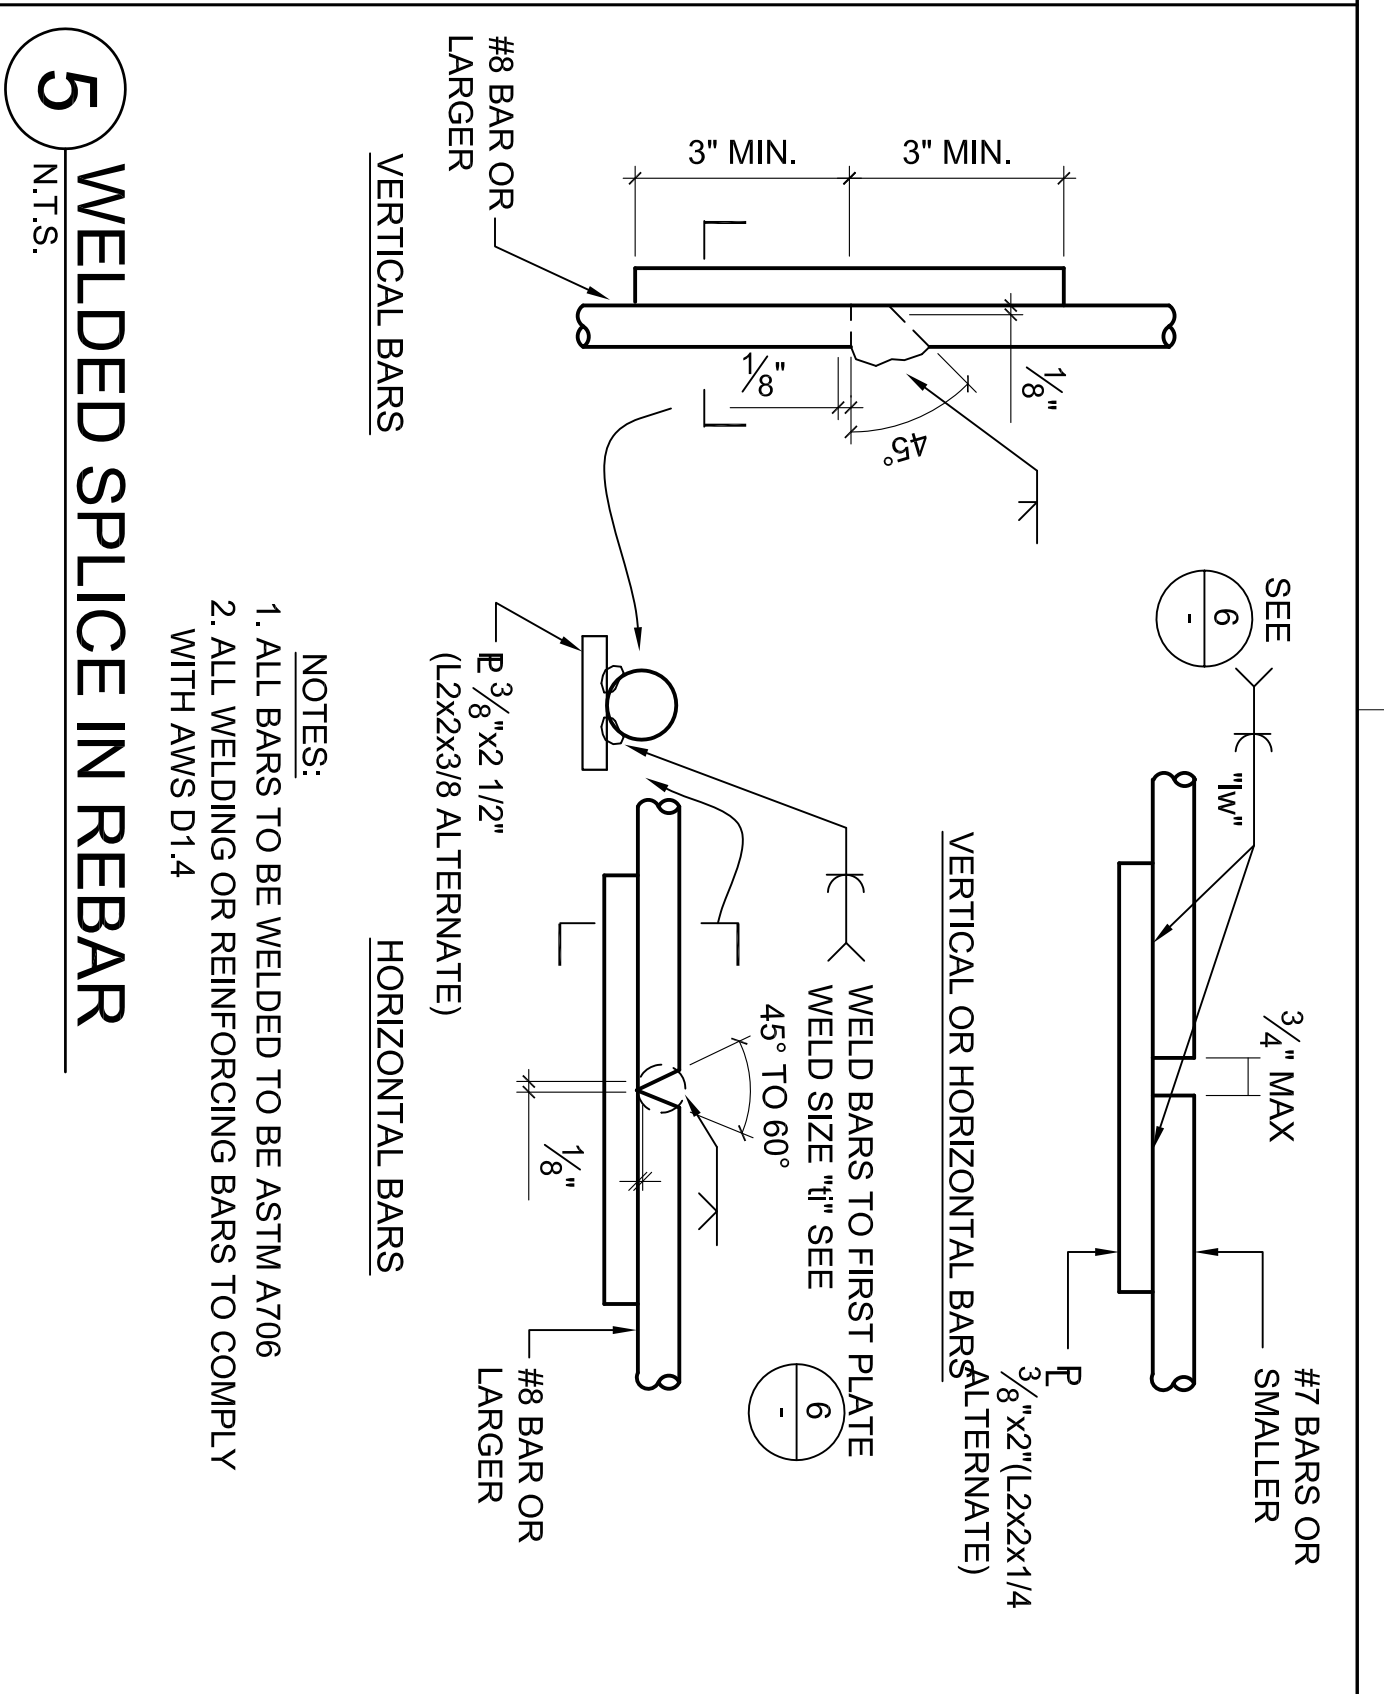
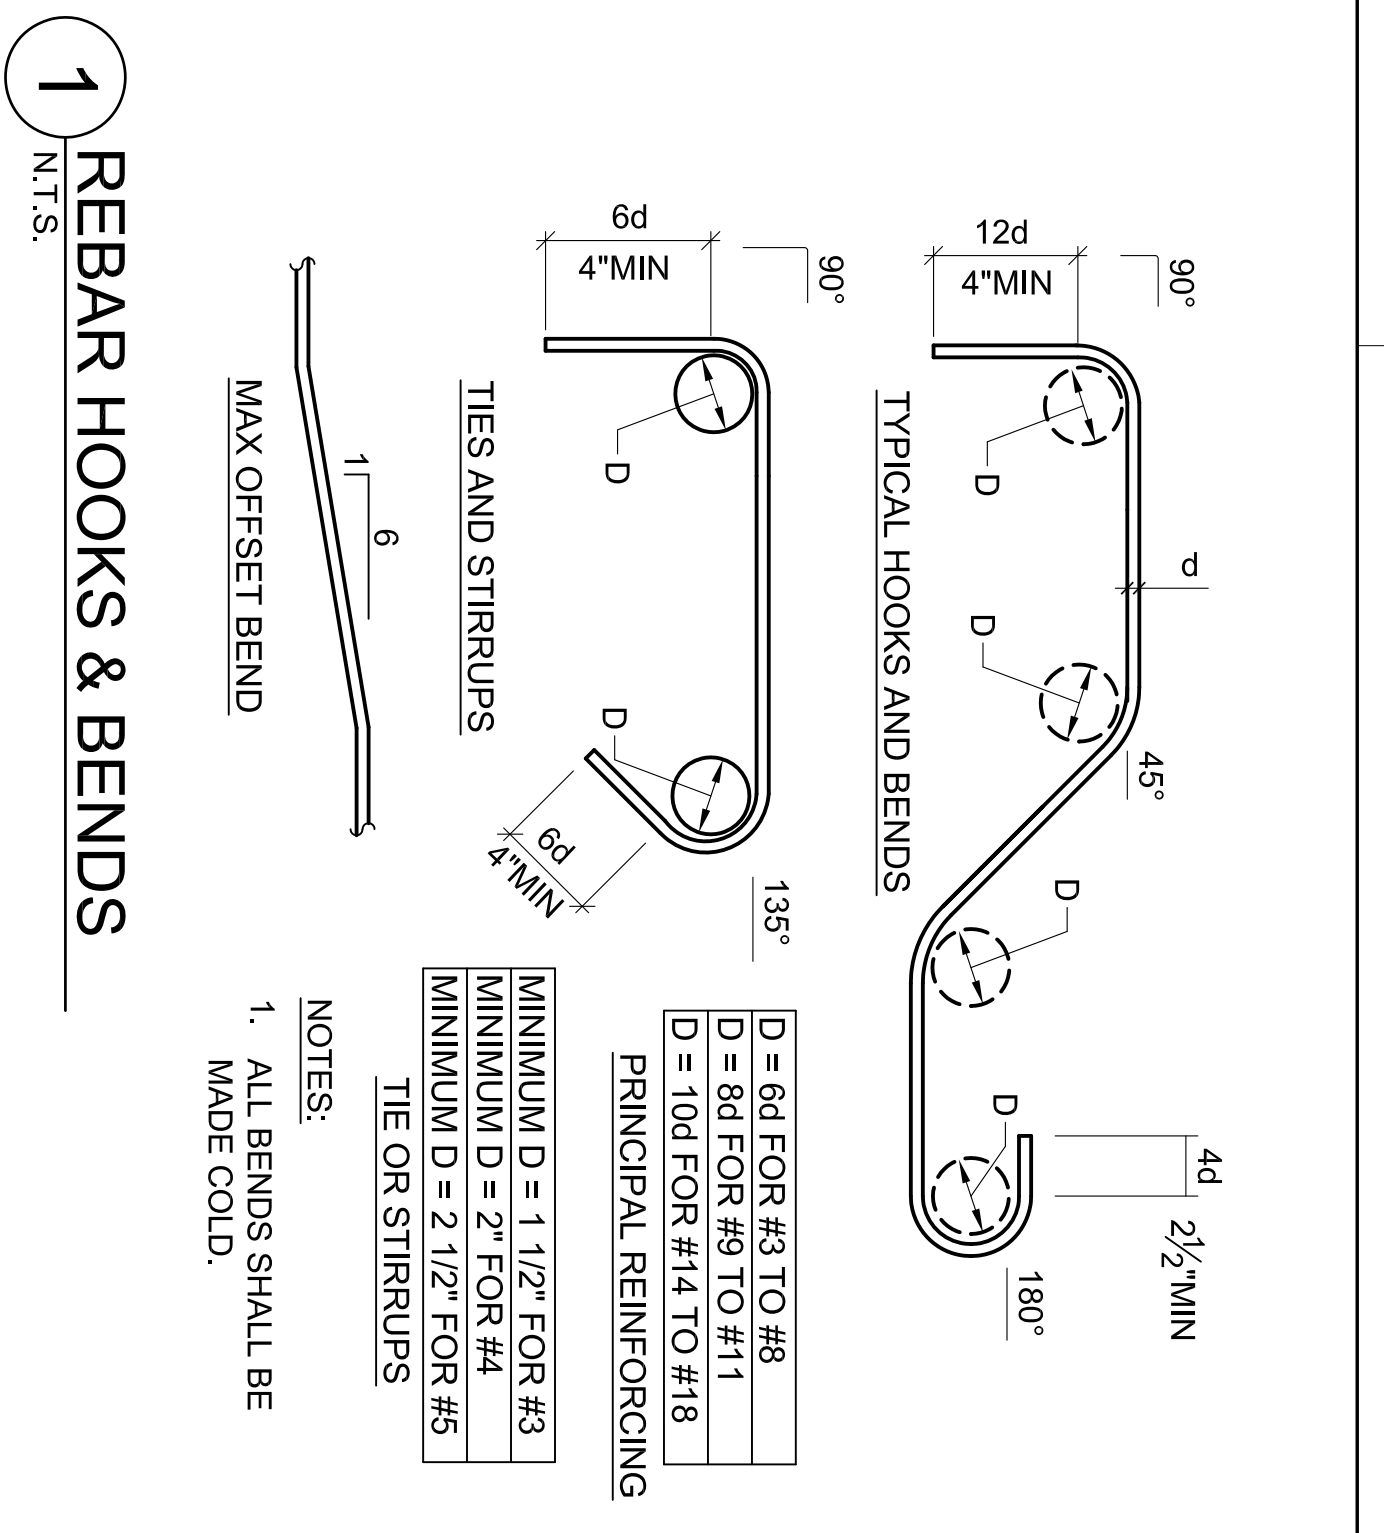


**6 REINFORCING BAR WELDS TO PLATES OR STEEL SHAPES**  
 N.T.S.

A307 BAR STUD SIZE	WELD SIZE	LENGTH "LW"	WELD SIZE
1/2"	#4	1 1/4"	3 1/2"
3/4"	#5	1 1/4"	5/16"
1"	#6	5/16"	3/8"
1 1/4"	#7	5/16"	4"
1 1/2"	#8	3/8"	4 1/2"
2"	#9	3/16"	4 1/2"

\* TYP. UNO.  
 USE V-GROOVE  
 USE V-GROOVE

NOTE: CHIP GRIND OR GOUGE TO SOUND METAL BEFORE WELDING OTHER SIDE.

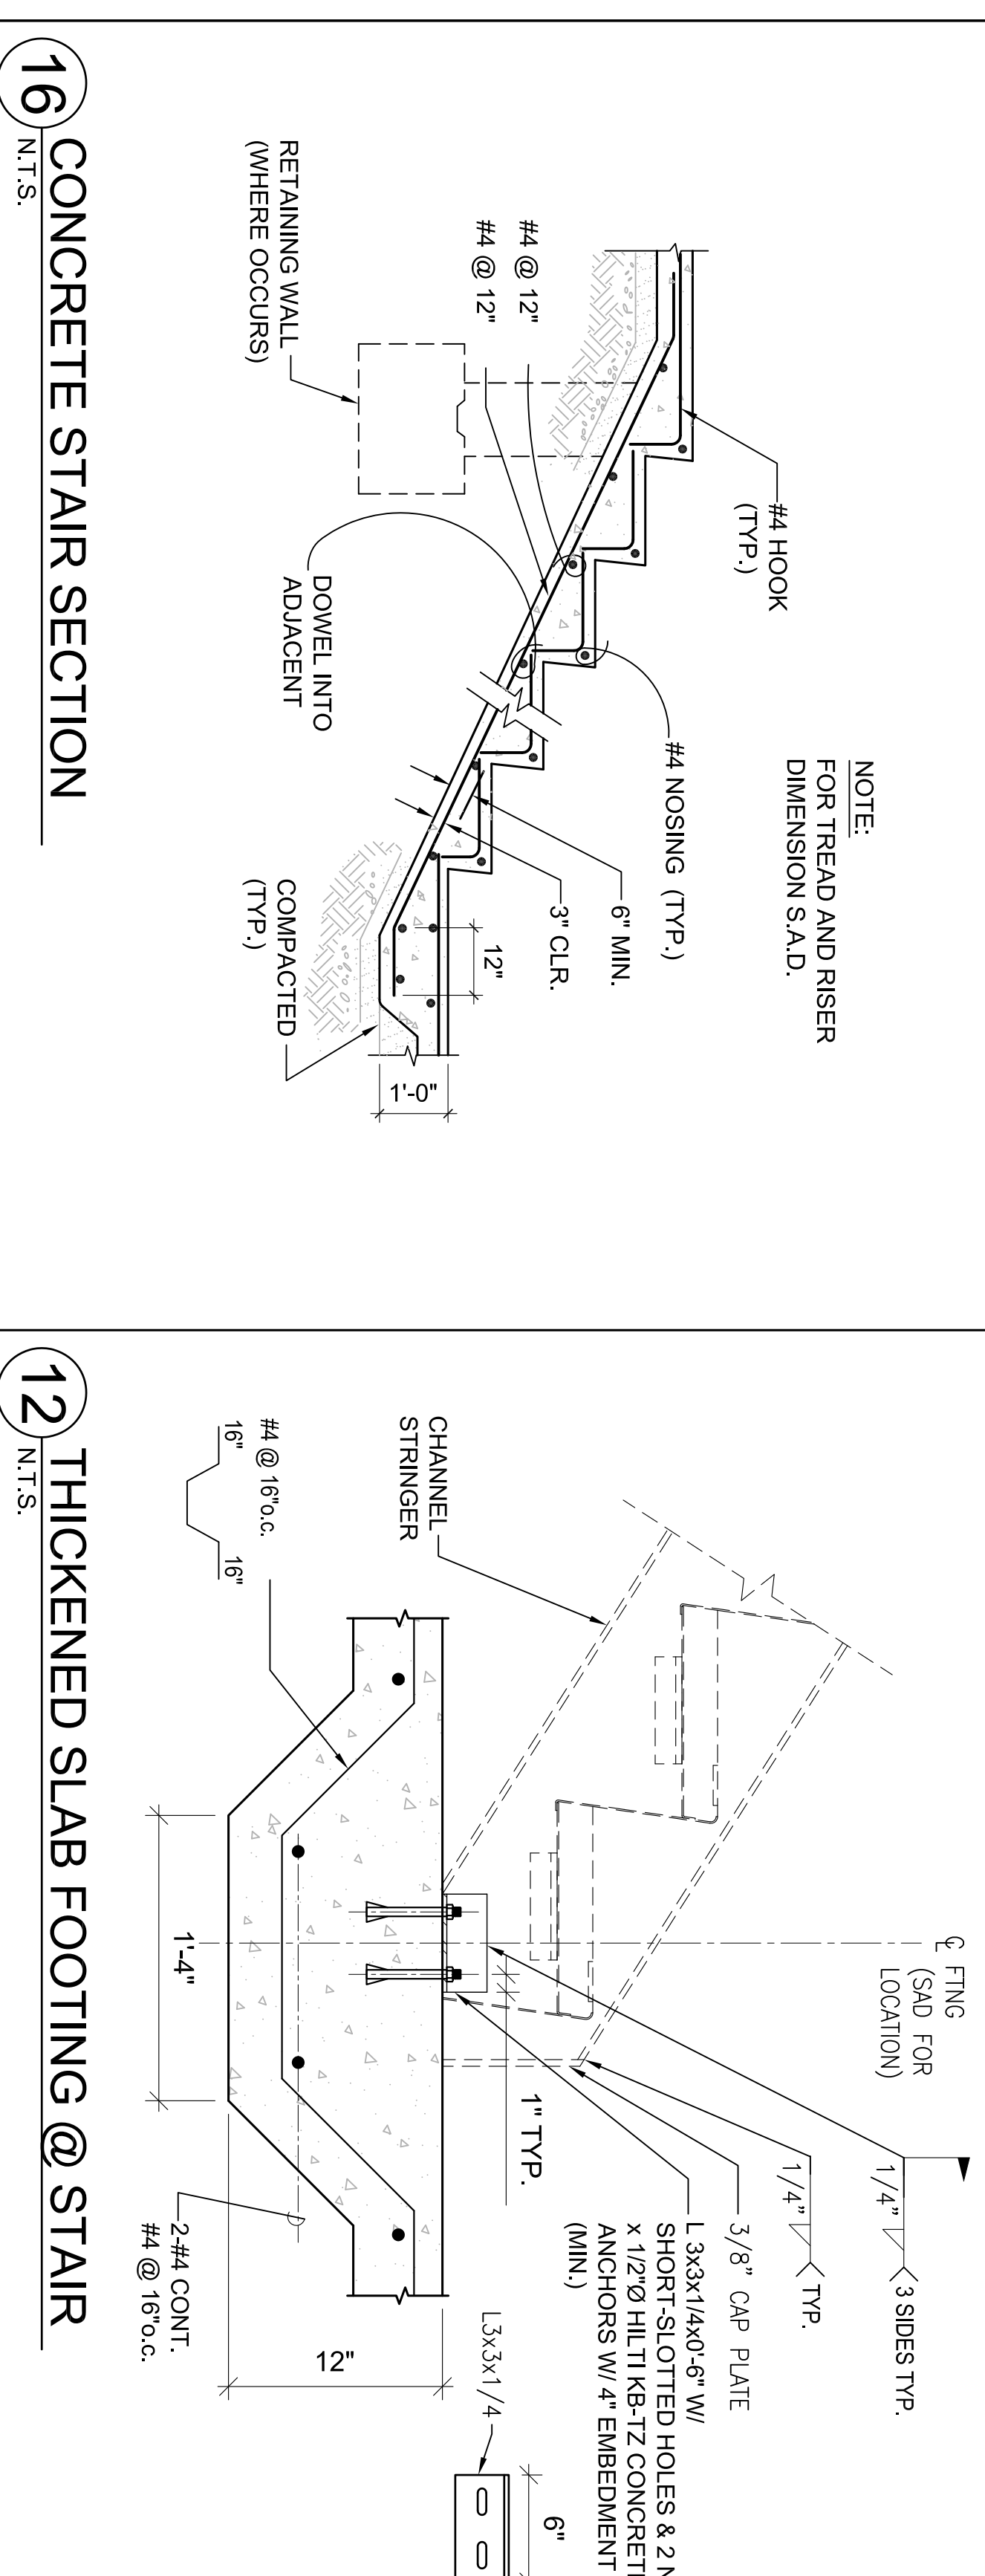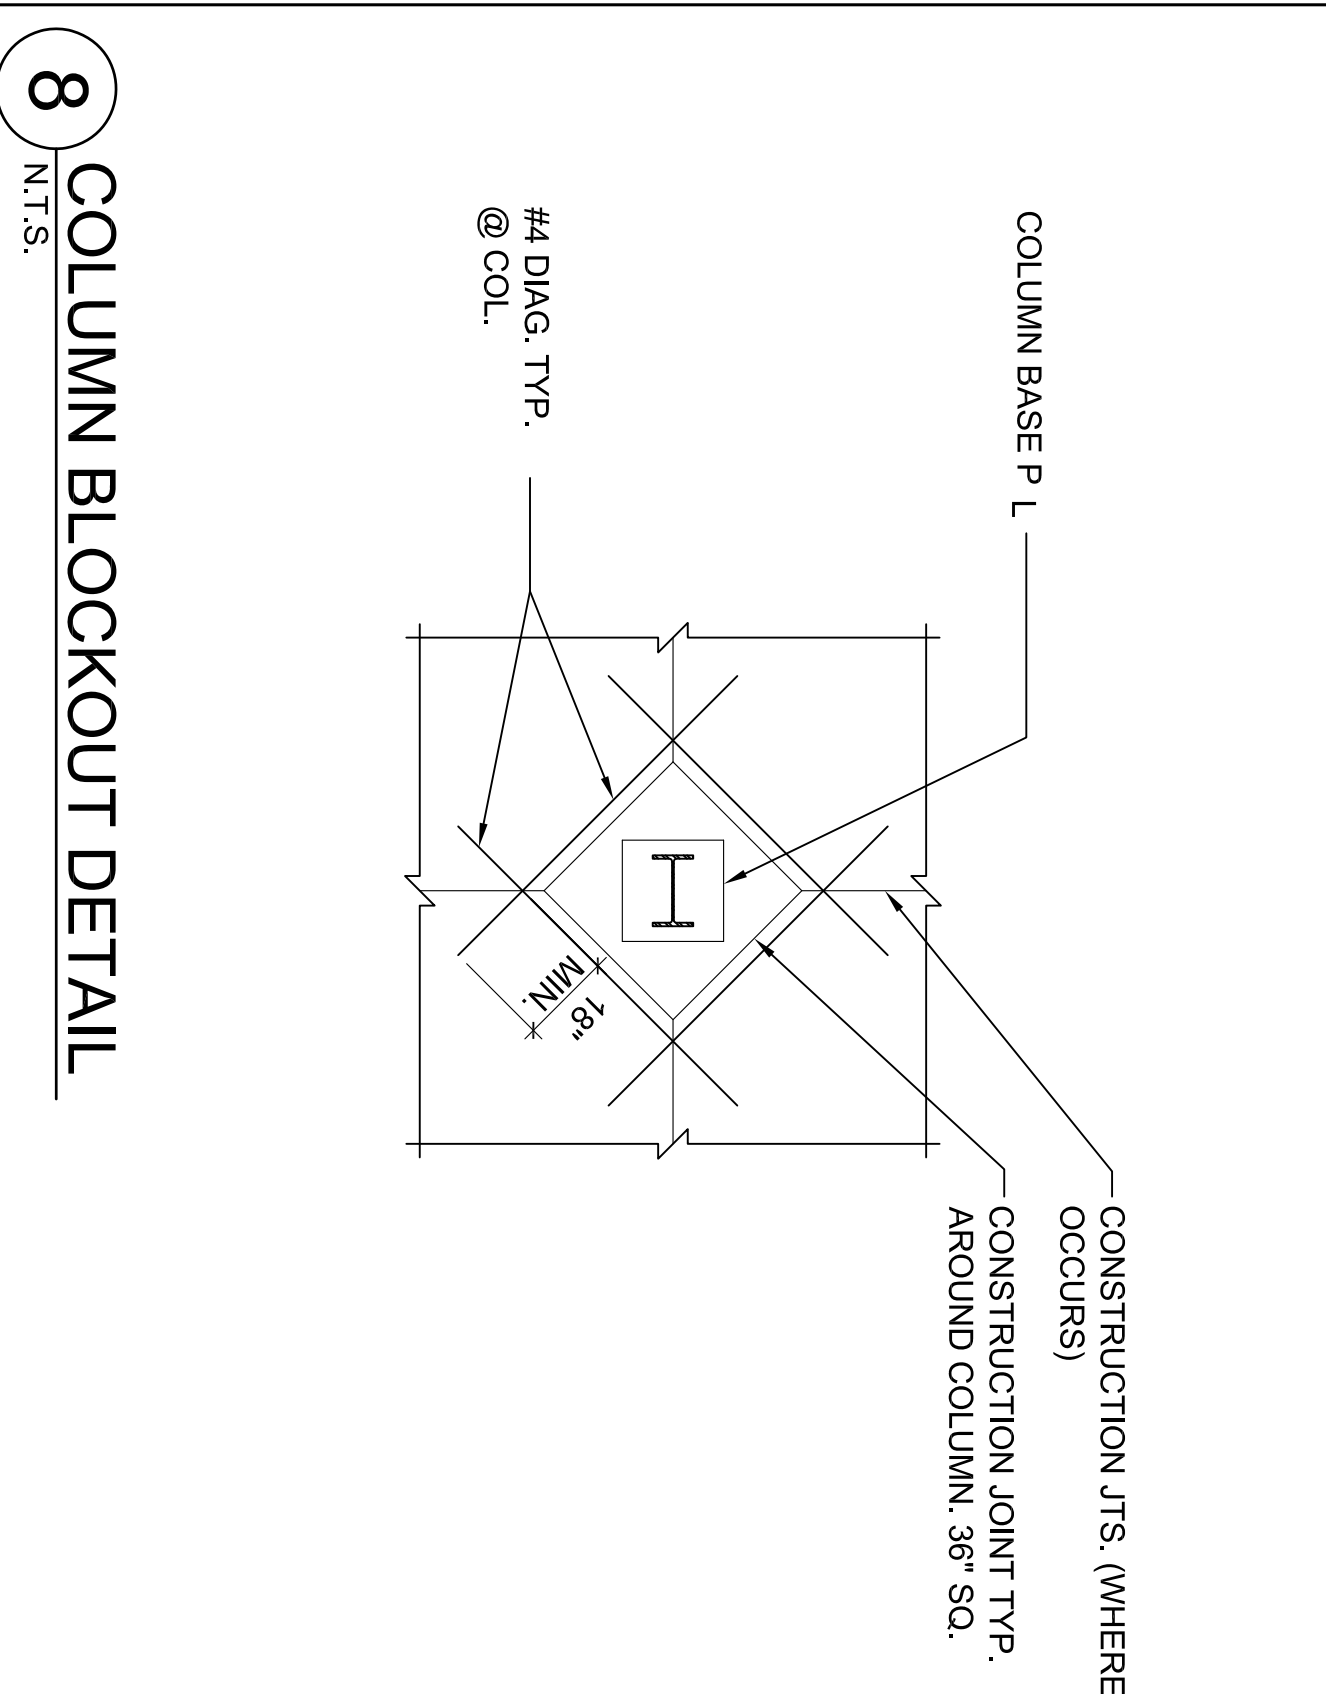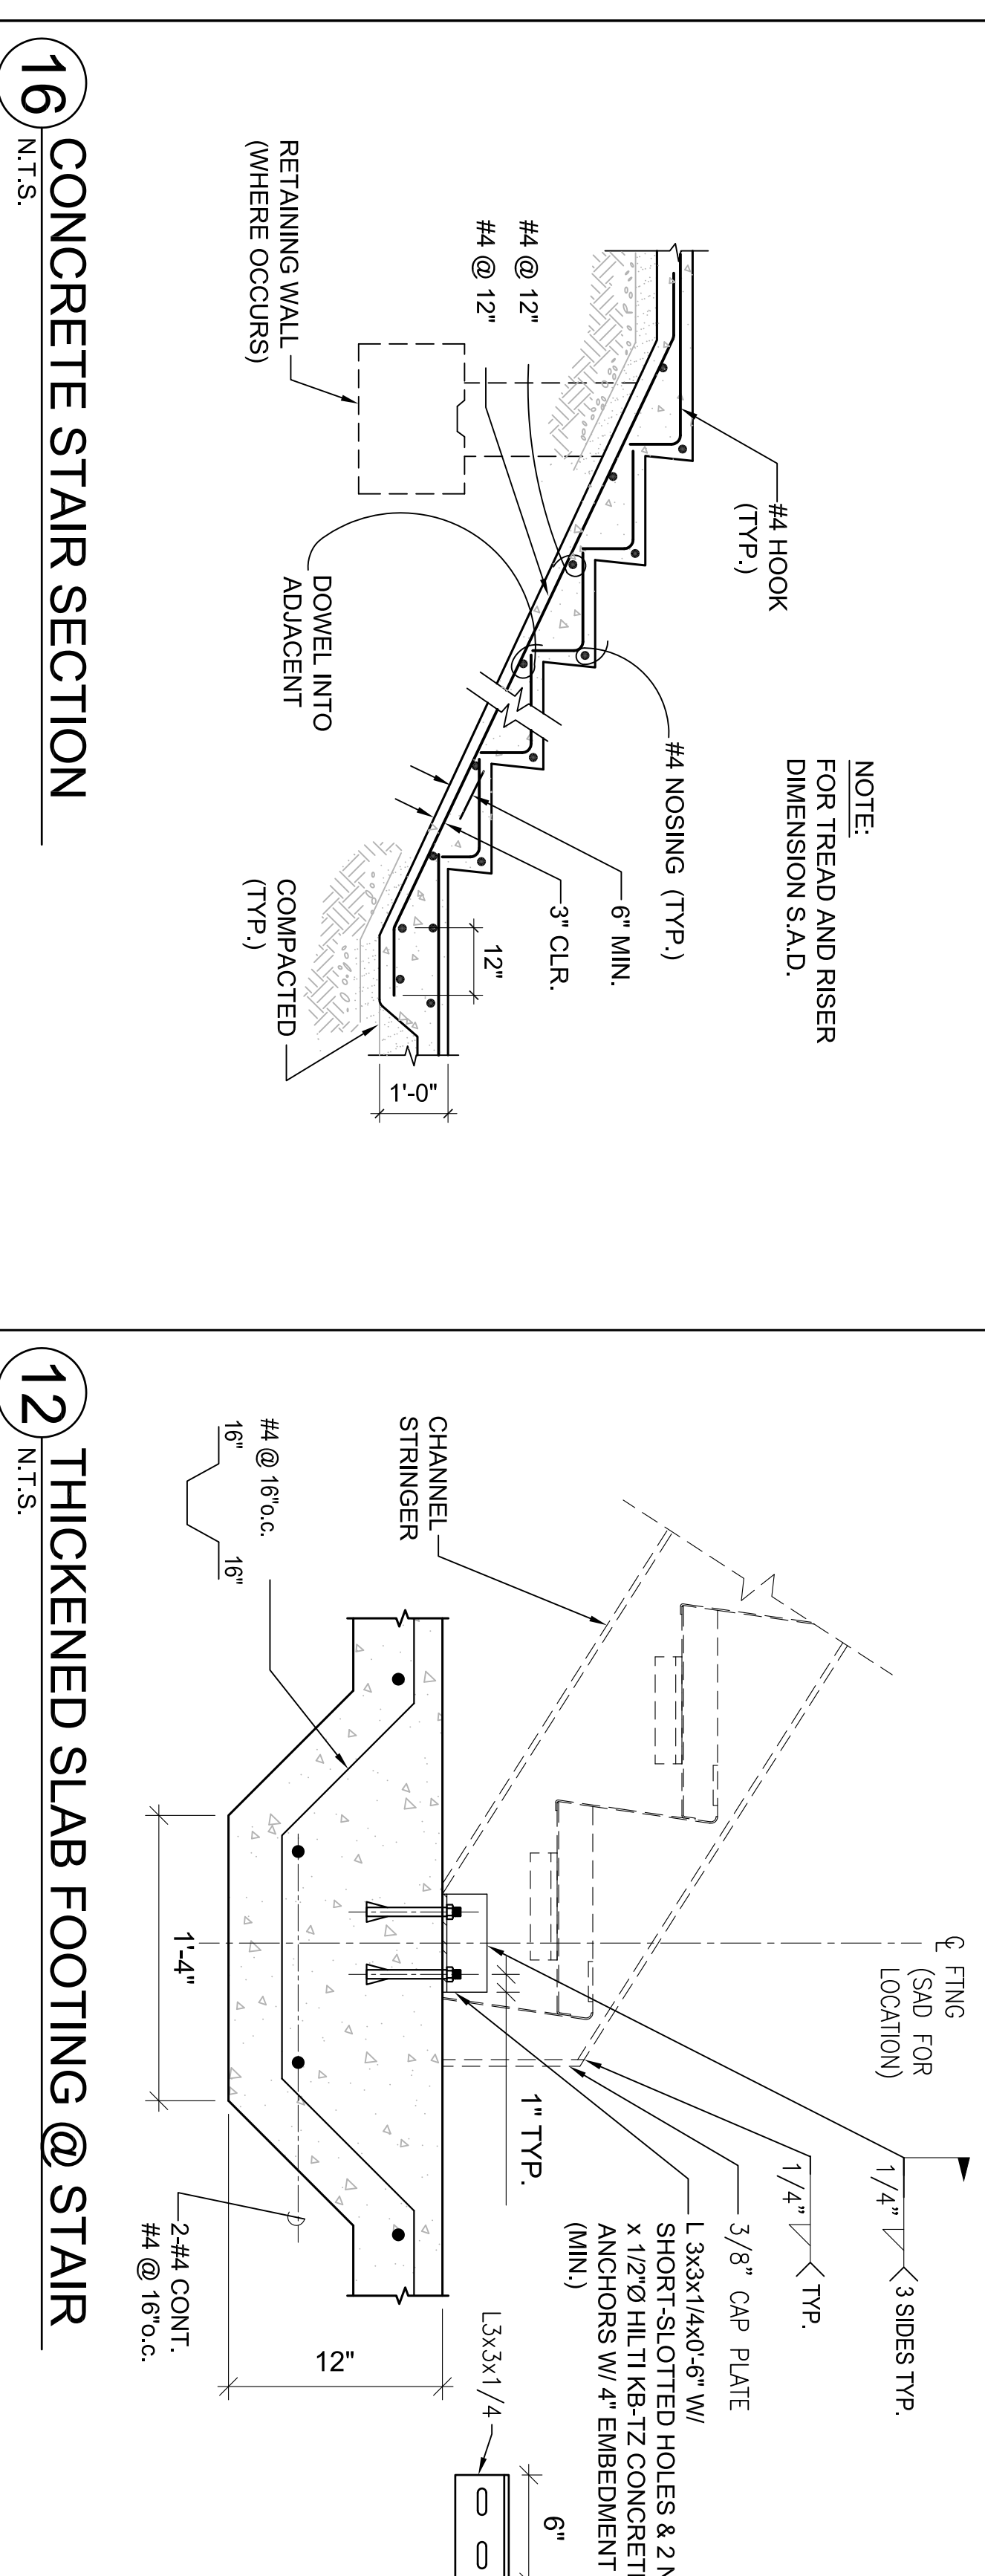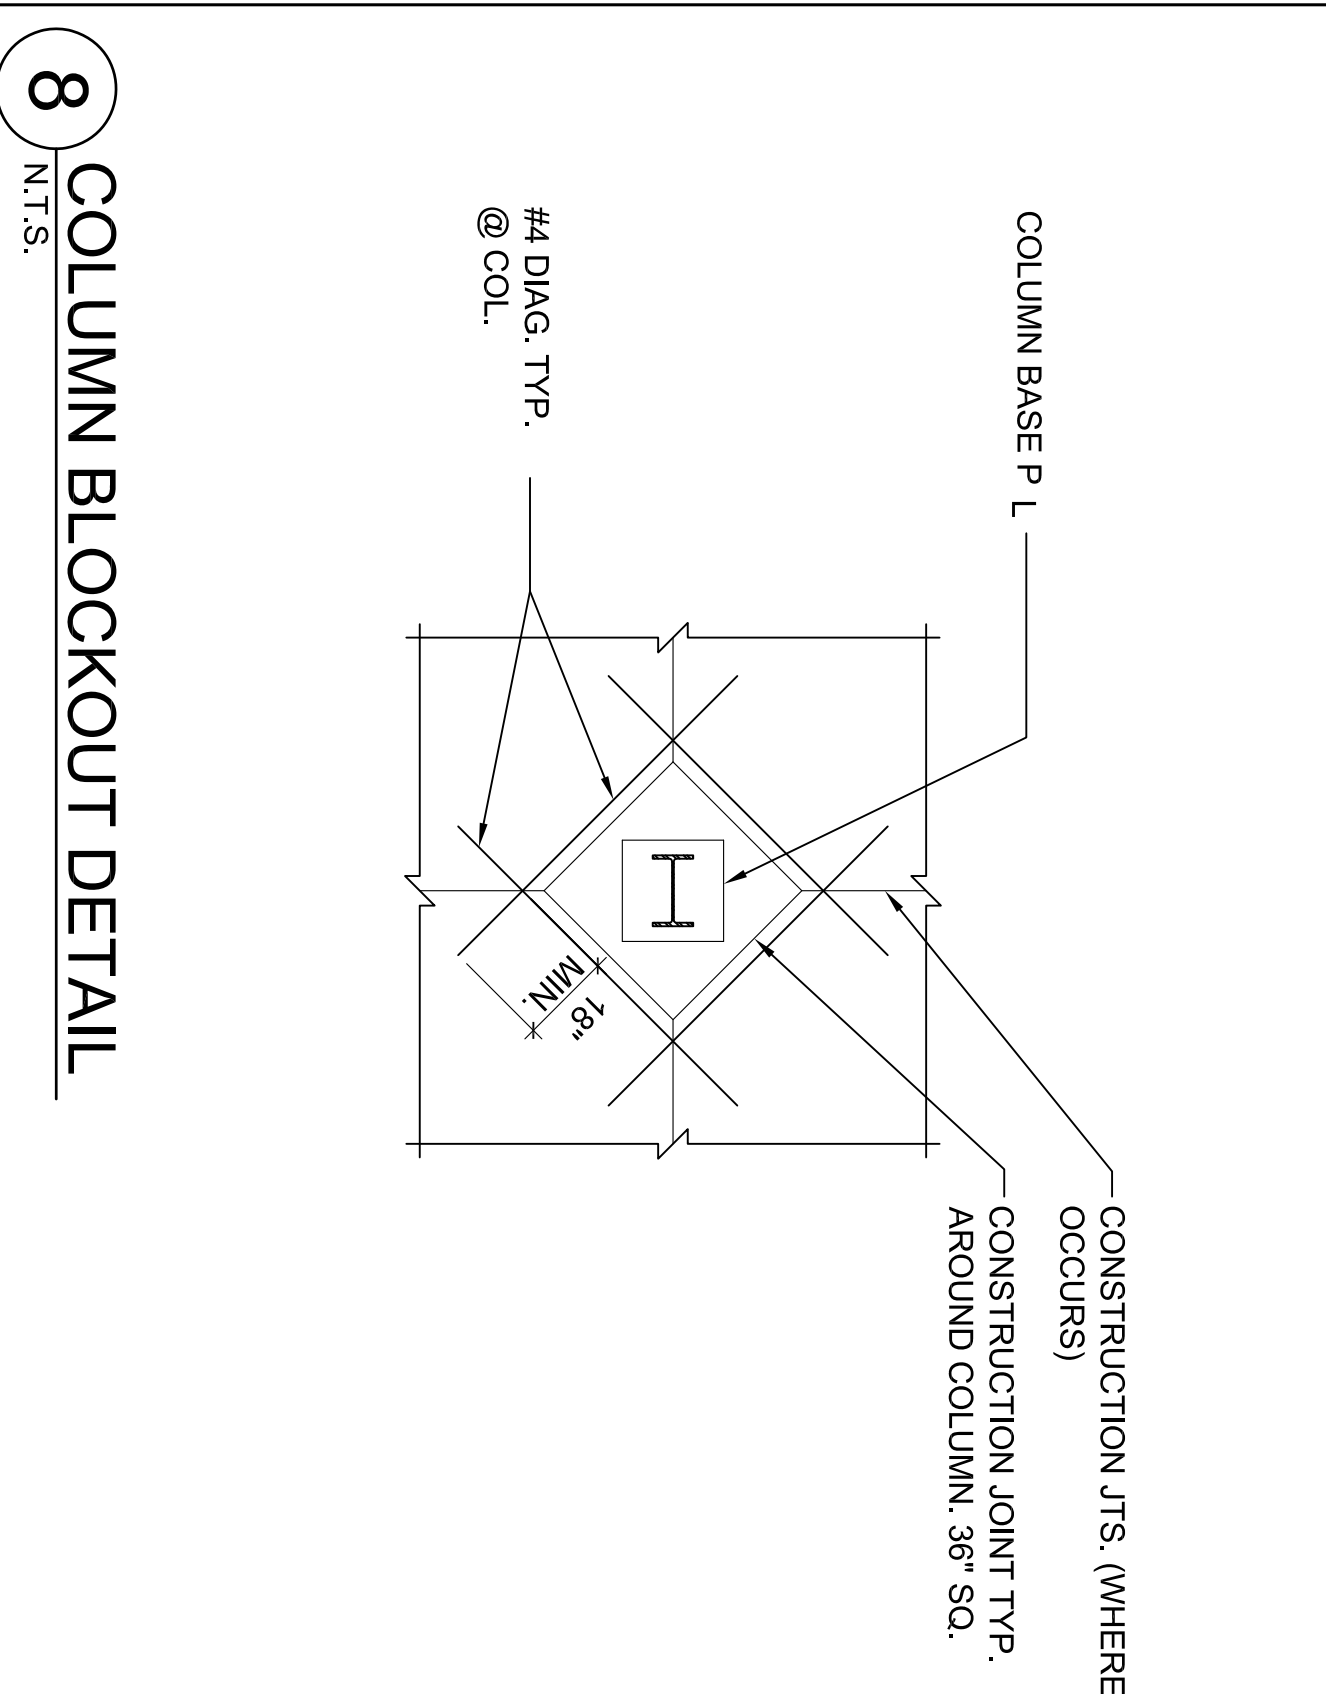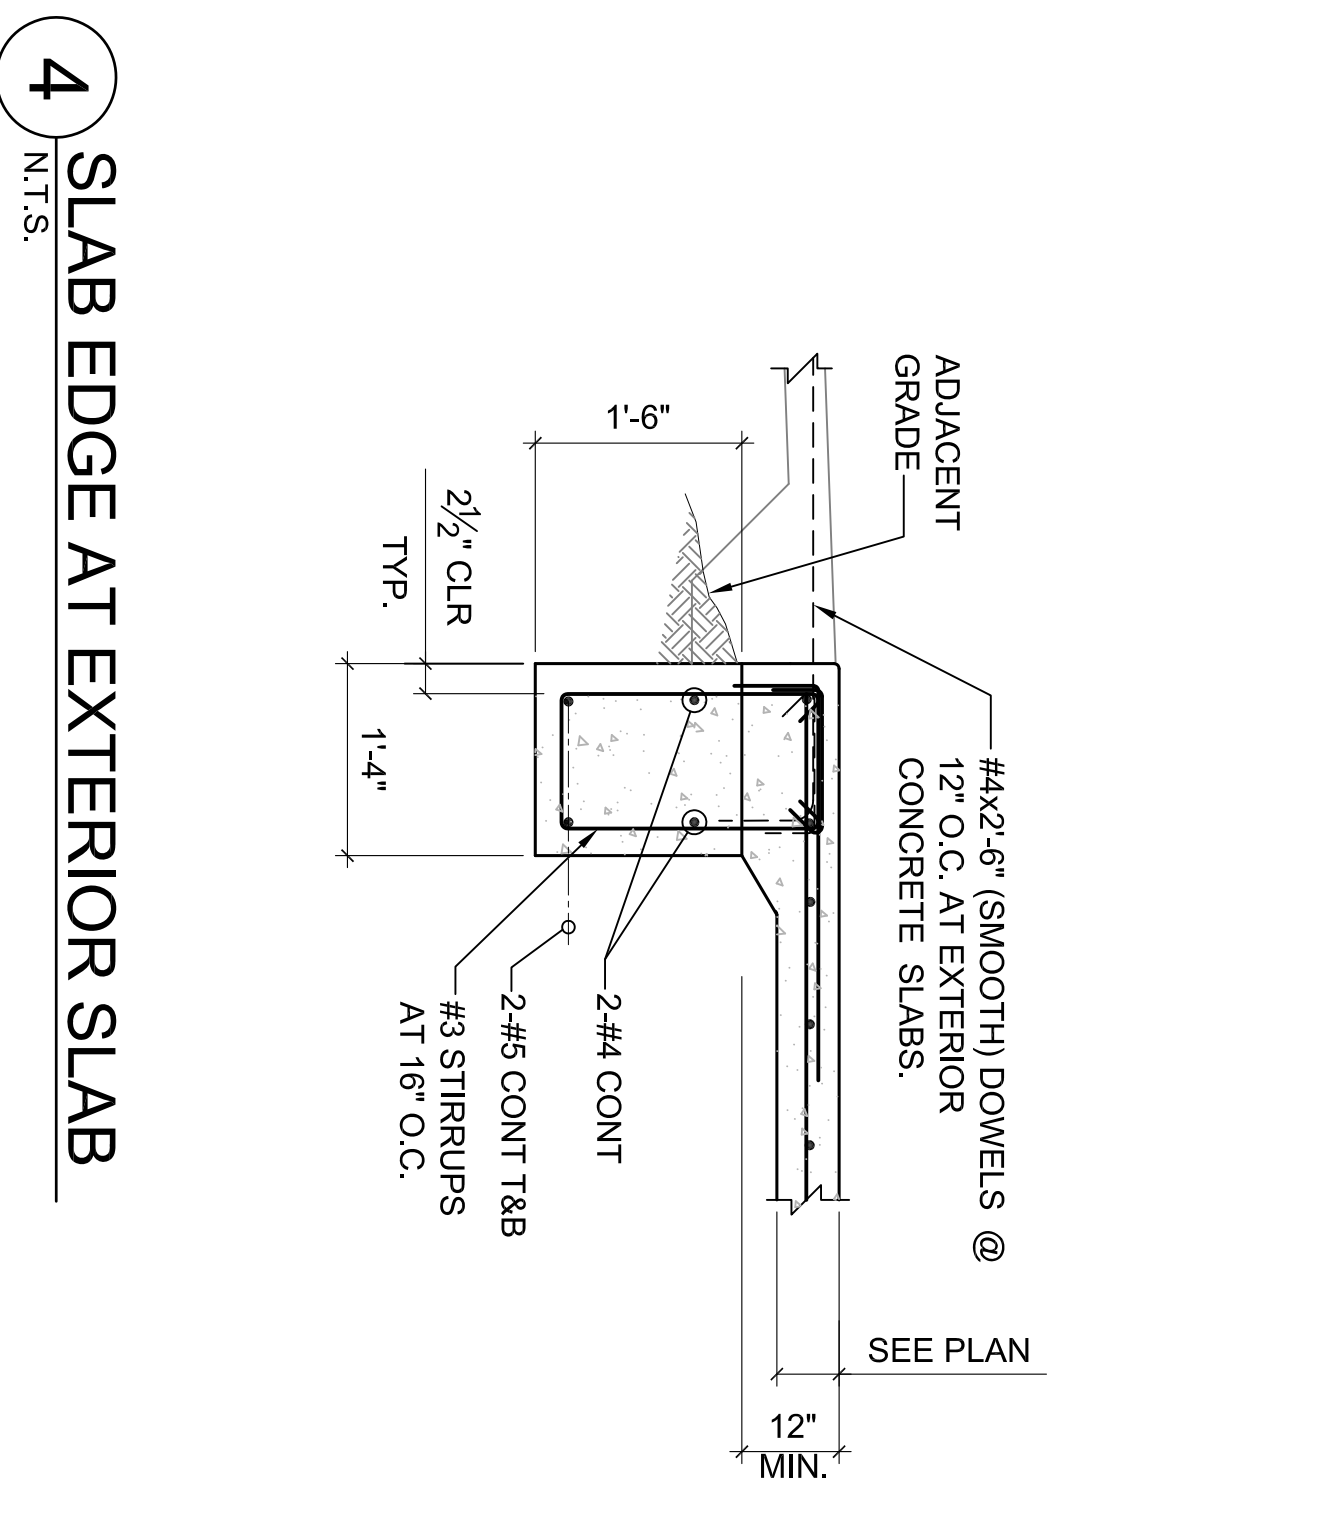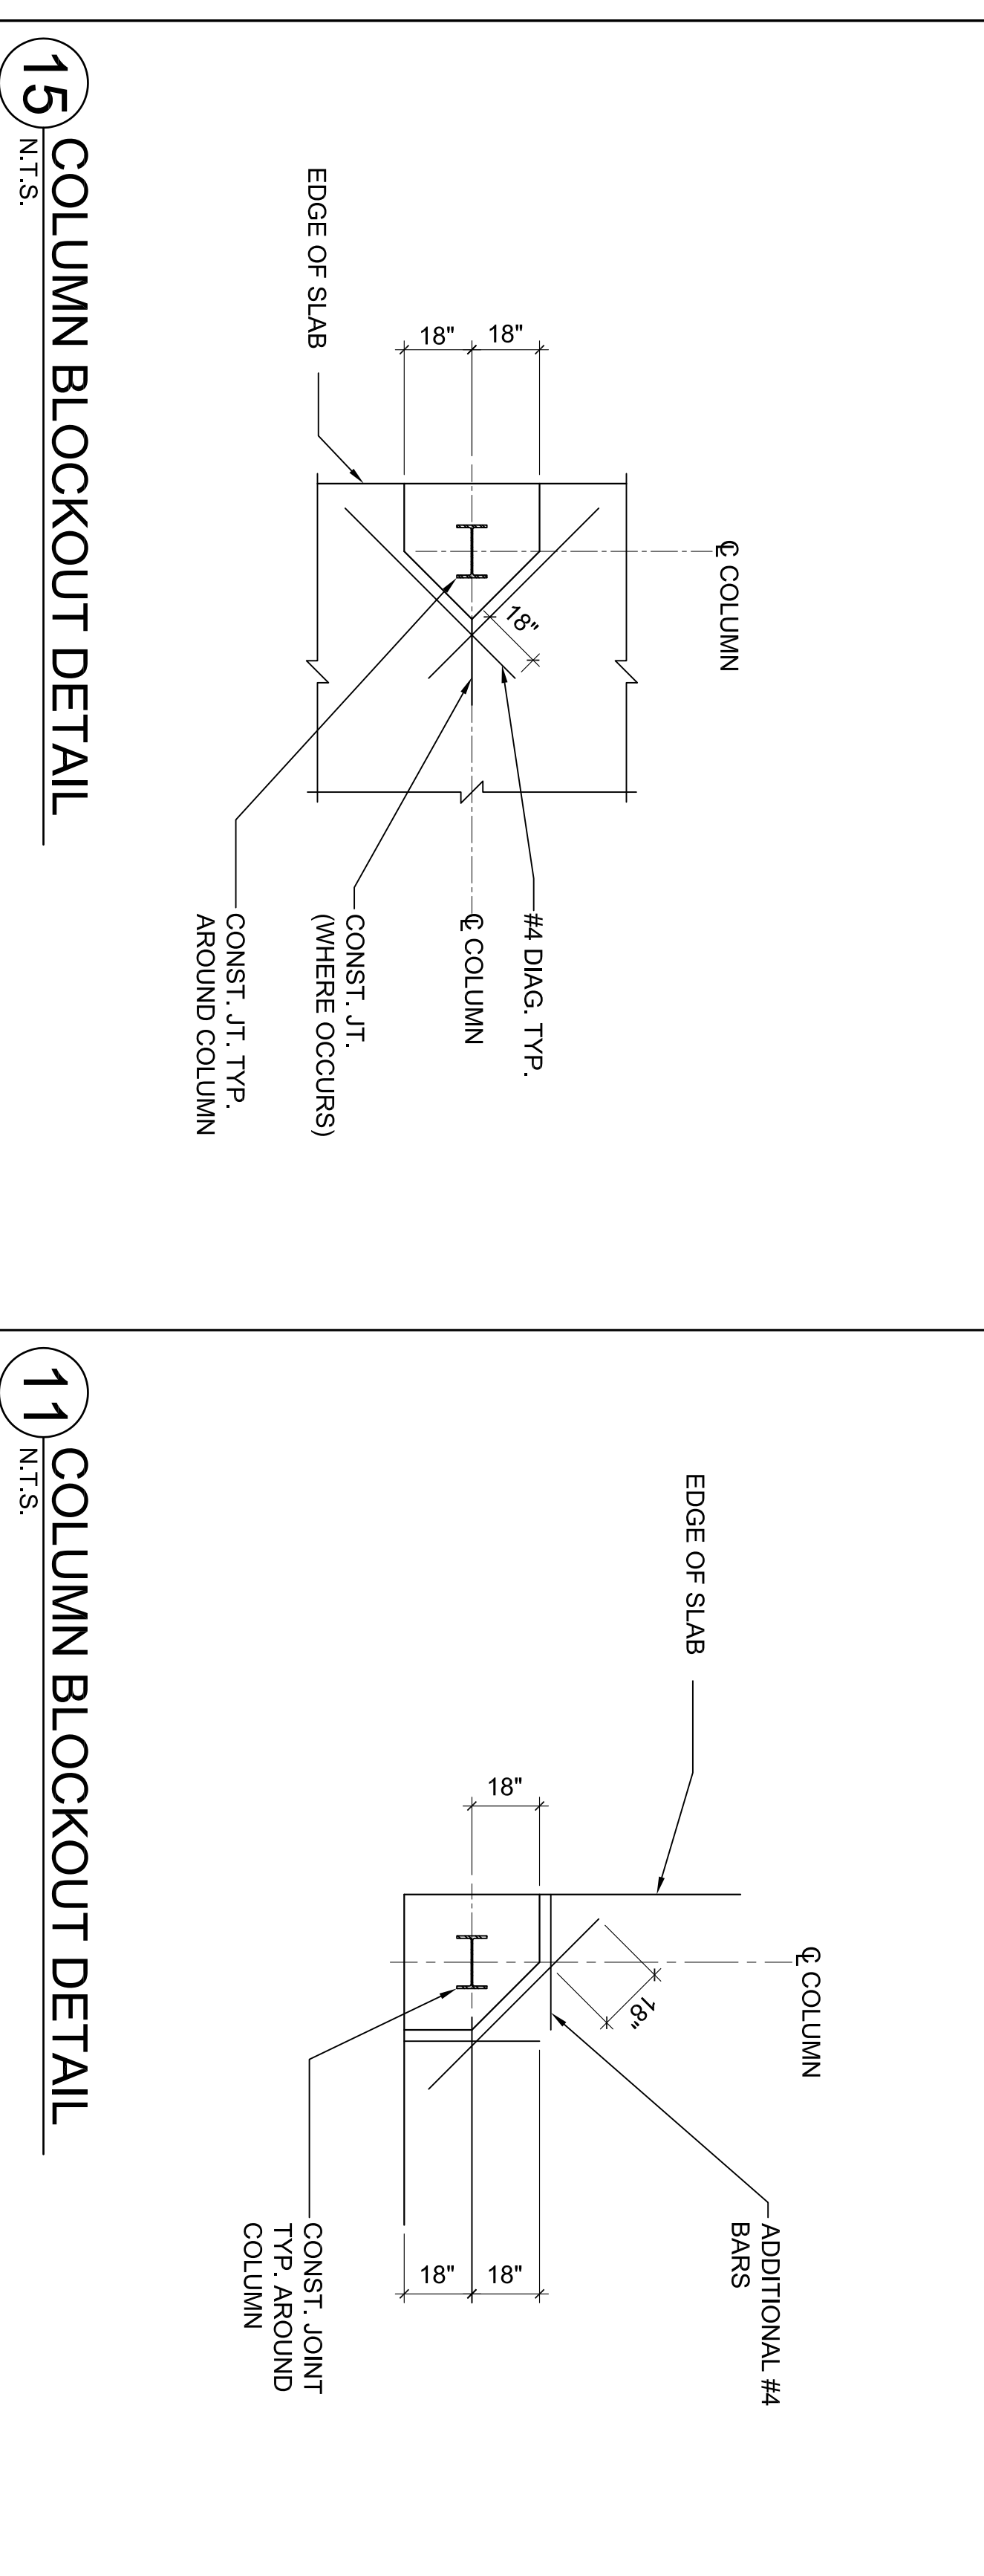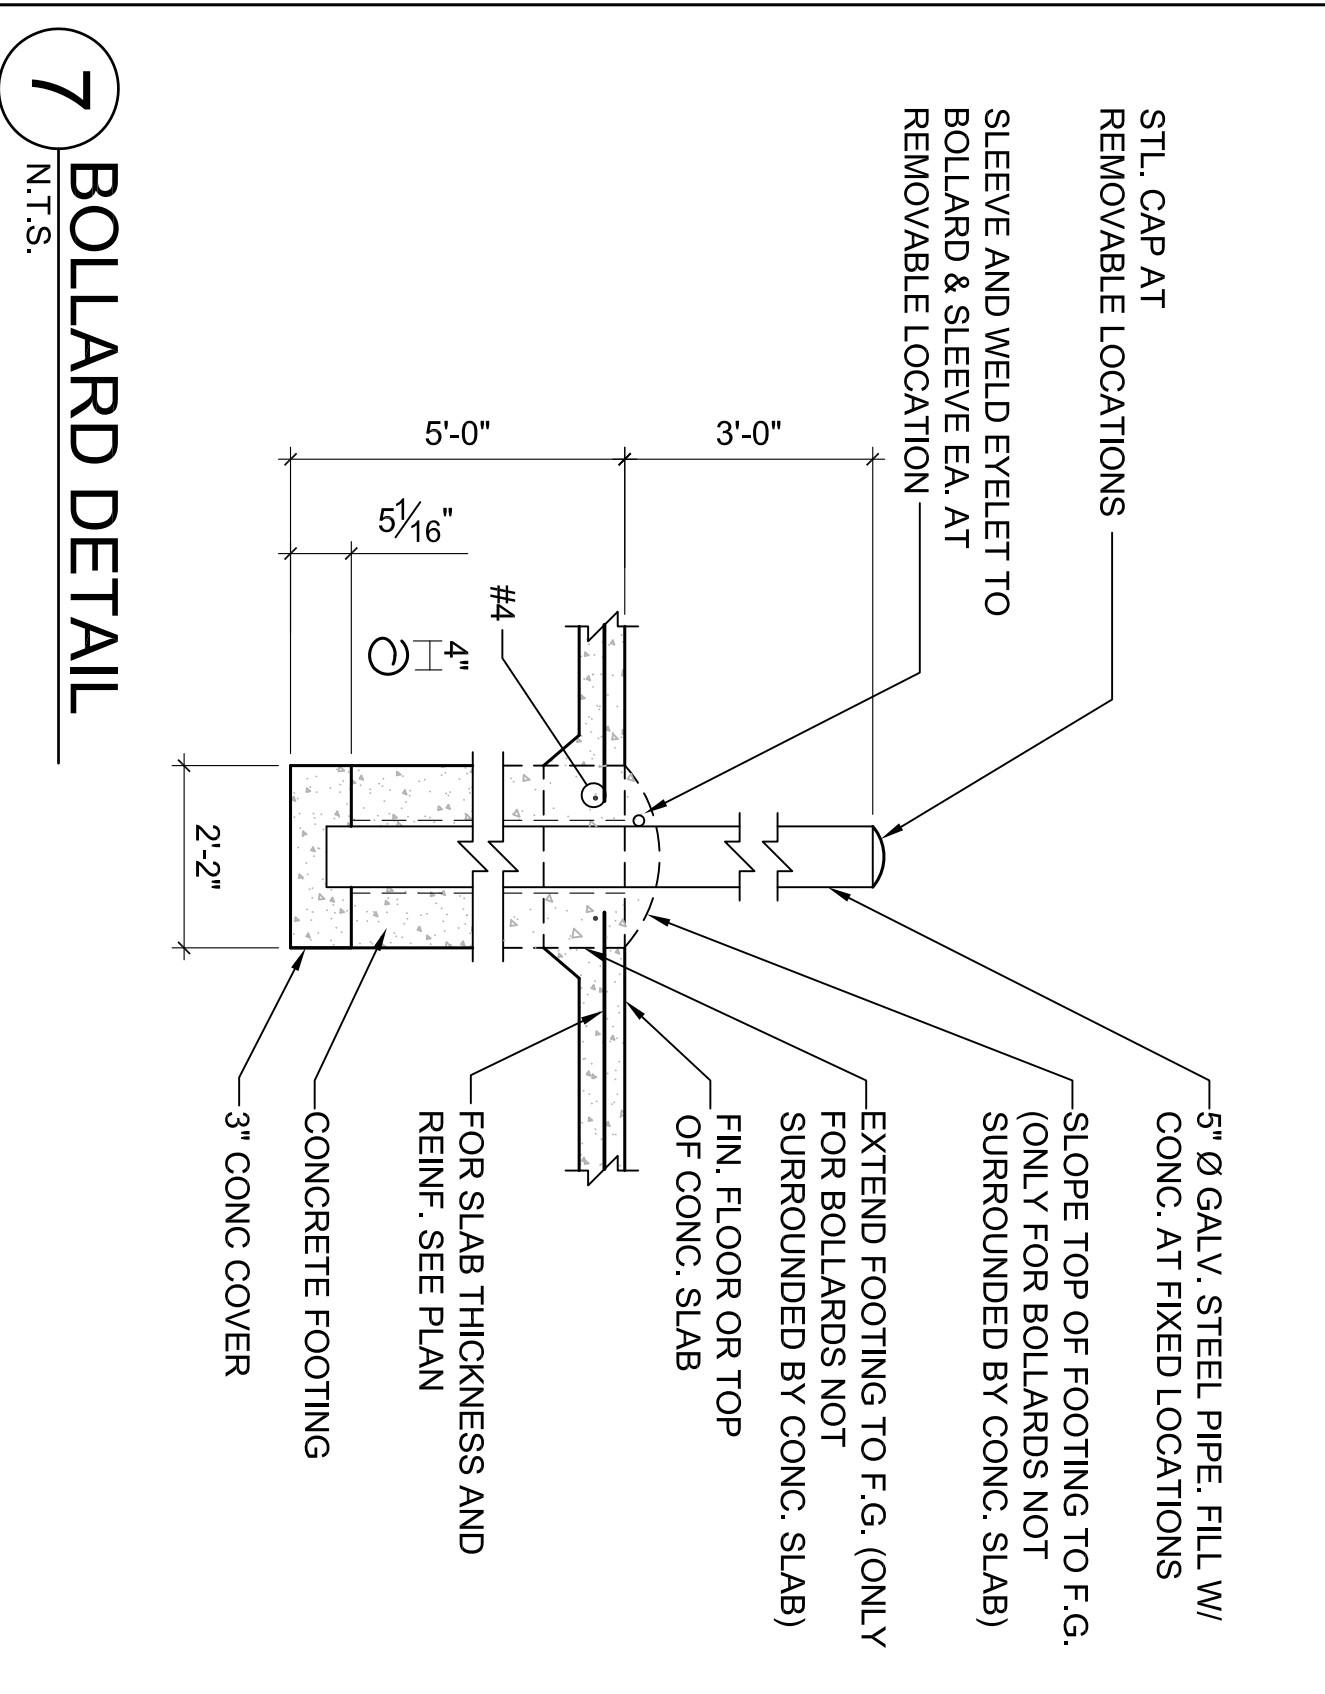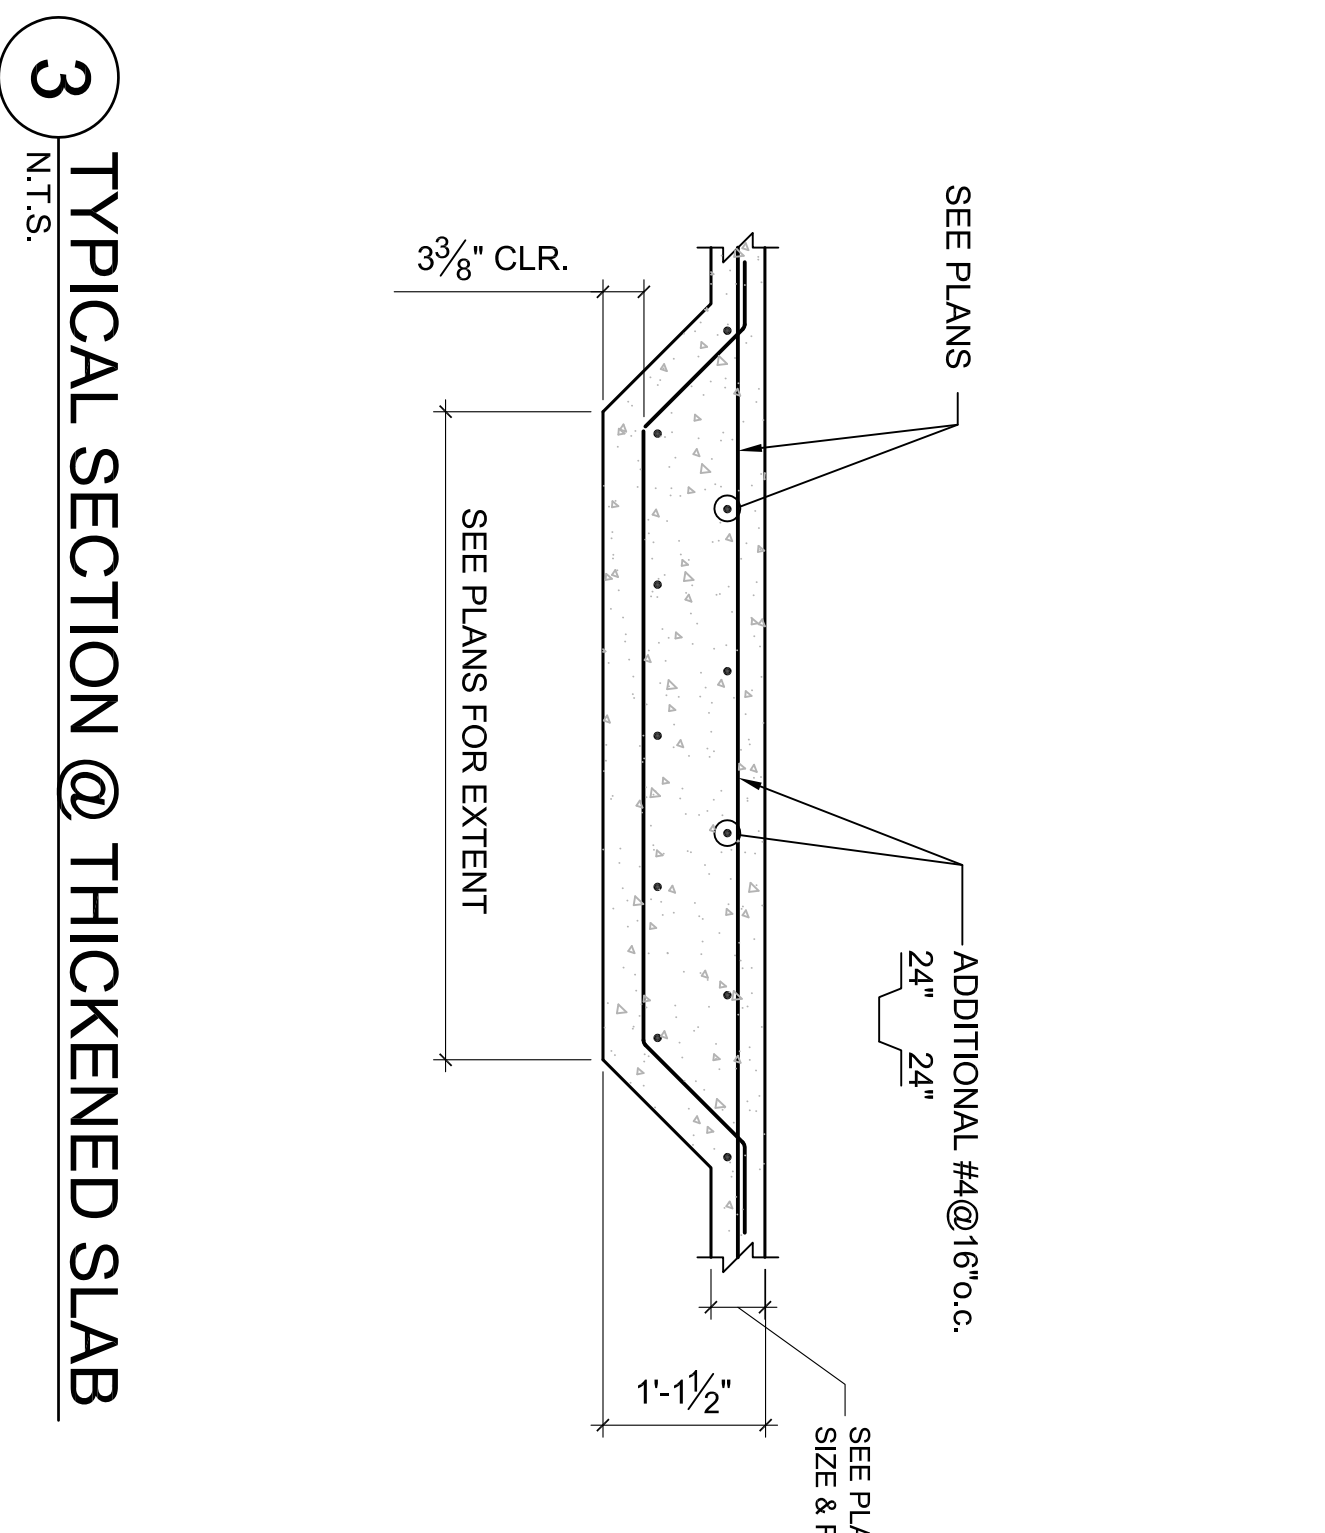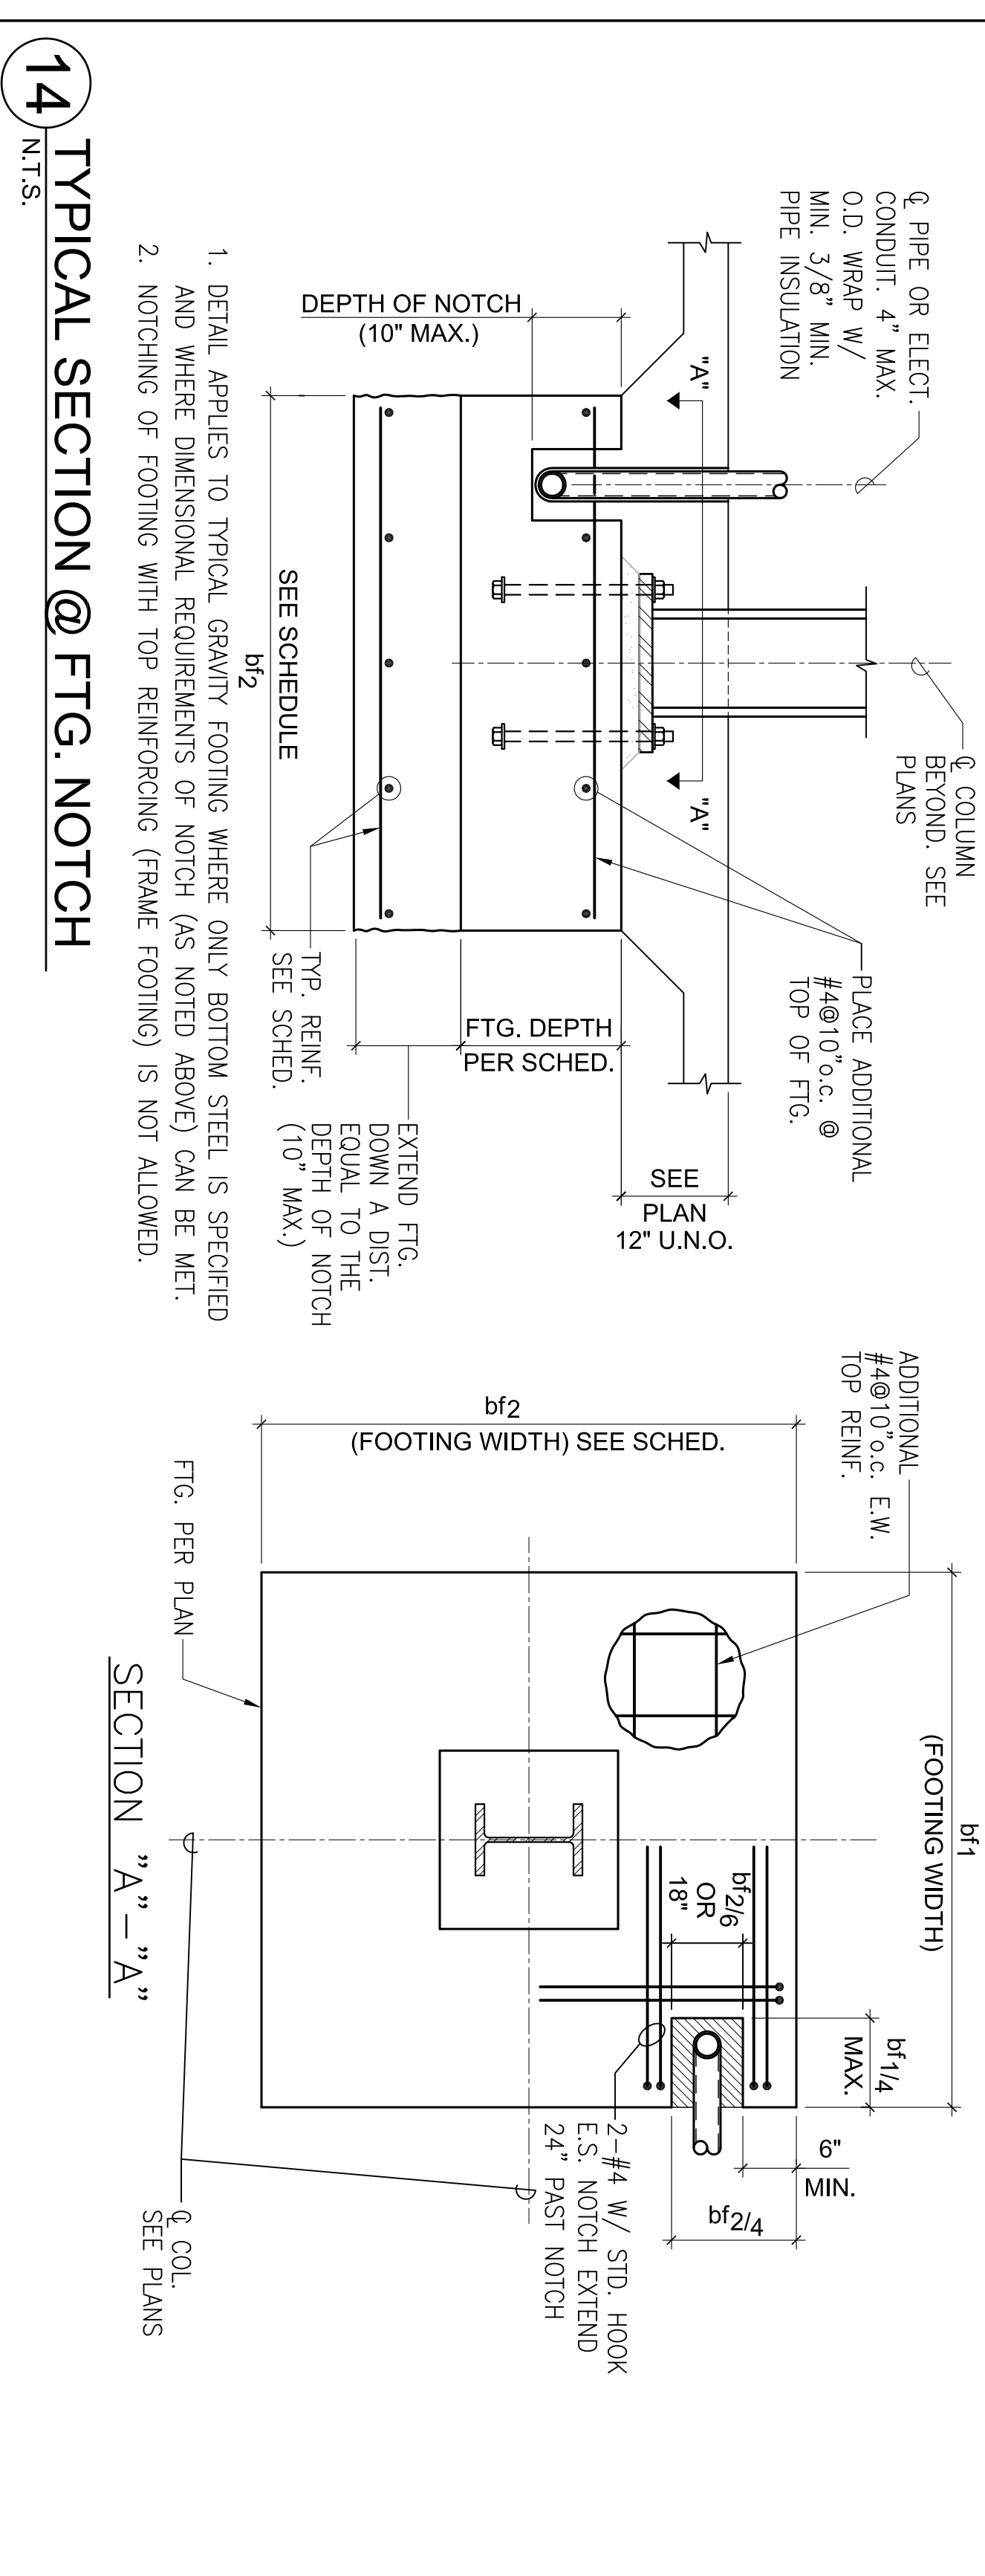


DECK MARK SECTION PLAN	DECK WELDS. SEE 10-12				REMARKS
	WELD TYPE	WELD	ATTACHMENT		
1	W2 FORMLOK	1 1/2" RIBBLE	4	12" B.P.	3 1/4" LWLT. CONC. FILL
2	W2 FORMLOK	1 1/2" RIBBLE	4	12" B.P.	4 1/4" LWLT. CONC. FILL

- SEE PLANS FOR ADDITIONAL WELDING REQUIREMENTS.
- ALL CONCRETE TOPPING SHALL BE REINFORCED WITH WWF 6x6-W2.3xW2.9, U.O.N.
- SIZES FOR WELD 'A' AND 'B' INDICATE THE SIZE OF THE EFFECTIVE FUSION AREA.

9 STEEL DECK SCHEDULE  
N.T.S.


MINIMUM SECTION PROPERTIES					
SECTION TYPE	THICKNESS (GA)	I (IN <sup>4</sup> /FT)	S (IN <sup>3</sup> /FT)	DECK EMBEDDED (COMPOSITE)	
W2-FORMLOK	18 GA.	.555	.510	.511	YES

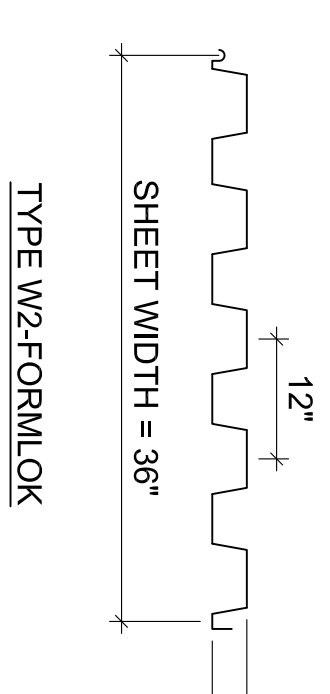

ICC REPORT # ER-20789


5 METAL DECK PROFILE  
N.T.S.

6 DETAIL AT DECK CHANGE  
N.T.S.

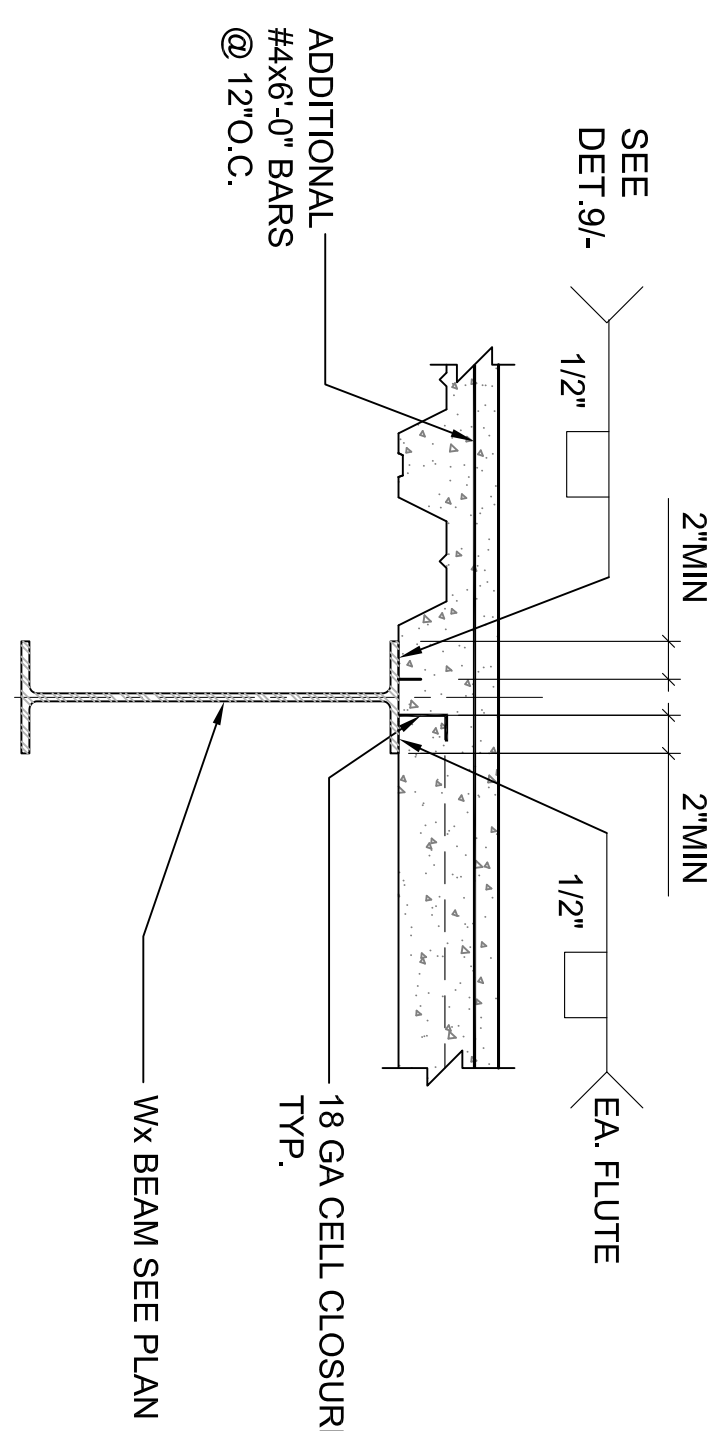


OVERHANG	EDGE FORM SIZE	WELD "A"
b ≤ 6"	14 GA	1/8"
6 < b ≤ 9"	12 GA	5/32"
9 < b ≤ 12"	10 GA	3/16"


1 EDGE DETAIL - DECK PERPENDICULAR  
N.T.S.

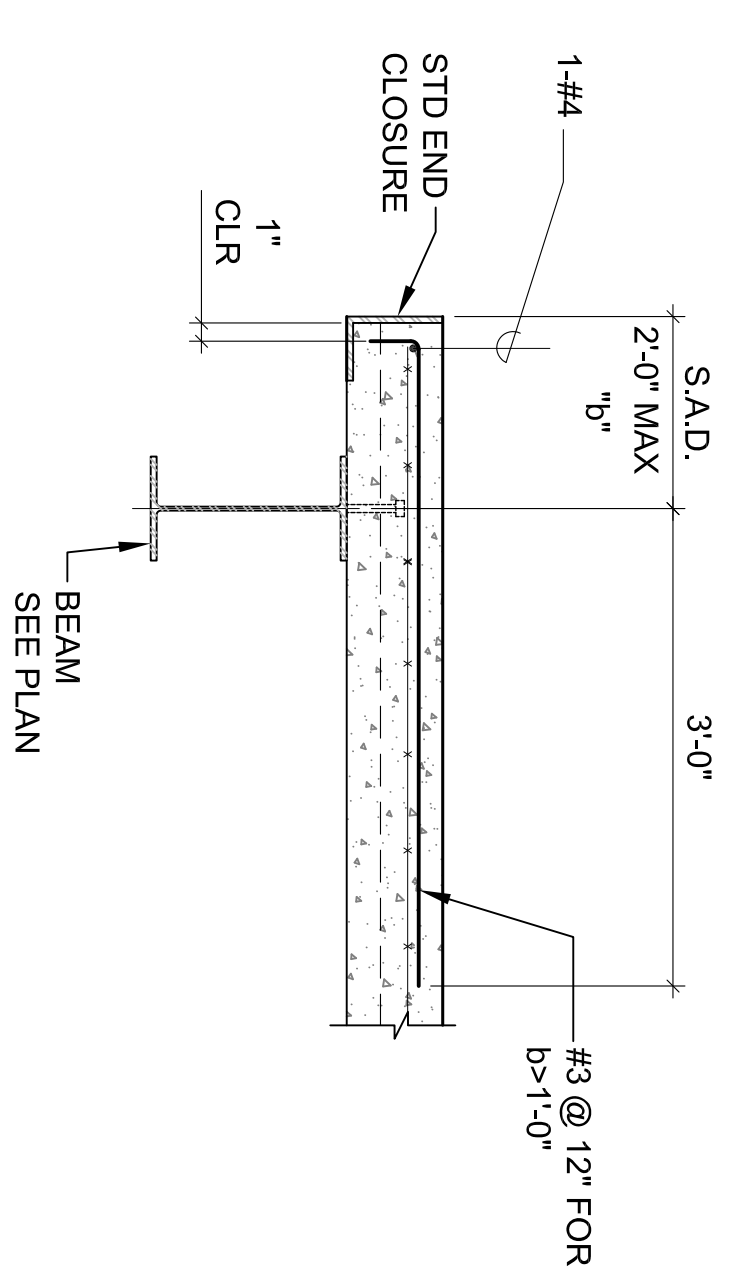


10 METAL DECK WELD DETAILS  
N.T.S.

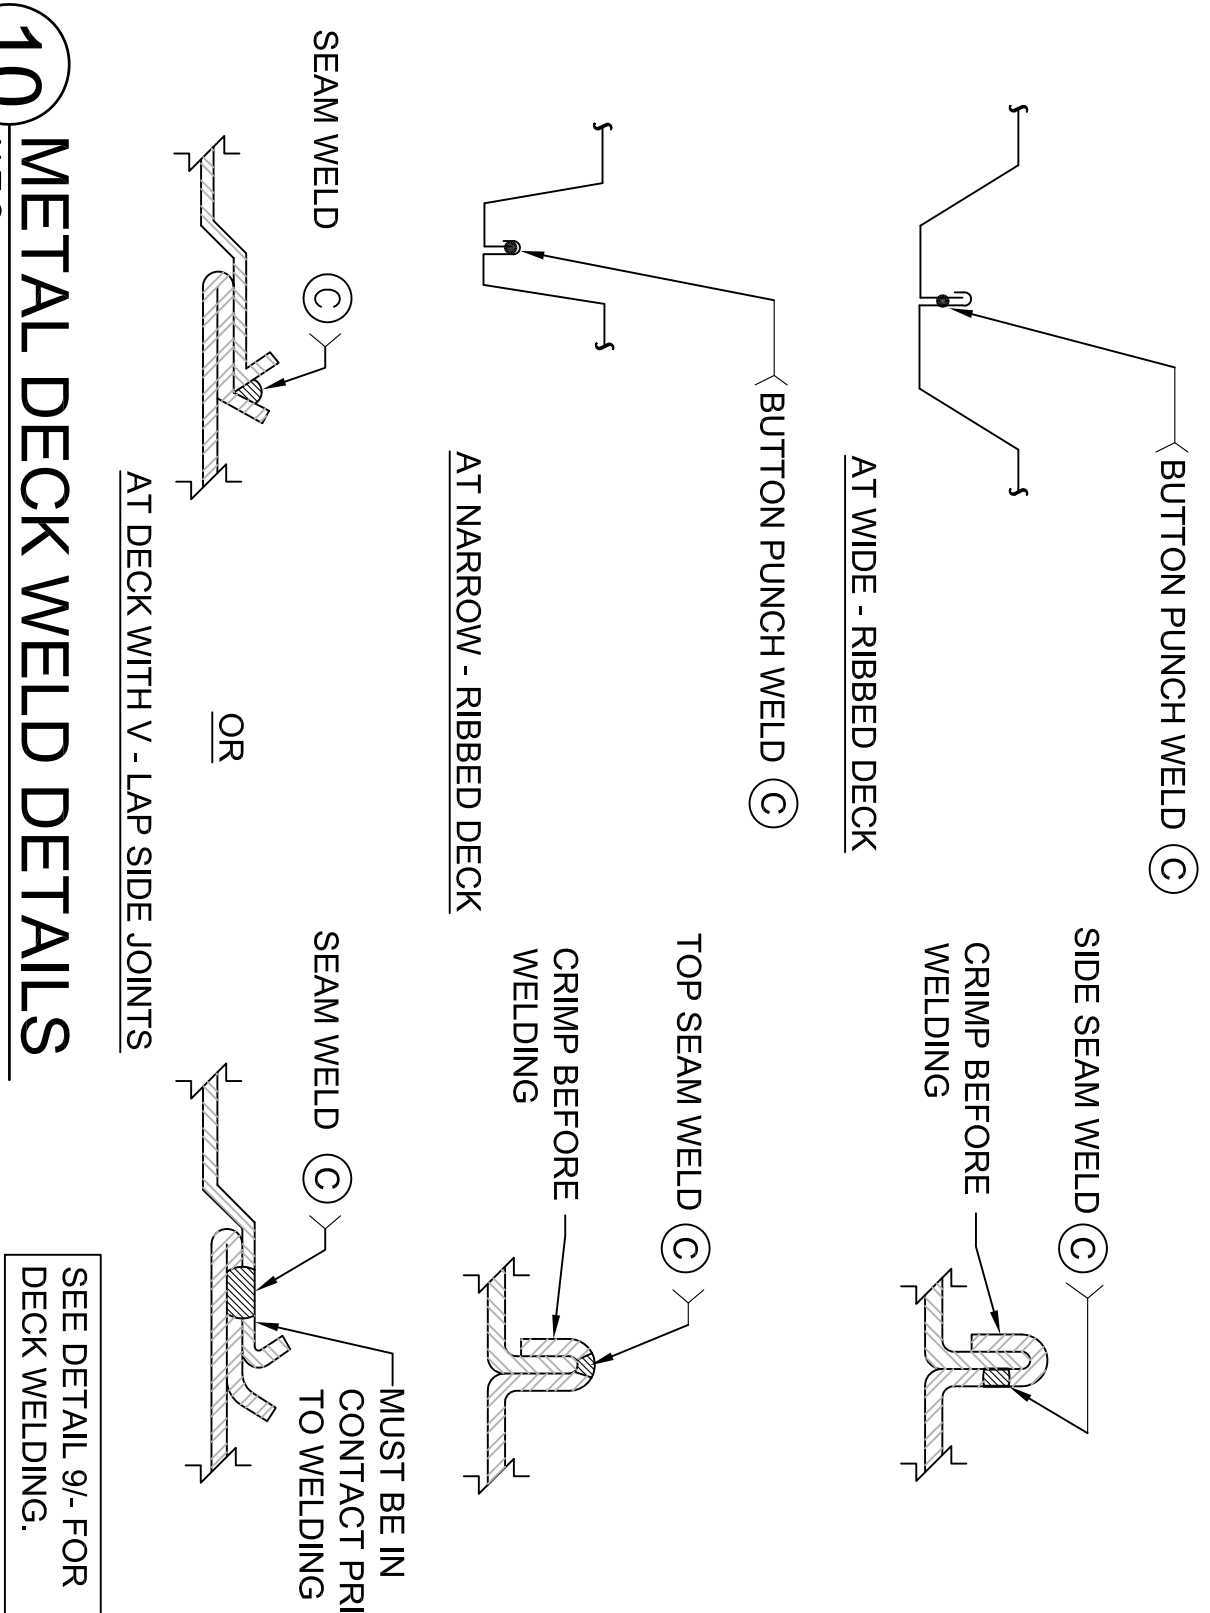

11 BEAM PARALLEL TO DECK  
N.T.S.

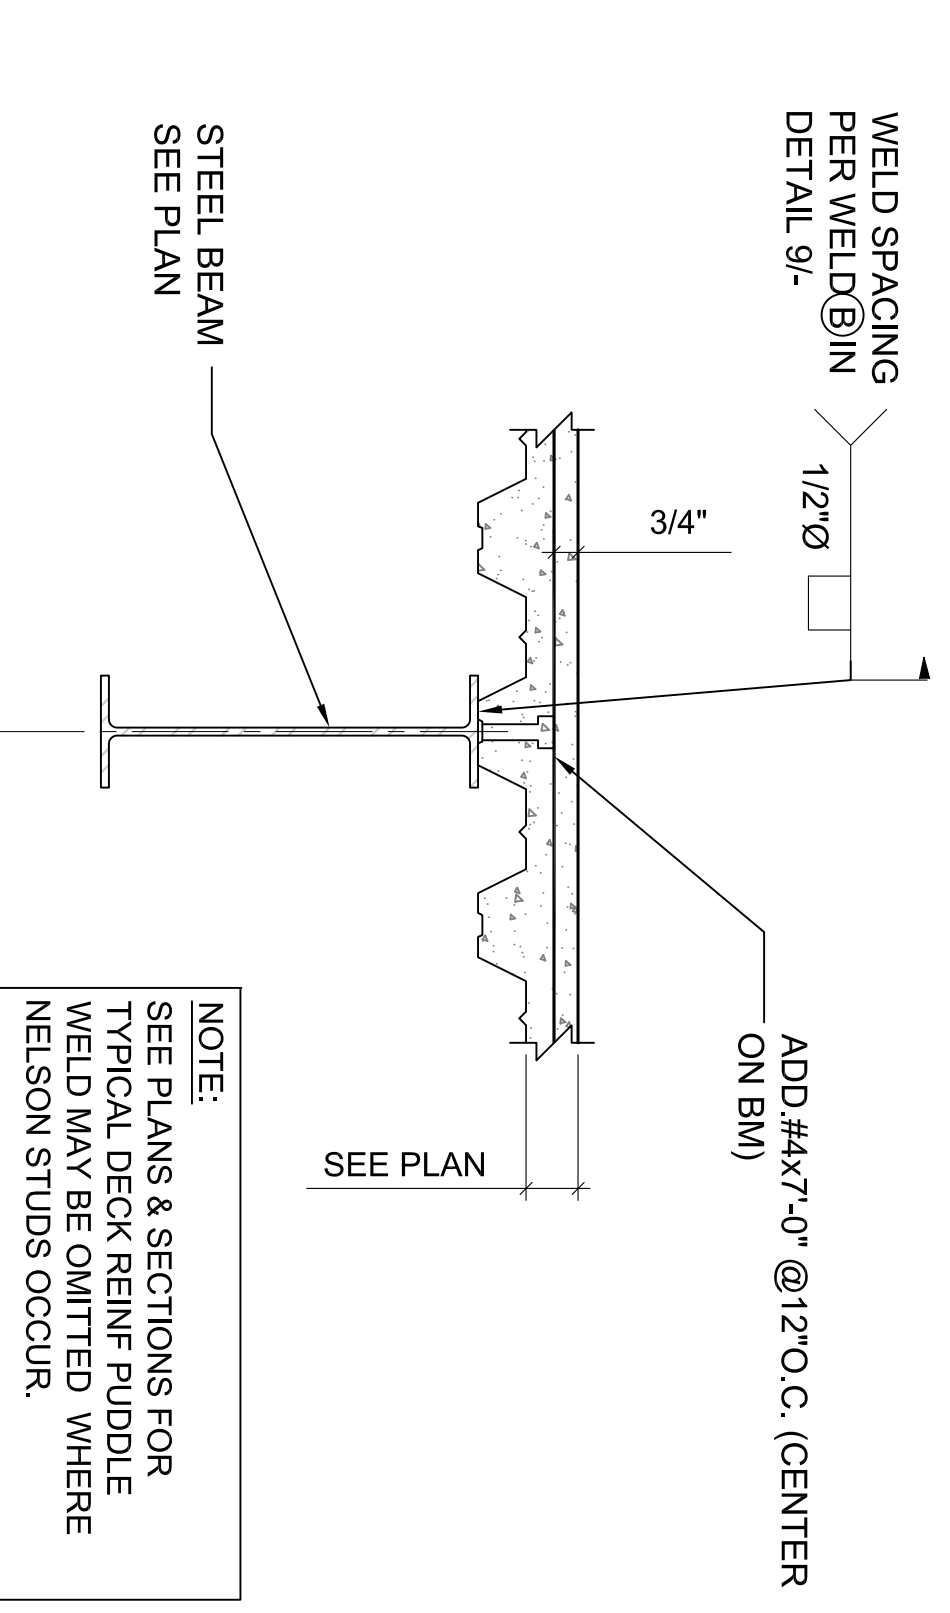





7 TYP. BRACE @ COMPOSITE DECK  
N.T.S.

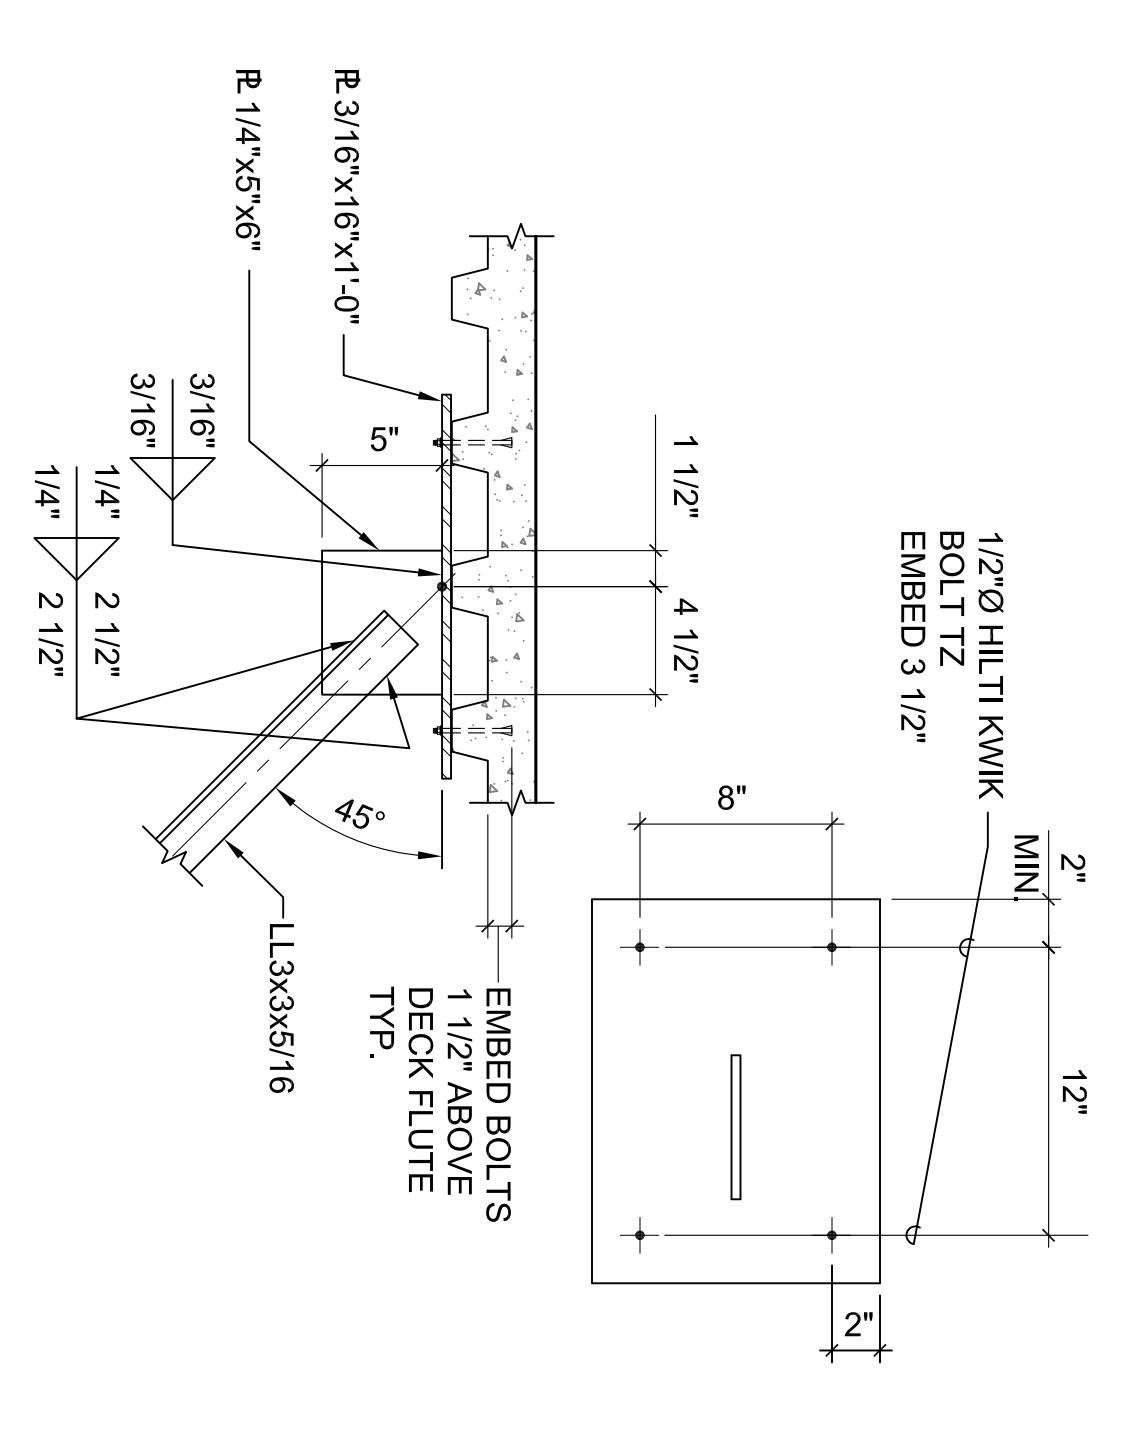


SEE DETAIL 9c FOR DECK WELDING.

SEE STEEL DECK WELDING SCHEDULE NOTES AND OTHER DETAILS

12 STEEL DECK TO BEAM WELD DETAILS  
N.T.S.

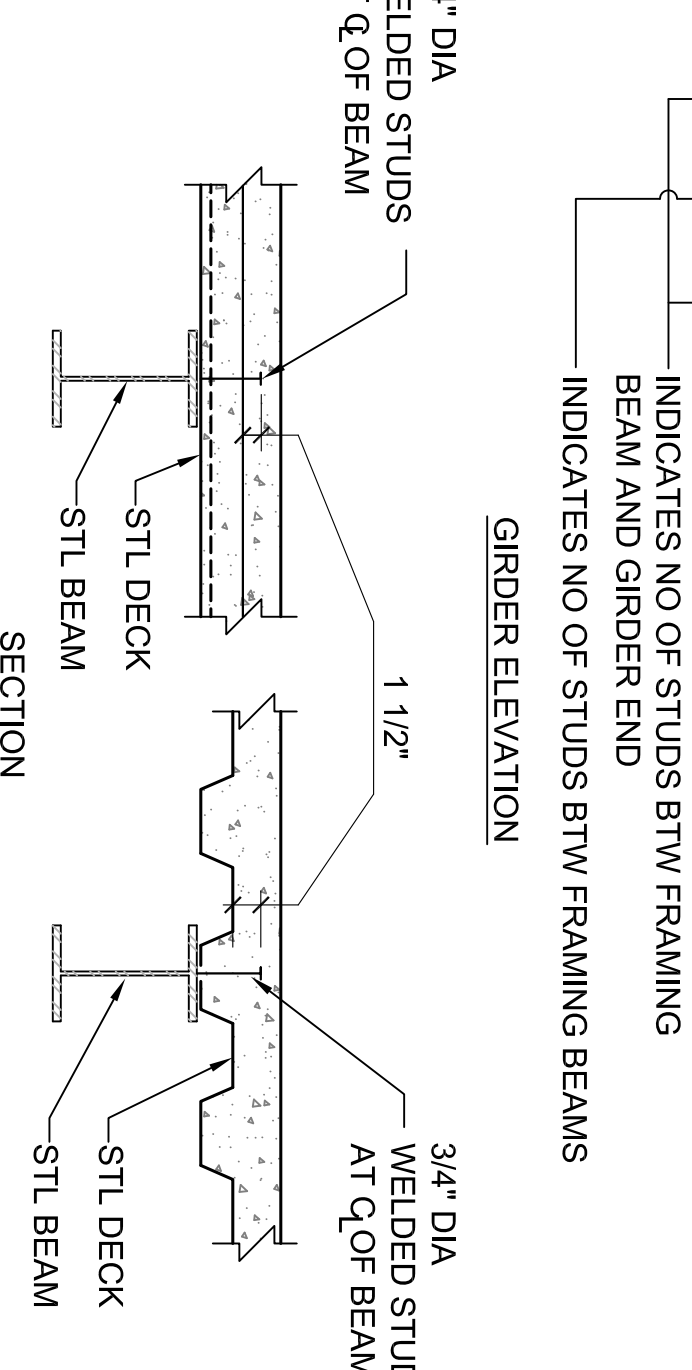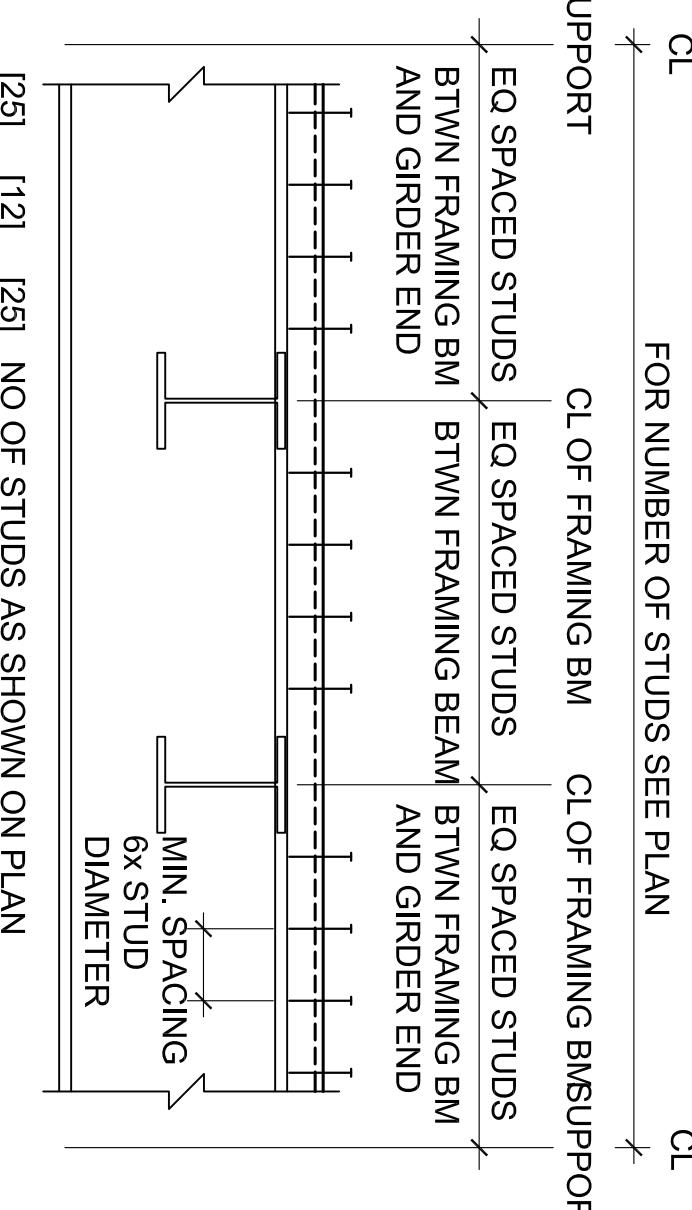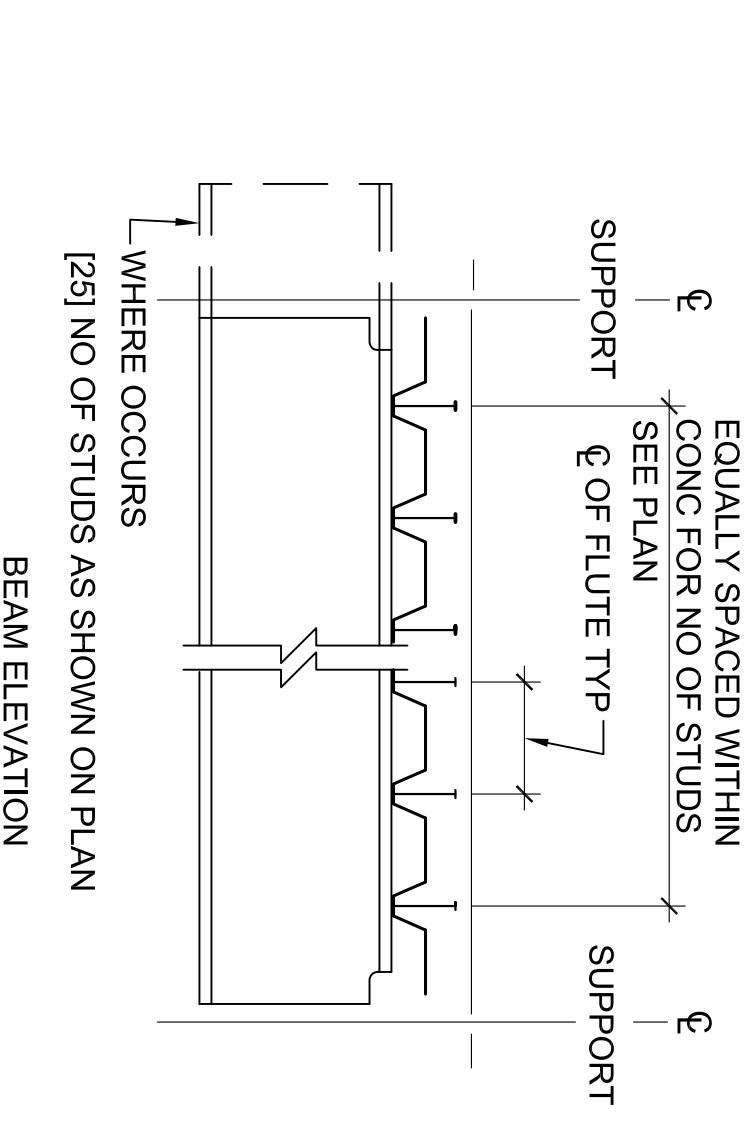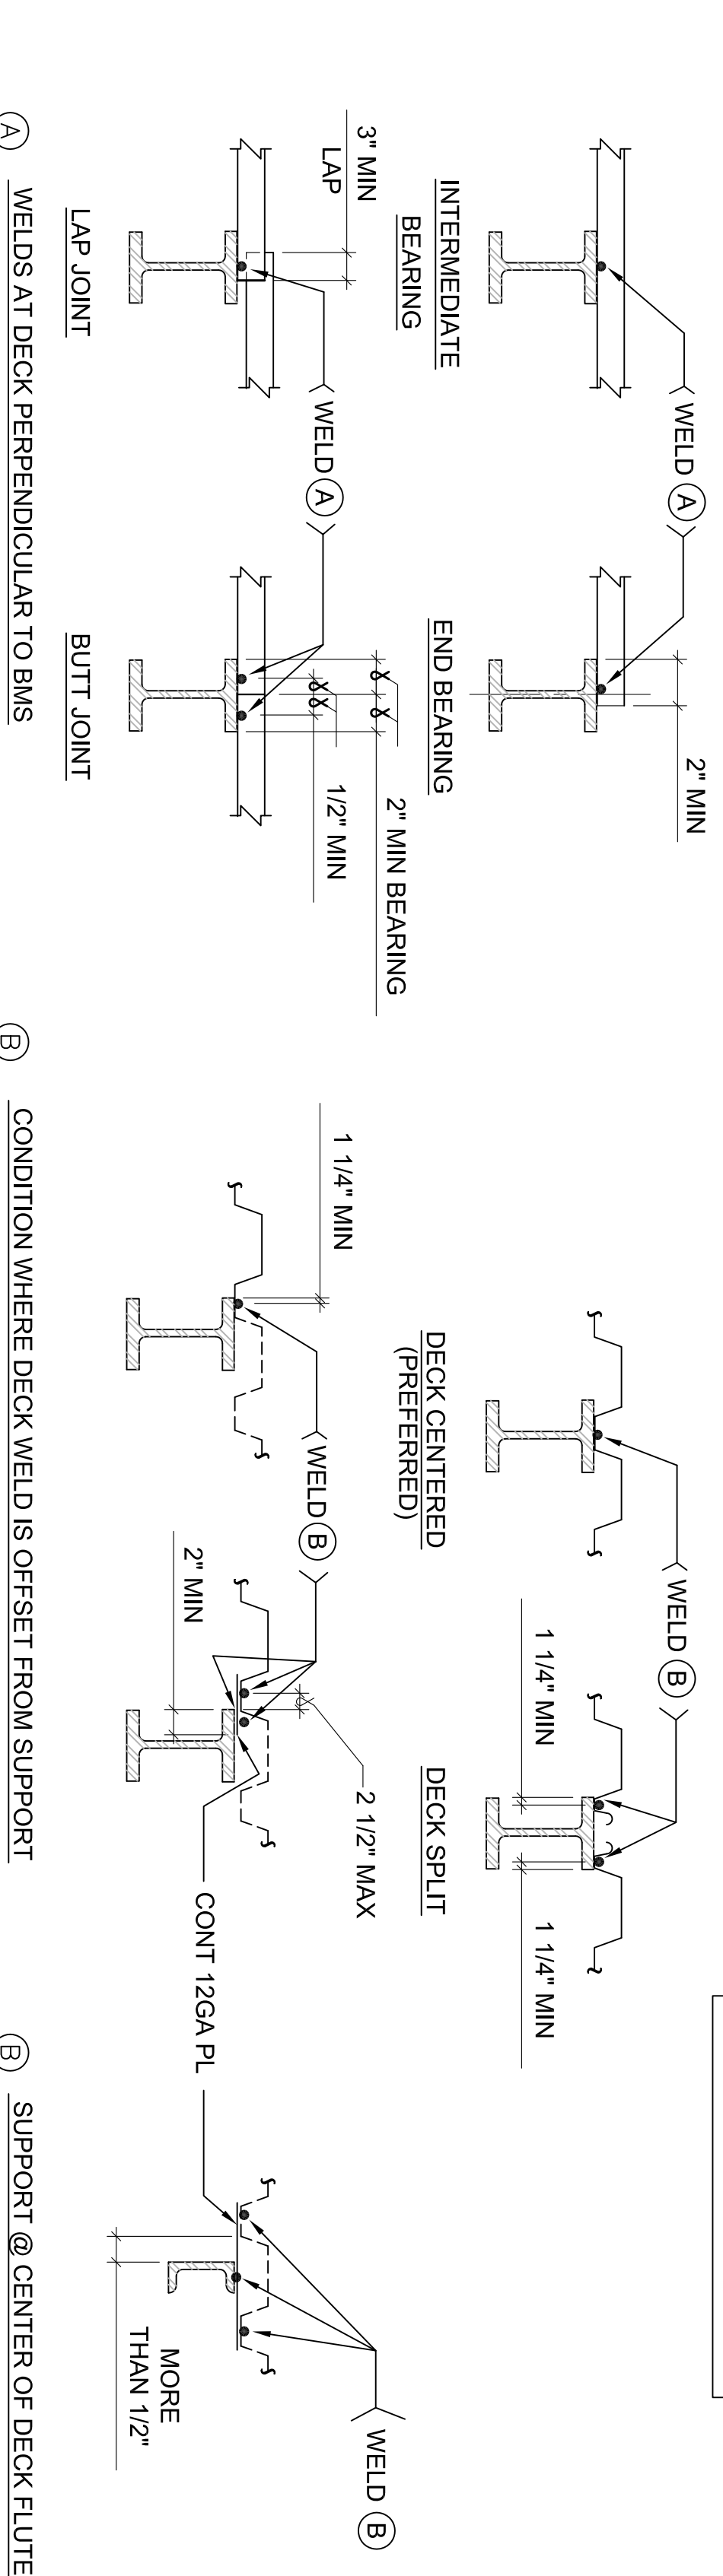


14 WELDED HEADED ANCHOR STUD DETAILS  
N.T.S.

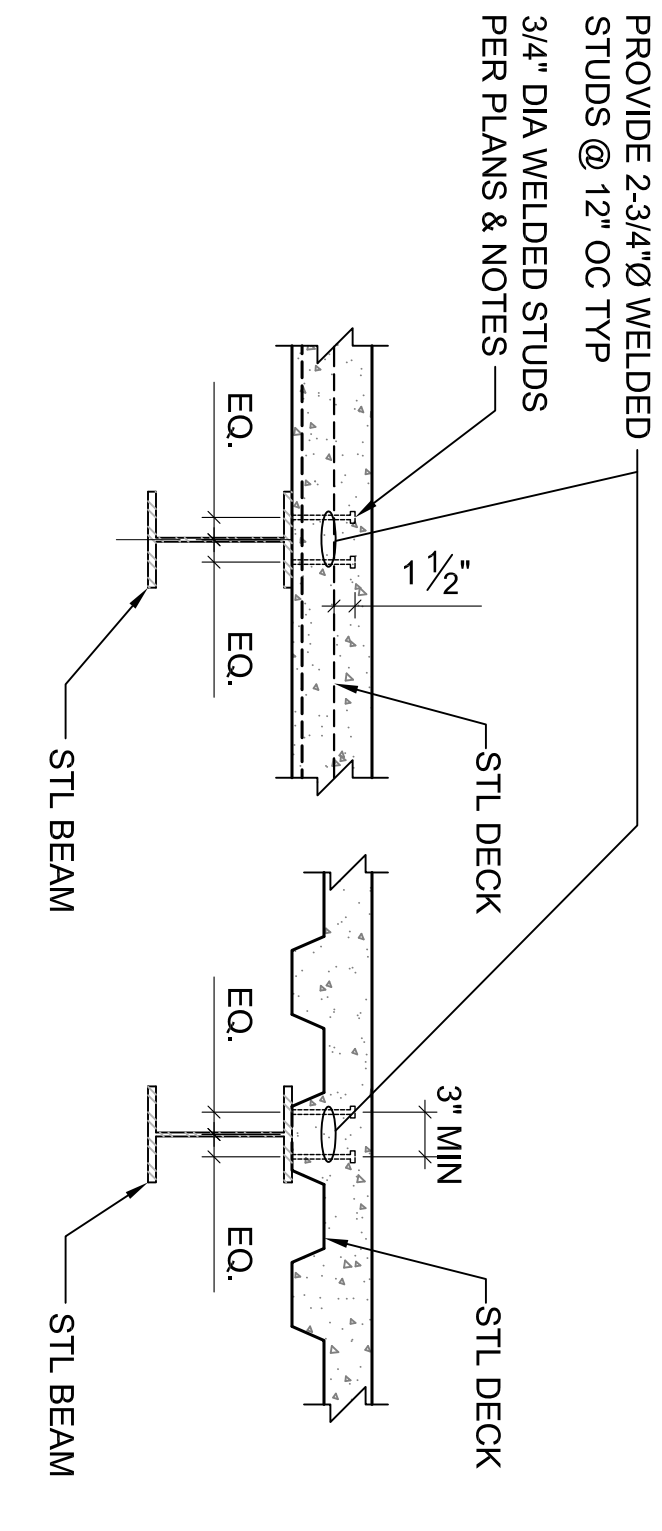


- SEE 14 - FOR ADDITIONAL INFORMATION.
- SEE PLAN & PLAN NOTES FOR STUD SPACING.

15 WELDED HEADED ANCHOR STUDS AT COLLECTOR & FRAME BEAMS  
N.T.S.

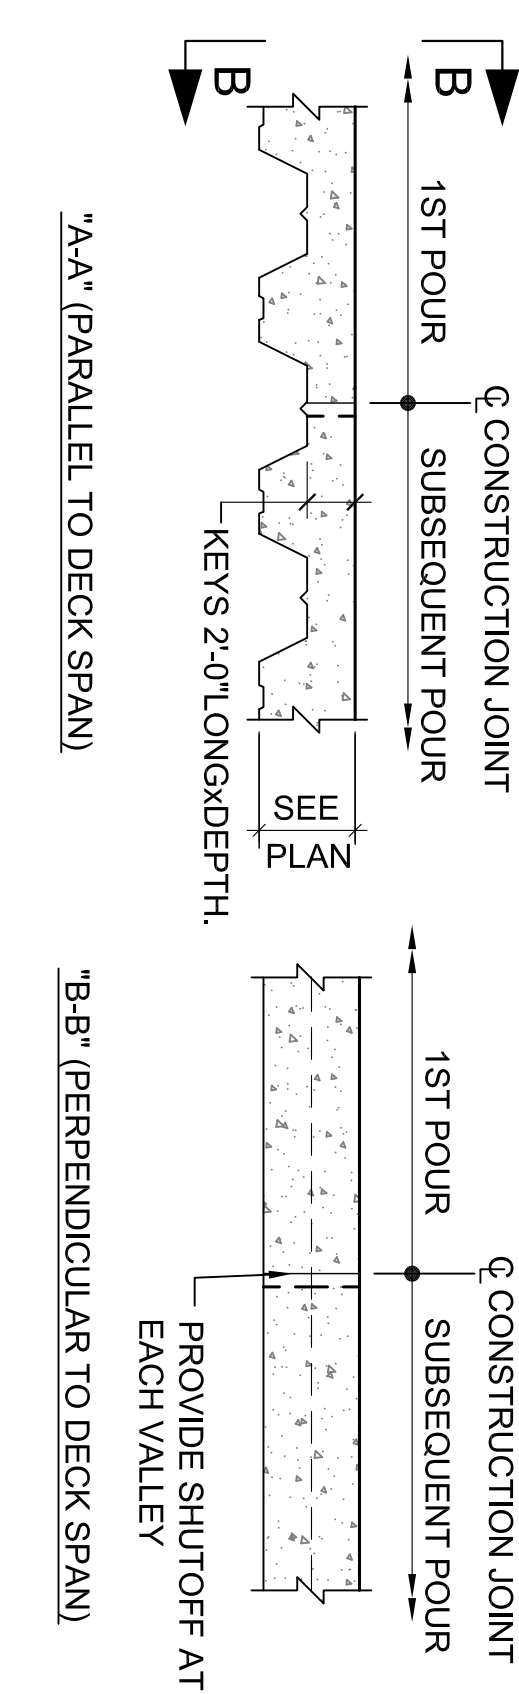


- REINFC. CONT. THRU JOINT, U.O.N. (2'-0" MIN.)
- SEE PLAN OR SPECIFICATIONS FOR LOCATION OF C.I.'S

16 CONSTRUCTION JOINT IN CONCRETE / DECK  
N.T.S.

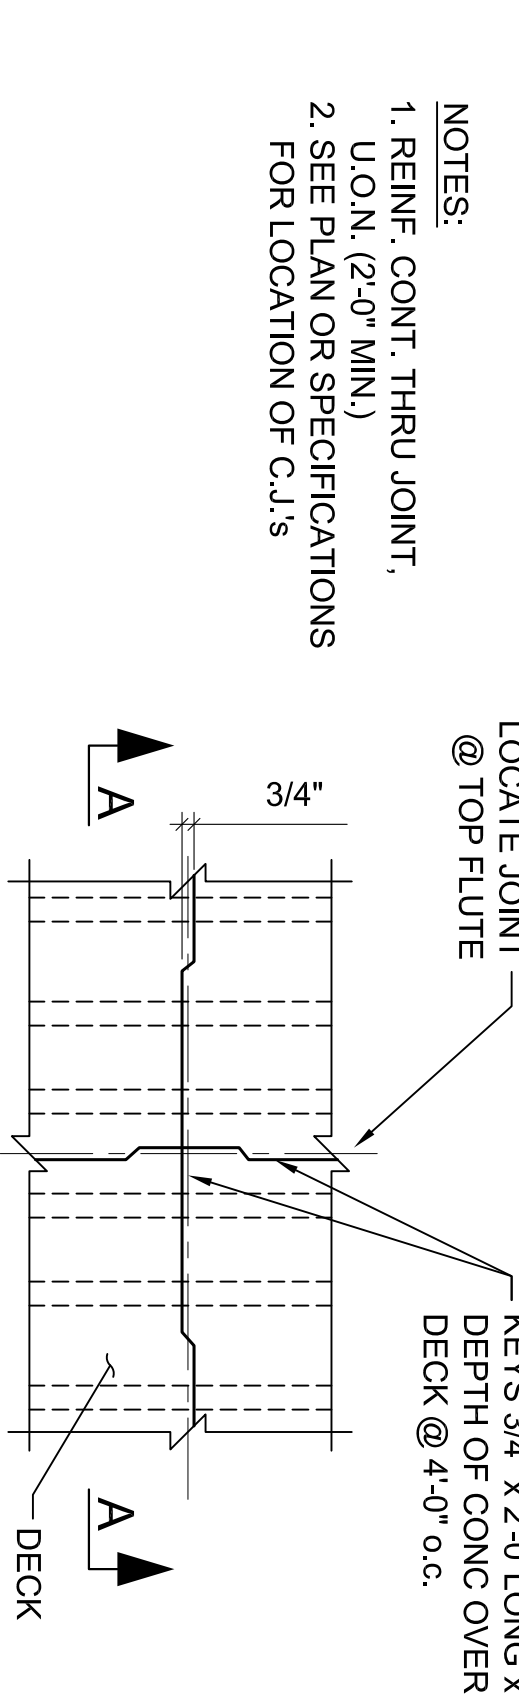


4 TYPICAL COMPOSITE PARALLEL METAL DECK EDGE DETAIL  
N.T.S.

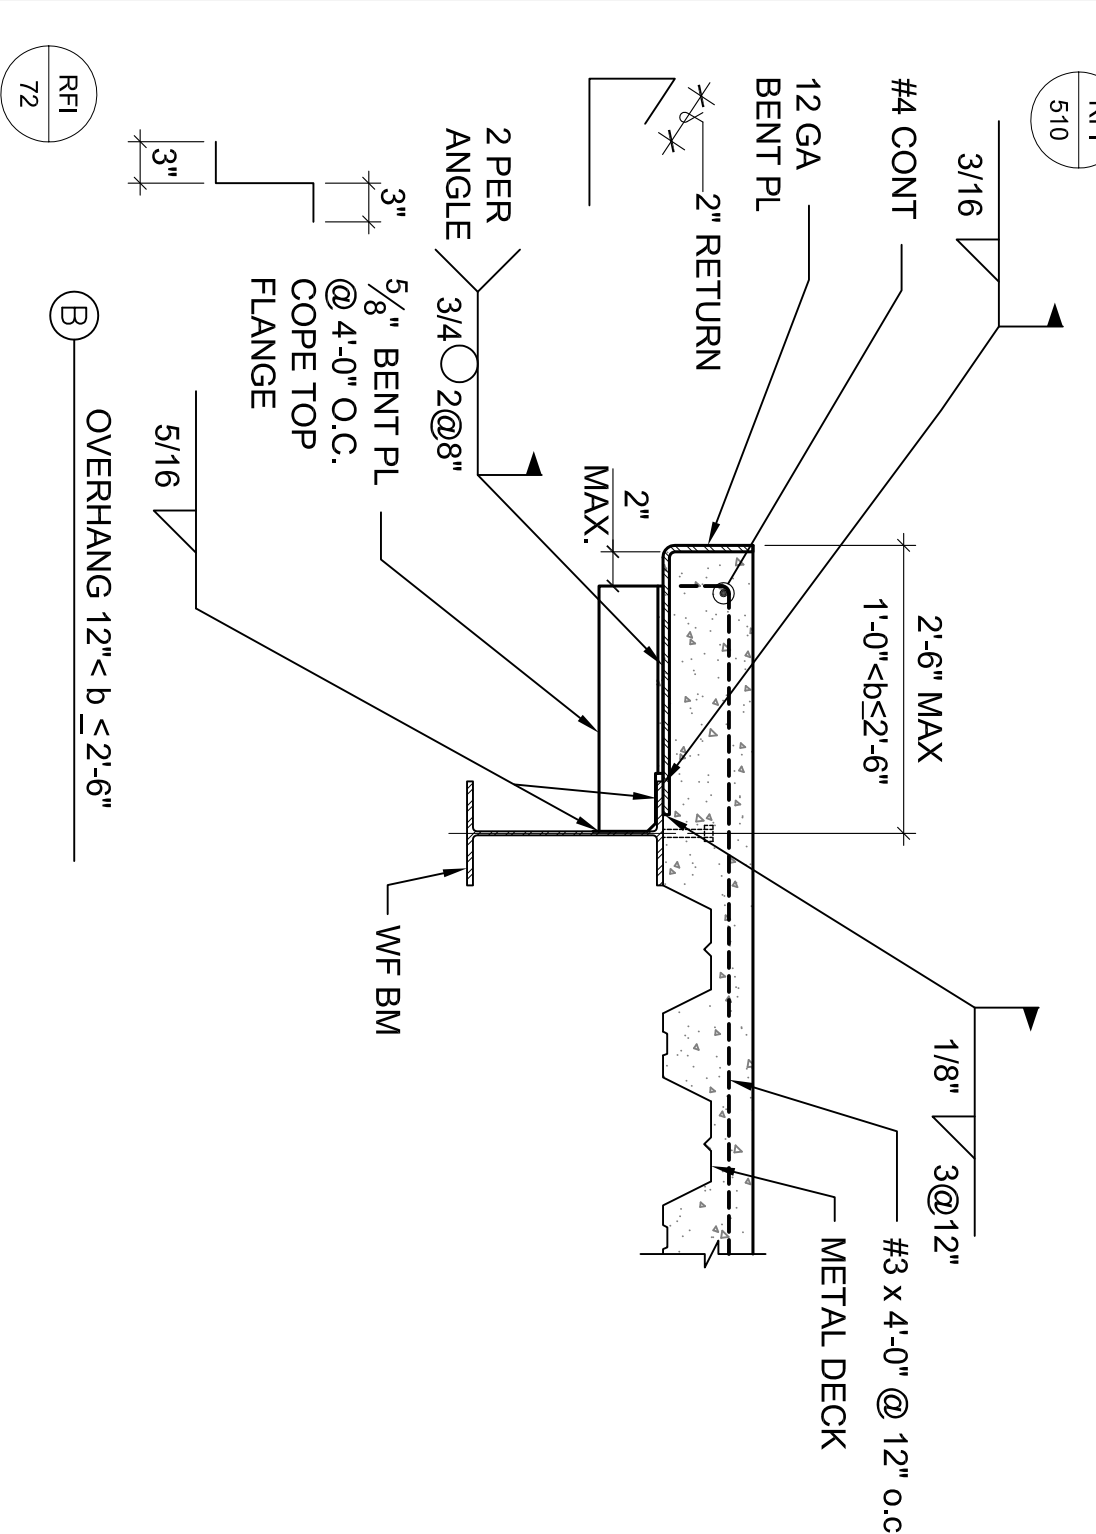


- ALL GAGES SHOWN ARE MINIMUM DECK CONTRAST TO VERIFY ADEQUACY OF EDGE FORM FOR CONG. PLACEMENT.
- SEE OTHER DETAILS FOR EXTERIOR STUD OR GFRC ATTACHMENTS.

All drawings and notes shall remain the property of the Architect and shall not be reproduced, stored in a retrieval system, or transmitted in any form or by any means, electronic, mechanical, photocopying, recording, or by any information storage and retrieval system, without the prior written consent of the Architect/Engineer.


Title block is to be 100% of the drawing. The block must be printed from the original data. Name scales must be adjusted. The line should be equal to one inch.

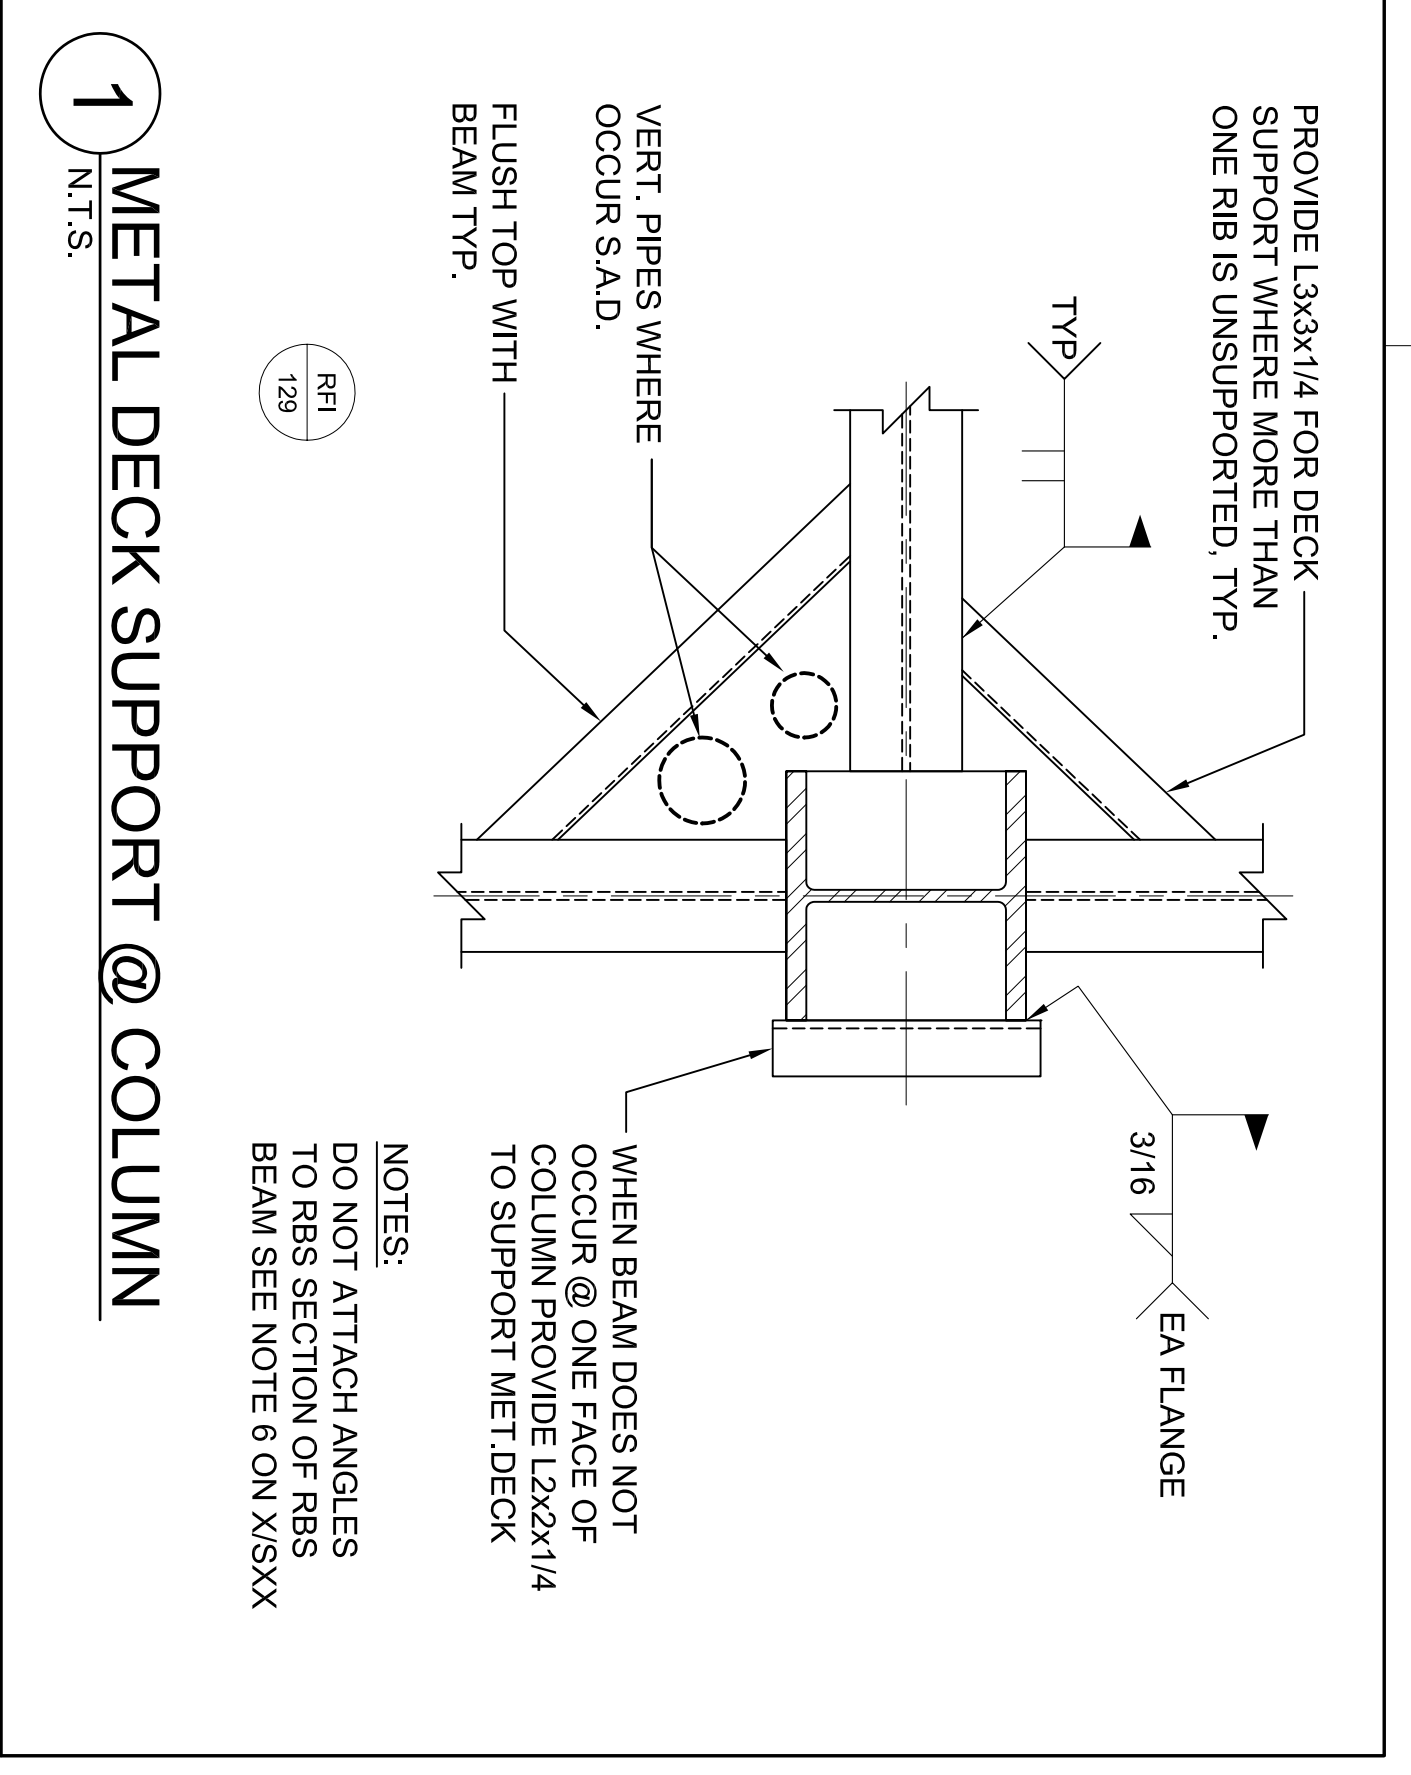


**1 METAL DECK SUPPORT @ COLUMN**  
 N.T.S.

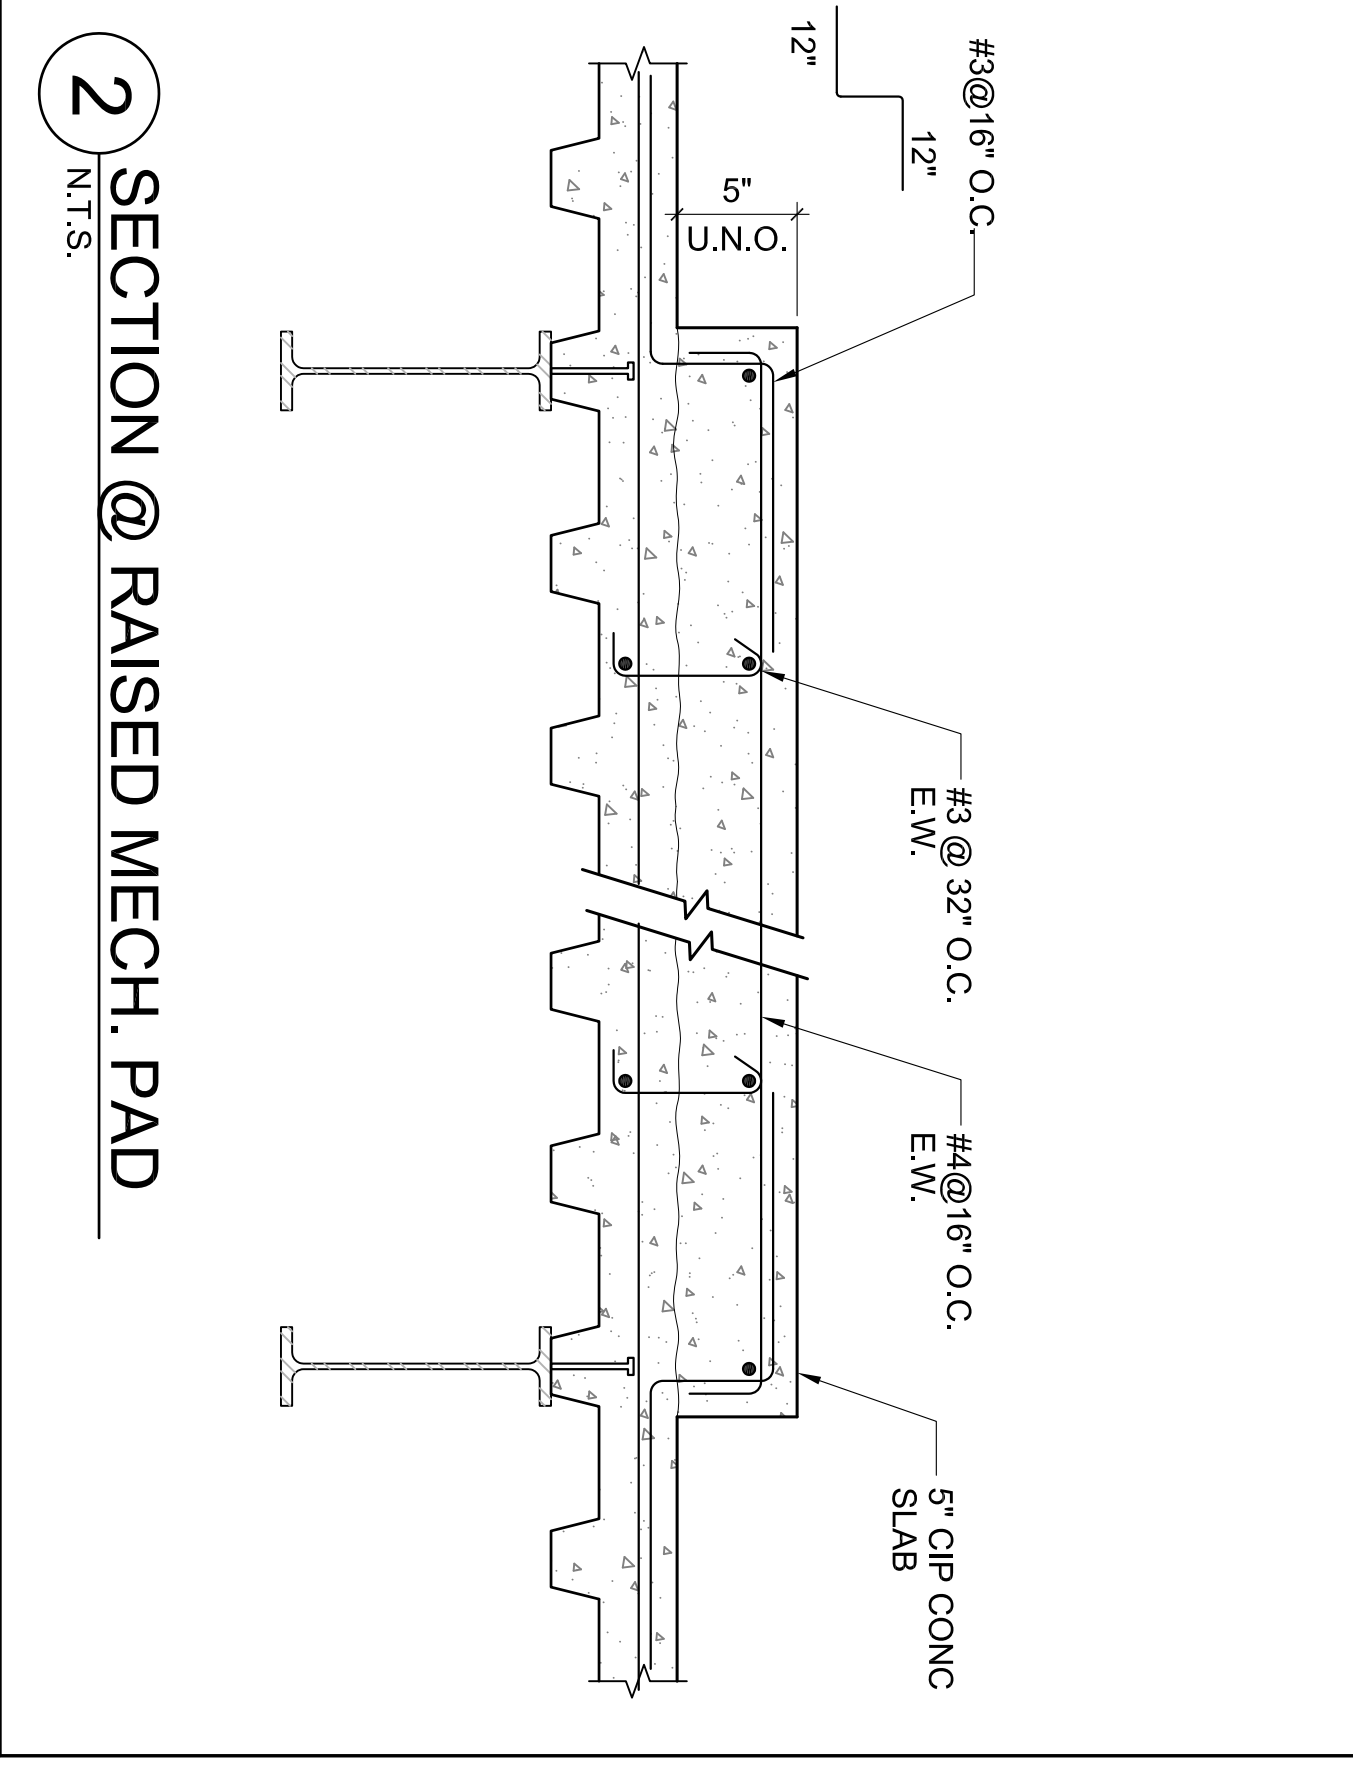


**2 SECTION @ RAISED MECH. PAD**  
 N.T.S.

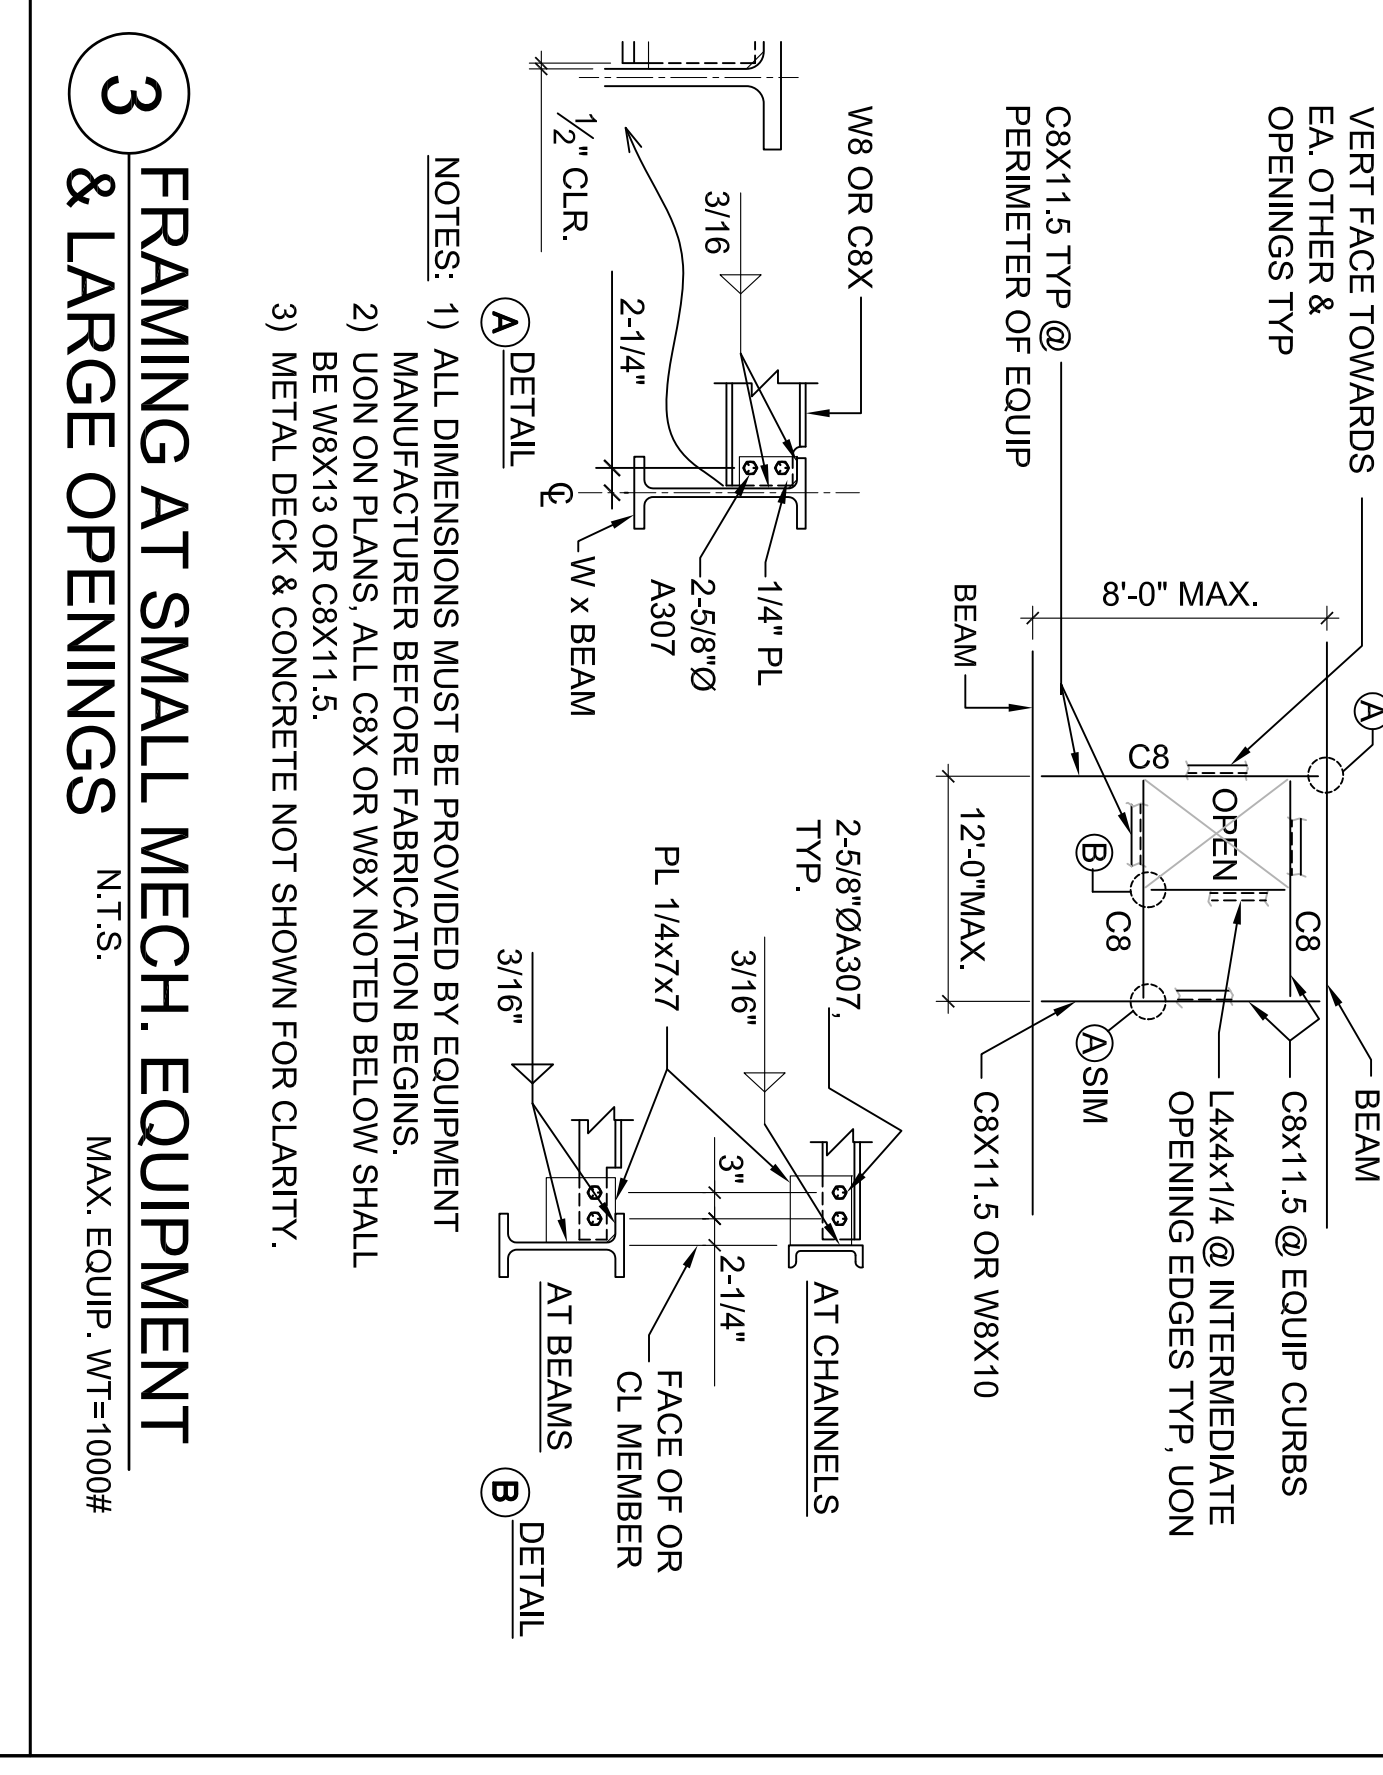


**3 FRAMING AT SMALL MECH. EQUIPMENT & LARGE OPENINGS**  
 N.T.S. MAX. EQUIP. WT=1000#

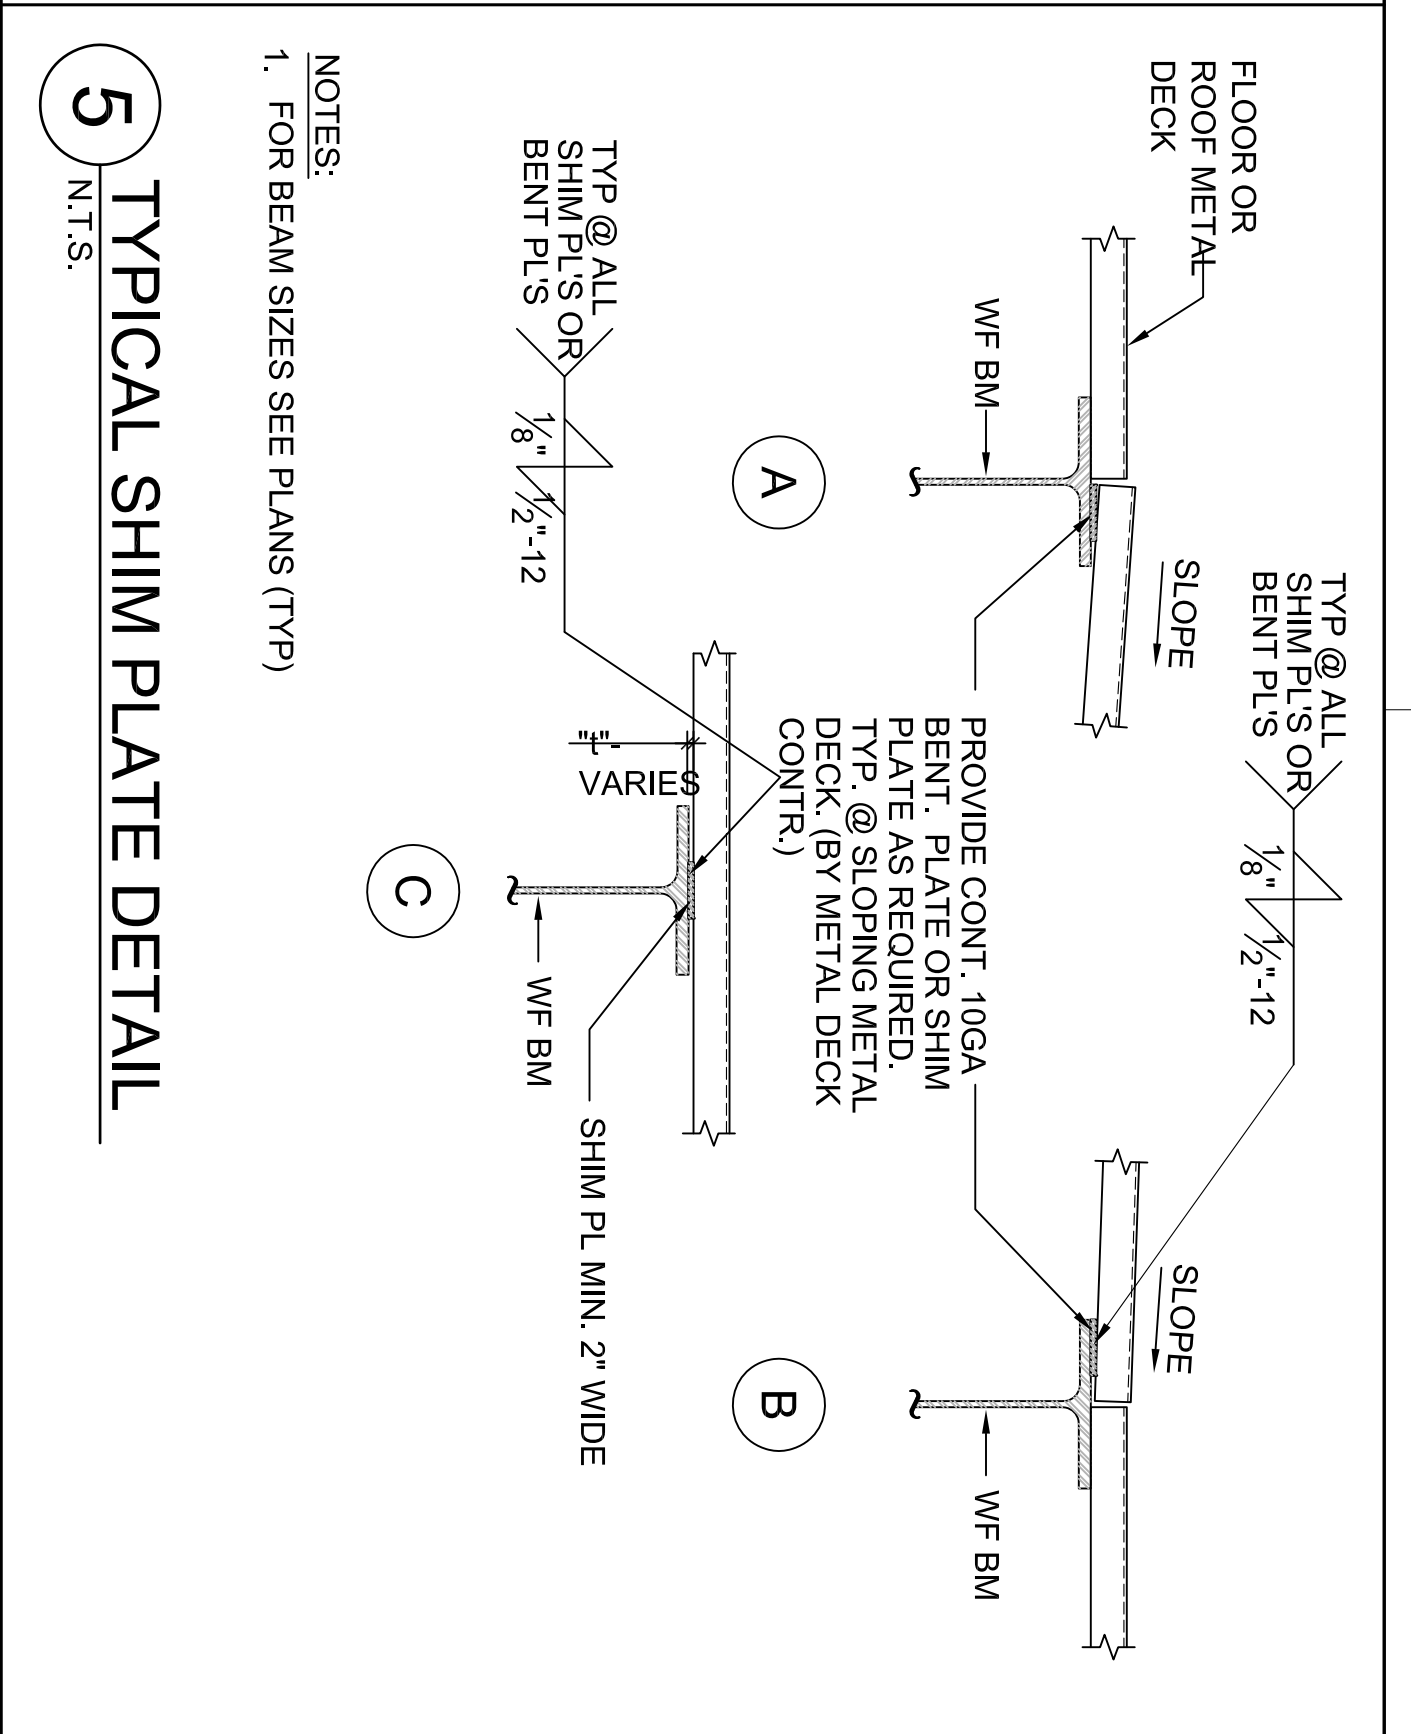


**5 TYPICAL SHIM PLATE DETAIL**  
 N.T.S.

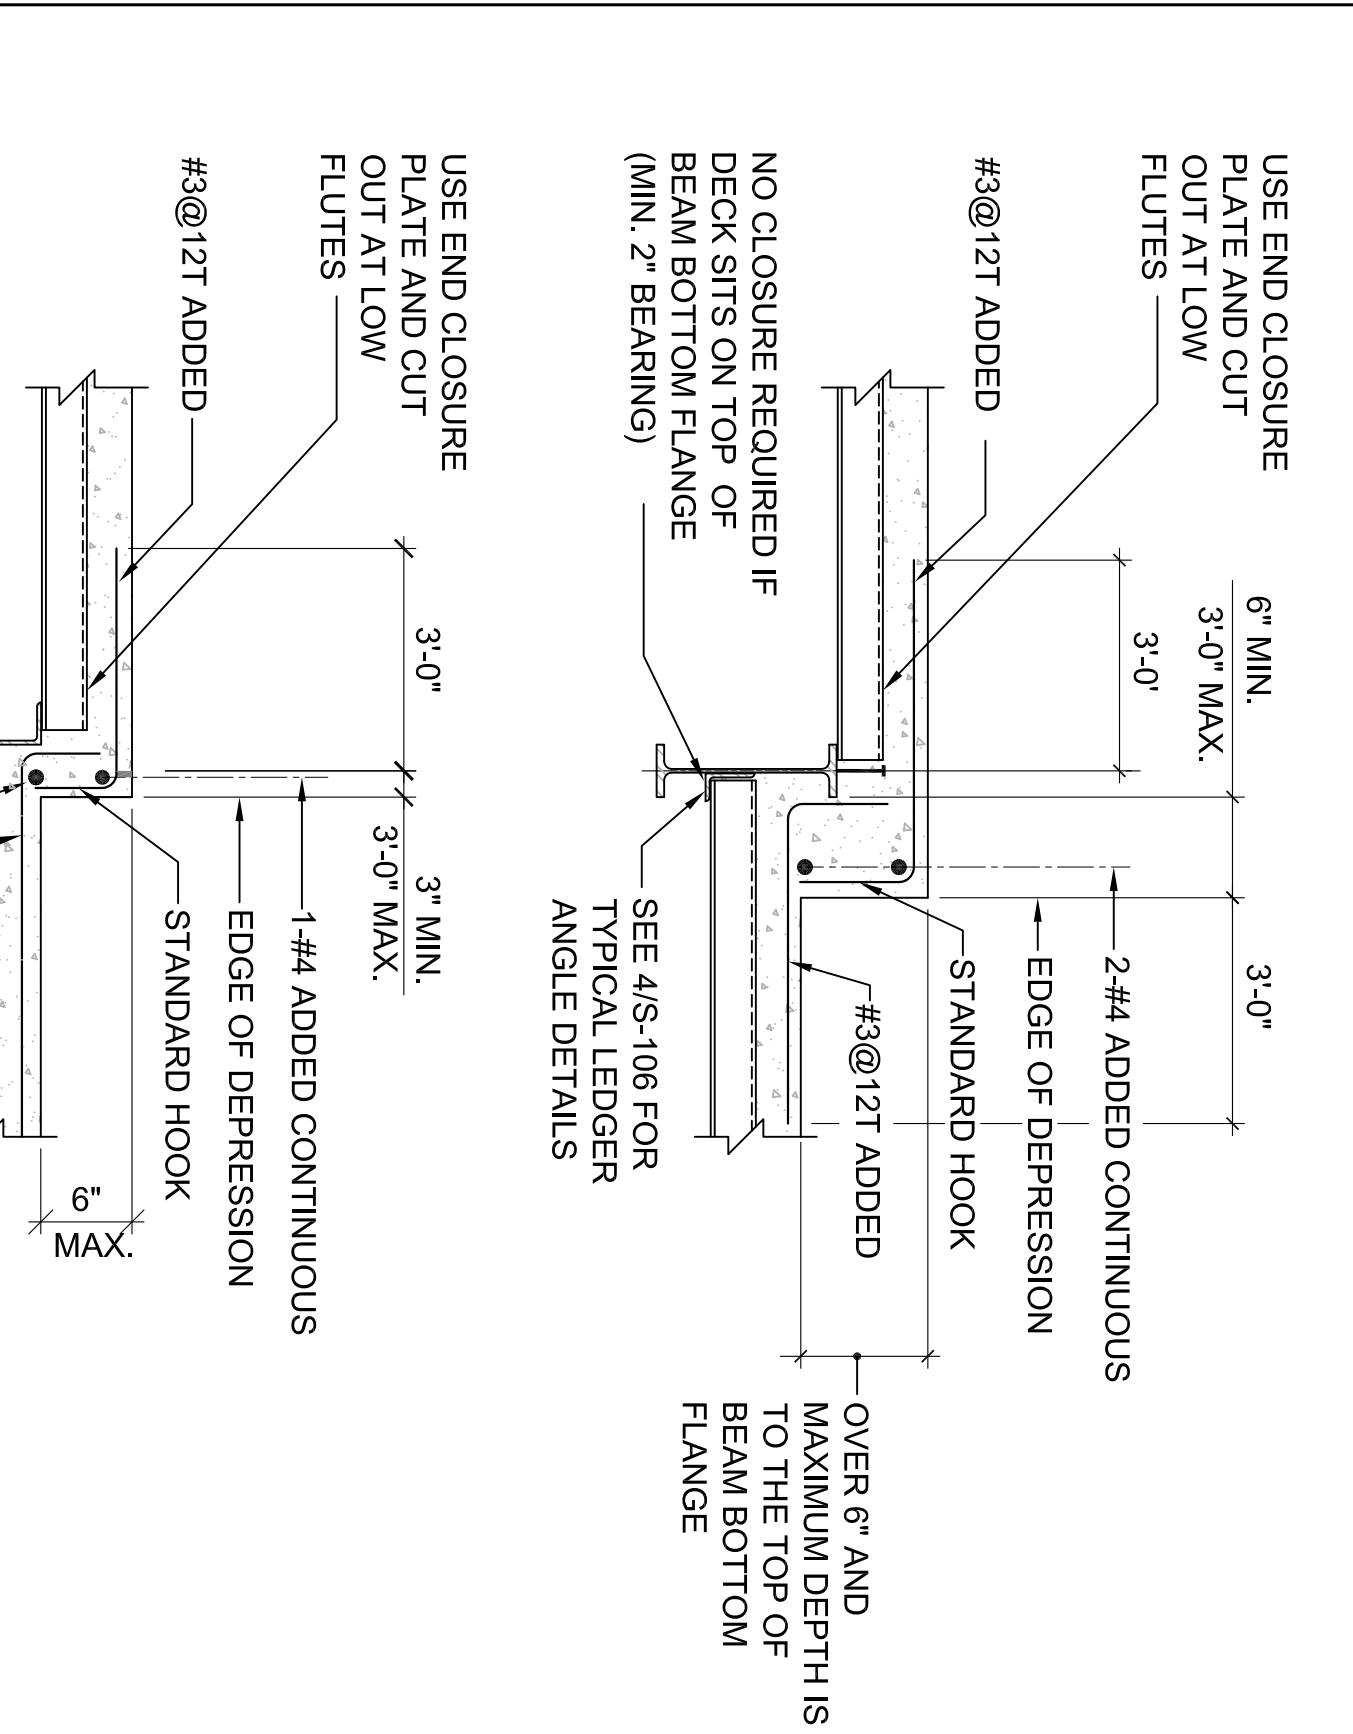


**7 TYPICAL METAL DECK DETAILS @ SLAB DEPRESSIONS**  
 N.T.S.

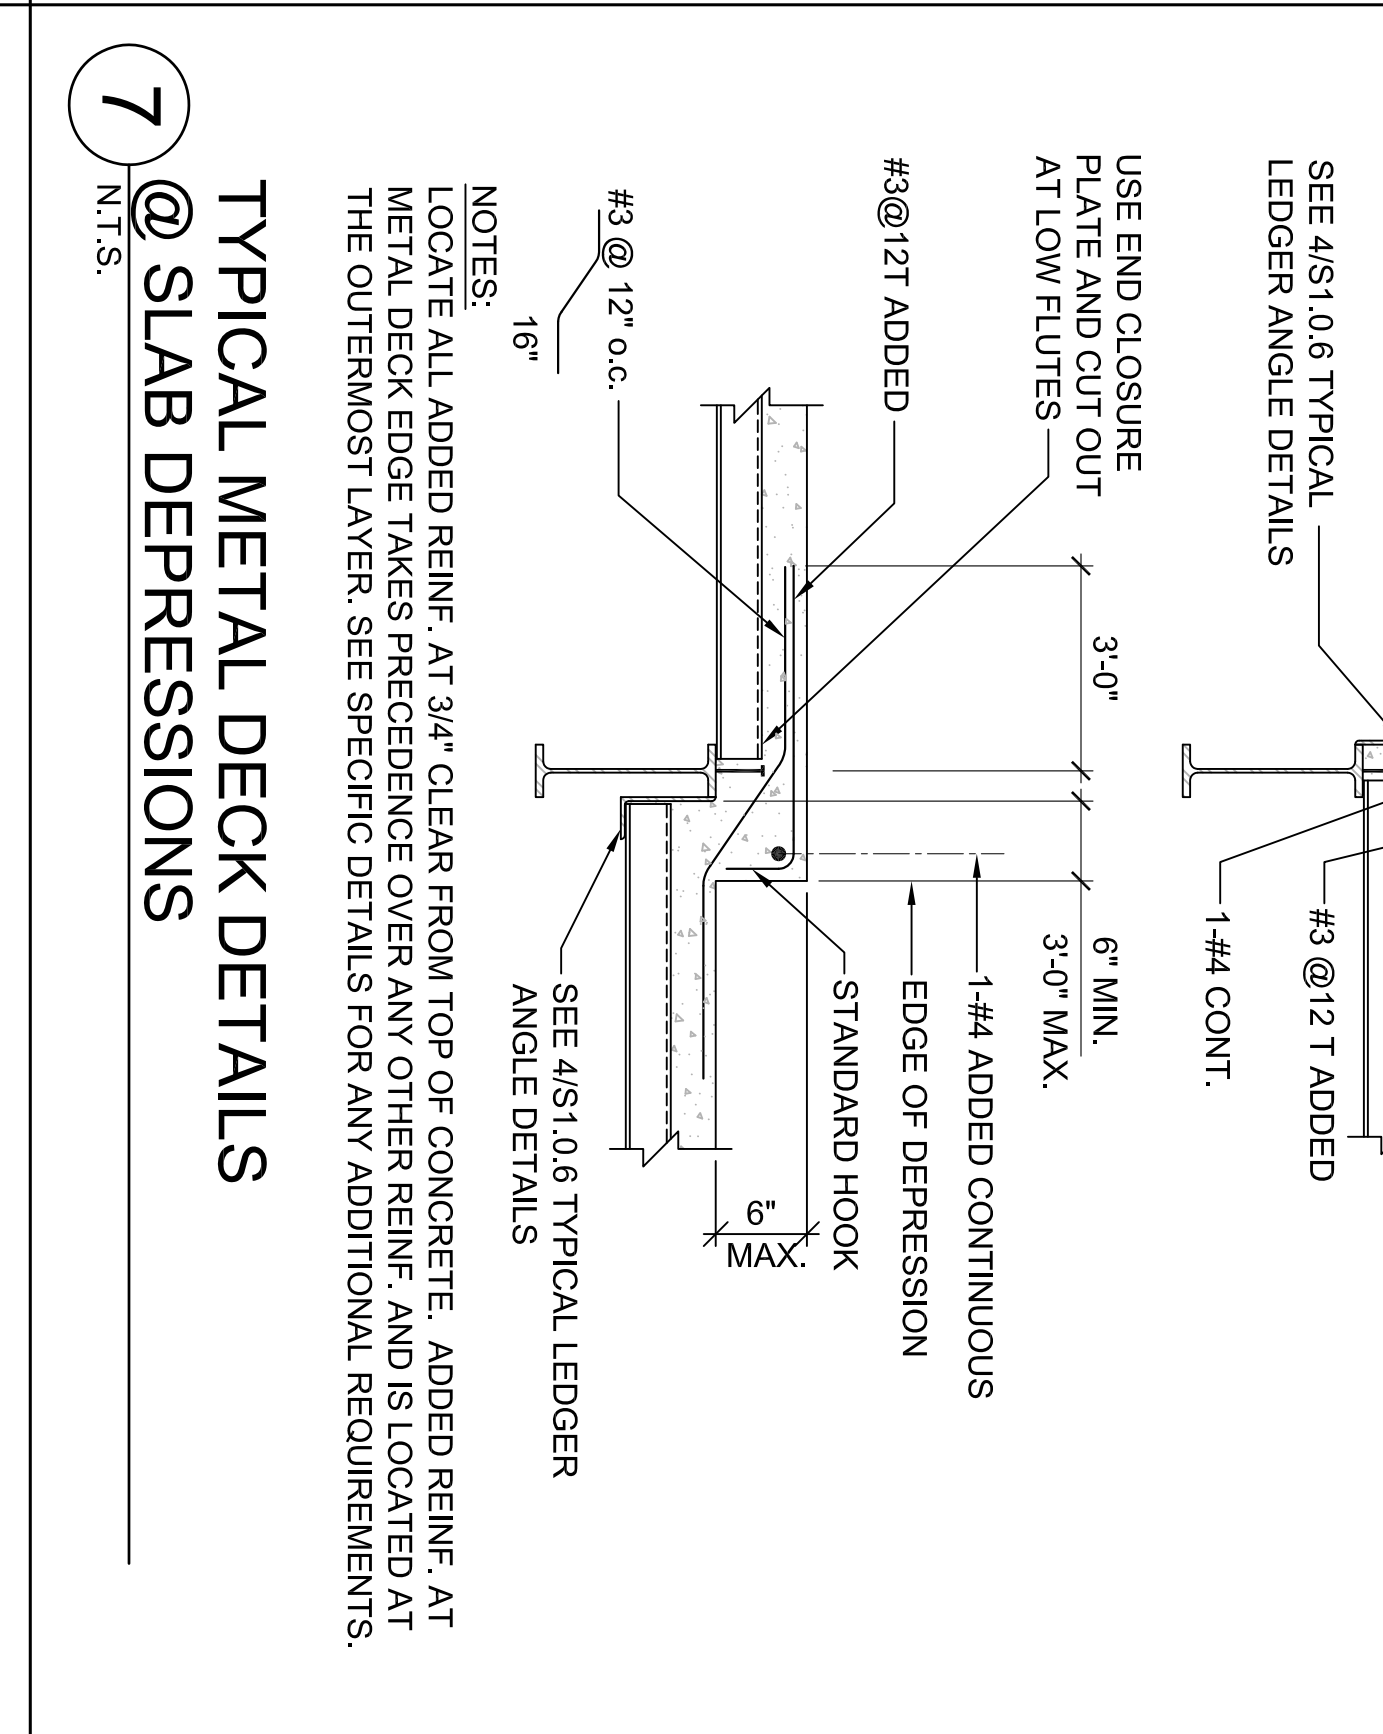


**8 PROCEDURE FOR CONSTRUCTION OF SLAB ON CAMBERED BEAMS**  
 N.T.S.

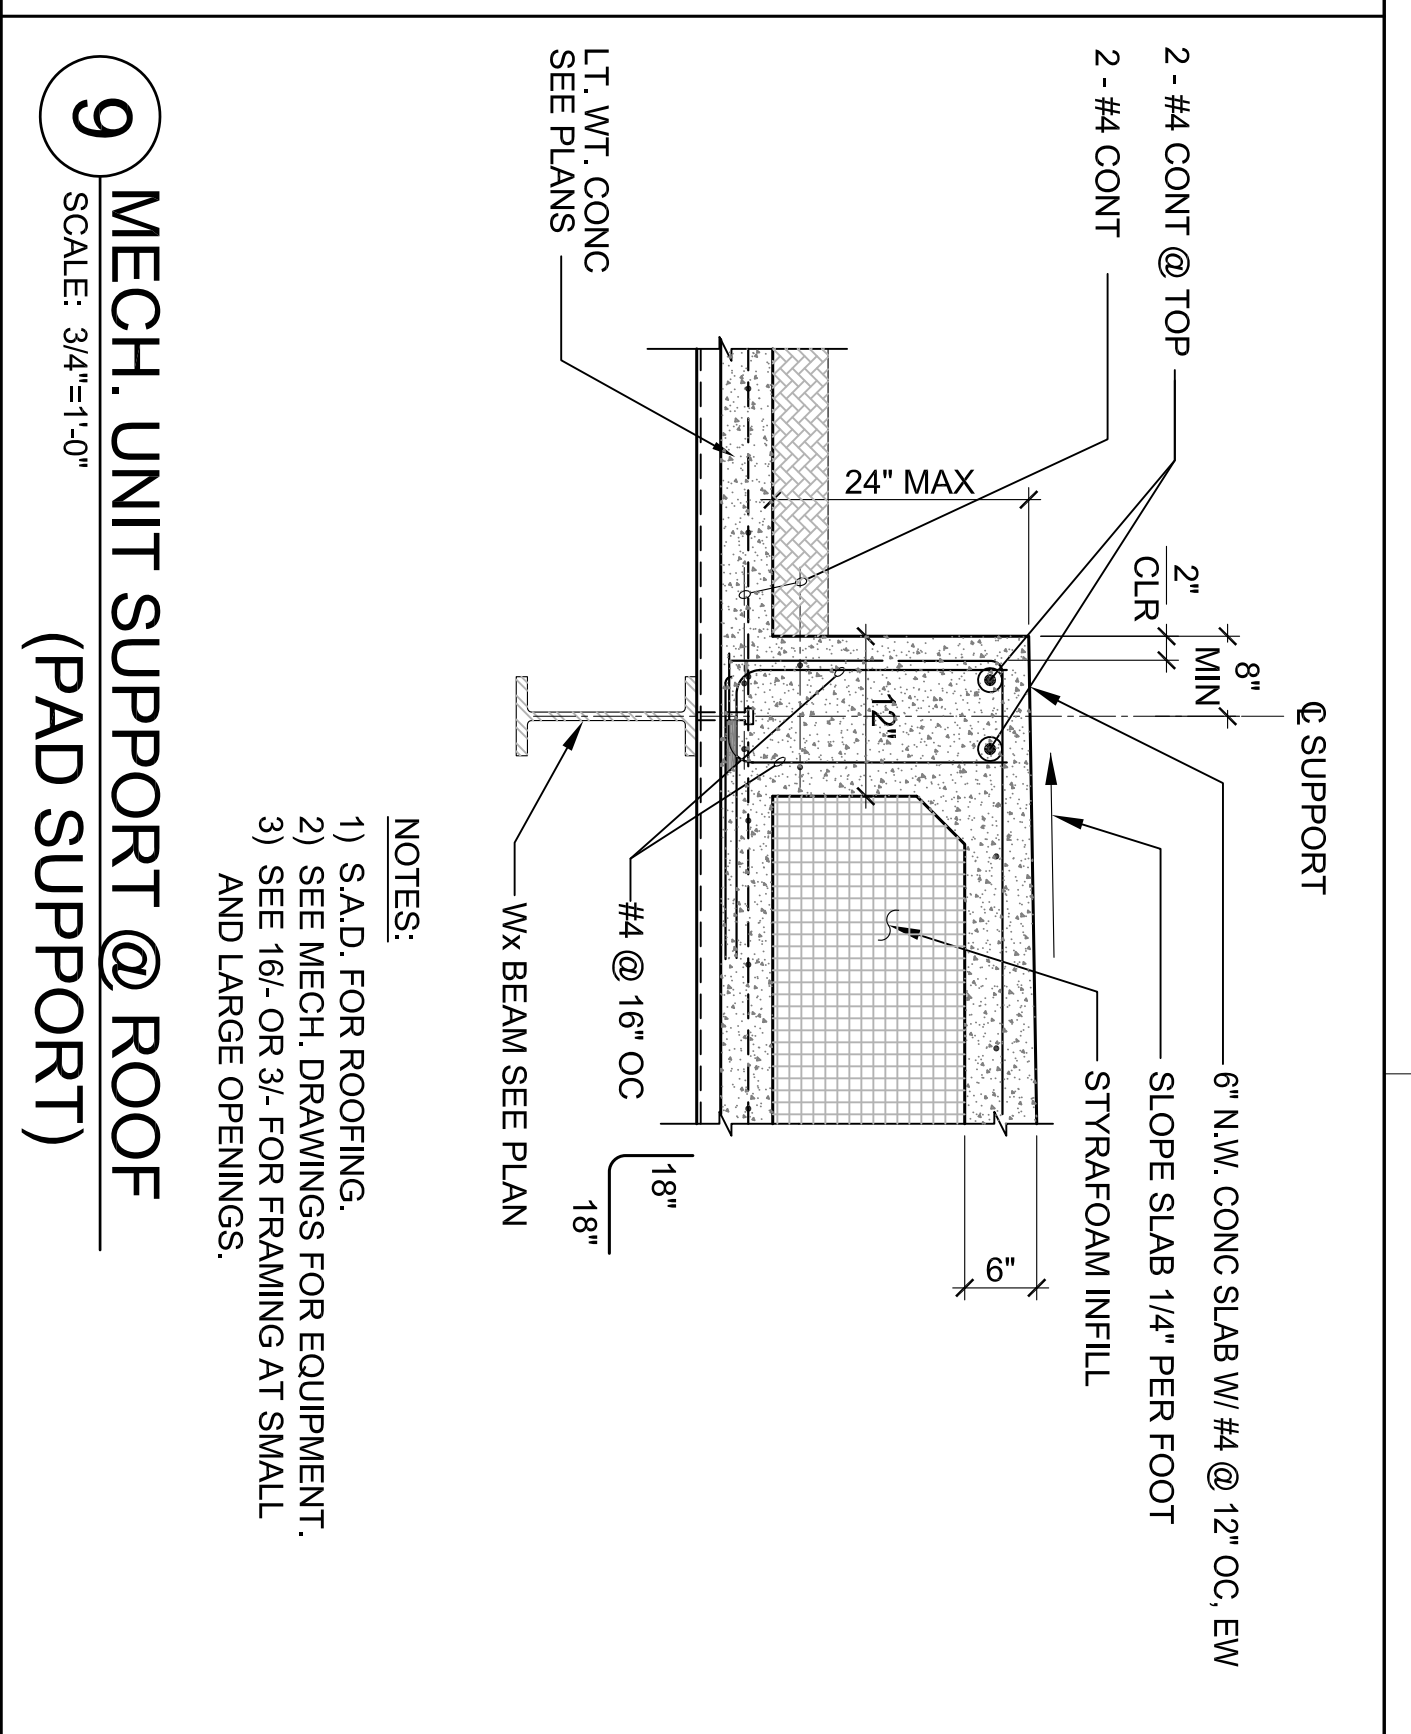


**9 MECH. UNIT SUPPORT @ ROOF (PAD SUPPORT)**  
 SCALE: 3/4\"/>

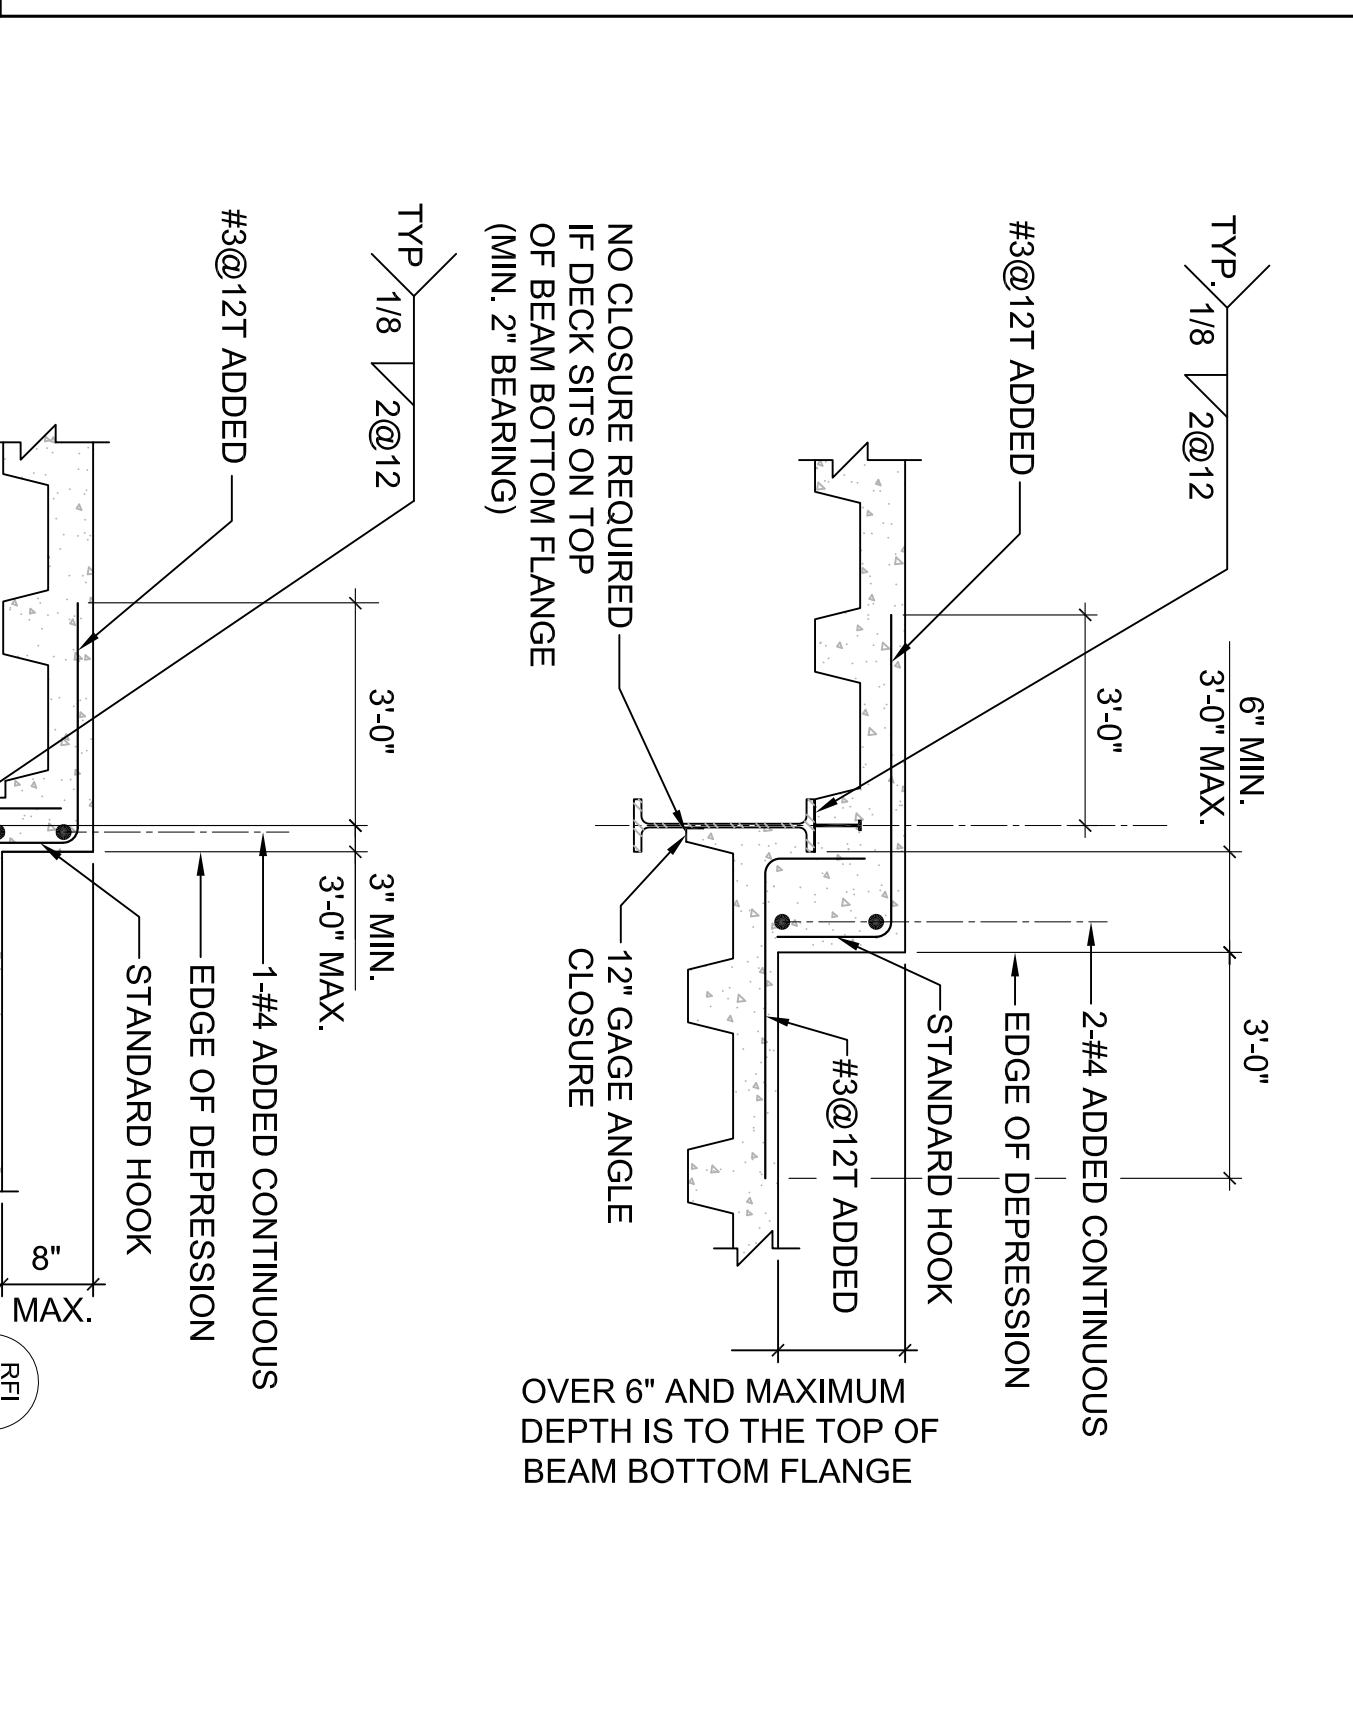


**11 TYPICAL METAL DECK DETAILS @ SLAB DEPRESSIONS**  
 N.T.S.

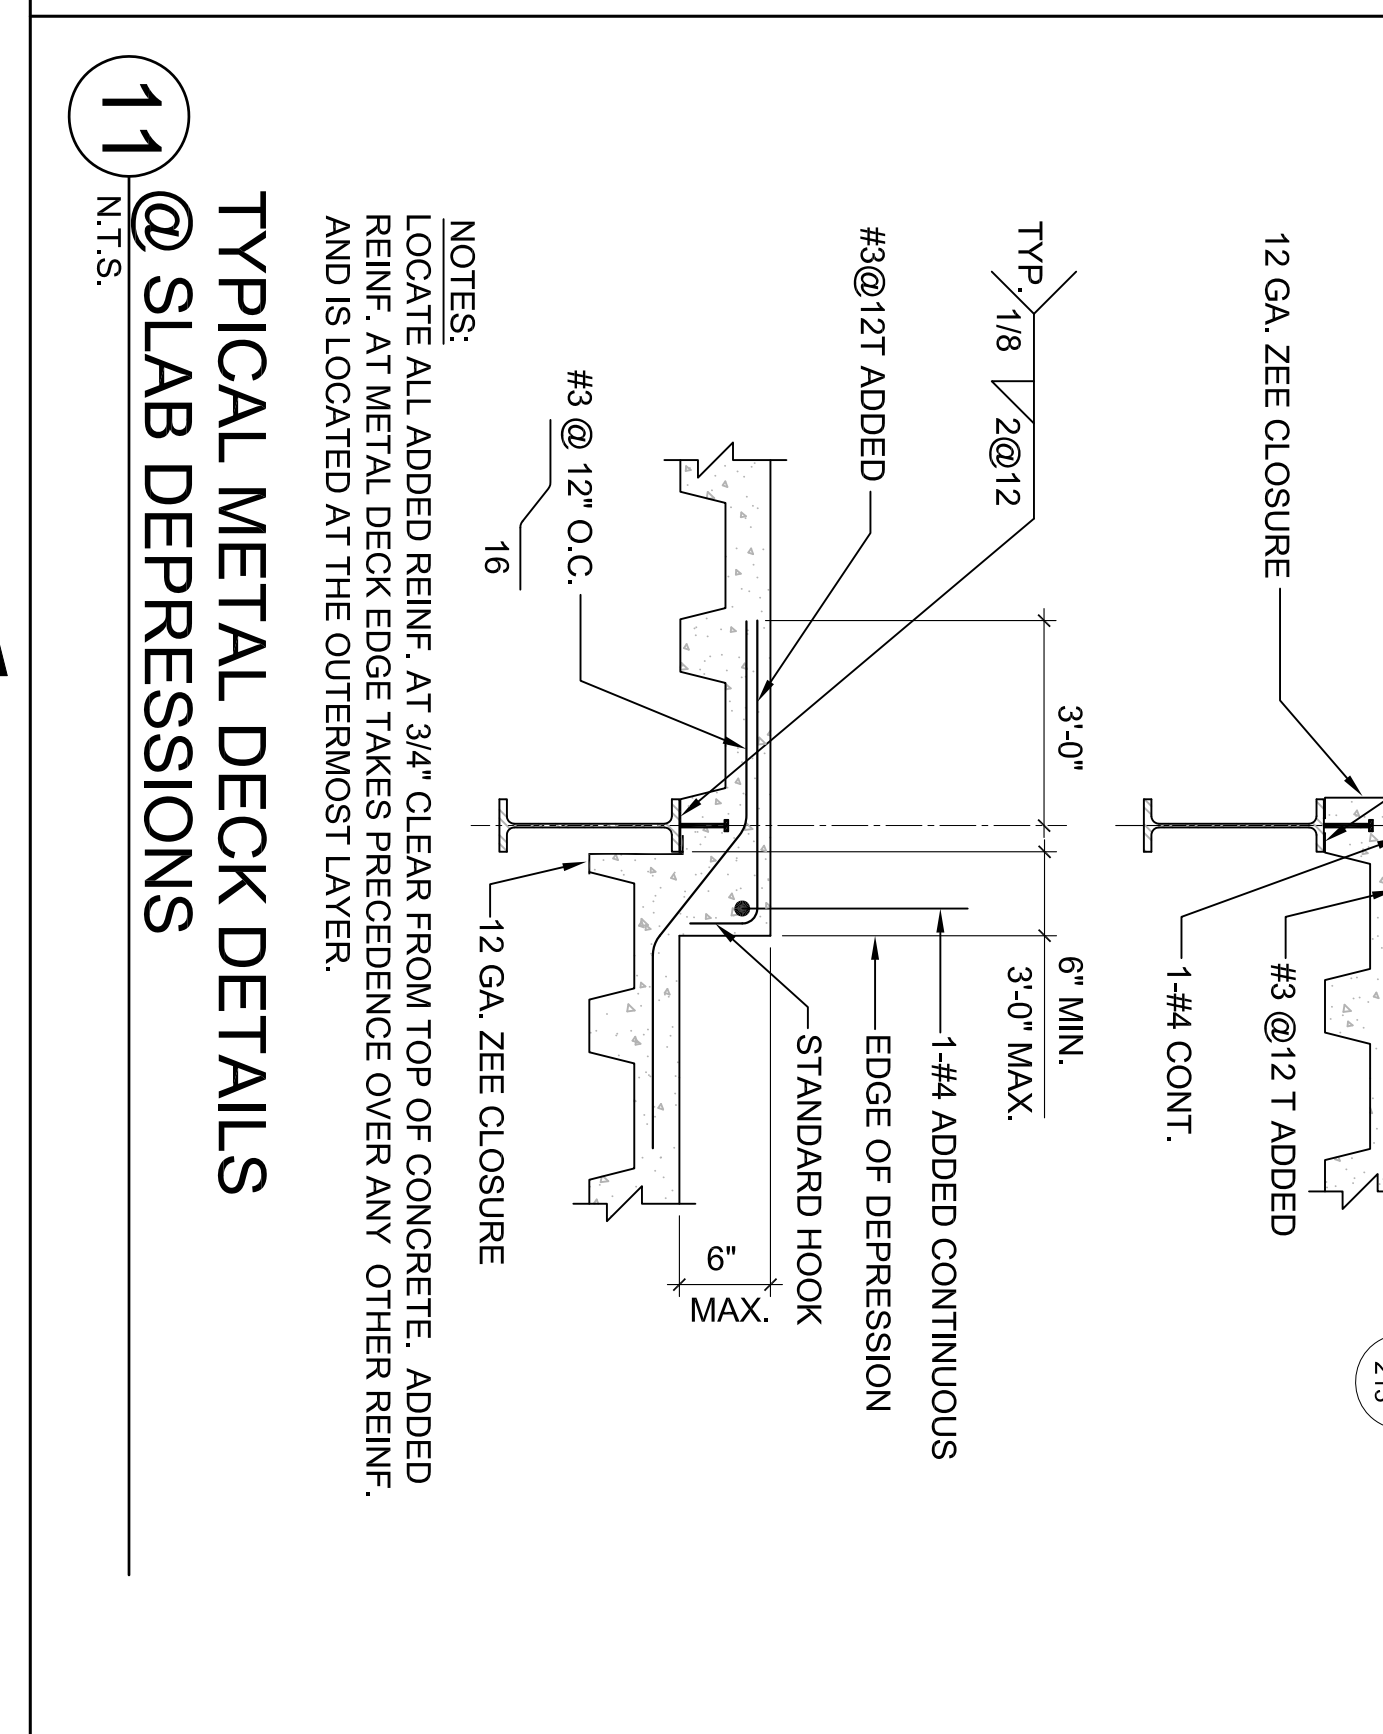

**13 MECH. UNIT SUPPORT @ ROOF (CURB SUPPORT)**  
 SCALE: 3/4\"/>

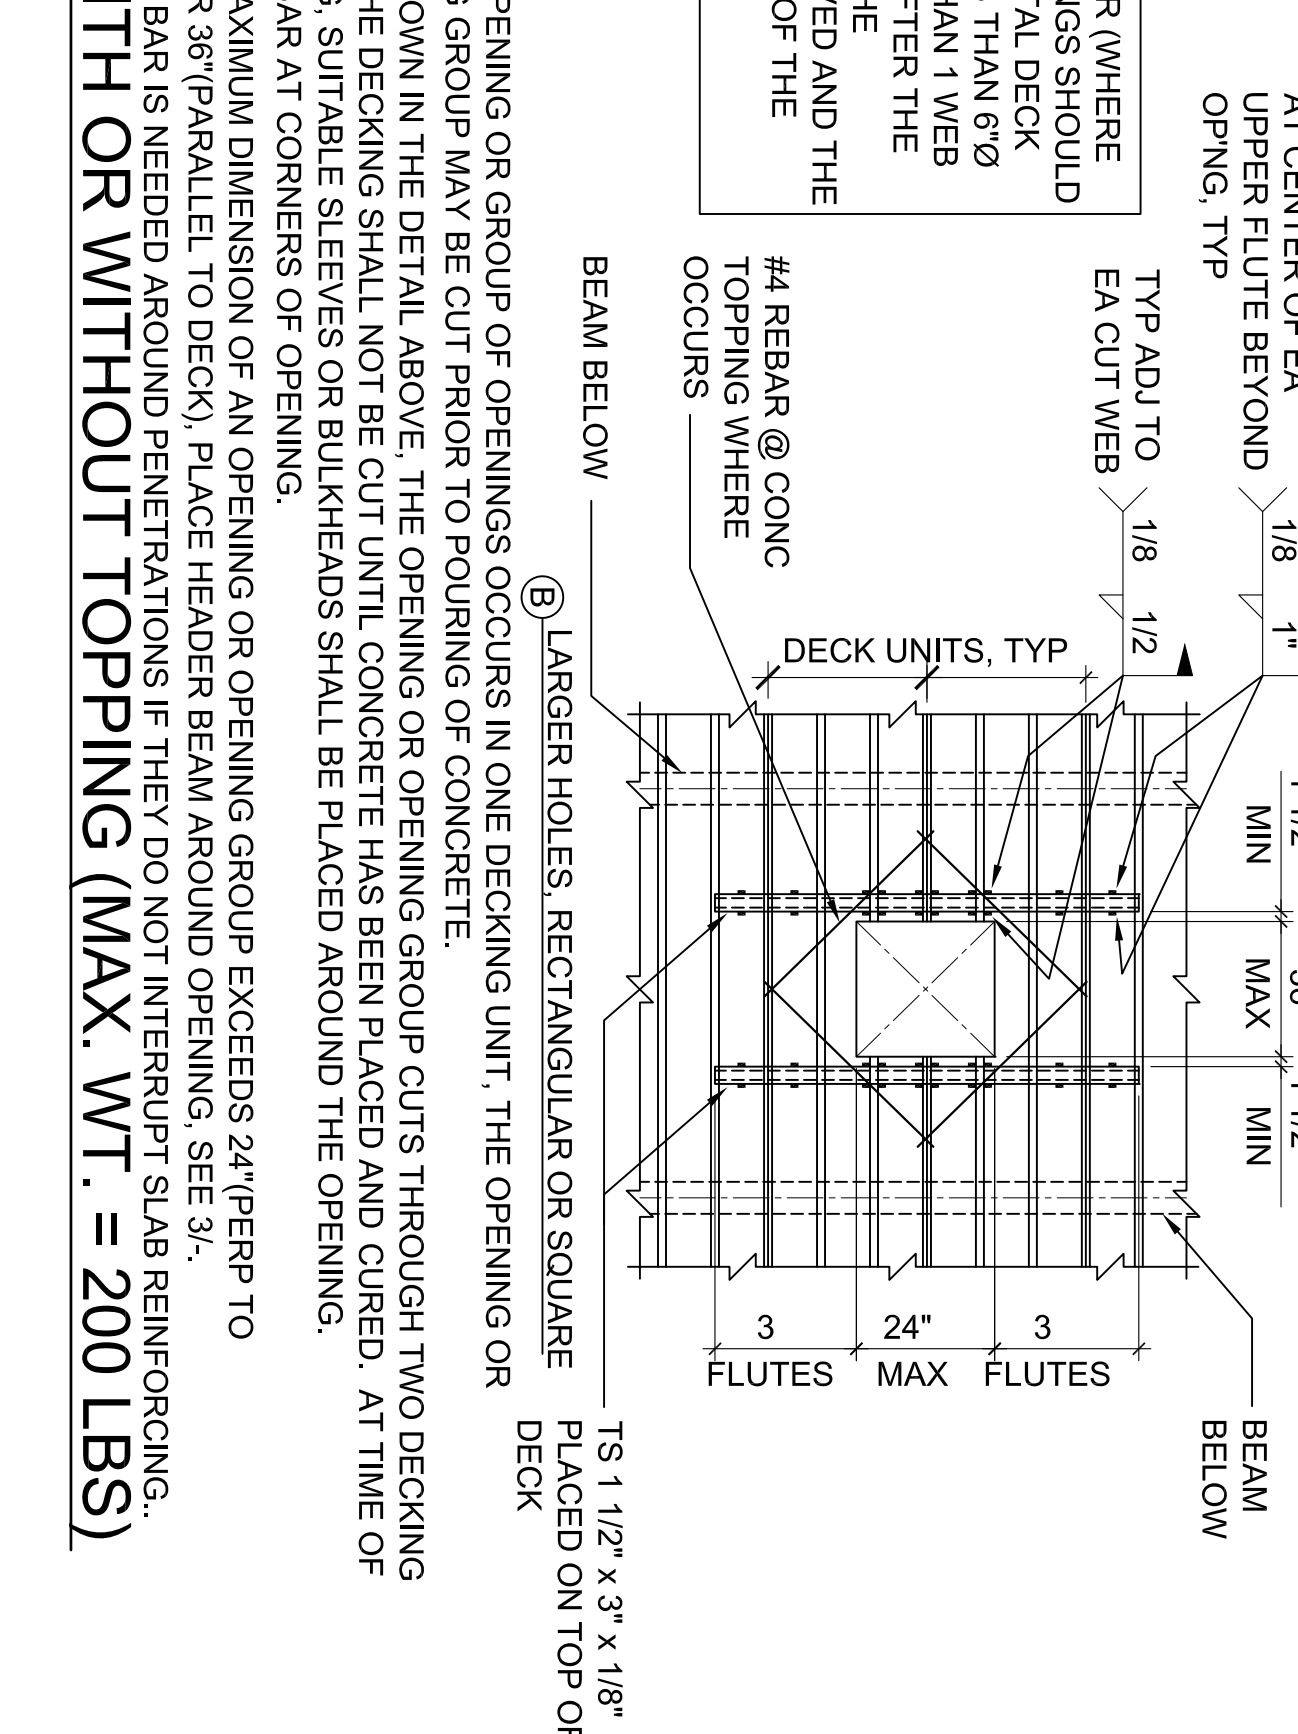


**15 TYPICAL DECK SPLICE AT SUPPORT**  
 N.T.S.

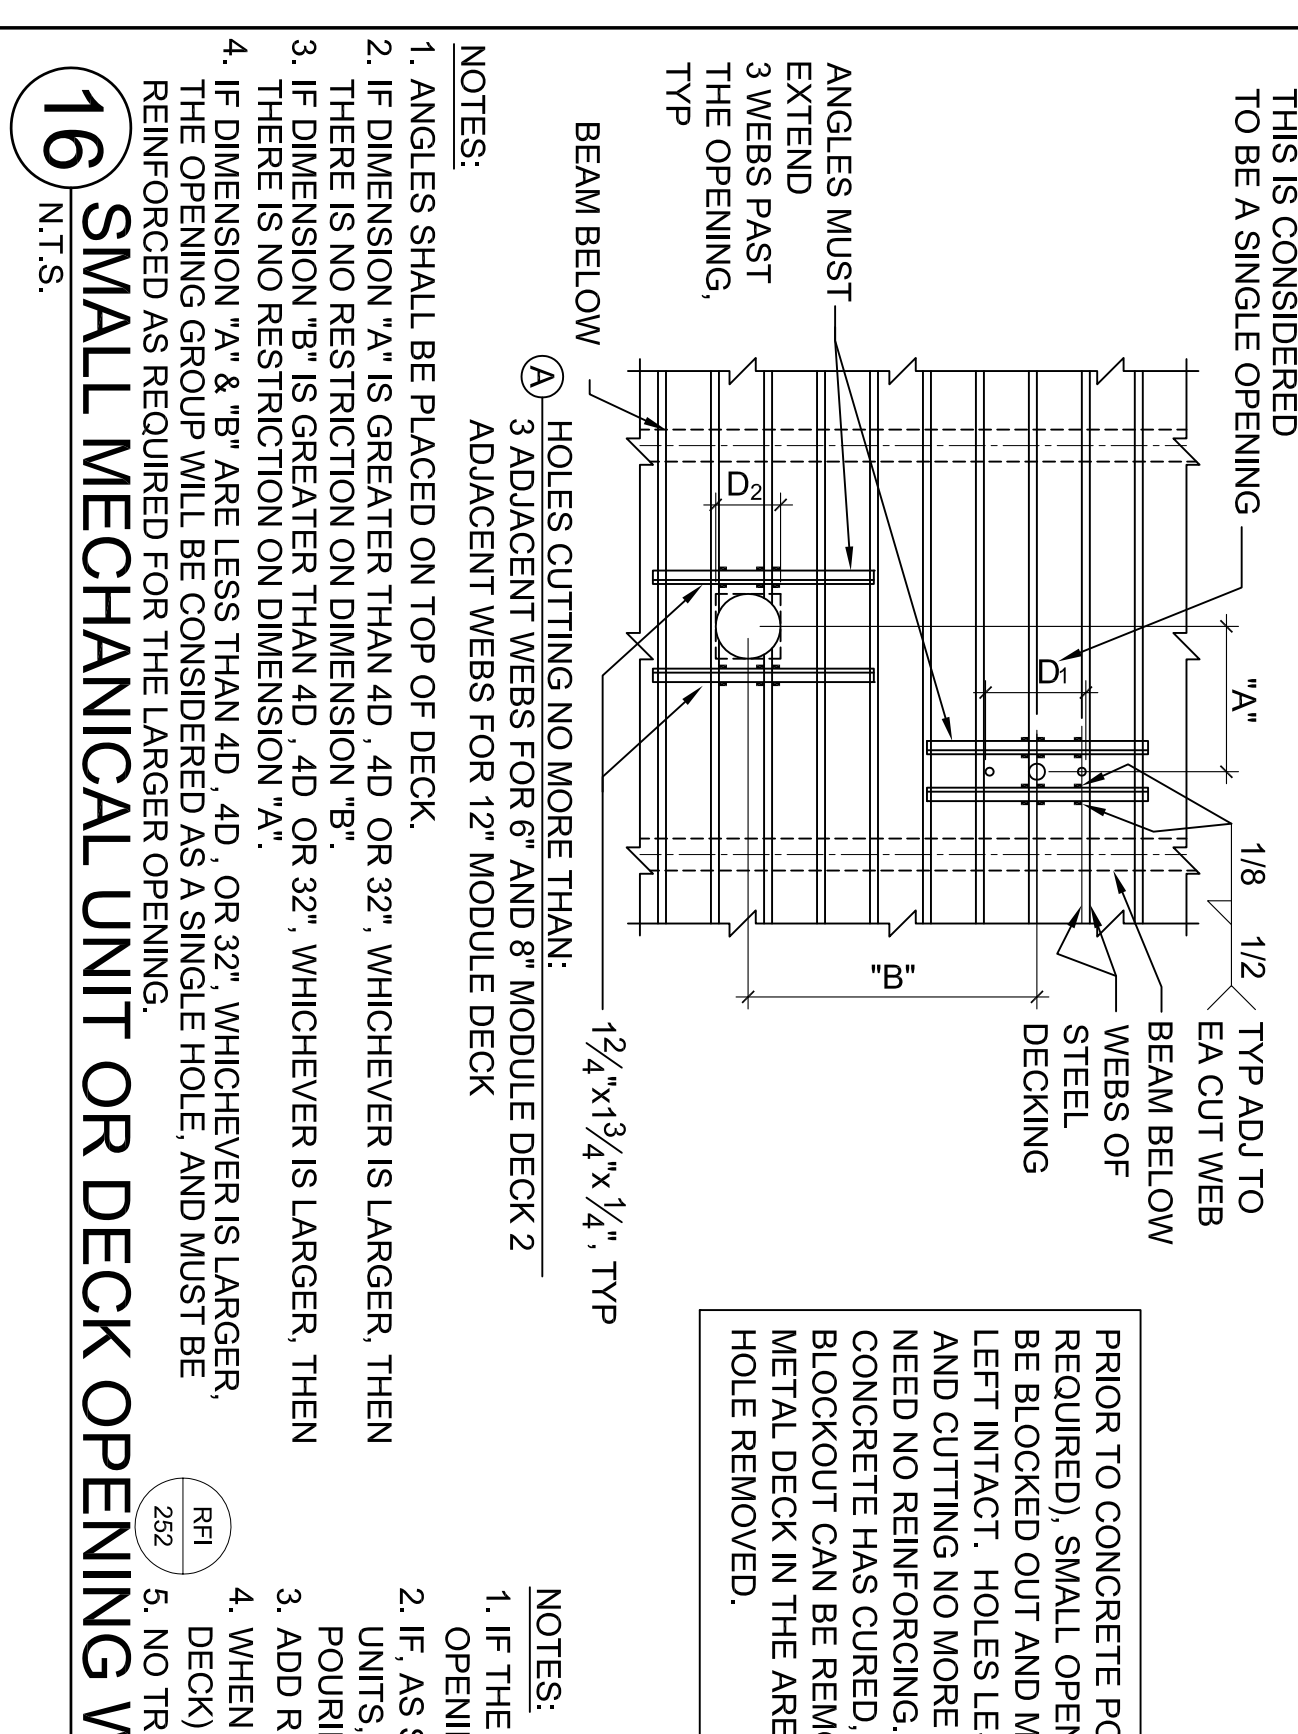

**16 SMALL MECHANICAL UNIT OR DECK OPENING WITH OR WITHOUT TOPPING (MAX. WT. = 200 LBS)**  
 N.T.S.

All drawings and/or modifications prepared by hand, including original and modified work of the Architect/Engineer and may not be reproduced, used or distributed without consent of Architect/Engineer.

Title block is in 1/8\"/>

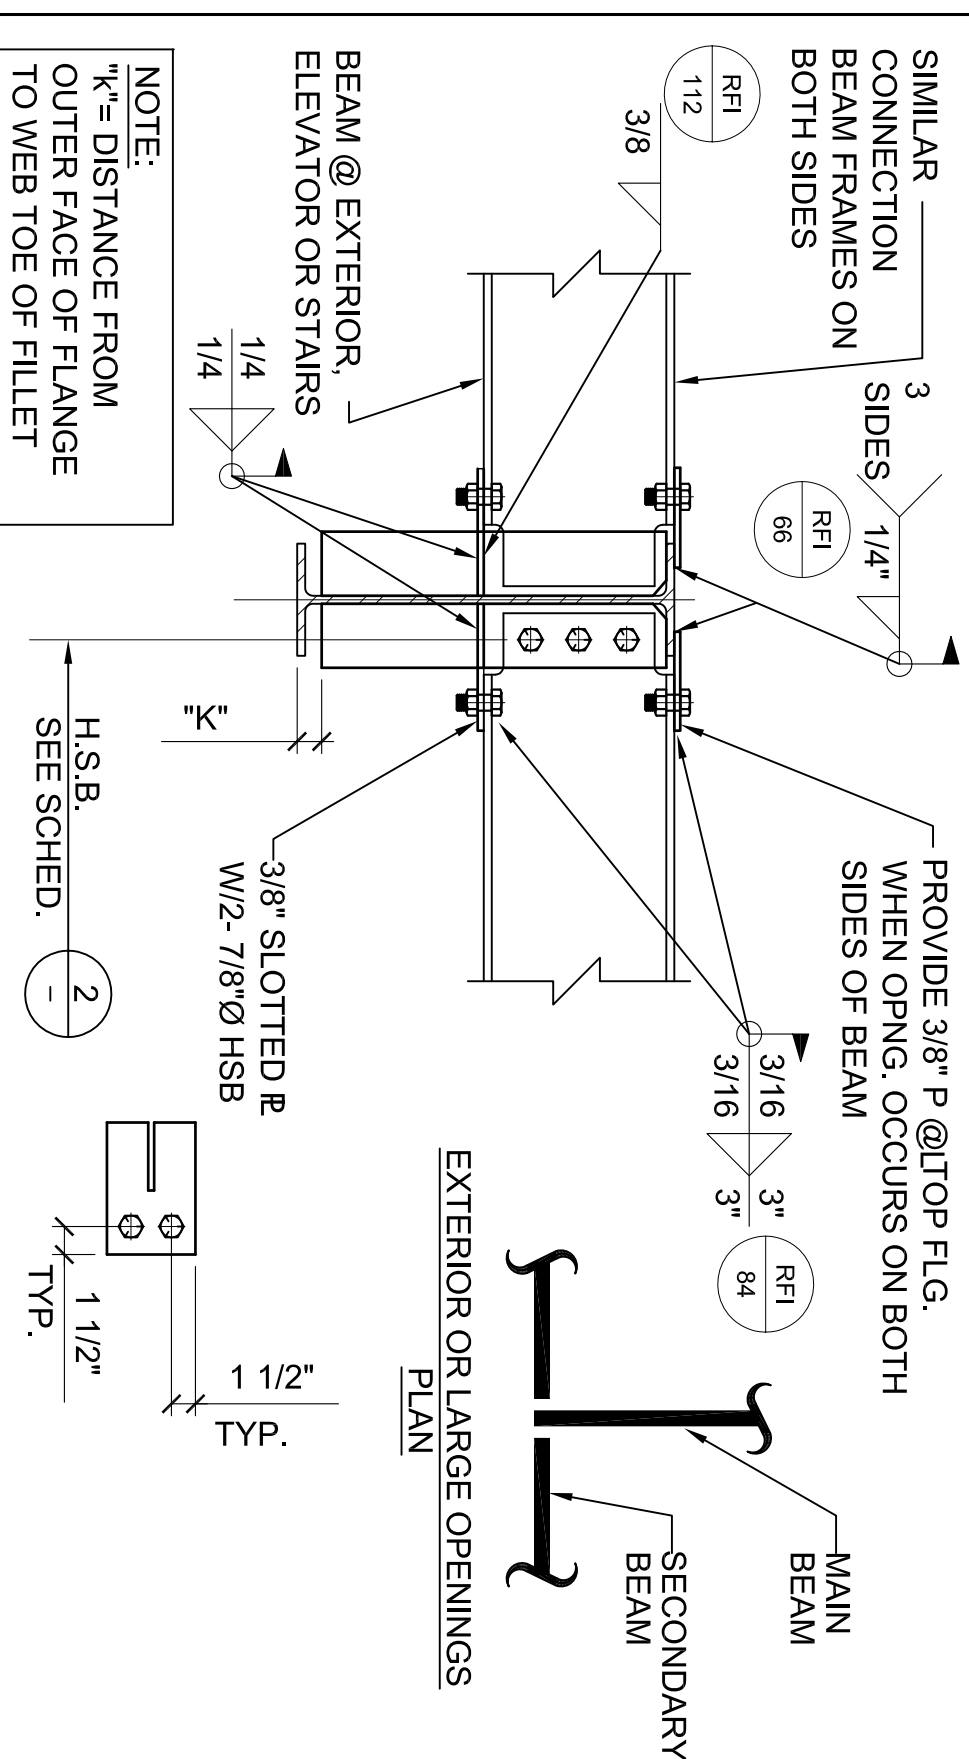


**1 BEAM TO BEAM CONN. @ EXTERIOR OVERHANGS AND INTERIOR OPENINGS**  
N.T.S.


BEAM SIZE	CONNECTION	WELD	REMARKS
C6, W6	PLATE-T	E	3/16"
C8-C10, W8-W10	3/8"	E	5/16"
W12	3/8"	E	5/16"
W14	3/8"	E	5/16"
W16	3/8"	E	5/16"
W18	3/8"	E	5/16"
W21	1/2"	E	3/8"
W24	1/2"	E	3/8"
W27	1/2"	E	3/8"
W30	1/2"	E	3/8"
W33	1/2"	E	3/8"

1. USE A325-N BOLTS.
2. USE PLATE-F<sub>y</sub>=58 ksi F<sub>u</sub>=68 ksi
3. USE A325-SC BOLTS (PRE-TENSIONED) WHERE INDICATED ON PLANS. SEE (1) (4) (6) FOR ITEM NOT NOTED HERE.


**2 BEAM CONNECTION SCHEDULE**  
NO SCALE

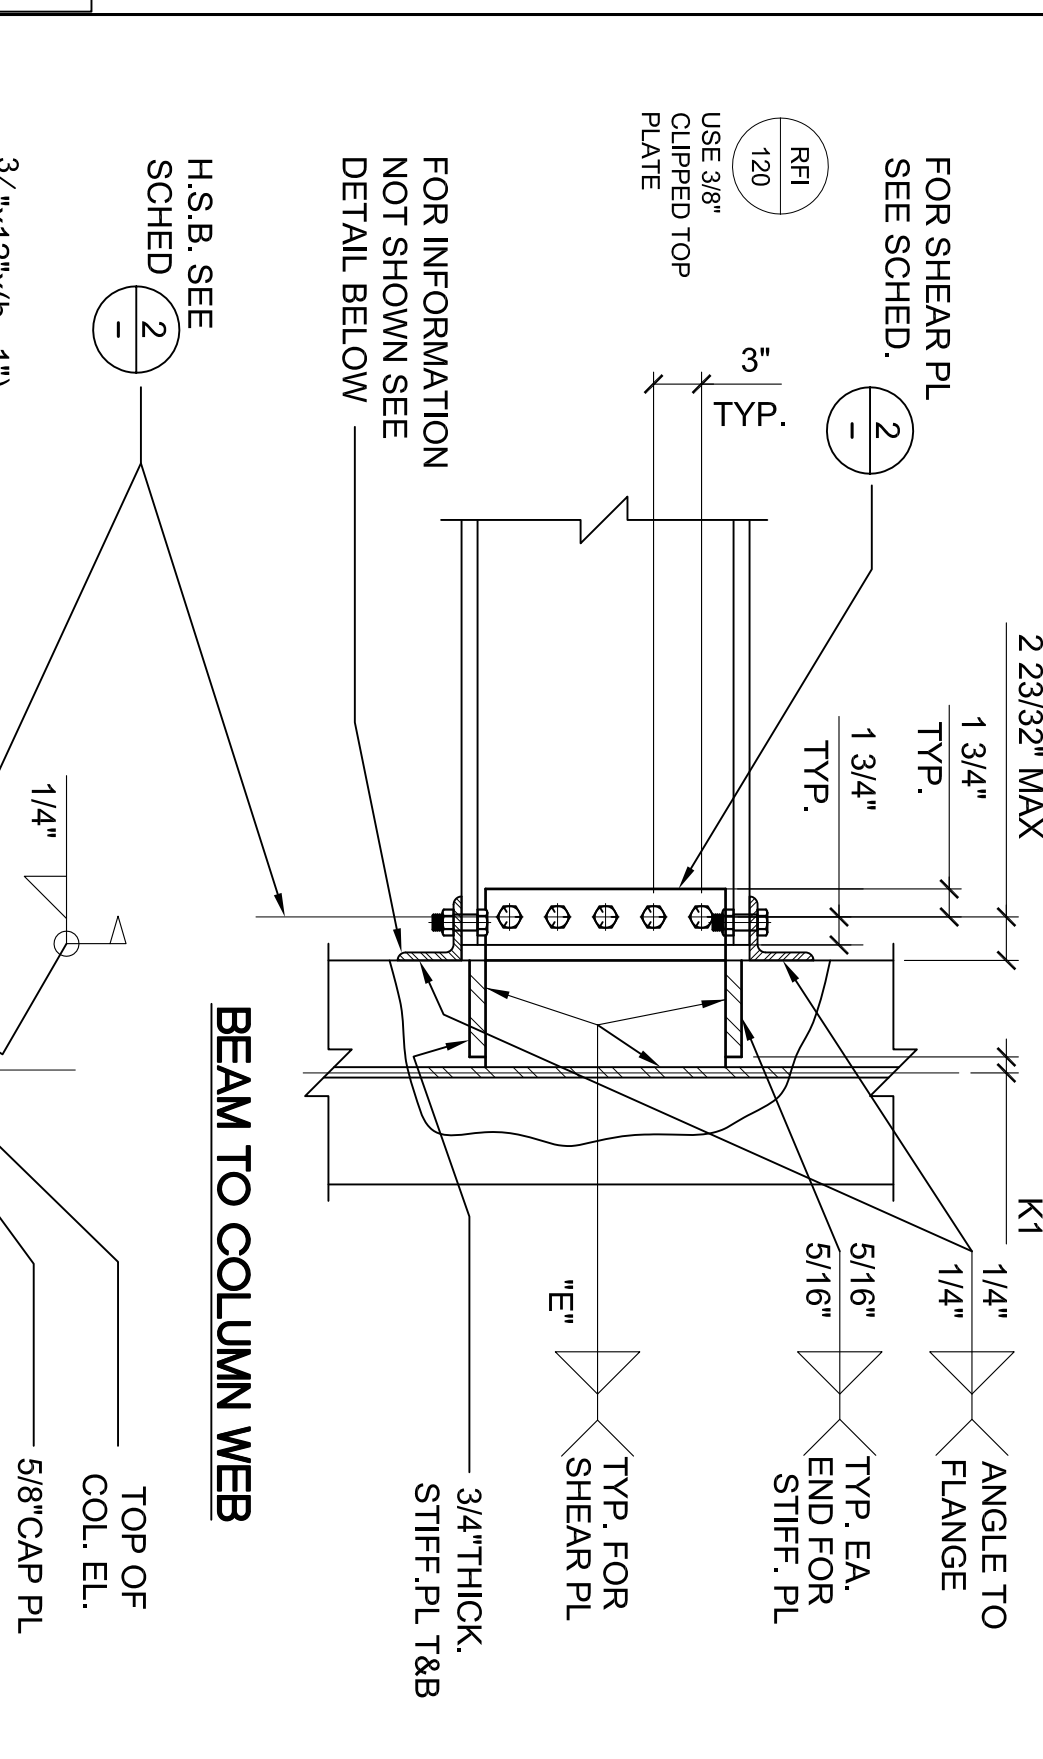


**3 BEAM TO COLUMN WEB**  
N.T.S.

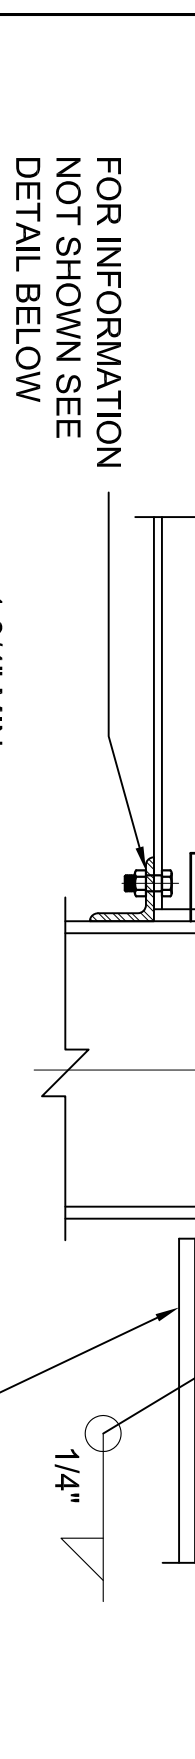


**4 NON-MOMENT BEAM TO COLUMN CONN.**  
N.T.S.

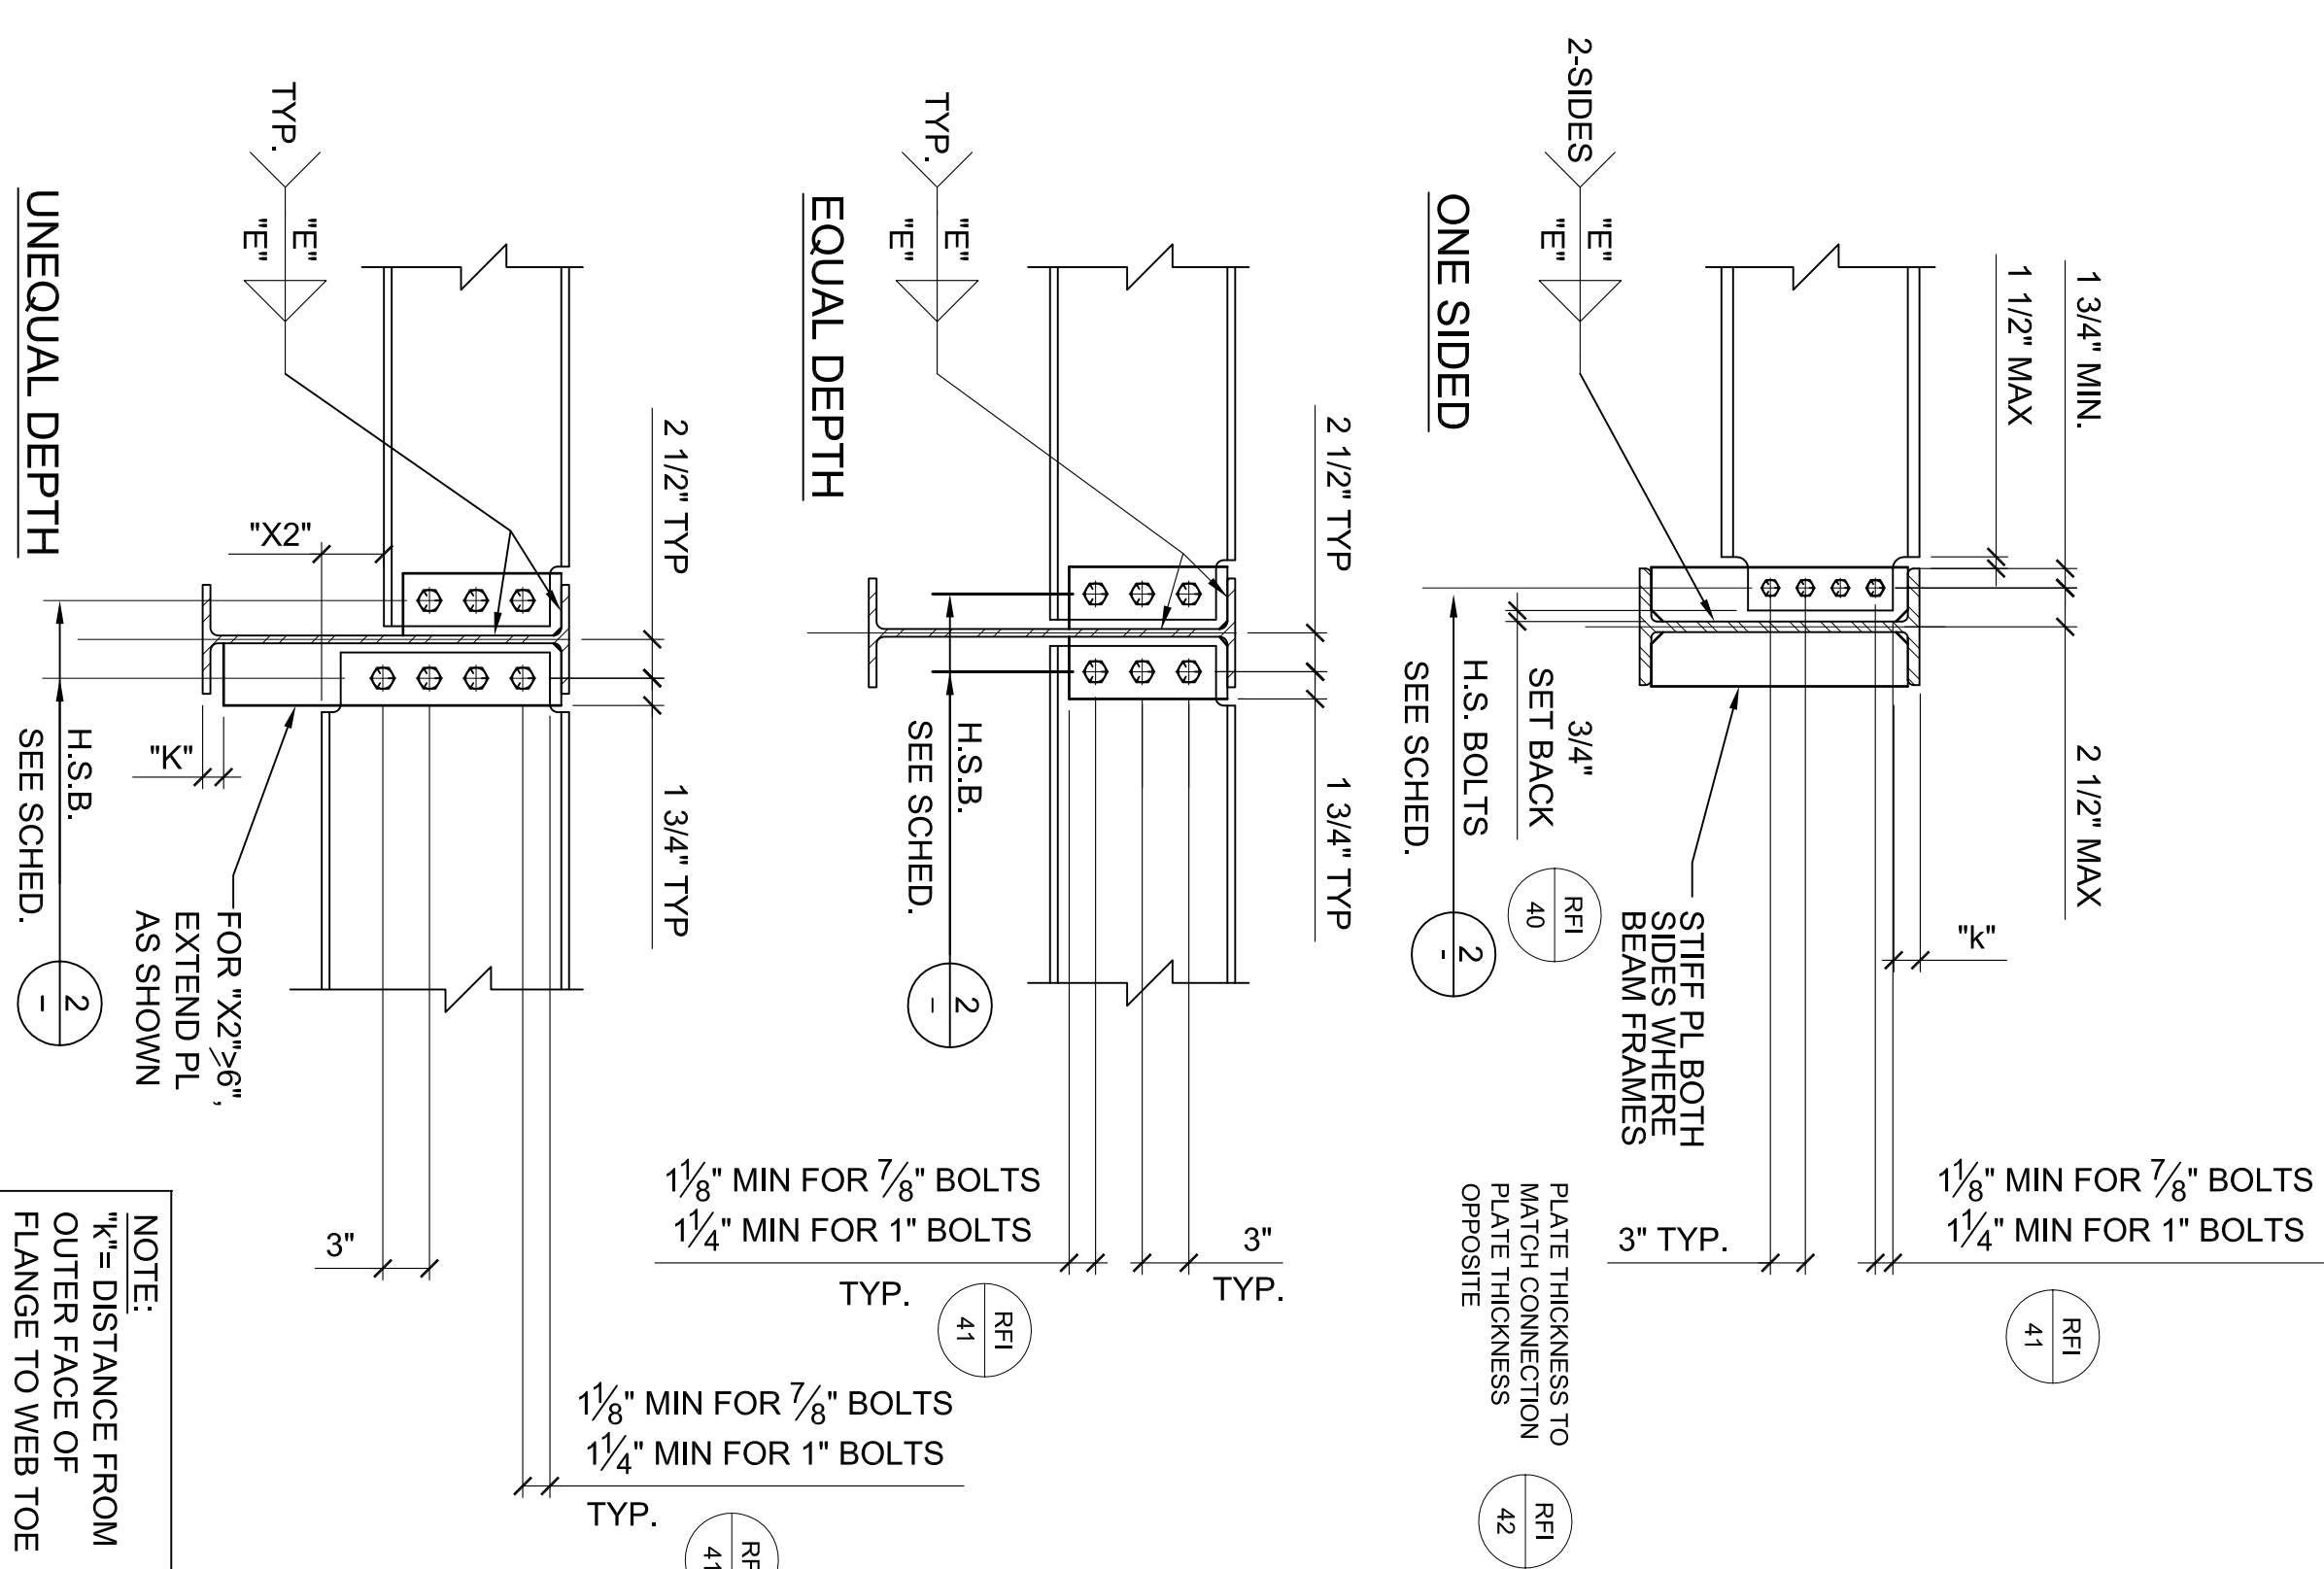


**6 NON-MOMENT STEEL CONNECTION BEAM TO BEAM OR BEAM TO GIRDER**  
N.T.S.

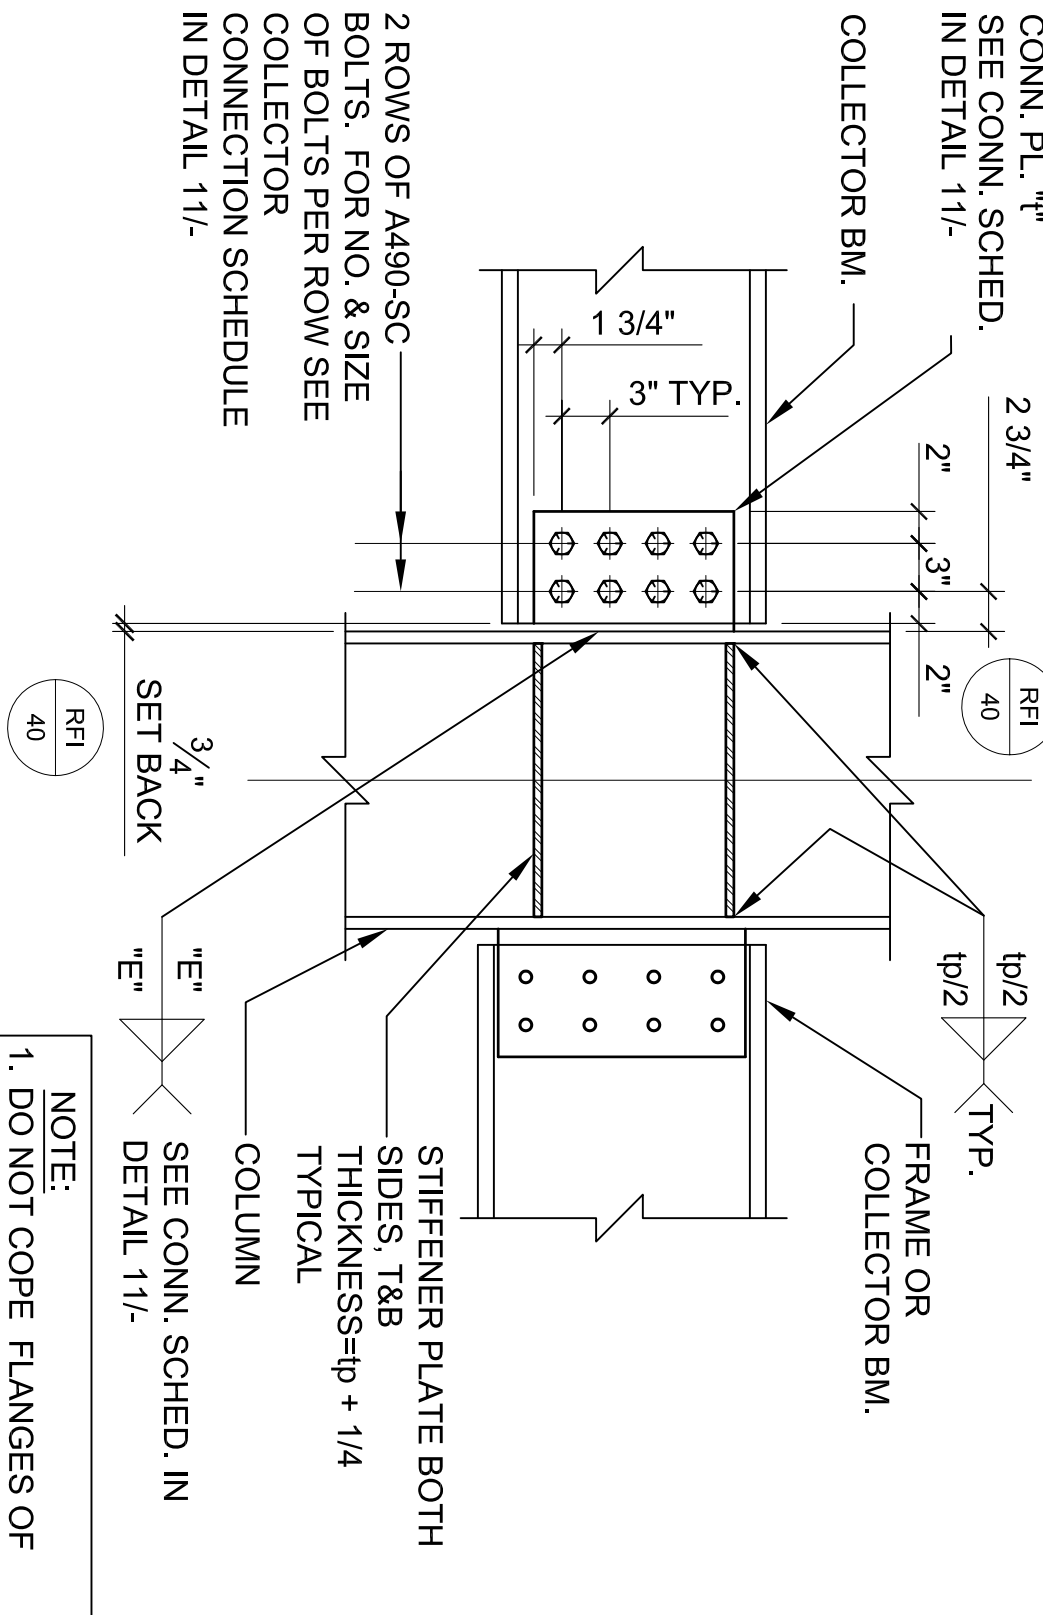

**7 COLLECTOR CONNECTION BEAM TO COLUMN FLANGE**  
N.T.S.

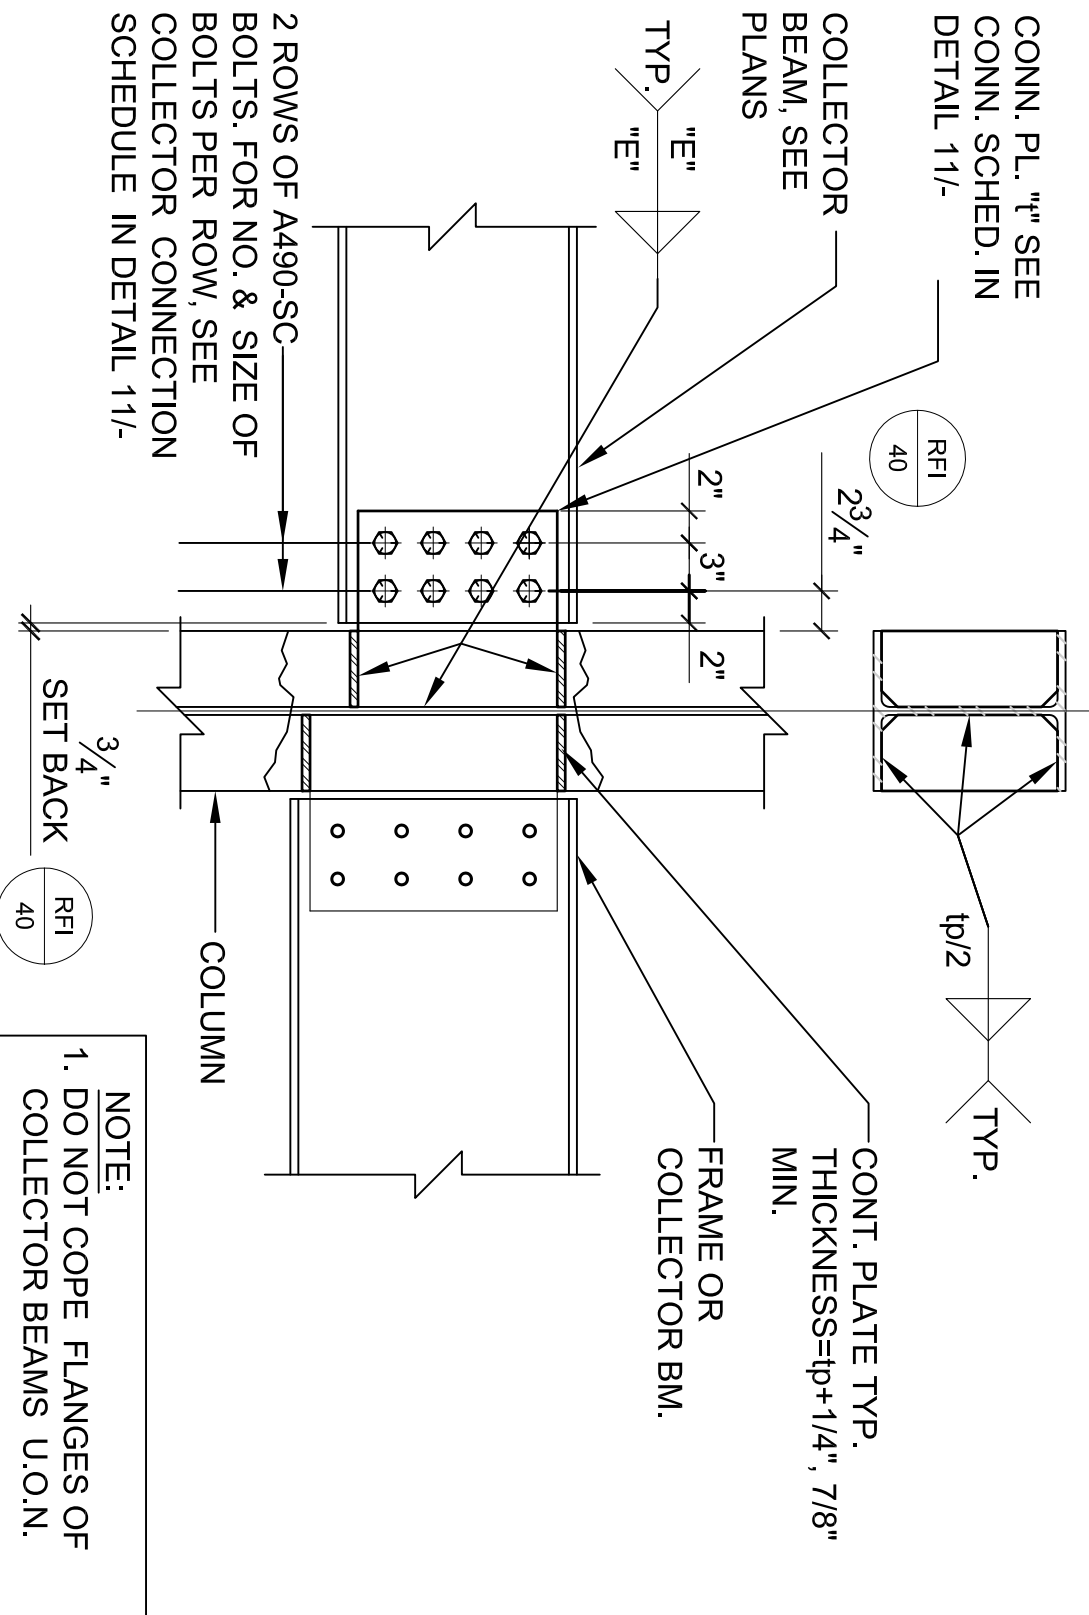

**8 COLLECTOR CONNECTION BEAM TO COLUMN WEB**  
N.T.S.

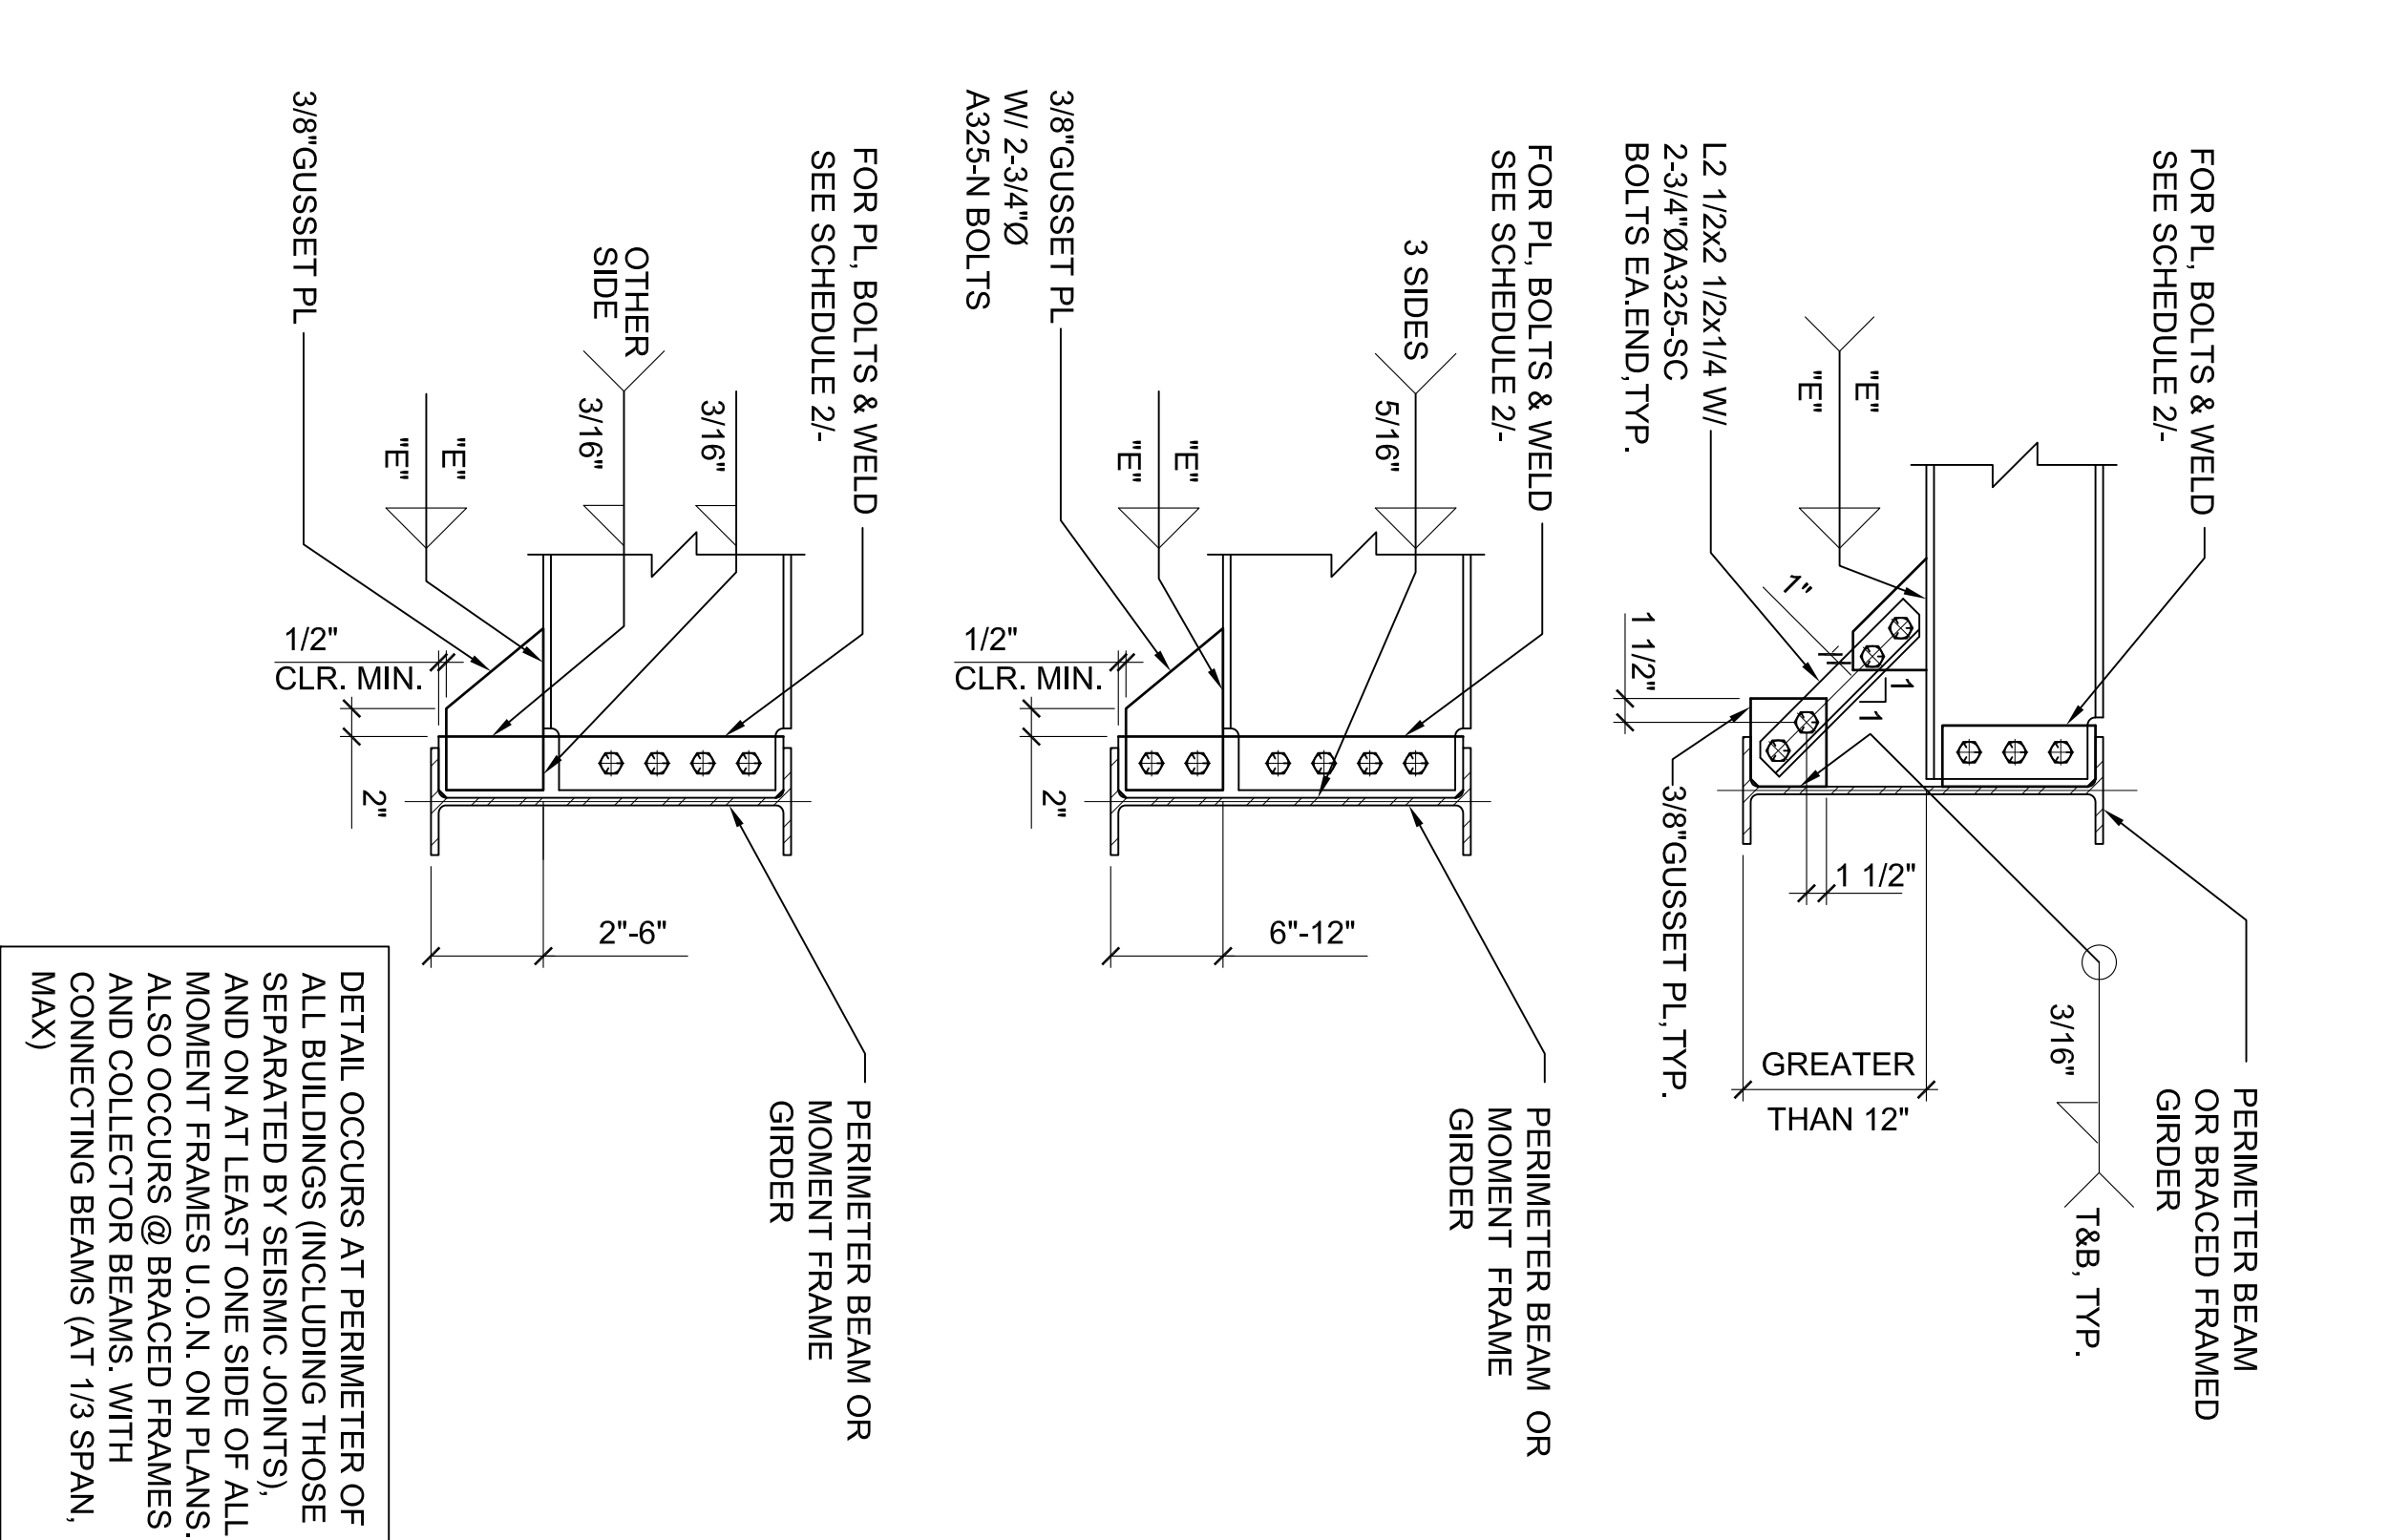


**10 BEAM CONNECTION @ PERIMETER BEAM, MOMENT FRAMES & BRACED FRAMES**  
N.T.S.


FRAMED BEAM CONNECTION SCHEDULE	WELD
BEAM SIZE	E
PLATE-T	E
CONNECTION	E
BOLTS	E
W10	3/4"
W14	3/4"
W16	3/4"
W18	3/4"
W21	3/4"
W24	3/4"
W27	3/4"
W30	3/4"
W33	3/4"

1. USE A490-SC STD BOLTS
2. USE PLATE-F<sub>y</sub>=50ksi F<sub>u</sub>=65 ksi
3. STEEL BEAM-F<sub>y</sub>=50 ksi
4. BASED ON LRFD


**11 FRAMED BEAM COLLECTOR CONNECTION**  
N.T.S.

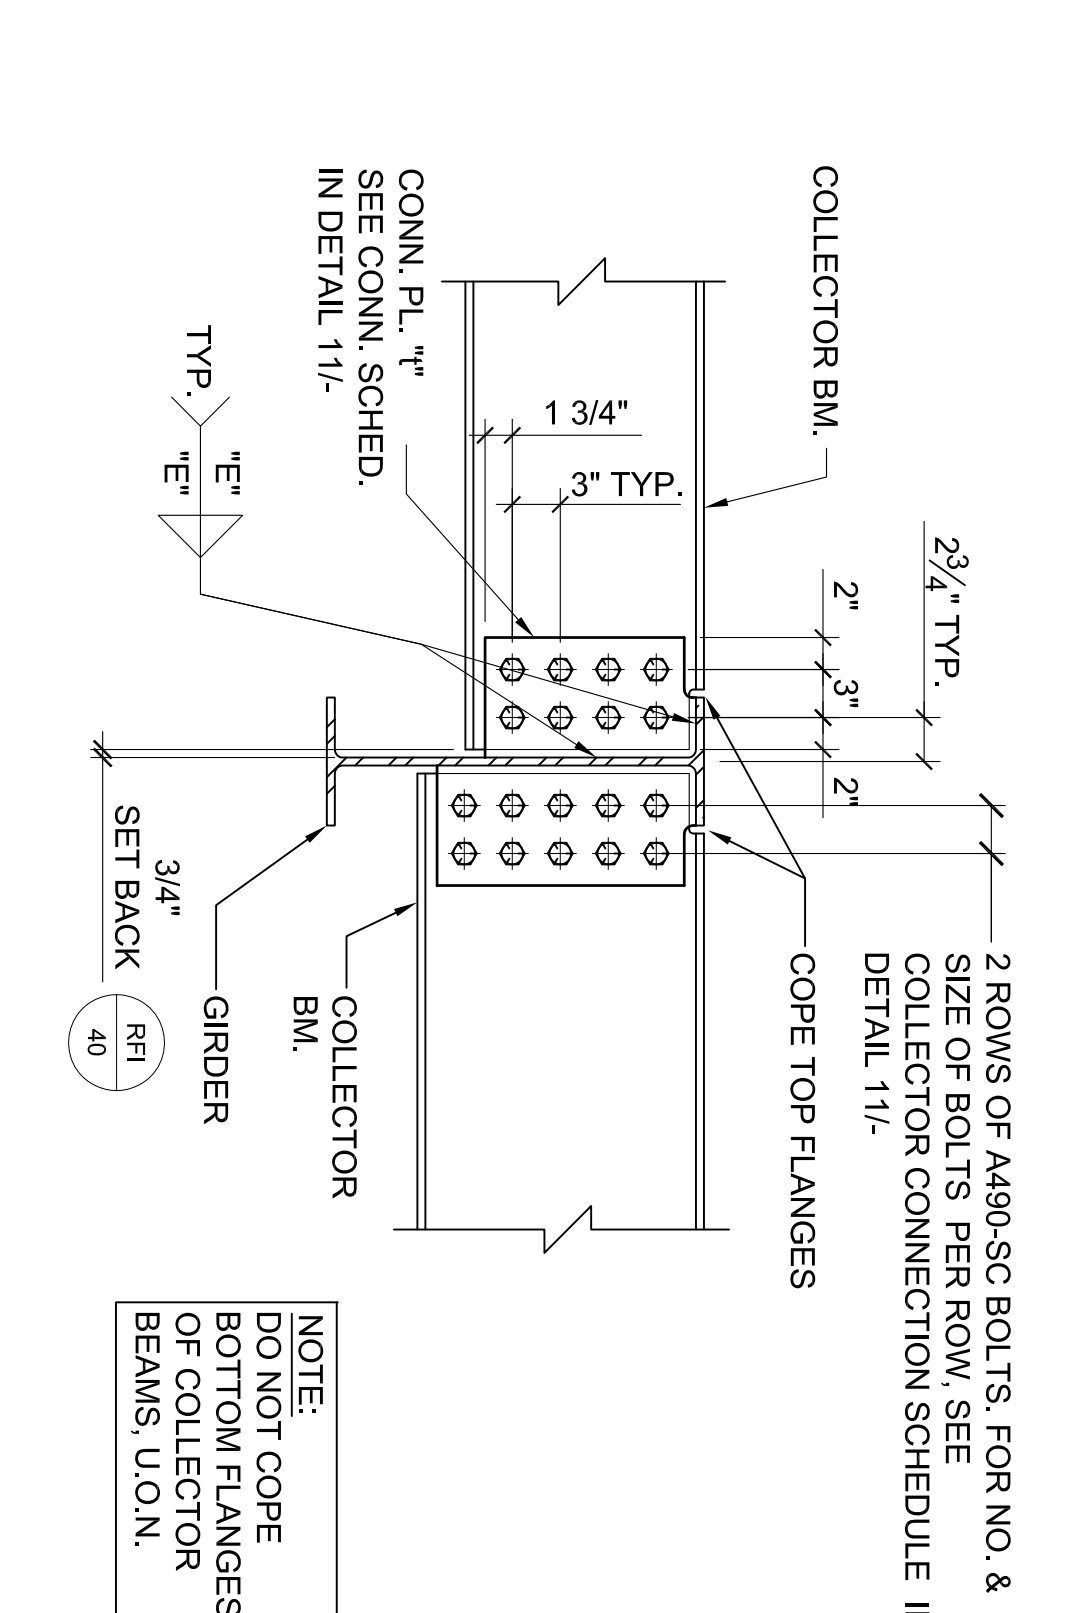

**12 BEAM TO BEAM COLLECTOR CONNECTION DETAIL**  
N.T.S.

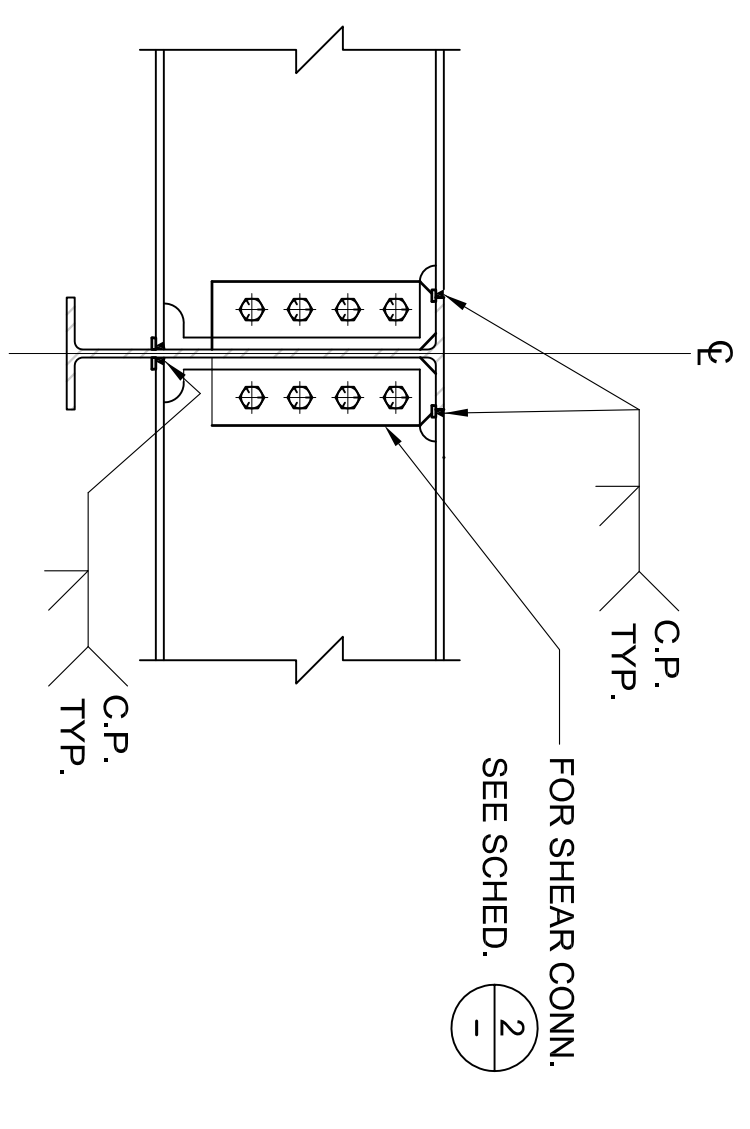


**15 MOMENT BM TO GIRDER CONNECTION**  
N.T.S.

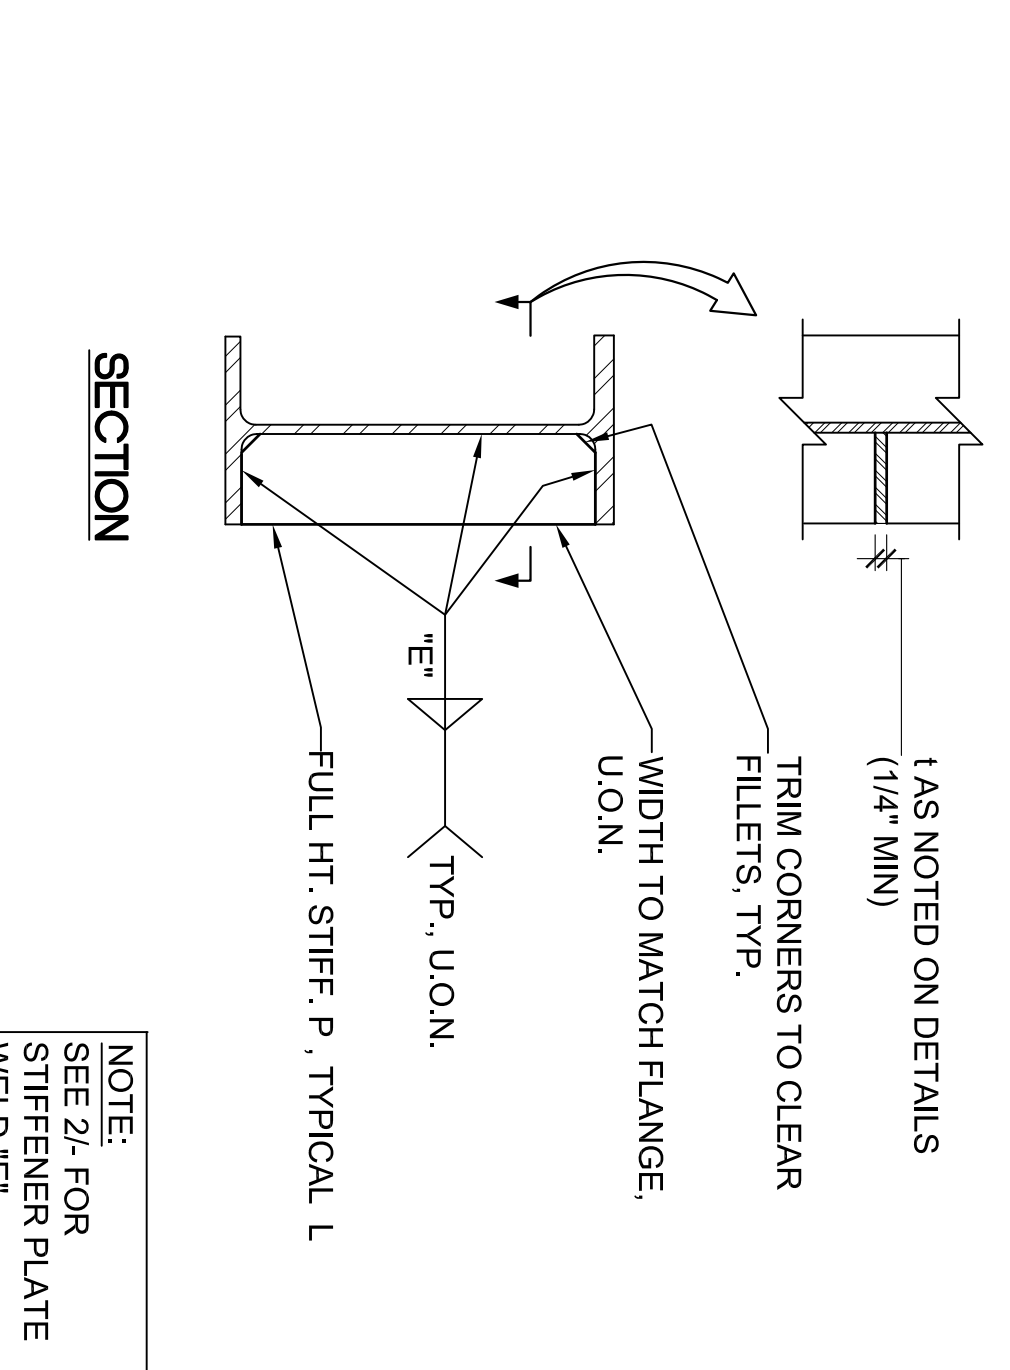


**16 BEAM WEB STIFFENER DETAIL**  
N.T.S.



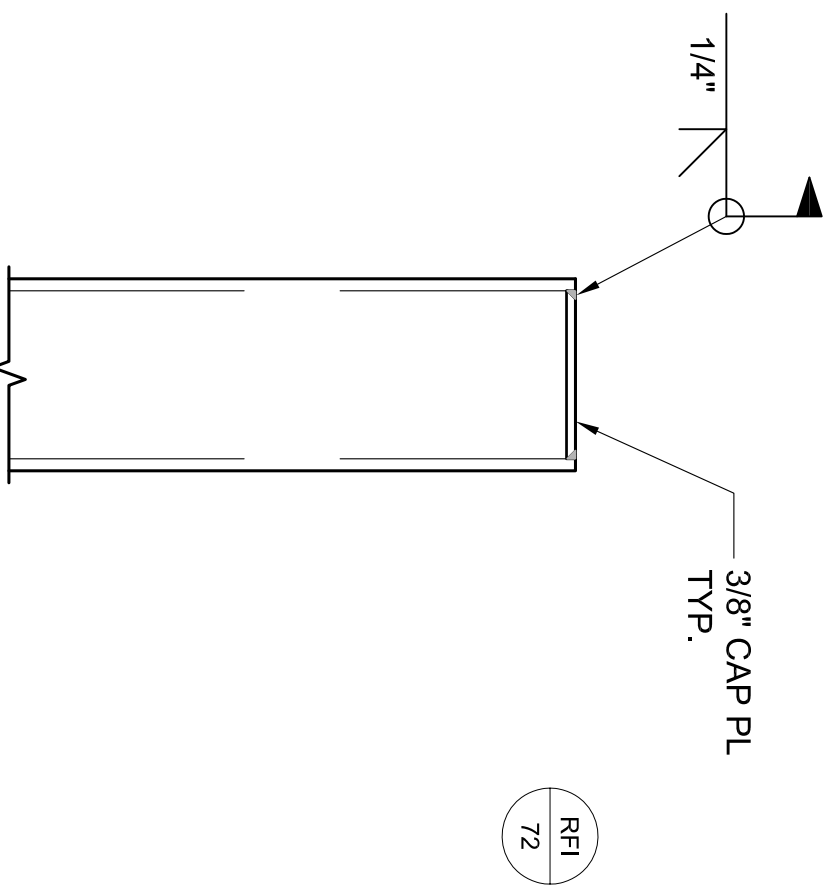


**13** TYPICAL HSS CAP PLATE  
N.T.S.

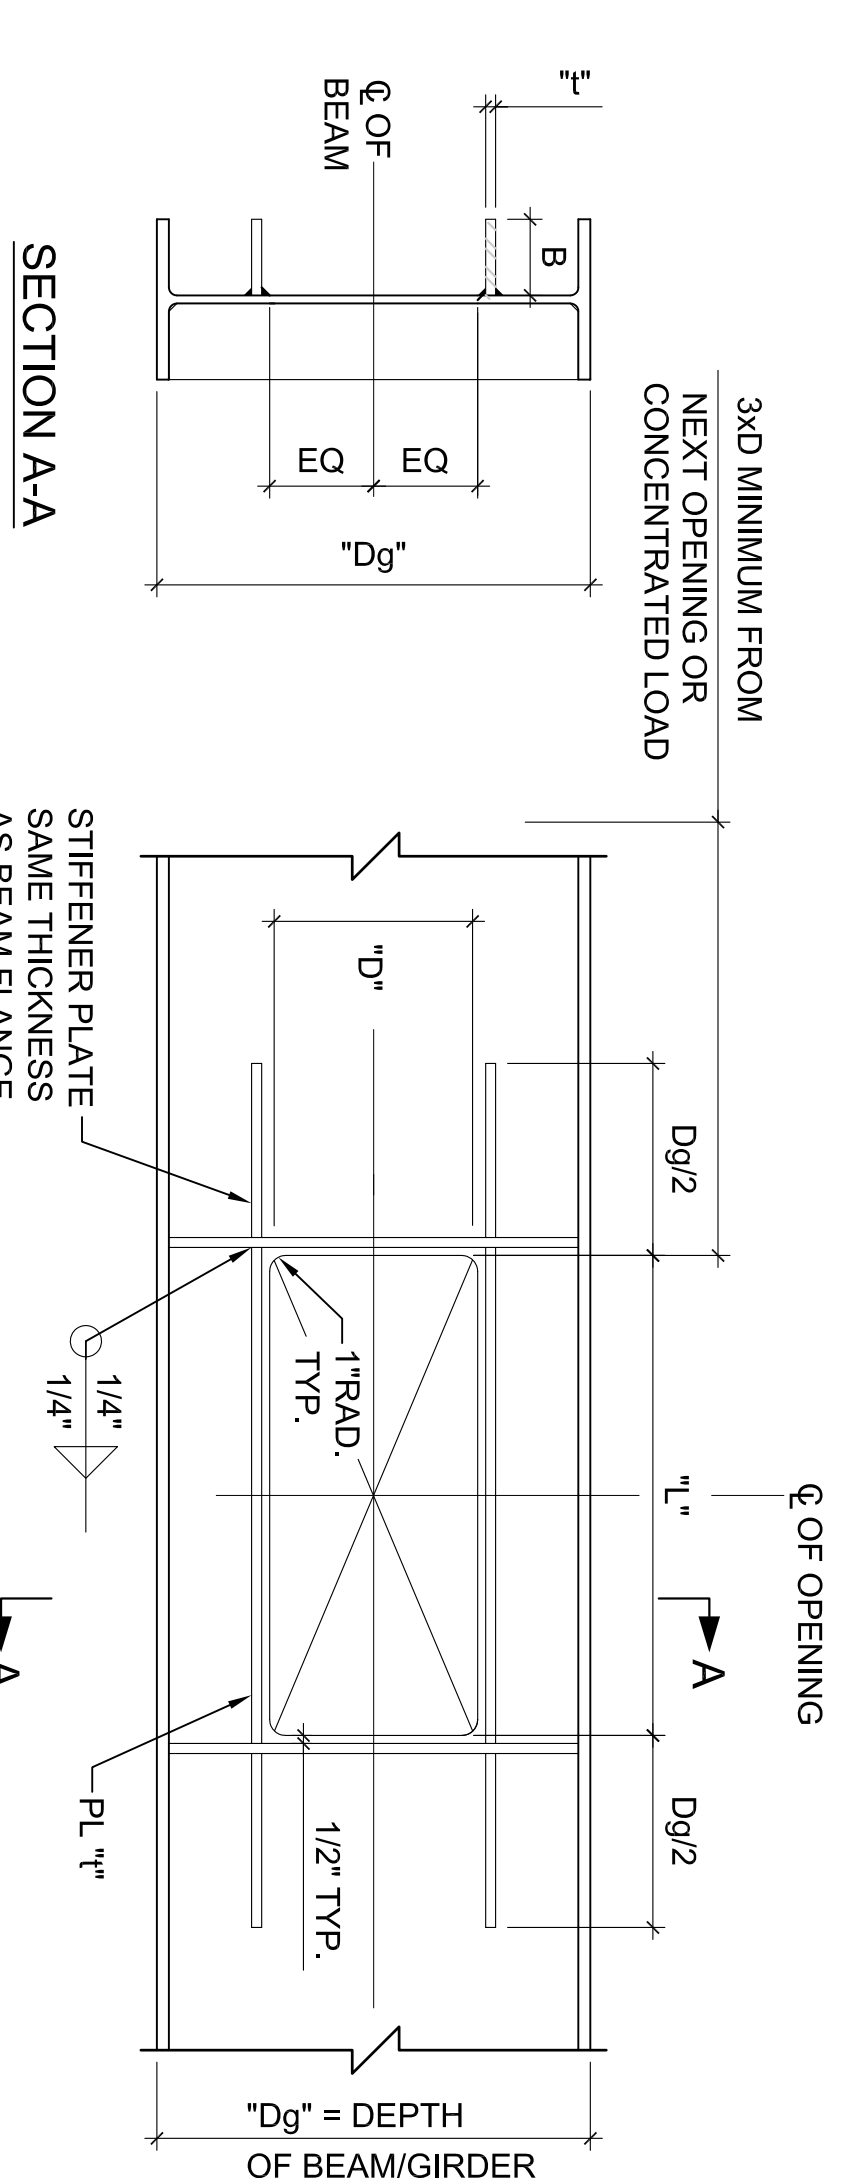


**9** BEAM REINF. @ PIPE PENETRATION  
N.T.S.

BEAM/ GIRDER SIZE	MAXIMUM SIZE OF OPENING (IN)		REINFORCING PLATES (IN)	
	D	L	t	B
W16	5 1/2	16	2 1/2	2 1/2
W18	6	18	2 1/2	2 1/2
W21	7	21	3	3
W24	8	24	3 1/2	3 1/2
W27	9	27	3 1/2	3 1/2
W30	10	30	4	4
W36	12	32	6	6


THICKNESS OF PLATES TO EQUAL THICKNESS OF BEAM FLANGES.

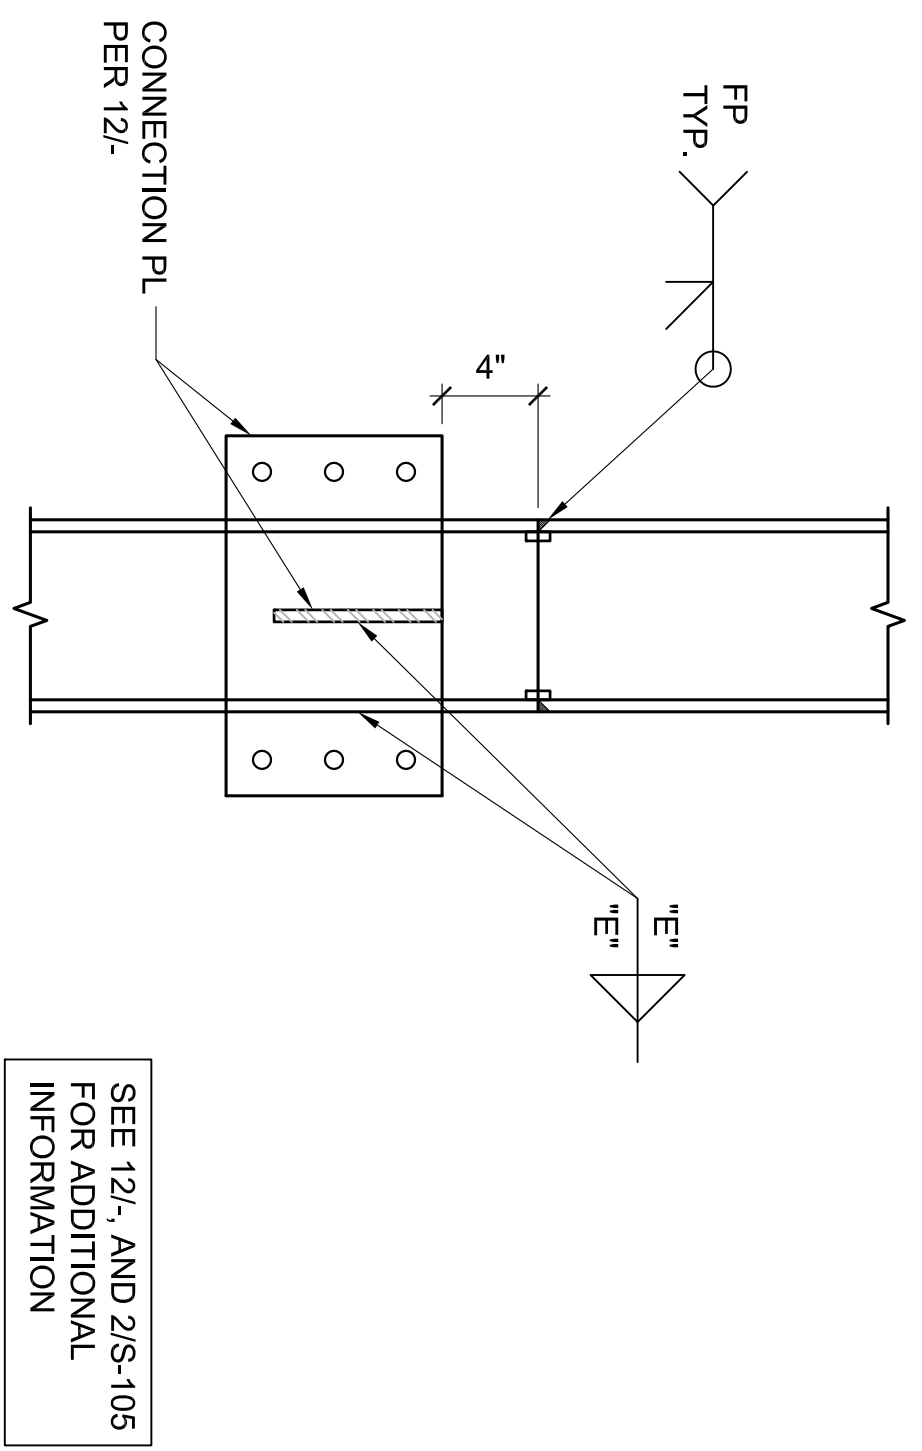


**14** MIDHEIGHT CONNECTION @ HSS COLUMN  
N.T.S.

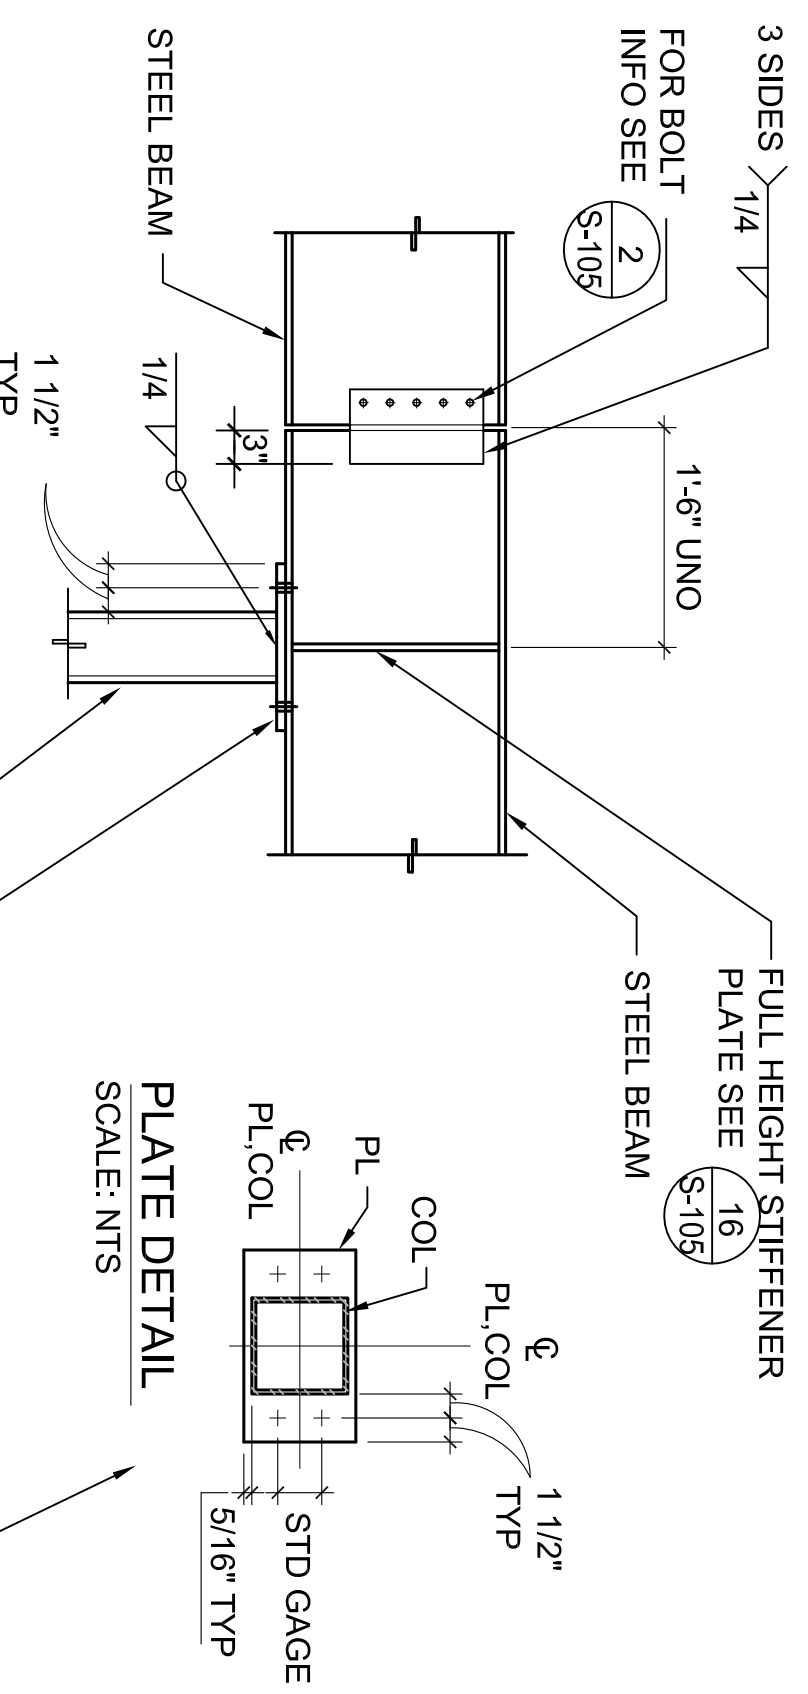


**10** STEEL BEAMS TO COLUMN CONN.  
N.T.S.

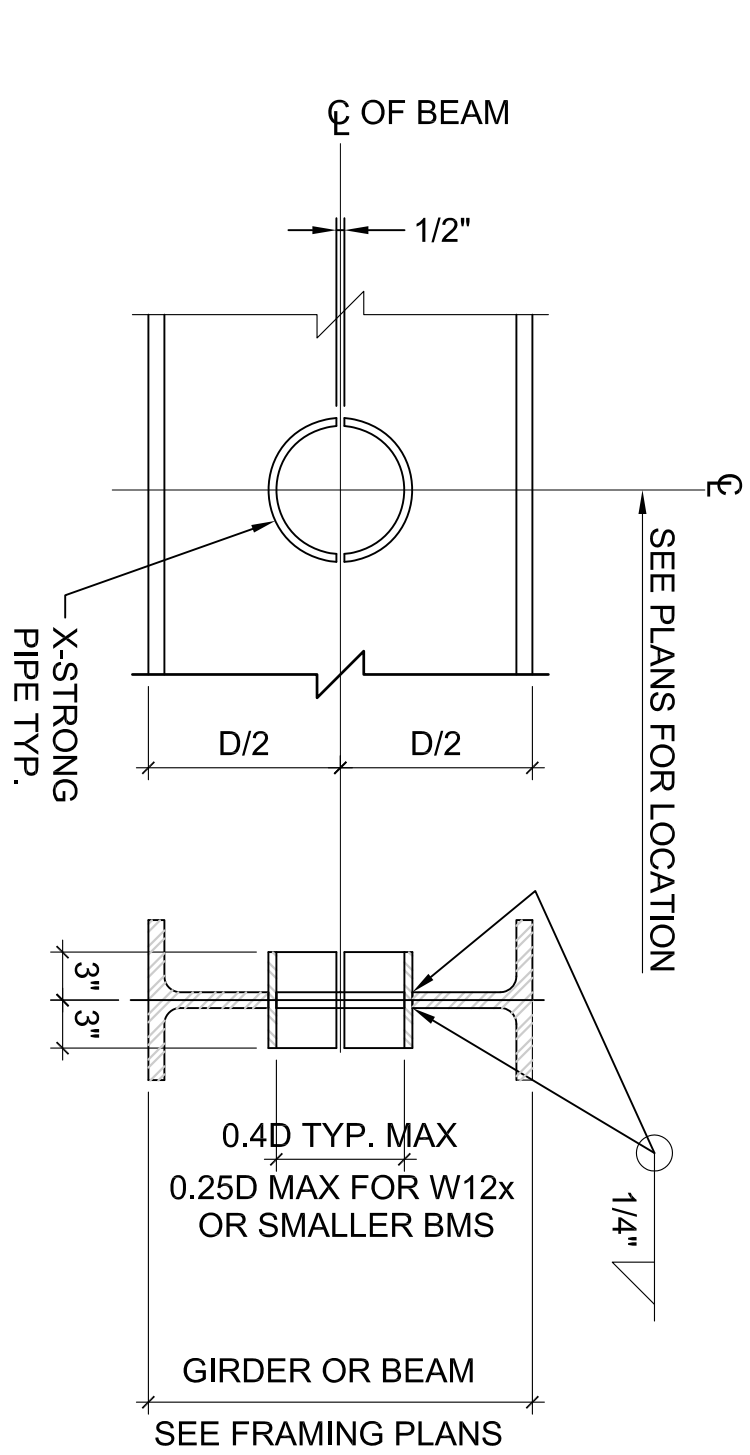


**6** BEAM REINF. @ PIPE PENETRATION  
N.T.S.

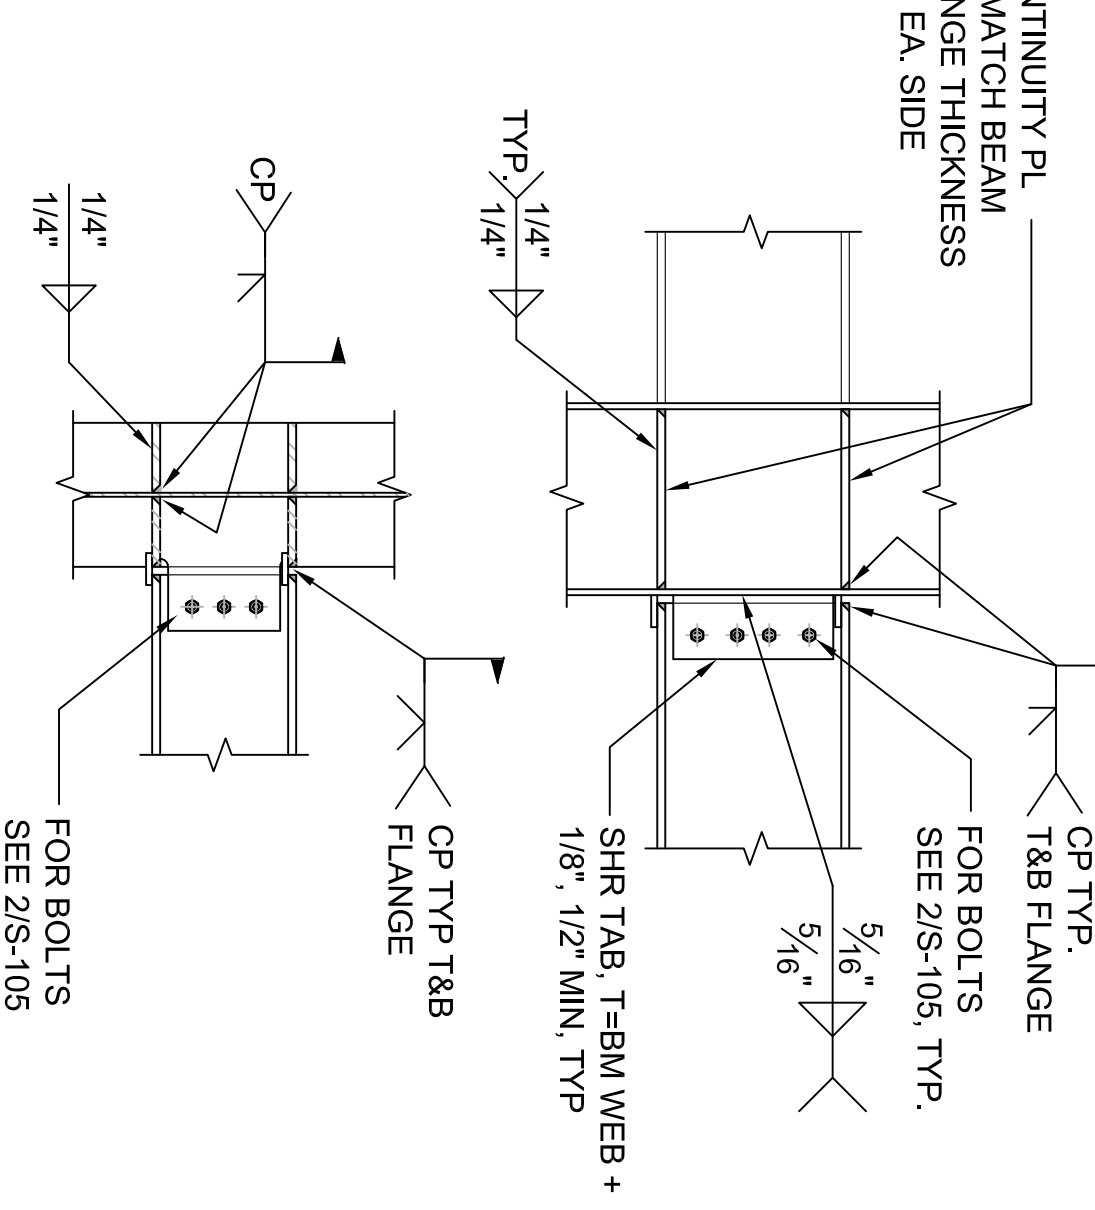


**15** BEAM TO COL. MOMENT GRAVITY CONN.  
N.T.S.

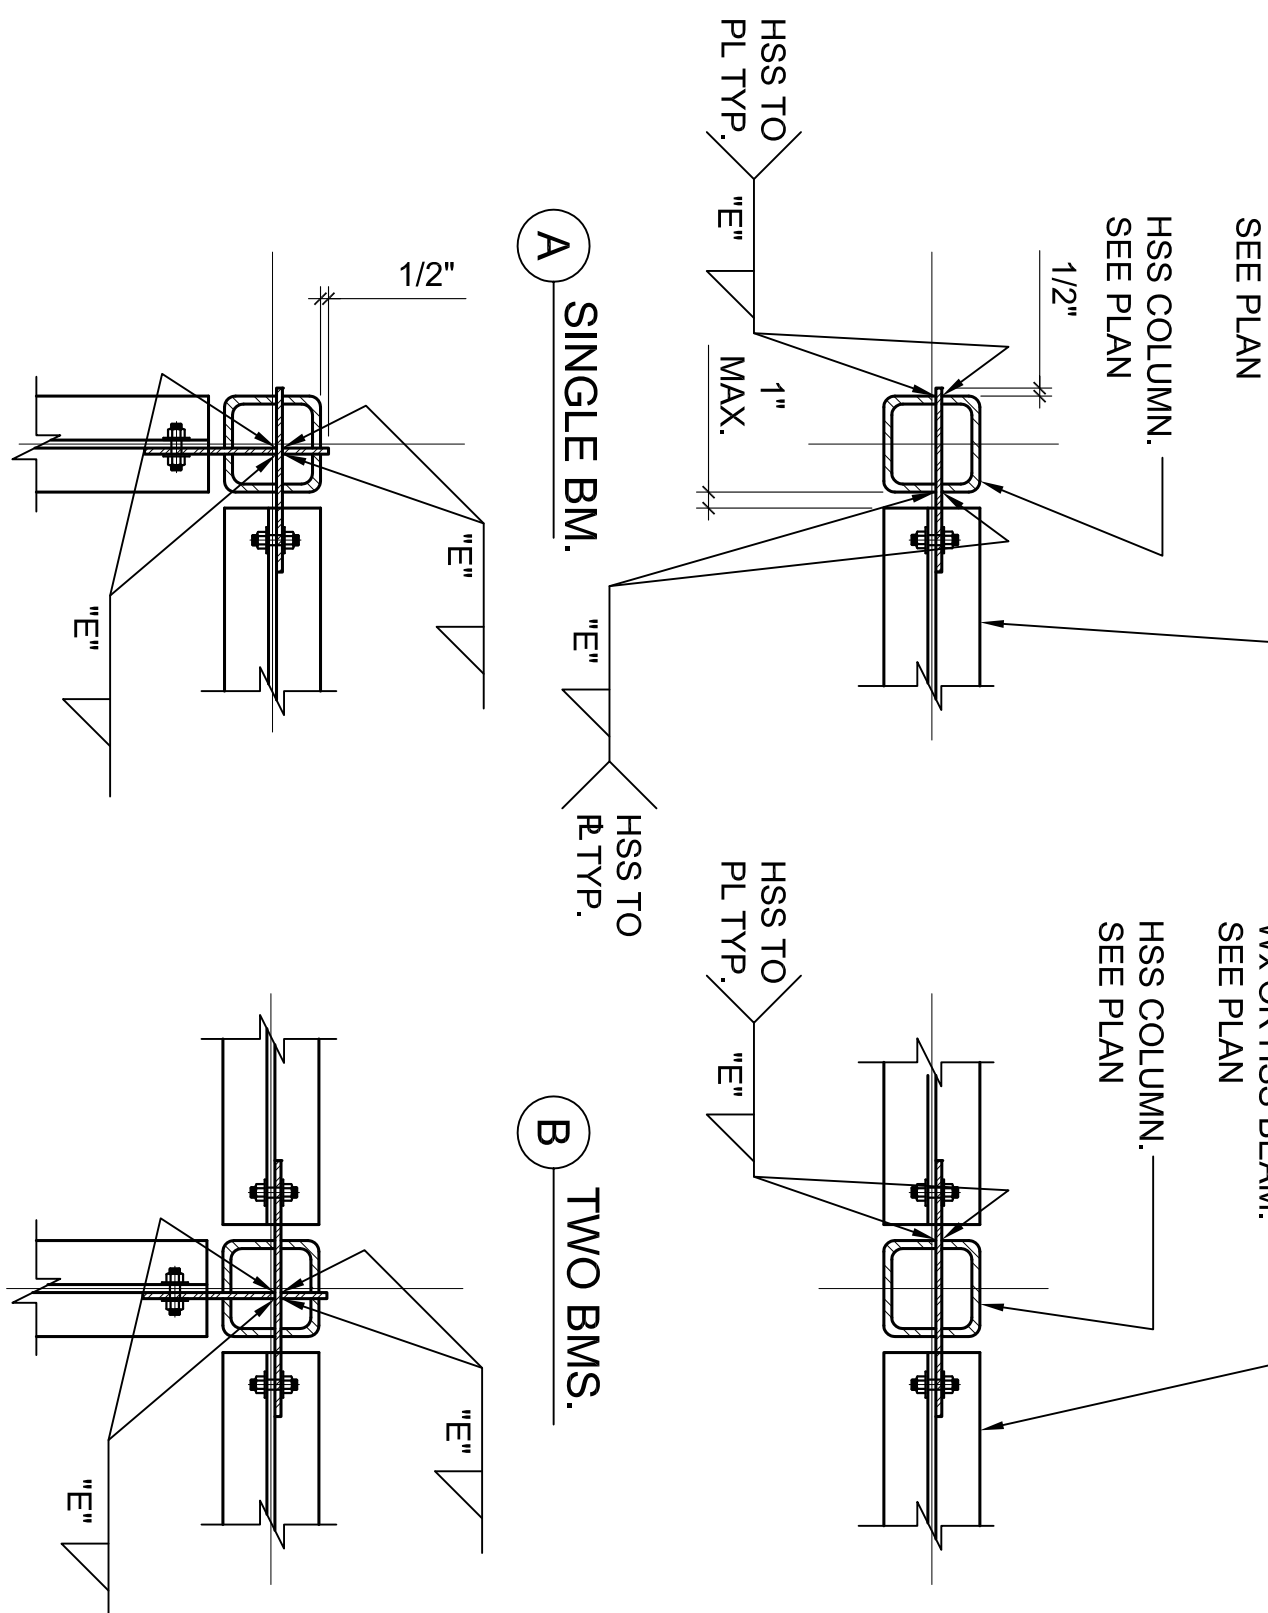


**12** HSS COLUMN TO BEAM  
N.T.S.

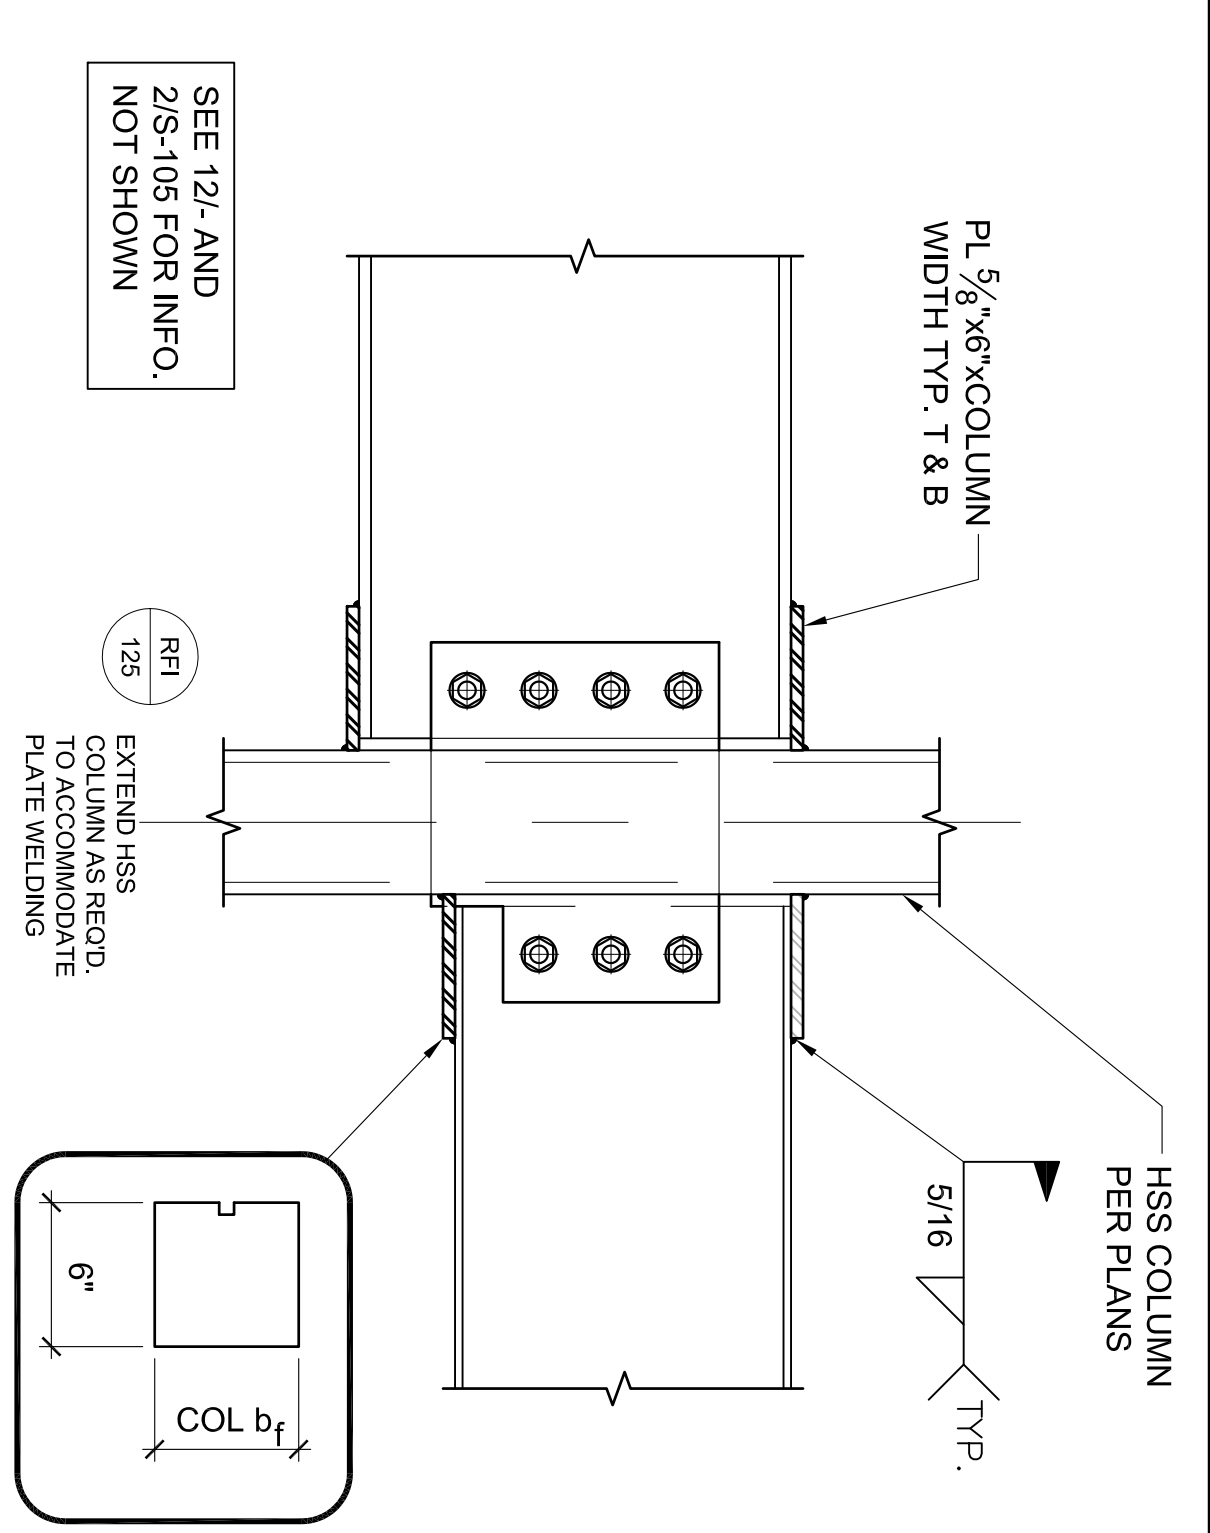


**8** ADDITIONAL BRACING @ EXT. HSS COLUMN  
N.T.S.

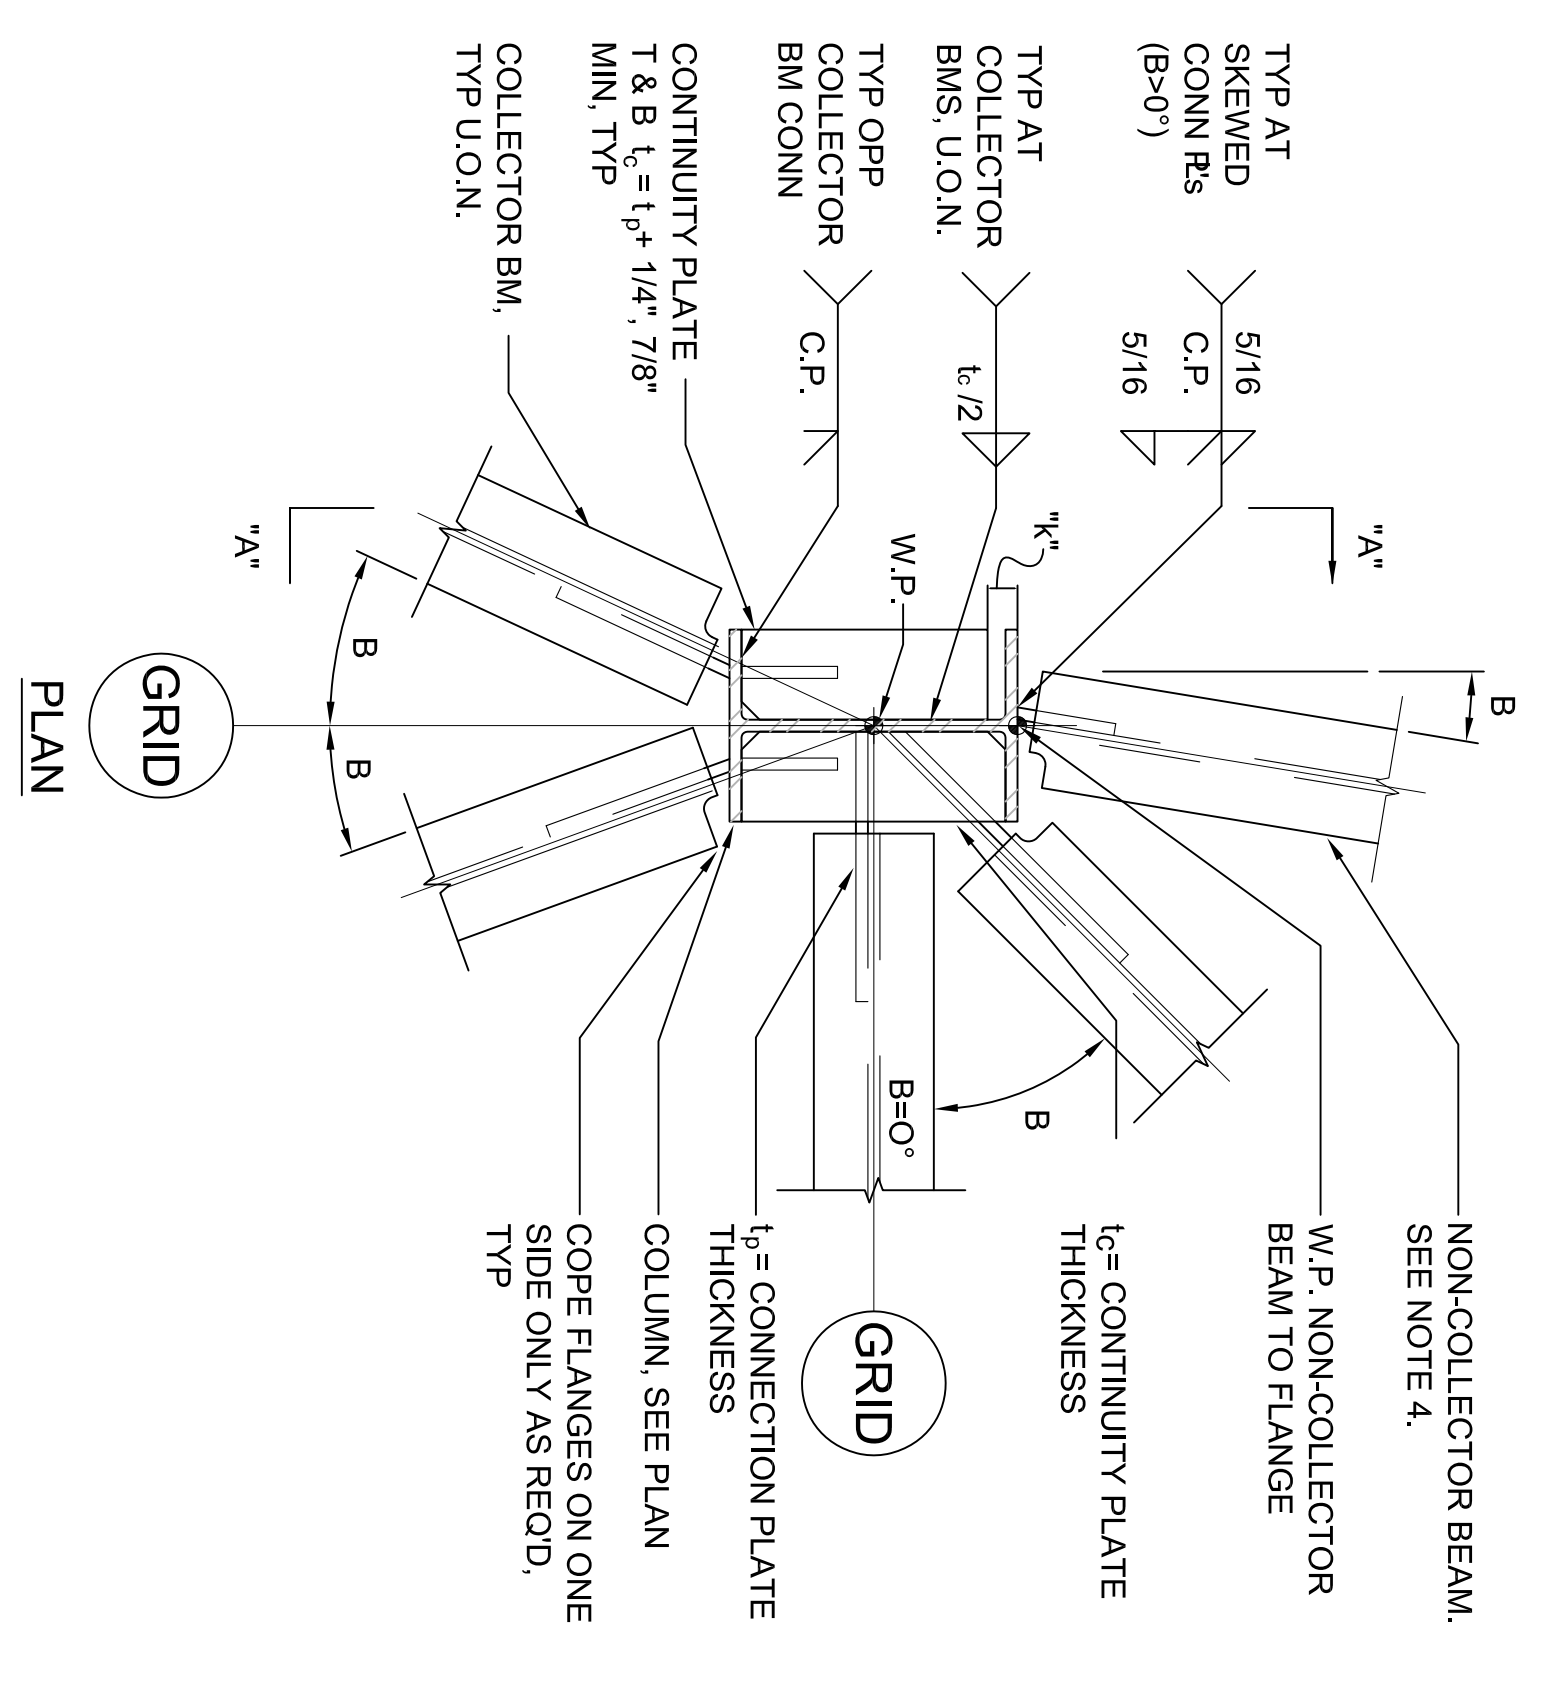

**3** NON-MOMENT SKEWED BEAM TO COLUMN CONNECTION DETAIL  
N.T.S.

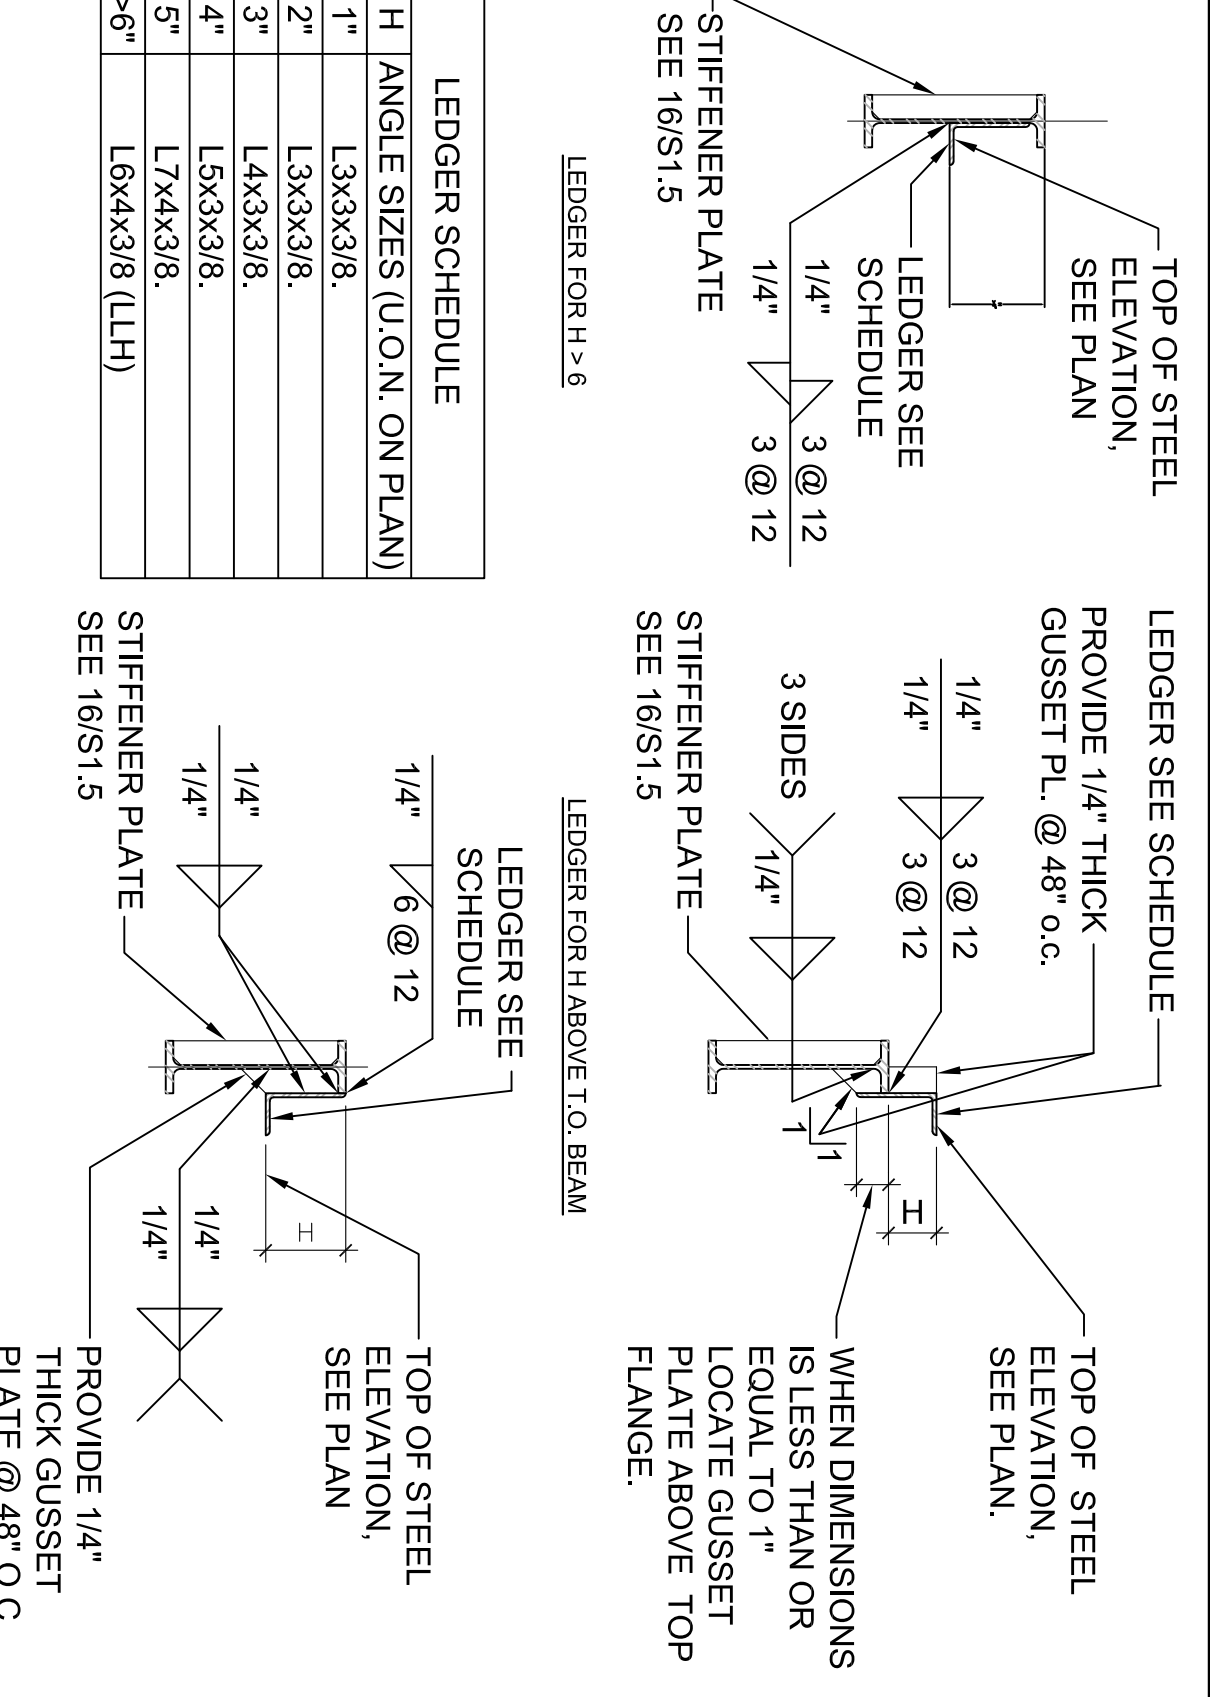


**4** LEDGER DETAIL  
N.T.S.

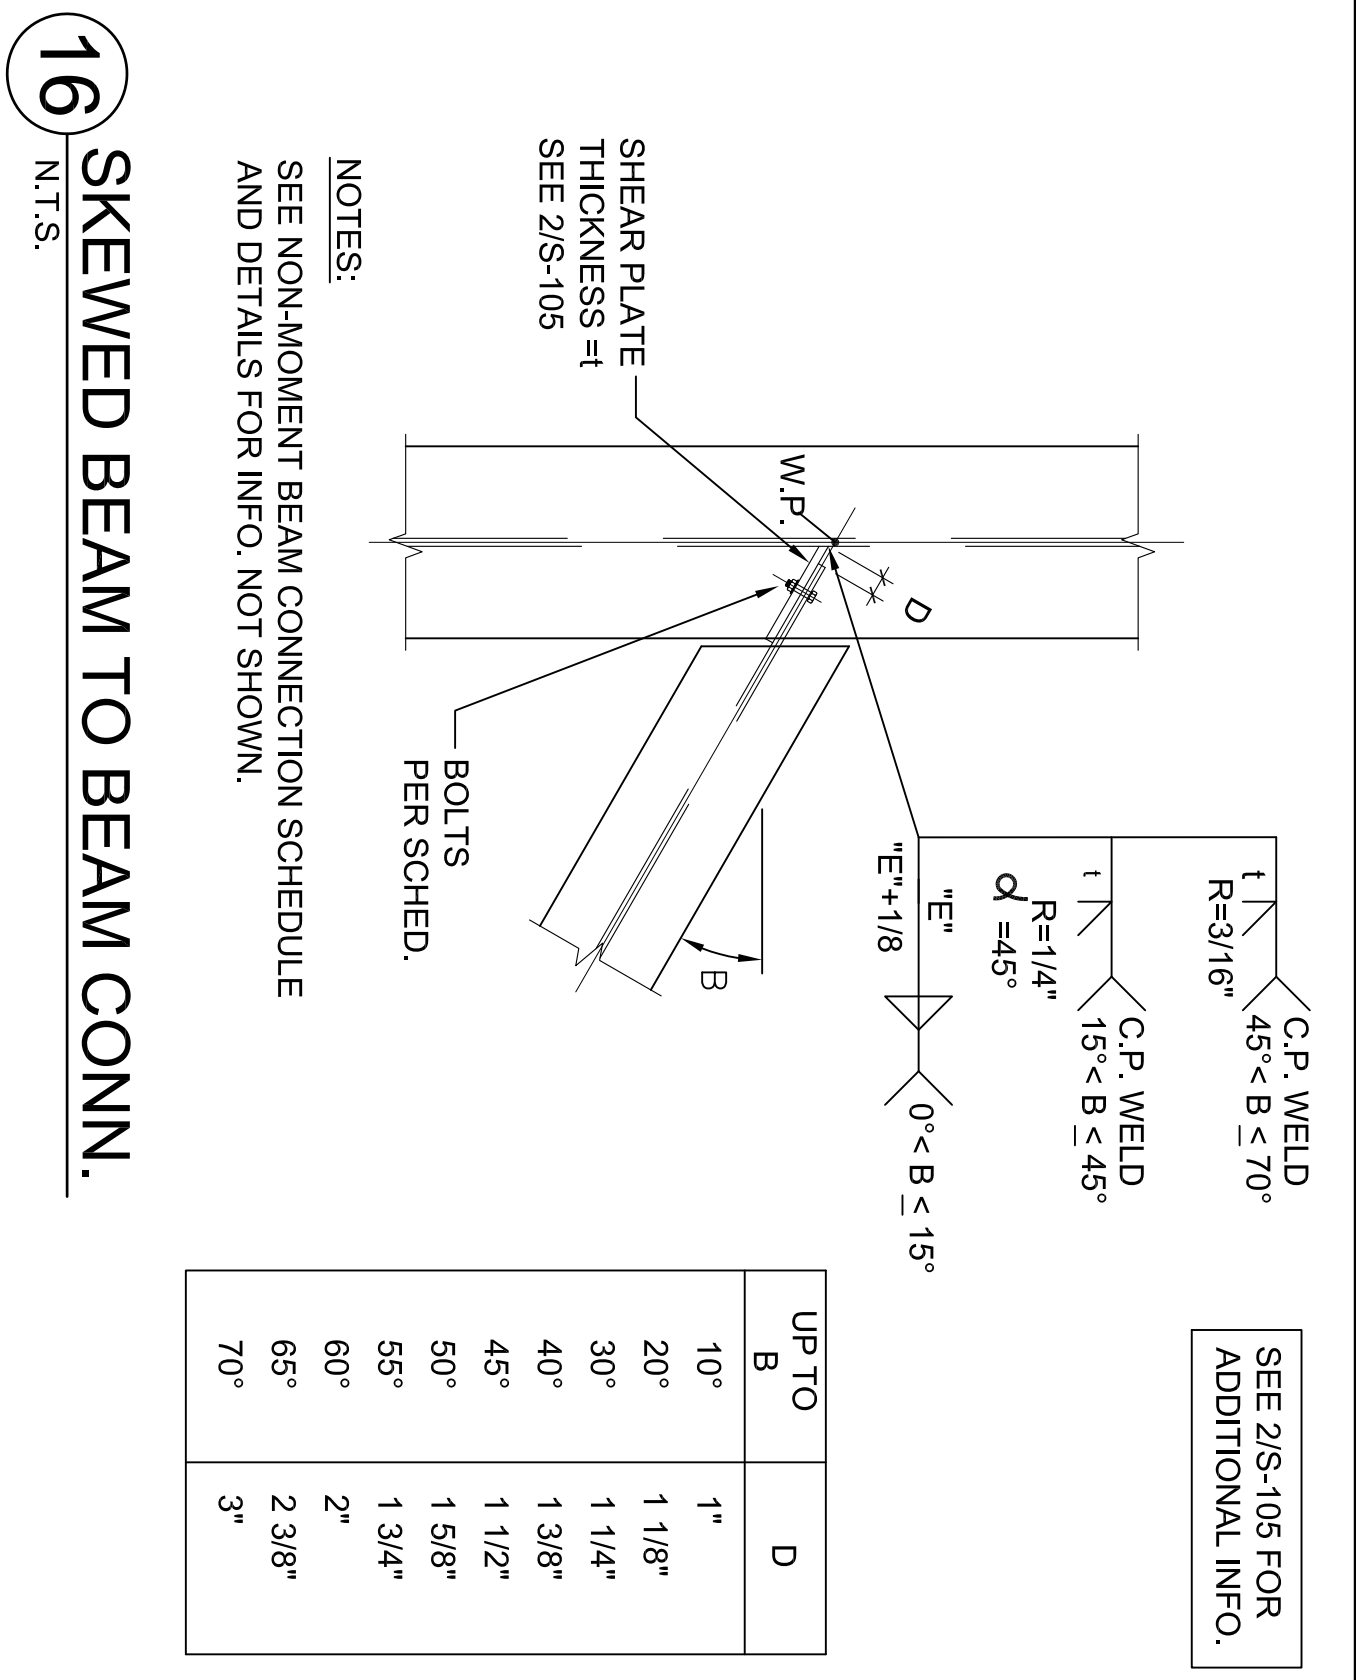

**16** SKEWED BEAM TO BEAM CONN.  
N.T.S.

All drawings and/or related materials have been prepared and checked under the supervision of a registered Professional Engineer and are hereby certified to be correct.


This drawing is to be used only for the project and location specified. It is not to be used for any other project or location without the written consent of the design engineer.

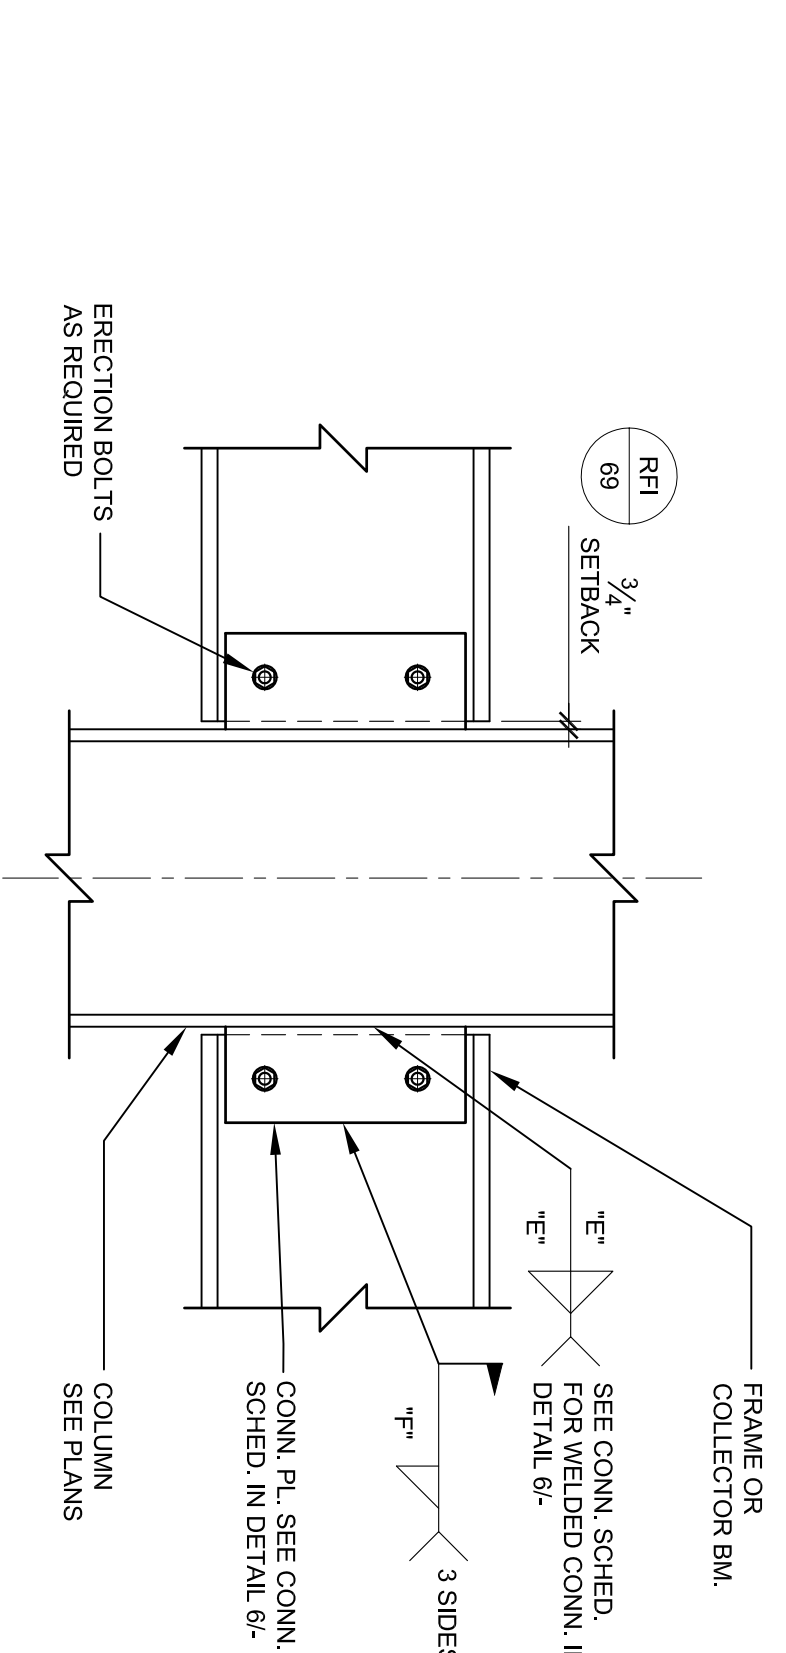

WELDED COLLECTOR CONNECTION			REMARKS		
BEAM SIZE	PLATE	CONNECTION	-E-	-F-	-S-
W16	11"x13"x3/4"	3/8"	3/8"	3/8"	
W18	12"x8"x3/4"	3/8"	3/8"	3/8"	
W21	15"x8"x3/4"	7/16"	7/16"	7/16"	
W24	18"x8"x3/4"	1/2"	1/2"	1/2"	

1. ALL PLATES - F<sub>y</sub>=50 ksi F<sub>w</sub>=65 ksi
2. DO NOT COPE FLANGES OF COLLECTOR OR BEAMS U.O.N.
3. SEE DETAIL 4/IS-105 FOR ANGLES @ PERIMETER BEAMS.
4. PERPENDICULAR BEAM & CONNECTIONS NOT SHOWN FOR CLARITY.
5. SEE 805 FOR ADDITIONAL REQUIREMENTS AT WEAK-AXIS COLUMN CONNECTIONS.


6 COLLECTOR CONNECTION SCHEDULE (TYPE 1)  
 SCALE: NONE

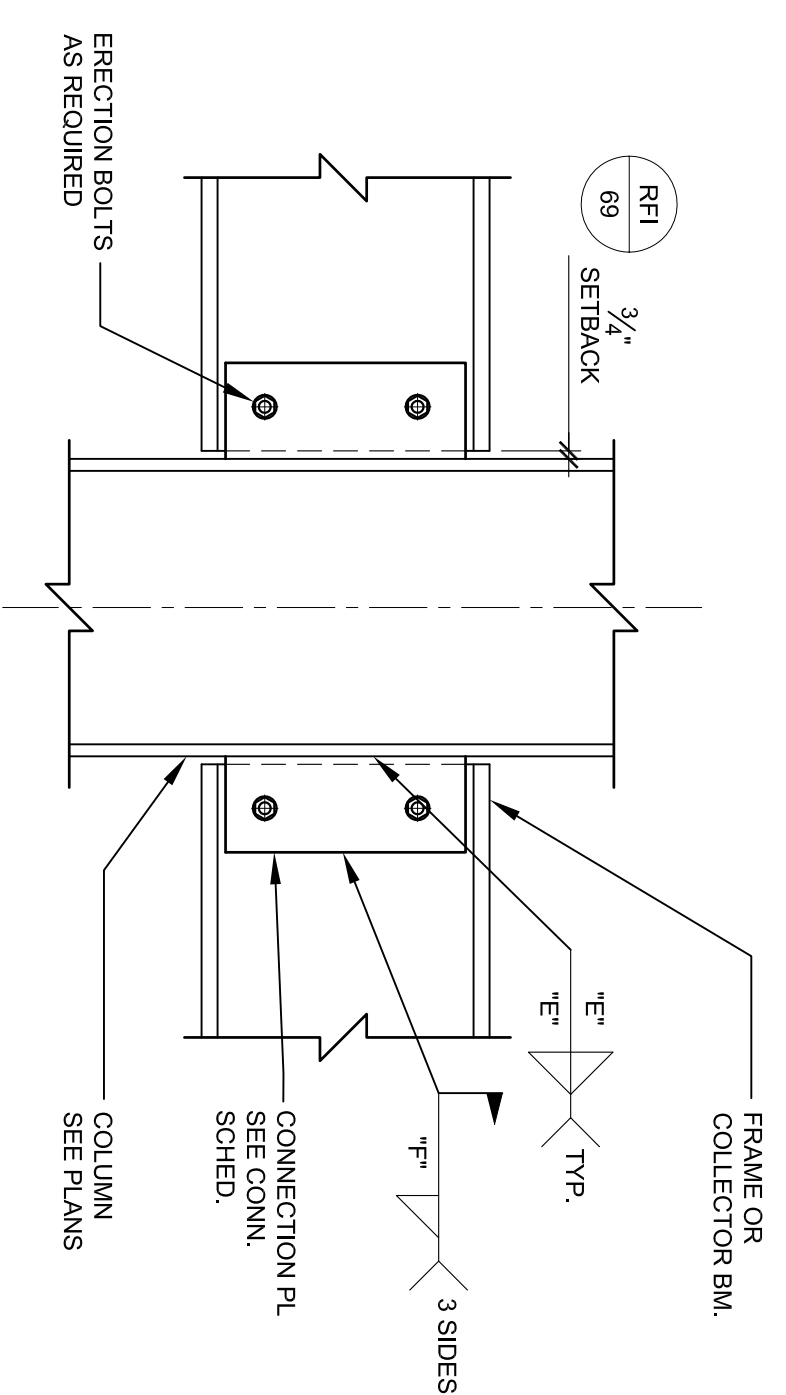


WELDED COLLECTOR CONNECTION			REMARKS		
BEAM SIZE	PLATE	CONNECTION	-E-	-F-	-S-
W21	15"x13"x3/4"	7/16"	7/16"	7/16"	
W24	18"x13"x3/4"	1/2"	1/2"	1/2"	
W27	20"x13"x3/4"	9/16"	9/16"	9/16"	

1. ALL PLATES - F<sub>y</sub>=50 ksi F<sub>w</sub>=65 ksi
2. DO NOT COPE FLANGES OF COLLECTOR OR BEAMS U.O.N.
3. SEE DETAIL 4/IS-105 FOR ANGLES @ PERIMETER BEAMS.
4. PERPENDICULAR BEAM & CONNECTIONS NOT SHOWN FOR CLARITY.
5. SEE 805 FOR ADDITIONAL REQUIREMENTS AT WEAK-AXIS COLUMN CONNECTIONS.


10 COLLECTOR CONNECTION SCHEDULE (TYPE 2)  
 SCALE: NONE

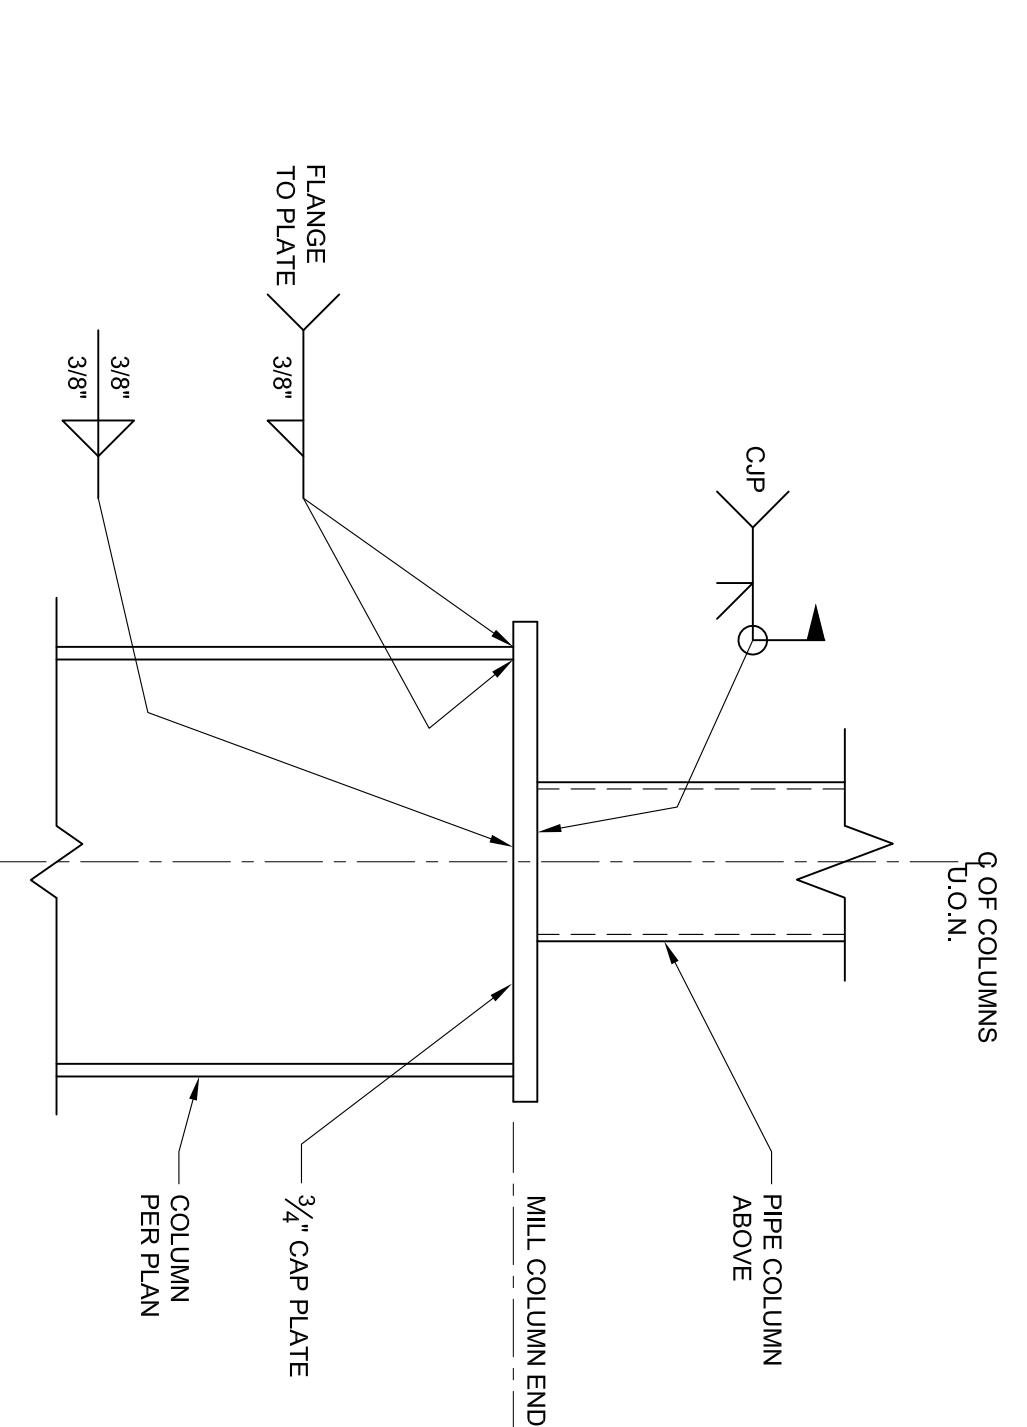


7 POST TO COLUMN DETAIL  
 SCALE: 1/2"=1'-0"

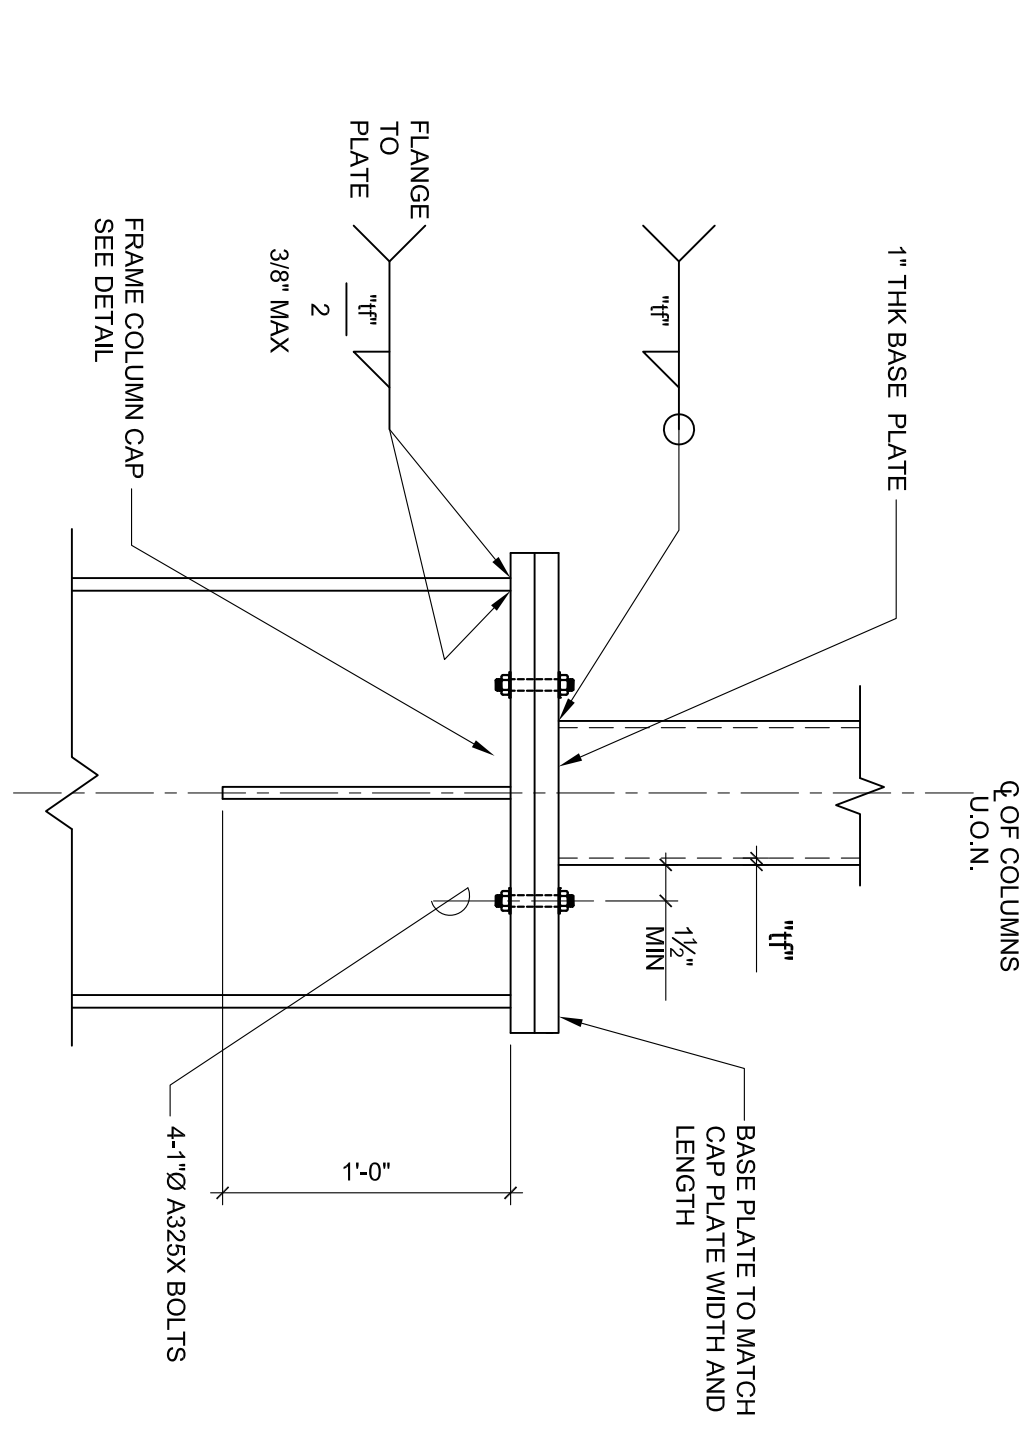

3 TS COLUMN TO FRAME COLUMN DETAIL  
 SCALE: 1/2"=1'-0"








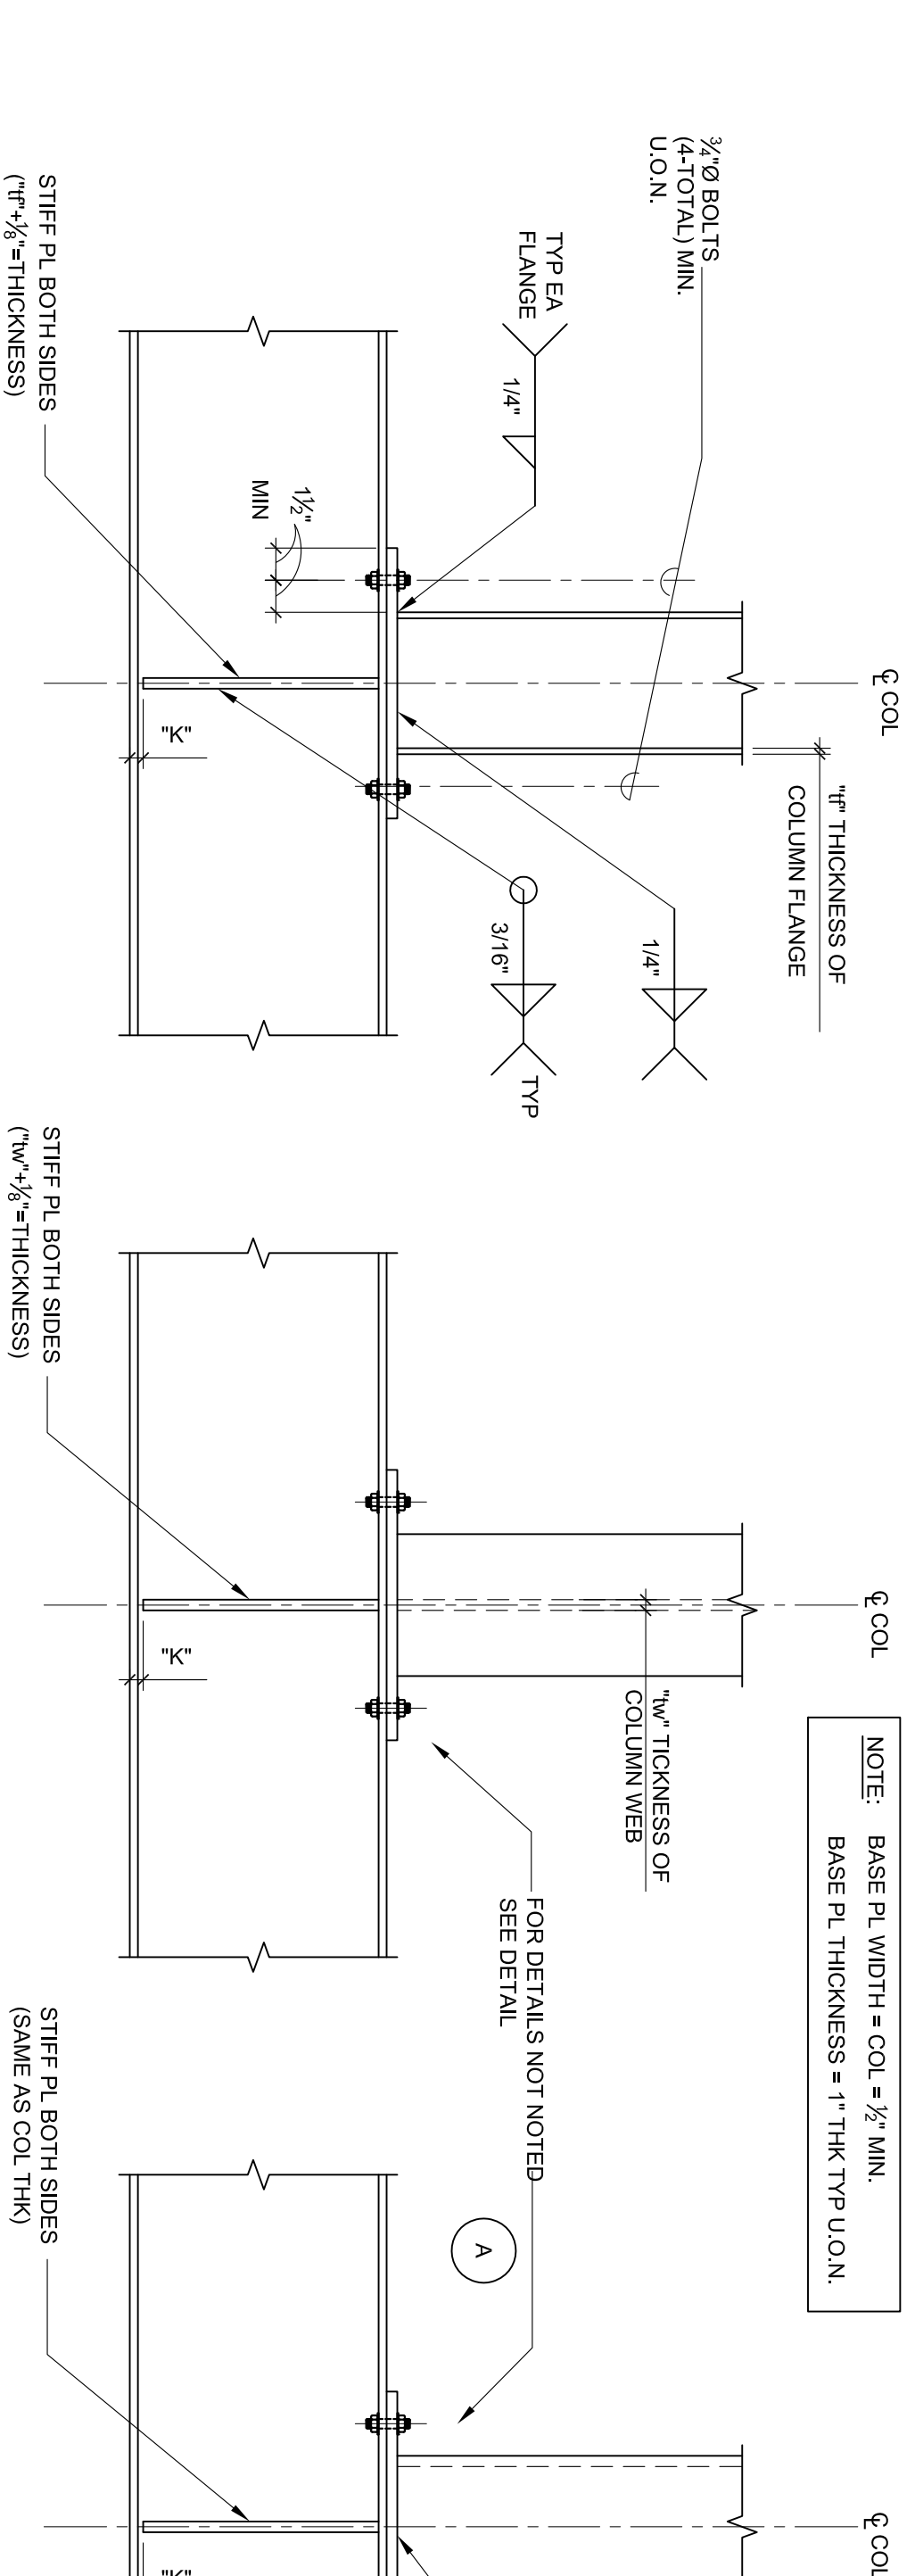


8 TYPICAL NON-FRAME COLUMN TO BEAM  
 SCALE: 1/2"=1'-0"

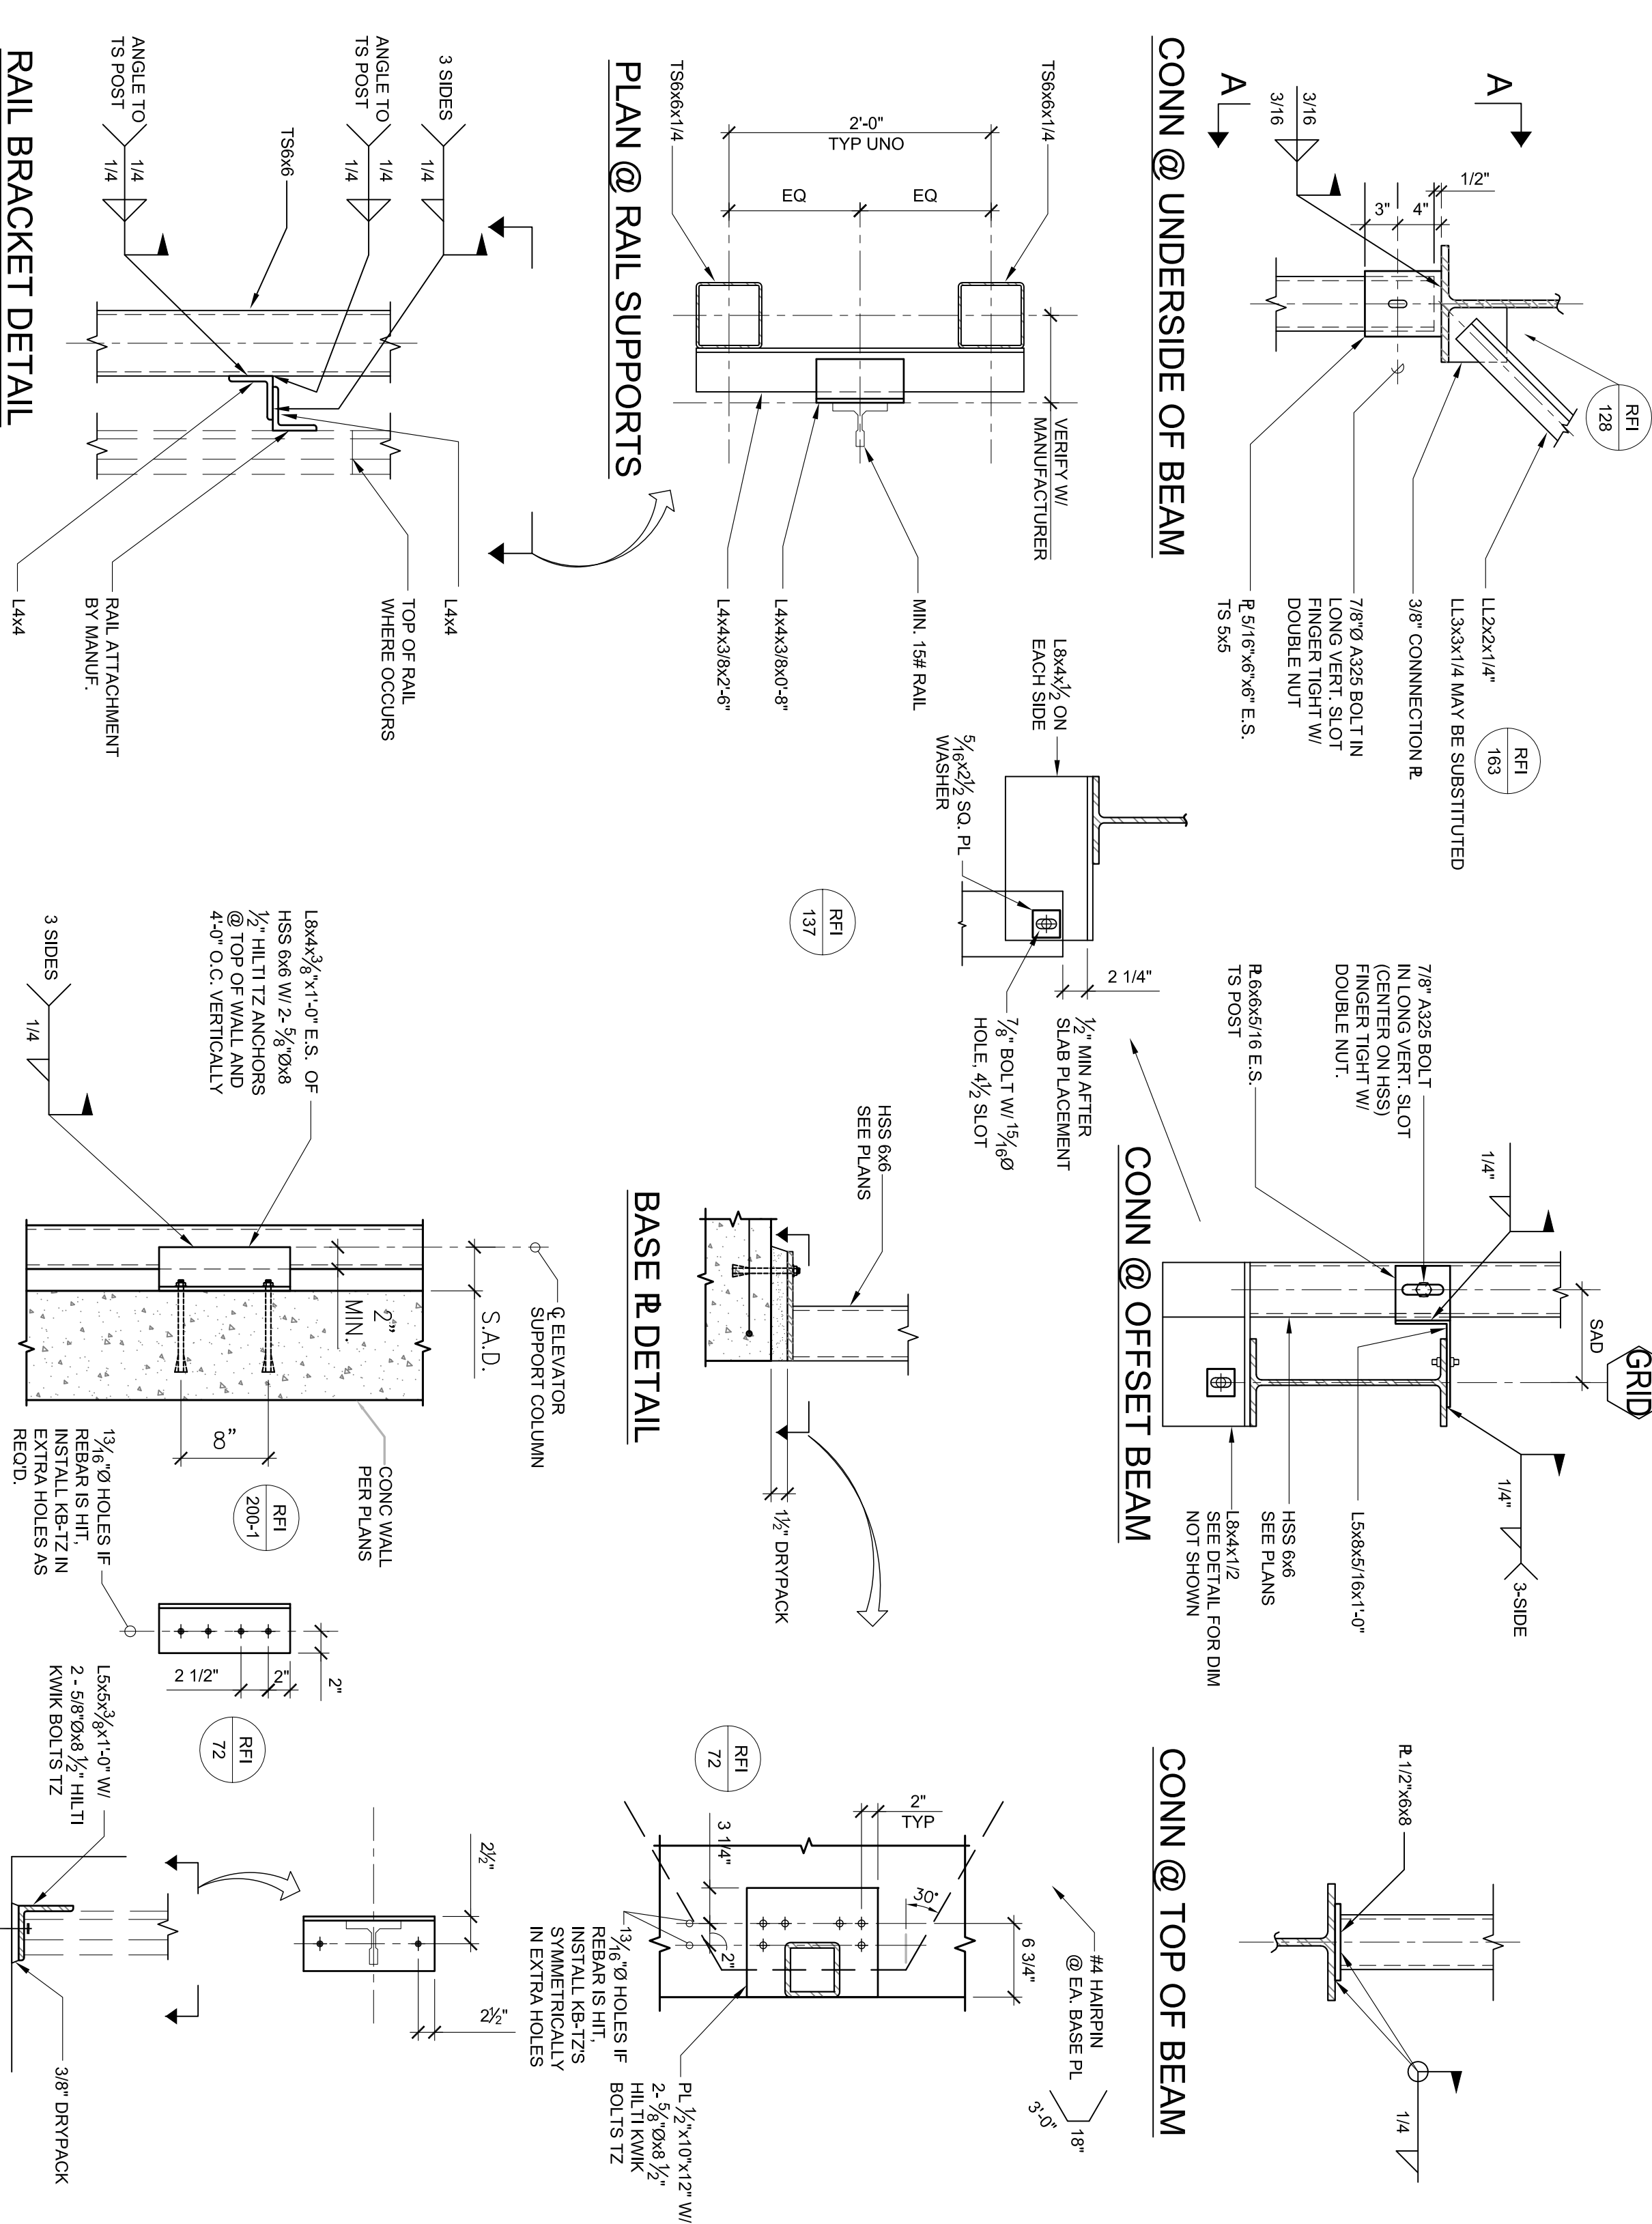

16 ELEVATOR RAIL SUPPORT DETAIL  
 SCALE: 1/2"=1'-0"


All drawings and/or details are the property of the Architect/Engineer and may not be reproduced, used or disclosed without consent of the Architect/Engineer.  
 Titles, drawings, or notes are the property of the Architect/Engineer and may not be reproduced, used or disclosed without consent of the Architect/Engineer.  
 Notes scales must be indicated. This line should be equal to one inch.

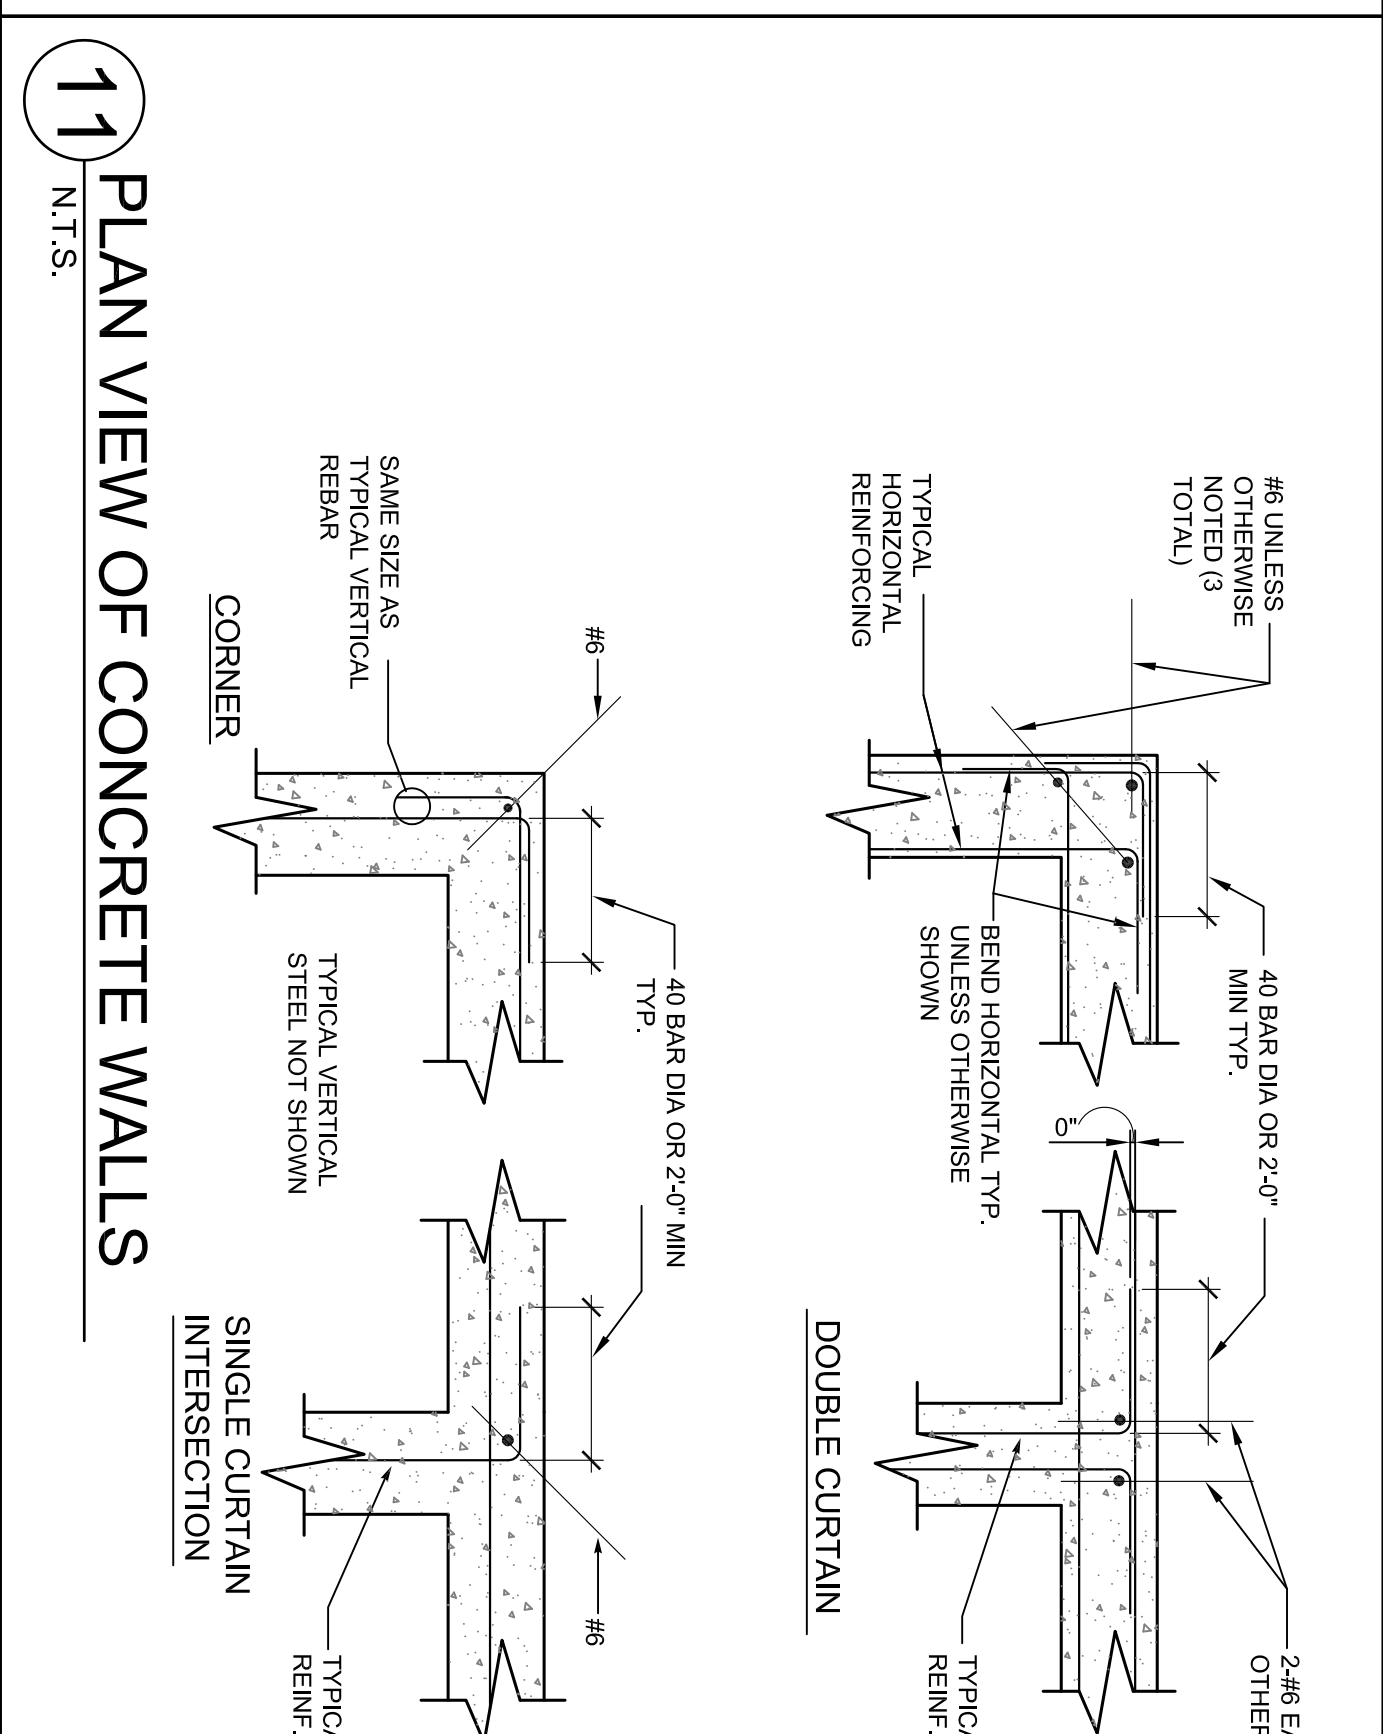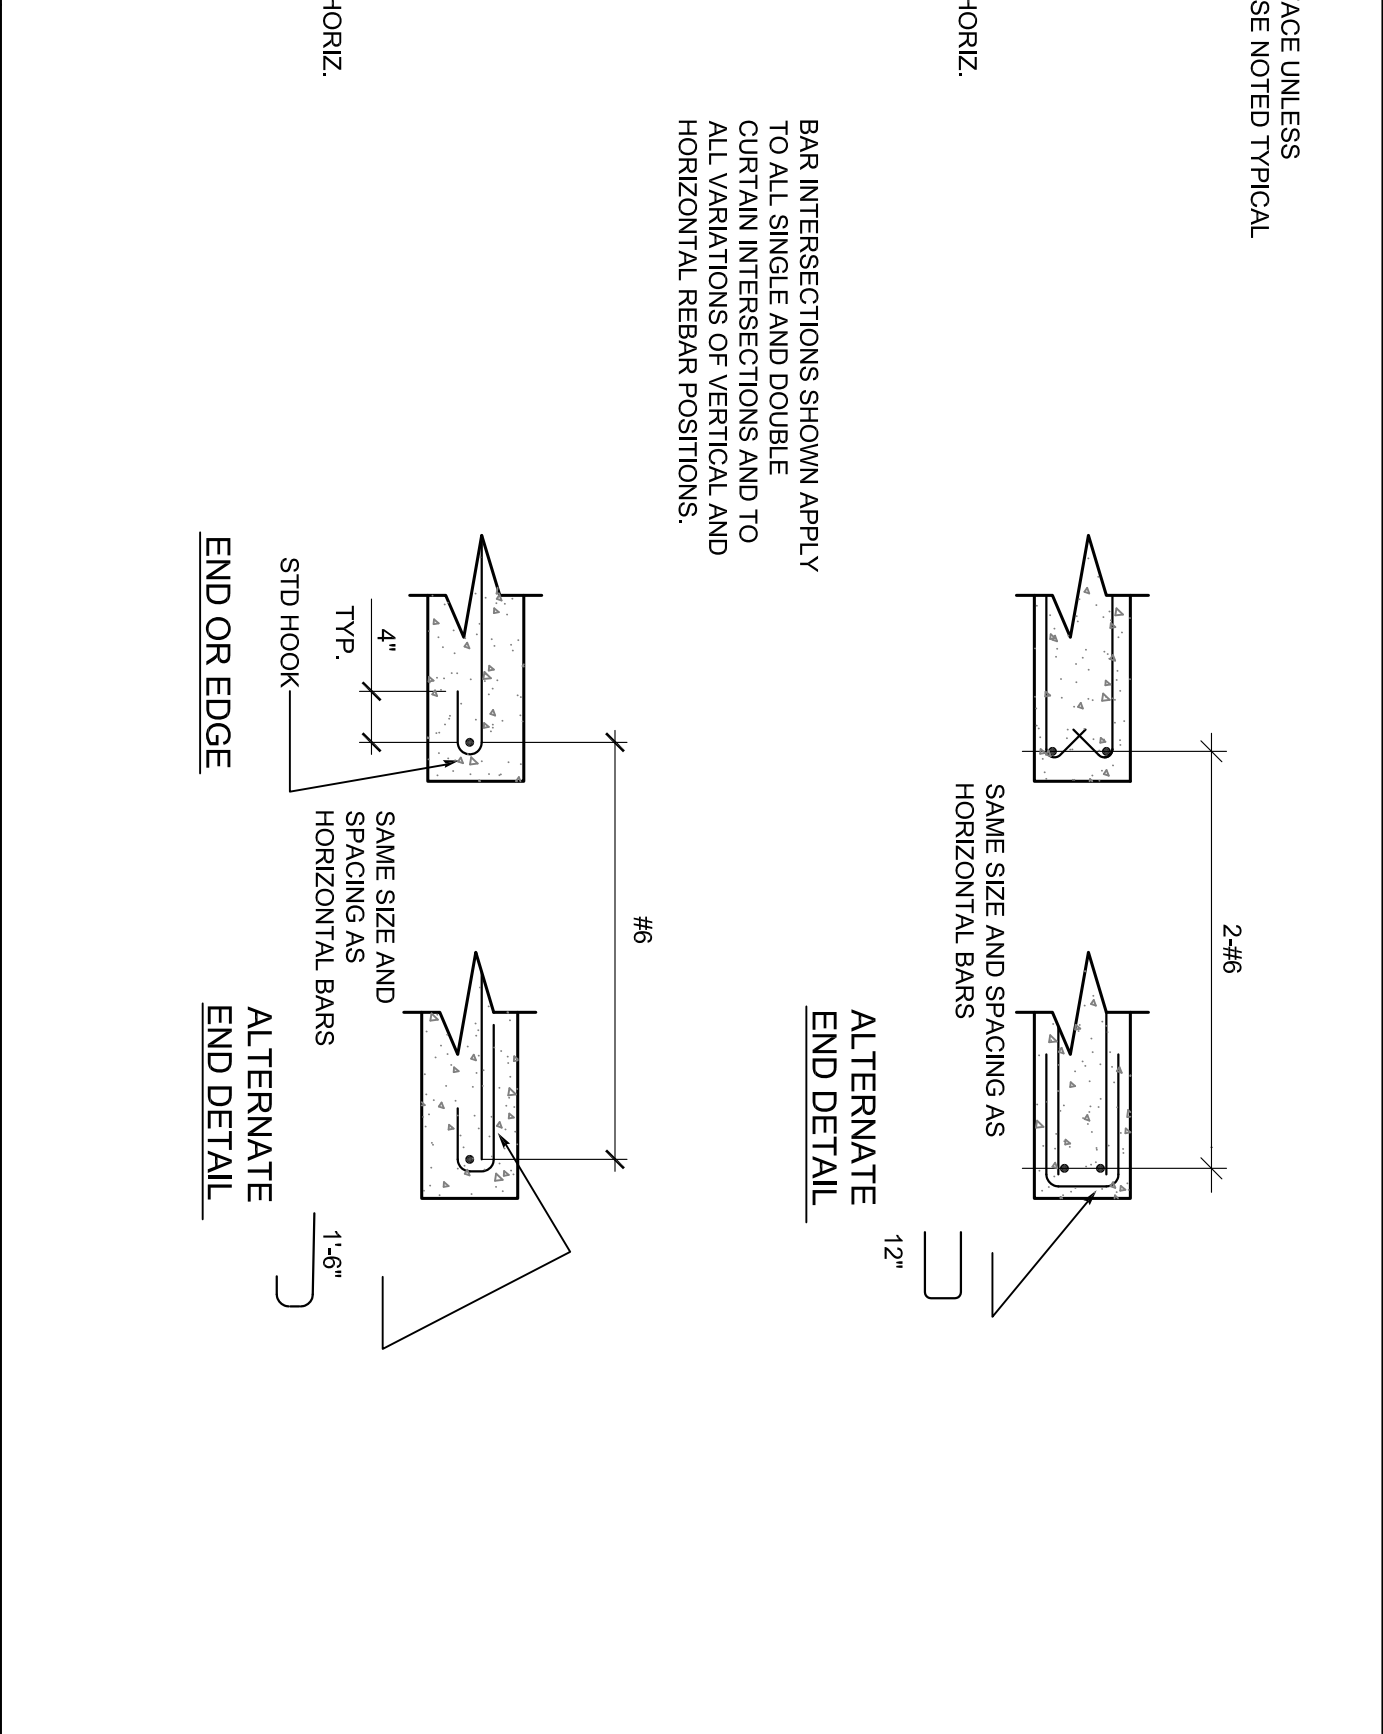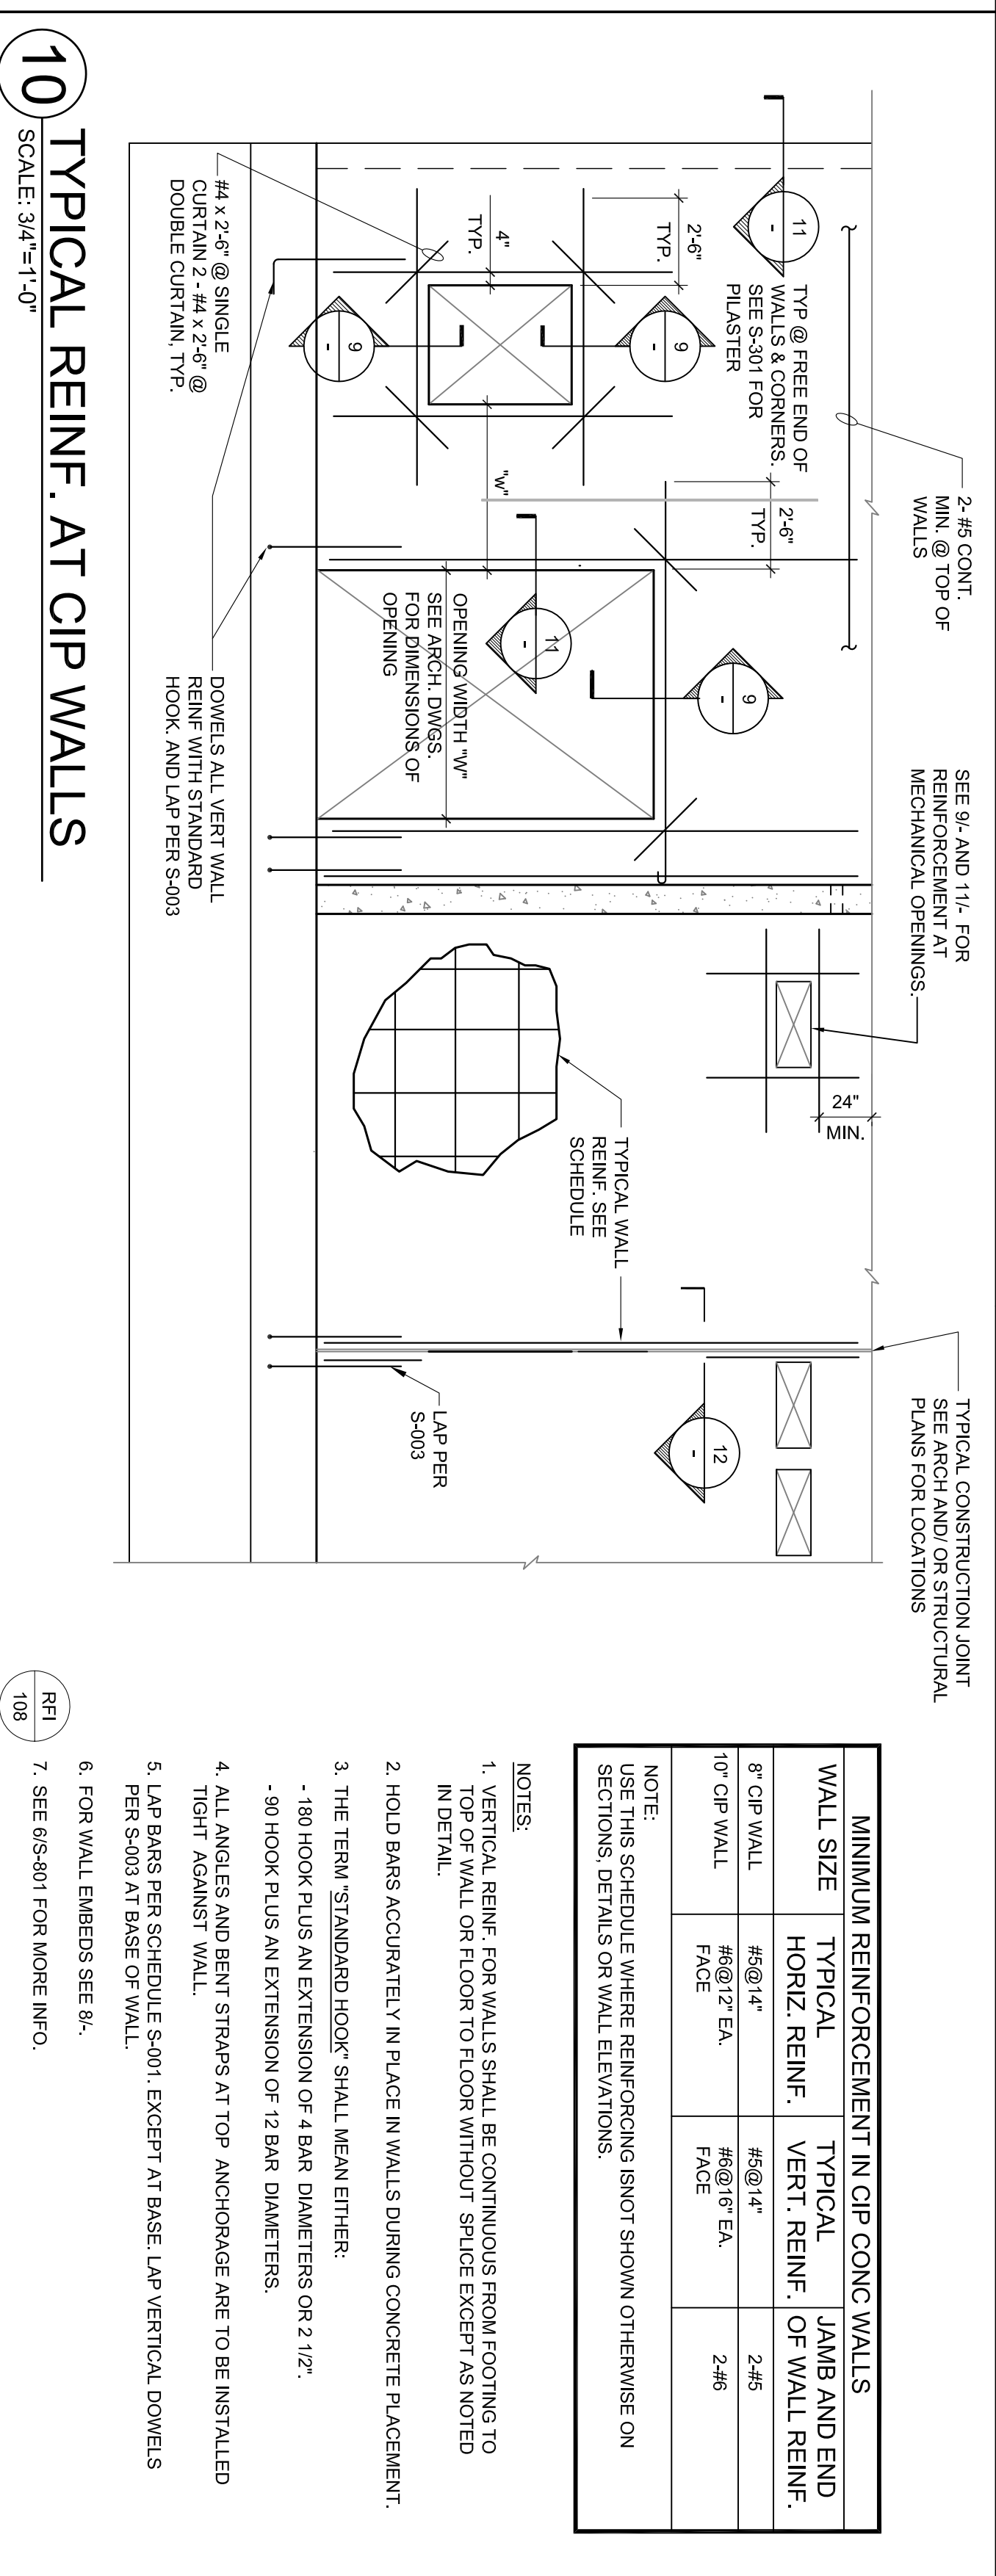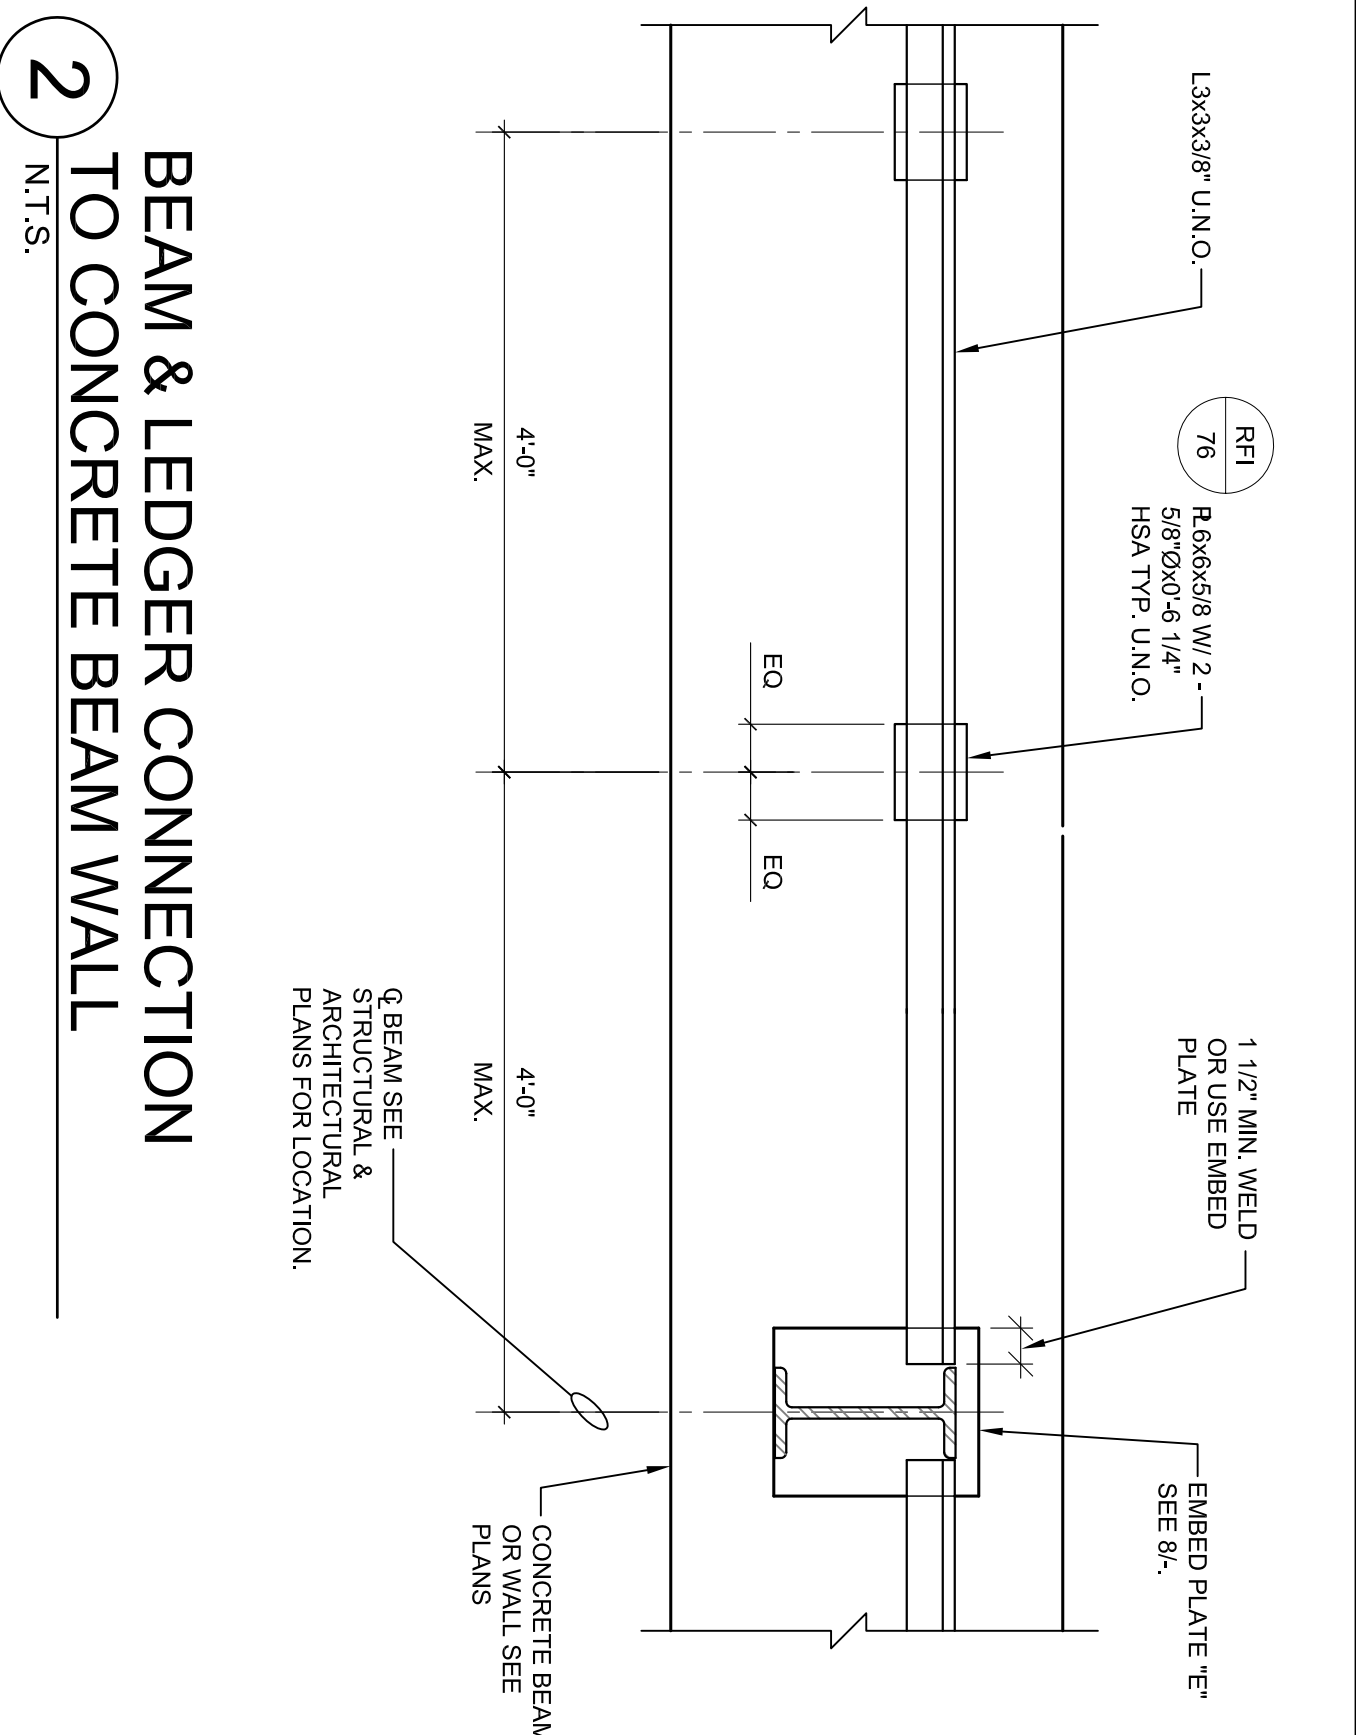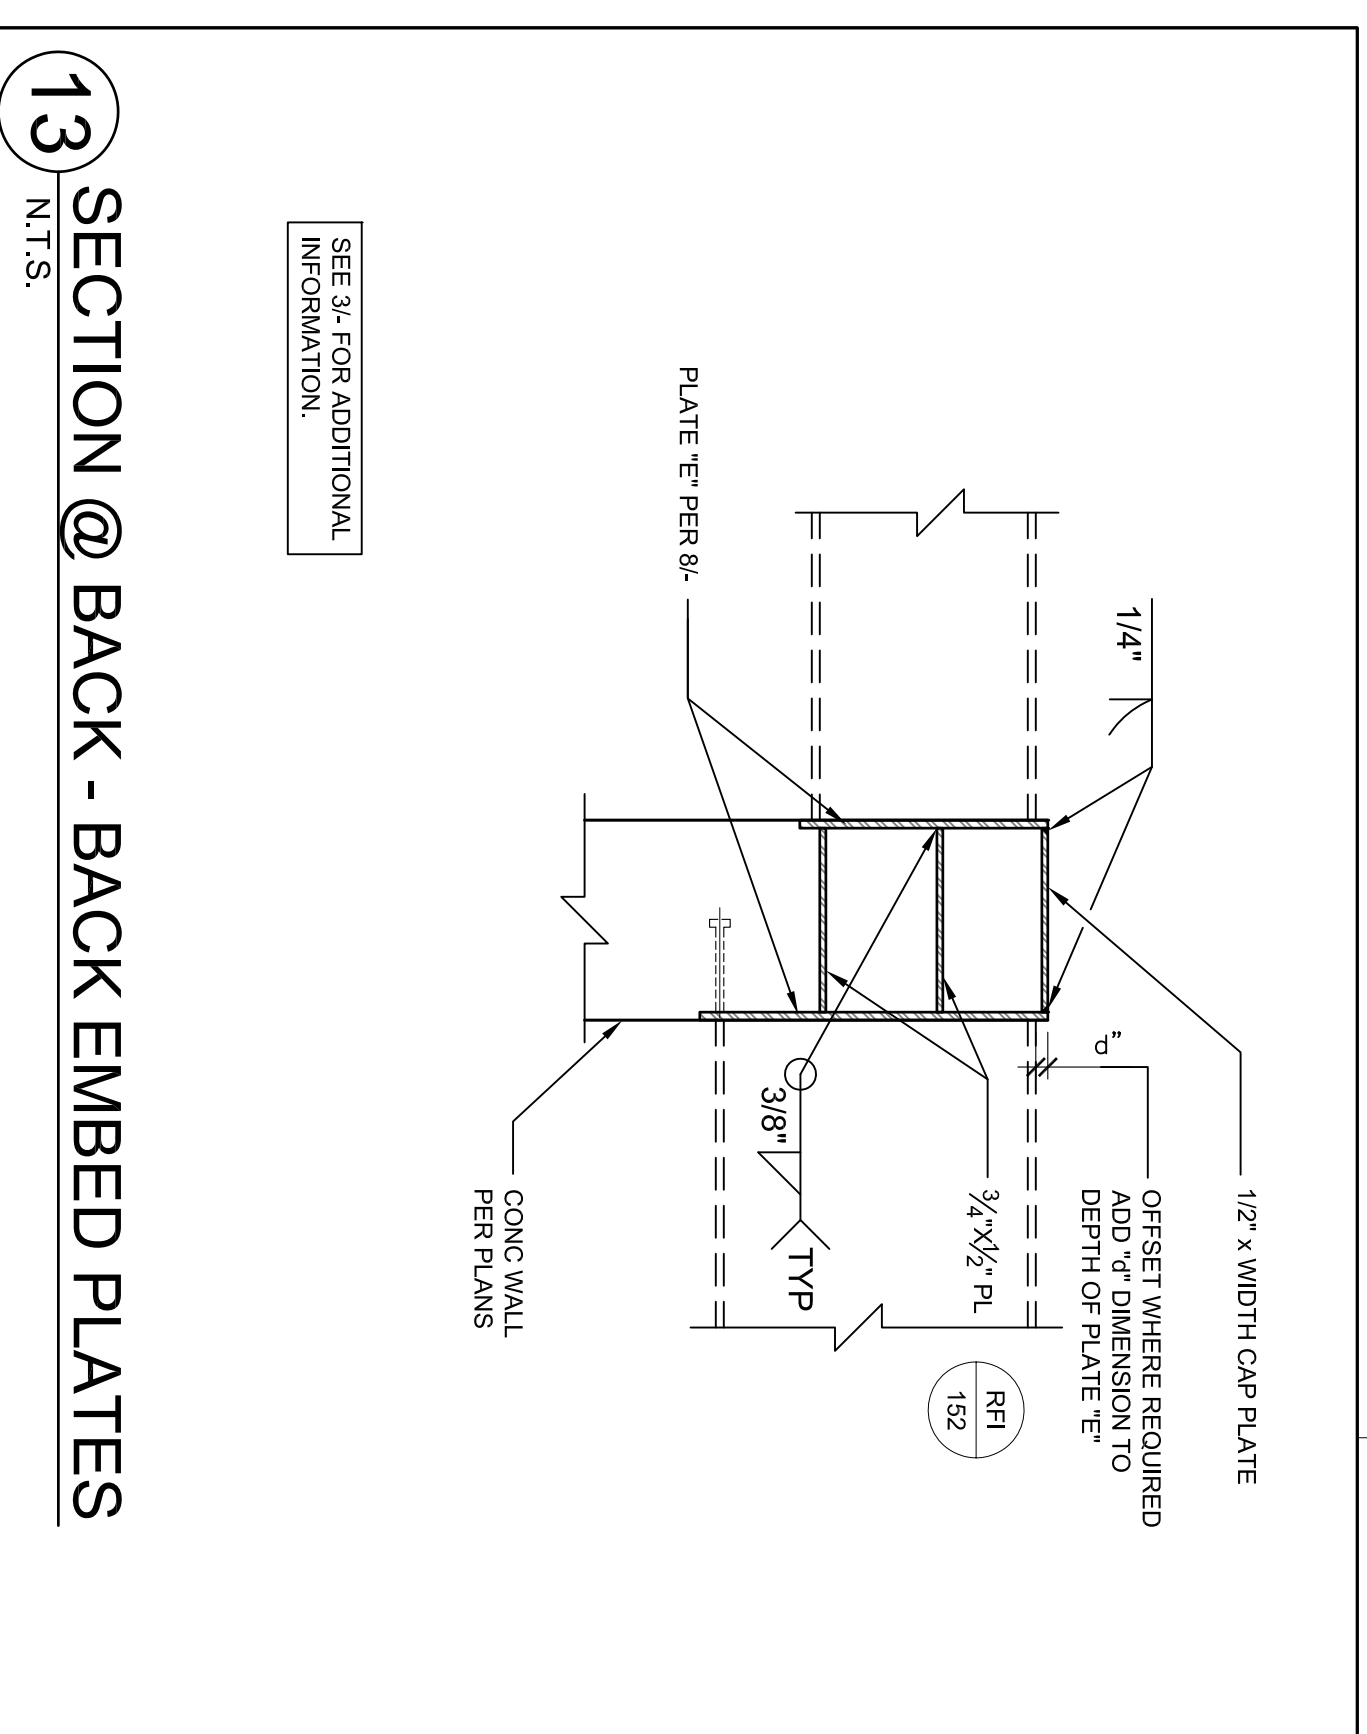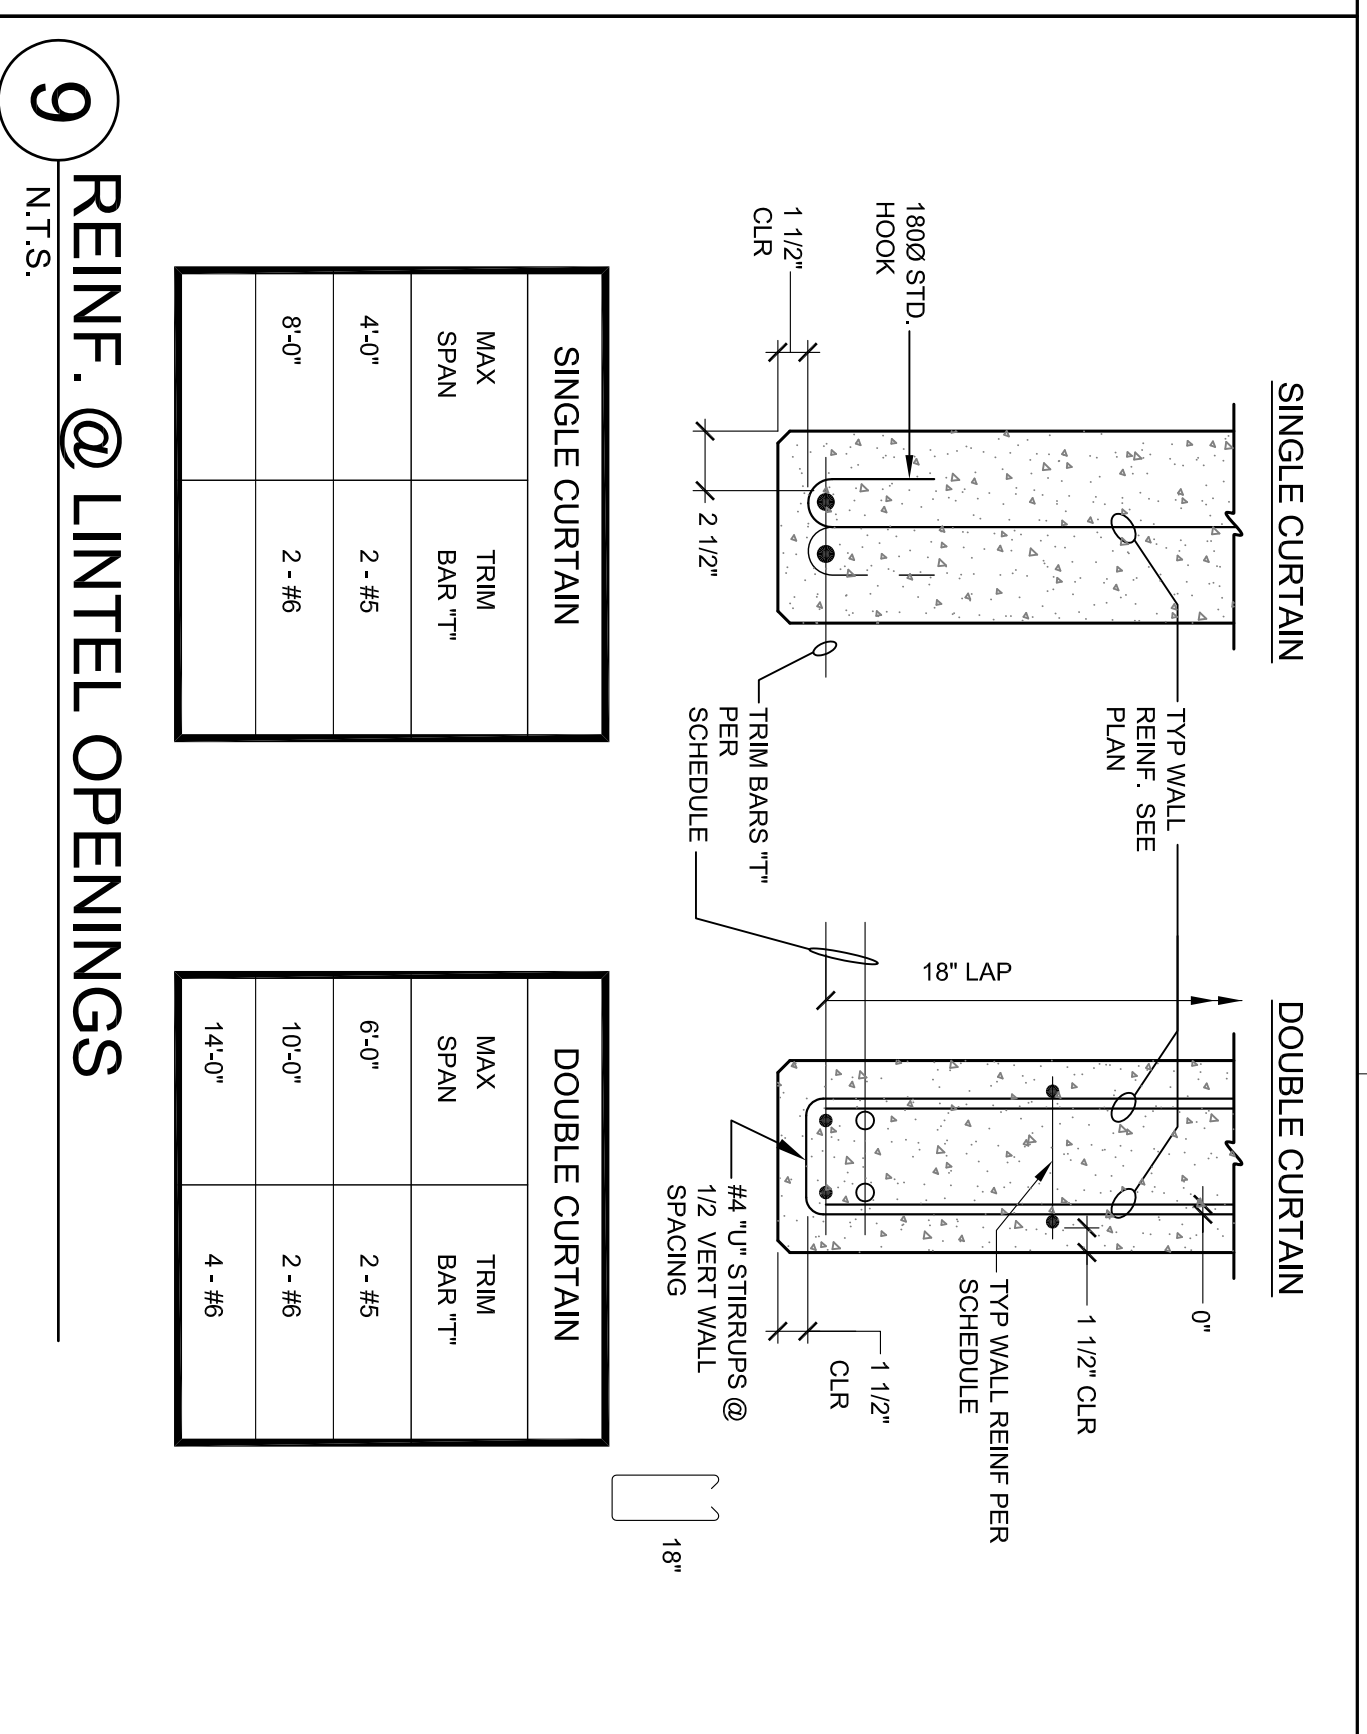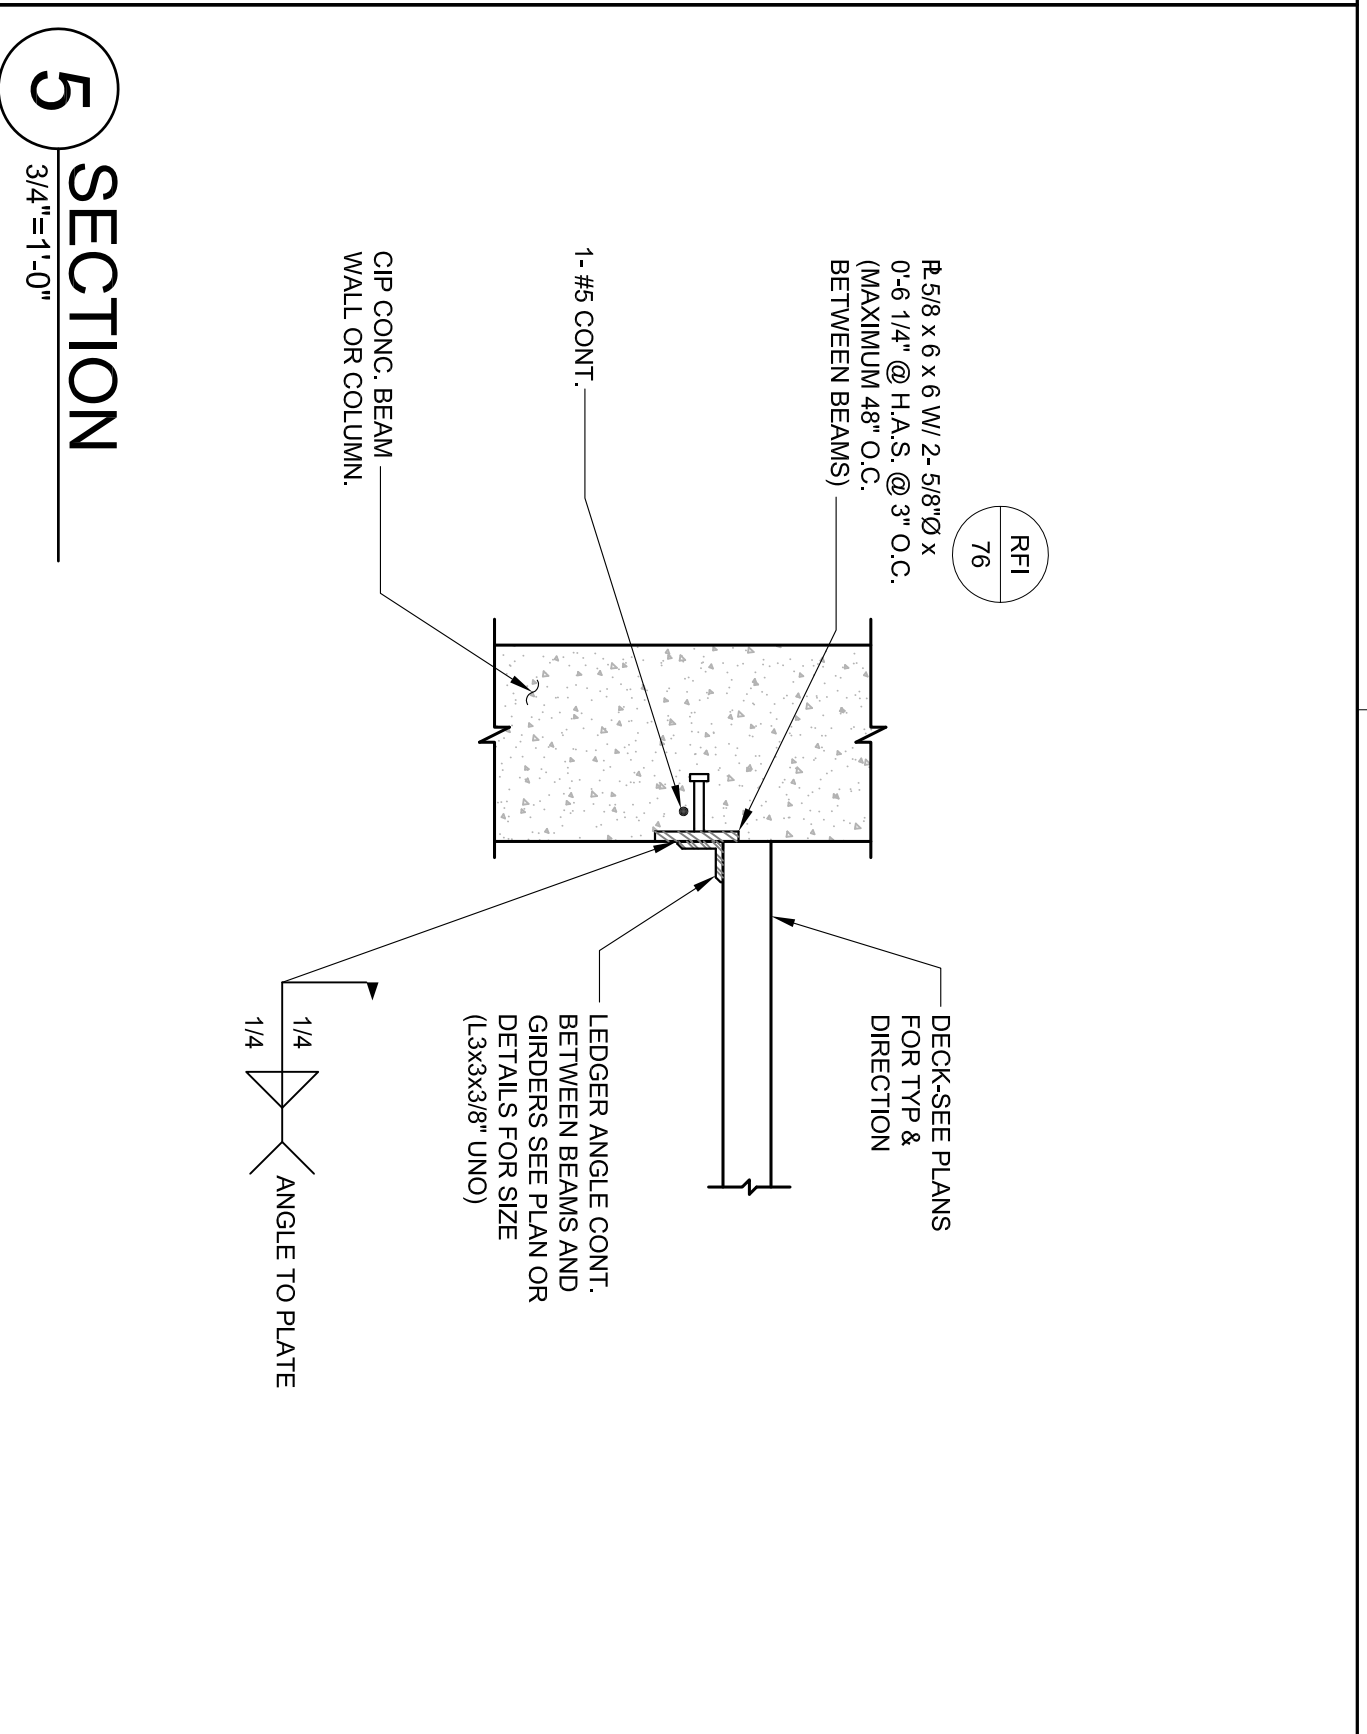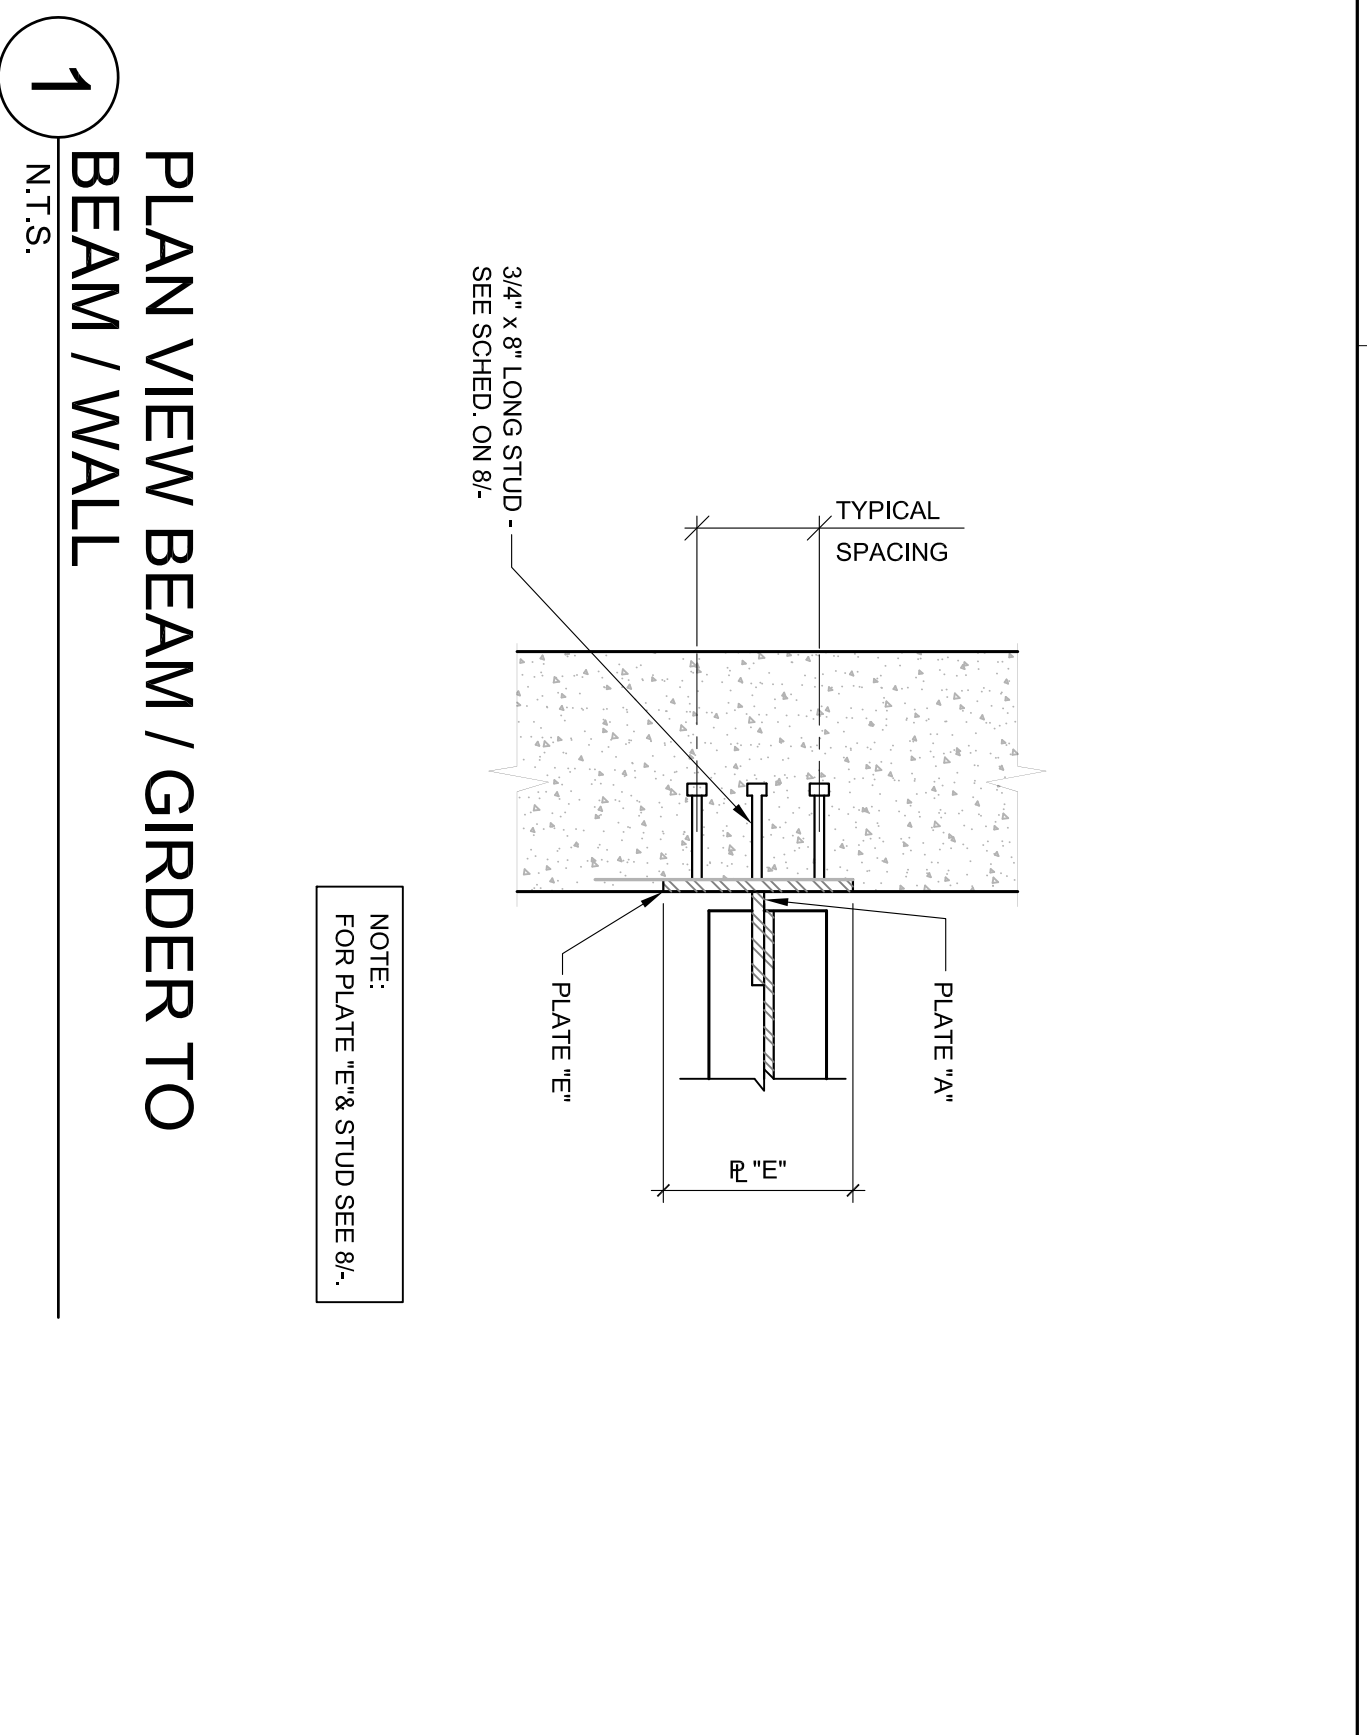

**8 BEAM CONNECTION SCHEDULE**  
 N.T.S.

BEAM/GIRDER SIZE	PLATE THICKNESS INCH	THICKNESS INCHES	WIDTH INCHES	DEPTH INCHES	WELD 1 INCH	NO. OF H.S. ASTM A325M BOLTS	STUD DIAMETER INCH	NO. OF LONG STUDS WELDED TO PLATE	HORIZ. STUD SPACING	VERTICAL STUD SPACING
W8	3/8	1/2	10	10	1/4"	2	3/4	4(2-ROWS)	6"	6"
W10	3/8	3/4	10	12	1/4"	3	3/4	4(2-ROWS)	6"	8"
W12	3/8	3/4	10	14	1/4"	3	3/4	6(2-ROWS)	6"	5 1/2"
W14	3/8	3/4	12	16	1/4"	3	3/4	6(2-ROWS)	9"	6 1/2"
W16	3/8	3/4	12	18	5/16"	4	3/4	6(2-ROWS)	9"	7 1/2"
W18	3/8	3/4	12	18	3/8"	5	3/4	6(2-ROWS)	9"	7 1/2"
W21	3/8	3/4	12	21	3/8"	6	3/4	8(2-ROWS)	9"	6"
W24	3/8	3/4	12	24	3/8"	7	3/4	8(2-ROWS)	9"	7"
*HSS 8x	3/8	1/2	10	10	1/4"	2	3/4	4(2-ROWS)	6"	6"

NOTE:  
 1. AS PER 8c-7c SHALL BE IN ACCORDANCE WITH APPROVED METHODS PER C.A.C.  
 2. PROVIDE LONGER DEPTH PLATE WHERE CONCRETE BEAM EXTENDS ABOVE TOP OF BEAM.  
 3. SEE 11c-3c FOR ADDITIONAL INFORMATION.  
 \* PROVIDE PLATE W/ E.S. OF HSS

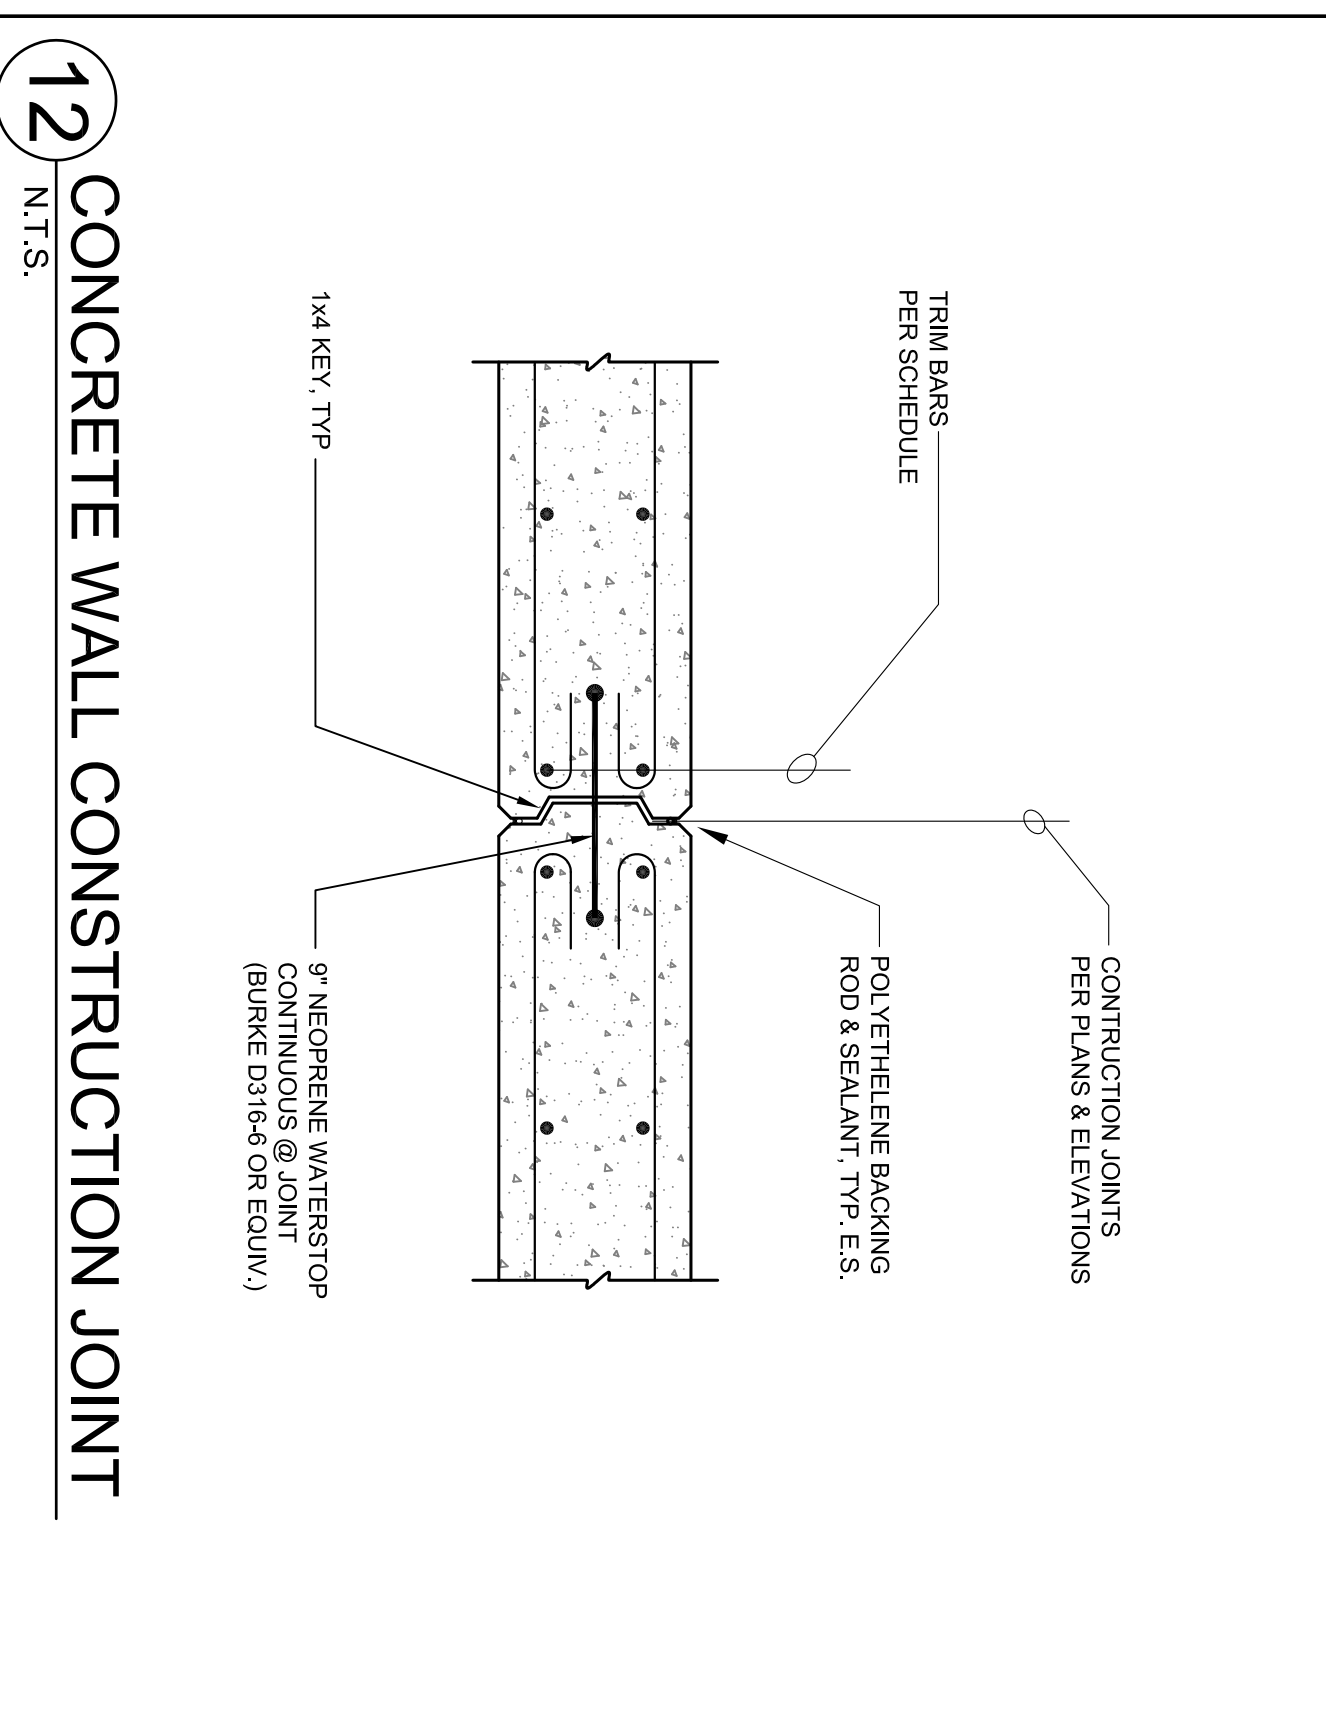

ABBREVIATIONS

Table with 4 columns: Abbreviation, Full Name, Symbol, and Description. Includes terms like AT (Inside Diameter), AC (Asphaltic Concrete), AD (Additional), etc.

A. GENERAL

- 1. THE FOLLOWING STRUCTURAL SHEETS S-109 - S-112 ARE INTENDED TO ONLY ADDRESS THE CONSTRUCTION OR INTERIOR METAL STUD SYSTEMS. SEE INCREMENT #2 FOR STRUCTURAL DESIGN OF THE BUILDING SYSTEM.
2. THE INTENT OF THESE DRAWINGS IS TO SHOW ALL ITEMS NECESSARY TO COMPLETE THE LIGHT GAUGE METAL FRAMING FOR THESE METHODS AND/OR MATERIALS NOT SHOWN. THE MINIMUM REQUIREMENTS OF THE 2007 CBC SHALL GOVERN ALL WORK AND CONSTRUCTION AND SAFETY REQUIREMENTS.

B. DESIGN BASIS

- 1. REFERENCE CODE
2007 CALIFORNIA BUILDING CODE, VOLUME 2
2. DESIGN LOADS: THE ACTUAL WEIGHT OF ALL PERMANENT CONSTRUCTION AND FIXED EQUIPMENT.
OFFICE AREAS / CLASSROOMS: 50 PSF
HIGH DENSITY STORAGE & FILE ROOMS: 125 PSF
CORRIDORS, STAIRS: 100 PSF
PARTITION LOAD ALLOWANCE IN OFFICE AND ADMINISTRATIVE AREAS: 15 PSF
ASSEMBLY ROOMS / AREAS, AUDITORIUMS: 100 PSF
ROOF: 20 PSF
80 PSF
SLABS ON GRADE: 85 MPH
WIND LOADS: BASIC WIND SPEED: 85 MPH
EXPOSURE: C

SEISMIC LOADS:

- SEISMIC LOADS WILL BE DETERMINED IN ACCORDANCE WITH 2007 CBC AND ASCE 7-05 USING THE FOLLOWING DESIGN CRITERIA:
SITE CLASSIFICATION: CLASS D
DESIGN FACTORS: Fg = 1.0 Fv = 1.5 Sds = 1.15 Sd1 = 0.96
SEISMIC USE GROUP III: R = 5 (SPECIAL REINFORCED CONCRETE SHEARWALL)
SEISMIC DESIGN CATEGORY: E

C. METAL STUDS

- 1. ALL LIGHTGAUGE METAL FRAMING SHALL BE AS NOTE BELOW:
INTERIOR STUDS: GALVANIZED
EXTERIOR STUDS: GALVANIZED
2. ALL LIGHTGAUGE METAL FRAMING CONSTRUCTION SHALL BE IN ACCORDANCE WITH AISI SPECIFICATIONS FOR DESIGN OF COLD FORMED STEEL STRUCTURAL MEMBER LATEST EDITION.
3. ALL LIGHTGAUGE METAL FRAMING SHALL CONFORM WITH THE FOLLOWING:
GALVANIZED STUDS: ASTM A653, GRADE 50 (Fy = 50,000 psi)
GALVANIZED STUDS: ASTM A653, GRADE 33 (Fy = 33,000 psi)
GALVANIZED TOP TRACK: ASTM A653, GRADE 50 (Fy = 50,000 psi)
SLIPRACK SYSTEMS OR EQUAL: INTERIOR VERTICAL PARTITIONS: ASTM A653, GRADE 33 (Fy = 33,000 psi)
SLIPRACK SYSTEMS OR EQUAL: INTERIOR VERTICAL PARTITIONS: GALVANIZED TRACK AND ACCESSORIES: BRIDGING: ASTM A653, GRADE 33 (Fy = 33,000 psi)

- 4. DOUBLE VERTICAL STUDS SHALL BE STITCH WELDED TOGETHER ON BOTH FLANGE WITH 1/16" GROOVE WELDS x 1" LONG AT 12" ON CENTER, U.N.O.
5. BOTTOM STUD TRACKS FOR INTERIOR PARTITIONS SHALL MATCH THE SIZE AND GAGE OF THE WALL STUDS AND SHALL HAVE 1.5" FLANGES (U.N.O.). TOP TRACKS AT INTERIOR PARTITION SHALL HAVE 2" FLANGES MATCH THE SIZE AND GAGE OF TYPICAL STUDS BUT SHALL BE 14 GA. MIN. AND SHALL BE MANUFACTURED BY SLIP TRACK SYSTEMS OR EQUAL.

MINIMUM SECTION PROPERTIES FOR STEEL STUDS AT INTERIOR AND EXTERIOR PARTITIONS AND THOSE STUDS REFERENCED ON ARCHITECTURAL DRAWINGS SHALL BE AS FOLLOWS:

Table with 6 columns: MIN. GA (THICKNESS), STUD / TRACK TYPE, STUD / TRACK SIZE, EFFECTIVE I in^4, EFFECTIVE S in^3. Lists various steel stud and track specifications.

THESE VALUES ARE TAKEN FROM THE SSMA CATALOG, ICC #493P & THE DIERICH CATALOG ICC #4794.

MINIMUM SECTION PROPERTIES FOR PROPRIETARY JAMSTUDS: FOR ALTERNATE METAL STUD JAMBS.

Table with 6 columns: MIN. GA (THICKNESS), STUD TYPE, STUD SIZE, EFFECTIVE I in^4, EFFECTIVE S in^3. Lists proprietary jamb stud specifications.

THESE VALUES ARE TAKEN FROM THE STEEL NETWORK JAMSTUD SECTION PROPERTIES TABLE.

- 8. ALL SHEET METAL SCREWS SHALL PROTRUDE 1/4" THROUGH METAL FRAMING.
9. AS A MINIMUM ANCHOR TRACK TO CONCRETE WITH HULTI 0.145" DIAMETER X-DIM (ICC #7389) LOW VELOCITY POWDER DRIVEN INSERTS @ 16" o.c. OR APPROX. EQUAL. THE INSERTS SHALL HAVE A MINIMUM 1 1/2" EMBEDMENT INTO THE CONCRETE AND SHALL BE LOCATED AT MINIMUM 3" FROM ANY CONCRETE EDGE. THE INSERTS SHALL BE PLACED ADJACENT TO EACH WALL STUD AT A MAXIMUM DISTANCE OF 3". POWDER DRIVEN ANCHORS SHALL NOT BE USED IN CONCRETE CURBS OR EXTERIOR WALLS EXCEPT AS SHOWN ON TYPICAL DETAILS.
10. CONTRACTOR SHALL COMPLY WITH ALL OF THE MANUFACTURER'S INSTALLATION SPECIFICATIONS AND RECOMMENDATIONS. ALL METAL STUDS SHALL HAVE STIFFENED FLANGES. SEE DRAWINGS FOR SPECIFIC DETAILS ON CONNECTIONS, BRACING, BRIDGING, ETC. CONTRACTOR SHALL PROVIDE ALL ACCESSORIES INCLUDING, BUT NOT LIMITED TO, TRACKS, CLIPS, AND OTHER ACCESSORIES REQUIRED FOR A COMPLETE AND PROPER INSTALLATIONS, AND AS RECOMMENDED BY THE MANUFACTURER FOR THE STEEL MEMBERS USED.
11. ALL METAL STUDS TO BE MANUFACTURED BY MEMBERS OF THE STEEL STUD MANUFACTURER'S ASSOCIATION, SSMA (ICC #493P), U.N.O.
12. SEE ARCH PLAN FOR SPECIAL METAL STUD FRAMING WHERE INDICATED.
13. FOR FASTENERS INSTALLED IN CONCRETE, MINIMUM SPACING BETWEEN FASTENERS IS 4" o.c. AND MINIMUM EDGE DISTANCE IS 3" TYP. U.N.O.
14. FOR SHEET METAL SCREWS INSTALLED IN LIGHT GAUGE METAL FRAMING, MINIMUM SPACING BETWEEN FASTENERS IS 1 1/2" o.c. AND MINIMUM EDGE DISTANCE IS 3/4" TYP. U.N.O.
15. AS MINIMUM PROVIDE (2) #10 SMS AT EACH LIGHT GAUGE METAL MEMBER CONNECTION, U.N.O.

D. CURTAIN WALL / STOREFRONT DESIGN WINDOW SYSTEM

- 1. CURTAIN WALL SYSTEM SHALL BE DESIGNED AND BRACED TO MEET ALL GRAVITY, SEISMIC AND WIND LOADING CRITERIA AS STIPULATED ON THE GENERAL STRUCTURAL NOTES, SECTION B (DESIGN BASIS).
2. THE DESIGN AND DETAILING OF THE CURTAIN WALL SYSTEM SHALL MEET ALL APPLICABLE SECTIONS OF THE 2007 C.B.C. WITH STATE AMENDMENTS.
3. THE CURTAIN WALL SYSTEM SHALL ACCOMMODATE INTERIOR DRAFTS PER 2007 CBC WITH STATE AMENDMENTS SECTION 1633A2.4.2. THE GENERAL CONTRACTOR SHALL SUBMIT COMPLETE STRUCTURAL PLANS, SECTIONS, AND CALCULATIONS STAMPED AND SEALED BY A CIVIL OR STRUCTURAL ENGINEER REGISTERED IN THE STATE OF CALIFORNIA. SUBMITTALS SHALL BE IN ACCORDANCE WITH DIVISION 1. ALL PLANS AND SECTIONS SHALL BE DRAWN TO SCALE. THE GENERAL CONTRACTOR SHALL ALLOW TWO WEEKS FOR THE ENGINEER OF RECORD TO REVIEW THE ABOVE REFERENCED CURTAIN WALL CALCULATIONS AND SHOP DRAWINGS.

E. DRILLED-IN EXPANSION BOLTS AND ADHESIVE ANCHORS IN CONCRETE

SEE S-103

NOTES

- 1. ANCHOR DIAMETER REFERS TO THE THREAD SIZE OF THE WEDGE ANCHOR.
2. APPLY PROOF TEST LOADS TO WEDGE ANCHORS WITHOUT REMOVING THE NUT IF POSSIBLE. IF NOT, REMOVE NUT AND INSTALL A THREADED COUPLER TO THE SAME TIGHTNESS OF THE ORIGINAL NUT USING A TORQUE WRENCH AND APPLY LOAD.
3. REACTION LOADS FROM TEST FIXTURES MAY BE APPLIED CLOSE TO THE ANCHOR BEING TESTED, PROVIDED THE ANCHOR IS NOT RESTRAINED FROM WITHDRAWING BY THE FIXTURE(S).
4. SHALL NOT BE USED AT OR BELOW GRADE.
5. TEST EQUIPMENT IS TO BE CALIBRATED BY AN APPROVED TESTING LABORATORY IN ACCORDANCE WITH STANDARD RECOGNIZED PROCEDURES.
6. THE FOLLOWING CRITERIA APPLY FOR THE ACCEPTANCE OF INSTALLED ANCHORS:
HYDRAULIC RAM METHOD: THE ANCHOR SHOULD HAVE NO OBSERVABLE MOVEMENT AT THE APPLICABLE TEST LOAD. FOR WEDGE AND STEEL TYPE ANCHORS, A PRACTICAL WAY TO DETERMINE OBSERVABLE MOVEMENT IS THAT THE WASHER UNDER THE NUT BECOMES LOOSE. TORQUE TEST:
ANCHORS TESTED WITH A CALIBRATED TORQUE WRENCH MUST ATTAIN THE SPECIFIED TORQUE WITHIN 1/2 TURN OF THE NUT. ALL TESTING REQUIREMENTS SHALL BE IN COMPLIANCE W/ DSA IR 19-1
EXCEPTIONS:
UNDERCUT ANCHORS THAT ARE SO DESIGNED TO ALLOW VISUAL CONFIRMATION OF FULL SET, NEED NOT BE TENSION OR TORQUE TESTED. IF THE MANUFACTURER'S INSTALLATION TORQUE IS LESS THAN THE SPECIFIED TEST TORQUE, USE THE MANUFACTURER'S SPECIFIED INSTALLATION TORQUE FOR TESTING THE ANCHORS.
7. TESTING MUST OCCUR 24 HOURS MINIMUM AFTER INSTALLATION OF THE SUBJECT ANCHORS.
8. WHEN INSTALLING DRILLED-IN ANCHORS AND /OR POWDER DRIVEN PINS IN EXISTING NON-PRESTRESSED REINFORCED CONCRETE, USE CARE AND CAUTION TO AVOID CUTTING OR DAMAGING THE EXISTING REINFORCING BARS.
9. THESE TENSION VALUES ARE ONLY APPLICABLE WHEN THE ANCHORS ARE INSTALLED WITH SPECIAL INSPECTION AS SET FORTH IN SECTION 306 AND 1701 OF THE CODE.
10. THE TABULATED VALUES ARE FOR ANCHORS WITH SPACE AND EDGE DISTANCES AS PROVIDED IN TABLE 3 OF ICC ESN-1917
11. THE TABULATED VALUES FOR LIGHT WEIGHT CONCRETE ARE THE ANCHORS INSTALLED IN LIGHTWEIGHT EXPANDED SHALE AGGREGATE CONCRETE HAVING THE COMPRESSIVE STRENGTH AT THE TIME OF INSTALLATION. CONCRETE AGGREGATE MUST COMPLY WITH U.B.C. STANDARD NO. 19-5
12. FOR WEDGE ANCHORS INSTALLED IN LIGHT WEIGHT CONCRETE TO RESIST SEISMIC OR WIND LOADS, THE ALLOWABLE TENSION AND SHEAR CAPACITY OF ANCHORS SHALL BE TAKEN AS 80% OF THE ALLOWABLE VALUE LISTED IN ICC REPORT #1917.
13. IF ANY ANCHOR FAILS TESTING, ALL ANCHORS OF THE SAME CATEGORY, NOT PREVIOUSLY TESTED, SHALL BE TESTED UNTIL 20 CONSECUTIVE ANCHORS PASS THE TEST REQUIREMENTS. THE INITIAL TESTING FREQUENCY SHALL THEN BE RESUMED.

WRNS STUDIO logo and address: 501 SECOND STREET 4TH FLOOR, STE. 402 SAN FRANCISCO, CALIFORNIA 94107

Steinberg Architects logo and contact info: Hensel Phelps Construction Co.

Grosby Group logo and contact info: 2200 SAN ANTONIO DRIVE, SUITE 200, SAN FRANCISCO, CA 94116


PROJECT RECORD SET

SKYLINE COLLEGE CIP2 DESIGN-BUILD PROJECT BUILDING 4


Table with 4 columns: PROJECT NO., DATE, SCALE, SHEET TITLE. Includes project details like PROJECT NO. 0071240 and SHEET TITLE: GENERAL STRUCTURAL NOTES.

JAMB SCHEDULE		1 HOUR FIRE RATED WALL SYSTEM		2 HOUR FIRE RATED WALL SYSTEM	
WIDTH OF OPENING "W"	WALL SYSTEM	4" WALL	6" WALL	4" WALL	6" WALL
W ≤ 2'-0"	STANDARD	JAMSTUD*	STANDARD	JAMSTUD*	STANDARD
		400S138-43	400S138-43	400S138-54	400S138-54
2'-0" < W ≤ 4'-0"	STANDARD	JAMSTUD*	STANDARD	JAMSTUD*	STANDARD
		400S138-54	400S250-43	400S250-43	400S250-43
4'-0" < W ≤ 6'-0"	STANDARD	JAMSTUD*	STANDARD	JAMSTUD*	STANDARD
		400S162-54	400S250-54	400S250-54	400S250-54
6'-0" < W ≤ 8'-0"	STANDARD	JAMSTUD*	STANDARD	JAMSTUD*	STANDARD
		400S138-54	400S250-54	400S138-54	400S250-54
8'-0" < W ≤ 12'-0"	STANDARD	JAMSTUD*	STANDARD	JAMSTUD*	STANDARD
		400S138-54	400S350-54	400S350-54	400S350-54

**5 TYPICAL INTERIOR & ALTERNATE METAL STUD JAMB SCHEDULE**  
N.T.S.

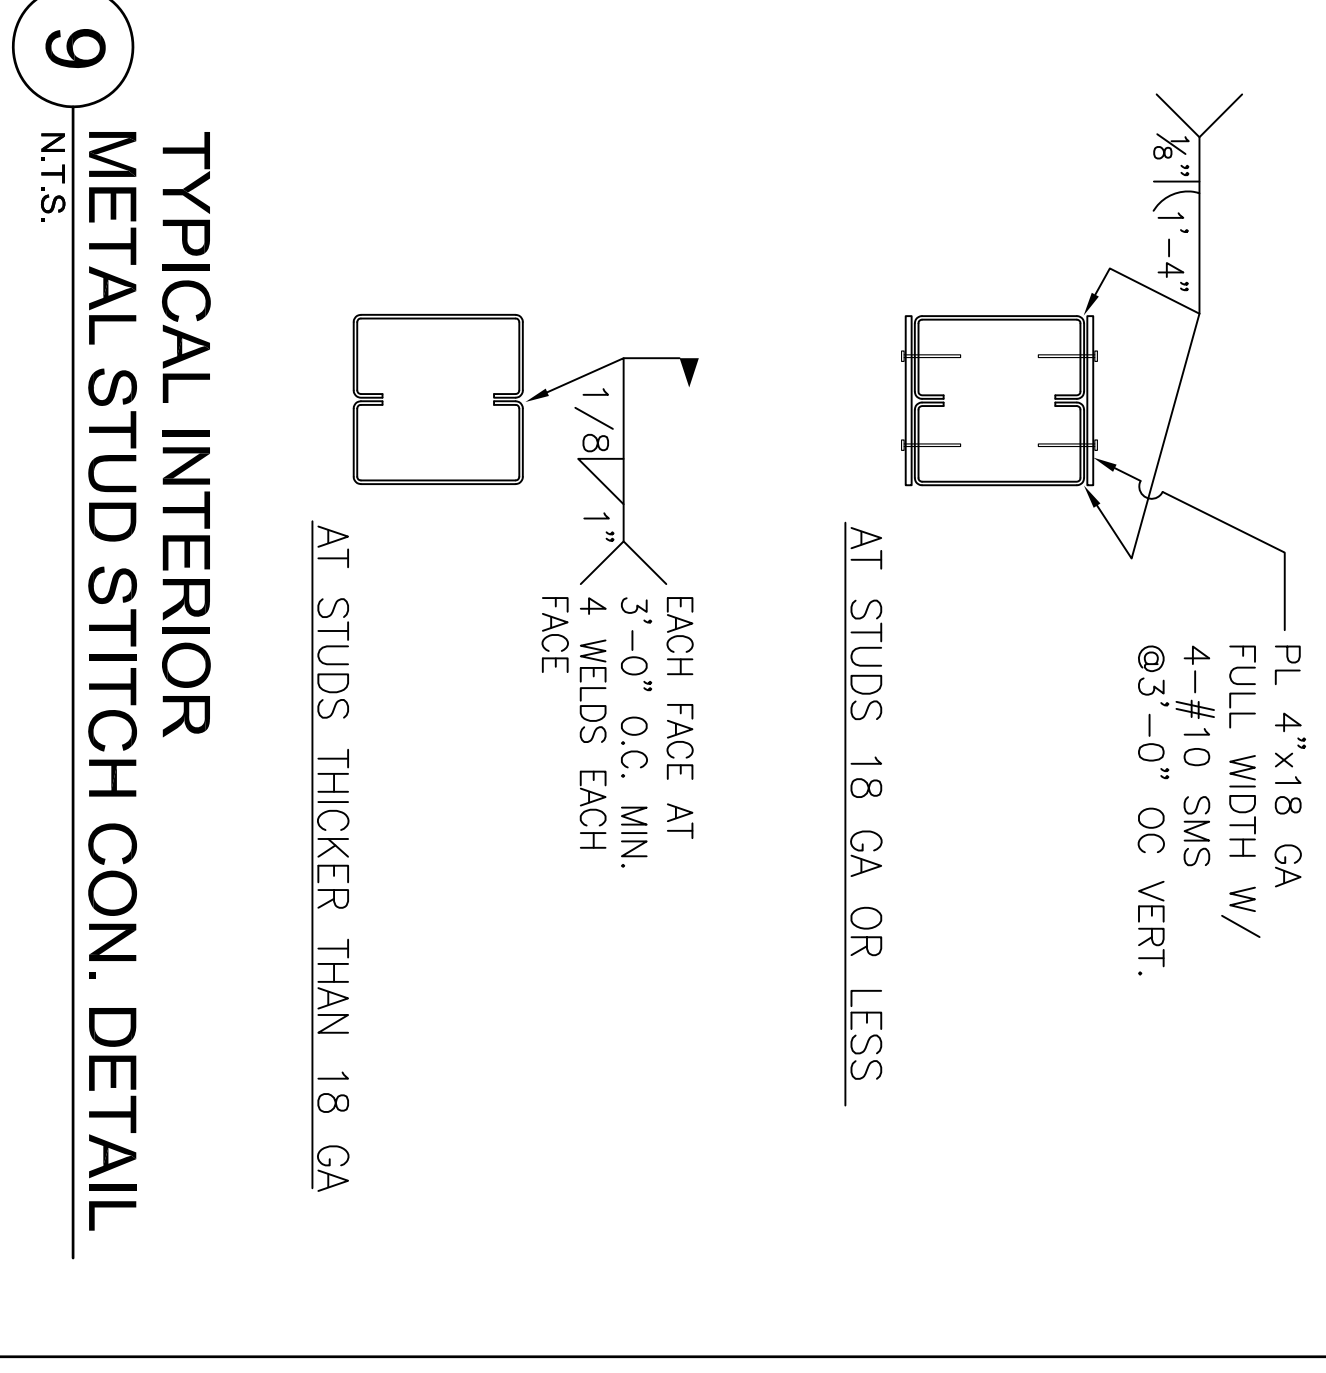


**9 TYPICAL INTERIOR METAL STUD STITCH CON. DETAIL**  
N.T.S.

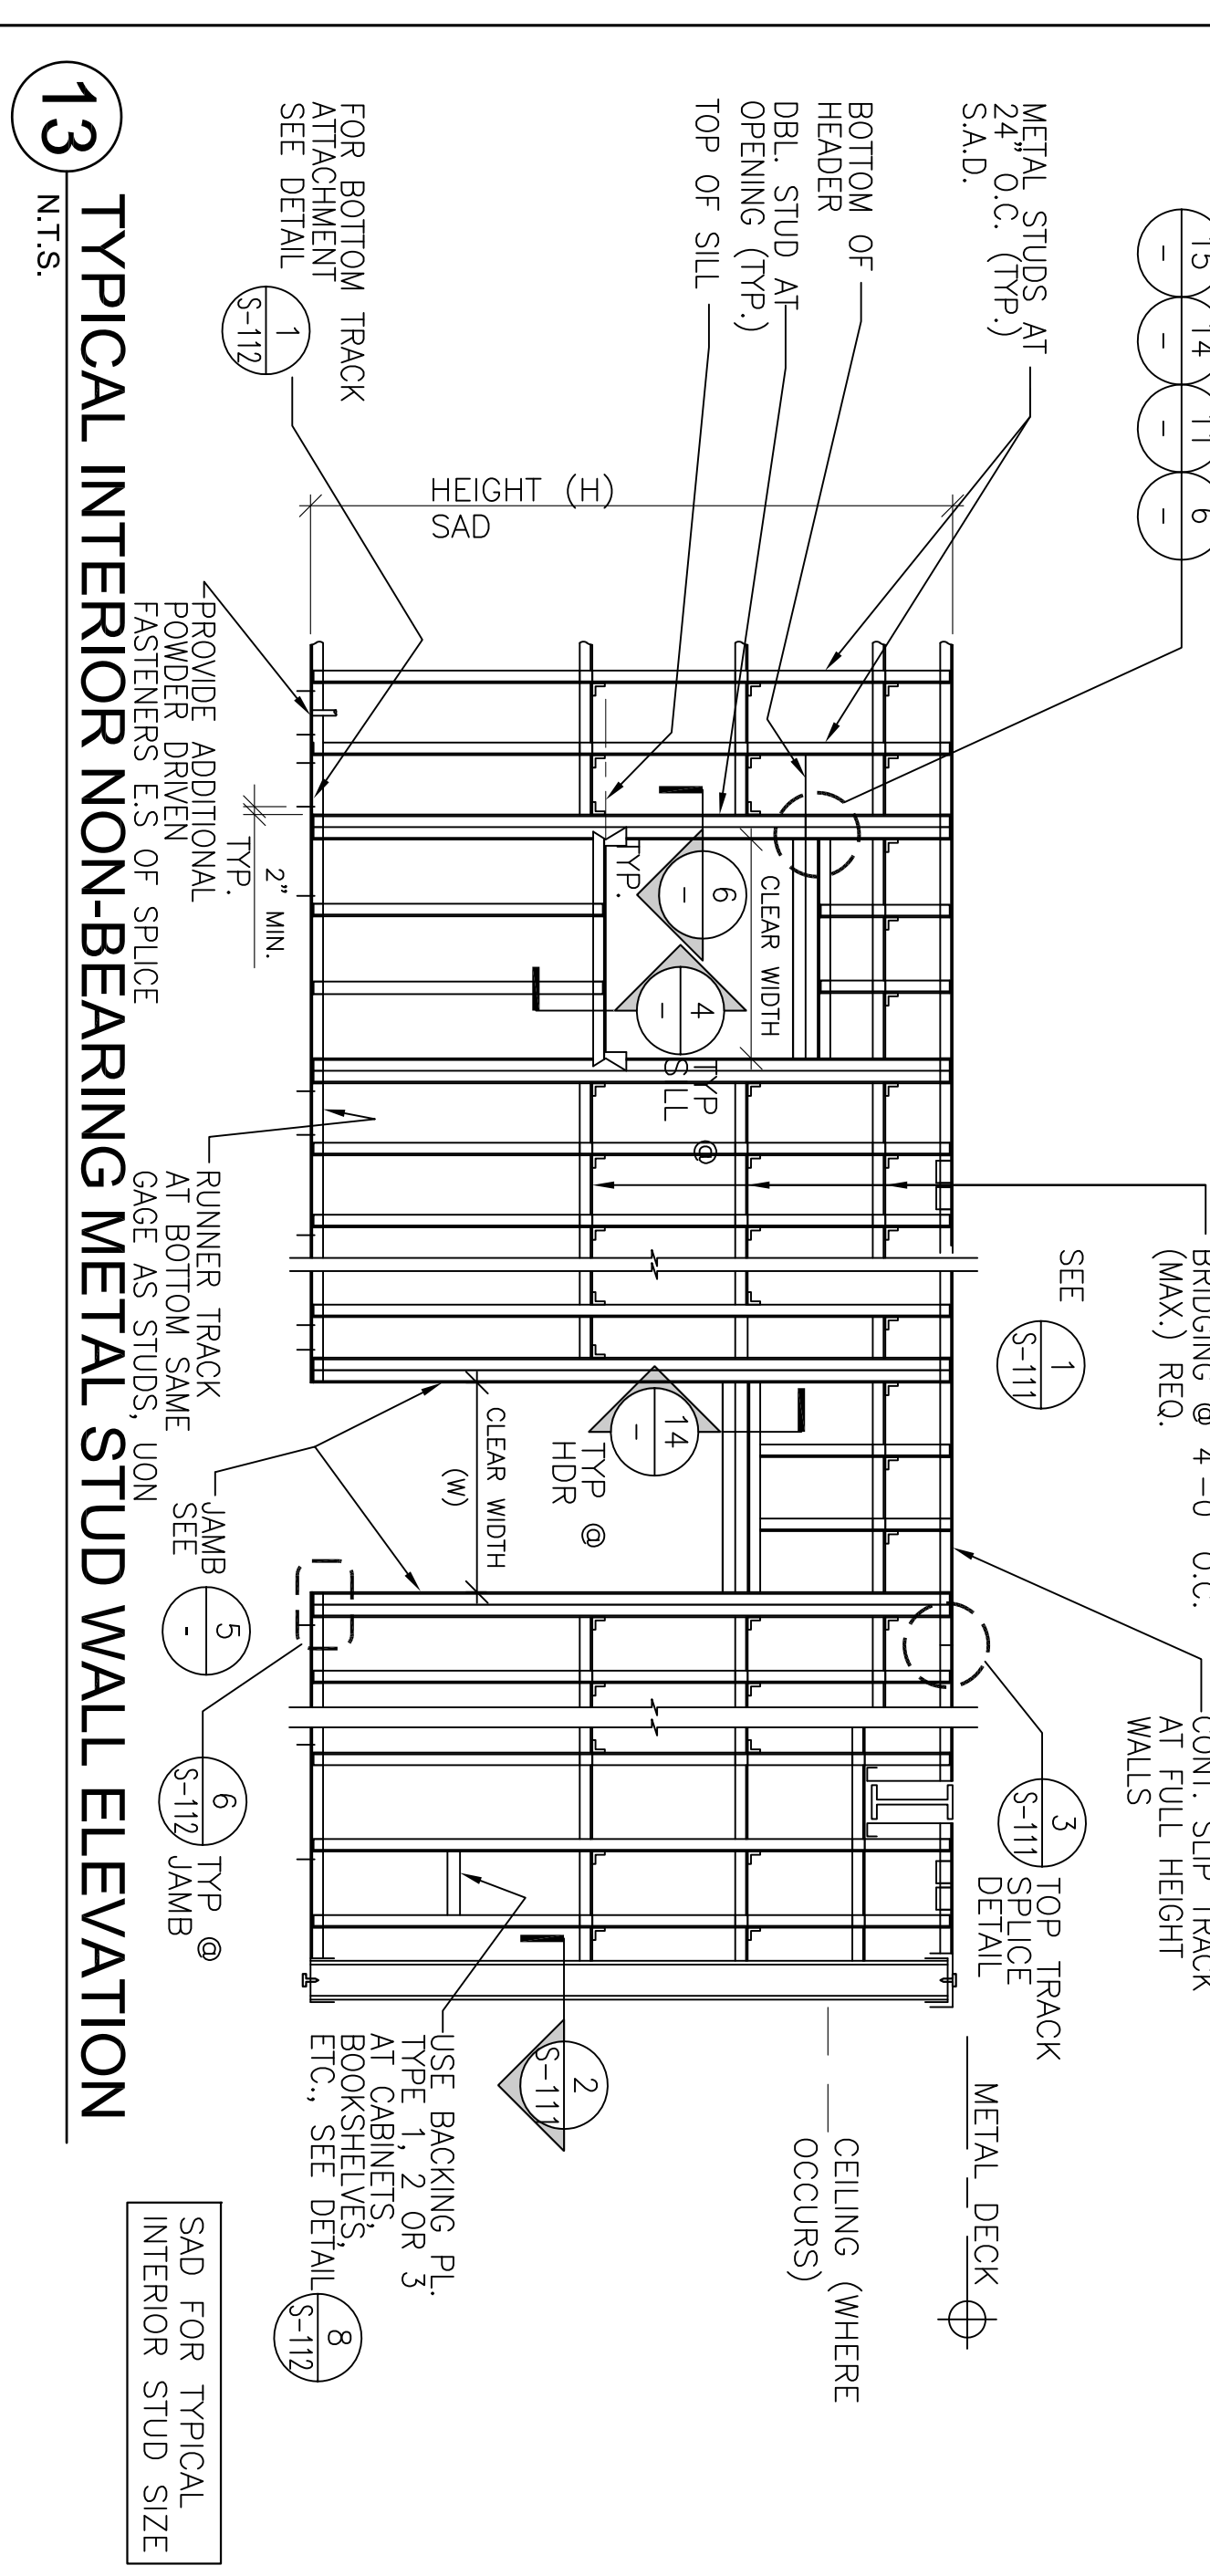

**13 TYPICAL INTERIOR NON-BEARING METAL STUD WALL ELEVATION**  
N.T.S.


WIDTH OF OPENING "W"	HEADER SCHEDULE		1 HOUR FIRE RATED WALL SYSTEM		2 HOUR FIRE RATED WALL SYSTEM	
	CONN. TYPE	WALL SYSTEM	CONN. TYPE	WALL SYSTEM	CONN. TYPE	WALL SYSTEM
W ≤ 2'-0"	BLOCKING ONLY		BLOCKING ONLY		BLOCKING ONLY	
2'-0" < W ≤ 4'-0"	B	(1)-HORIZONTAL TRACK 18GA x 200 LEG	B	(1)-HORIZONTAL TRACK 18GA x 200 LEG	B	(1)-HORIZONTAL TRACK 18GA x 200 LEG
4'-0" < W ≤ 6'-0"	A	(2)-VERTICAL STUDS 400S138-43 (2)-CLOSURE TRACKS 18GA x 200 LEG	A	(2)-VERTICAL STUDS 400S138-43 (2)-CLOSURE TRACKS 18GA x 200 LEG	A	(2)-VERTICAL STUDS 400S138-43 (2)-CLOSURE TRACKS 18GA x 200 LEG
6'-0" < W ≤ 8'-0"	A	(2)-VERTICAL STUDS 600S162-43 (2)-CLOSURE TRACKS 18GA x 200 LEG	A	(2)-VERTICAL STUDS 600S162-43 (2)-CLOSURE TRACKS 18GA x 200 LEG	A	(2)-VERTICAL STUDS 600S162-43 (2)-CLOSURE TRACKS 18GA x 200 LEG
8'-0" < W ≤ 12'-0"	A	(2)-VERTICAL STUDS 800S200-43 (2)-CLOSURE TRACKS 18GA x 200 LEG	A	(2)-VERTICAL STUDS 1000S200-54 (2)-CLOSURE TRACKS 18GA x 200 LEG	A	(2)-VERTICAL STUDS 1000S200-54 (2)-CLOSURE TRACKS 18GA x 200 LEG

**2 HEADER SCHEDULE**  
N.T.S.

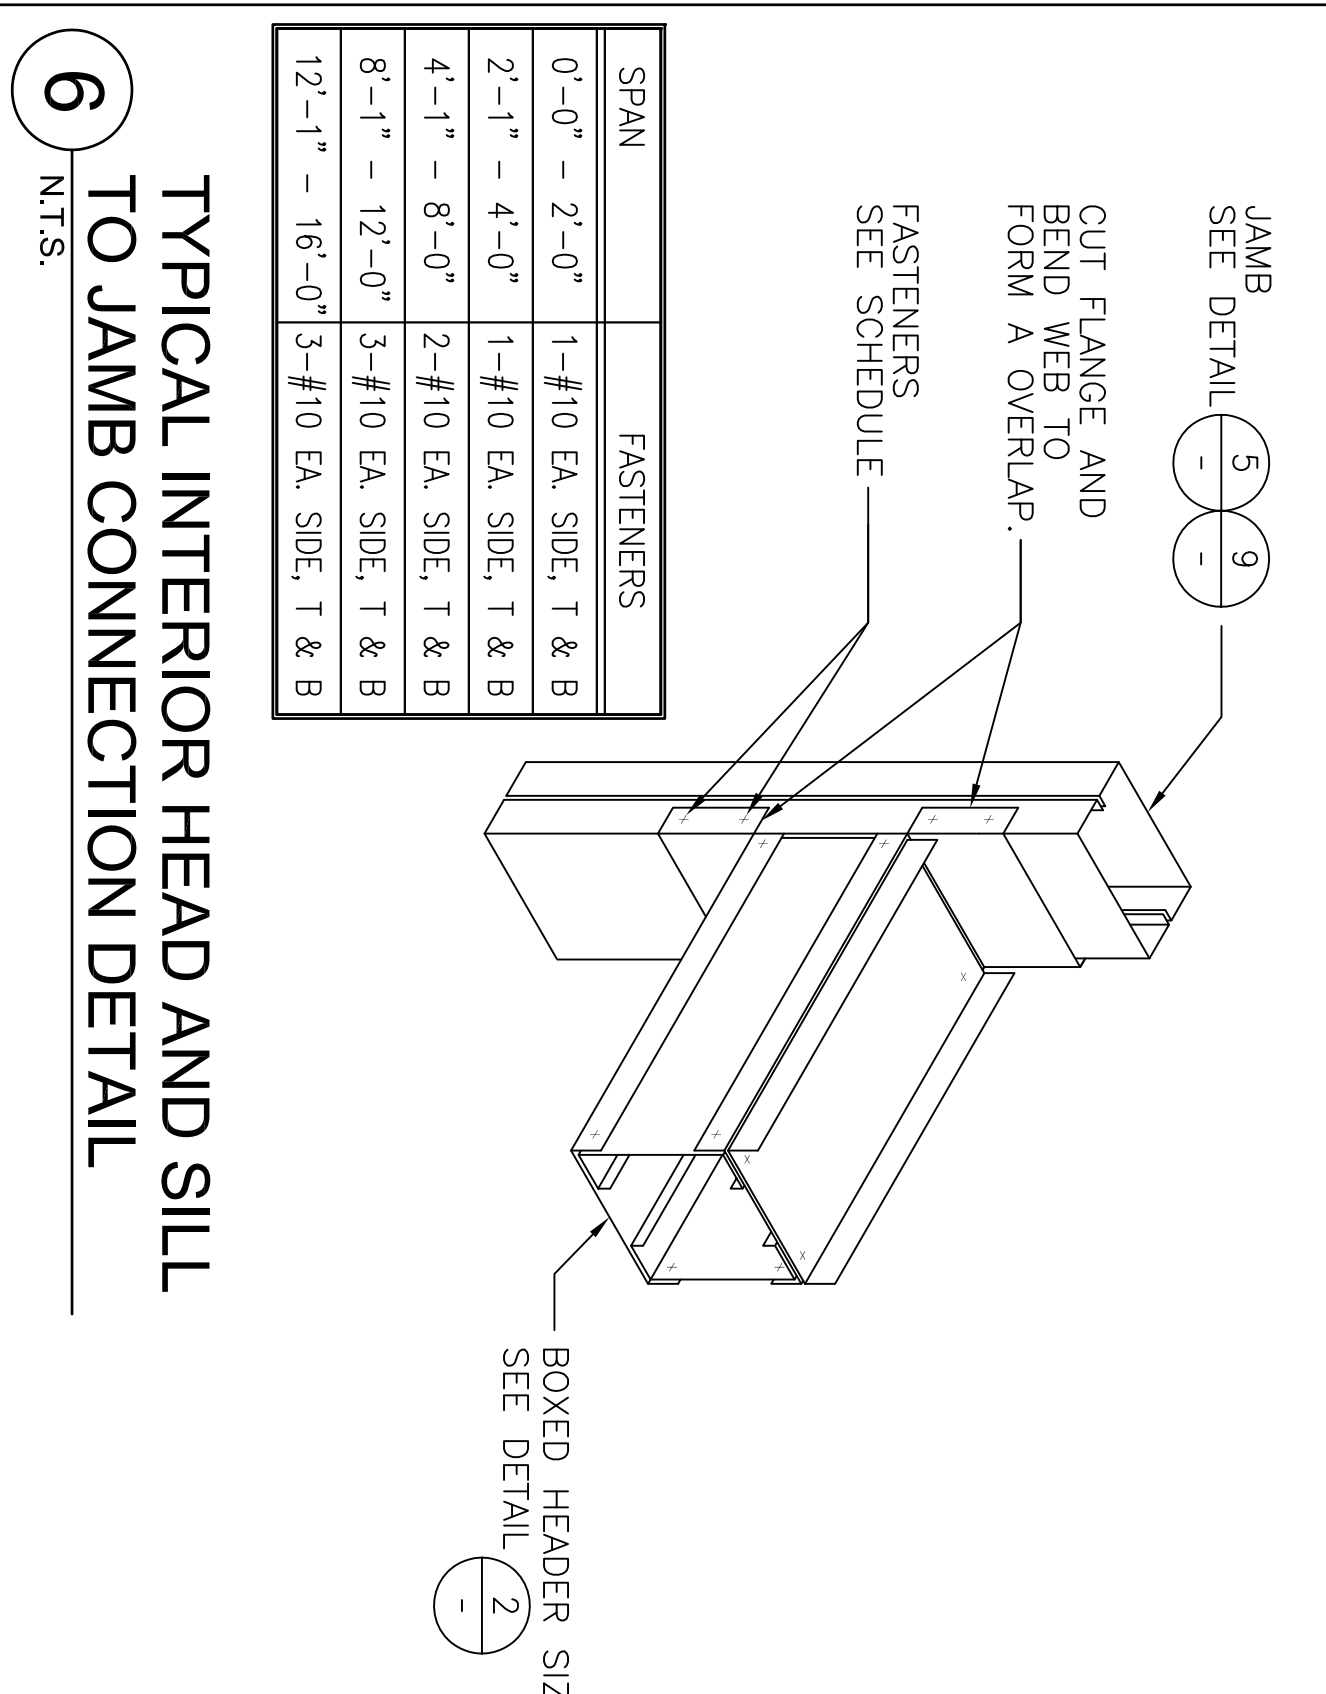


**6 TYPICAL INTERIOR HEAD AND SILL TO JAMB CONNECTION DETAIL**  
N.T.S.

ALTERNATE HEADER SCHEDULE: PRICELESS		1 HOUR FIRE RATED WALL SYSTEM		2 HOUR FIRE RATED WALL SYSTEM	
WIDTH OF OPENING "W"	BLOCKING ONLY	BLOCKING ONLY	BLOCKING ONLY	BLOCKING ONLY	BLOCKING ONLY
W ≤ 2'-0"	"D" x HDR200-33	"D" x HDR200-33	"D" x HDR200-33	"D" x HDR200-33	"D" x HDR200-33
2'-0" < W ≤ 4'-0"	"D" x HDR200-43	"D" x HDR200-43	"D" x HDR200-43	"D" x HDR200-43	"D" x HDR200-43
4'-0" < W ≤ 6'-0"	"D" x HDR200-54	"D" x HDR200-54	"D" x HDR200-54	"D" x HDR200-54	"D" x HDR200-54
6'-0" < W ≤ 8'-0"	"D" x HDR450-68	"D" x HDR450-68	"D" x HDR450-68	"D" x HDR450-68	"D" x HDR450-68
8'-0" < W ≤ 12'-0"	-	-	-	-	-

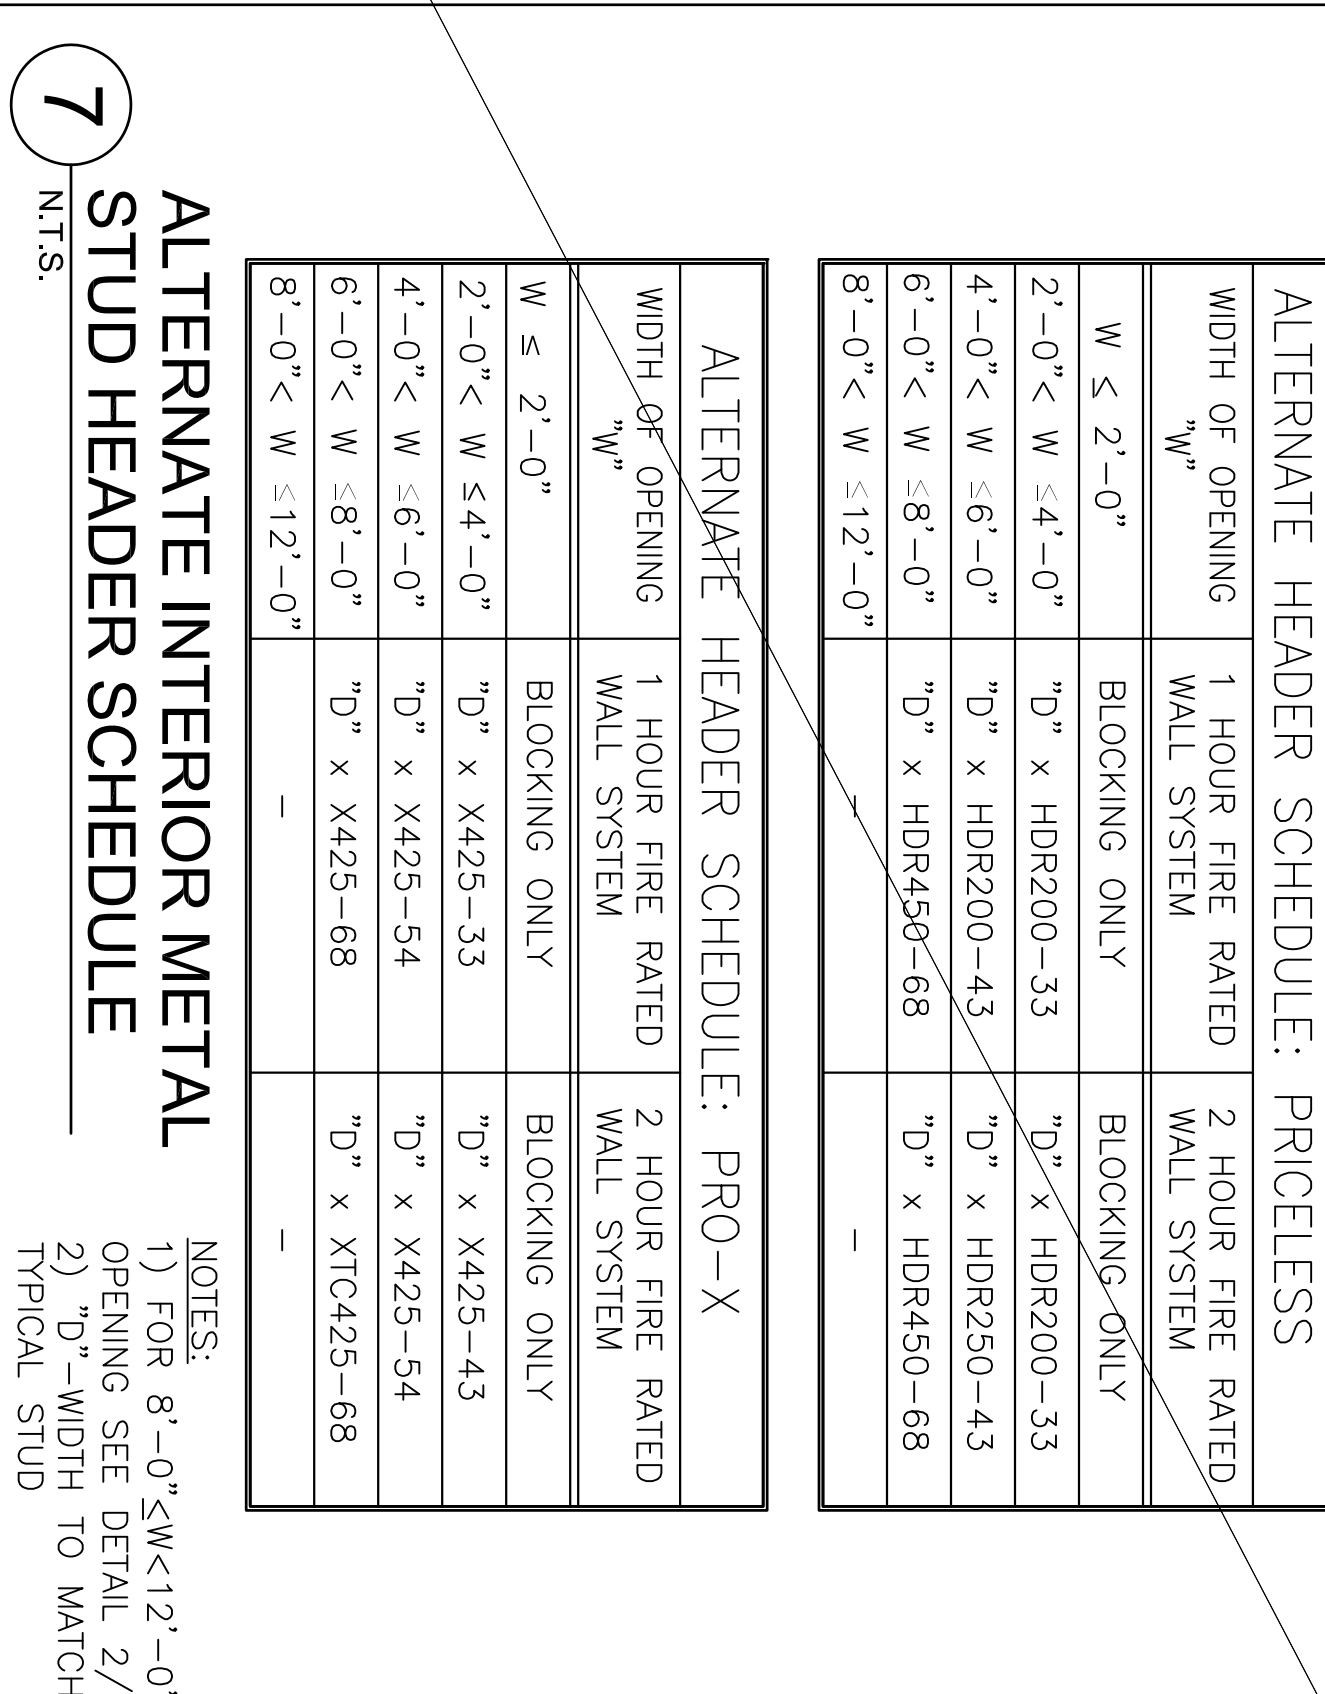


**7 ALTERNATE INTERIOR METAL STUD HEADER SCHEDULE**  
N.T.S.

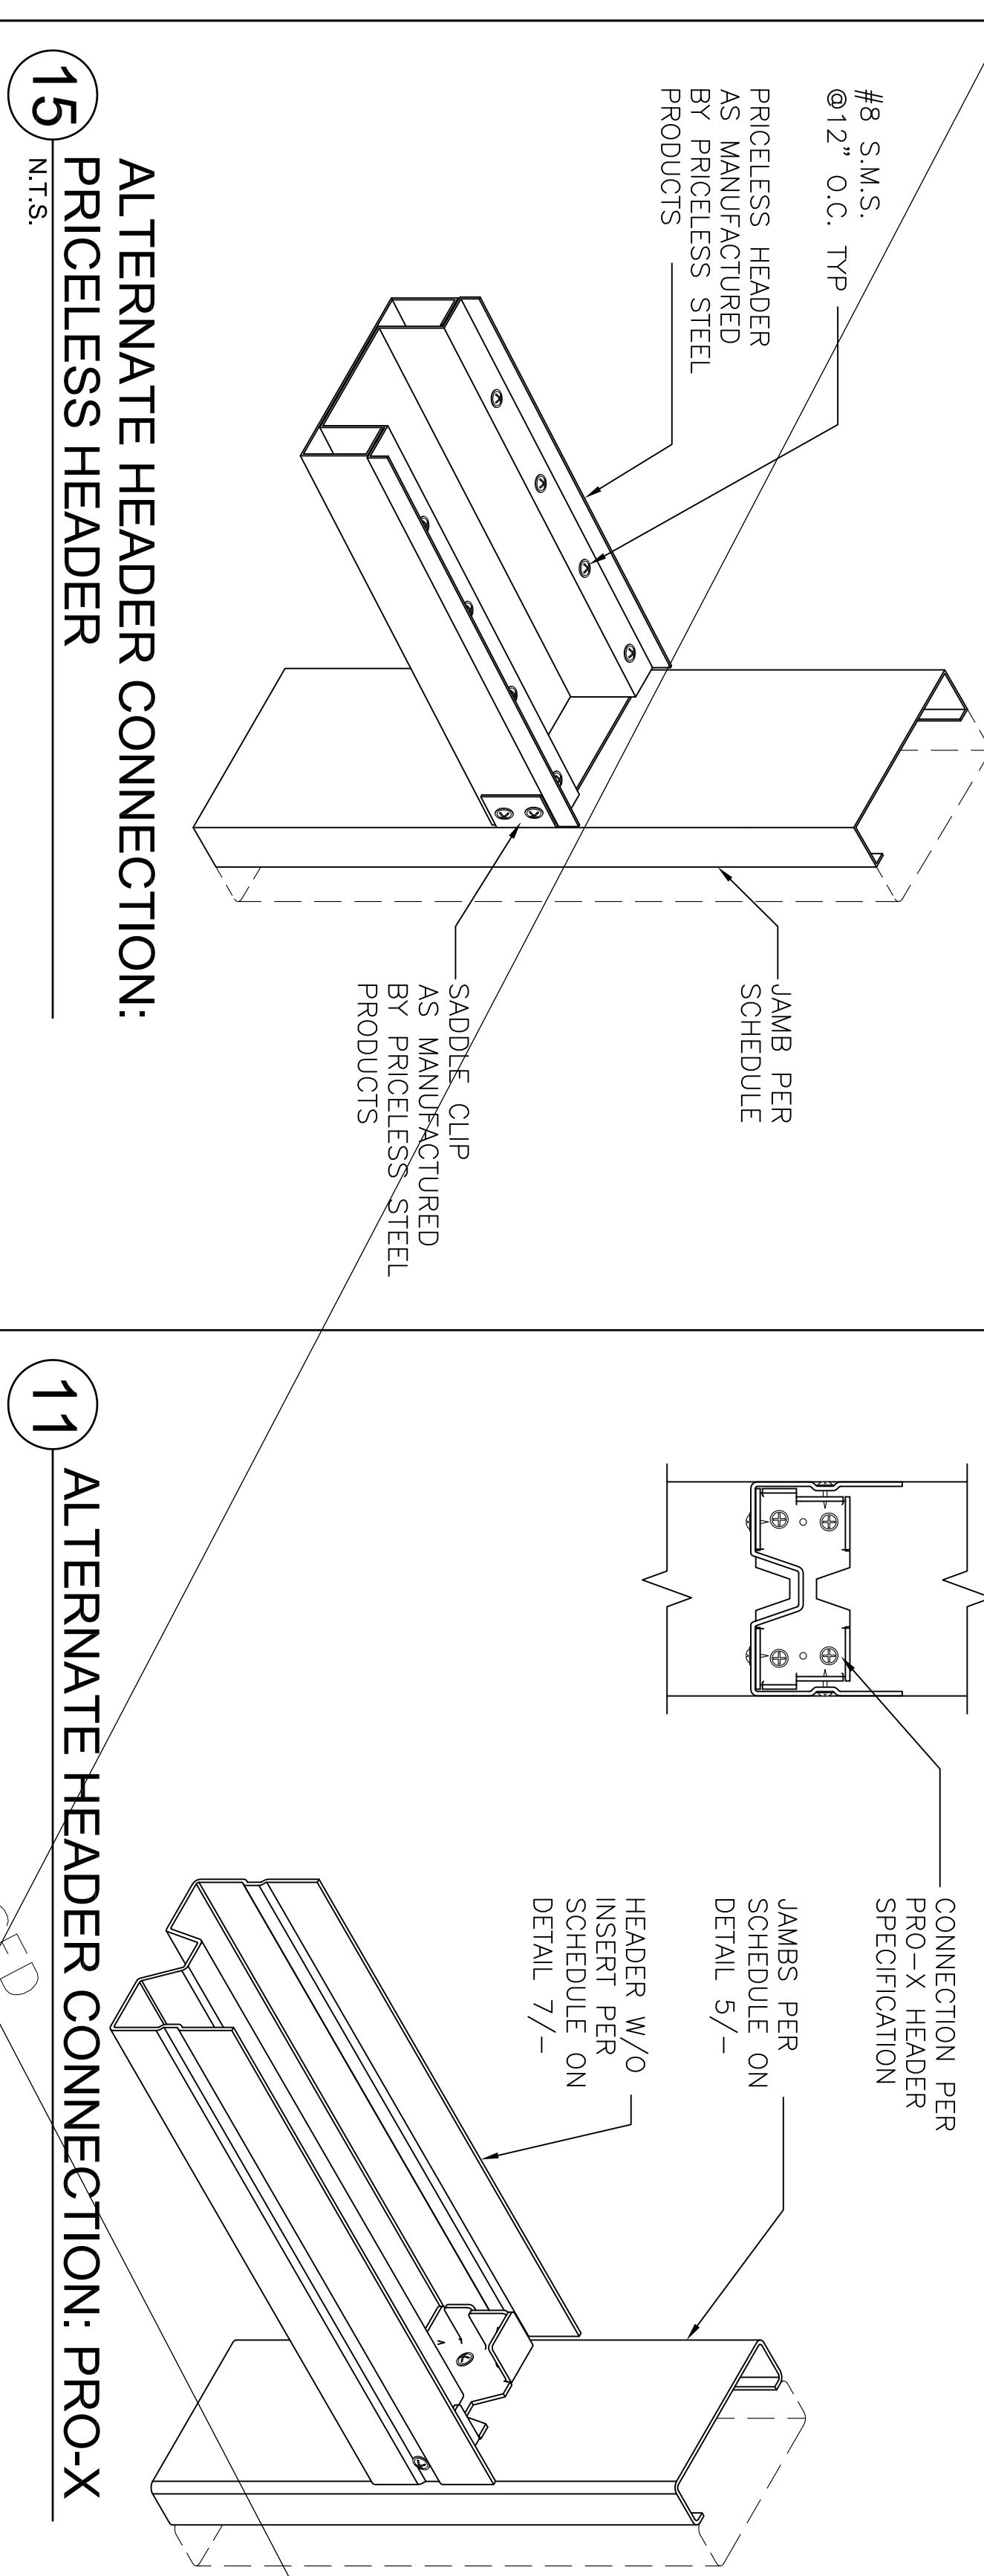


**11 ALTERNATE HEADER CONNECTION: PRO-X**  
N.T.S.


ALTERNATE SILL SCHEDULE: PRICELESS		1 HOUR FIRE RATED WALL SYSTEM		2 HOUR FIRE RATED WALL SYSTEM	
WIDTH OF OPENING "W"	BLOCKING ONLY	BLOCKING ONLY	BLOCKING ONLY	BLOCKING ONLY	BLOCKING ONLY
W ≤ 2'-0"	"D" x HDR200-33	"D" x HDR200-33	"D" x HDR200-33	"D" x HDR200-33	"D" x HDR200-33
2'-0" < W ≤ 4'-0"	"D" x HDR200-43	"D" x HDR200-43	"D" x HDR200-43	"D" x HDR200-43	"D" x HDR200-43
4'-0" < W ≤ 6'-0"	"D" x HDR200-54	"D" x HDR200-54	"D" x HDR200-54	"D" x HDR200-54	"D" x HDR200-54
6'-0" < W ≤ 8'-0"	"D" x HDR450-68	"D" x HDR450-68	"D" x HDR450-68	"D" x HDR450-68	"D" x HDR450-68
8'-0" < W ≤ 12'-0"	-	-	-	-	-

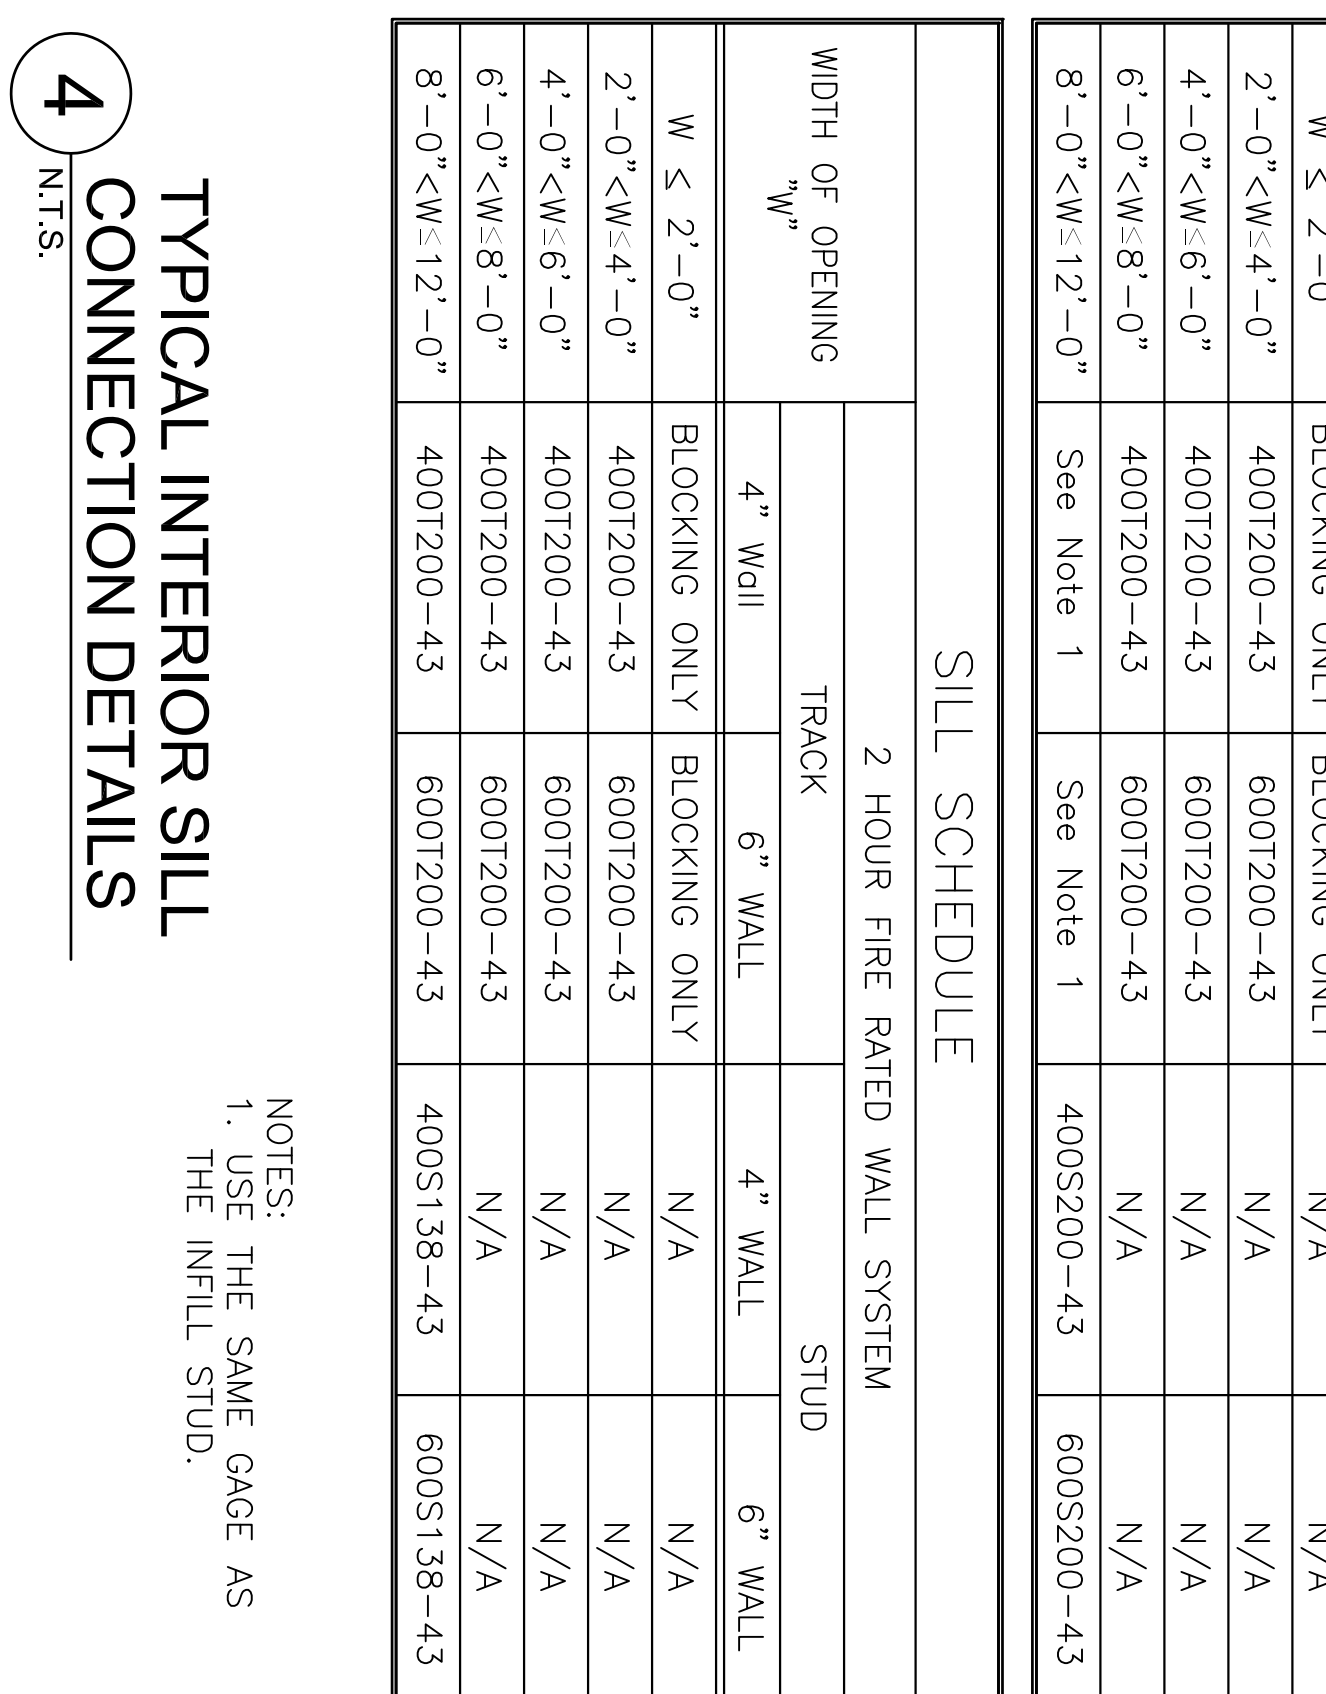


**8 ALTERNATE INTERIOR METAL STUD SILL SCHEDULE**  
N.T.S.

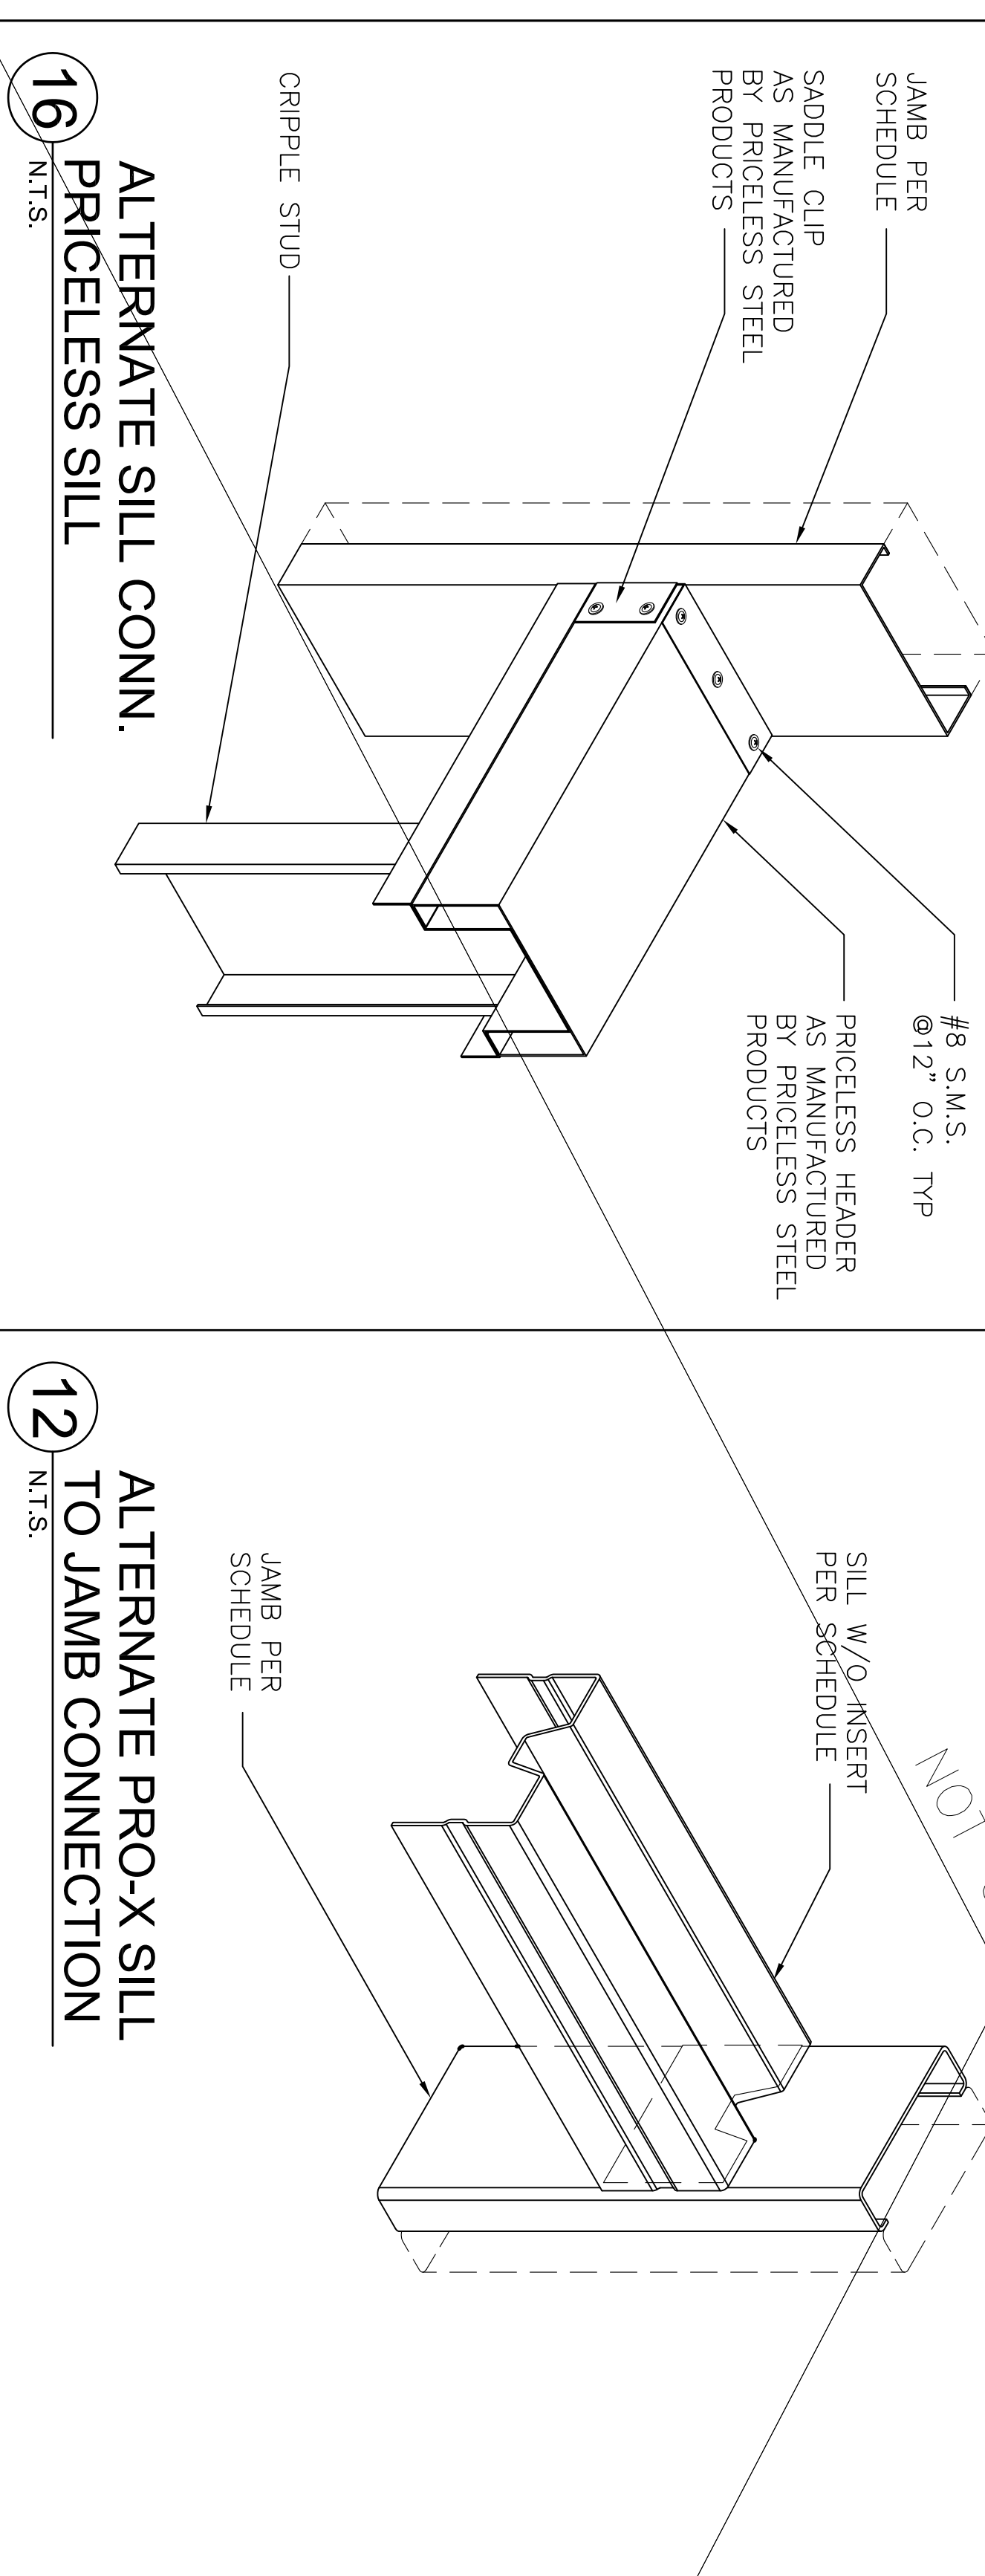


**12 ALTERNATE PRO-X SILL TO JAMB CONNECTION**  
N.T.S.

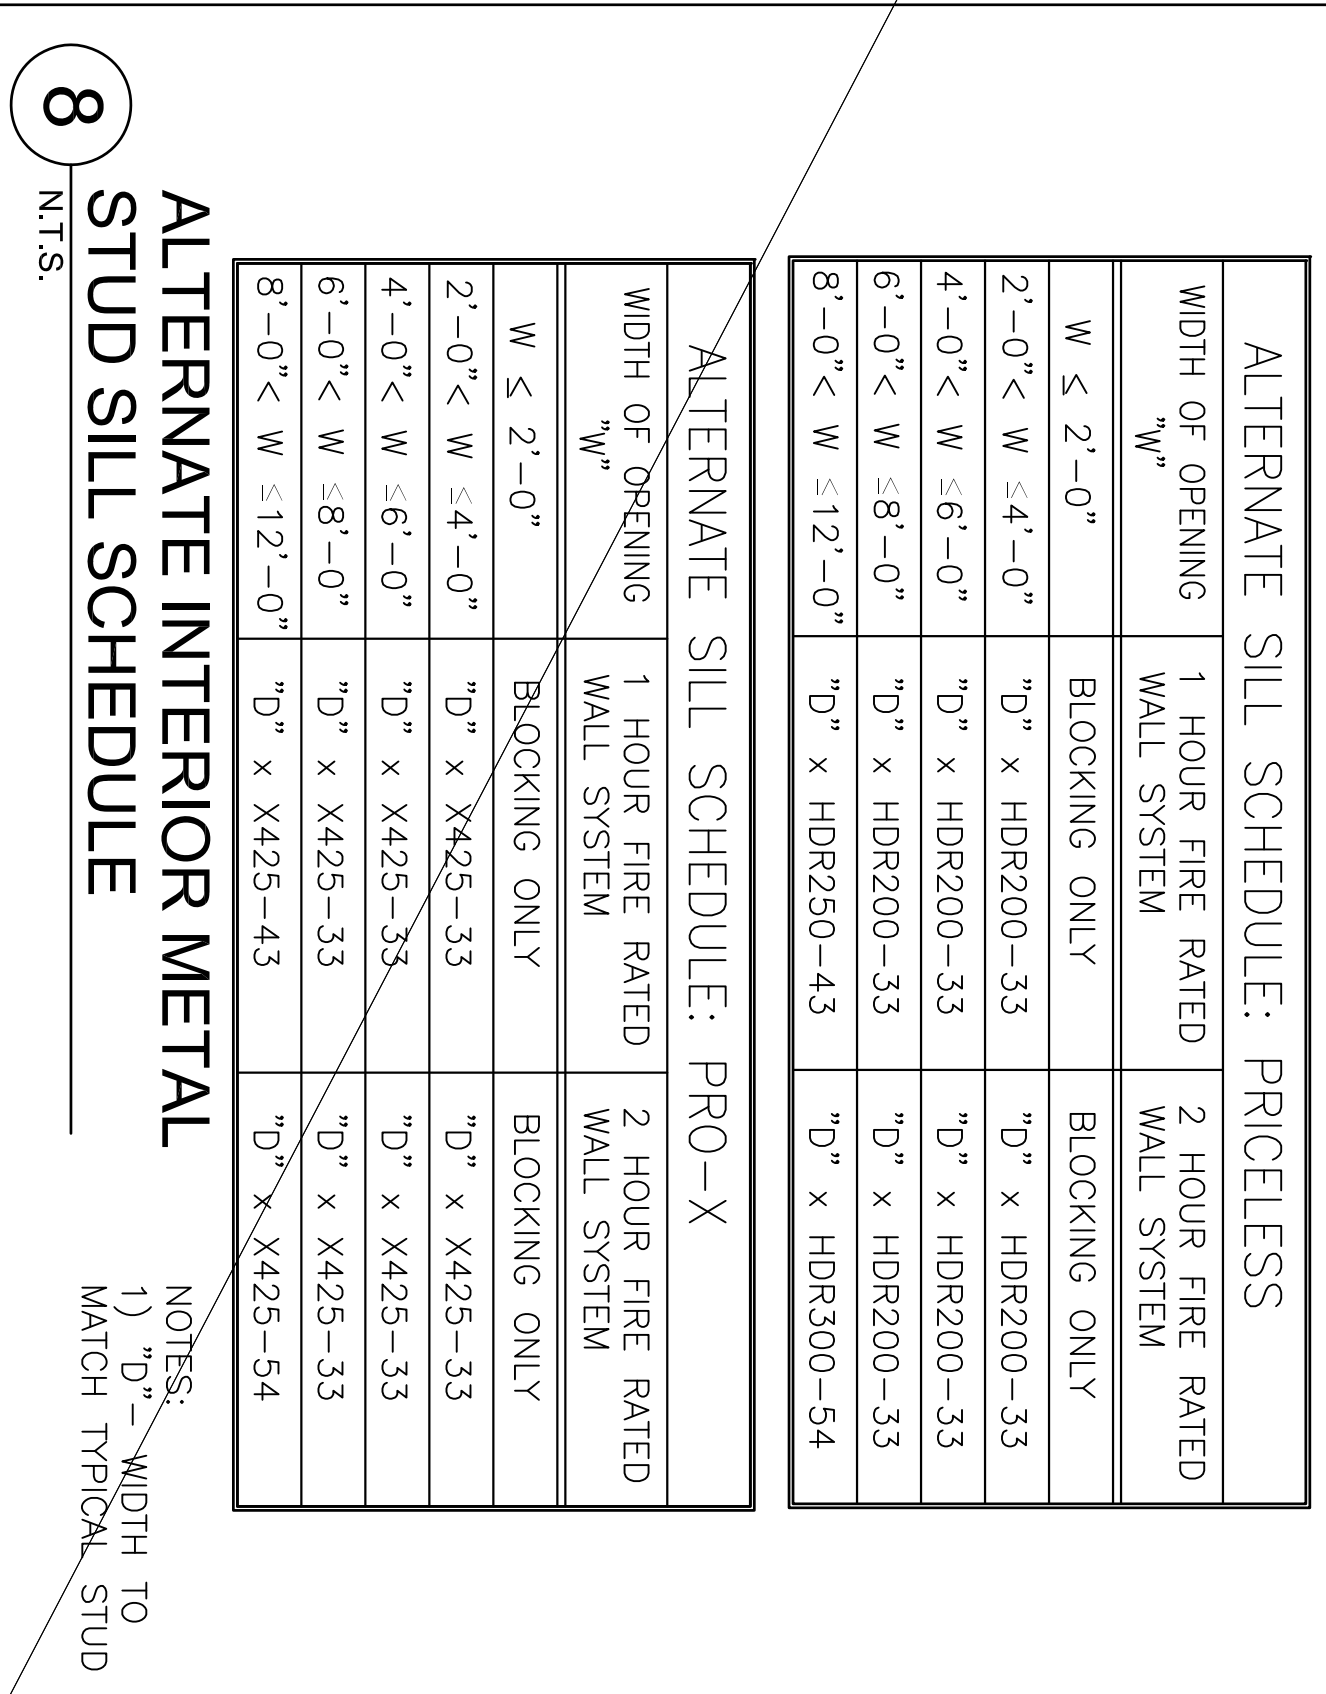


**4 TYPICAL INTERIOR SILL CONNECTION DETAILS**  
N.T.S.

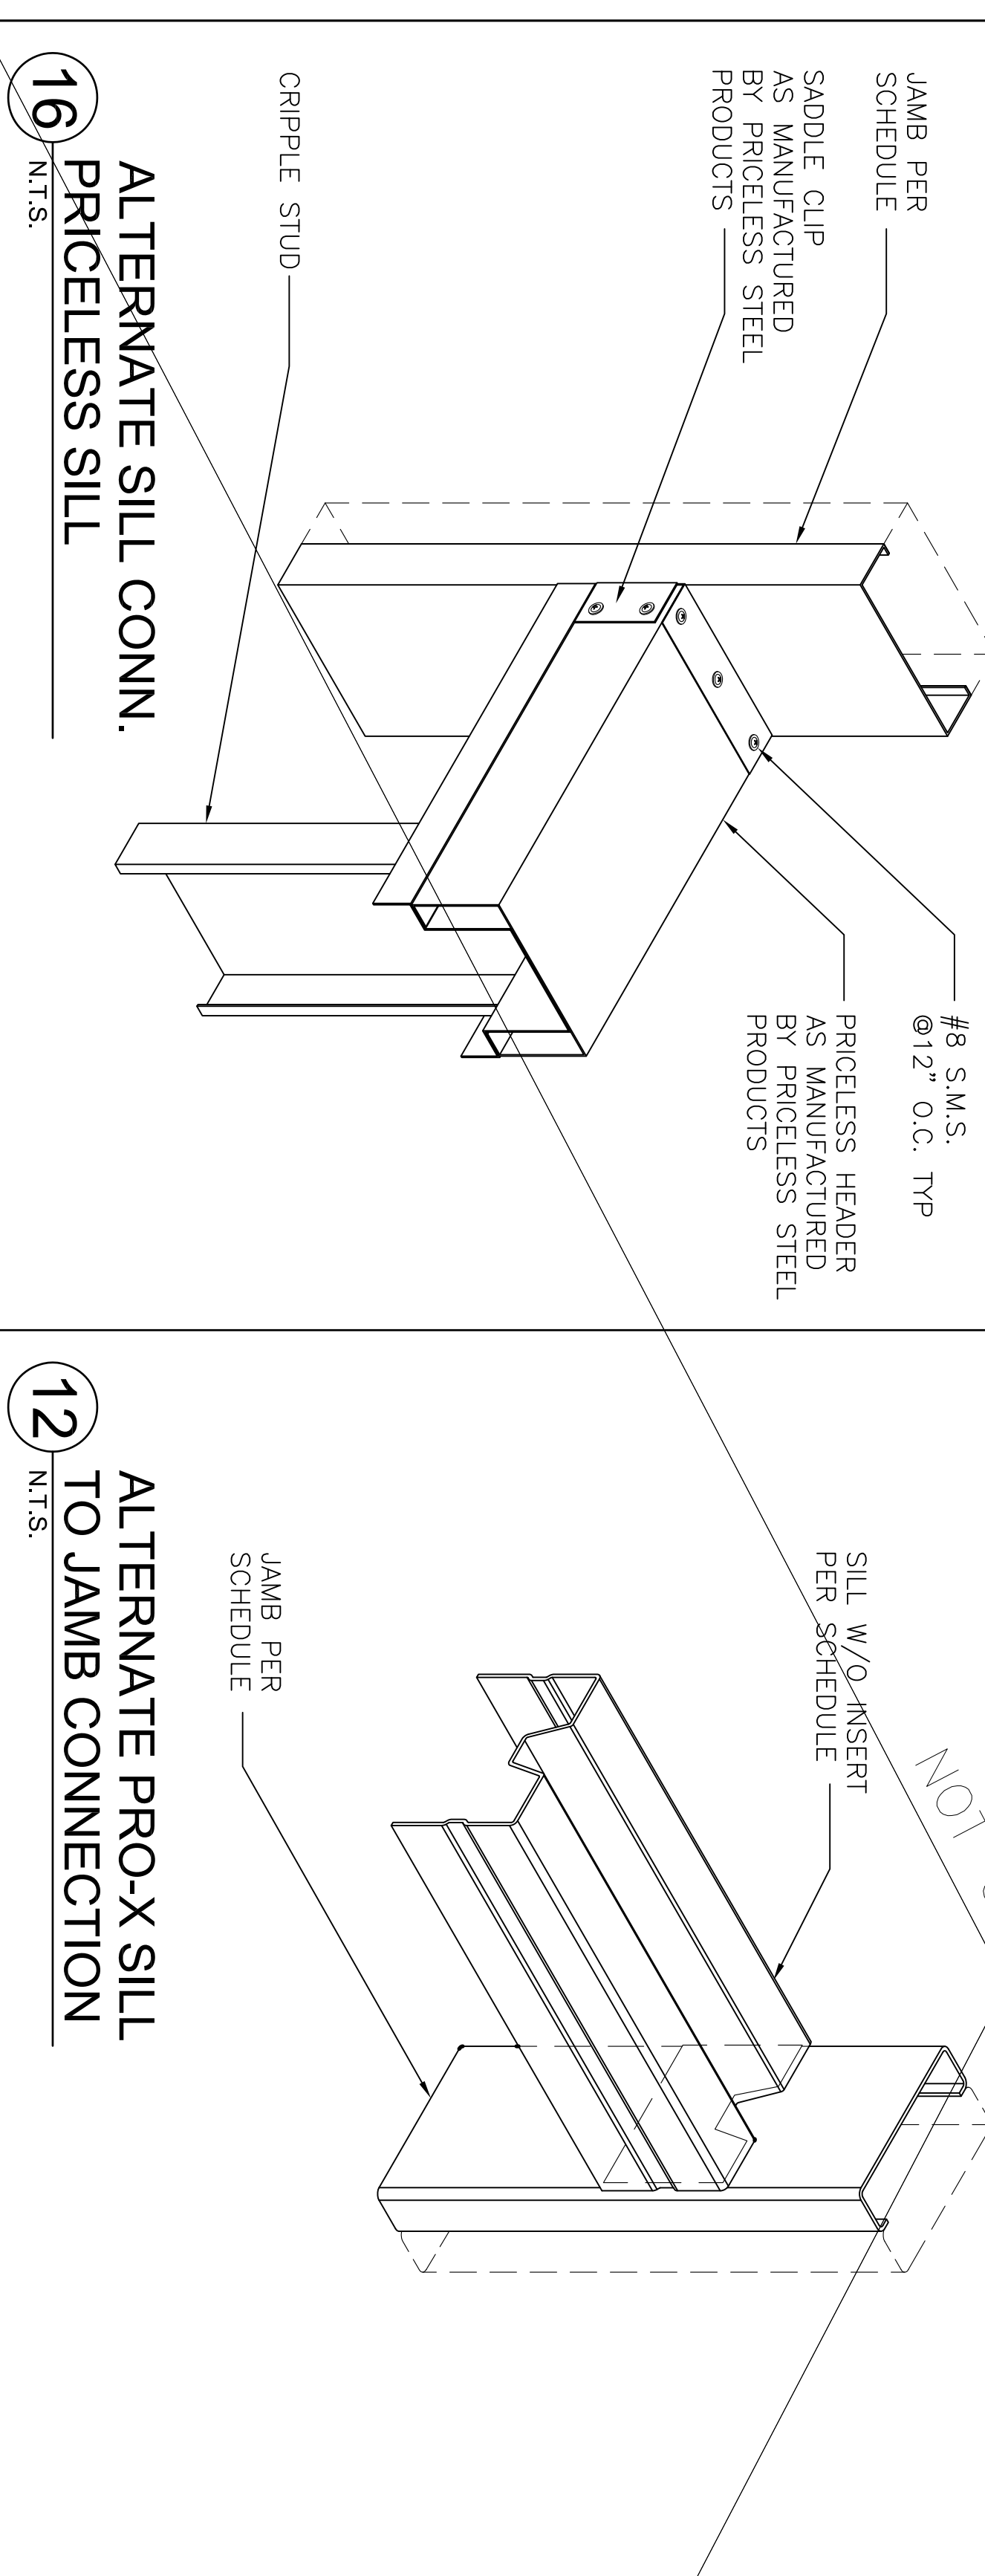

**15 ALTERNATE HEADER CONNECTION: PRICELESS**  
N.T.S.

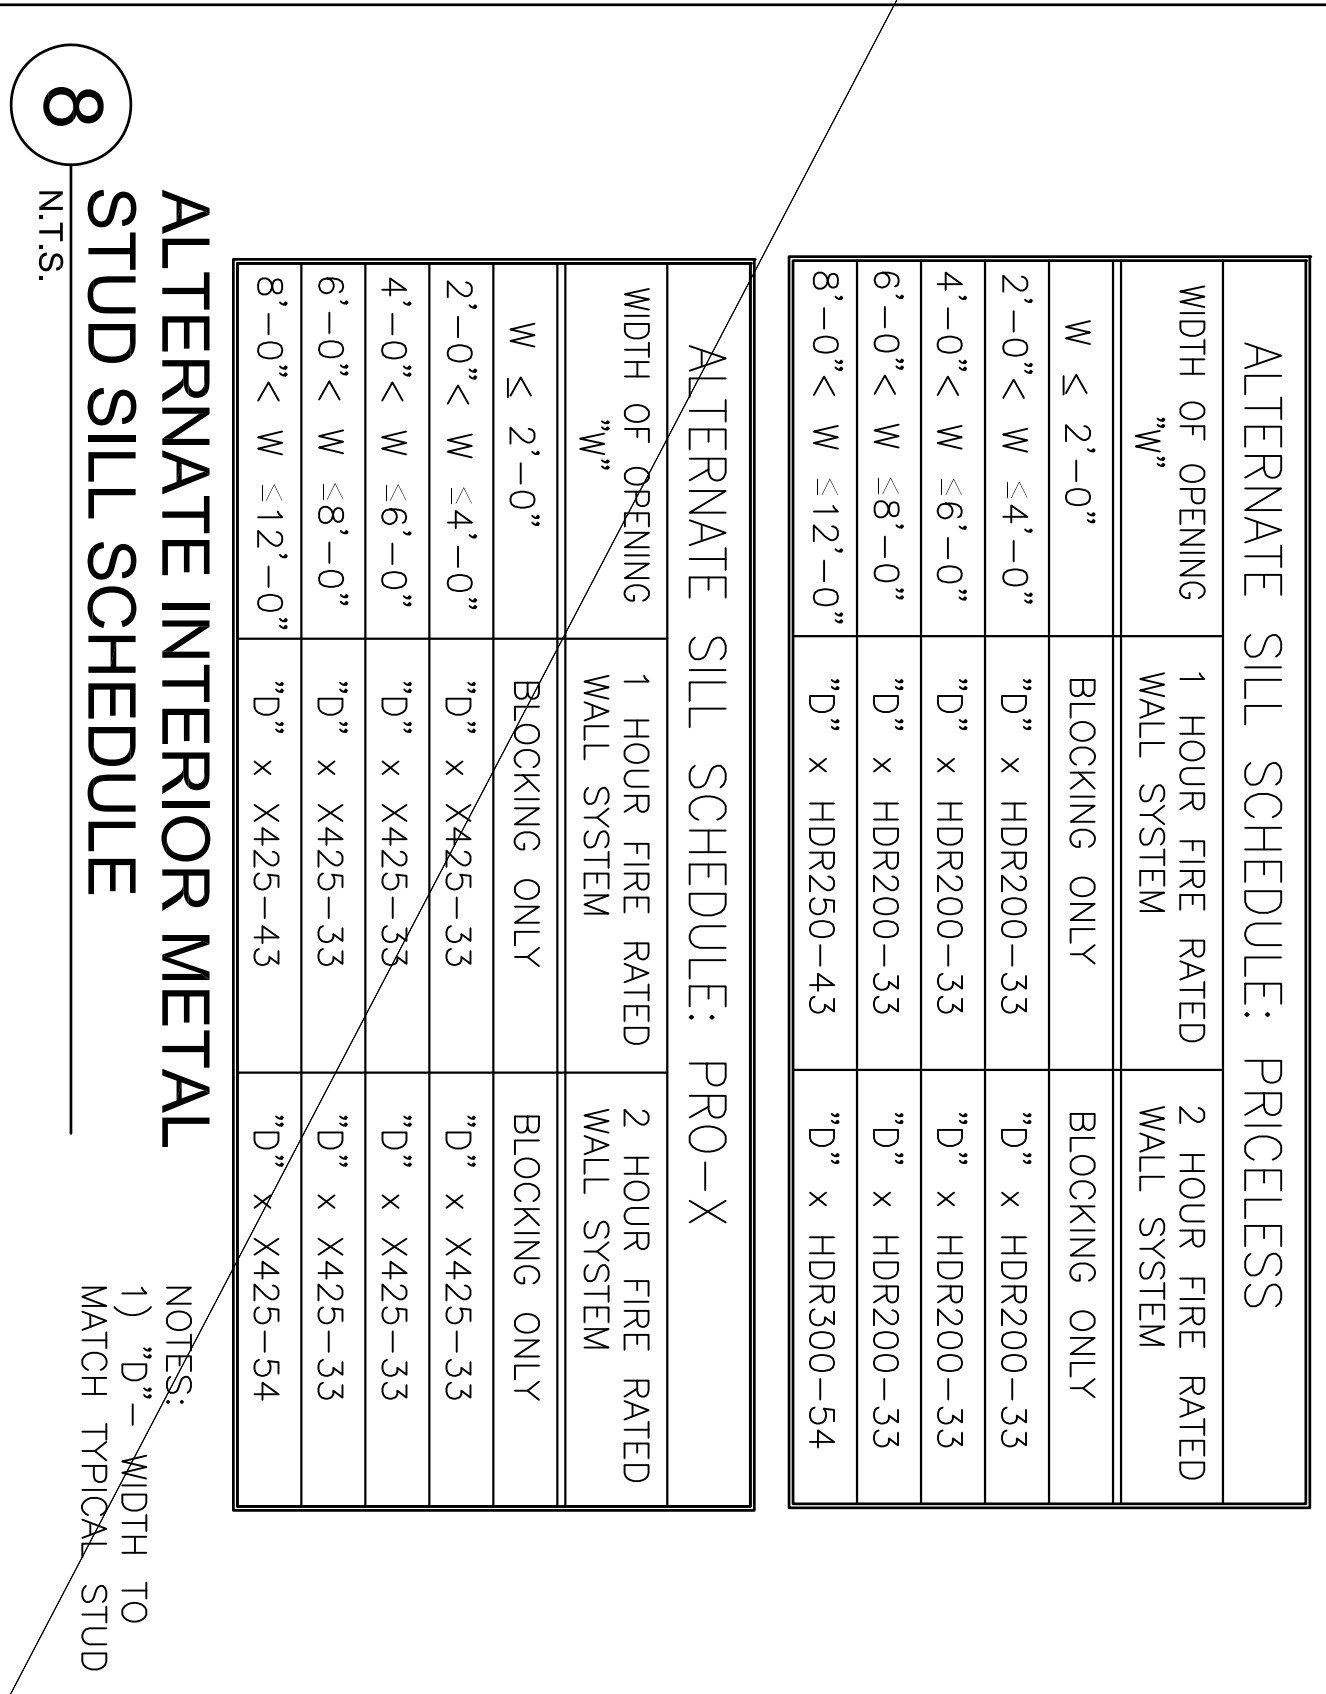


**16 ALTERNATE SILL CONN. PRICELESS SILL**  
N.T.S.

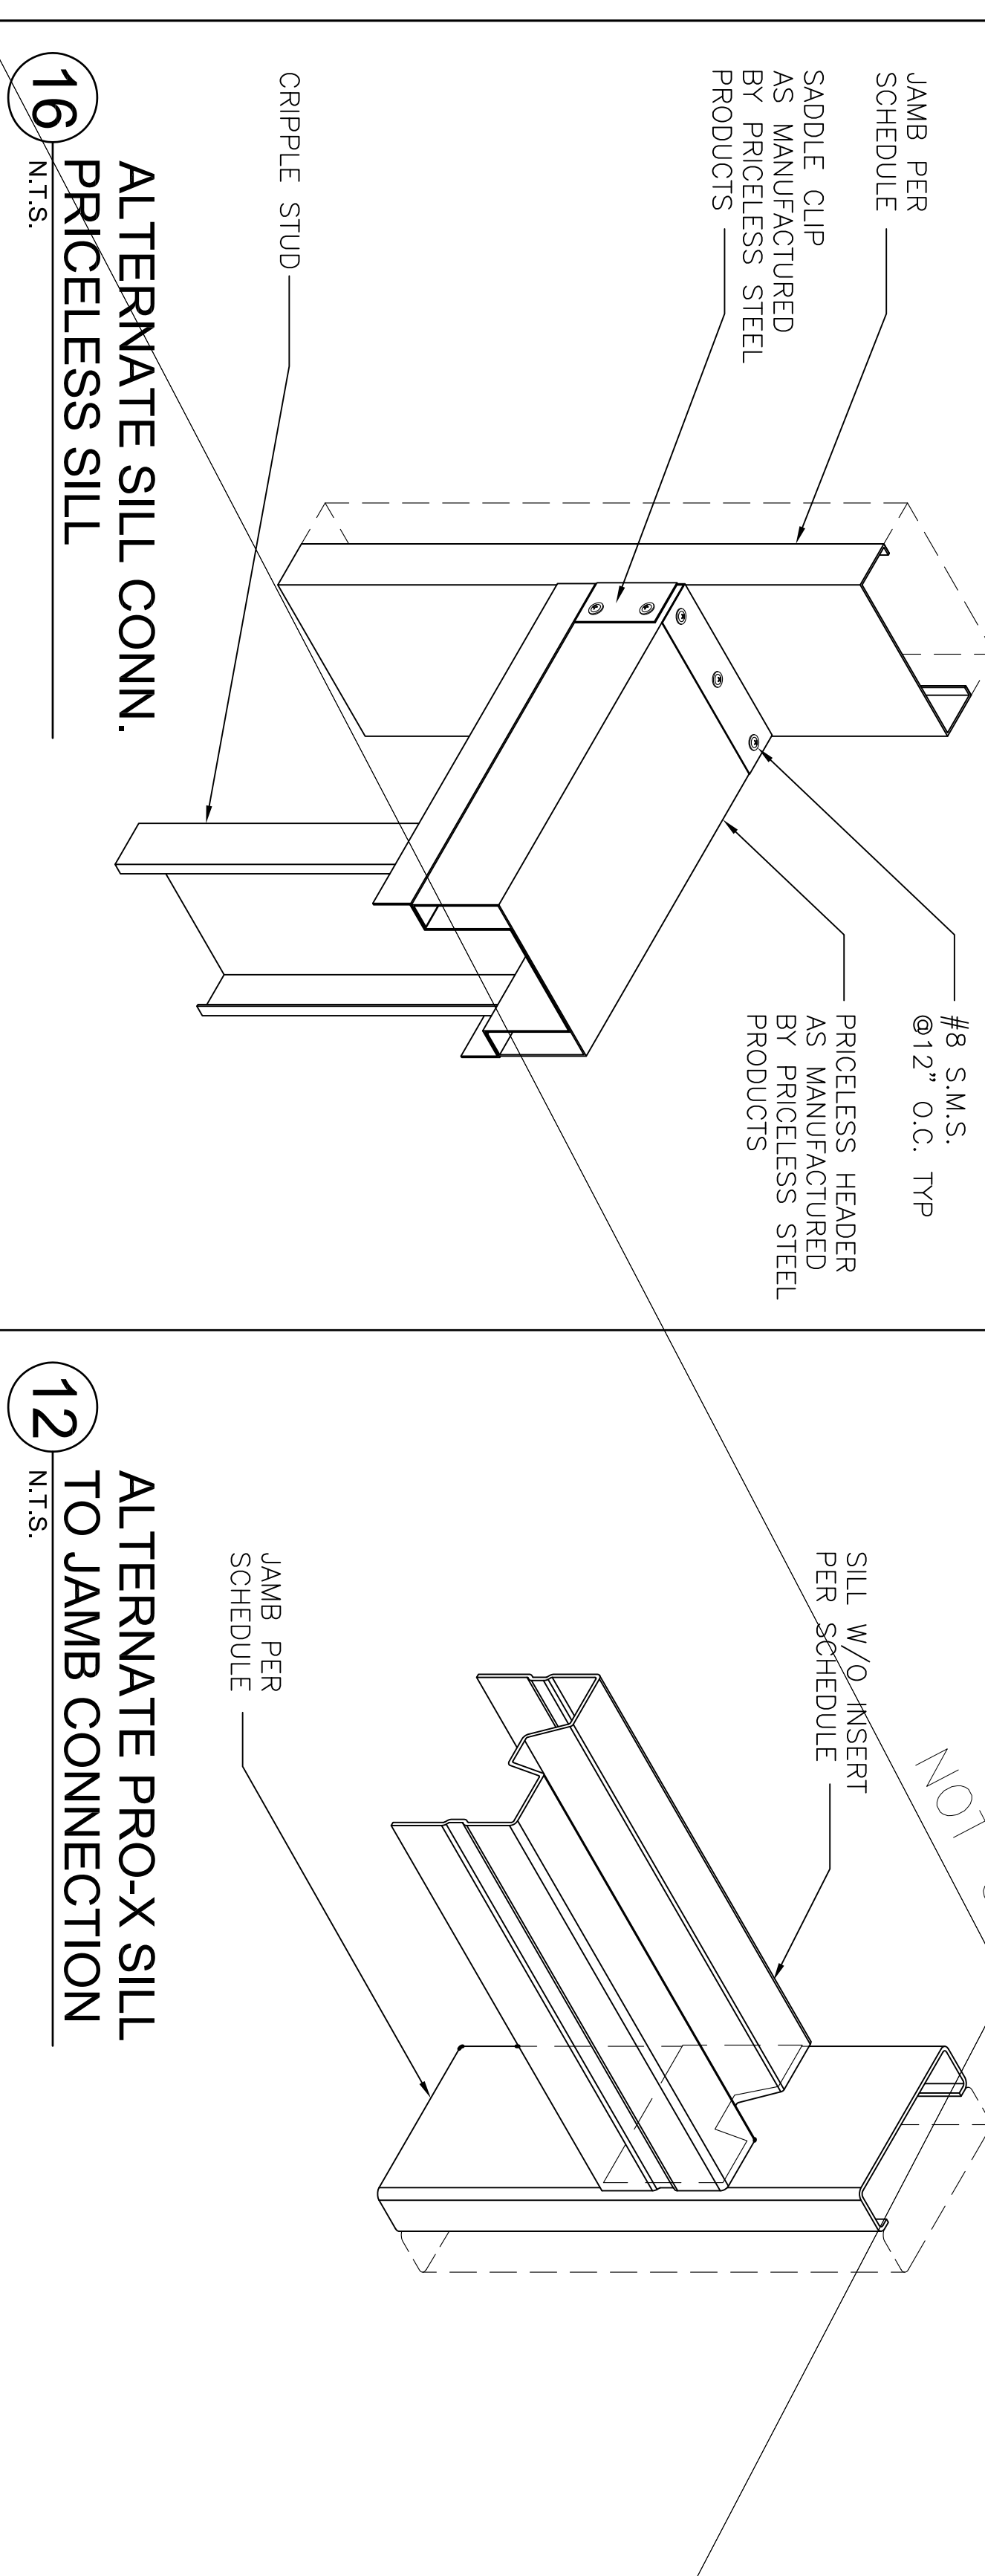


**16 ALTERNATE SILL CONN. PRICELESS SILL**  
N.T.S.




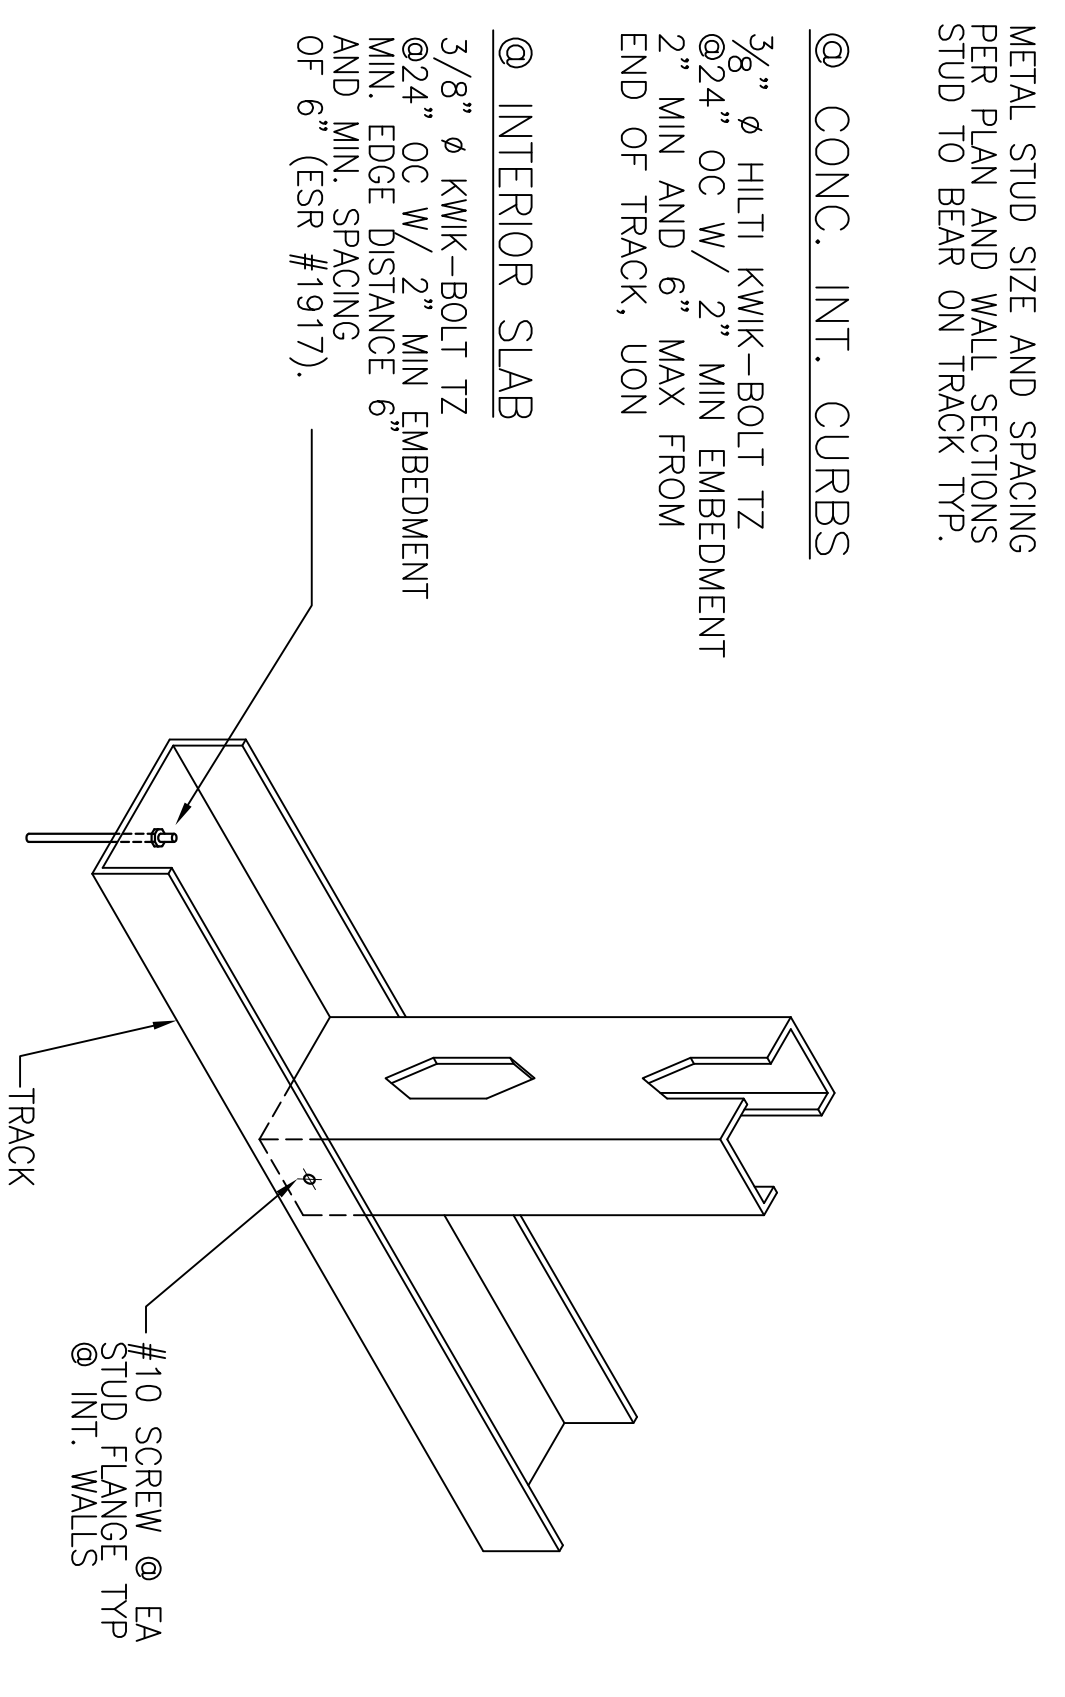


**1** TYPICAL INTERIOR STUD WALL BOTTOM TRACK CONN. TO CONCRETE  
 N.T.S.

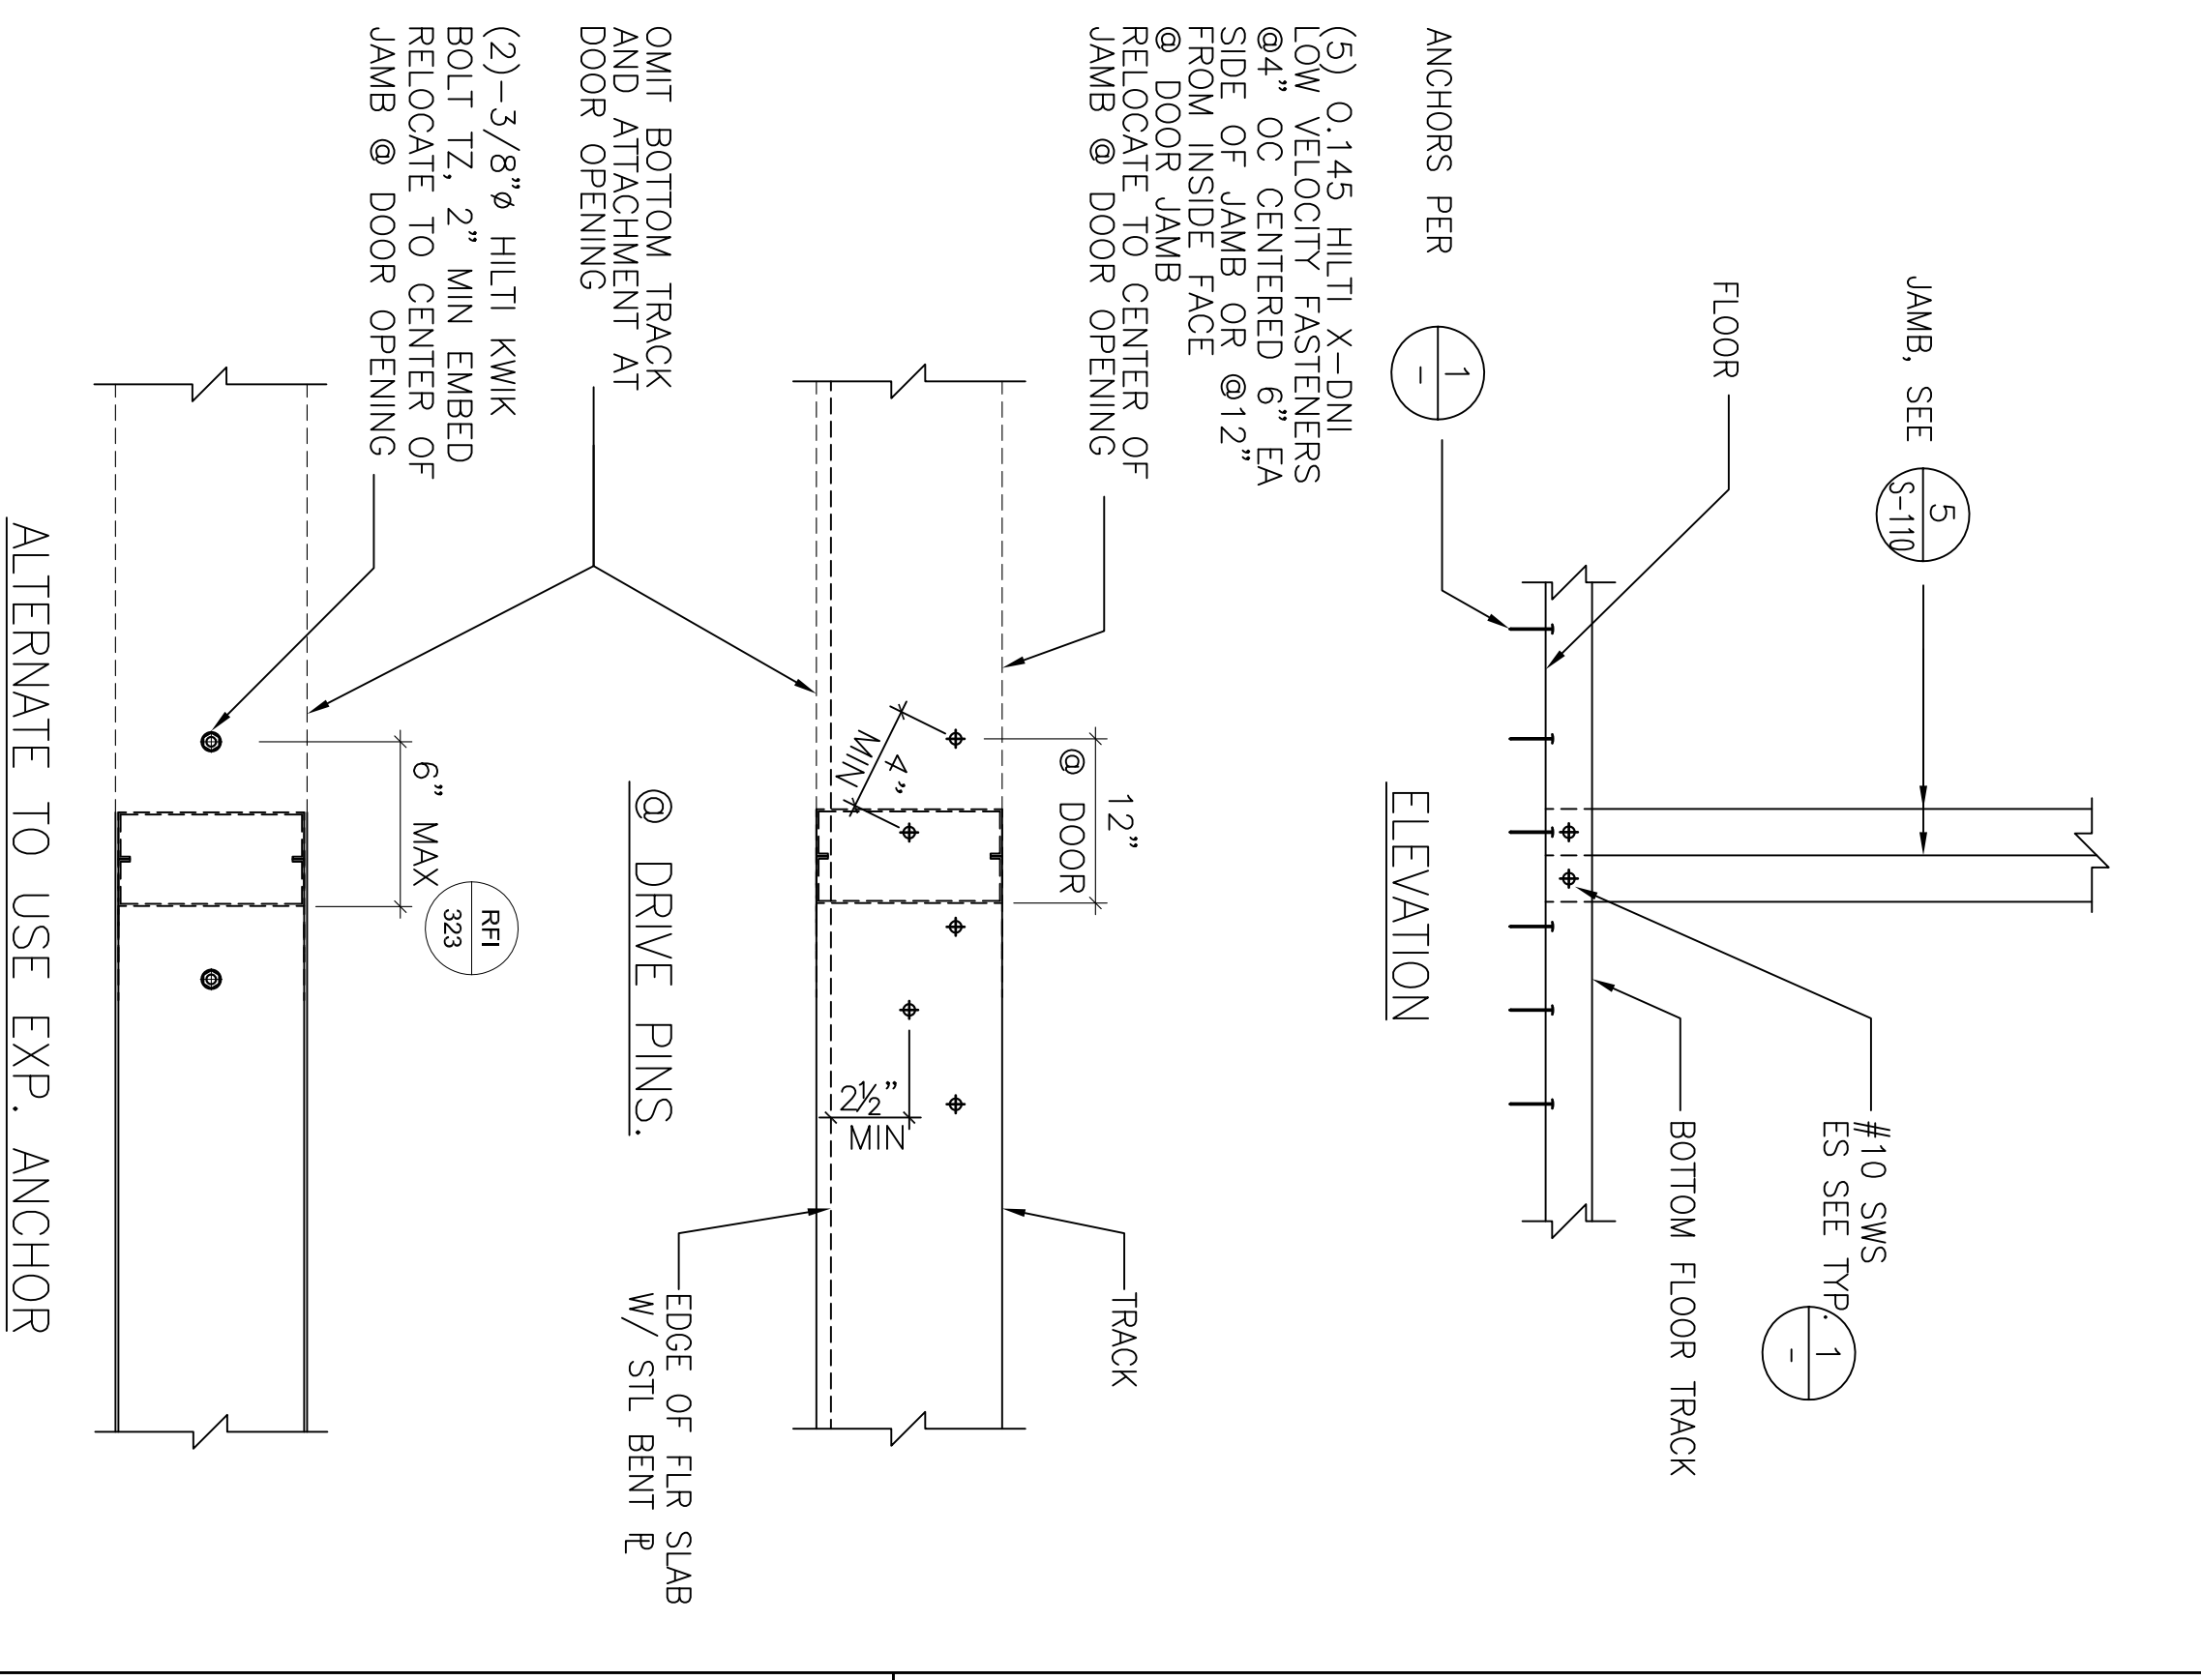

**6** TYPICAL INTERIOR JAMB STUD BOTTOM CONN. TO CONCRETE  
 N.T.S.

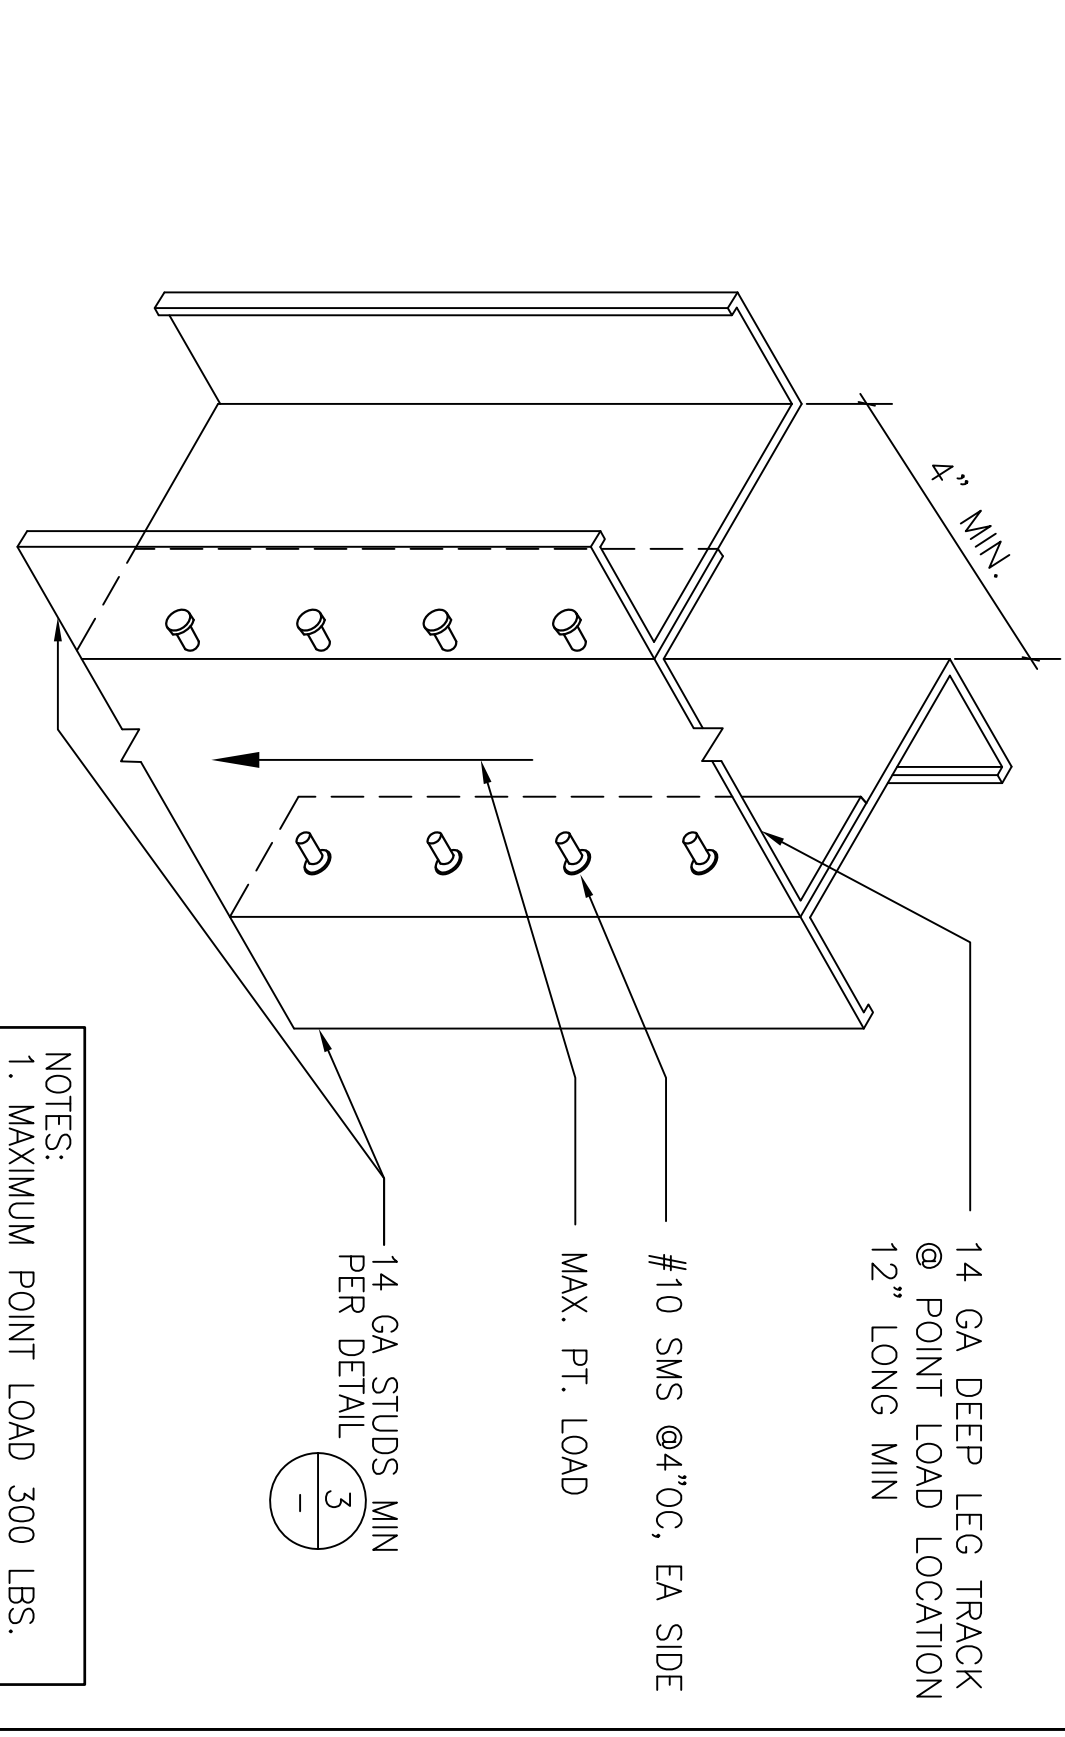

**7** TYPICAL INTERIOR BACKING PLATE CONNECTION (FOR WALL MOUNTED EQUIP.)  
 N.T.S.

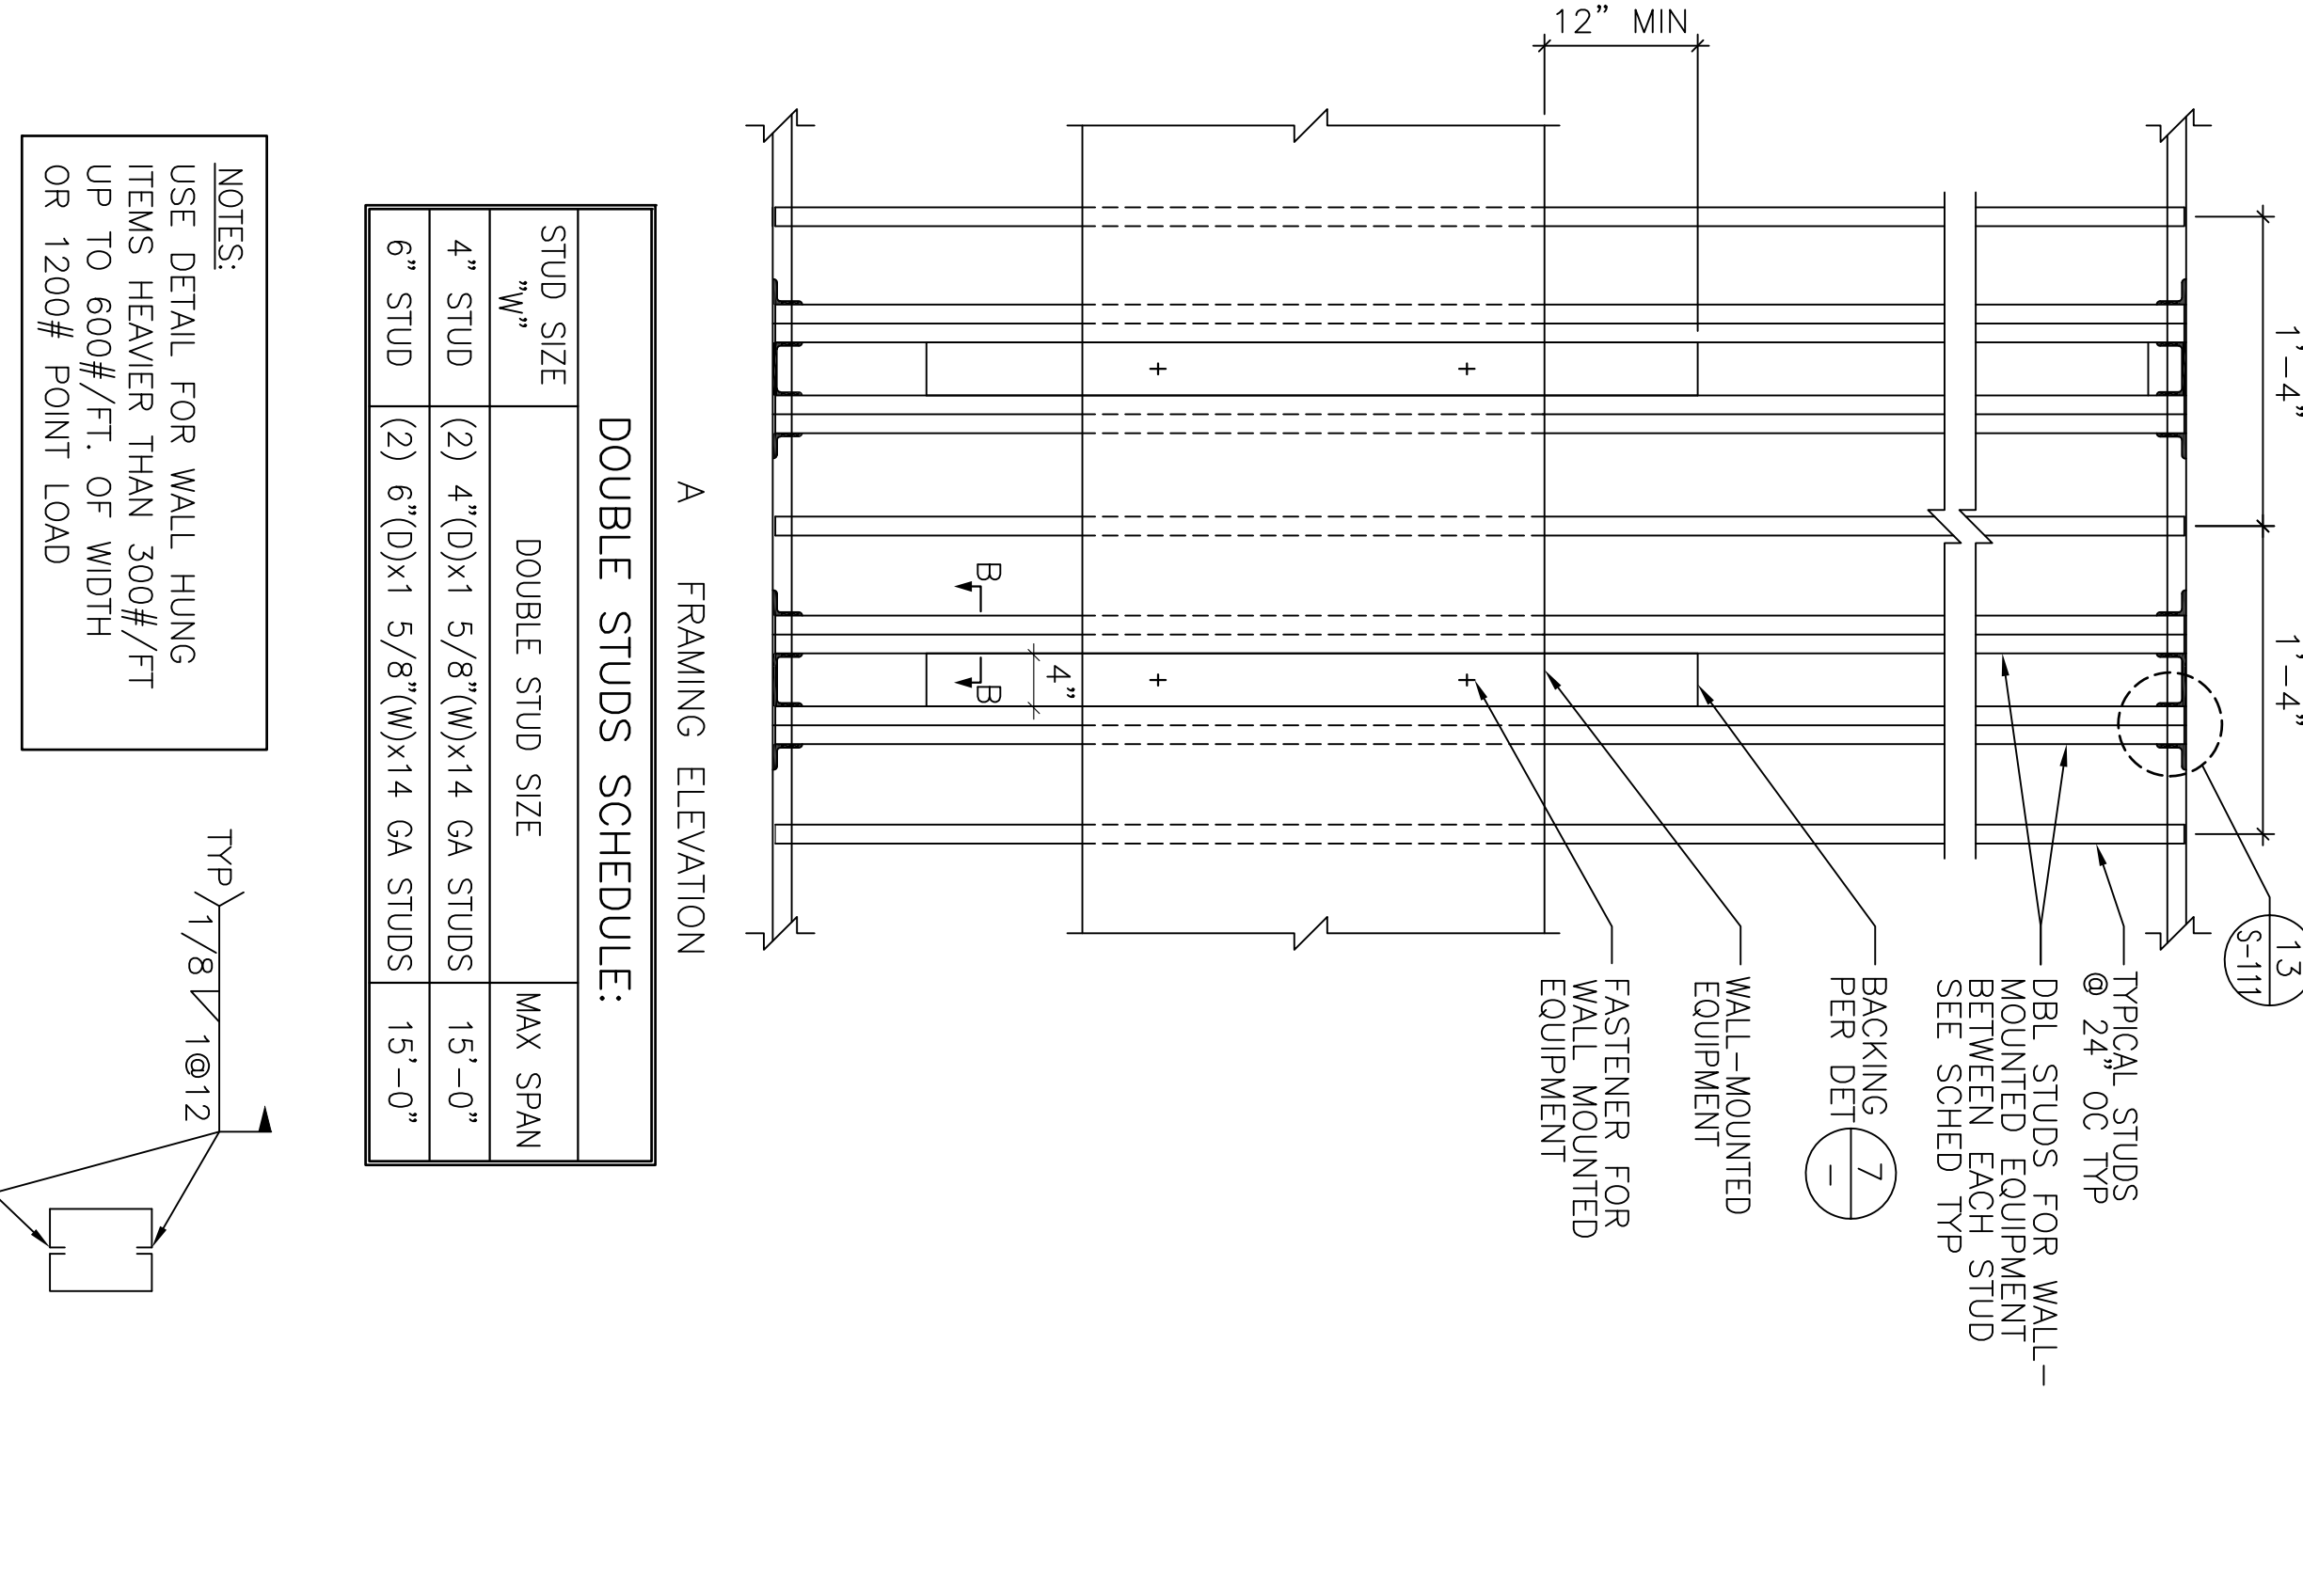


**3** TYPICAL INTERIOR STUD FRAMING @ LARGER WALL EQUIPMENT  
 N.T.S.


DOUBLE STUDS SCHEDULE:

STUD SIZE	DOUBLE STUD SIZE	MAX SPAN
4\"/>		


NOTES:  
 USE DETAIL FOR WALL HUNG ITEMS HEAVIER THAN 300#/FT UP TO 600#/FT. OF WIDTH OR 1200# POINT LOAD

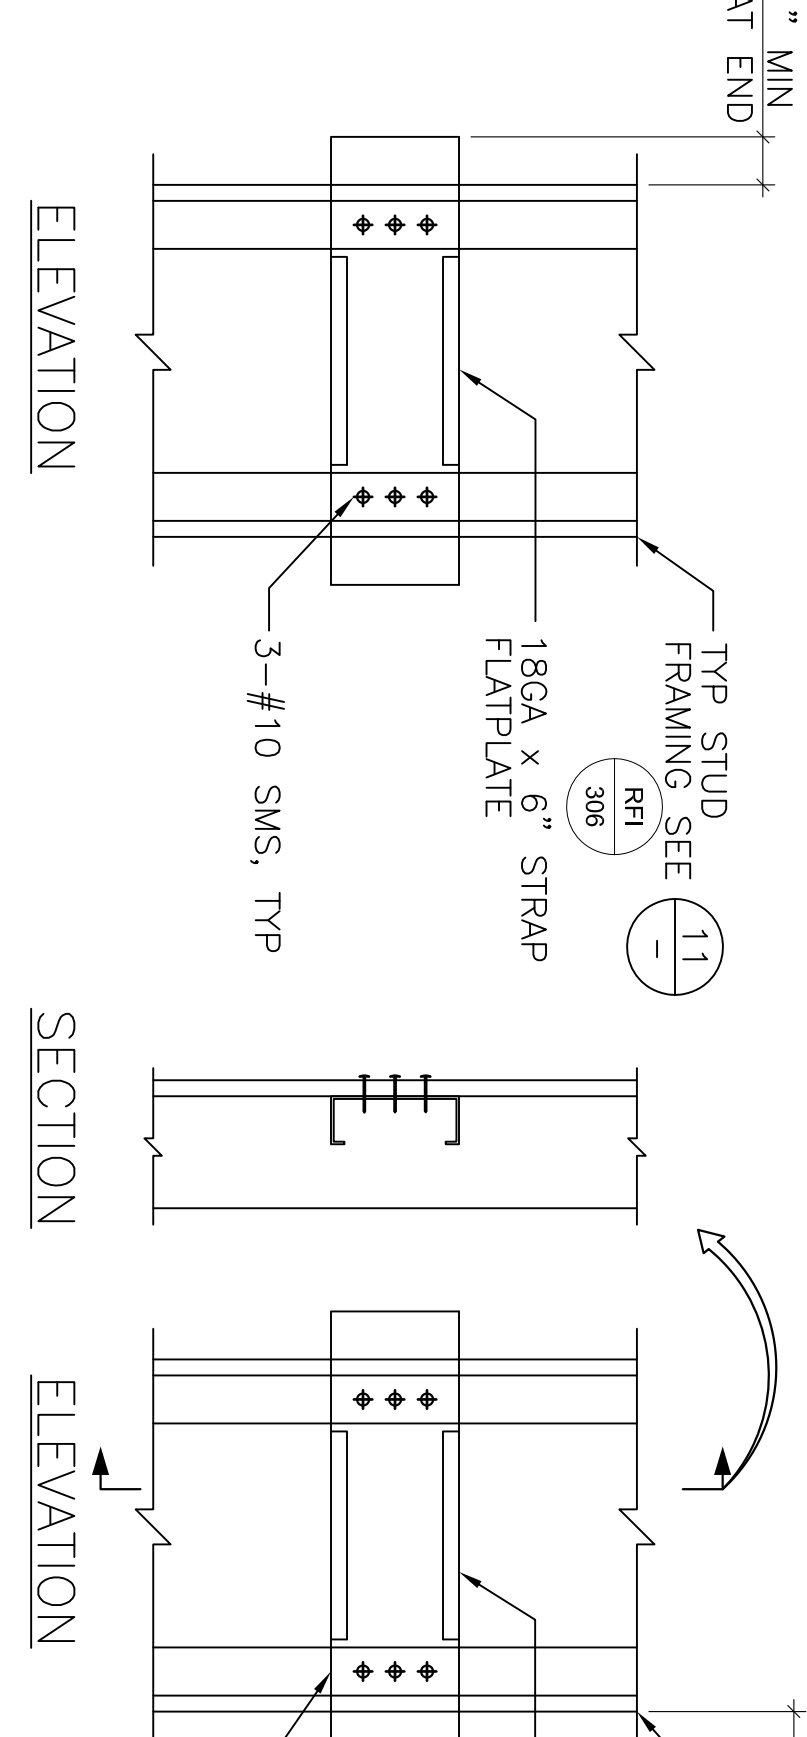


**8** TYPICAL INTERIOR BACKING PLATE CONNECTION DETAIL  
 N.T.S.

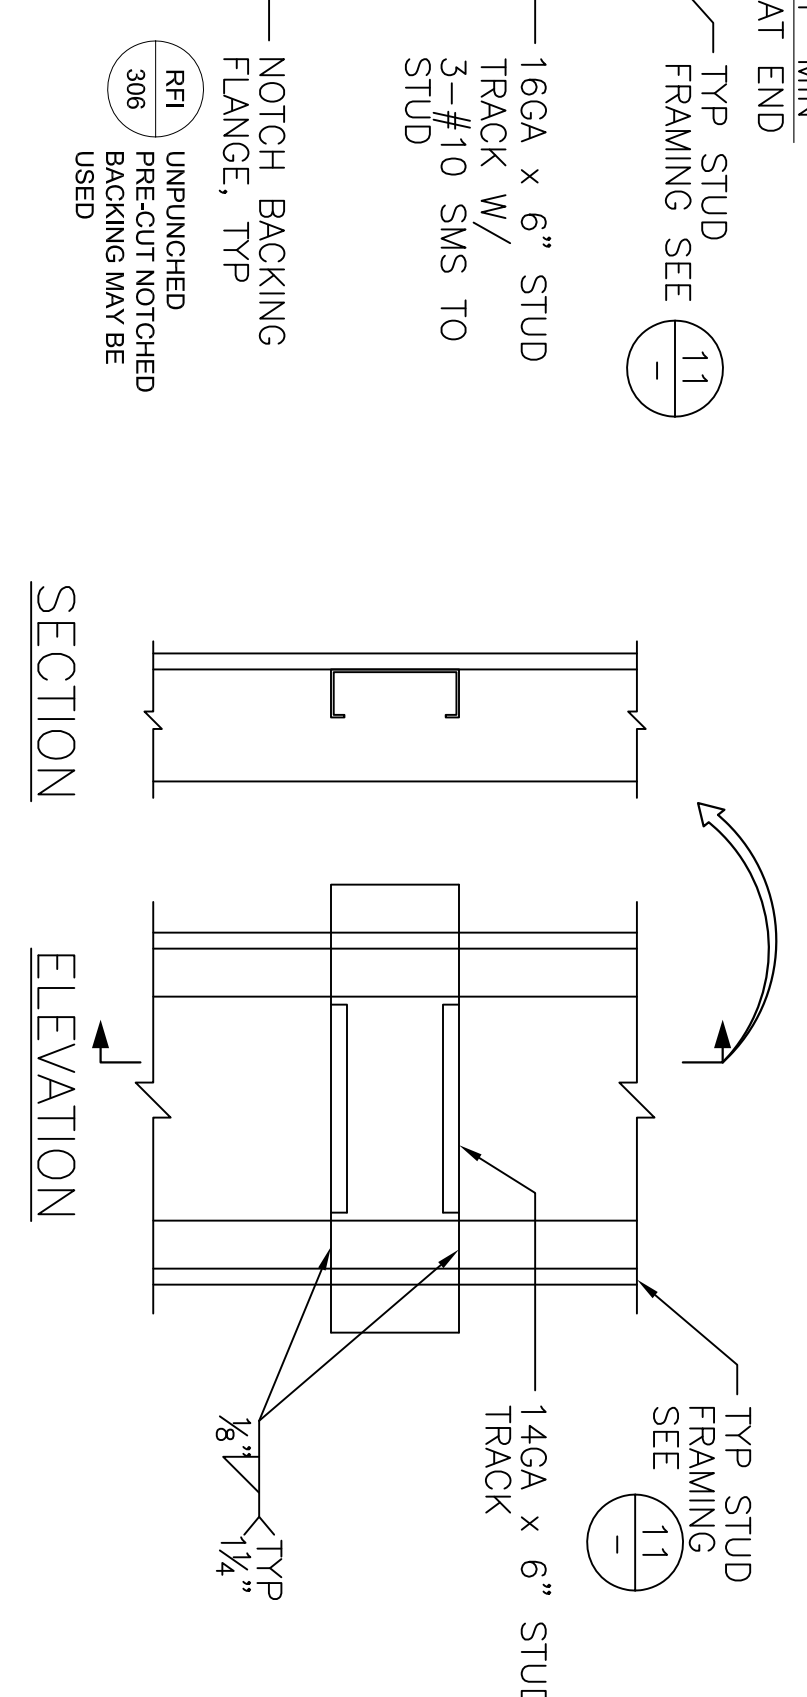

**3** TYPICAL INTERIOR STUD FRAMING @ LARGER WALL EQUIPMENT  
 N.T.S.

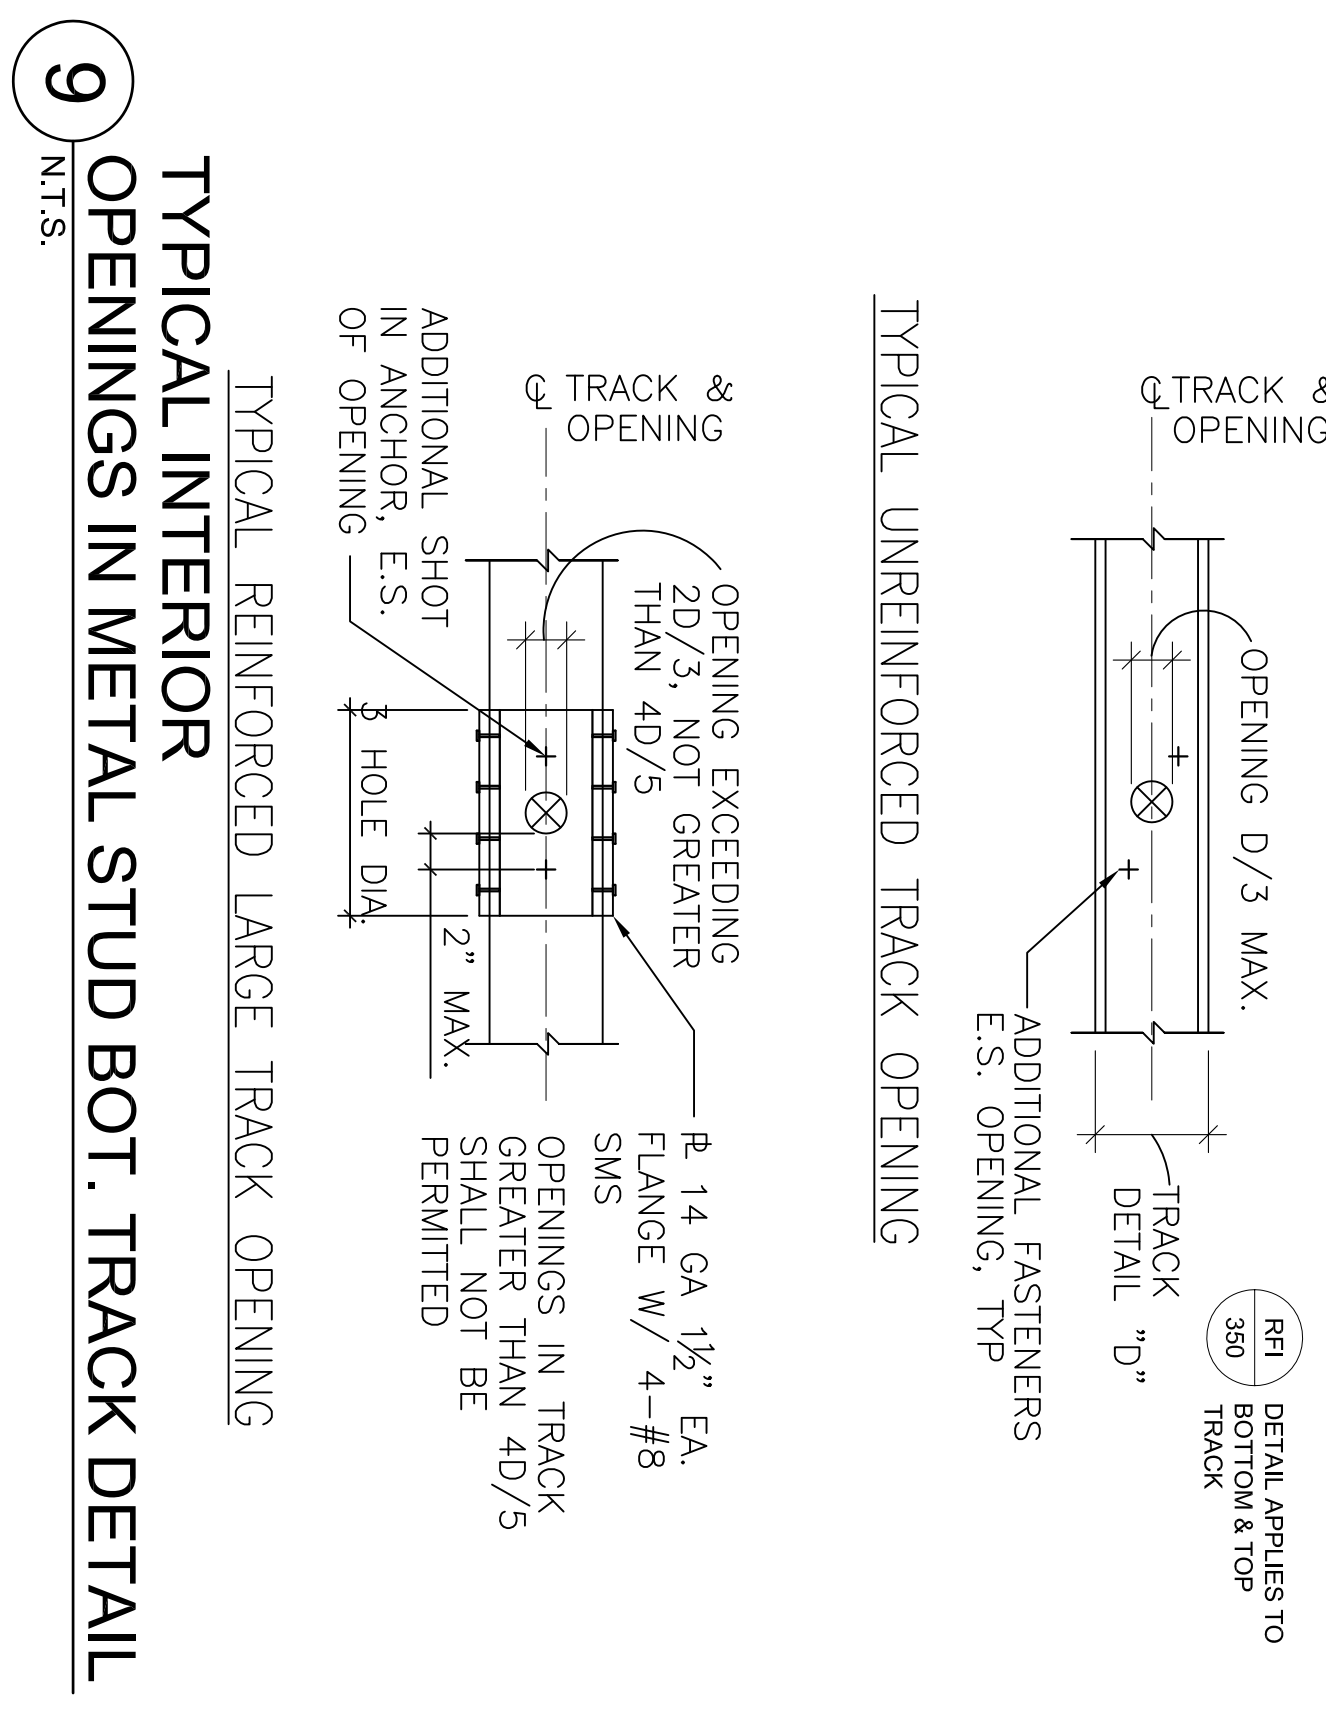

**9** TYPICAL INTERIOR OPENINGS IN METAL STUD BOT. TRACK DETAIL  
 N.T.S.

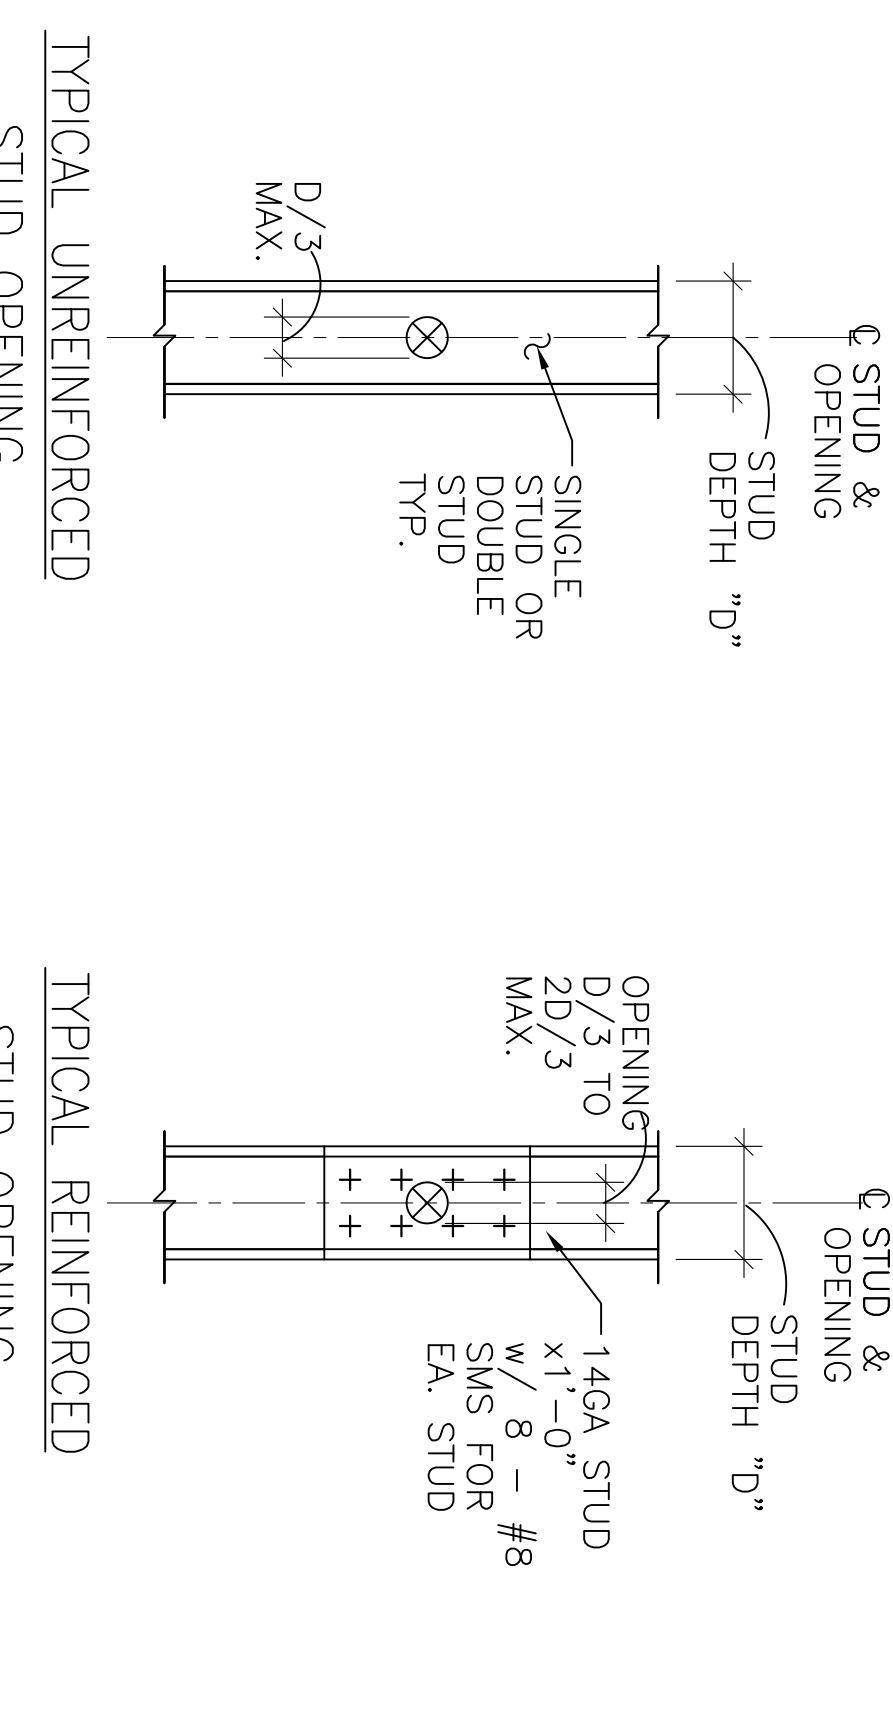


**10** TYPICAL INTERIOR OPENINGS IN METAL WALL STUDS DETAIL  
 N.T.S.


TYPICAL BACKING STUD SCHEDULE

BACKING TYPE	STUD DEPTH (IN)	STUD GAGE	MAX STUD SPACING (IN)
TYPE 1	4\"/>		


**11** TYPICAL INTERIOR BACKING PLATE CONNECTION SCHEDULE  
 N.T.S.

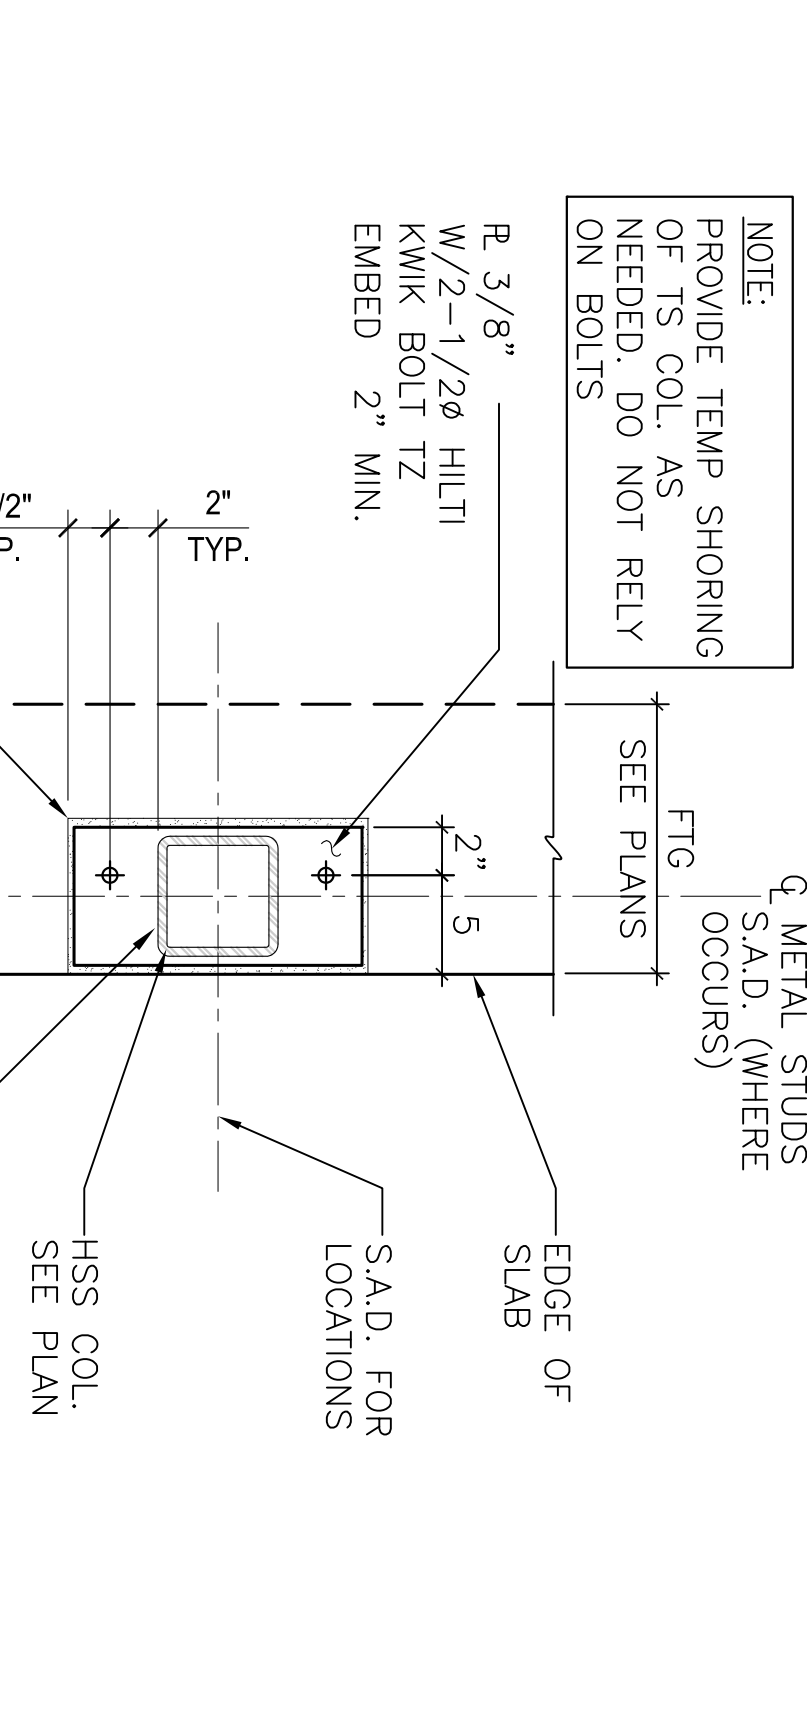


**12** TYPICAL INTERIOR TS POST @ STUD WALL TO CONC. CONN. DETAIL  
 N.T.S.

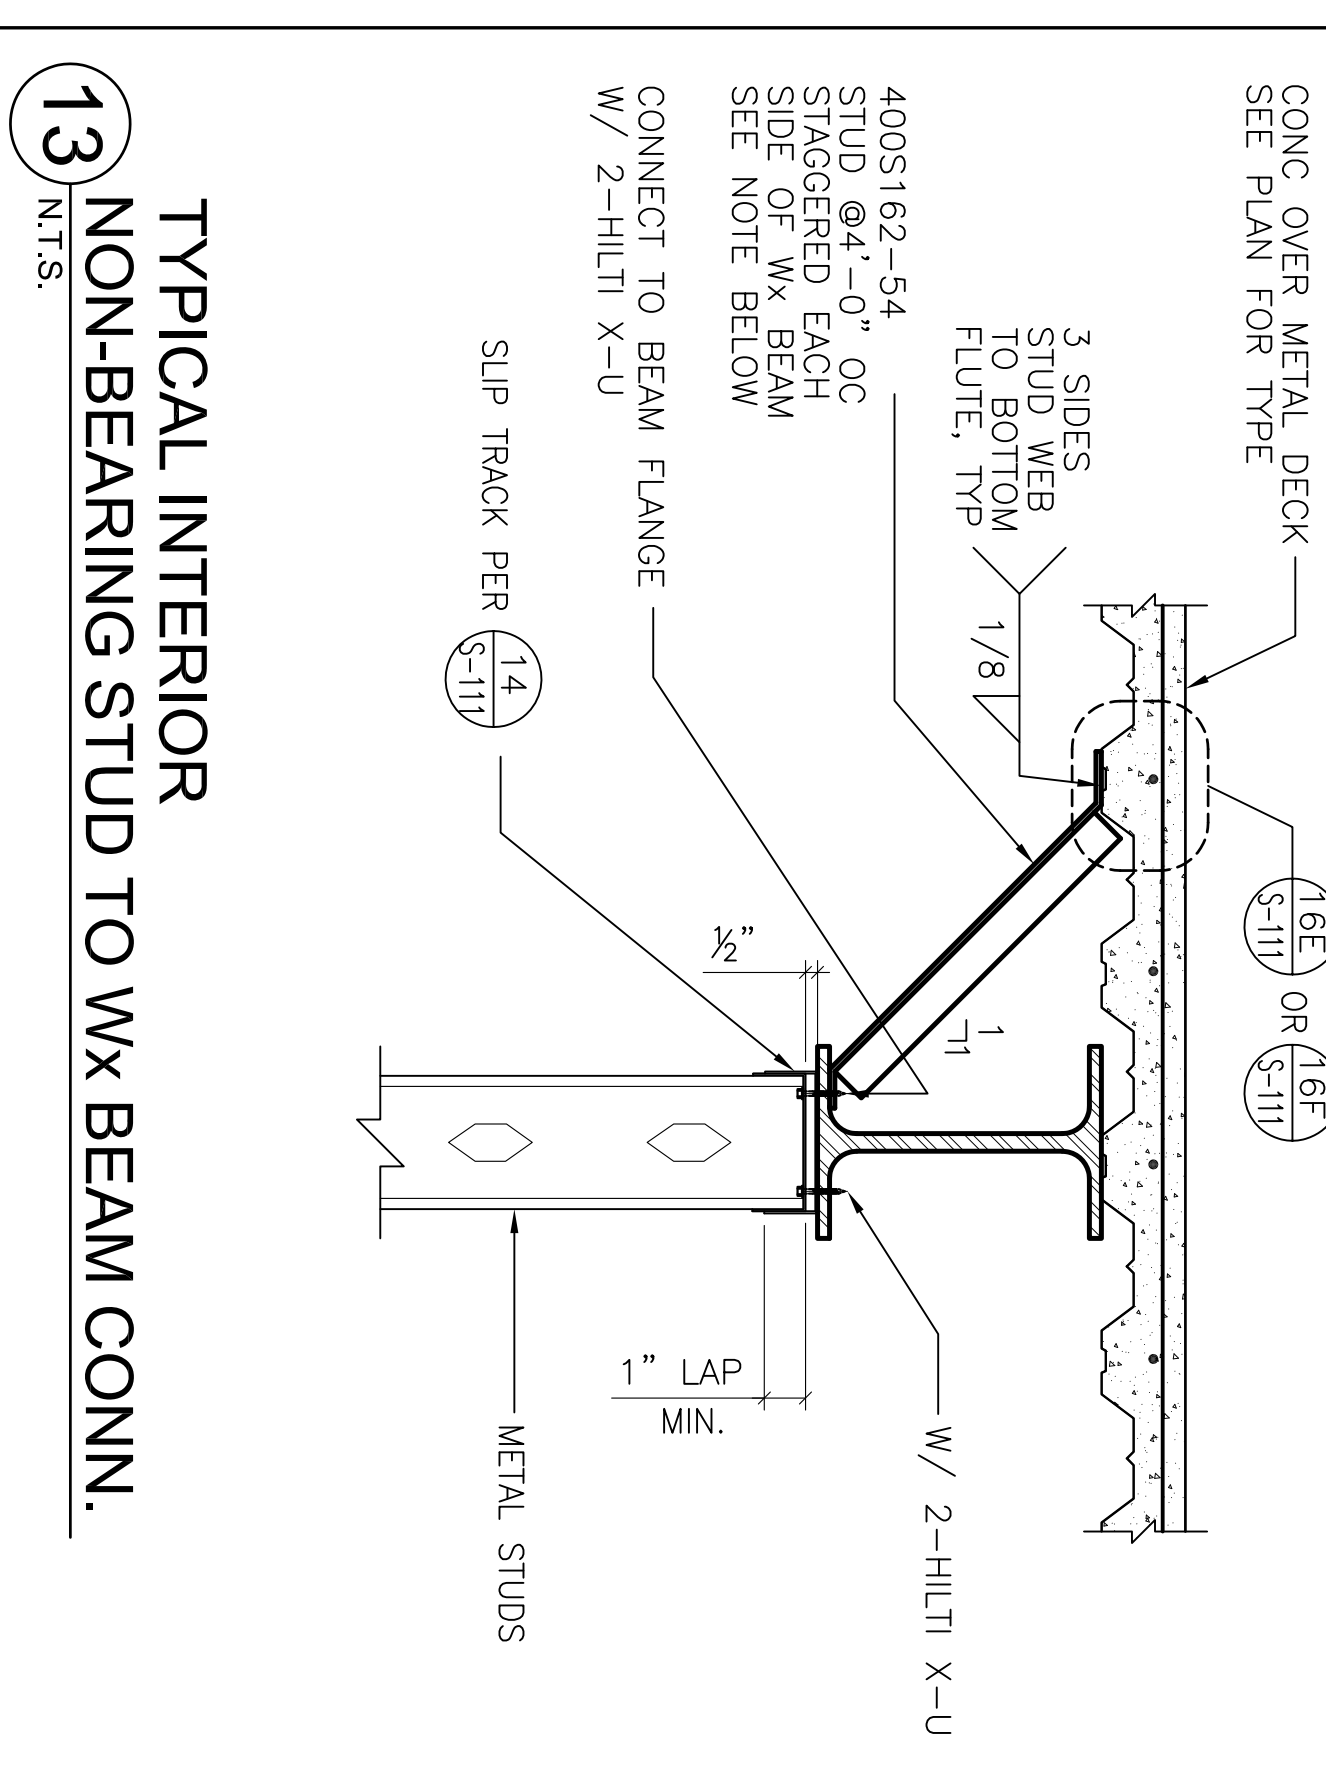


**13** TYPICAL INTERIOR NON-BEARING STUD TO Wx BEAM CONN.  
 N.T.S.

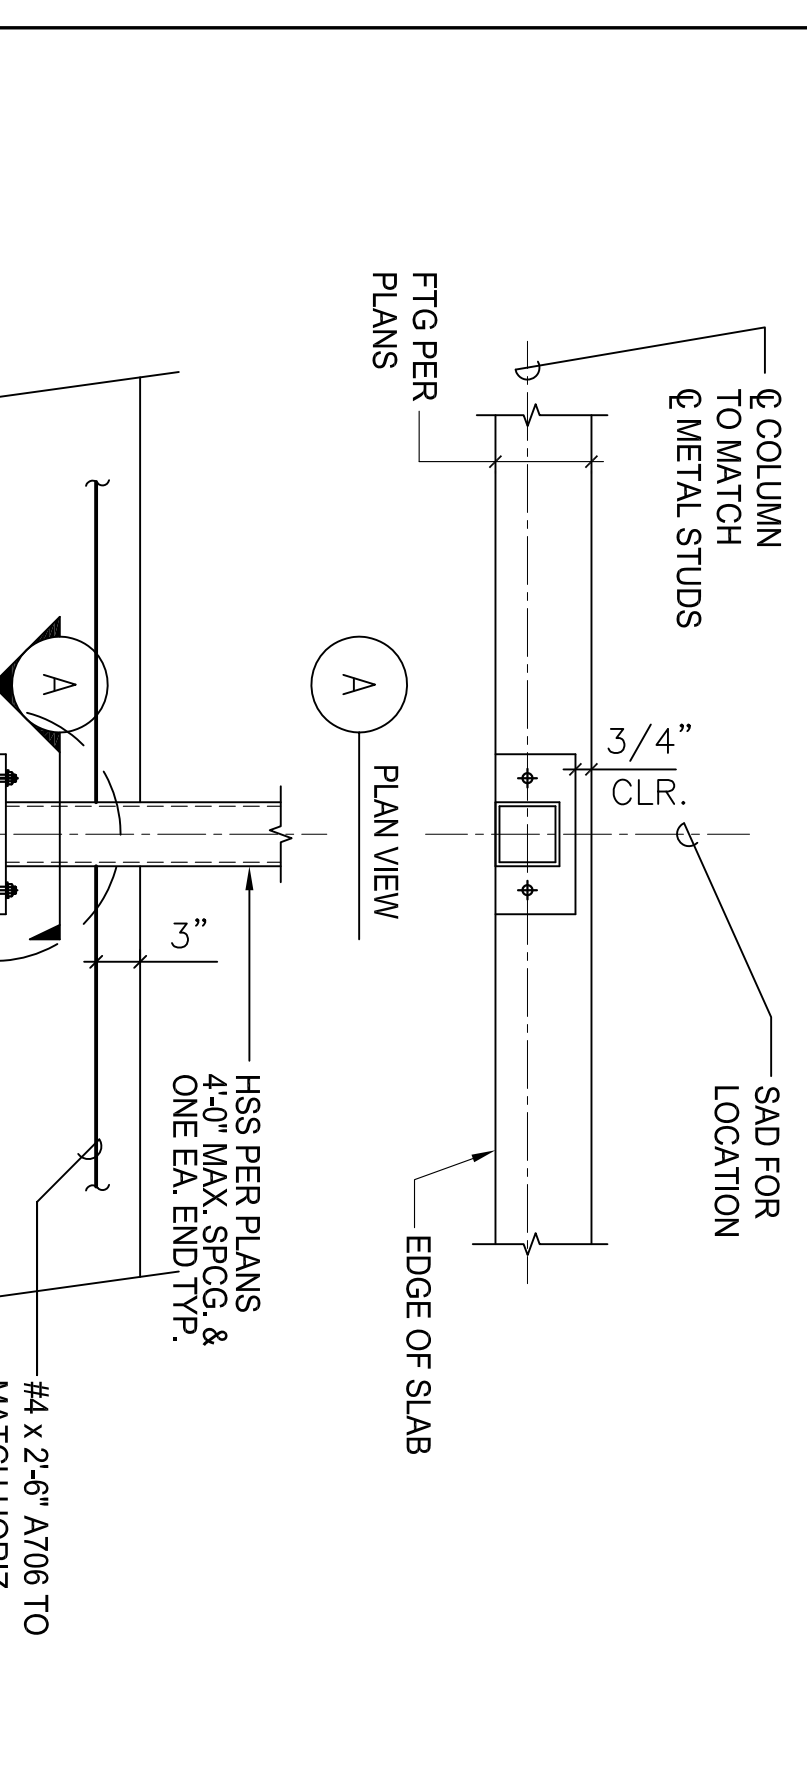


**16** TYPICAL INTERIOR TS POST @ STUD WALL SECTION  
 N.T.S.

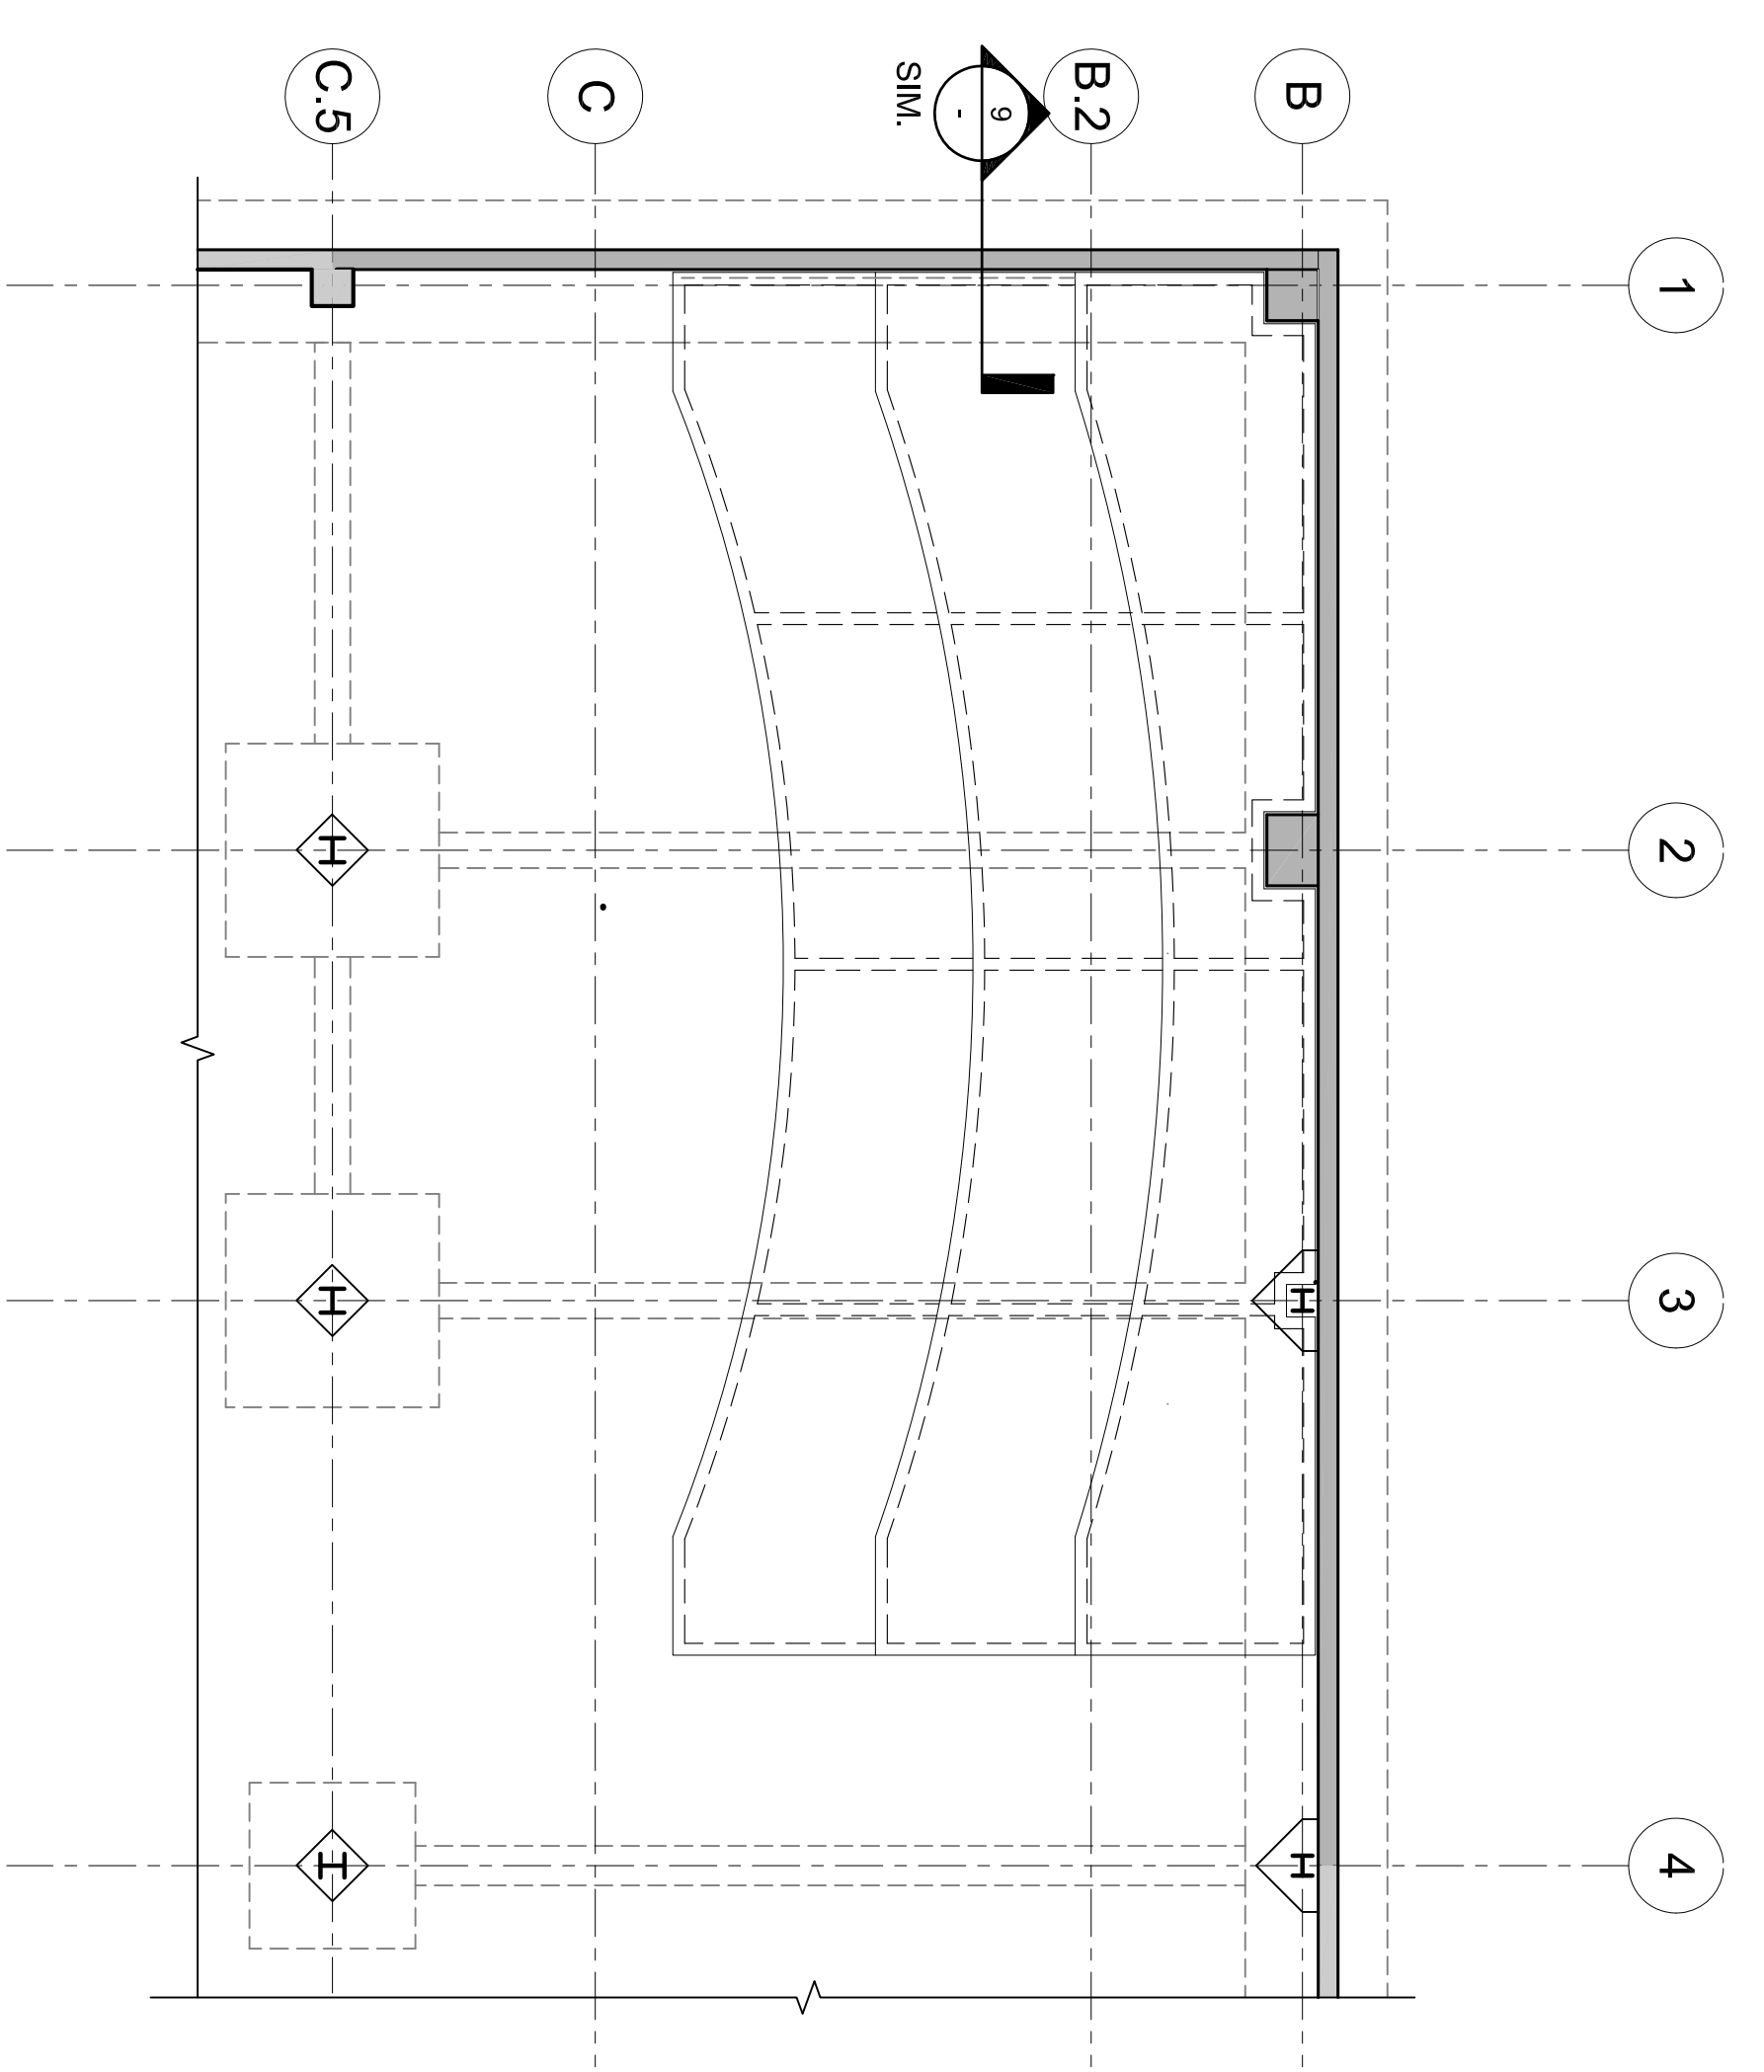

**7 ENLARGED PLAN @ CLASSROOMS**  
 SCALE: 1/8" = 1'-0"

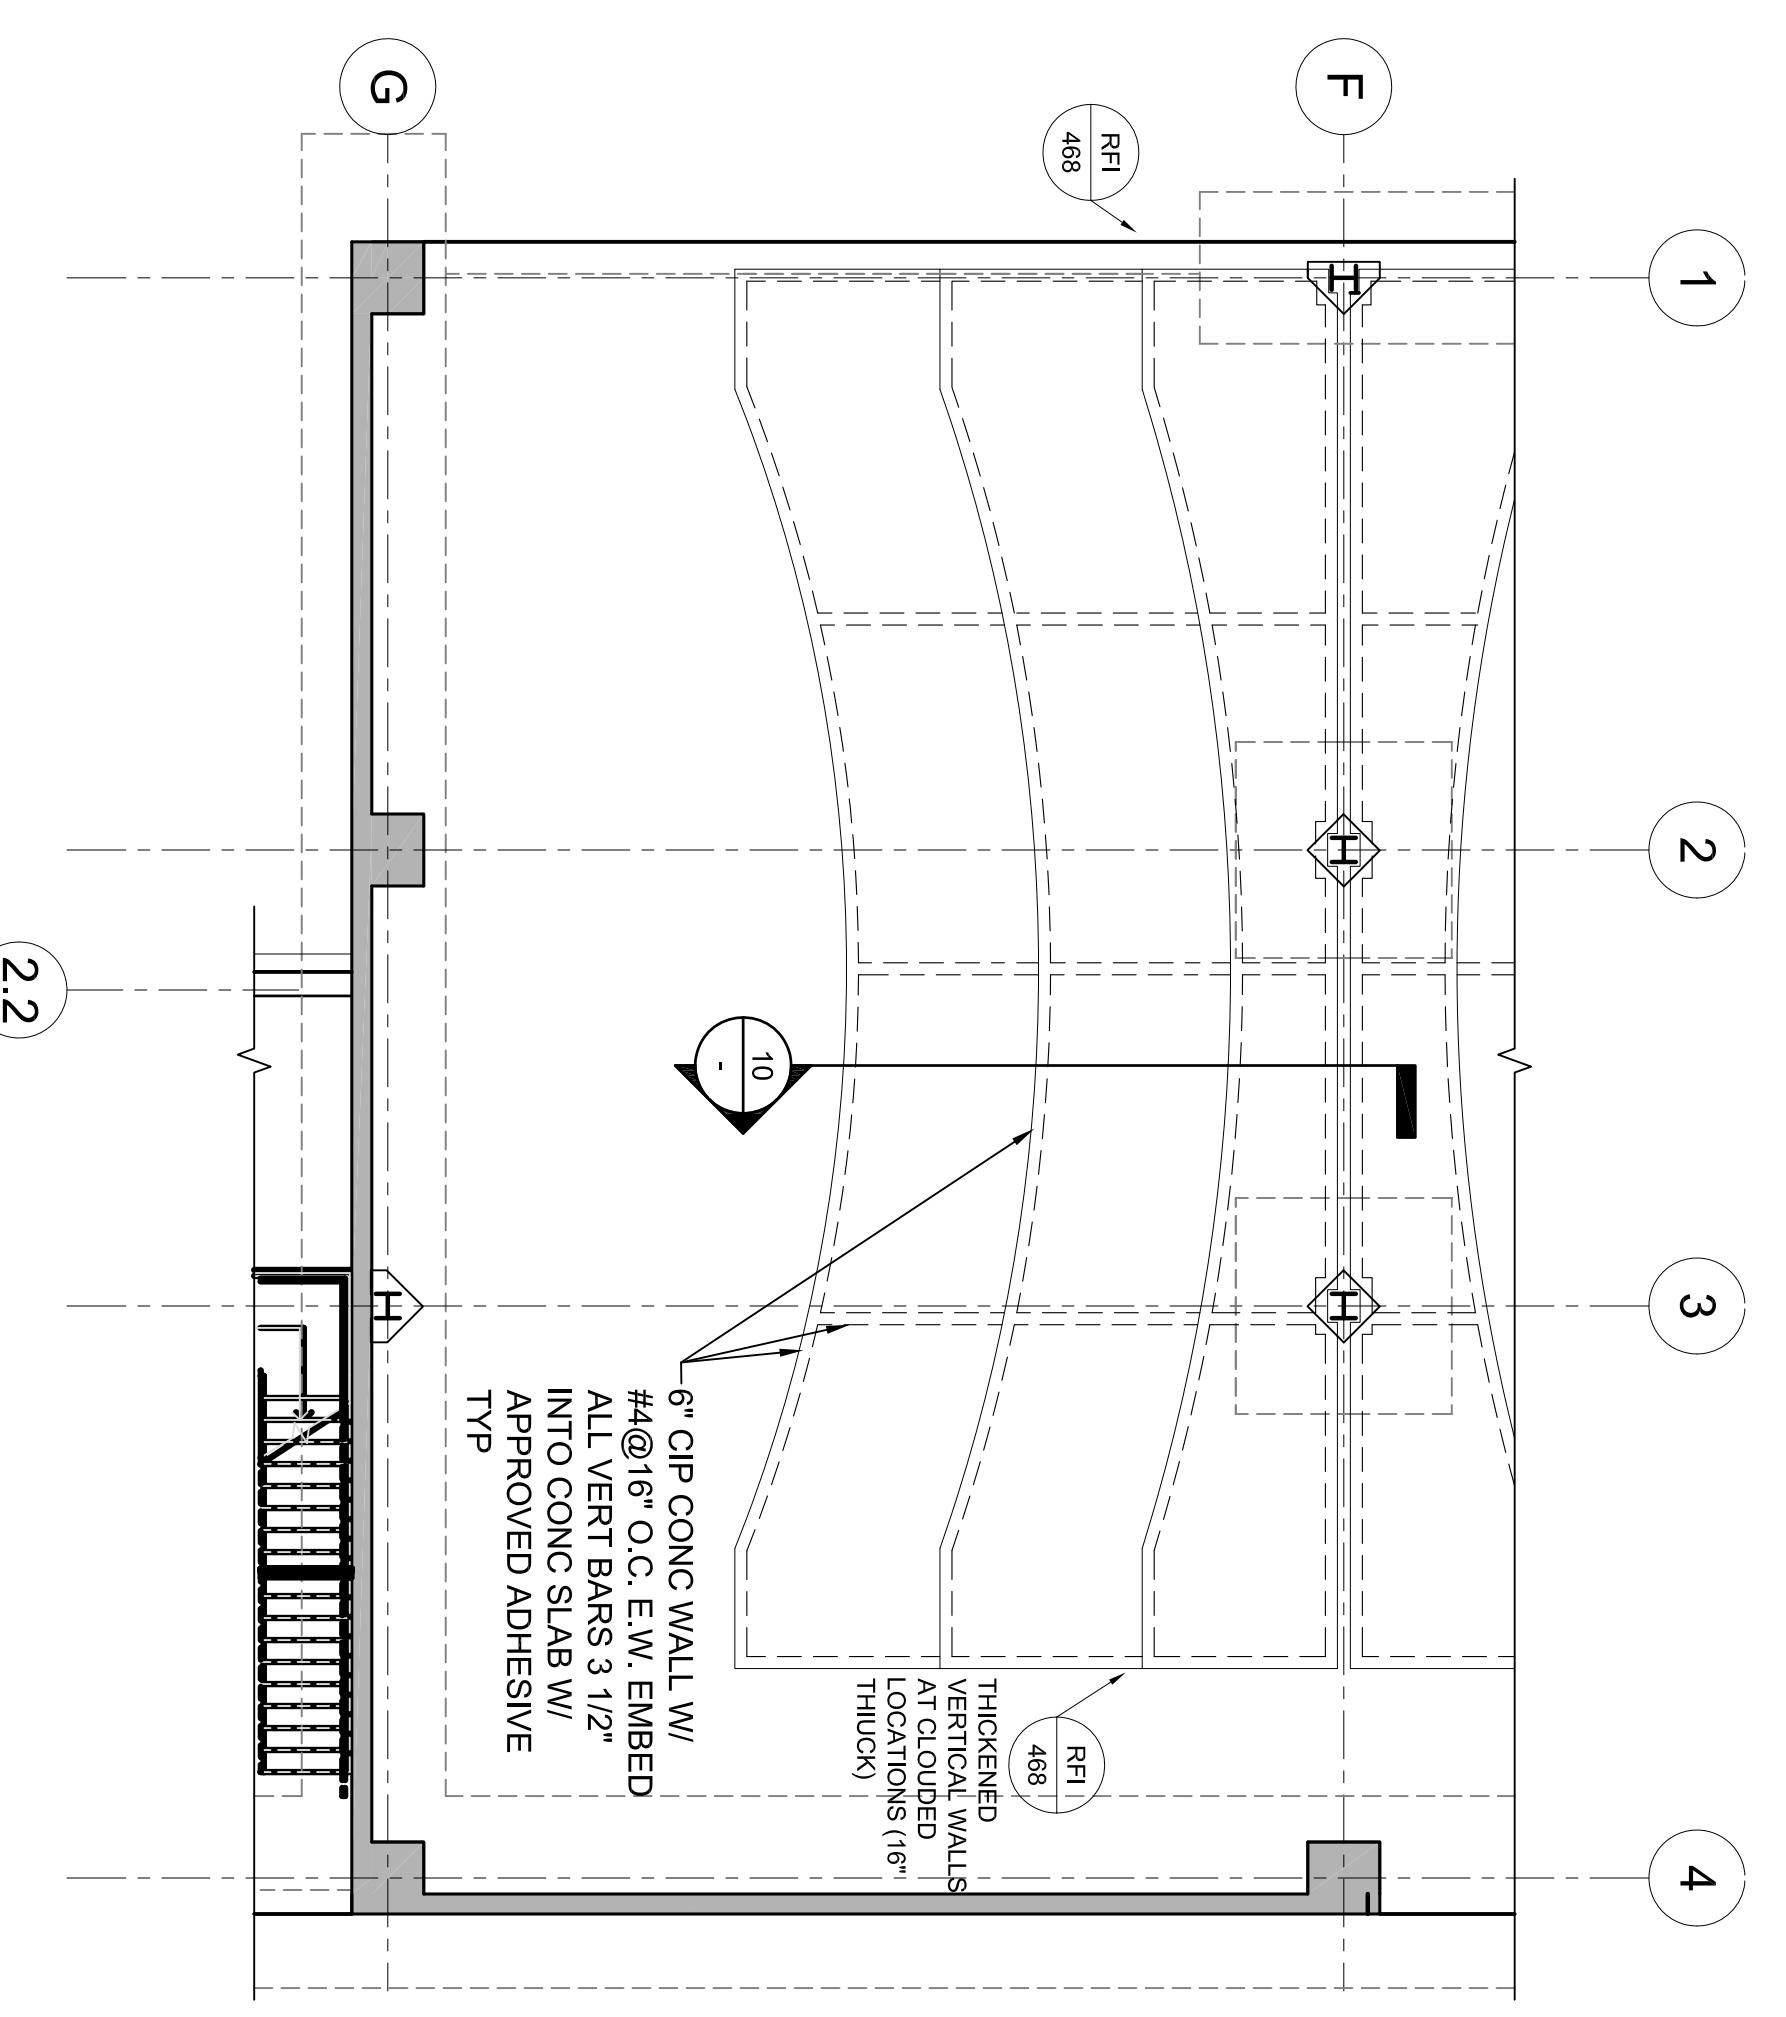


**17 ENLARGED PLAN @ CLASSROOMS**  
 SCALE: 1/8" = 1'-0"

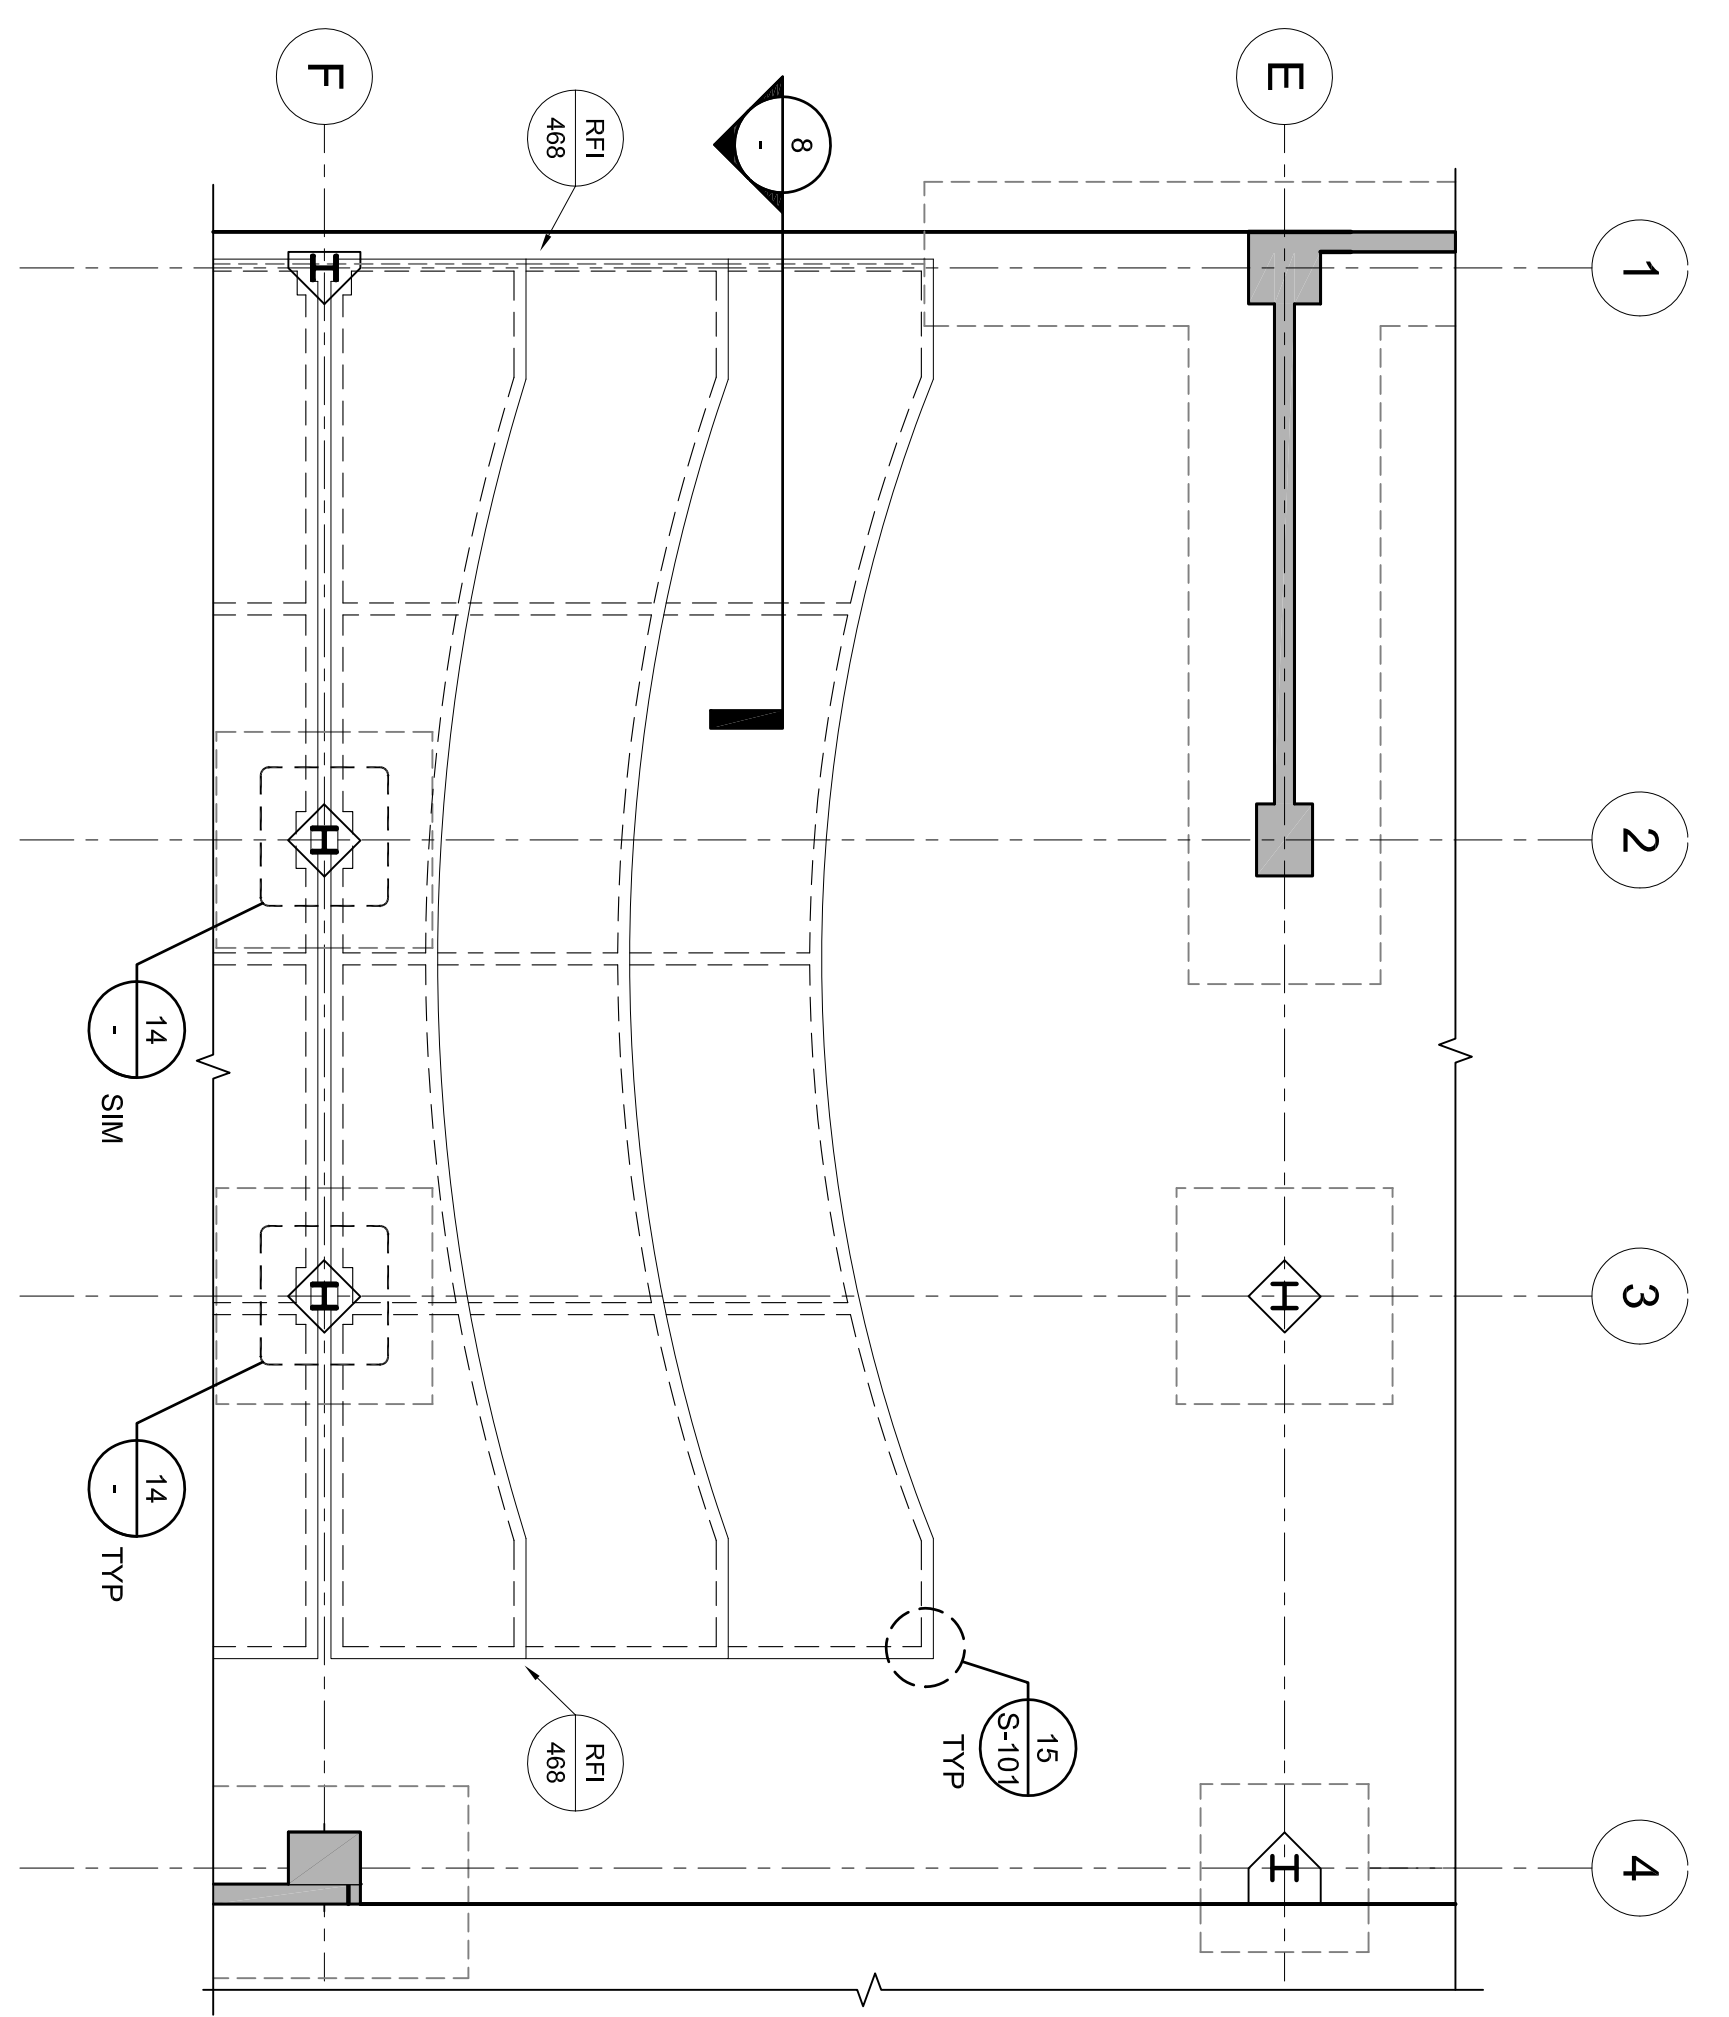


**22 ENLARGED PLAN @ CLASSROOMS**  
 SCALE: 1/8" = 1'-0"

#4 DOWELS @ 16" O.C. EMBED 3 1/2" WITH APPROVED ADHESIVE

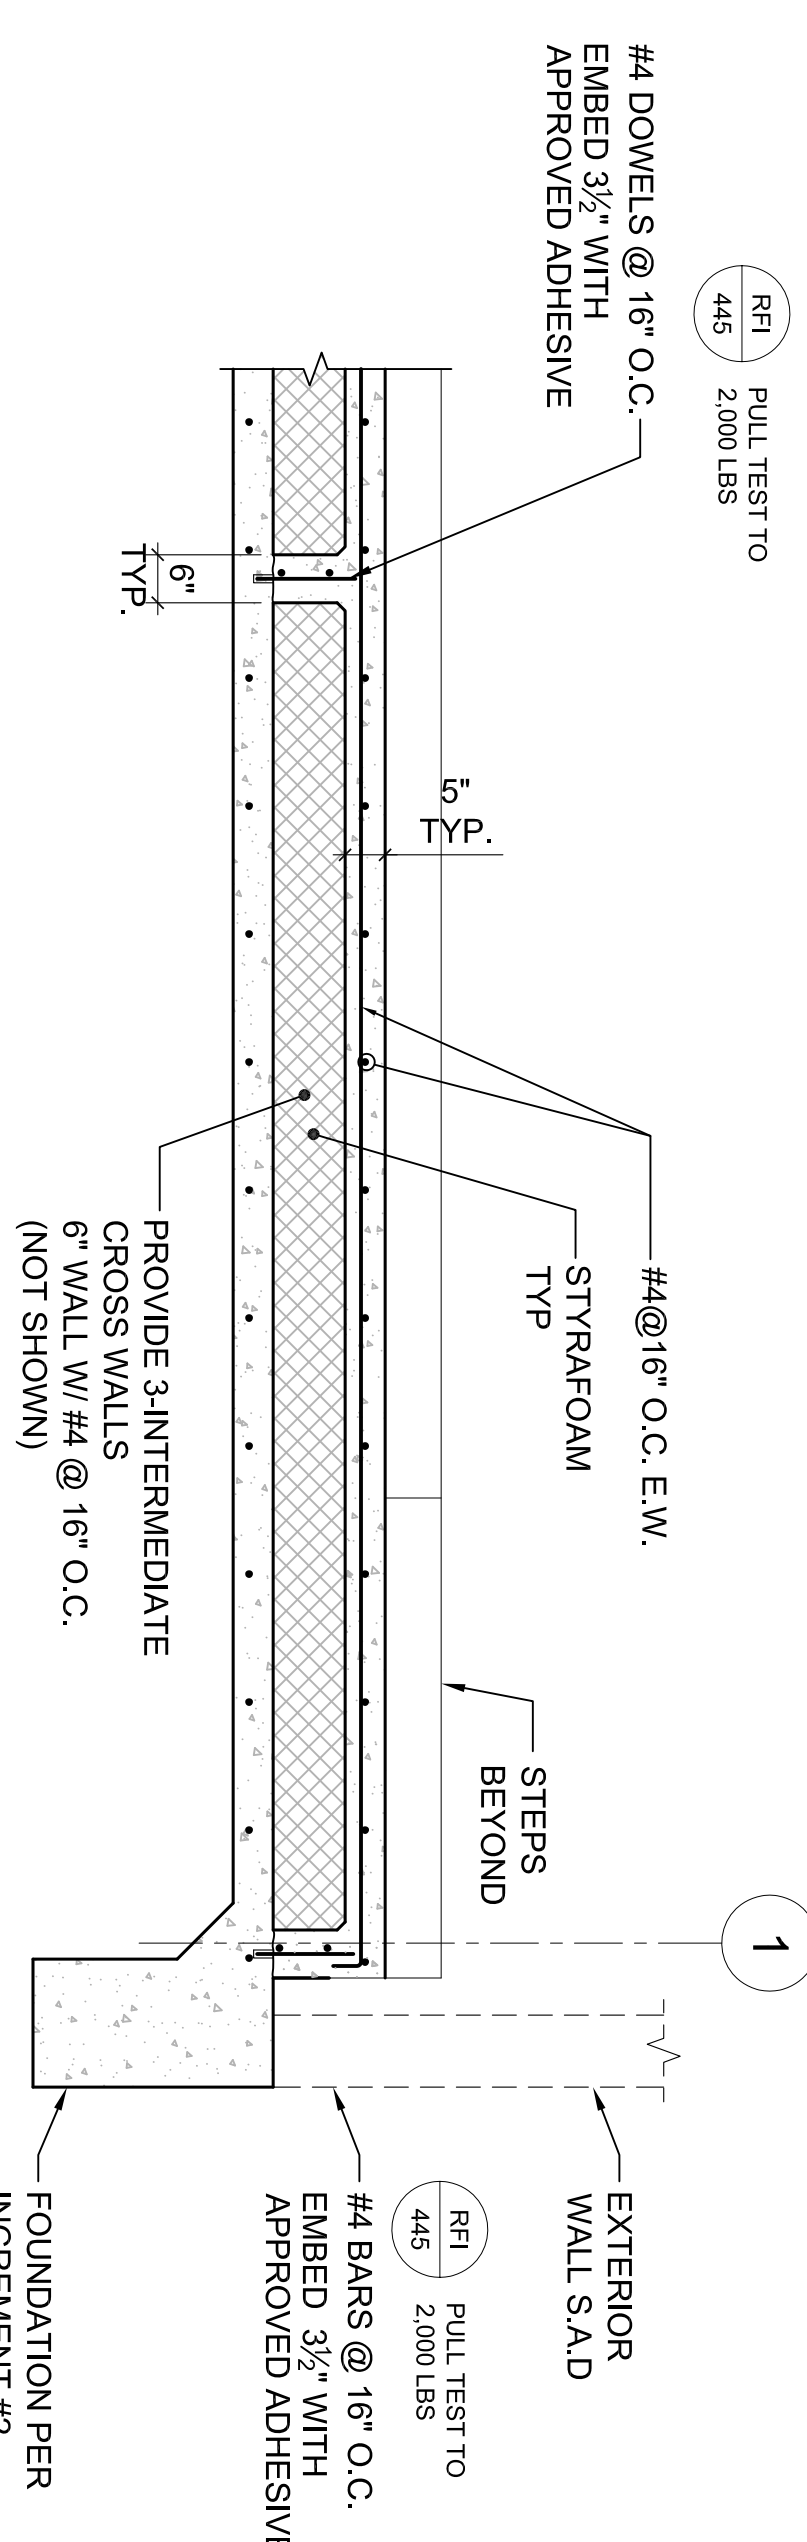


**8 SECTION**  
 SCALE: 1/4" = 1'-0"

6" CIP CONG WALL W/ #4 @ 16" O.C. E.V. EDGE OF SLAB 2" CLR TO COLUMN

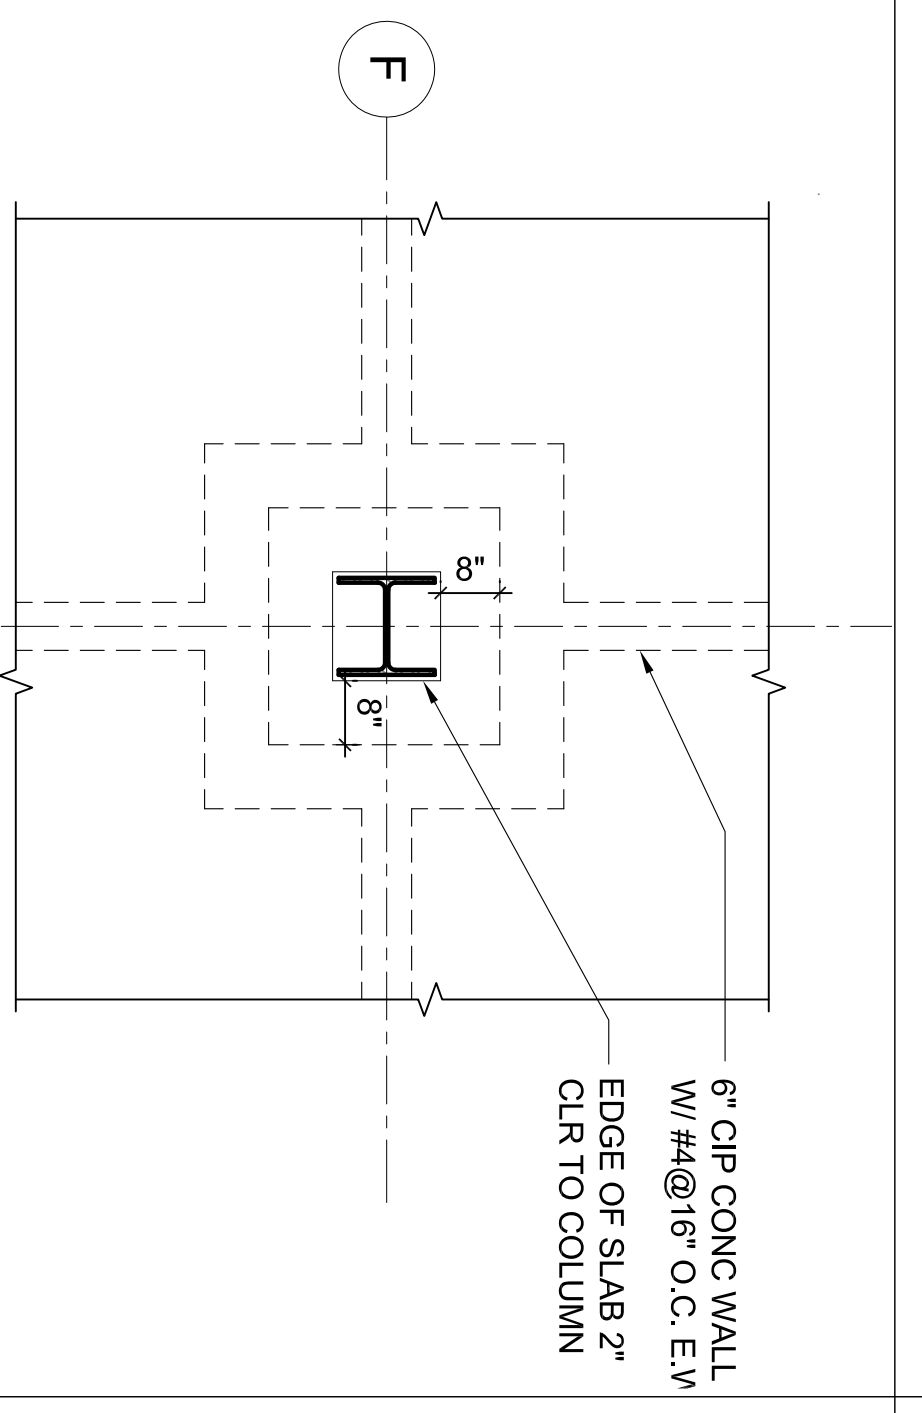


**14 ENLARGED PLAN**  
 SCALE: 1/2" = 1'-0"

#4 DOWELS @ 16" O.C. EMBED 3 1/2" WITH APPROVED ADHESIVE

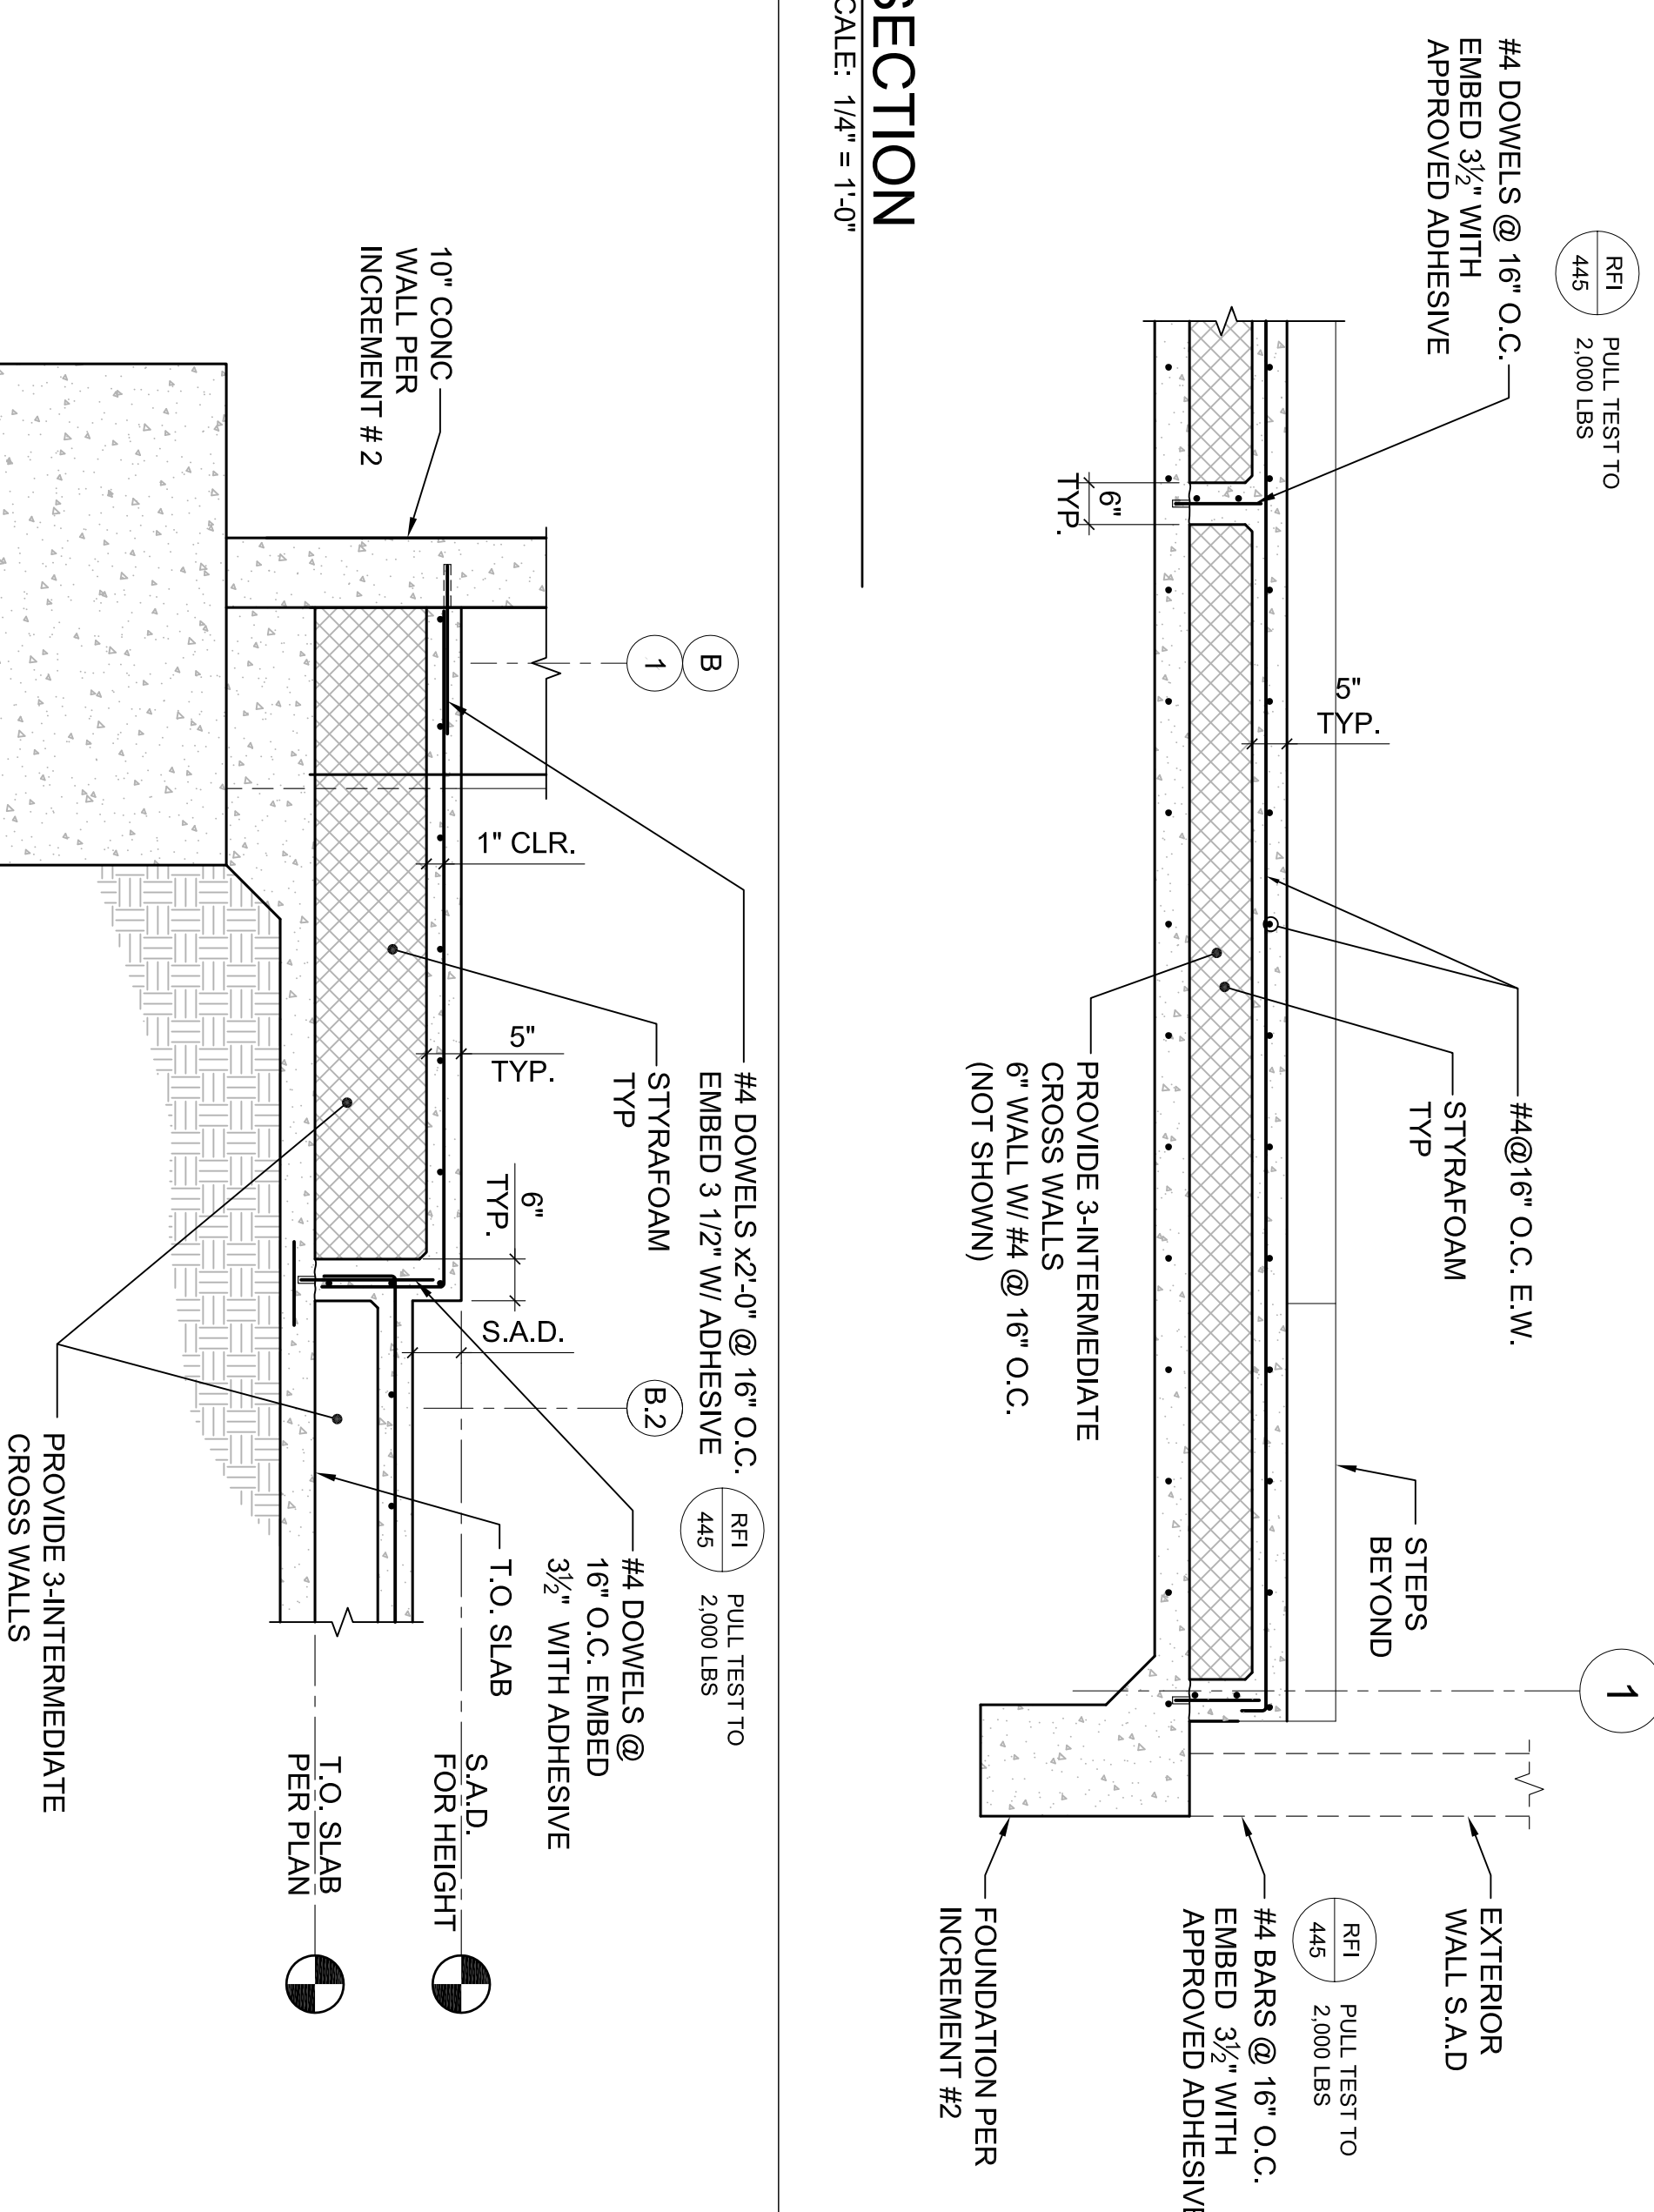


**9 SECTION**  
 SCALE: 3/4" = 1'-0"

4-3/8" Ø HILL TI KWIK-BOLT TZ EMBED 2" MIN. CONG. SLAB W/ #4 @ 16" O.C. E.W.

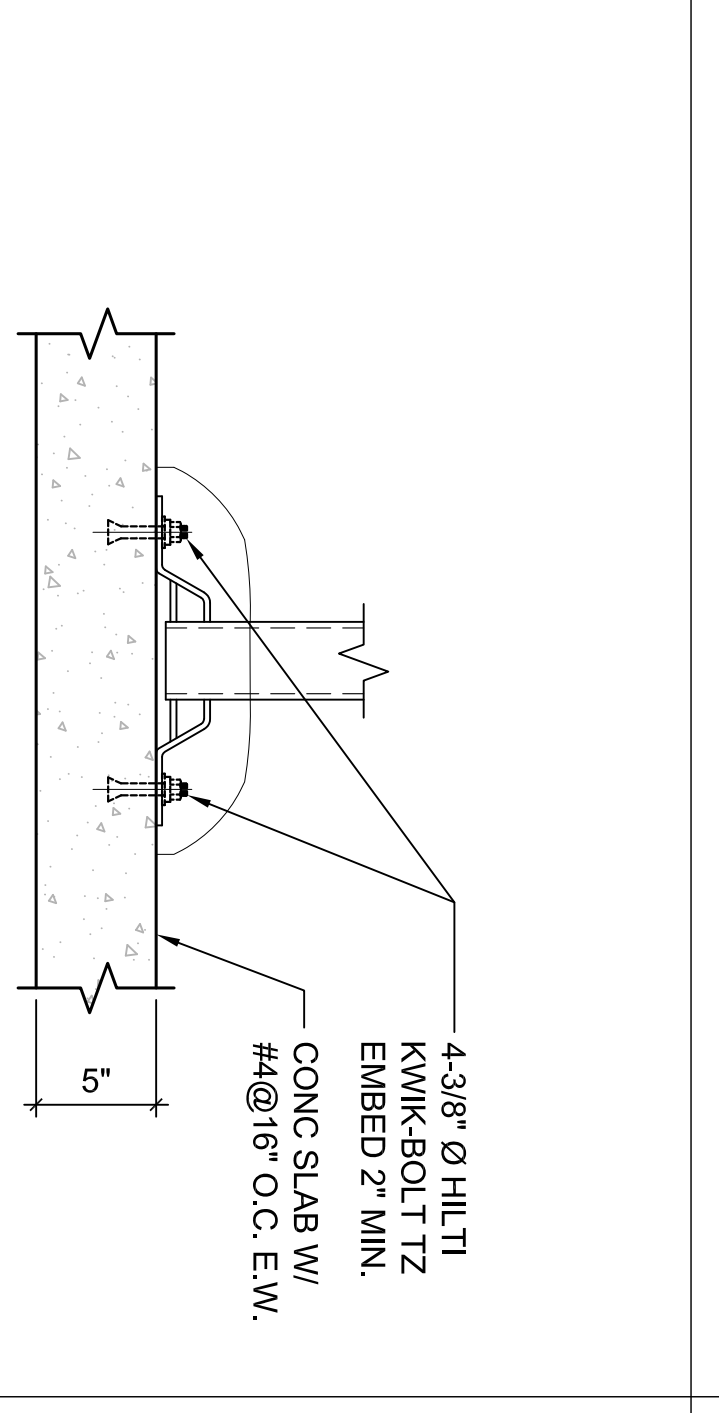

**15 DESK CONNECTION DETAIL**  
 SCALE: 1 1/2" = 1'-0"

#4 DOWELS @ 16" O.C. EMBED 3 1/2" WITH APPROVED ADHESIVE

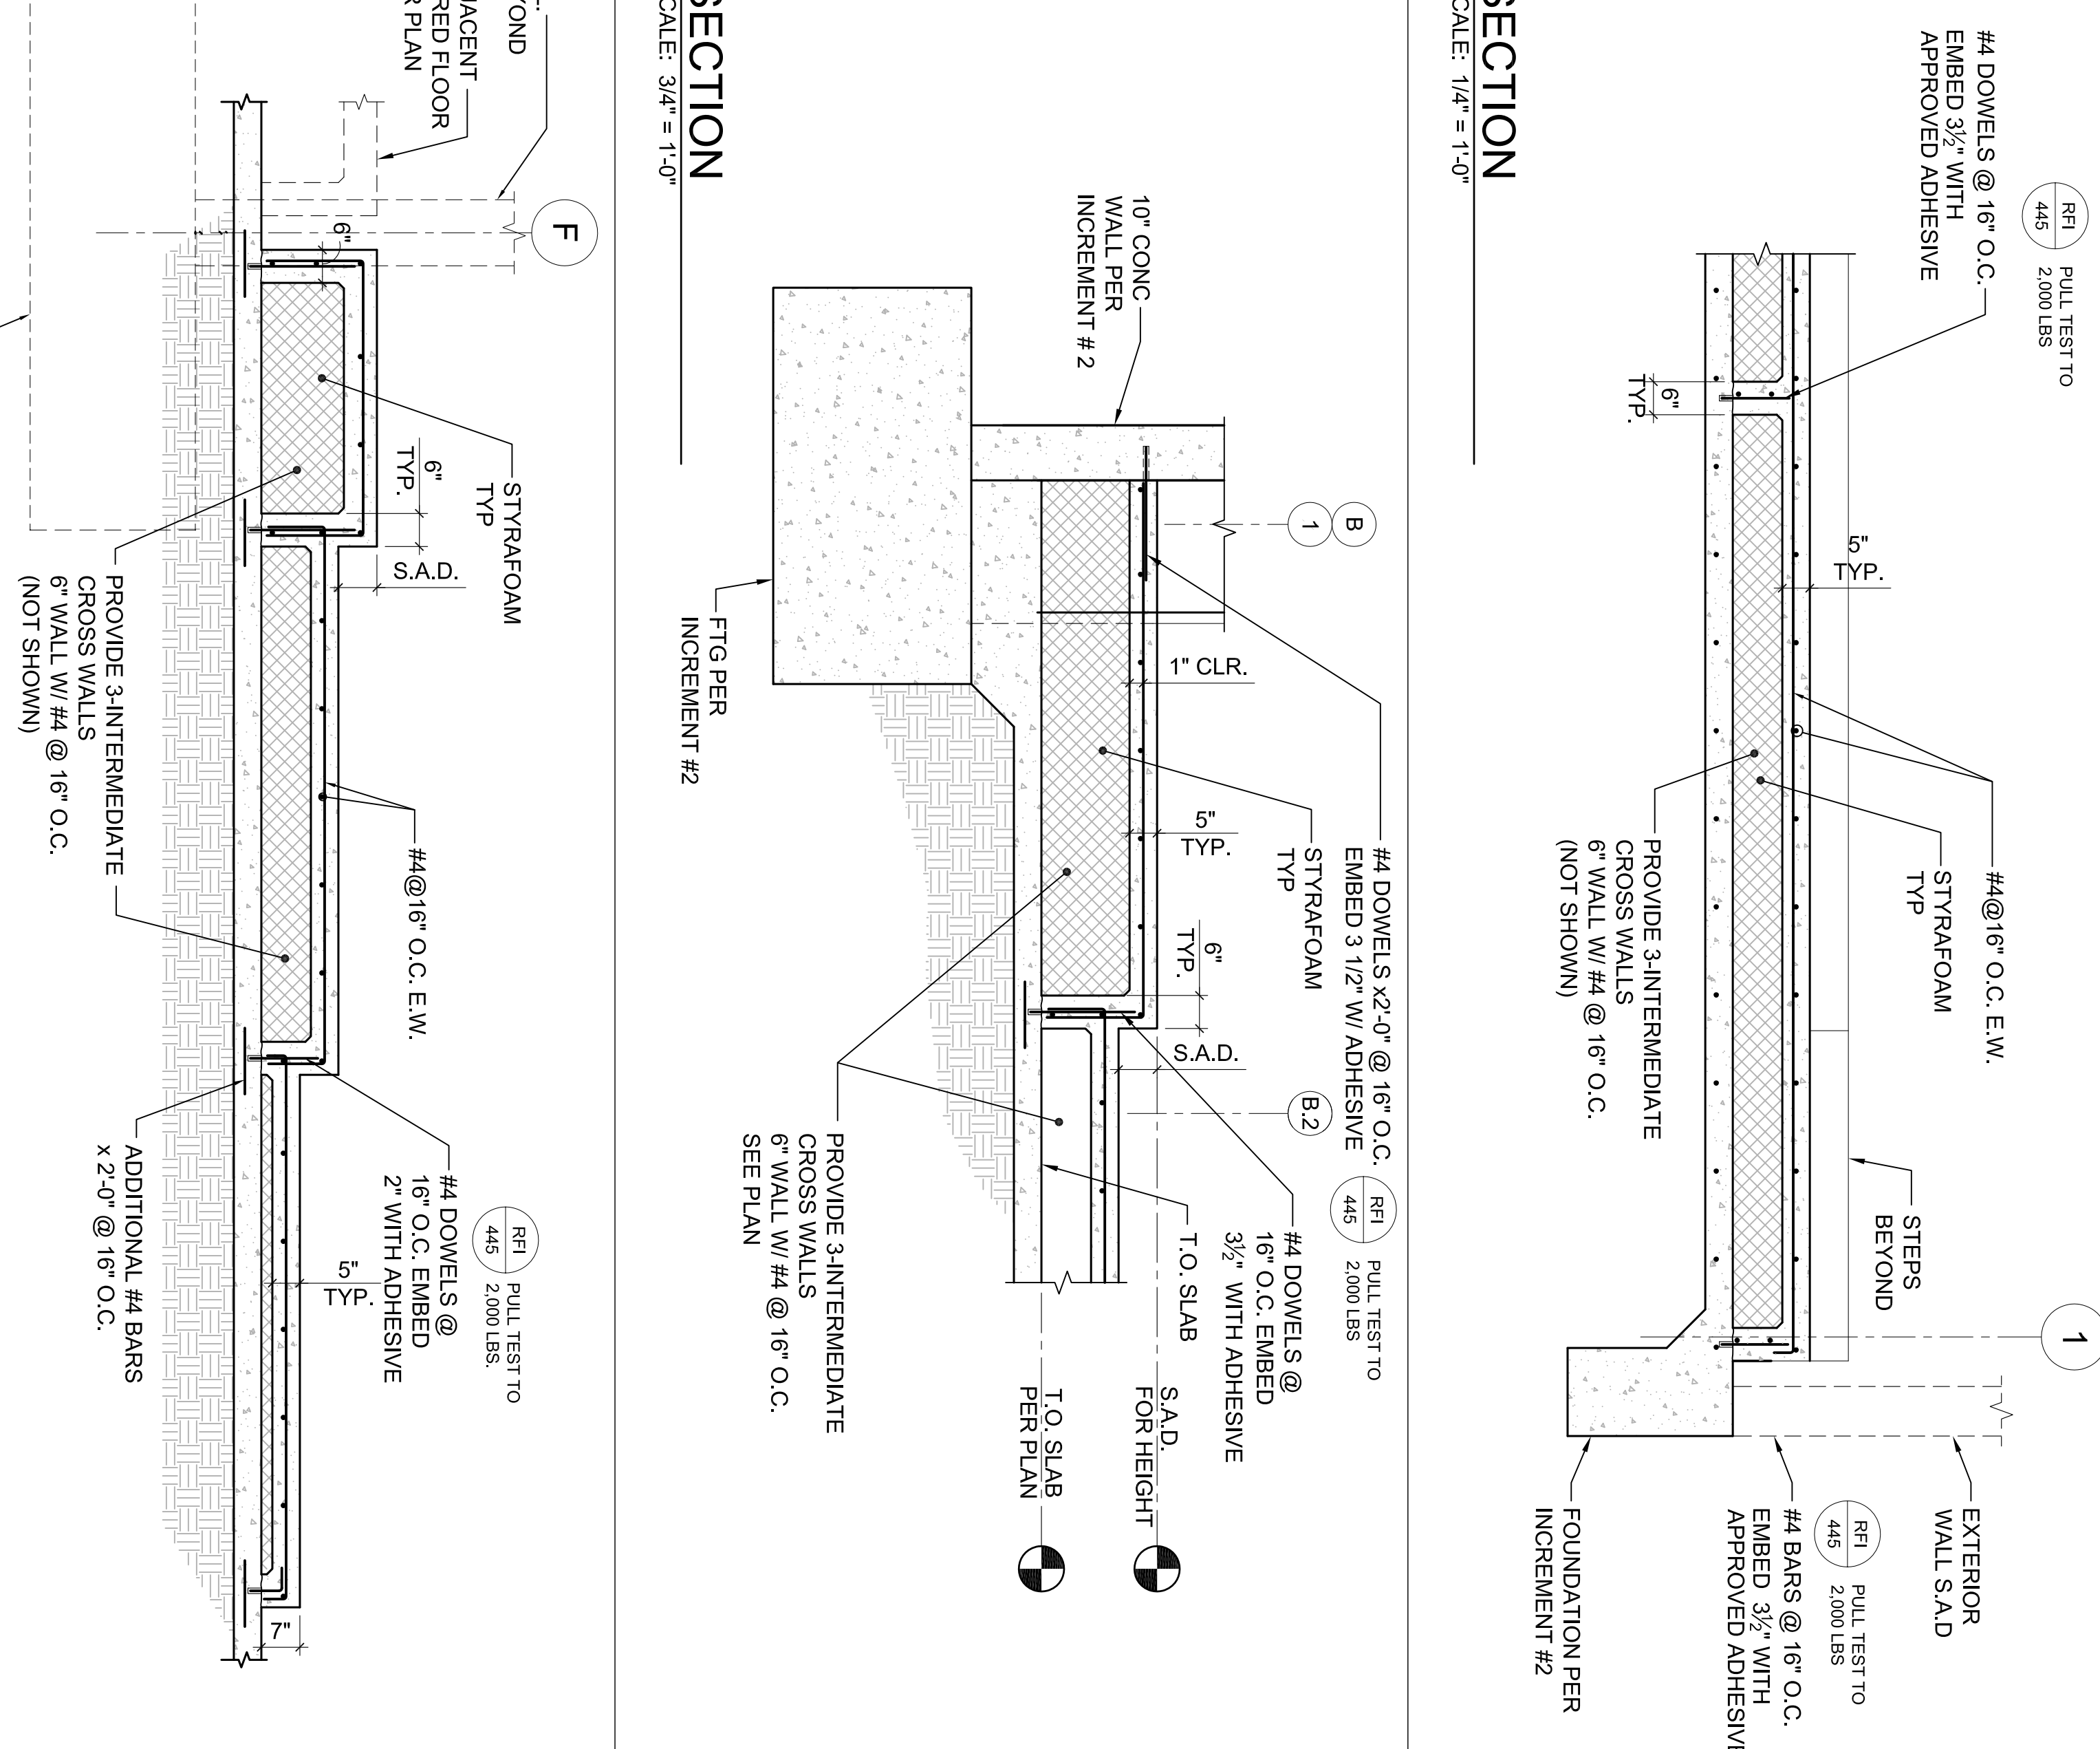


**10 SECTION @ TIERED FLOOR**  
 SCALE: 1/4" = 1'-0"

1) SEE INCREMENT #2 FOR STRUCTURAL DESIGN NOTES AND MATERIAL REQUIREMENTS.  
 2) SEE 18/A-911 FOR CONTINUOUS CANT. ALONG EDGE OF CIP CONCRETE TIERS.


**23 GENERAL NOTES**  
 NO SCALE

#4 DOWELS @ 16" O.C. EMBED 3 1/2" WITH APPROVED ADHESIVE

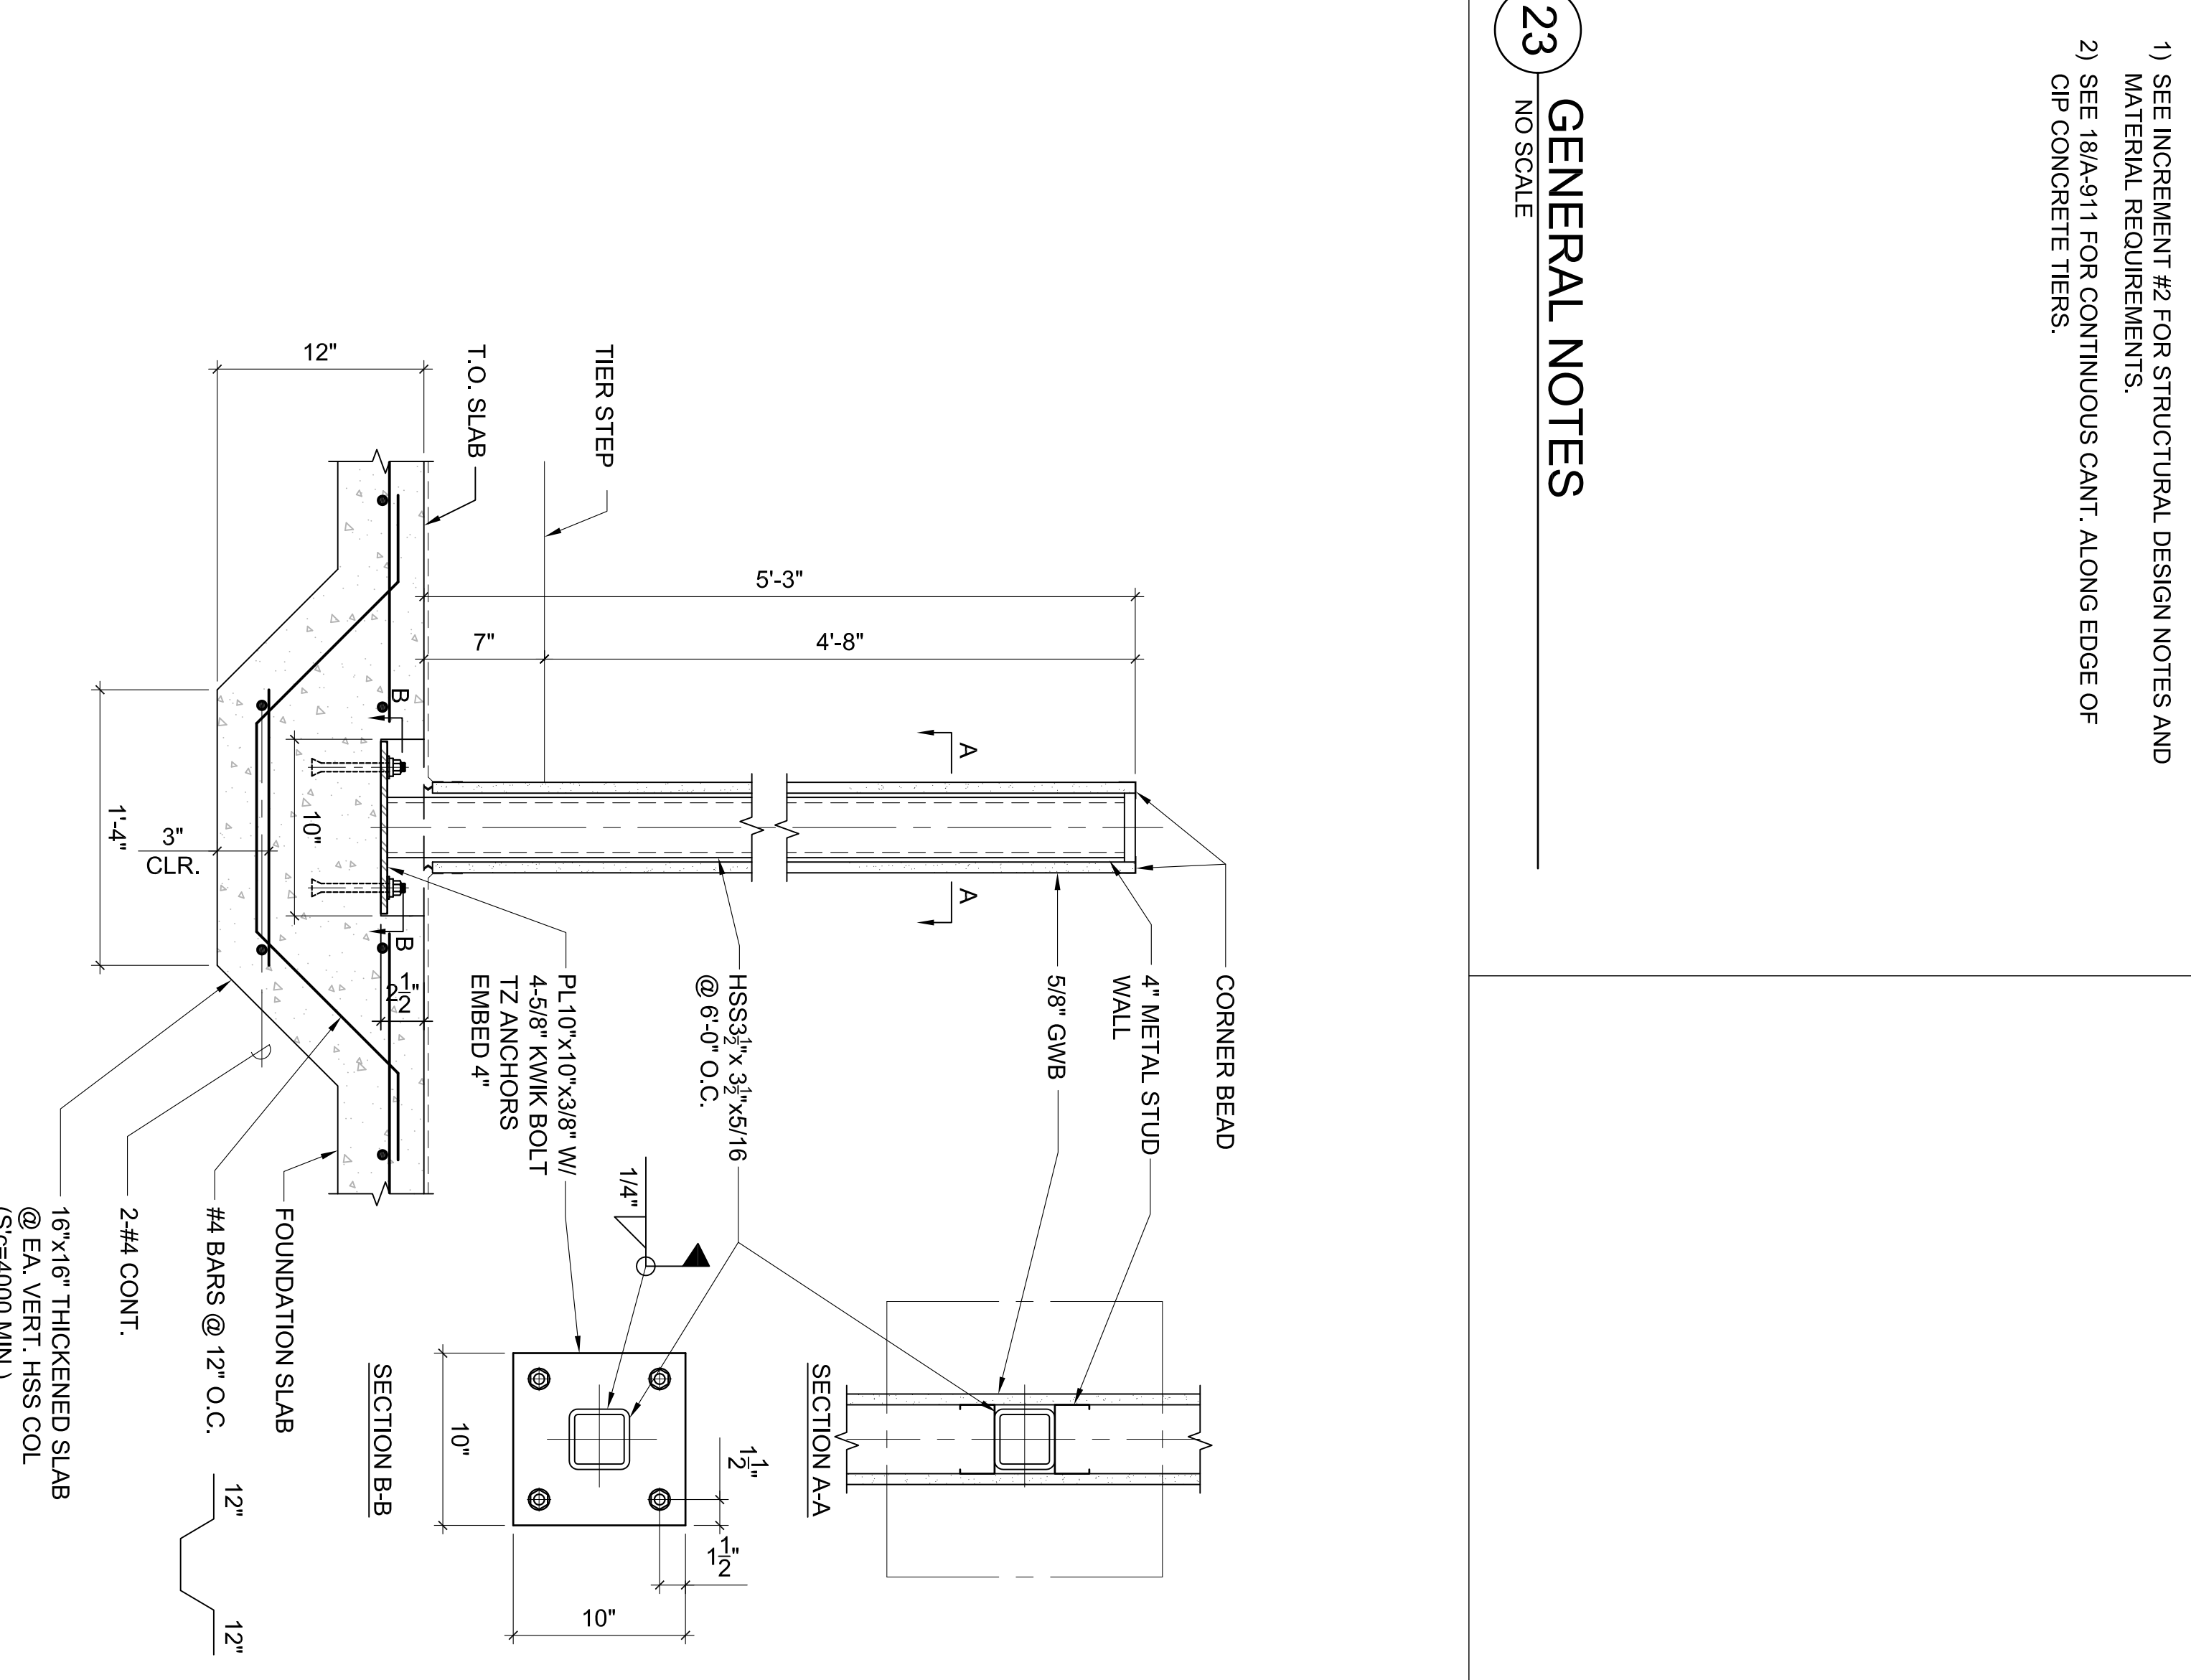

**25 PARTIAL HEIGHT WALL DETAIL**  
 SCALE: 1/2" = 1'-0"



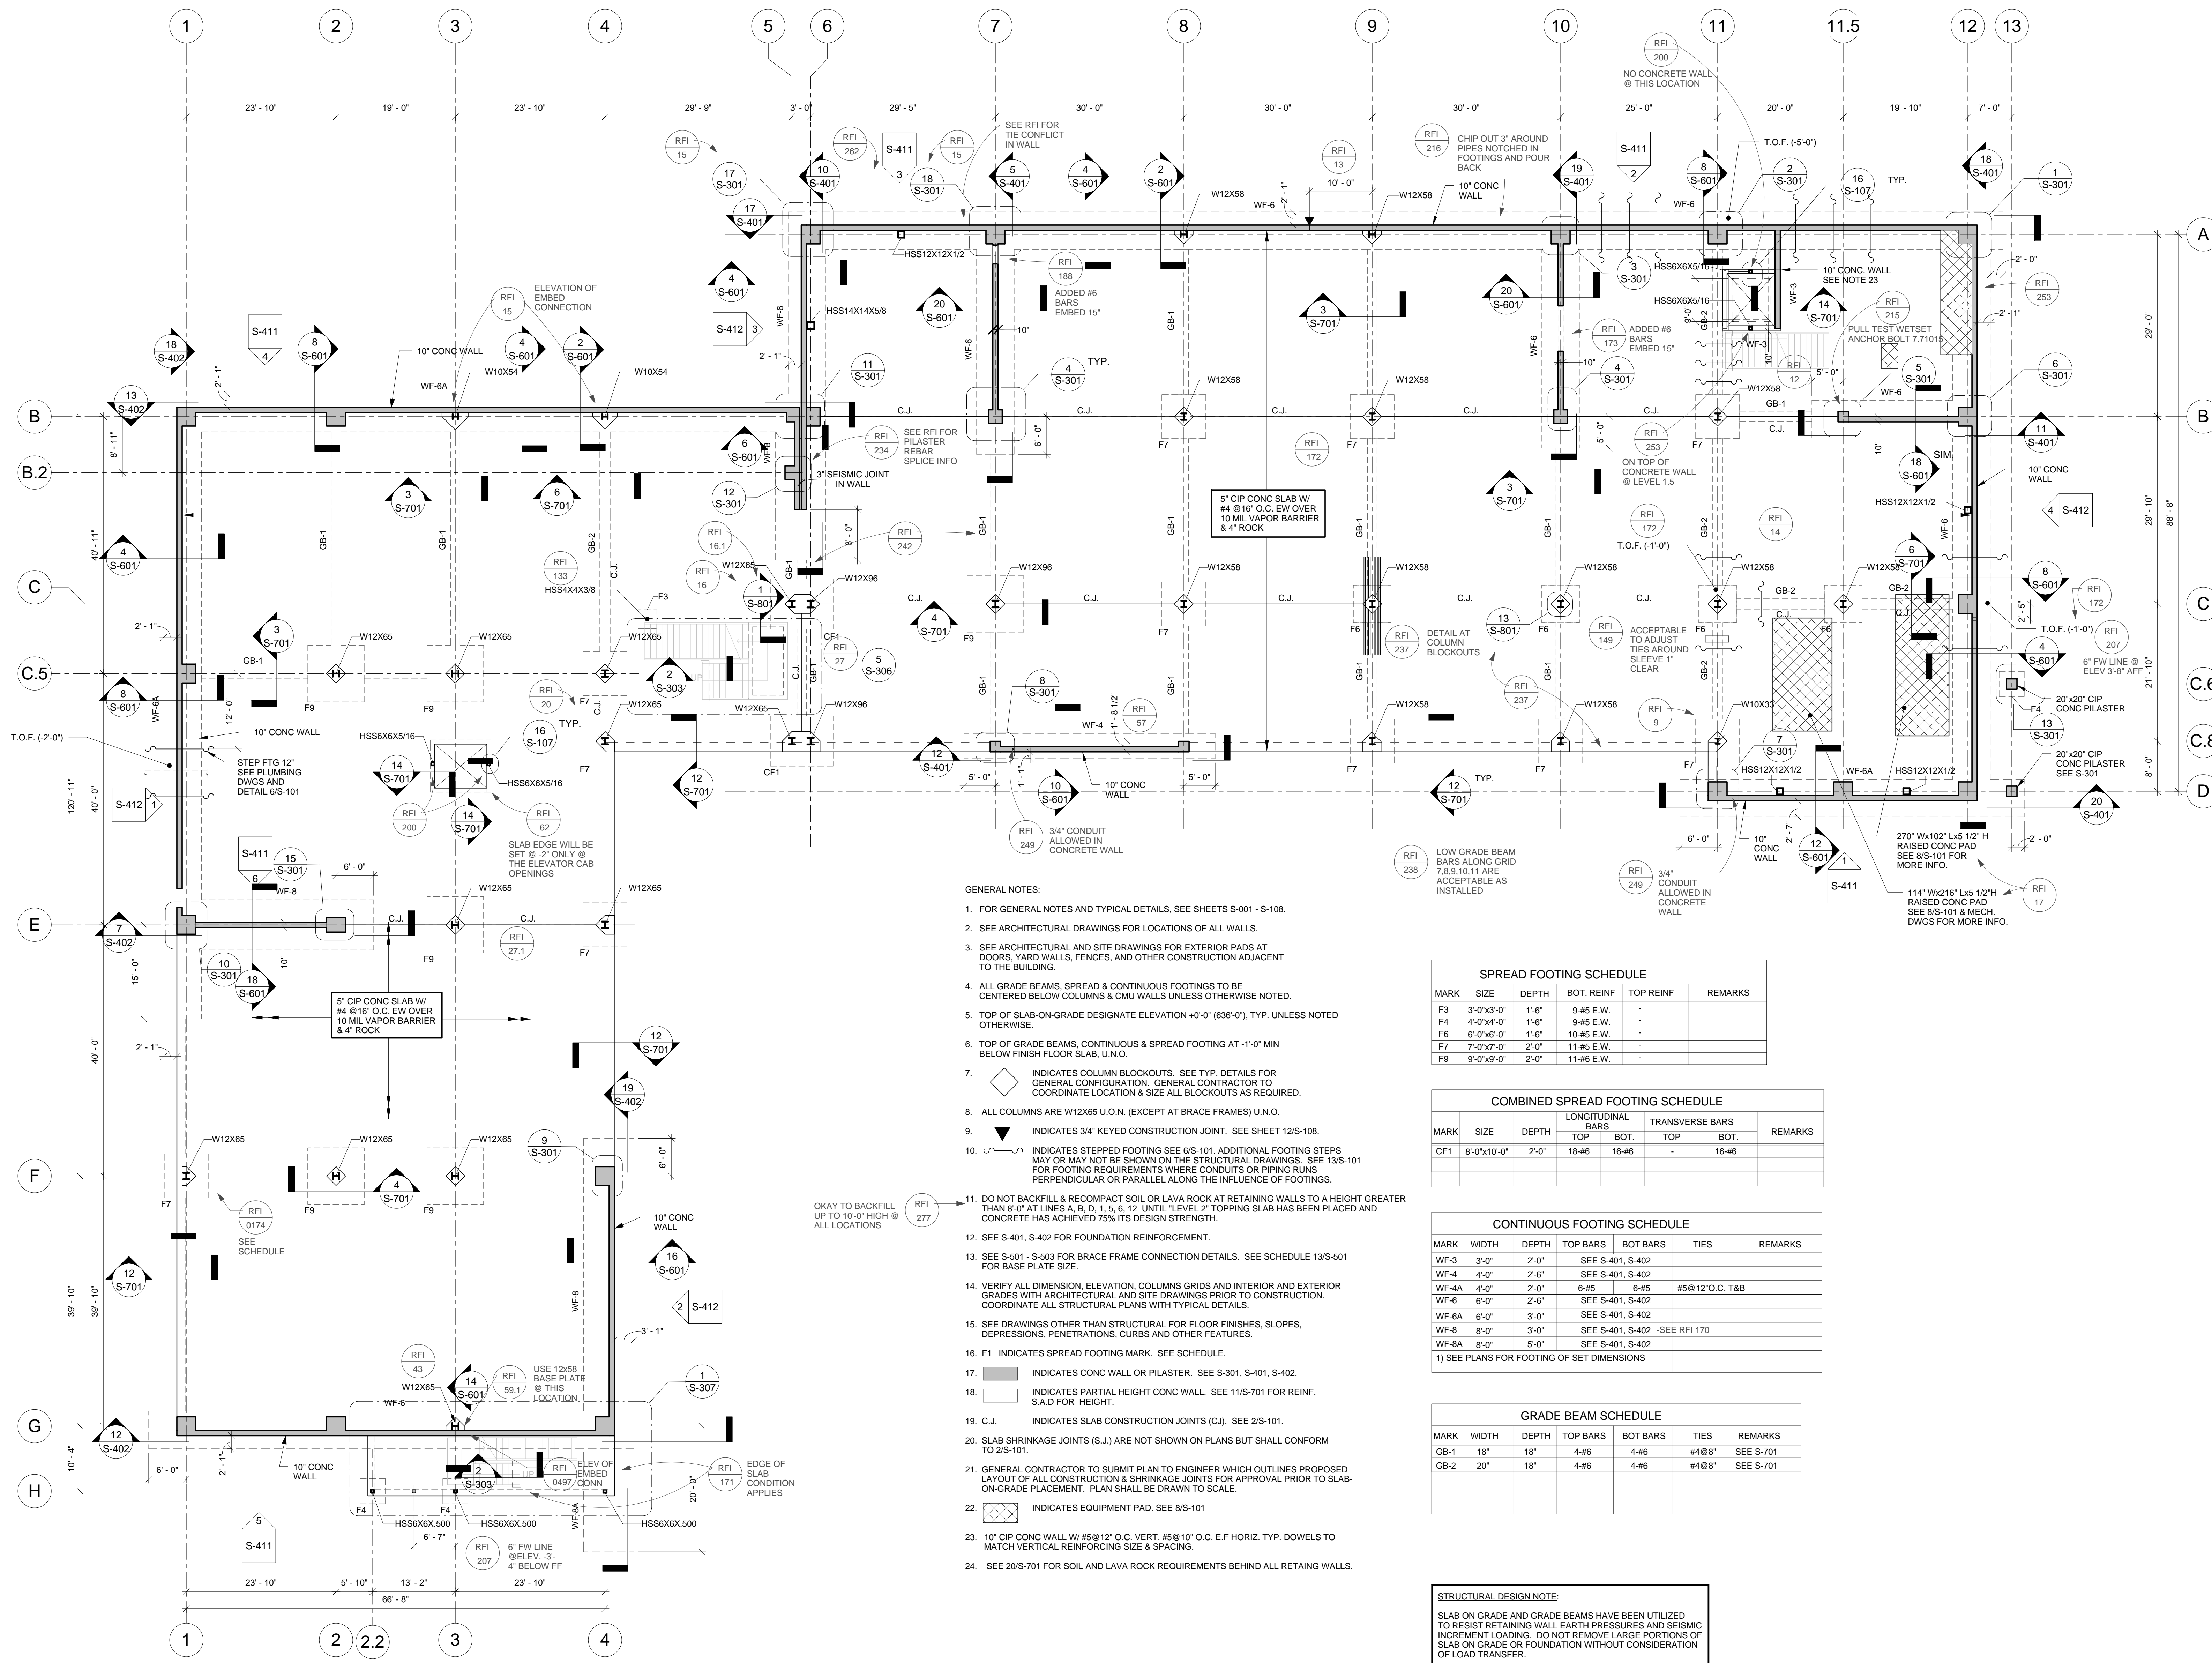

- GENERAL NOTES:**
- FOR GENERAL NOTES AND TYPICAL DETAILS, SEE SHEETS S-001 - S-108.
  - SEE ARCHITECTURAL DRAWINGS FOR LOCATIONS OF ALL WALLS.
  - SEE ARCHITECTURAL AND SITE DRAWINGS FOR EXTERIOR PADS AT DOORS, YARD WALLS, FENCES, AND OTHER CONSTRUCTION ADJACENT TO THE BUILDING.
  - ALL GRADE BEAMS, SPREAD & CONTINUOUS FOOTINGS TO BE CENTERED BELOW COLUMNS & CMU WALLS UNLESS OTHERWISE NOTED.
  - TOP OF SLAB-ON-GRADE DESIGNATE ELEVATION +0'-0" (636'-0"), TYP. UNLESS NOTED OTHERWISE.
  - TOP OF GRADE BEAMS, CONTINUOUS & SPREAD FOOTING AT -1'-0" MIN BELOW FINISH FLOOR SLAB, U.N.O.
  - INDICATES COLUMN BLOCKOUTS. SEE TYP. DETAILS FOR GENERAL CONFIGURATION. GENERAL CONTRACTOR TO COORDINATE LOCATION & SIZE ALL BLOCKOUTS AS REQUIRED.
  - ALL COLUMNS ARE W12X65 U.O.N. (EXCEPT AT BRACE FRAMES) U.N.O.
  - INDICATES 3/4" KEYPED CONSTRUCTION JOINT. SEE SHEET 12/S-108.
  - INDICATES STEPPED FOOTING SEE 6/S-101. ADDITIONAL FOOTING STEPS MAY OR MAY NOT BE SHOWN ON THE STRUCTURAL DRAWINGS. SEE 13/S-101 FOR FOOTING REQUIREMENTS WHERE CONDUITS OR PIPING RUNS PERPENDICULAR OR PARALLEL ALONG THE INFLUENCE OF FOOTINGS.
  - DO NOT BACKFILL & RECOMPACT SOIL OR LAVA ROCK AT RETAINING WALLS TO A HEIGHT GREATER THAN 8'-0" AT LINES A, B, D, 1, 5, 6, 12 UNTIL "LEVEL 2" TOPPING SLAB HAS BEEN PLACED AND CONCRETE HAS ACHIEVED 75% ITS DESIGN STRENGTH.
  - SEE S-401, S-402 FOR FOUNDATION REINFORCEMENT.
  - SEE S-601 - S-603 FOR BRACE FRAME CONNECTION DETAILS. SEE SCHEDULE 13/S-501 FOR BASE PLATE SIZE.
  - VERIFY ALL DIMENSION, ELEVATION, COLUMNS GRIDS AND INTERIOR AND EXTERIOR GRADES WITH ARCHITECTURAL AND SITE DRAWINGS PRIOR TO CONSTRUCTION. COORDINATE ALL STRUCTURAL PLANS WITH TYPICAL DETAILS.
  - SEE DRAWINGS OTHER THAN STRUCTURAL FOR FLOOR FINISHES, SLOPES, DEPRESSIONS, PENETRATIONS, CURBS AND OTHER FEATURES.
  - F1 INDICATES SPREAD FOOTING MARK. SEE SCHEDULE.
  - INDICATES CONC WALL OR PILASTER. SEE S-301, S-401, S-402.
  - INDICATES PARTIAL HEIGHT CONC WALL. SEE 11/S-701 FOR REINF. S.A.D FOR HEIGHT.
  - C.J. INDICATES SLAB CONSTRUCTION JOINTS (C.J.). SEE 2/S-101.
  - SLAB SHRINKAGE JOINTS (S.J.) ARE NOT SHOWN ON PLANS BUT SHALL CONFORM TO 2/S-101.
  - GENERAL CONTRACTOR TO SUBMIT PLAN TO ENGINEER WHICH OUTLINES PROPOSED LAYOUT OF ALL CONSTRUCTION & SHRINKAGE JOINTS FOR APPROVAL PRIOR TO SLAB-ON-GRADE PLACEMENT. PLAN SHALL BE DRAWN TO SCALE.
  - INDICATES EQUIPMENT PAD. SEE S/S-101.
  - 10" CIP CONC WALL W/ #5 @ 12" O.C. VERT. #5 @ 10" O.C. E.F. HORIZ. TYP. DOWELS TO MATCH VERTICAL REINFORCING SIZE & SPACING.
  - SEE 2/S-701 FOR SOIL AND LAVA ROCK REQUIREMENTS BEHIND ALL RETAINS WALLS.

**SPREAD FOOTING SCHEDULE**

MARK	SIZE	DEPTH	BOT. REINF.	TOP REINF.	REMARKS
F3	3'-0"x3'-0"	1'-6"	9-#5 E.W.	-	
F4	4'-0"x4'-0"	1'-6"	9-#5 E.W.	-	
F6	6'-0"x6'-0"	1'-6"	10-#5 E.W.	-	
F7	7'-0"x7'-0"	2'-0"	11-#5 E.W.	-	
F9	9'-0"x9'-0"	2'-0"	11-#6 E.W.	-	

**COMBINED SPREAD FOOTING SCHEDULE**

MARK	SIZE	DEPTH	LONGITUDINAL BARS		TRANSVERSE BARS		REMARKS
			TOP	BOT.	TOP	BOT.	
CF1	8'-0"x10'-0"	2'-0"	18-#6	16-#6	-	16-#6	

**CONTINUOUS FOOTING SCHEDULE**

MARK	WIDTH	DEPTH	TOP BARS	BOT BARS	TIES	REMARKS
WF-3	3'-0"	2'-0"	SEE S-401, S-402	SEE S-401, S-402		
WF-4	4'-0"	2'-6"	SEE S-401, S-402	SEE S-401, S-402		
WF-4A	4'-0"	2'-0"	6-#5	6-#5	#5 @ 12" O.C. T&B	
WF-6	6'-0"	2'-6"	SEE S-401, S-402	SEE S-401, S-402		
WF-6A	6'-0"	3'-0"	SEE S-401, S-402	SEE S-401, S-402		
WF-8	8'-0"	3'-0"	SEE S-401, S-402	SEE S-401, S-402	SEE RFI 170	
WF-8A	8'-0"	5'-0"	SEE S-401, S-402	SEE S-401, S-402		

1) SEE PLANS FOR FOOTING OF SET DIMENSIONS

**GRADE BEAM SCHEDULE**

MARK	WIDTH	DEPTH	TOP BARS	BOT BARS	TIES	REMARKS
GB-1	18"	18"	4-#6	4-#6	#4 @ 8"	SEE S-701
GB-2	20"	18"	4-#6	4-#6	#4 @ 8"	SEE S-701

**STRUCTURAL DESIGN NOTE:**  
SLAB ON GRADE AND GRADE BEAMS HAVE BEEN UTILIZED TO RESIST RETAINING WALL EARTH PRESSURES AND SEISMIC INCREMENTAL LOADINGS. DO NOT REMOVE LARGE PORTIONS OF SLAB ON GRADE OR FOUNDATION WITHOUT CONSULTATION OF LOAD TRANSFER.

**1 FOUNDATION PLAN**  
SCALE: 3/32" = 1'-0"


**PROJECT RECORD SET**

**SKYLINE COLLEGE**  
SAN MATEO COUNTY  
COMMUNITY COLLEGE  
DISTRICT

**CIP2 DESIGN-BUILD PROJECT BUILDING 4**


PROJECT NO.: 07055.00 DRAWN BY: AY  
DATE: 05.15.2009 CHECKED BY: CB  
SCALE: 3/32" = 1'-0"

SHEET TITLE:  
**FOUNDATION PLAN**

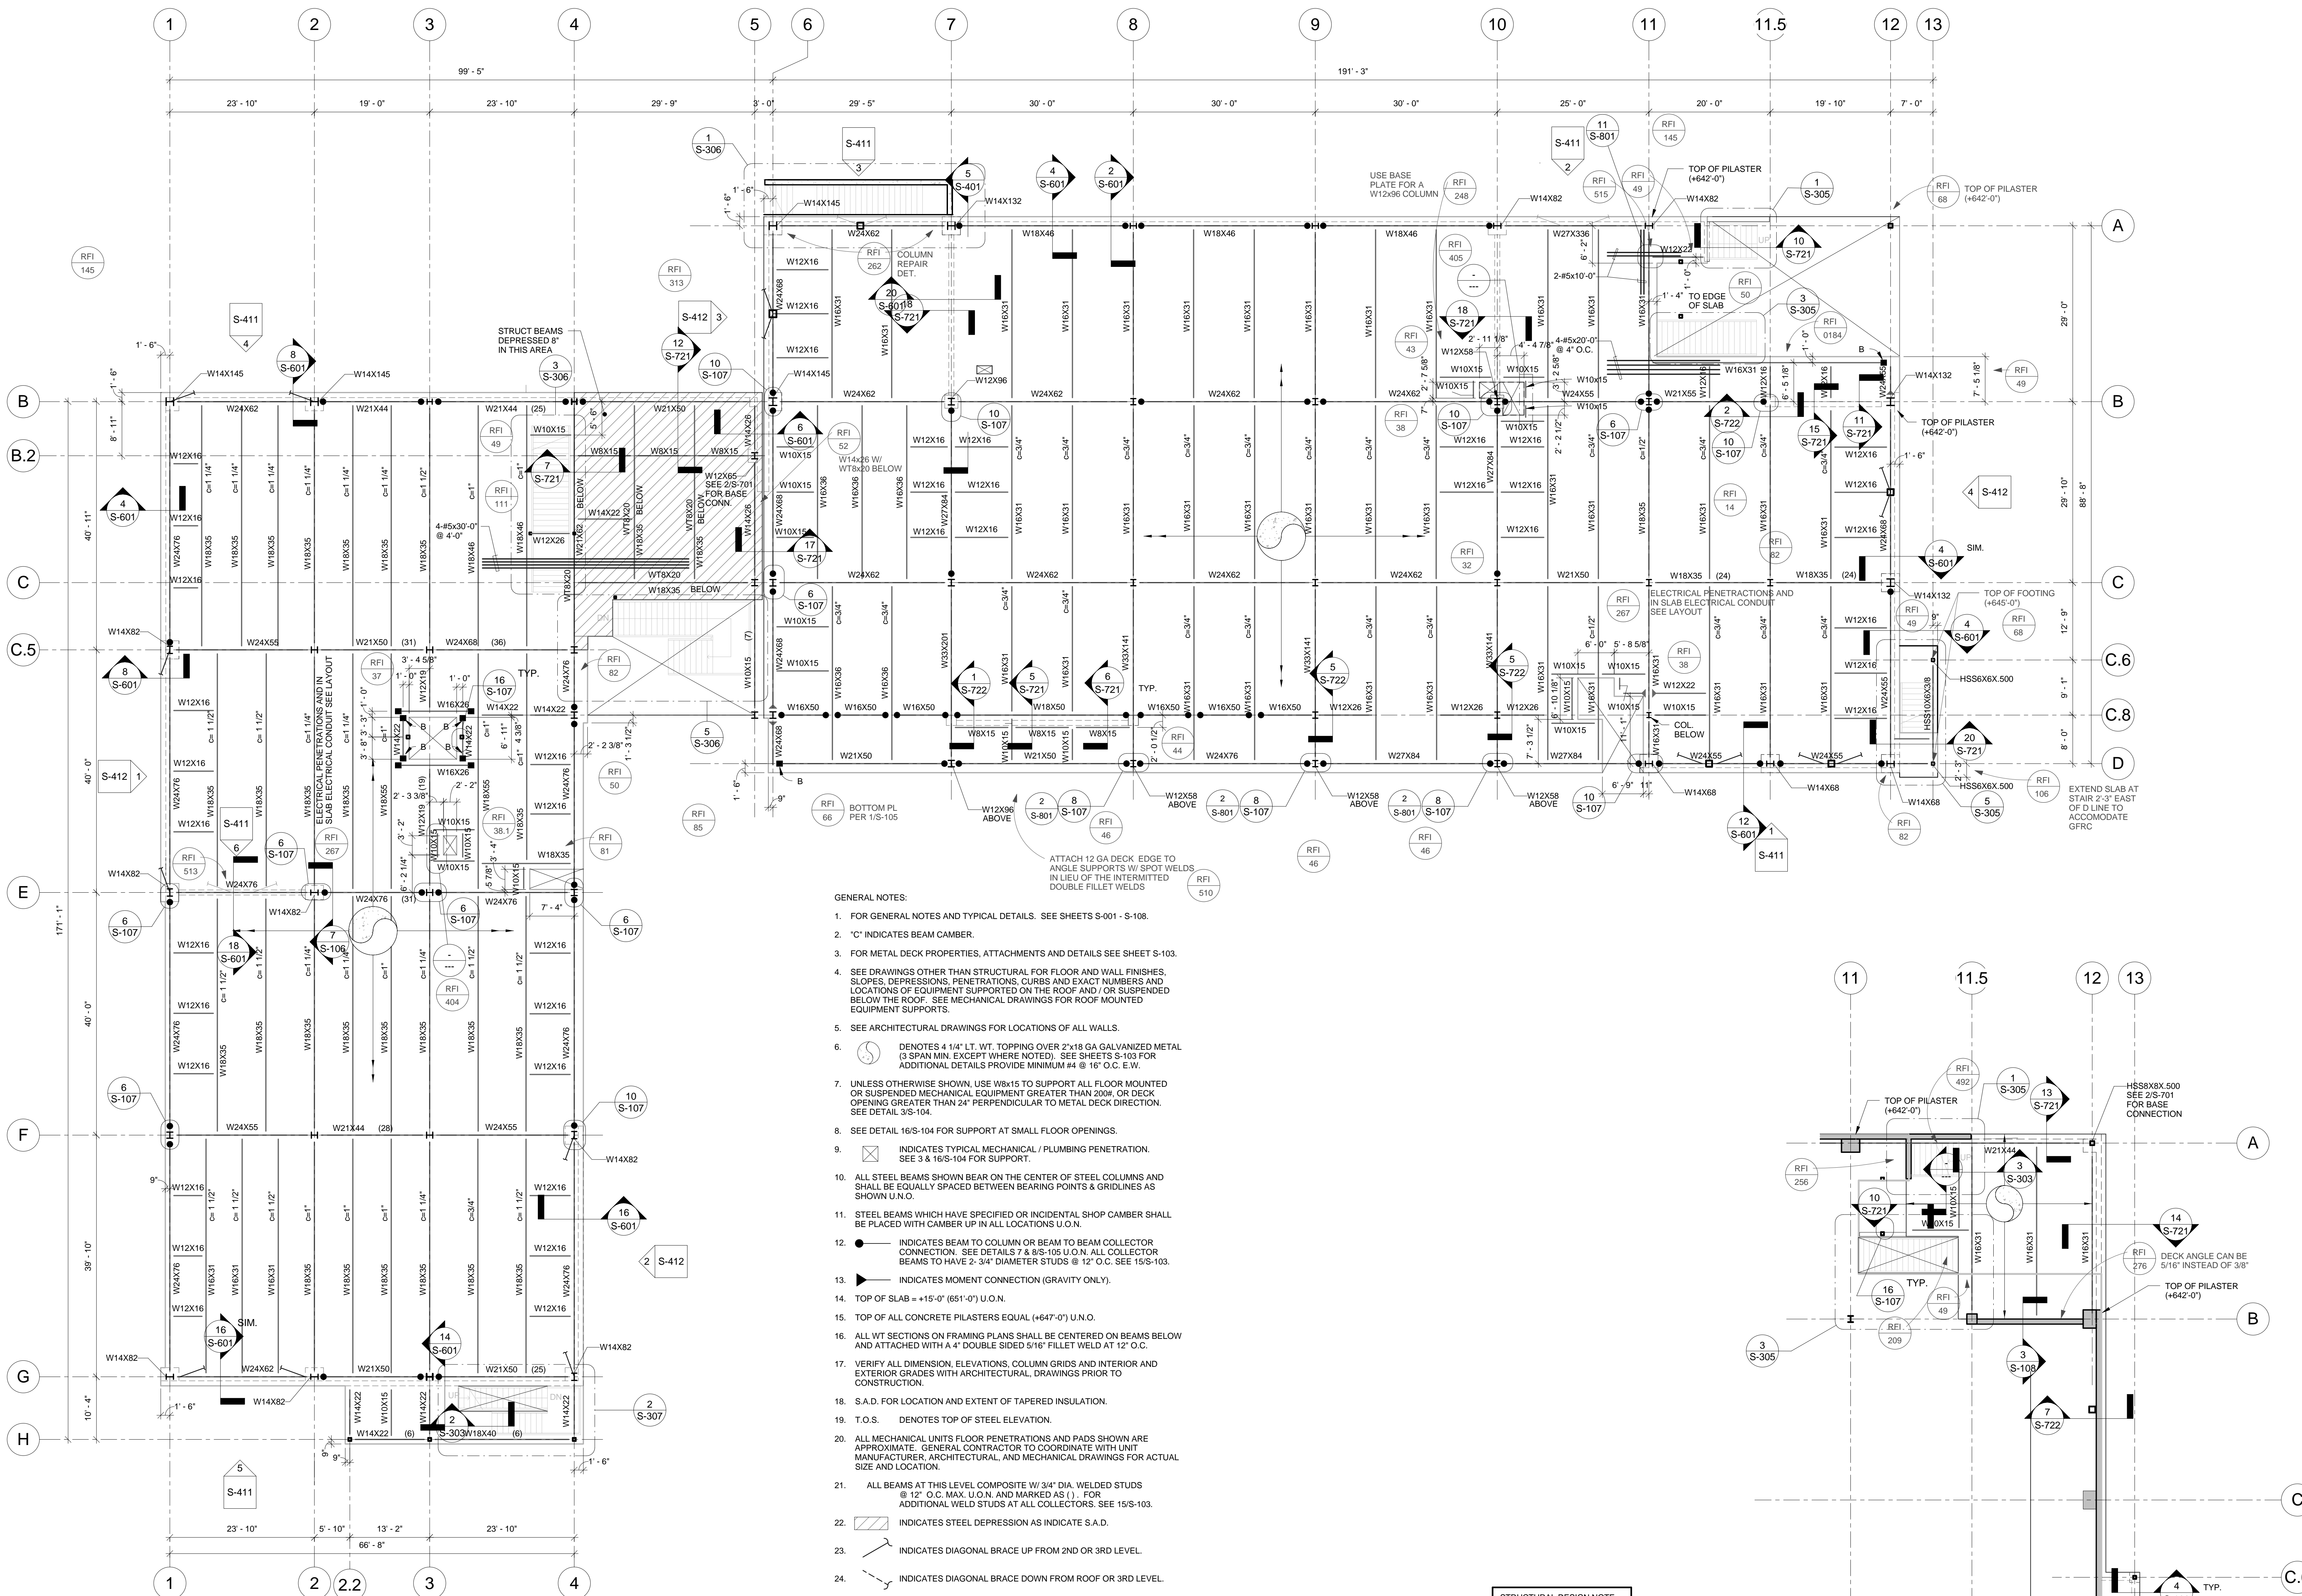

- GENERAL NOTES:
- FOR GENERAL NOTES AND TYPICAL DETAILS. SEE SHEETS S-001 - S-108.
  - "C" INDICATES BEAM CAMBER.
  - FOR METAL DECK PROPERTIES, ATTACHMENTS AND DETAILS SEE SHEET S-103.
  - SEE DRAWINGS OTHER THAN STRUCTURAL FOR FLOOR AND WALL FINISHES, SLOPES, DEPRESSIONS, PENETRATIONS, CURBS AND EXACT NUMBERS AND LOCATIONS OF EQUIPMENT SUPPORTED ON THE ROOF AND/OR SUSPENDED BELOW THE ROOF. SEE MECHANICAL DRAWINGS FOR ROOF MOUNTED EQUIPMENT SUPPORTS.
  - SEE ARCHITECTURAL DRAWINGS FOR LOCATIONS OF ALL WALLS.
  - ⊙ DENOTES 4 1/4" L.T. WT. TOPPING OVER 2X18 GA GALVANIZED METAL (3 SPAN MIN. EXCEPT WHERE NOTED). SEE SHEETS S-103 FOR ADDITIONAL DETAILS PROVIDE MINIMUM #4 @ 16" O.C. E.W.
  - UNLESS OTHERWISE SHOWN, USE W8X15 TO SUPPORT ALL FLOOR MOUNTED OR SUSPENDED MECHANICAL EQUIPMENT GREATER THAN 200# OR DECK OPENING GREATER THAN 24" PERPENDICULAR TO METAL DECK DIRECTION. SEE DETAIL 3/S-104.
  - SEE DETAIL 16/S-104 FOR SUPPORT AT SMALL FLOOR OPENINGS.
  - ⊠ INDICATES TYPICAL MECHANICAL PLUMBING PENETRATION. SEE 3 & 16/S-104 FOR SUPPORT.
  - ALL STEEL BEAMS SHOWN BEAR ON THE CENTER OF STEEL COLUMNS AND SHALL BE EQUALLY SPACED BETWEEN BEARING POINTS & GRIDLINES AS SHOWN U.N.O.
  - STEEL BEAMS WHICH HAVE SPECIFIED OR INCIDENTAL SHIP CAMBER SHALL BE PLACED WITH CAMBER UP IN ALL LOCATIONS U.N.O.
  - ⊙ INDICATES BEAM TO COLUMN OR BEAM TO BEAM COLLECTOR CONNECTION. SEE DETAILS 7 & 8/S-105 U.O.N. ALL COLLECTOR BEAMS TO HAVE 2-3/4" DIAMETER STUDS @ 12" O.C. SEE 15/S-103.
  - ⊙ INDICATES MOMENT CONNECTION (GRAVITY ONLY).
  - TOP OF SLAB = +15'-0" (651'-0") U.O.N.
  - TOP OF ALL CONCRETE PLASTER EQUAL (+647'-0") U.O.N.
  - ALL WT SECTIONS ON FRAMING PLANS SHALL BE CENTERED ON BEAMS BELOW AND ATTACHED WITH A 4" DOUBLE SIDED 5/16" FILLET WELD AT 12" O.C.
  - VERIFY ALL DIMENSION, ELEVATIONS, COLUMN GRIDS AND INTERIOR AND EXTERIOR GRADES WITH ARCHITECTURAL DRAWINGS PRIOR TO CONSTRUCTION.
  - S.A.D. FOR LOCATION AND EXTENT OF TAPERED INSULATION.
  - T.O.S. DENOTES TOP OF STEEL ELEVATION.
  - ALL MECHANICAL UNITS FLOOR PENETRATIONS AND PADS SHOWN ARE APPROXIMATE. GENERAL CONTRACTOR TO COORDINATE WITH UNIT MANUFACTURER, ARCHITECTURAL, AND MECHANICAL DRAWINGS FOR ACTUAL SIZE AND LOCATION.
  - ALL BEAMS AT THIS LEVEL COMPOSITE W/ 3/4" DIA. WELDED STUDS @ 12" O.C. MAX. U.O.N. AND MARKED AS ( ). FOR ADDITIONAL WELD STUDS AT ALL COLLECTORS. SEE 15/S-103.
  - ⊠ INDICATES STEEL DEPRESSION AS INDICATE S.A.D.
  - ⊠ INDICATES DIAGONAL BRACE UP FROM 2ND OR 3RD LEVEL.
  - ⊠ INDICATES DIAGONAL BRACE DOWN FROM ROOF OR 3RD LEVEL.
  - ⊠ INDICATES OPEN TO BELOW.
  - SEE S-204 FOR ADDITIONAL NOTES RELATED TO ROOF AREAS.
  - ⊠ INDICATES BEAM CONTINUOUS OVER COLUMN SEE 5/S-722.
  - ↑ INDICATES KICKER PER DETAIL 16/S-801.

STRUCTURAL DESIGN NOTE  
SECOND FLOOR DIAPHRAGM  
HAS BEEN DESIGNED TO  
SUPPORT THE RETAINING  
WALL EARTH PRESSURES AND  
INCREMENT LOADING.

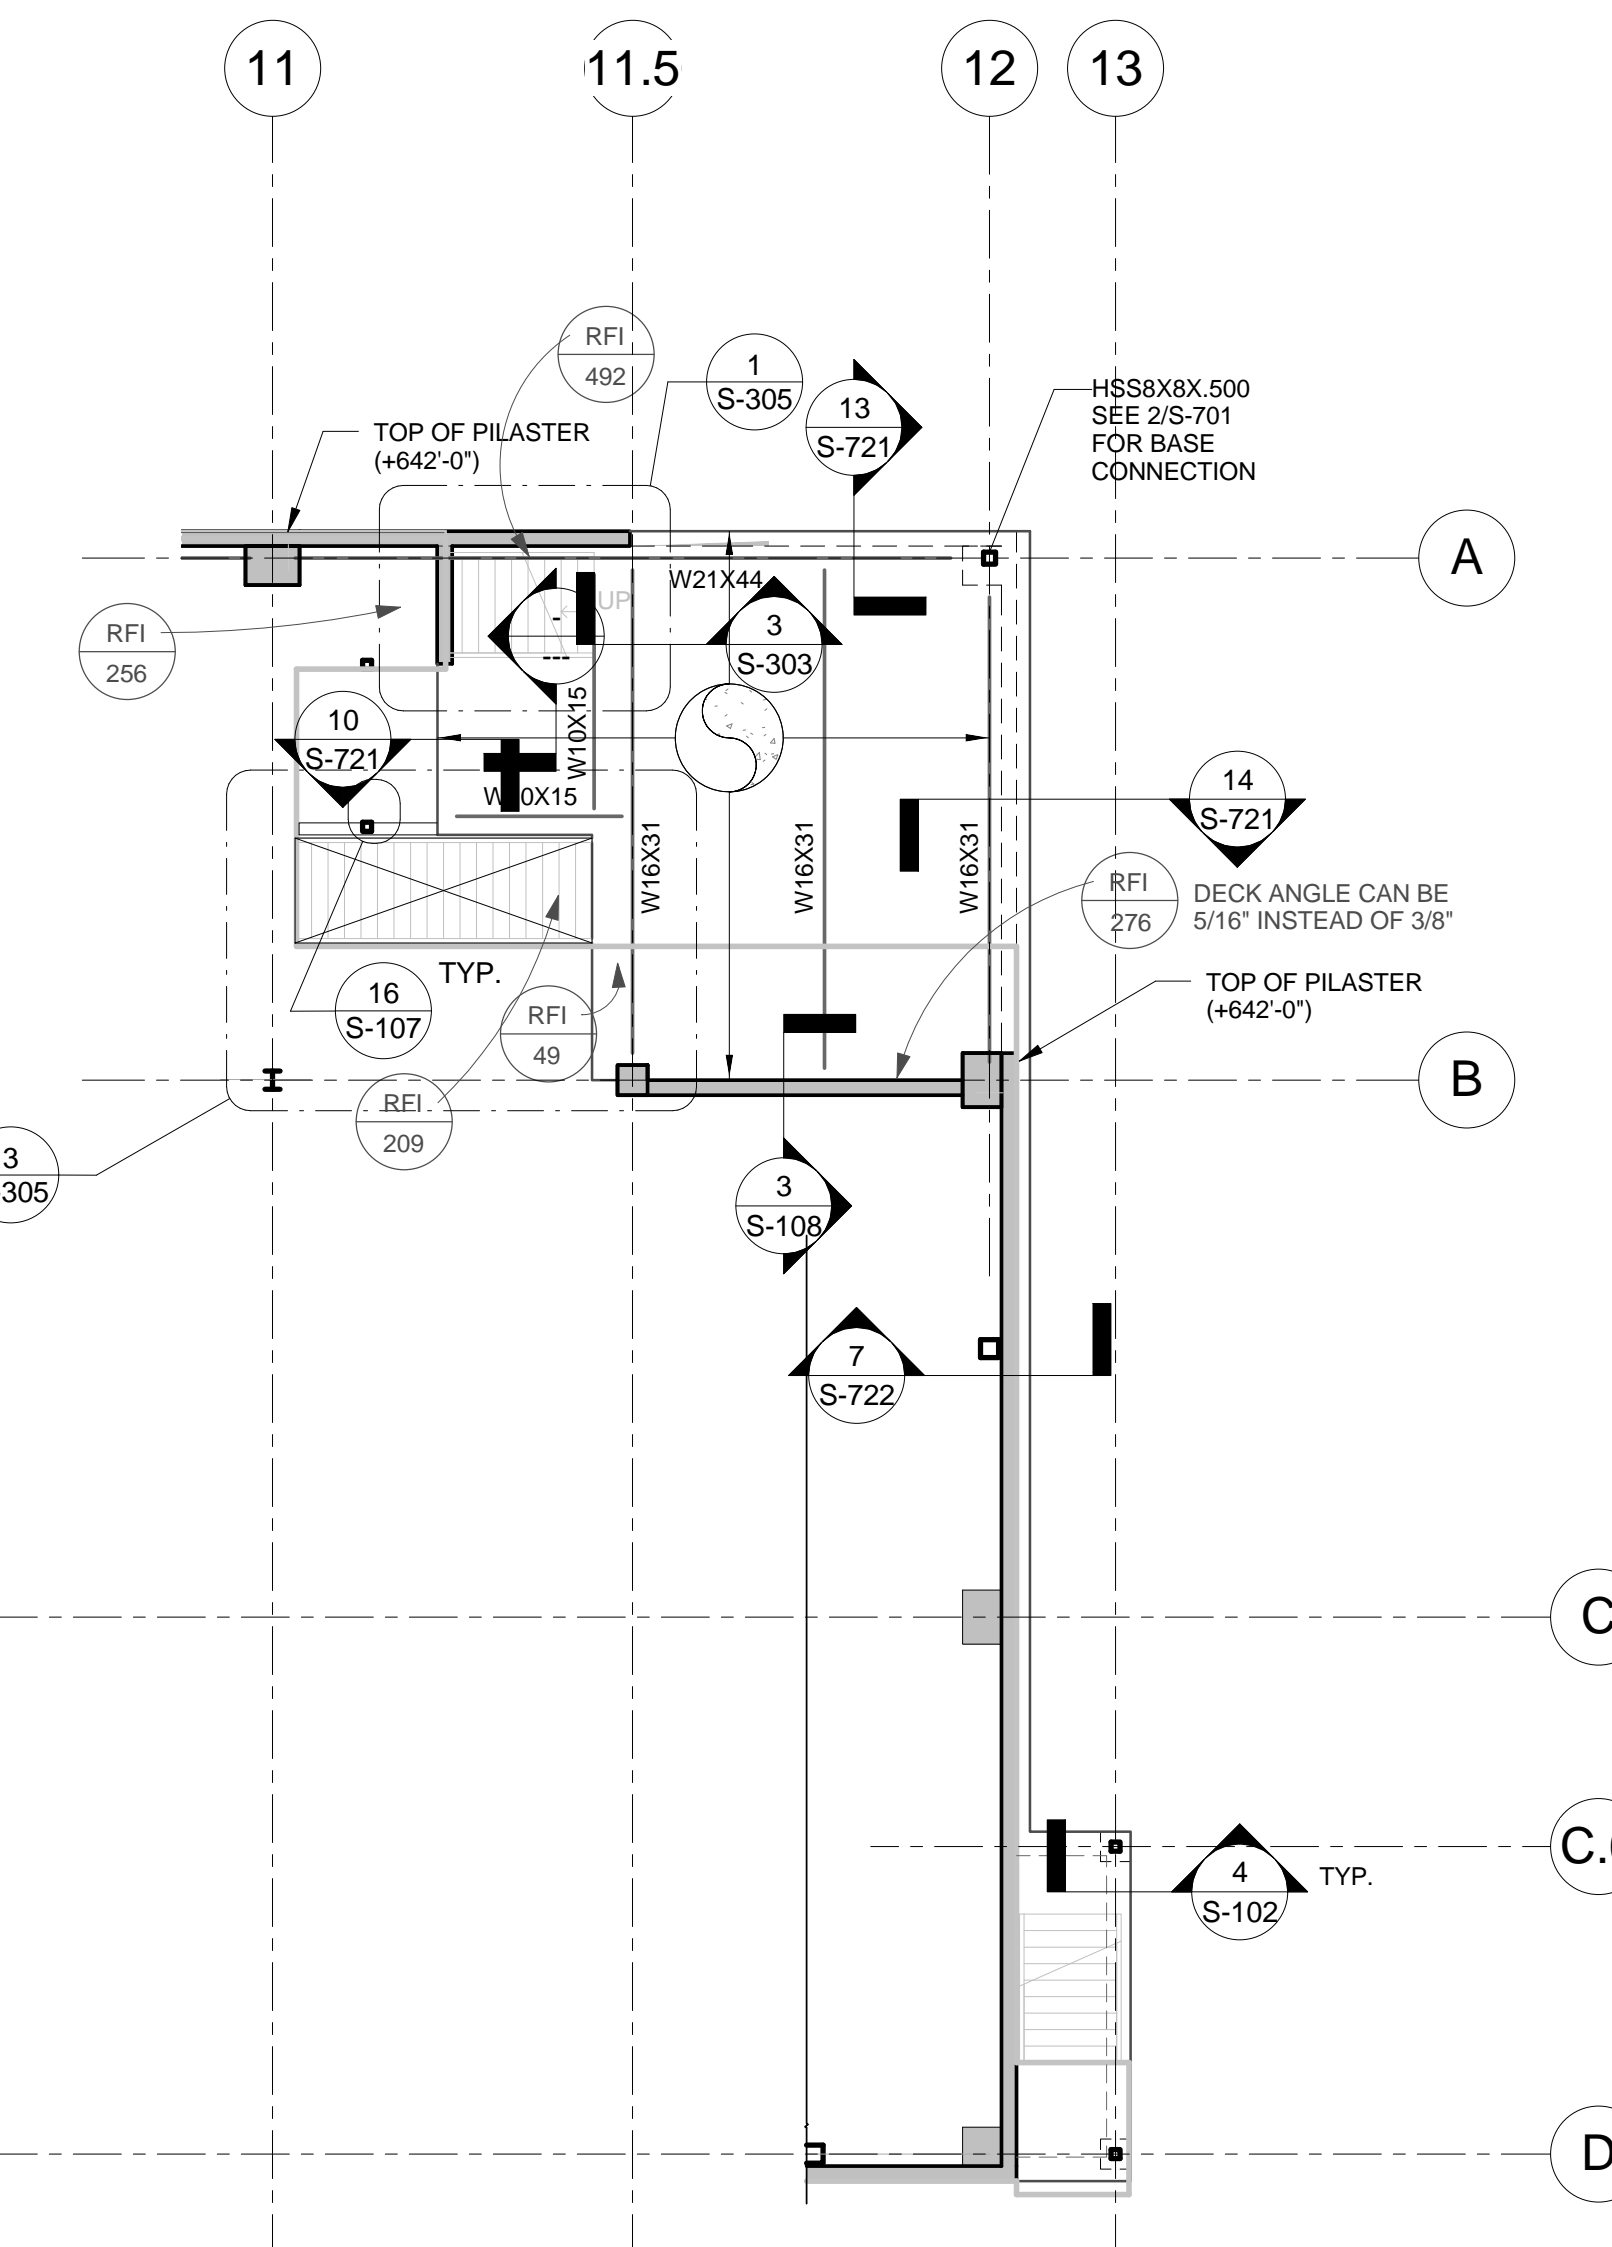

**1 LEVEL 2 FRAMING PLAN**  
SCALE: 3/32" = 1'-0"

**2 LEVEL 1.5 FRAMING PLAN**  
SCALE: 3/32" = 1'-0"


PROJECT  
RECORD SET

SKYLINE COLLEGE  
SAN MATEO COUNTY  
COMMUNITY COLLEGE  
DISTRICT

CIP2 DESIGN-BUILD  
PROJECT  
BUILDING 4

PROJECT NO.: 07055-00 DRAWN BY: AY  
DATE: 05.15.2009 CHECKED BY: CB  
SCALE: As indicated


SHEET TITLE:  
**LEVEL 2  
FRAMING PLAN**

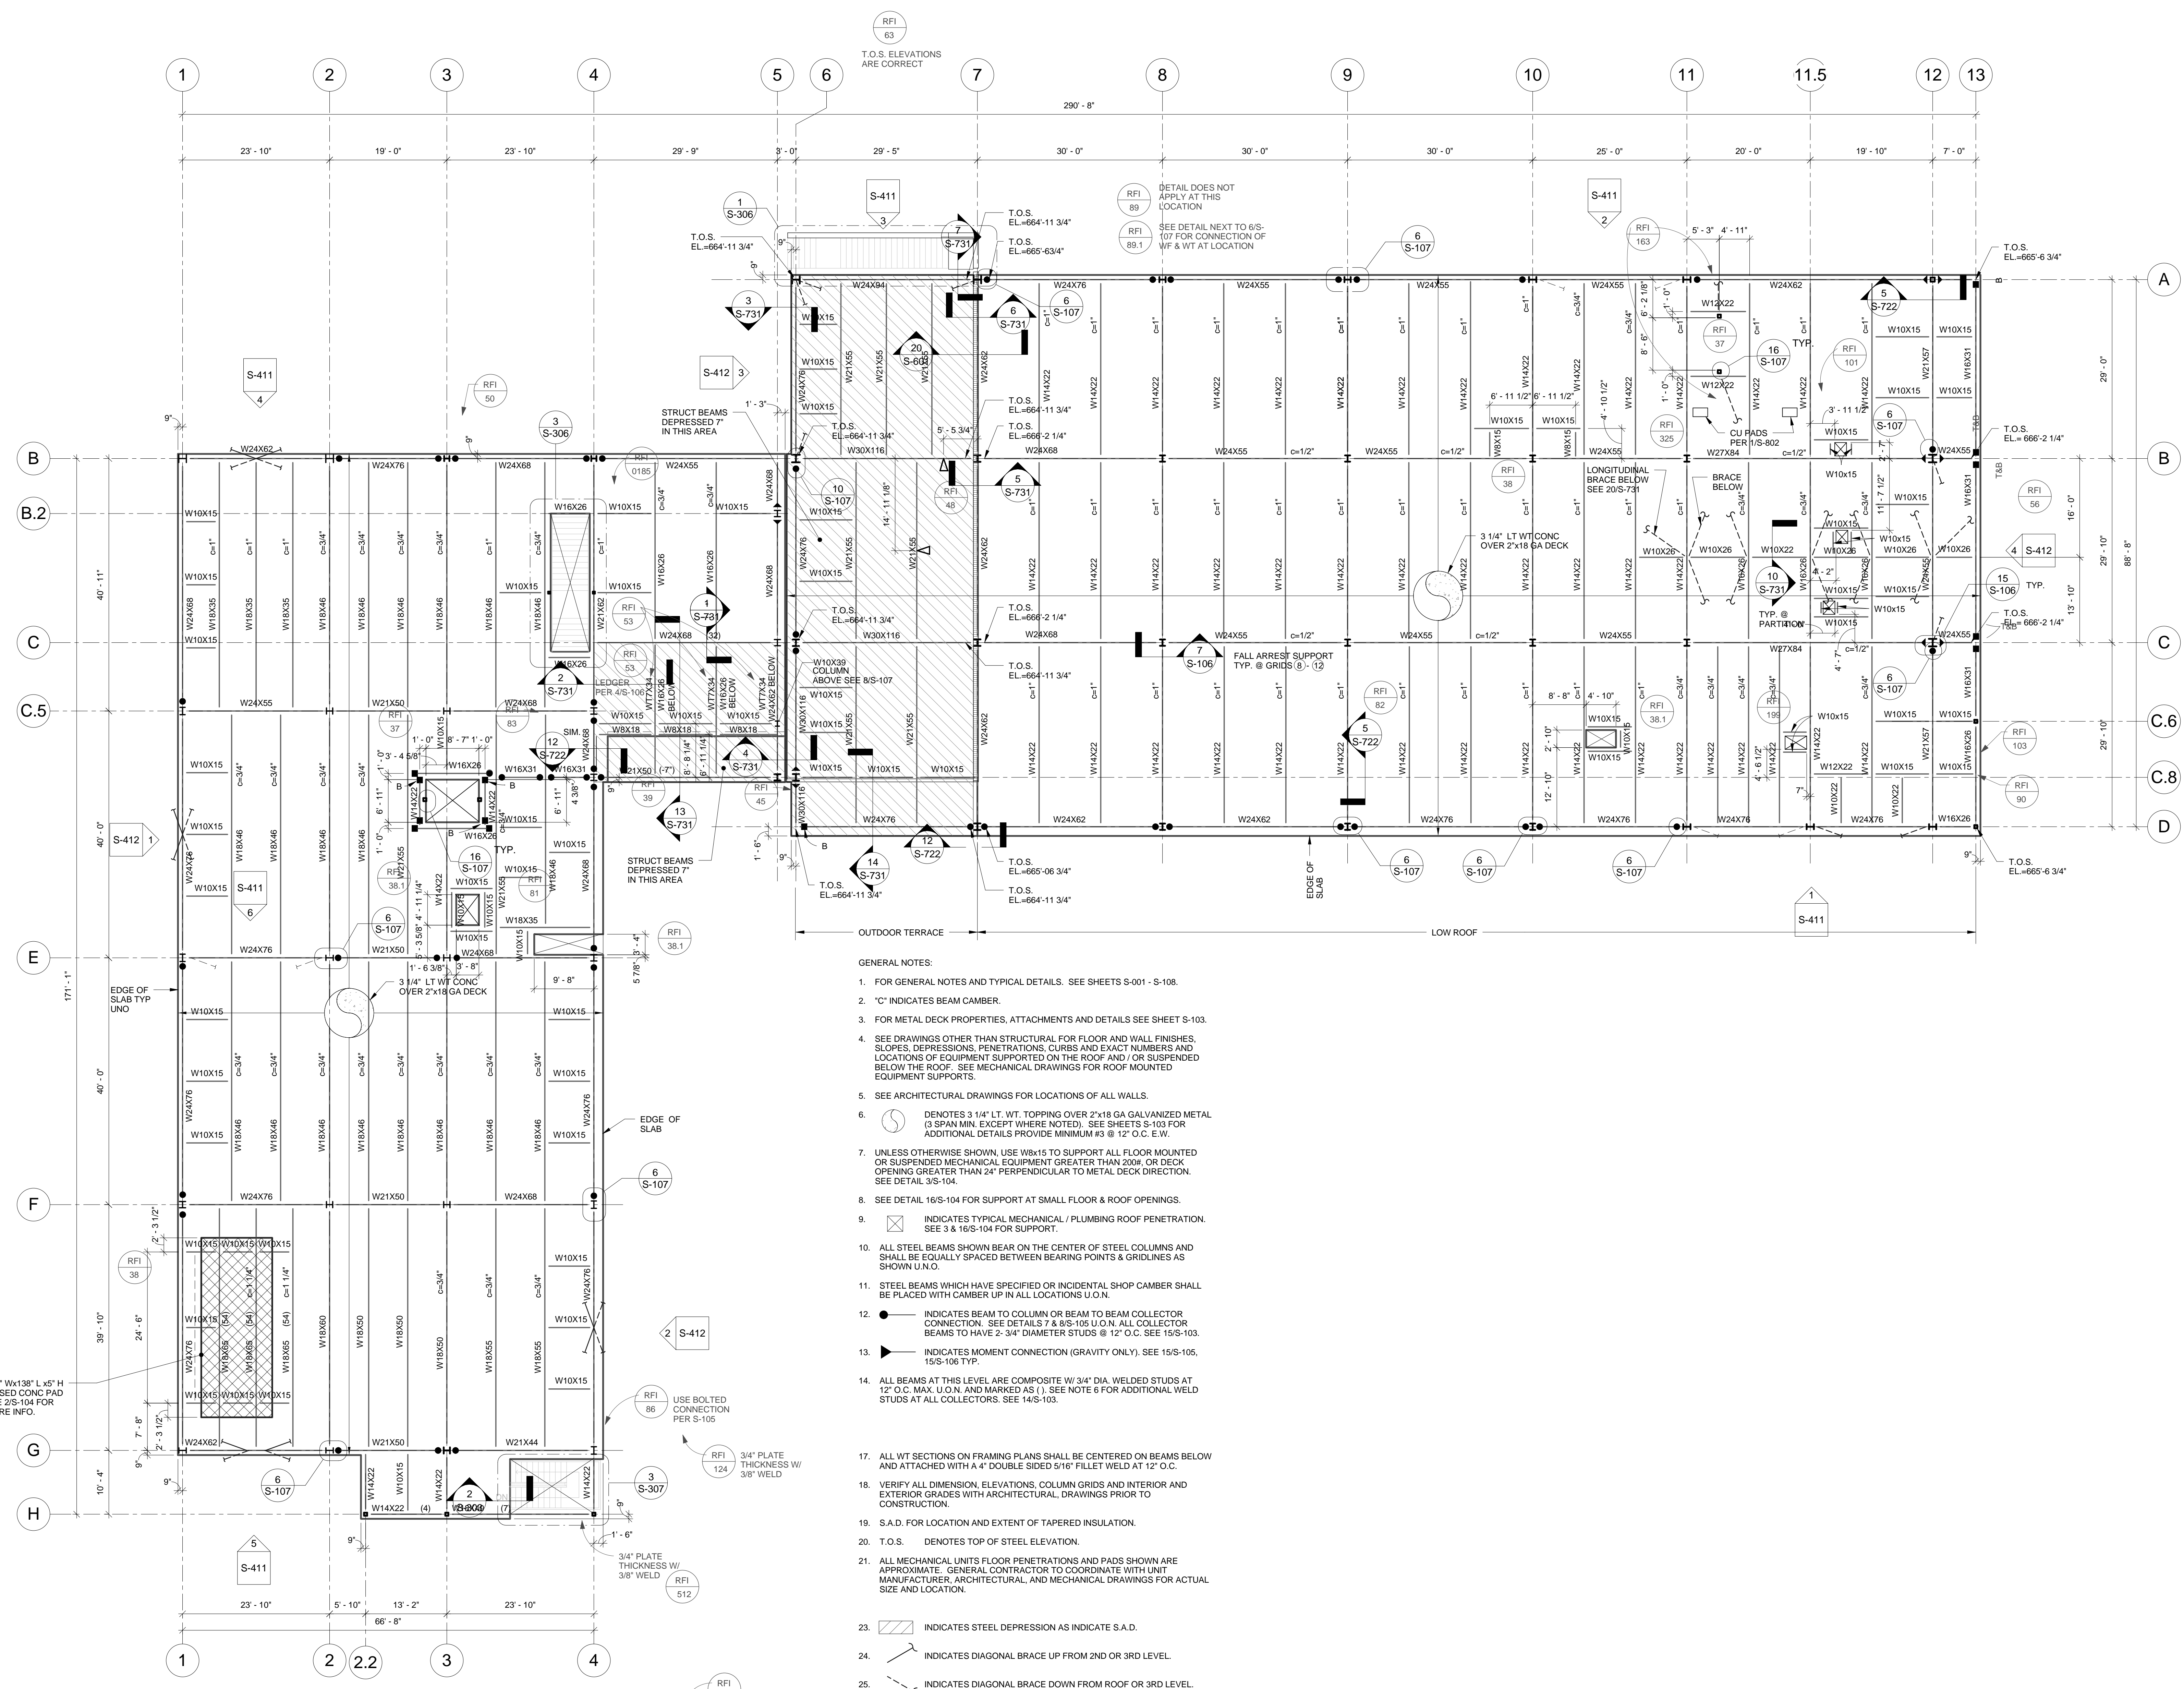

**1 LEVEL 3 FRAMING PLAN**  
SCALE: 3/32" = 1'-0"

- LEGEND**
- BOTTOM PL PER 1/S-105
  - TOP & BOTTOM PL PER 1/S-105
  - CONNECTION PER 1/S-105

- GENERAL NOTES:**
1. FOR GENERAL NOTES AND TYPICAL DETAILS. SEE SHEETS S-001 - S-108.
  2. "C" INDICATES BEAM CAMBER.
  3. FOR METAL DECK PROPERTIES, ATTACHMENTS AND DETAILS SEE SHEET S-103.
  4. SEE DRAWINGS OTHER THAN STRUCTURAL FOR FLOOR AND WALL FINISHES, SLOPES, DEPRESSIONS, PENETRATIONS, CURBS AND EXACT NUMBERS AND LOCATIONS OF EQUIPMENT SUPPORTED ON THE ROOF AND / OR SUSPENDED BELOW THE ROOF. SEE MECHANICAL DRAWINGS FOR ROOF MOUNTED EQUIPMENT SUPPORTS.
  5. SEE ARCHITECTURAL DRAWINGS FOR LOCATIONS OF ALL WALLS.
  - 6.
  7. UNLESS OTHERWISE SHOWN, USE W8x15 TO SUPPORT ALL FLOOR MOUNTED OR SUSPENDED MECHANICAL EQUIPMENT GREATER THAN 200#, OR DECK OPENINGS GREATER THAN 24\"/>
  8. SEE DETAIL 16/S-104 FOR SUPPORT AT SMALL FLOOR & ROOF OPENINGS.
  - 9.
  10. ALL STEEL BEAMS SHOWN BEAR ON THE CENTER OF STEEL COLUMNS AND SHALL BE EQUALLY SPACED BETWEEN BEARING POINTS & GRIDLINES AS SHOWN U.O.N.
  11. STEEL BEAMS WHICH HAVE SPECIFIED OR INCIDENTAL SHOP CAMBER SHALL BE PLACED WITH CAMBER UP IN ALL LOCATIONS U.O.N.
  - 12.
  - 13.
  14. ALL BEAMS AT THIS LEVEL ARE COMPOSITE W 3/4\"/>
  17. ALL WT SECTIONS ON FRAMING PLANS SHALL BE CENTERED ON BEAMS BELOW AND ATTACHED WITH A 4\"/>
  18. VERIFY ALL DIMENSION, ELEVATIONS, COLUMN GRIDS AND INTERIOR AND EXTERIOR GRADES WITH ARCHITECTURAL DRAWINGS PRIOR TO CONSTRUCTION.
  19. S.A.D. FOR LOCATION AND EXTENT OF TAPERED INSULATION.
  20. T.O.S. DENOTES TOP OF STEEL ELEVATION.
  21. ALL MECHANICAL UNITS FLOOR PENETRATIONS AND PADS SHOWN ARE APPROXIMATE. GENERAL CONTRACTOR TO COORDINATE WITH UNIT MANUFACTURER, ARCHITECTURAL, AND MECHANICAL DRAWINGS FOR ACTUAL SIZE AND LOCATION.
  - 23.
  - 24.
  - 25.
  26. PROVIDE 2#W10x22 TEMPORARY SUPPORT BEAMS AT ELEV. #1. NOT SHOWN ON PLANS.
  - 27.
  - 28.
  29. SEE S-204 FOR ADDITIONAL NOTES RELATED TO ROOF AREAS.
  - 30.

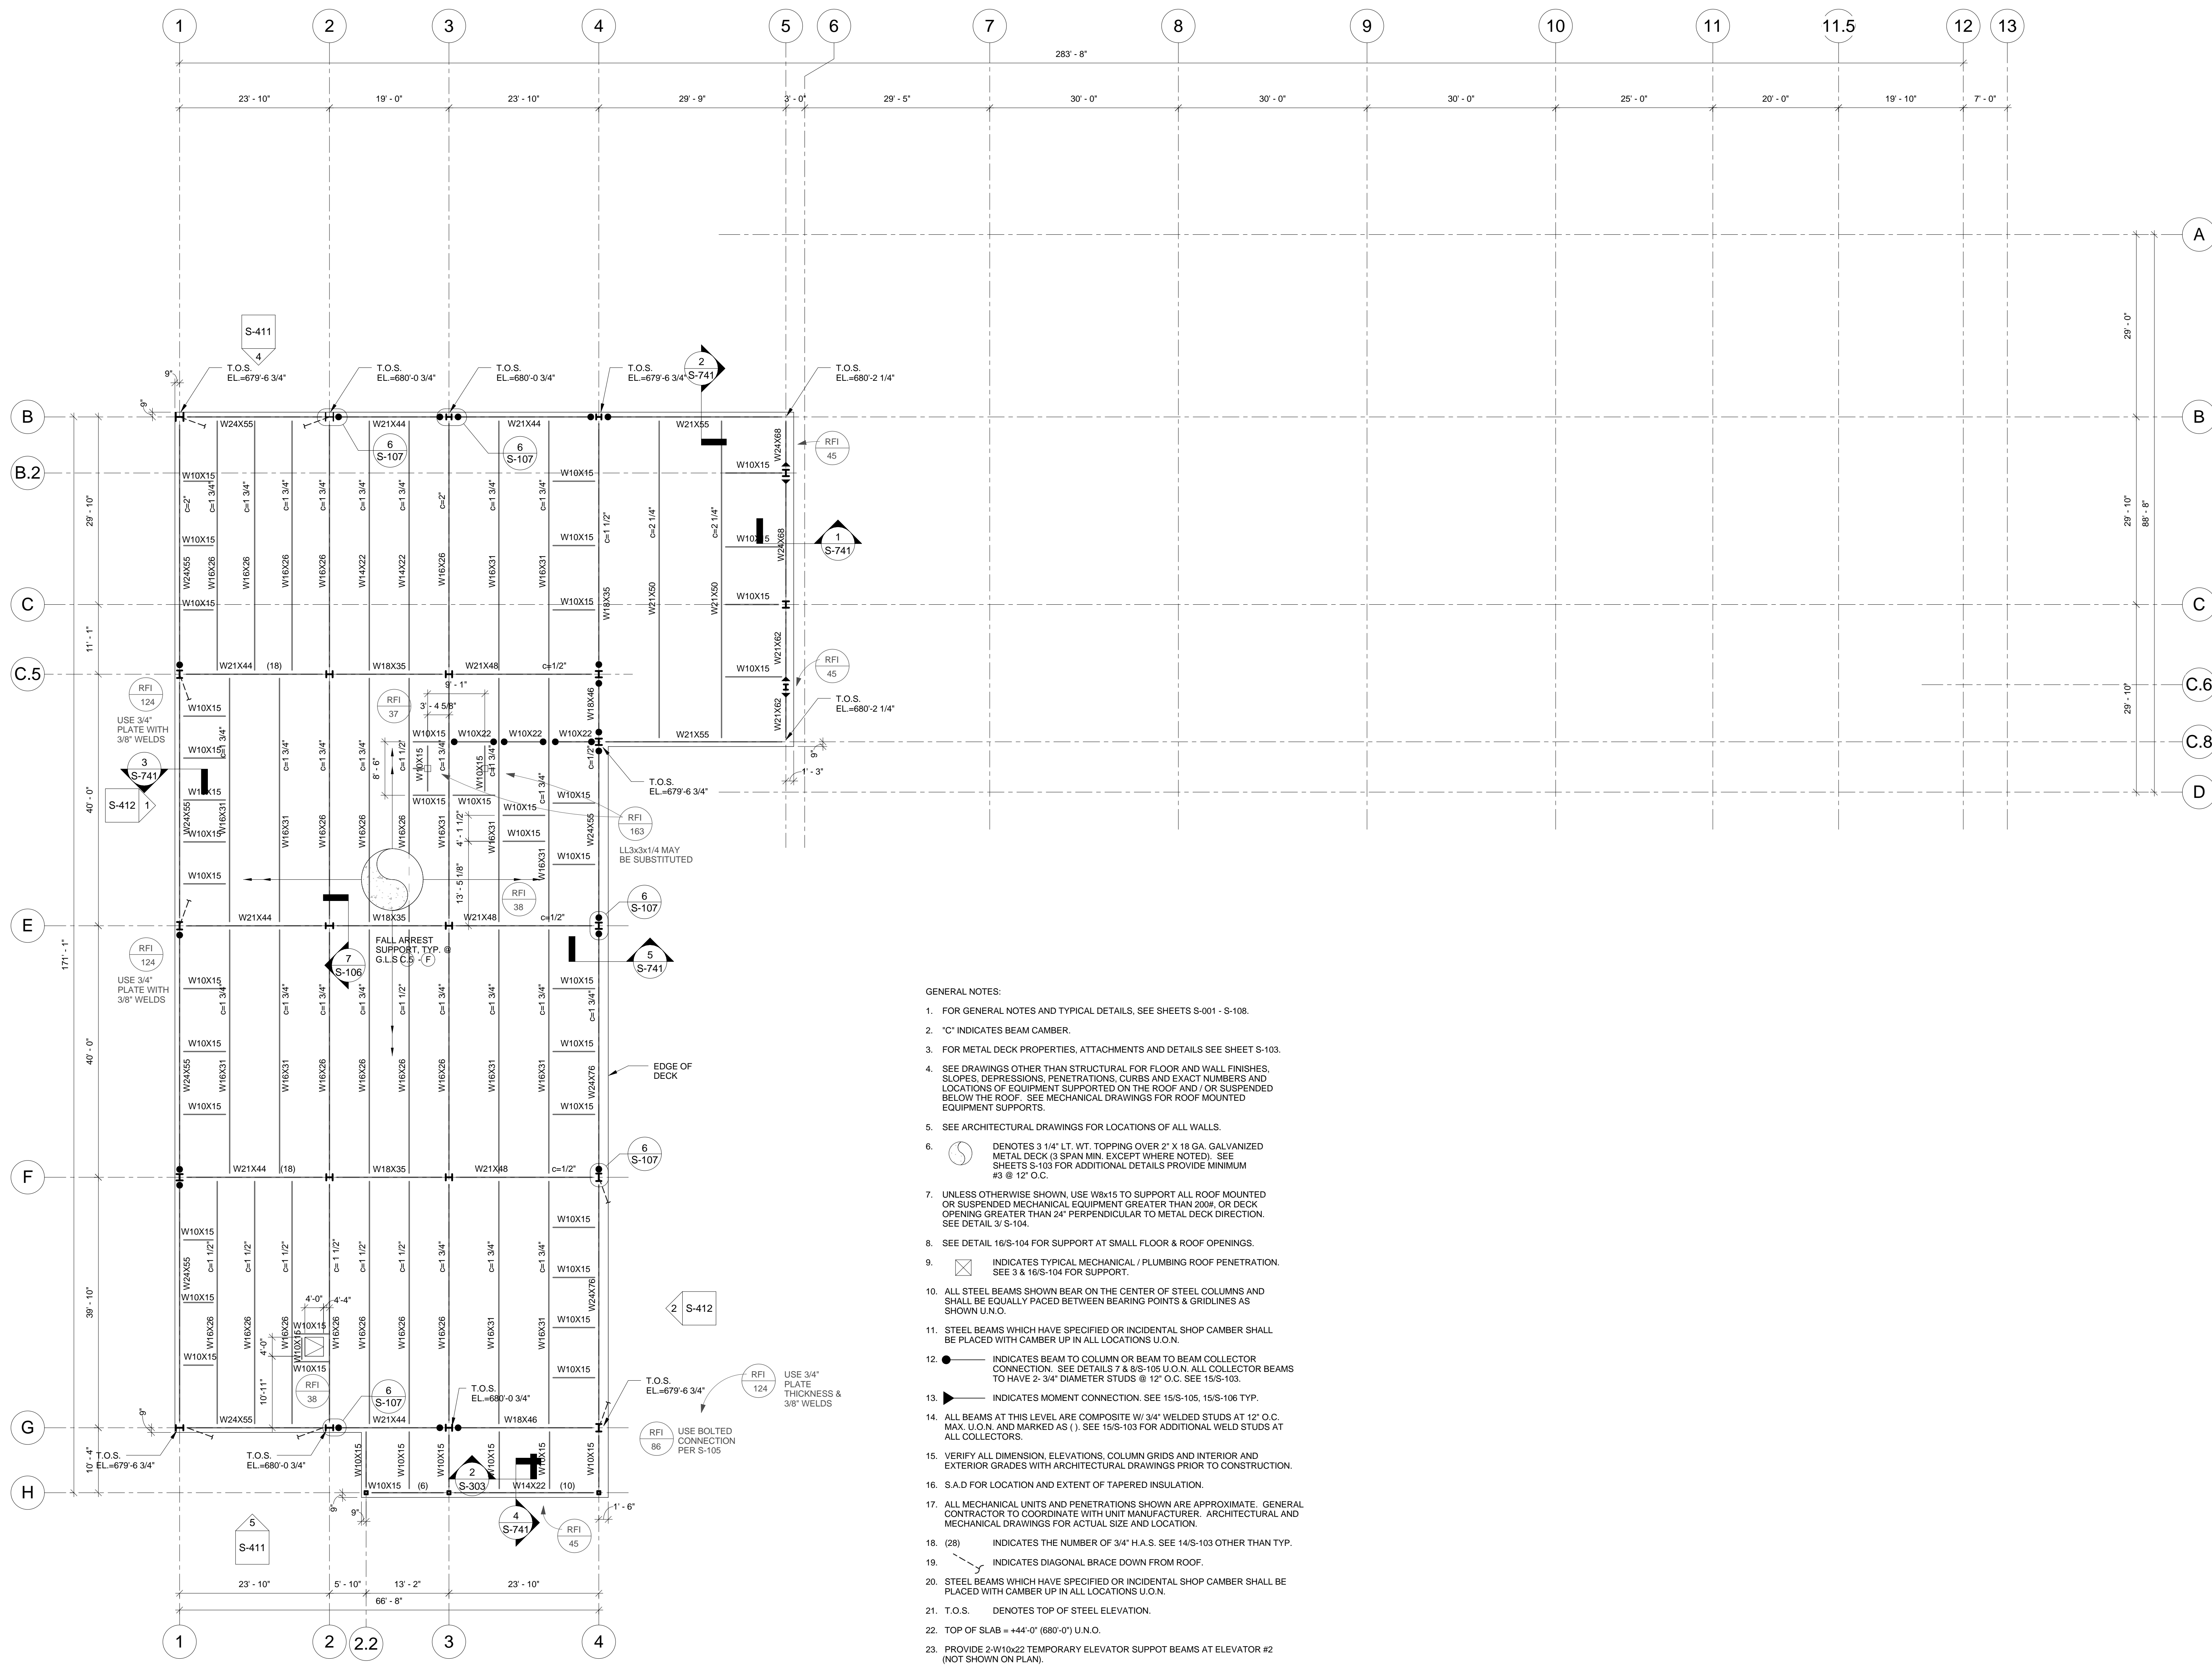

- GENERAL NOTES:**
- FOR GENERAL NOTES AND TYPICAL DETAILS, SEE SHEETS S-001 - S-108.
  - "C" INDICATES BEAM CAMBER.
  - FOR METAL DECK PROPERTIES, ATTACHMENTS AND DETAILS SEE SHEET S-103.
  - SEE DRAWINGS OTHER THAN STRUCTURAL FOR FLOOR AND WALL FINISHES, SLOPES, DEPRESSIONS, PENETRATIONS, CURBS AND EXACT NUMBERS AND LOCATIONS OF EQUIPMENT SUPPORTED ON THE ROOF AND/OR SUSPENDED BELOW THE ROOF. SEE MECHANICAL DRAWINGS FOR ROOF MOUNTED EQUIPMENT SUPPORTS.
  - SEE ARCHITECTURAL DRAWINGS FOR LOCATIONS OF ALL WALLS.
  - DENOTES 3 1/4" LT. WT. TOPPING OVER 2" X 18 GA. GALVANIZED METAL DECK (3 SPAN MIN. EXCEPT WHERE NOTED). SEE SHEETS S-103 FOR ADDITIONAL DETAILS PROVIDE MINIMUM #3 @ 12" O.C.
  - UNLESS OTHERWISE SHOWN USE W16X15 TO SUPPORT ALL ROOF MOUNTED OR SUSPENDED MECHANICAL EQUIPMENT GREATER THAN 200#, OR DECK OPENING GREATER THAN 24" PERPENDICULAR TO METAL DECK DIRECTION. SEE DETAIL 3 S-104.
  - SEE DETAIL 16S-104 FOR SUPPORT AT SMALL FLOOR & ROOF OPENINGS.
  - INDICATES TYPICAL MECHANICAL / PLUMBING ROOF PENETRATION. SEE 3 & 16S-104 FOR SUPPORT.
  - ALL STEEL BEAMS SHOWN BEAR ON THE CENTER OF STEEL COLUMNS AND SHALL BE EQUALLY PAVED BETWEEN BEARING POINTS & GRIDLINES AS SHOWN U.O.N.
  - STEEL BEAMS WHICH HAVE SPECIFIED OR INCIDENTAL SHOP CAMBER SHALL BE PLACED WITH CAMBER UP IN ALL LOCATIONS U.O.N.
  - INDICATES BEAM TO COLUMN OR BEAM TO BEAM COLLECTOR CONNECTION. SEE DETAILS 7 & 8 S-105 U.O.N. ALL COLLECTOR BEAMS TO HAVE 2-3/4" DIAMETER STUDS @ 12" O.C. SEE 15S-103.
  - INDICATES MOMENT CONNECTION. SEE 15S-105, 15S-106 TYP.
  - ALL BEAMS AT THIS LEVEL ARE COMPOSITE W/ 3/4" WELDED STUDS AT 12" O.C. MAX. U.O.N. AND MARKED AS ( ). SEE 15S-103 FOR ADDITIONAL WELD STUDS AT ALL COLLECTORS.
  - VERIFY ALL DIMENSION, ELEVATIONS, COLUMN GRIDS AND INTERIOR AND EXTERIOR GRADES WITH ARCHITECTURAL DRAWINGS PRIOR TO CONSTRUCTION.
  - S.A.D FOR LOCATION AND EXTENT OF TAPERED INSULATION.
  - ALL MECHANICAL UNITS AND PENETRATIONS SHOWN ARE APPROXIMATE. GENERAL CONTRACTOR TO COORDINATE WITH UNIT MANUFACTURER. ARCHITECTURAL AND MECHANICAL DRAWINGS FOR ACTUAL SIZE AND LOCATION.
  - (28) INDICATES THE NUMBER OF 3/4" H.A.S. SEE 14S-103 OTHER THAN TYP.
  - INDICATES DIAGONAL BRACE DOWN FROM ROOF.
  - STEEL BEAMS WHICH HAVE SPECIFIED OR INCIDENTAL SHOP CAMBER SHALL BE PLACED WITH CAMBER UP IN ALL LOCATIONS U.O.N.
  - T.O.S. DENOTES TOP OF STEEL ELEVATION.
  - TOP OF SLAB = +44'-0" (680'-0") U.O.N.
  - PROVIDE 2-W10X22 TEMPORARY ELEVATOR SUPPOT BEAMS AT ELEVATOR #2 (NOT SHOWN ON PLAN).

**1 ROOF FRAMING PLAN**  
SCALE: 3/32" = 1'-0"





















**PROJECT RECORD SET**

   **SKYLINE COLLEGE**  
SAN MATEO COUNTY  
COMMUNITY COLLEGE  
DISTRICT

**CIP2 DESIGN-BUILD PROJECT BUILDING 4**





















PROJECT NO.: 07055.00 DRAWN BY: AY  
DATE: 05.15.2009 CHECKED BY: CB  
SCALE: 3/32" = 1'-0"

**ROOF FRAMING PLAN**

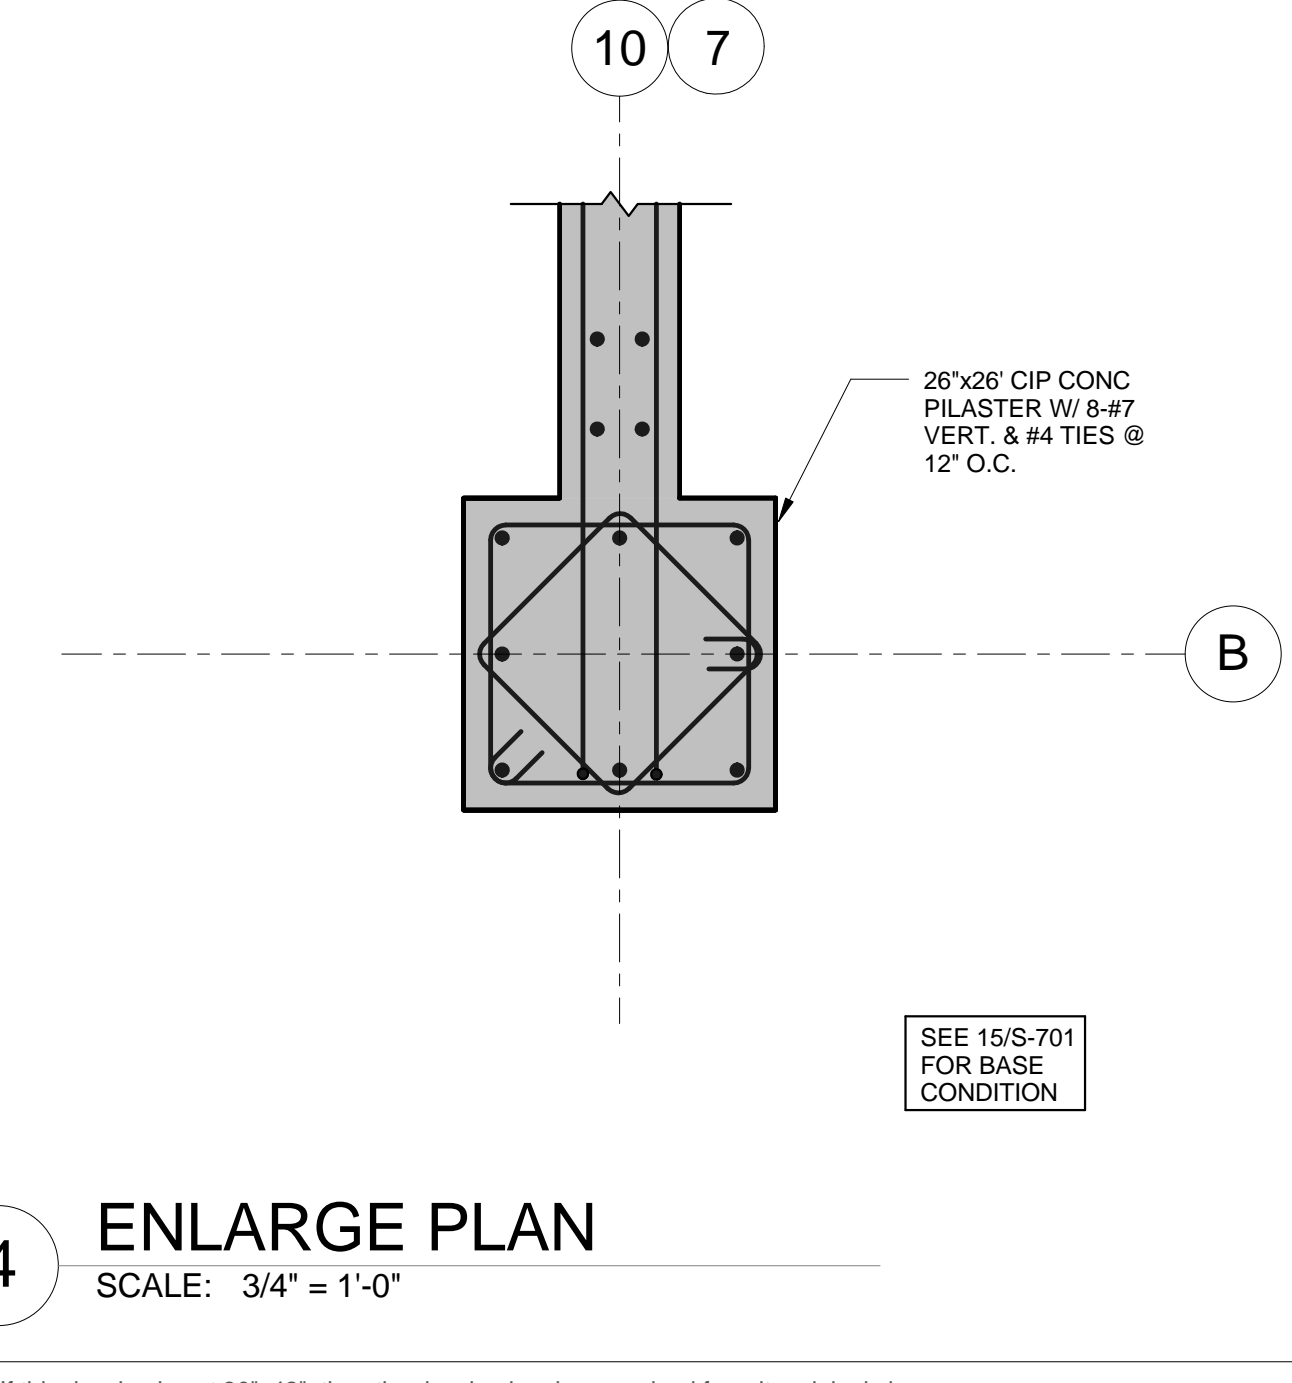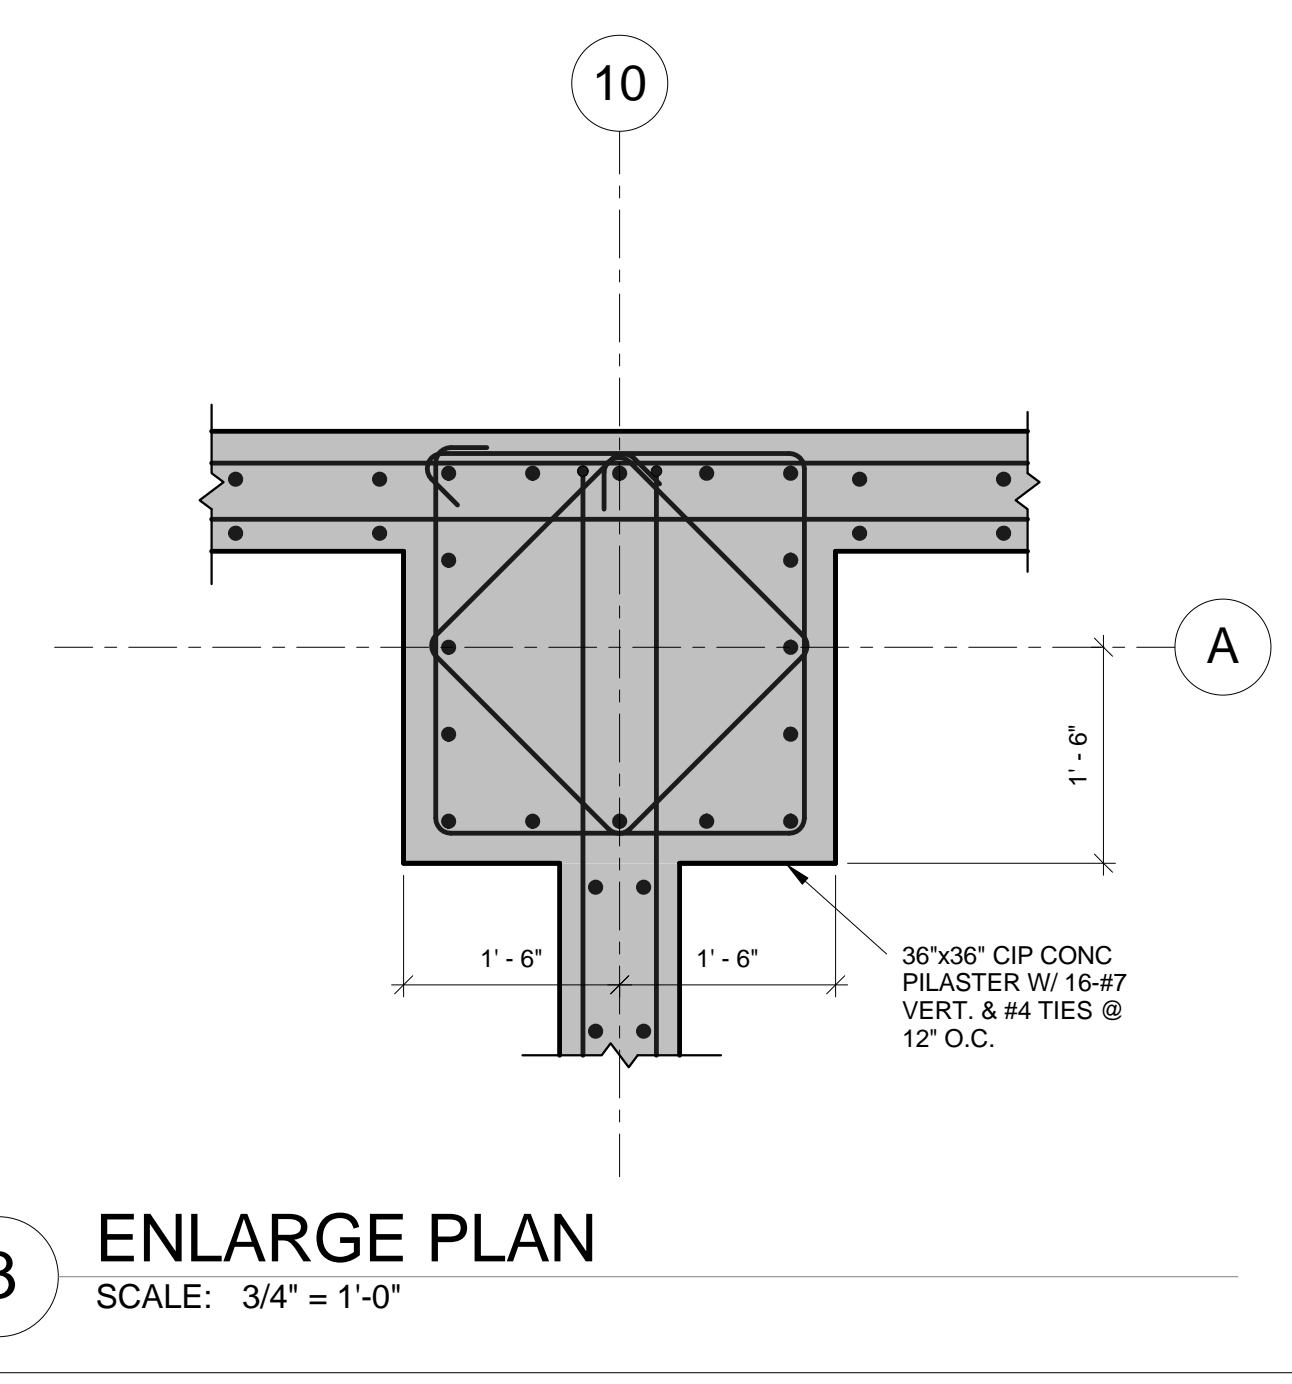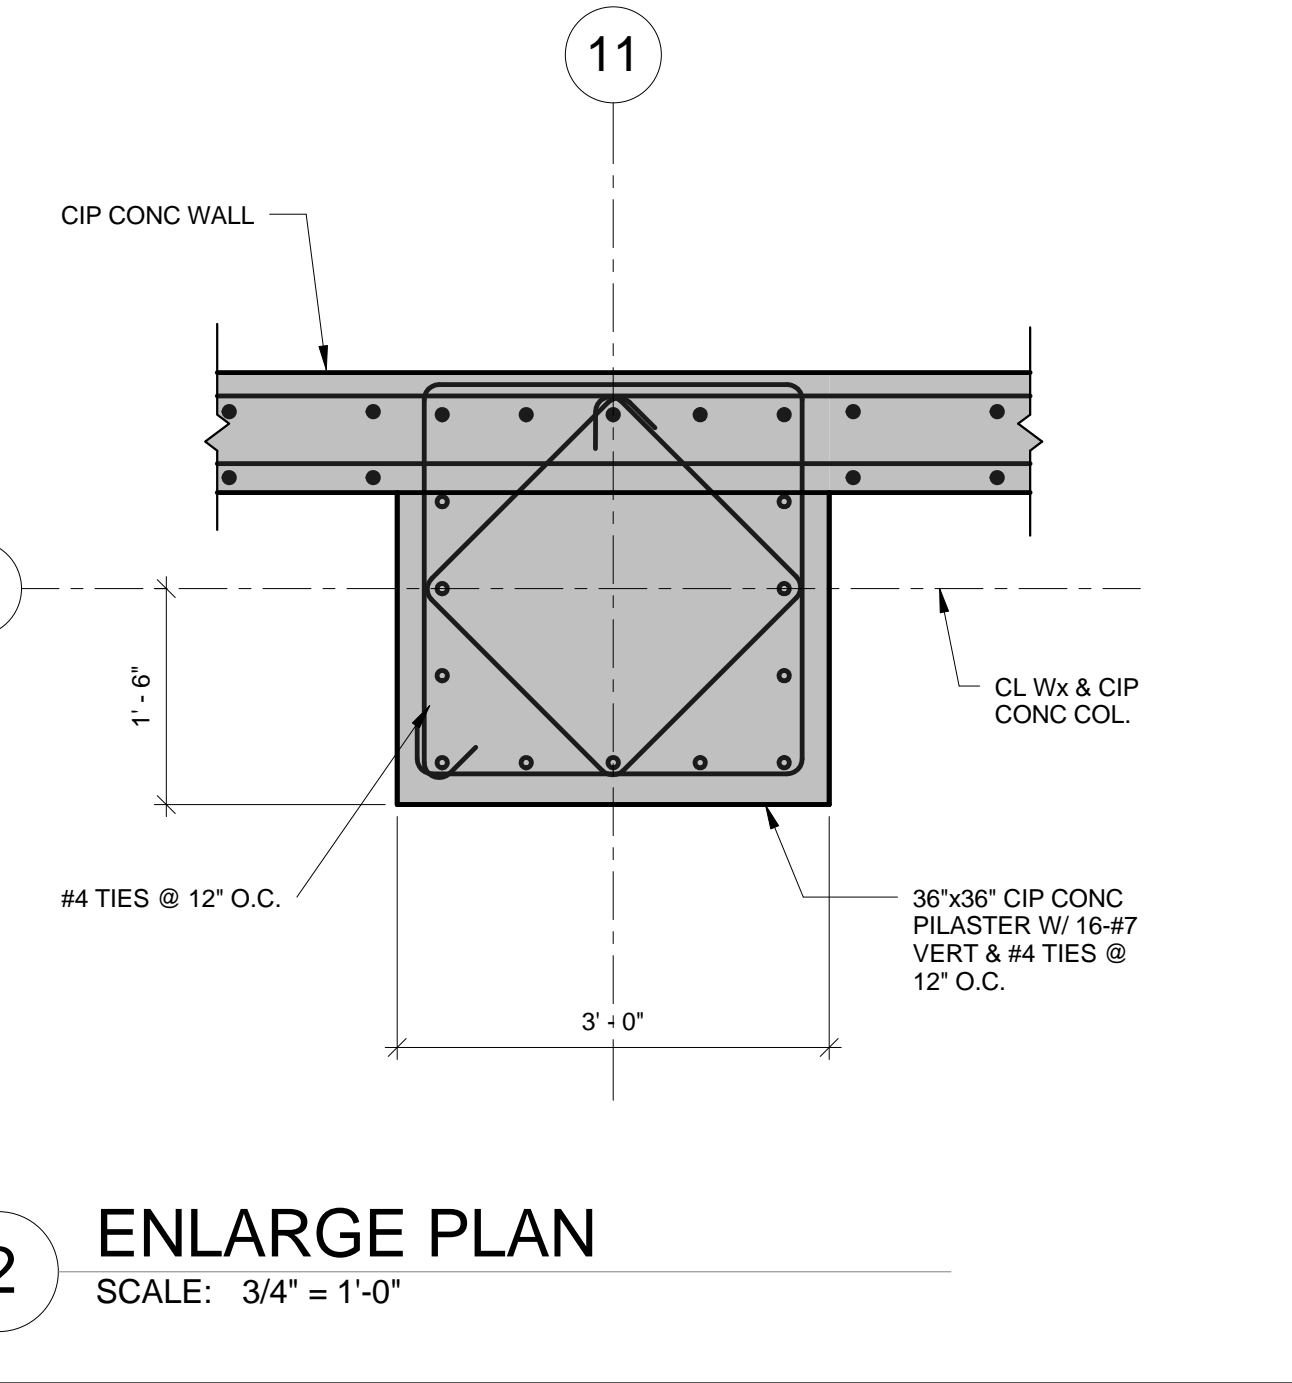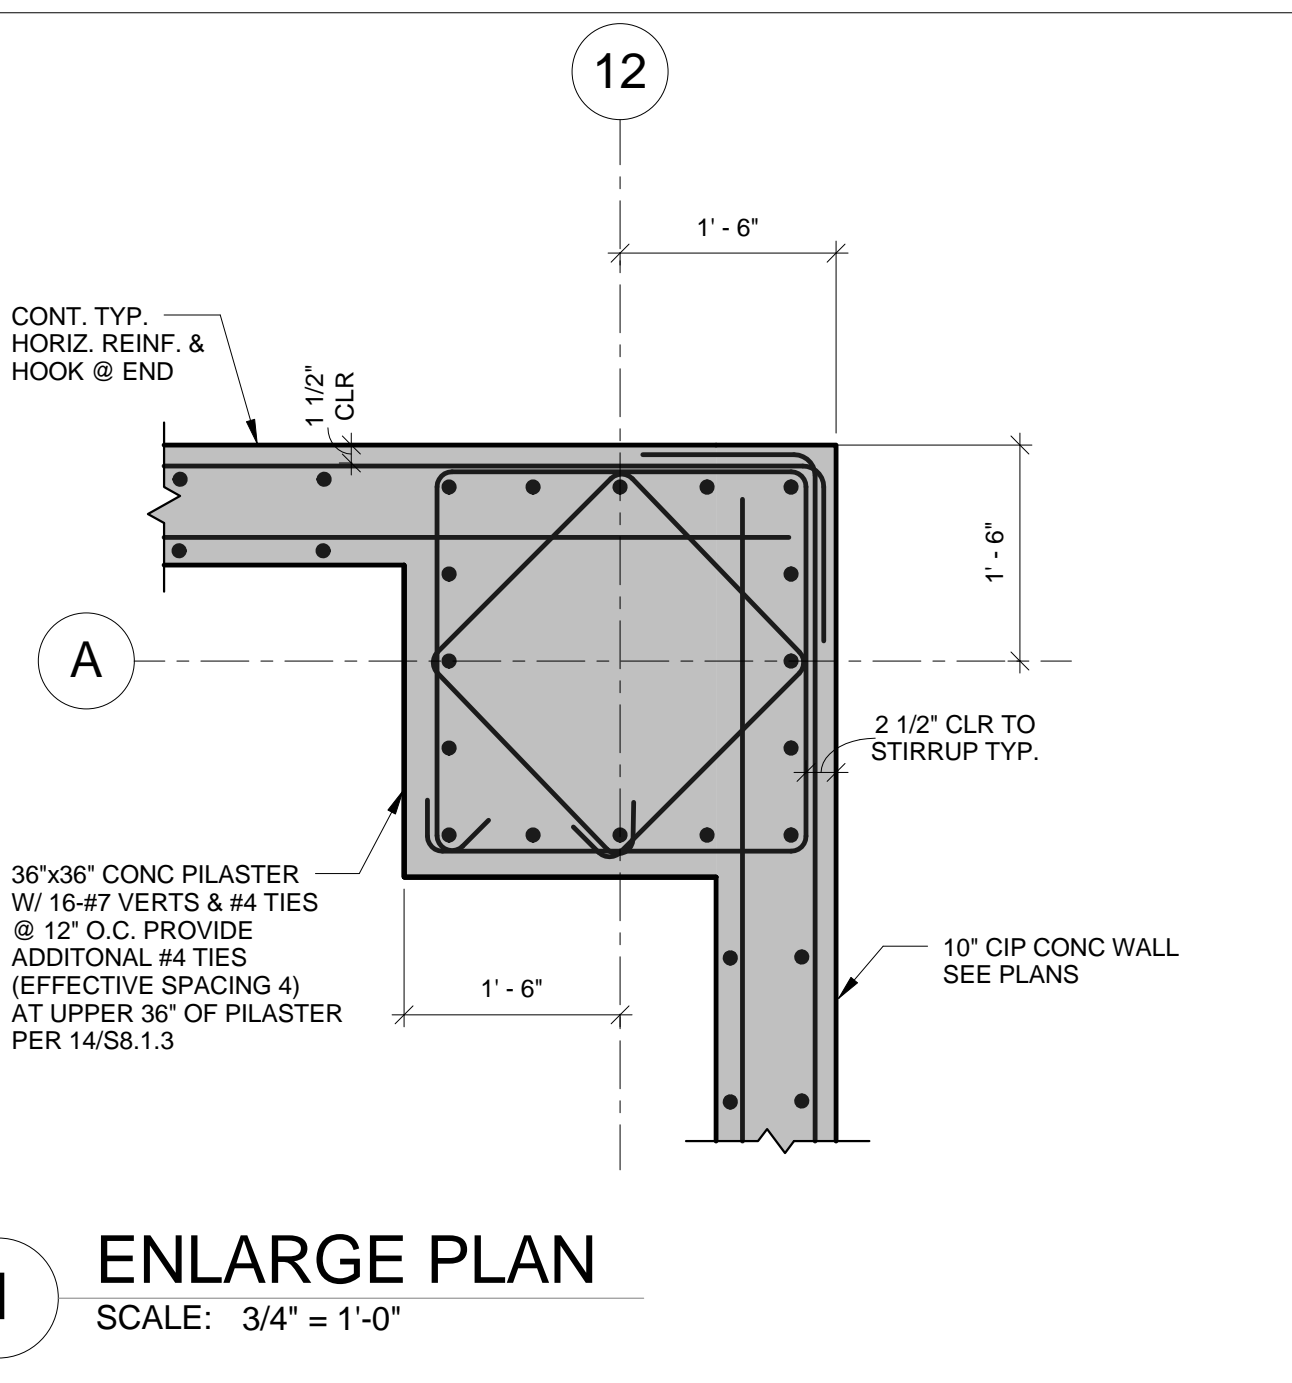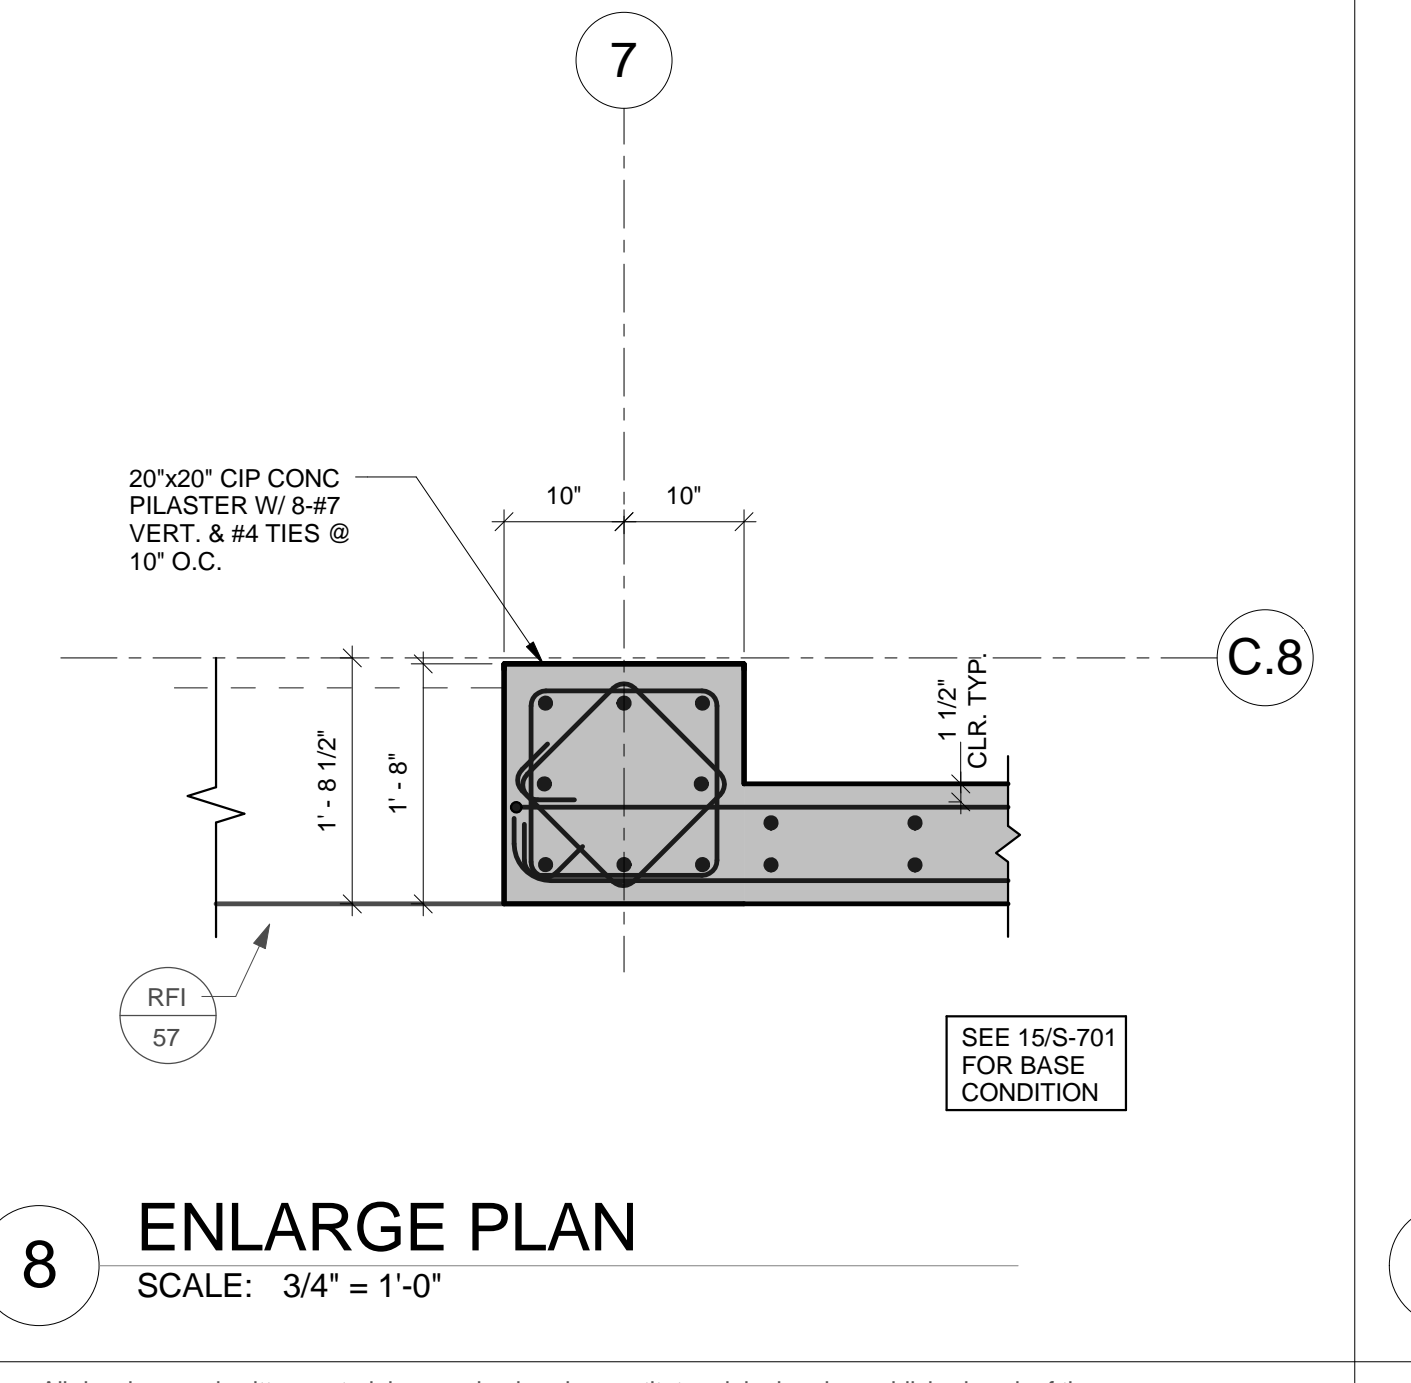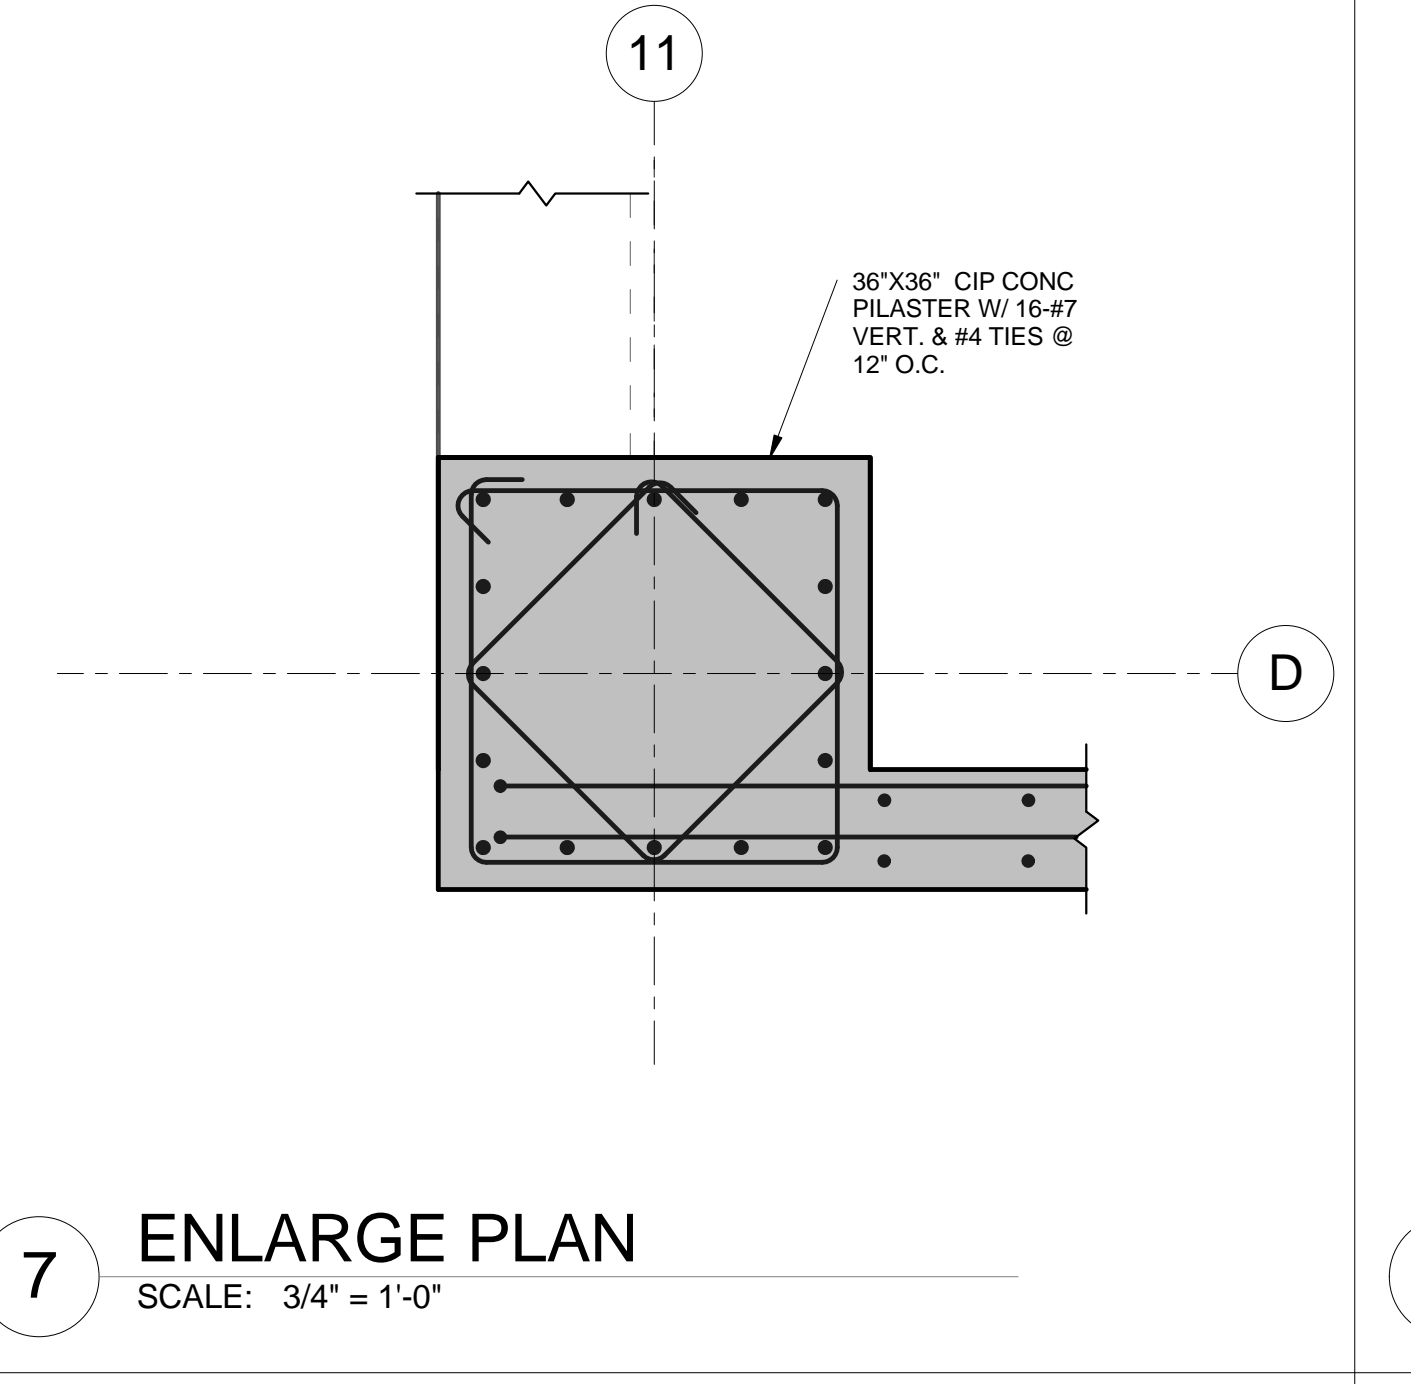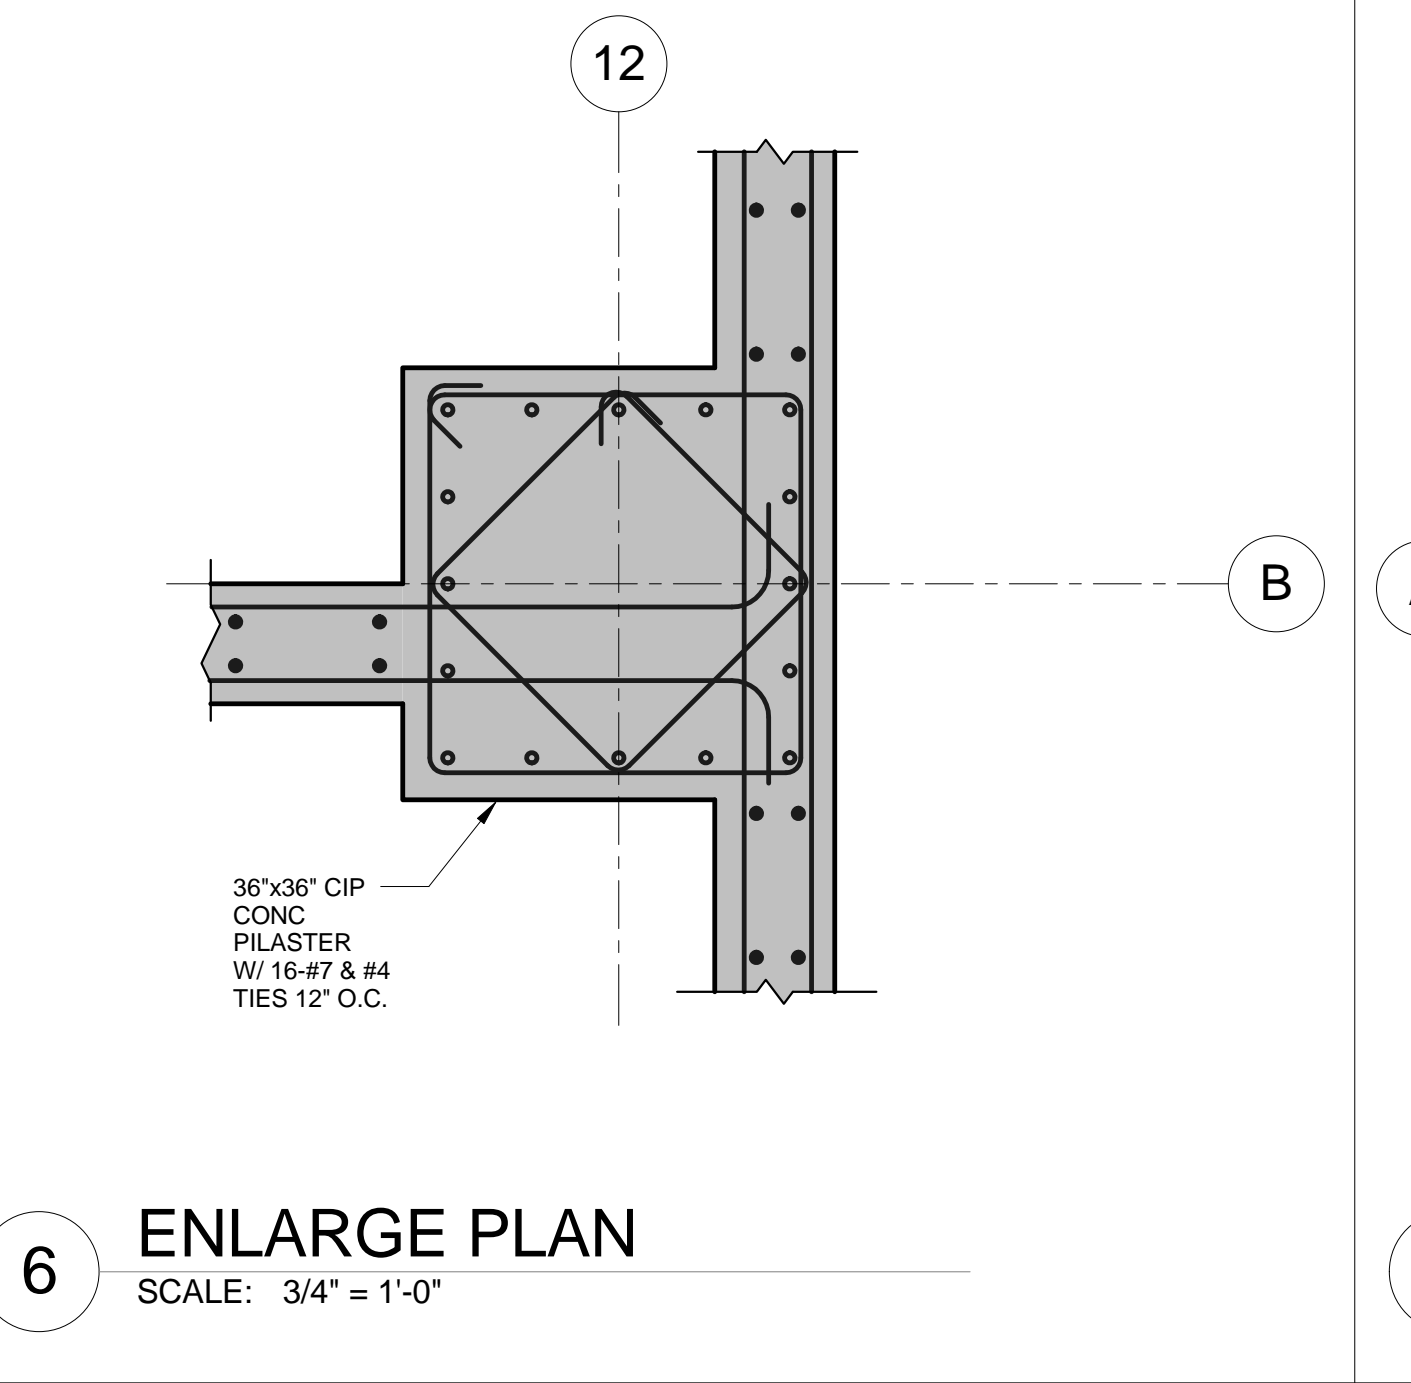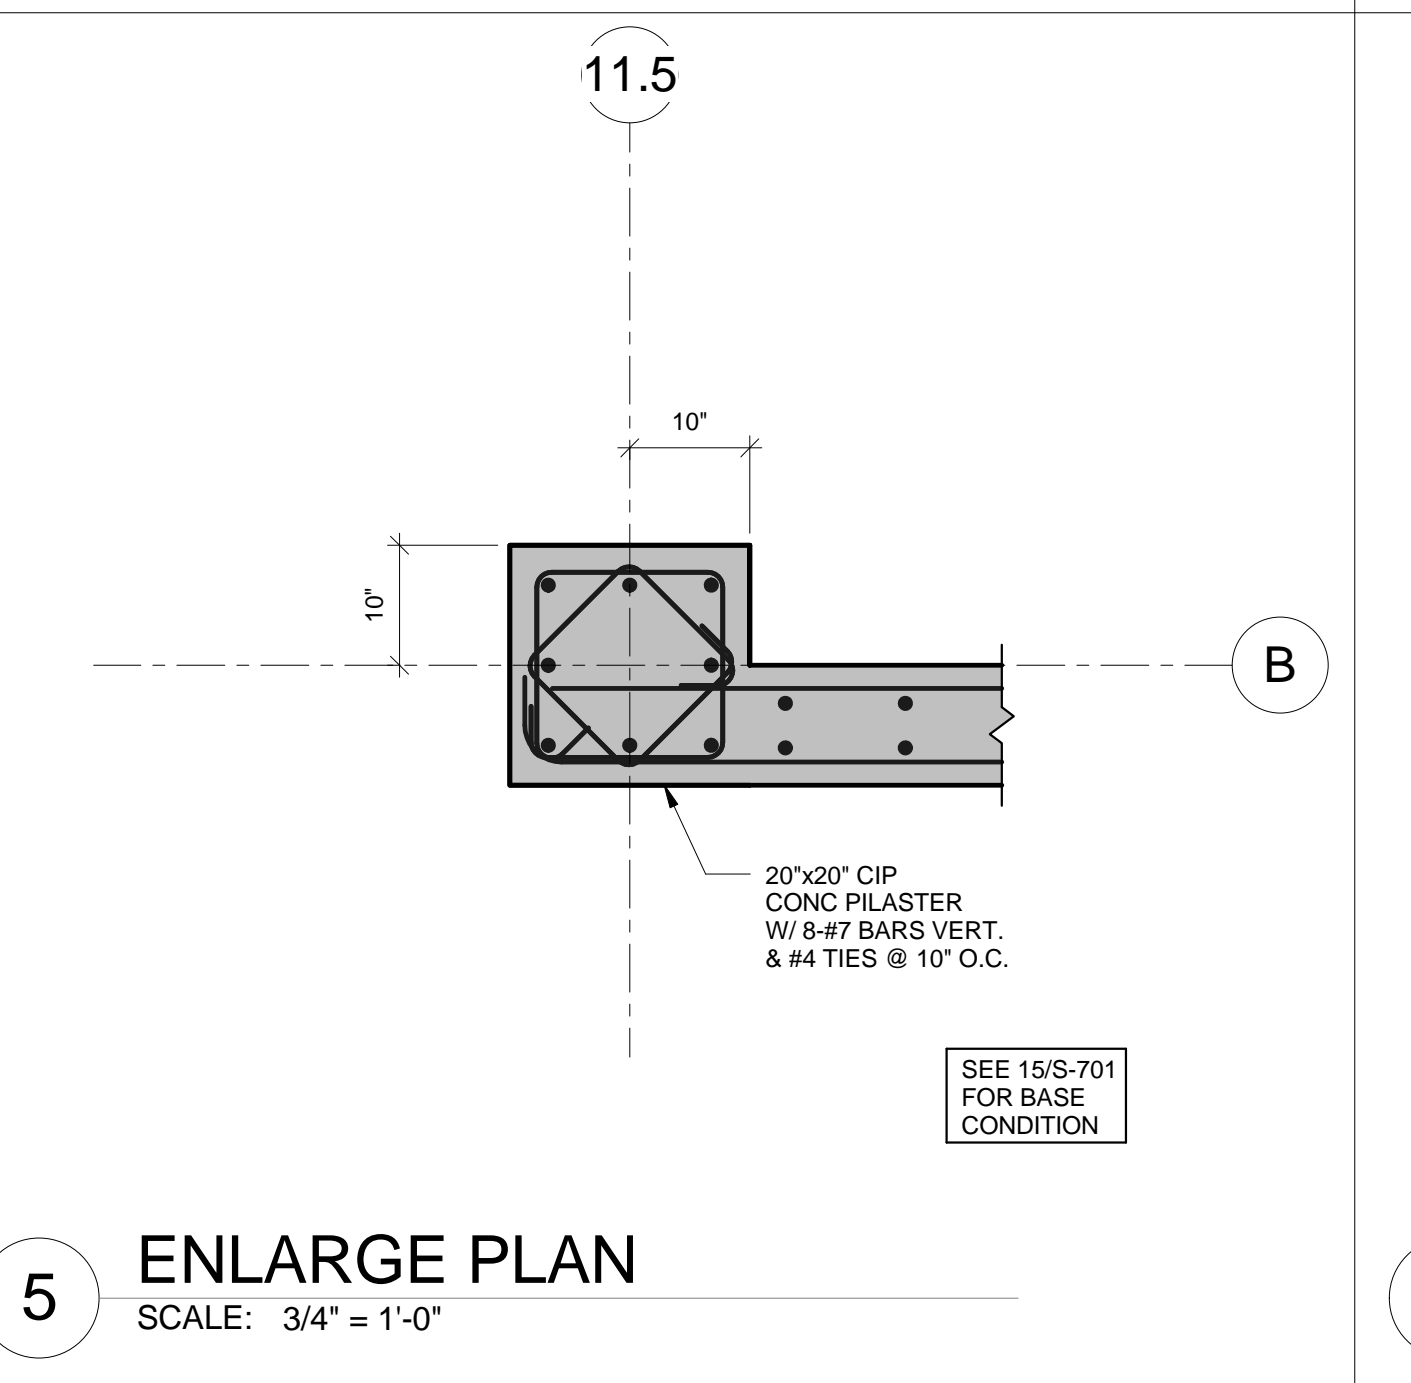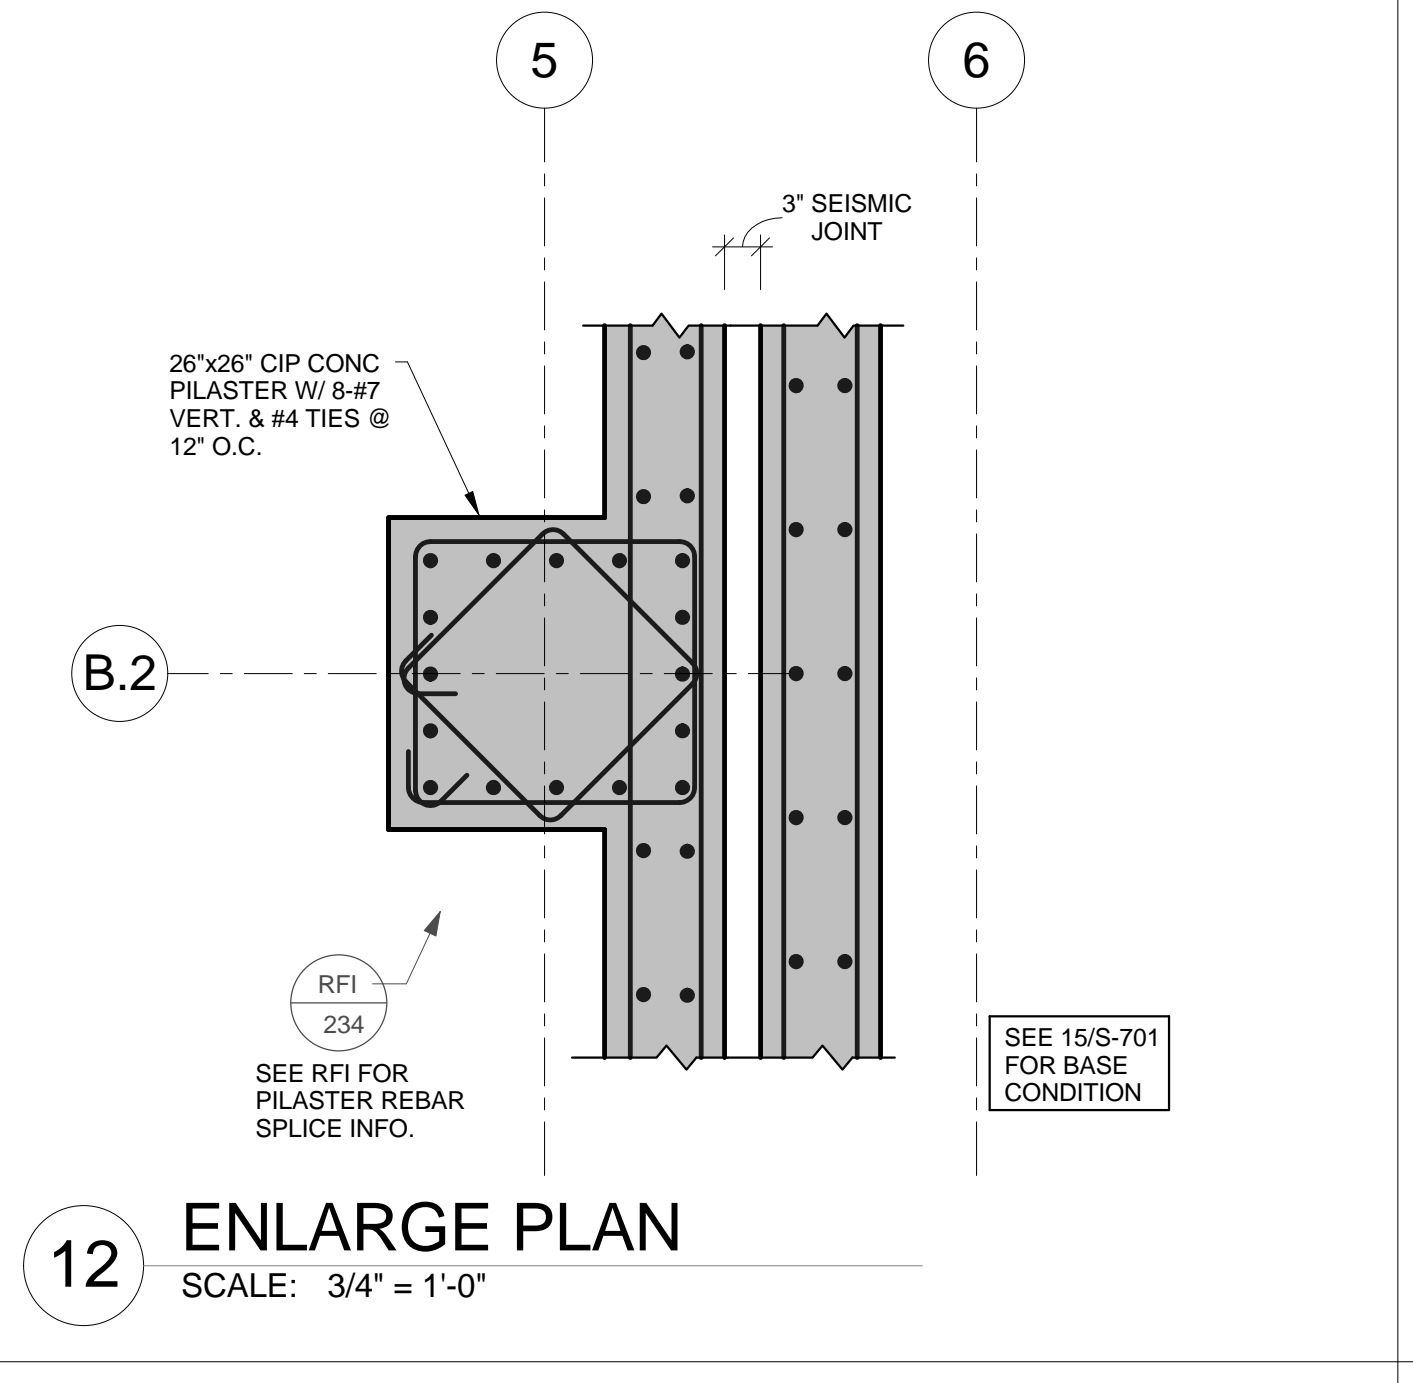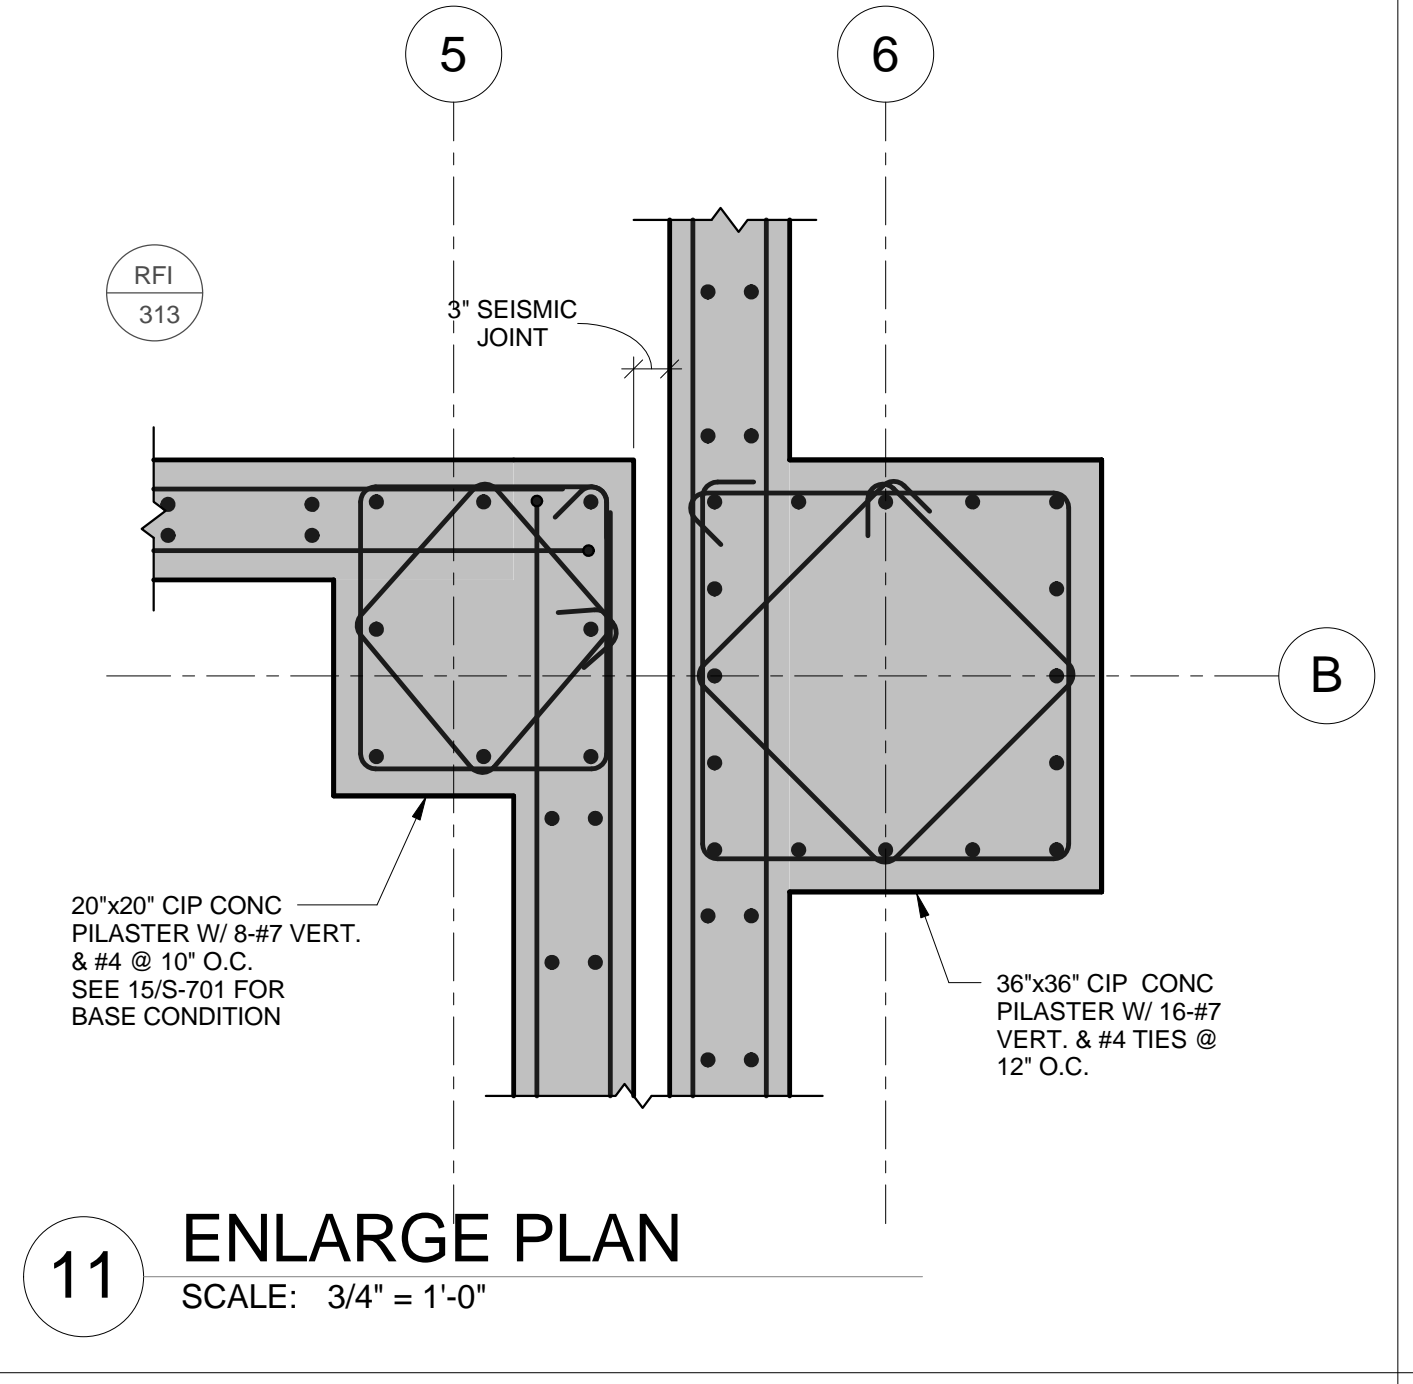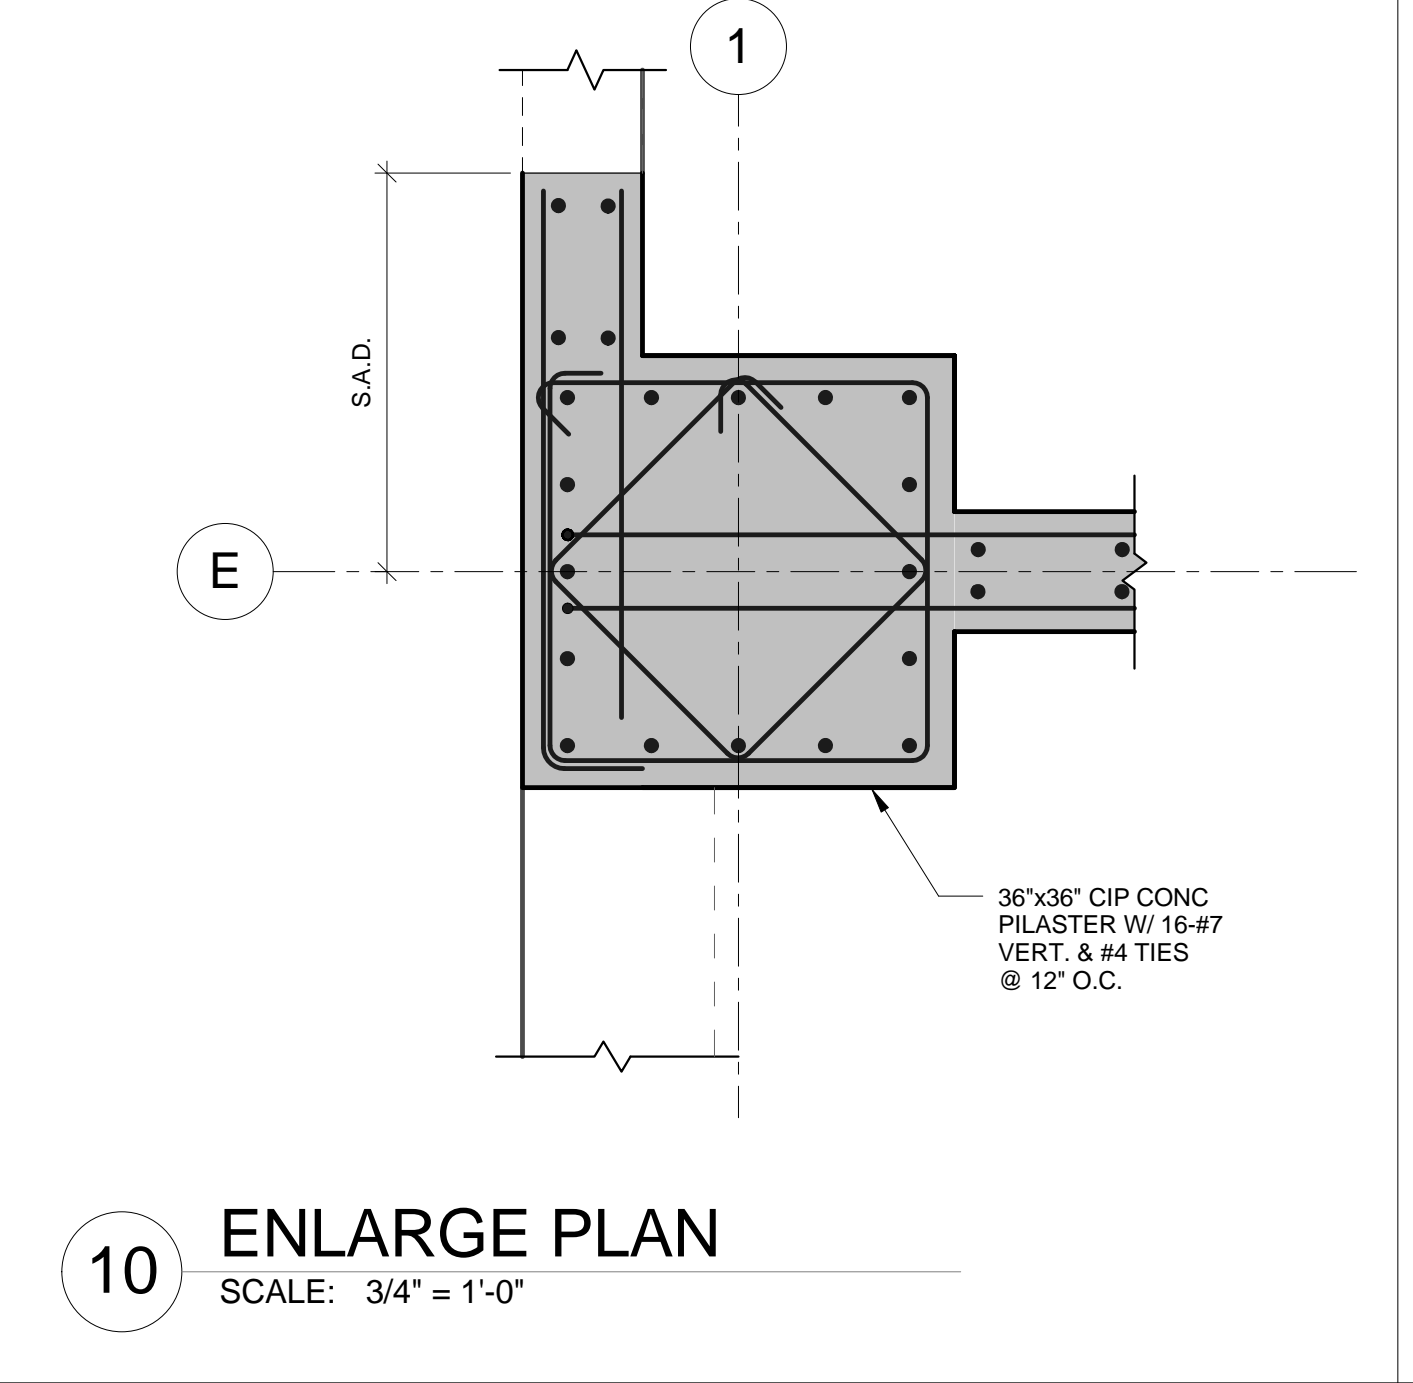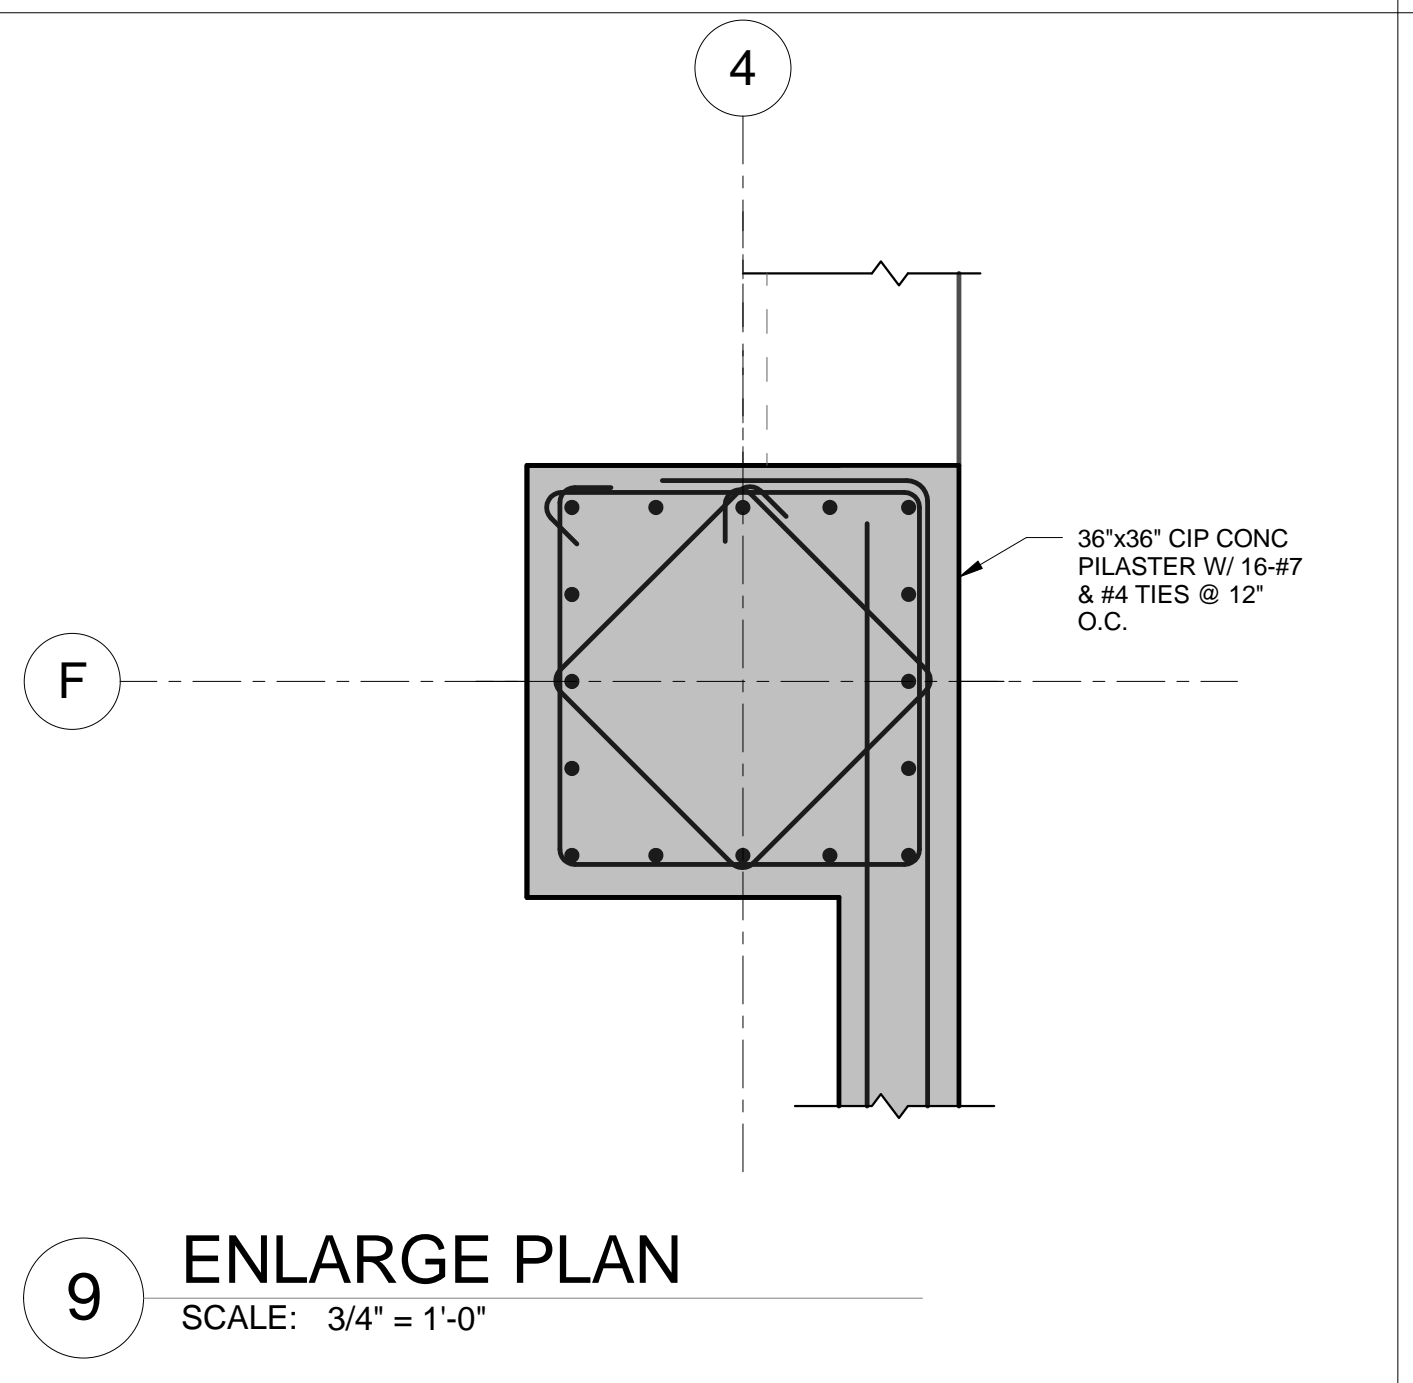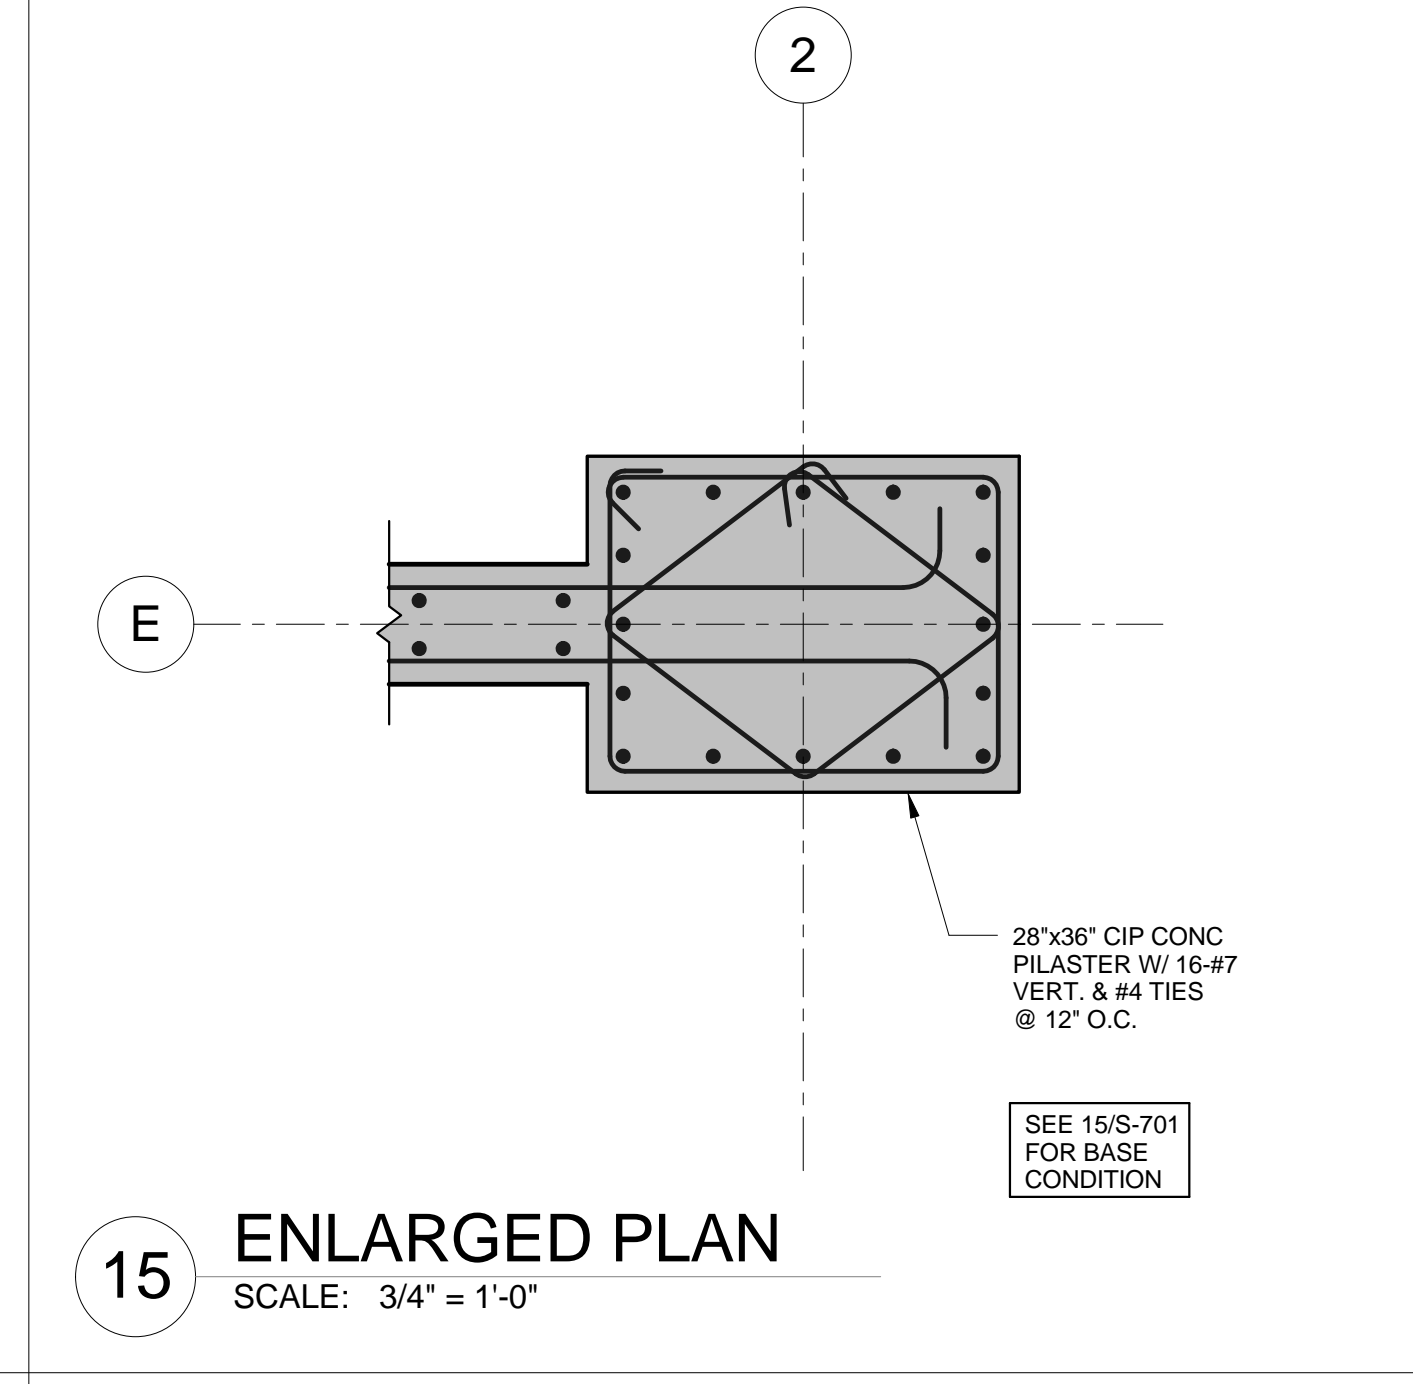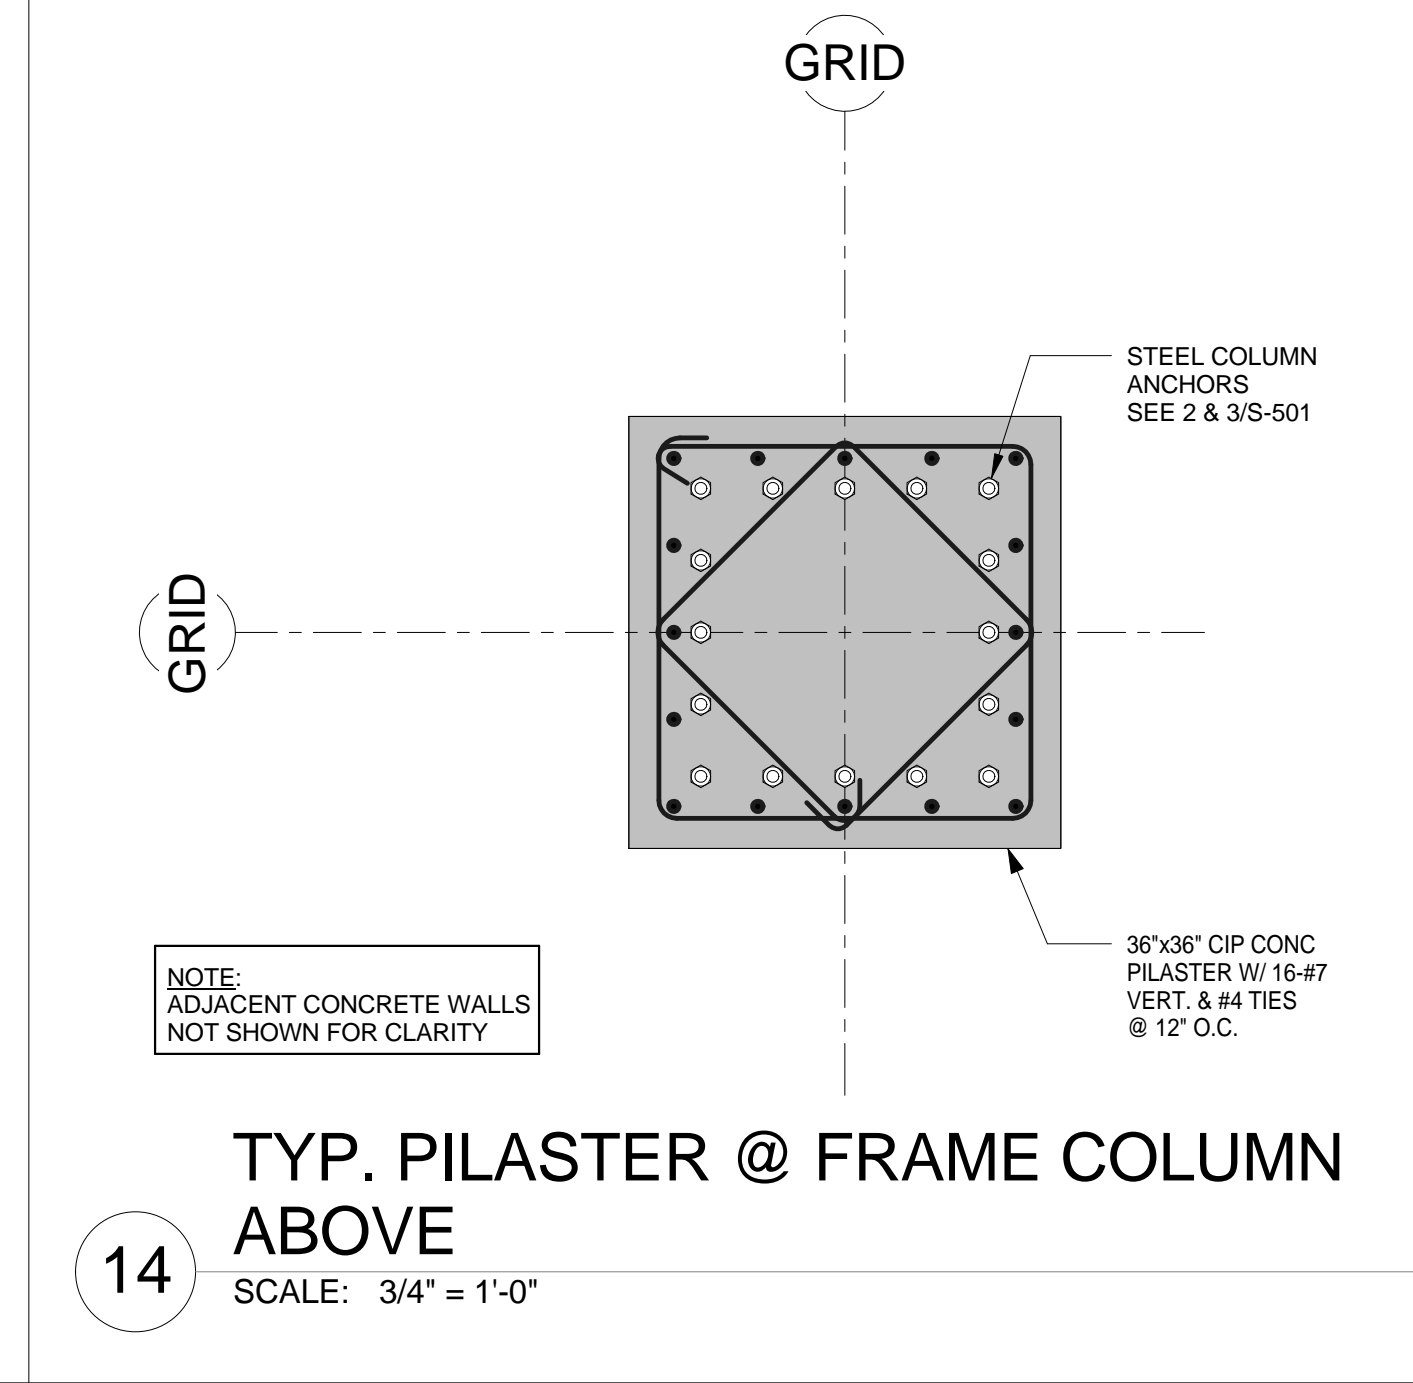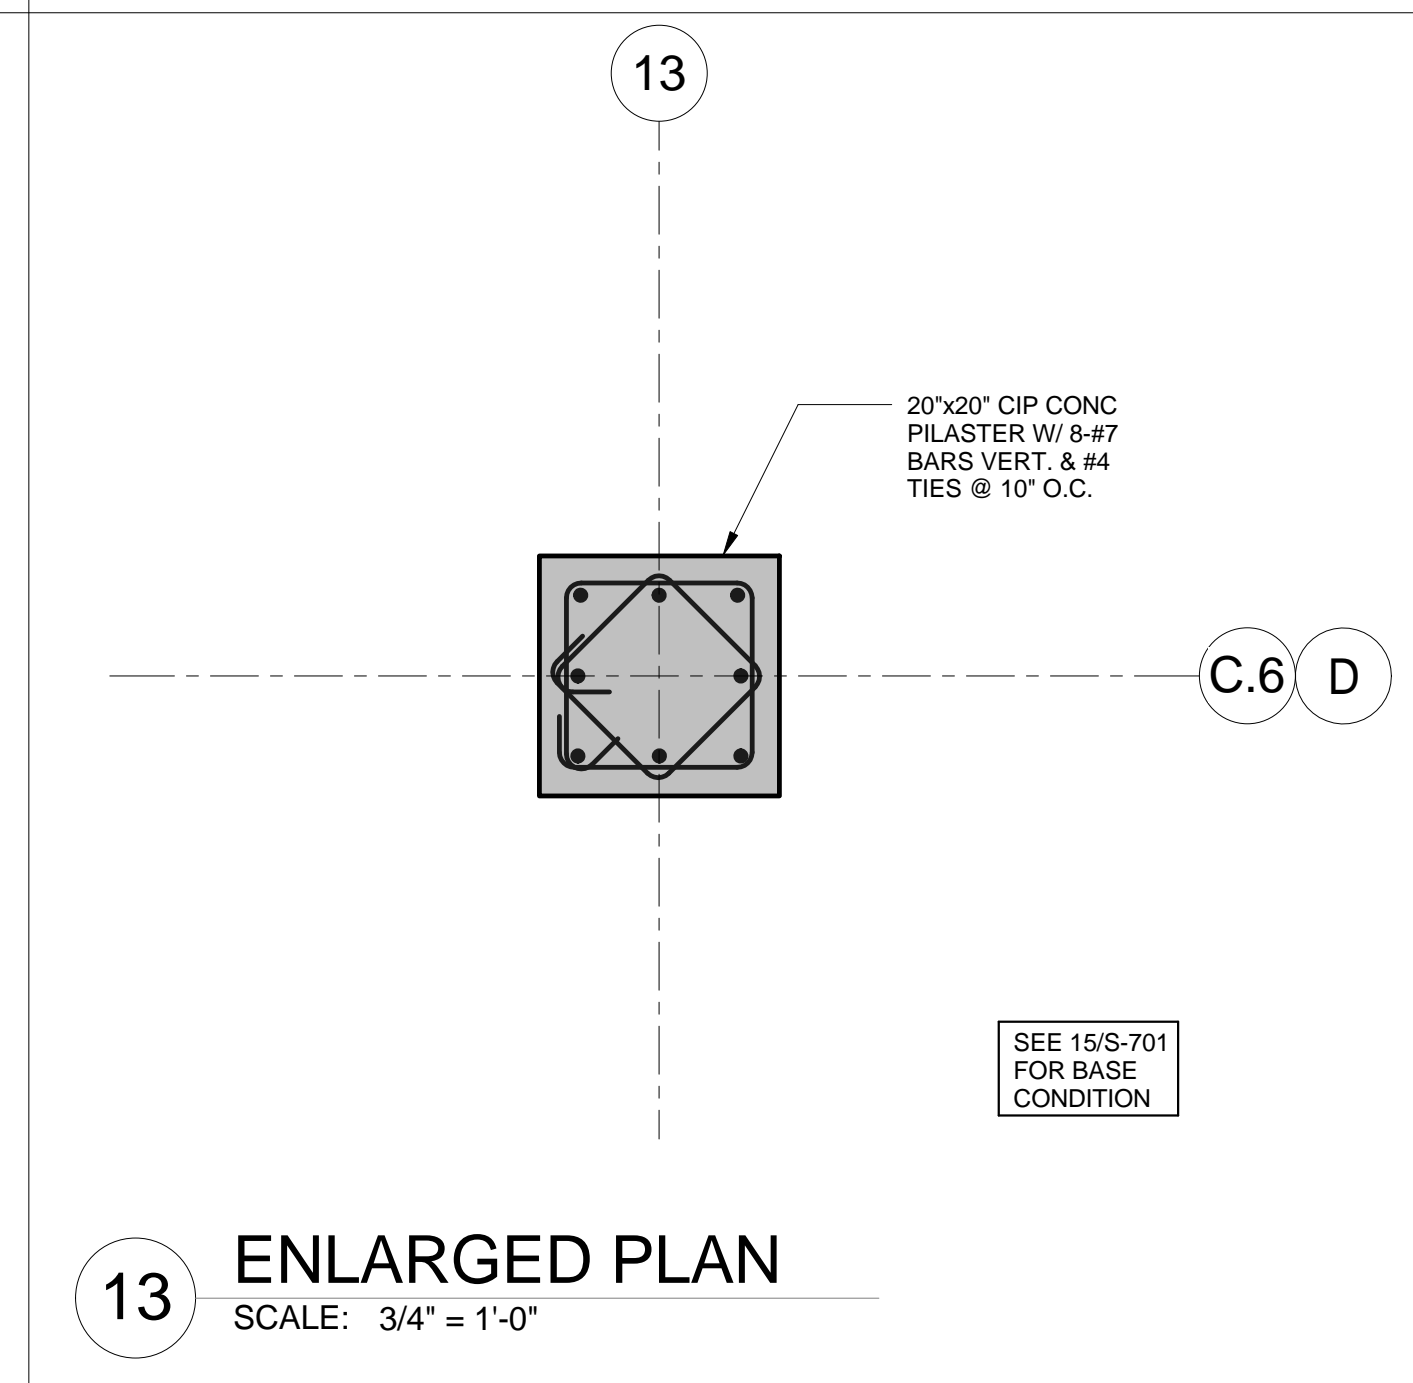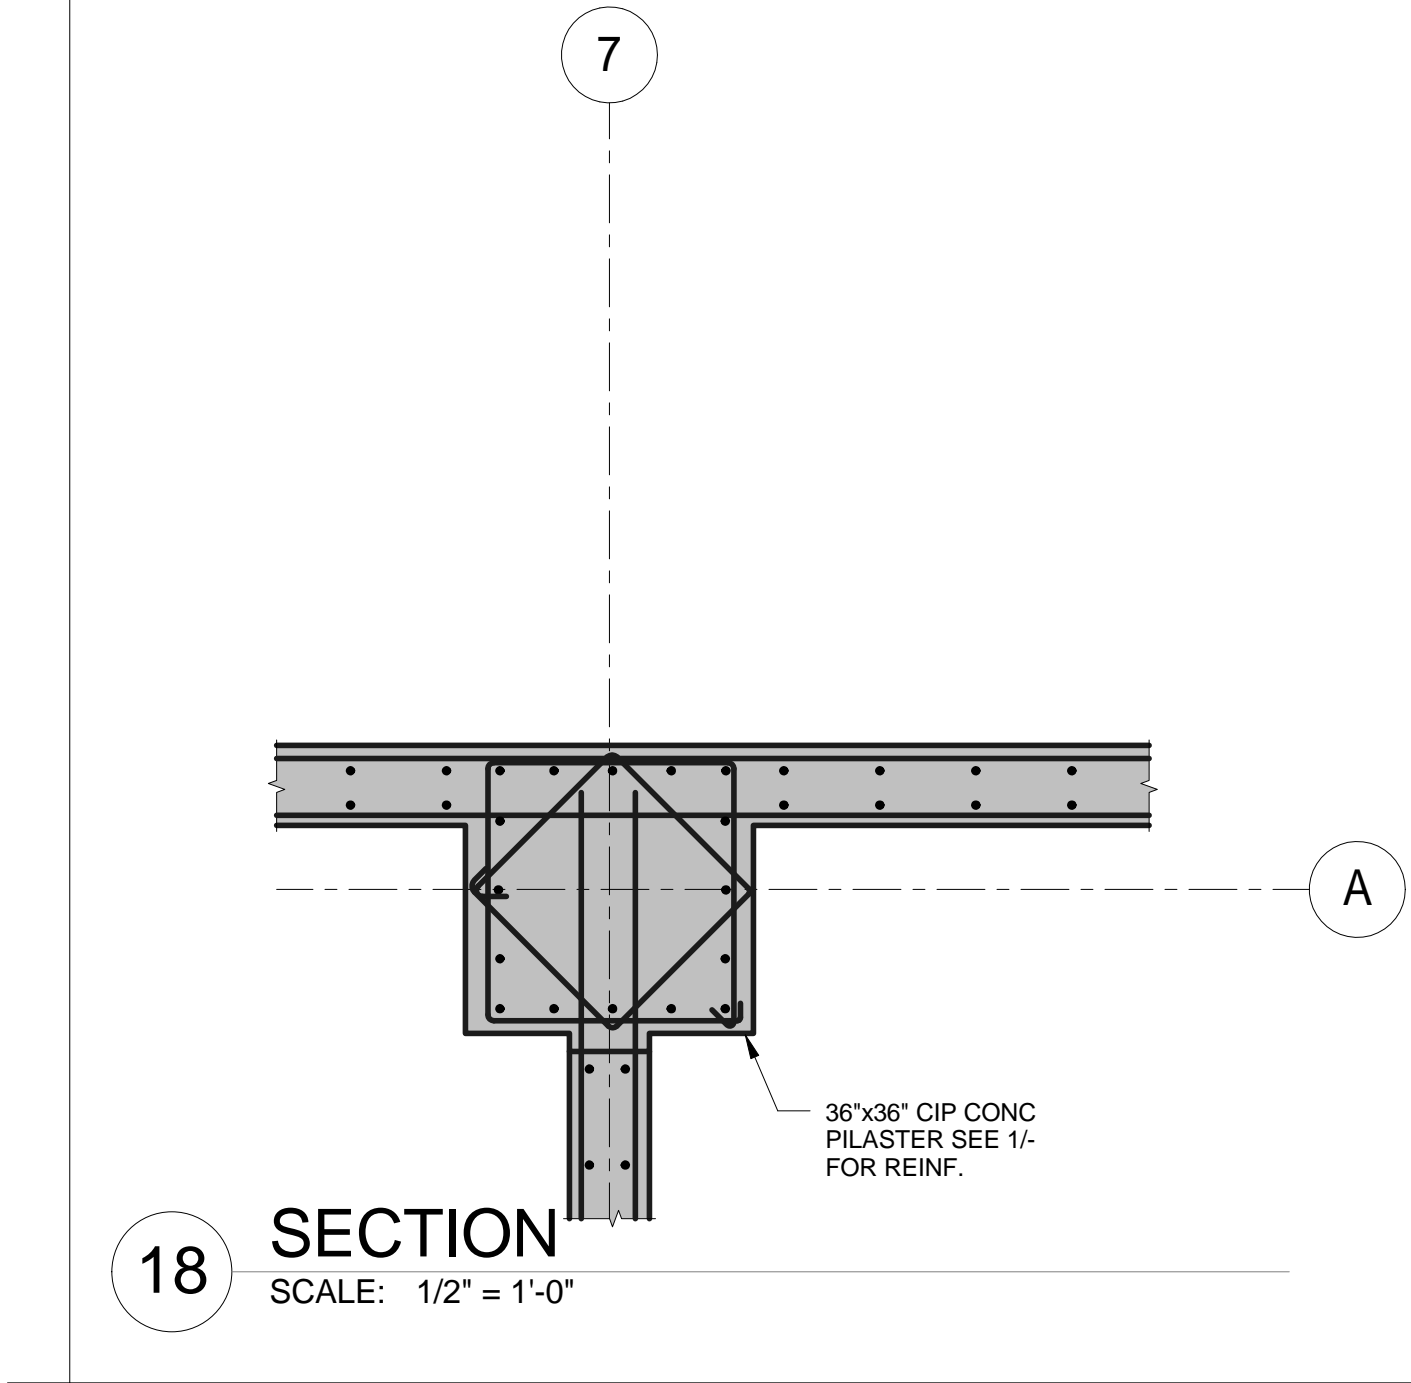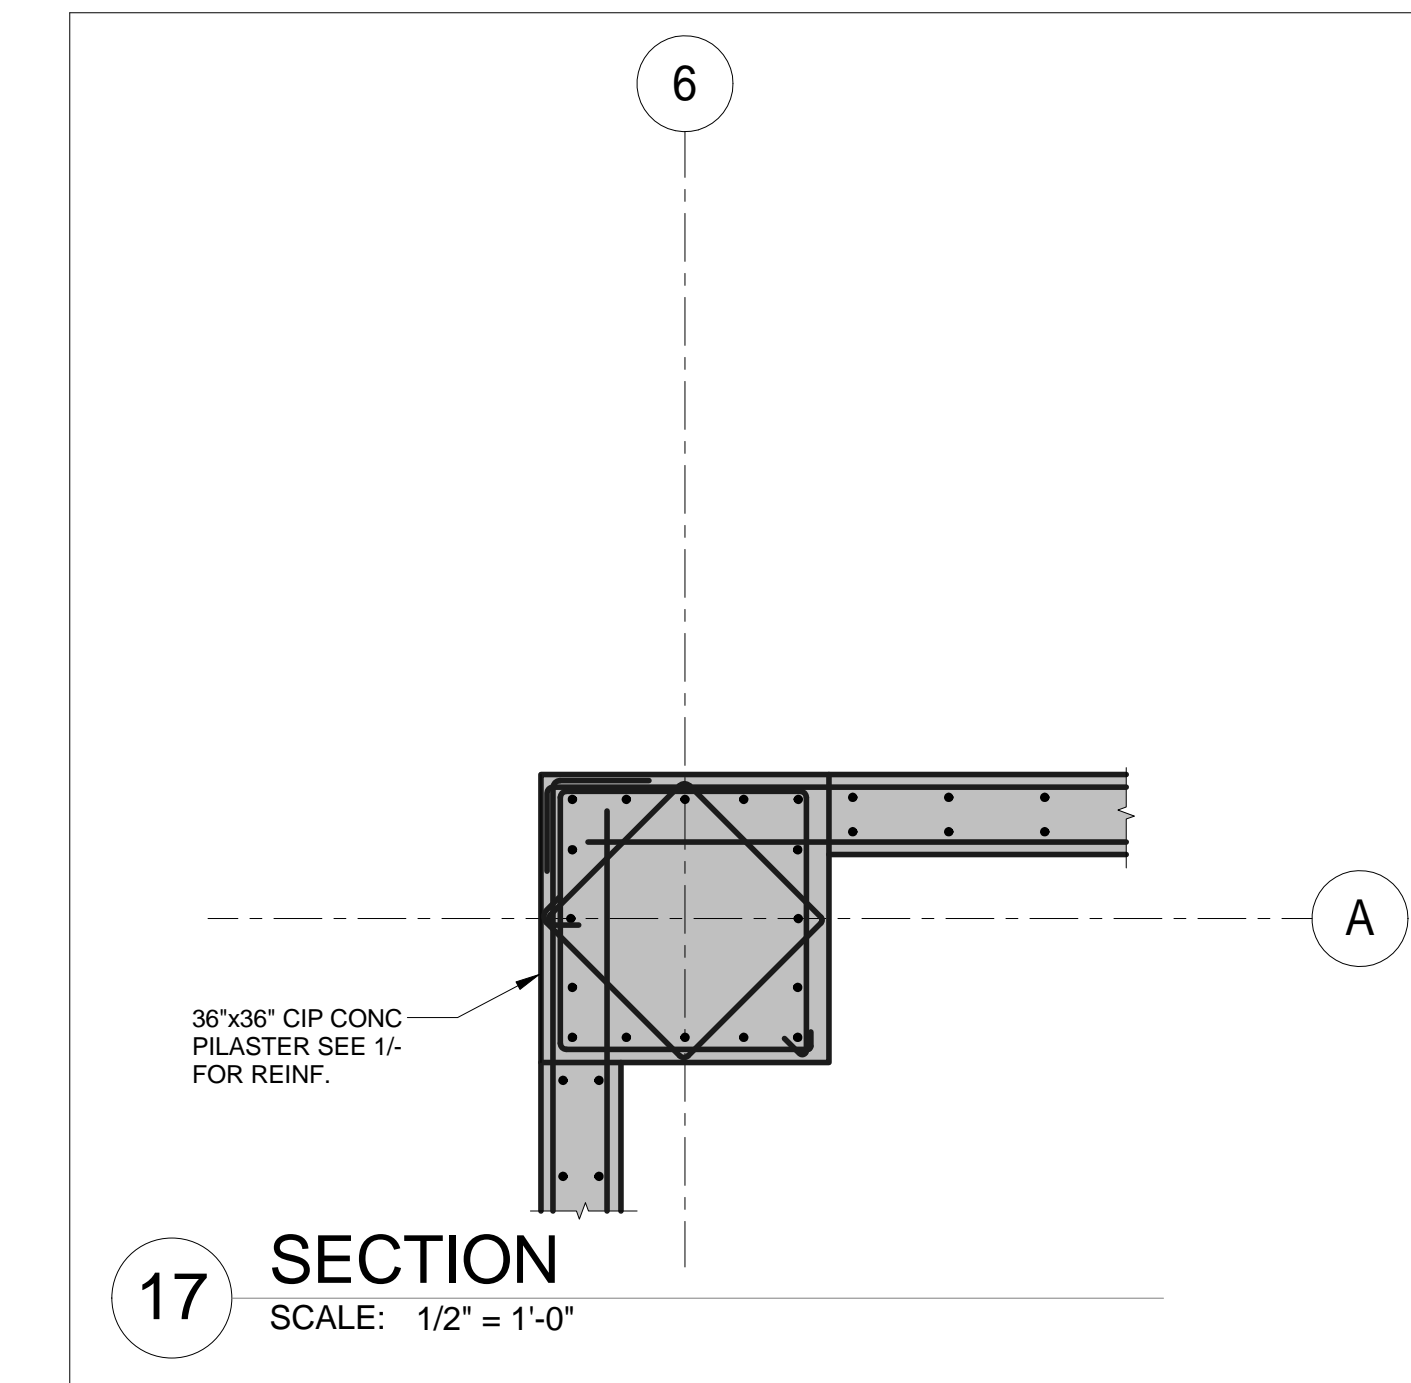

All drawings and written material appearing herein constitute original and unpublished work of the Architect/Engineer and may not be duplicated, used or disclosed without consent of Architect/Engineer.


If this drawing is not 30"x42", then the drawing has been revised from its original size. Note: scales must be adjusted. This line should be equal to one inch.

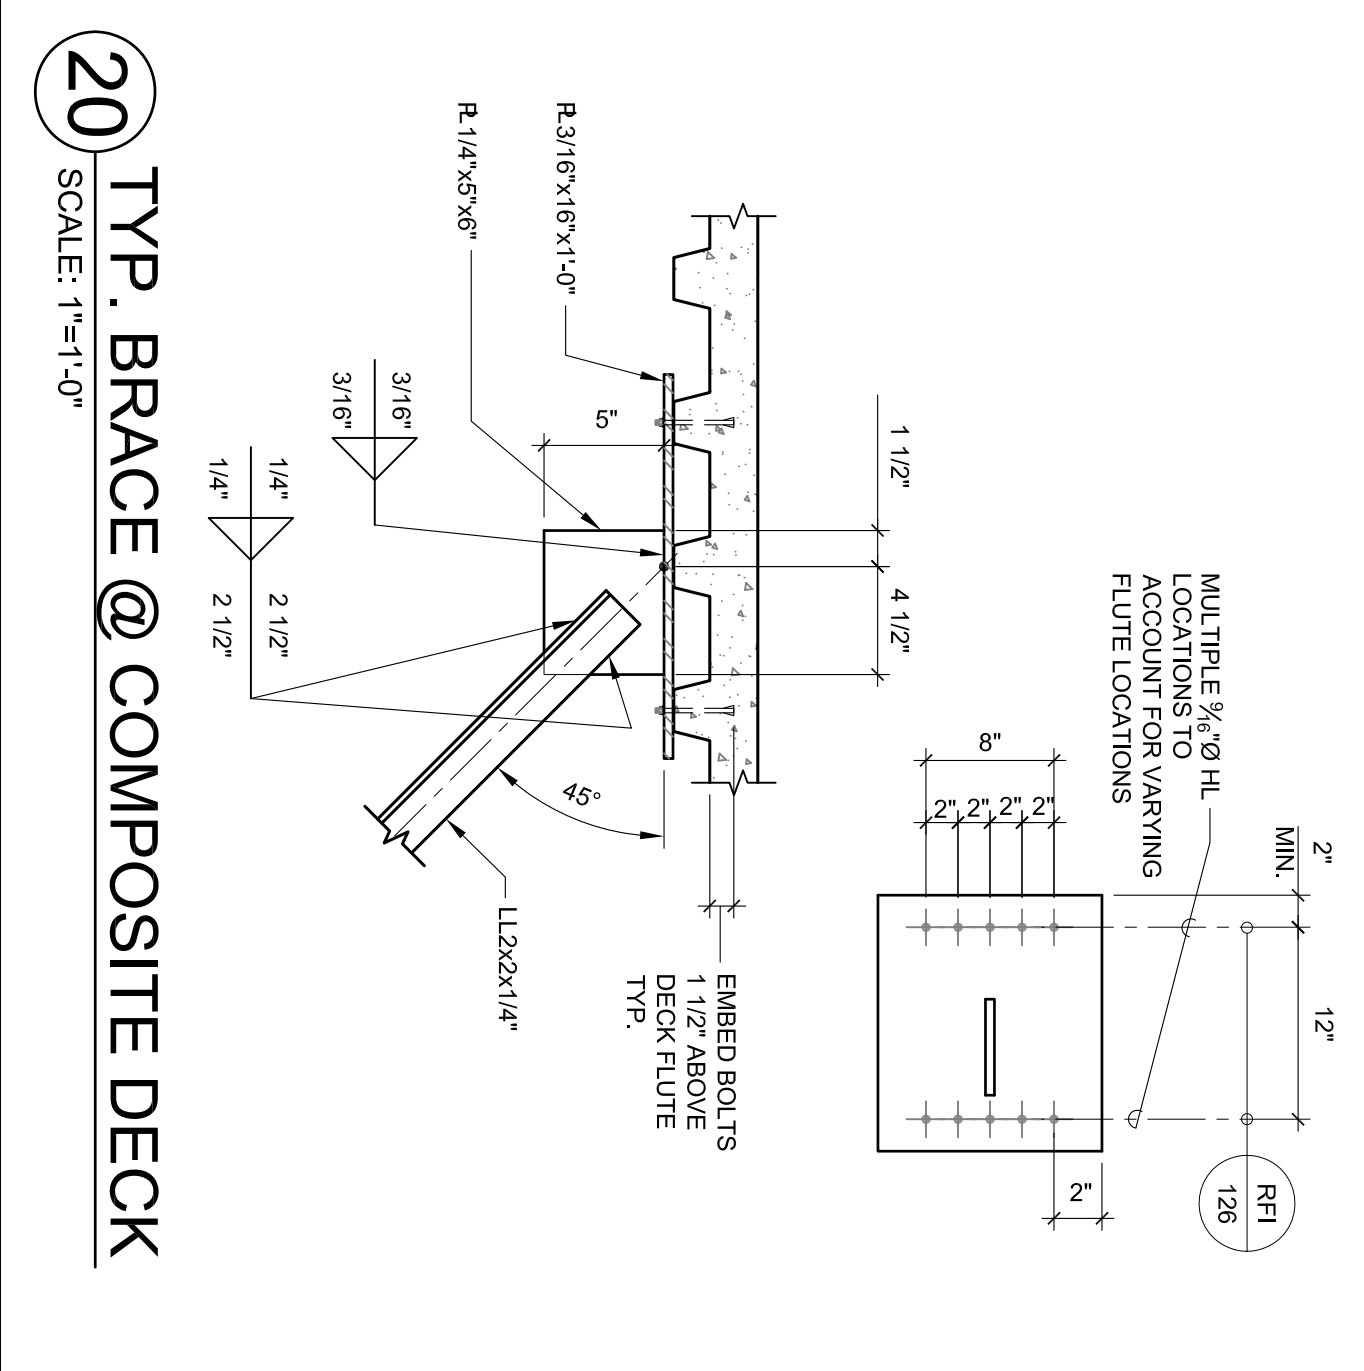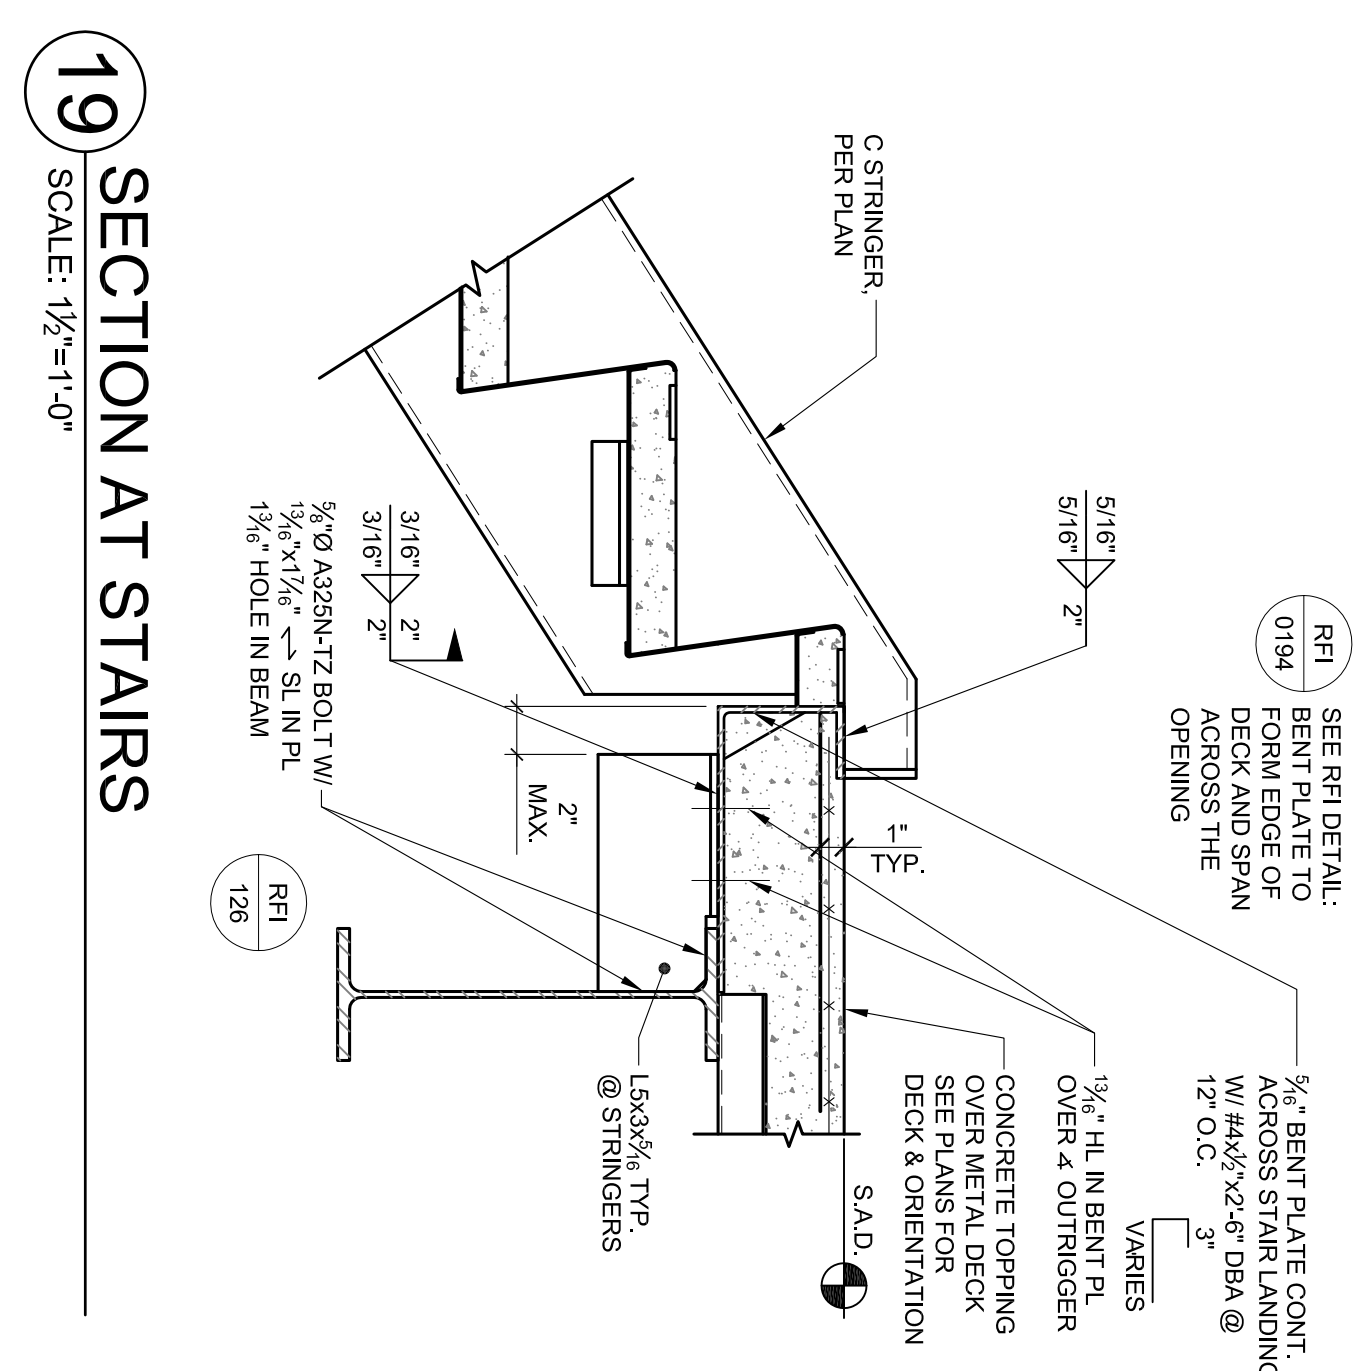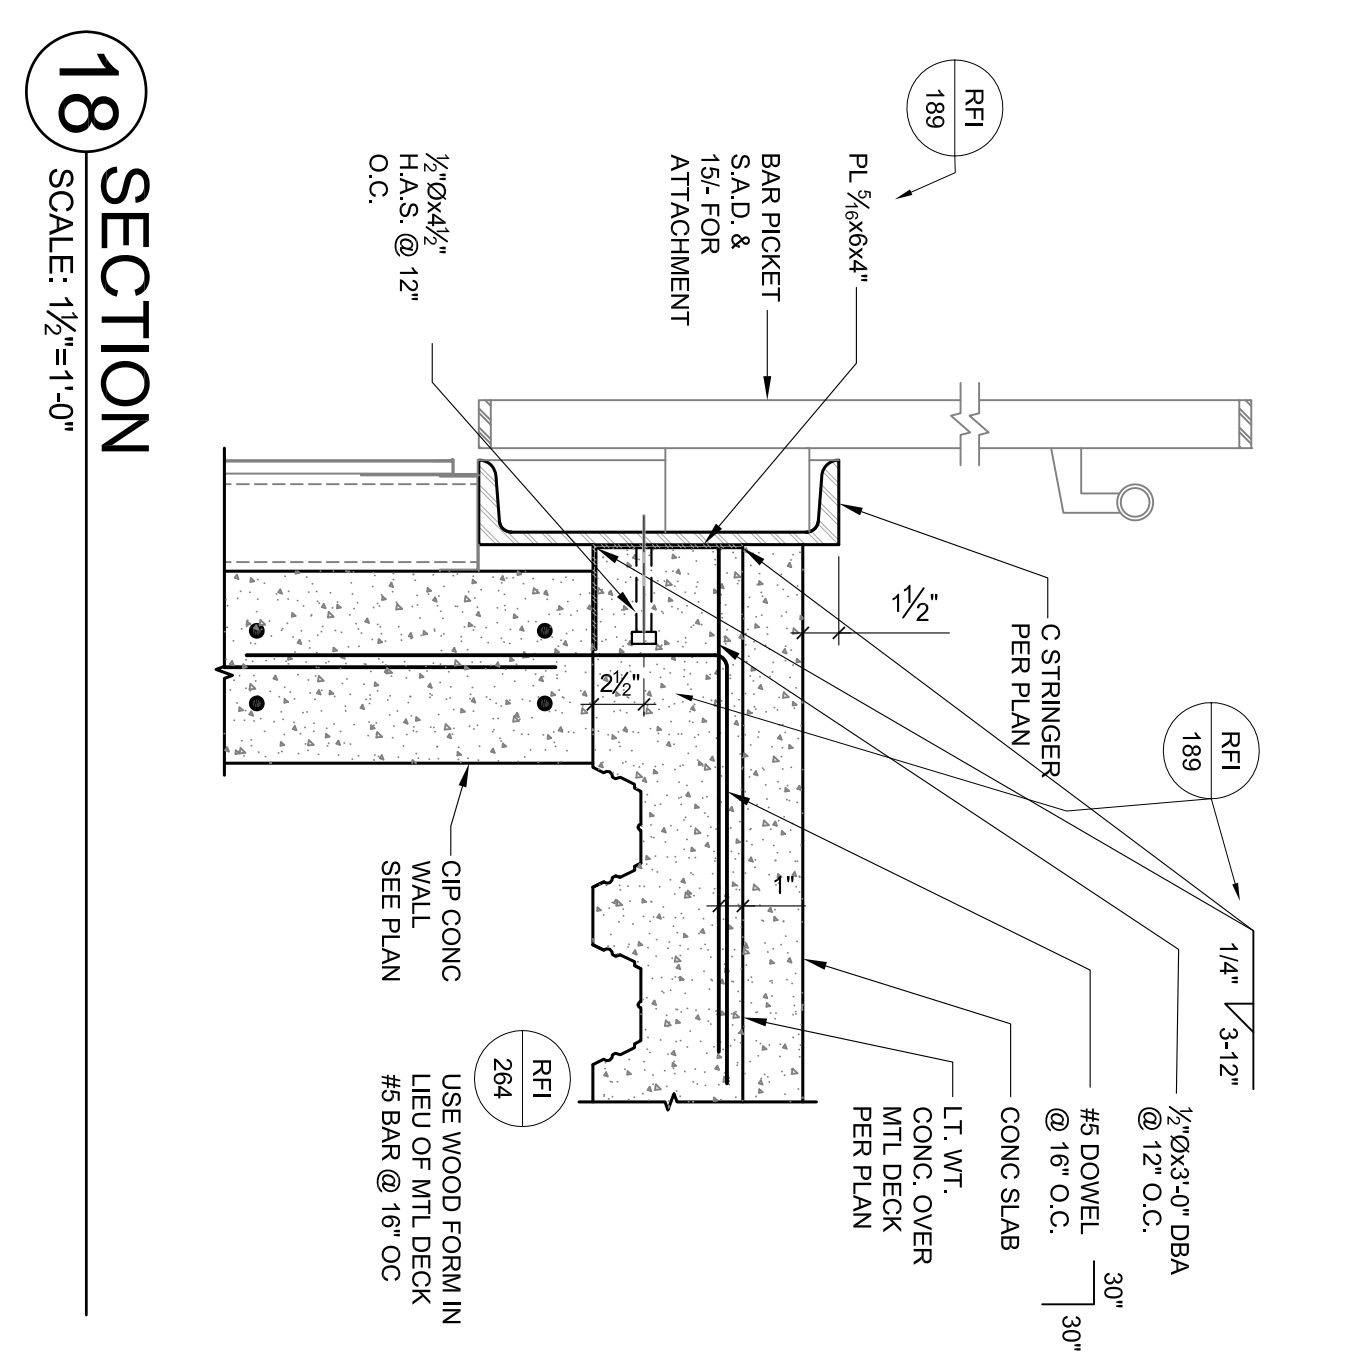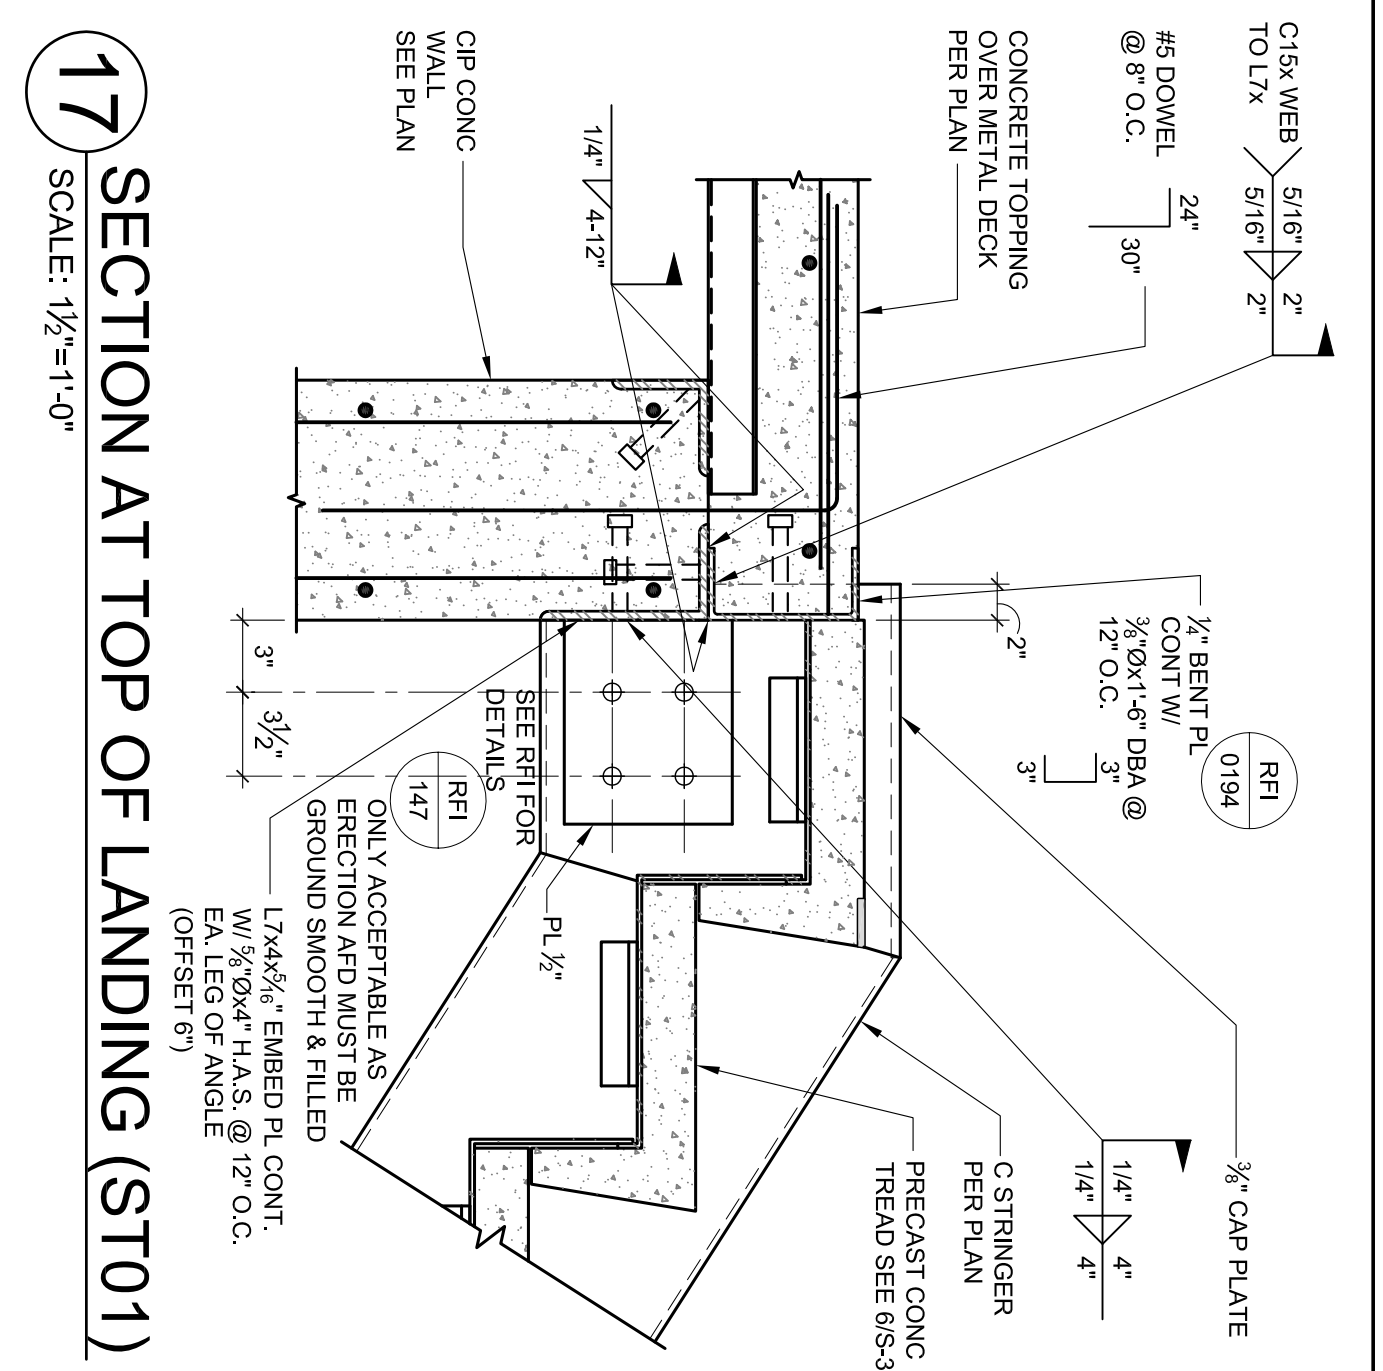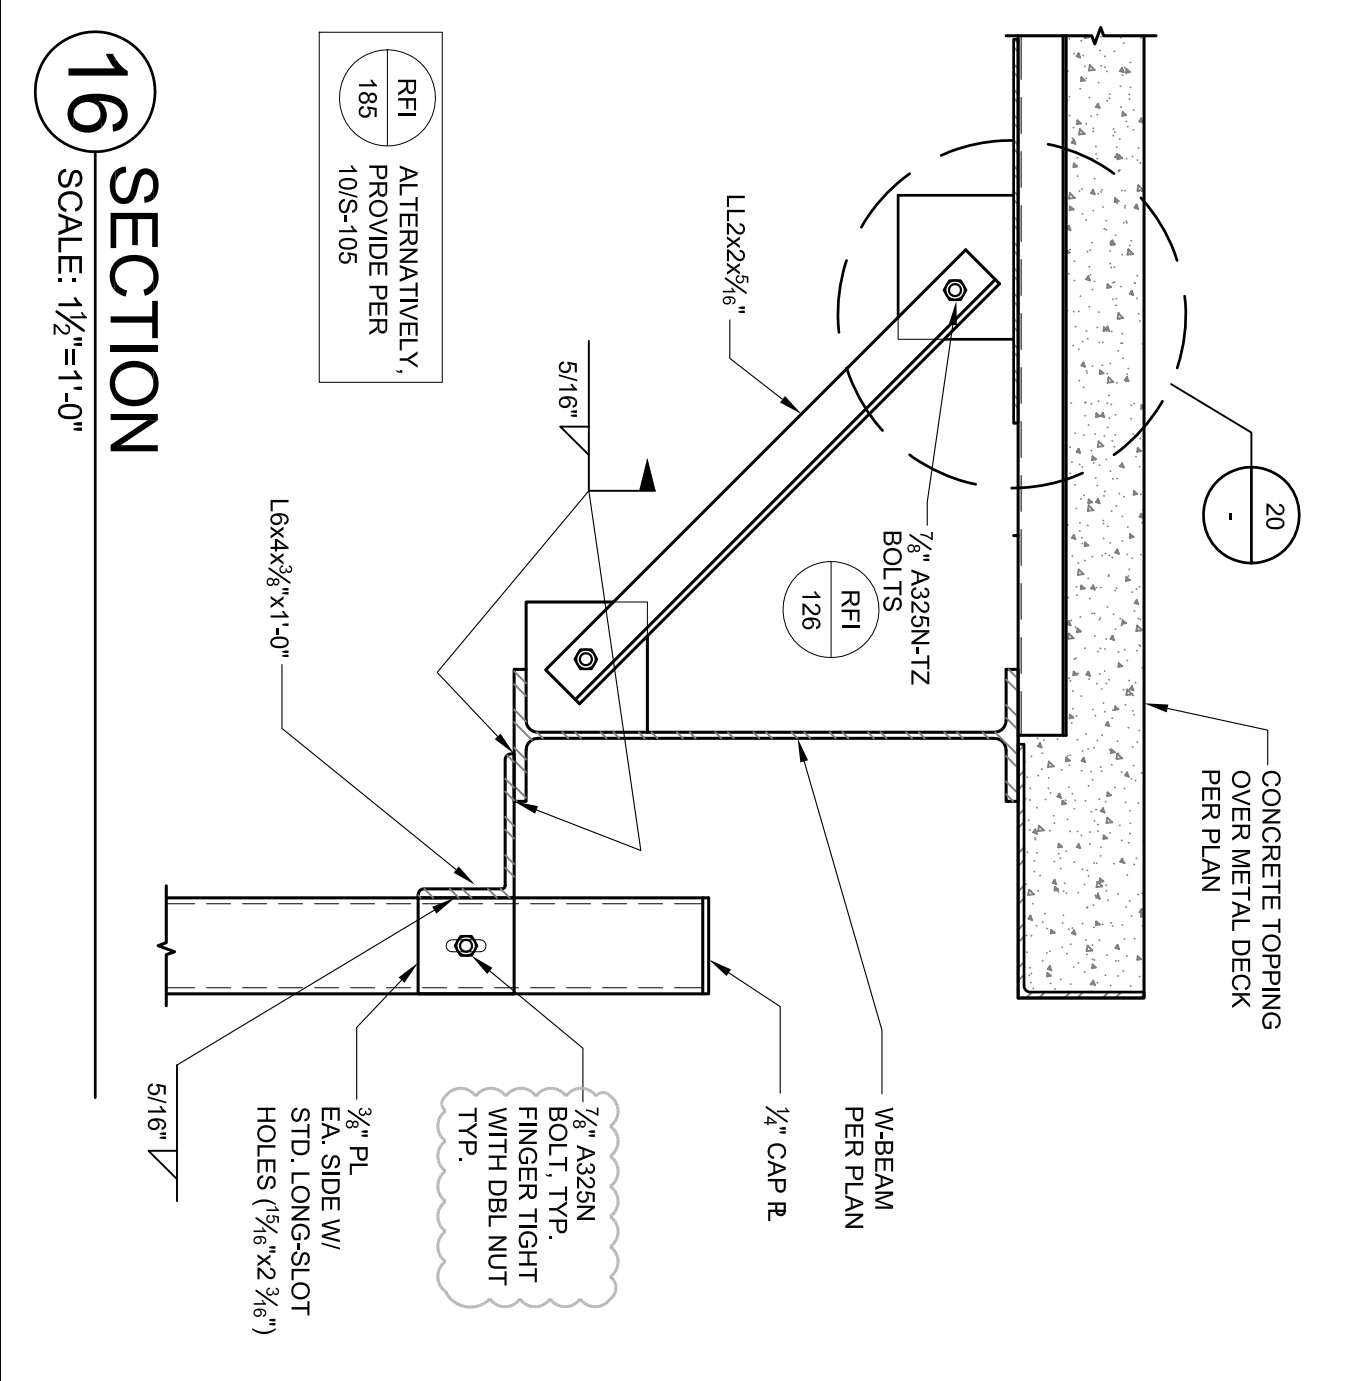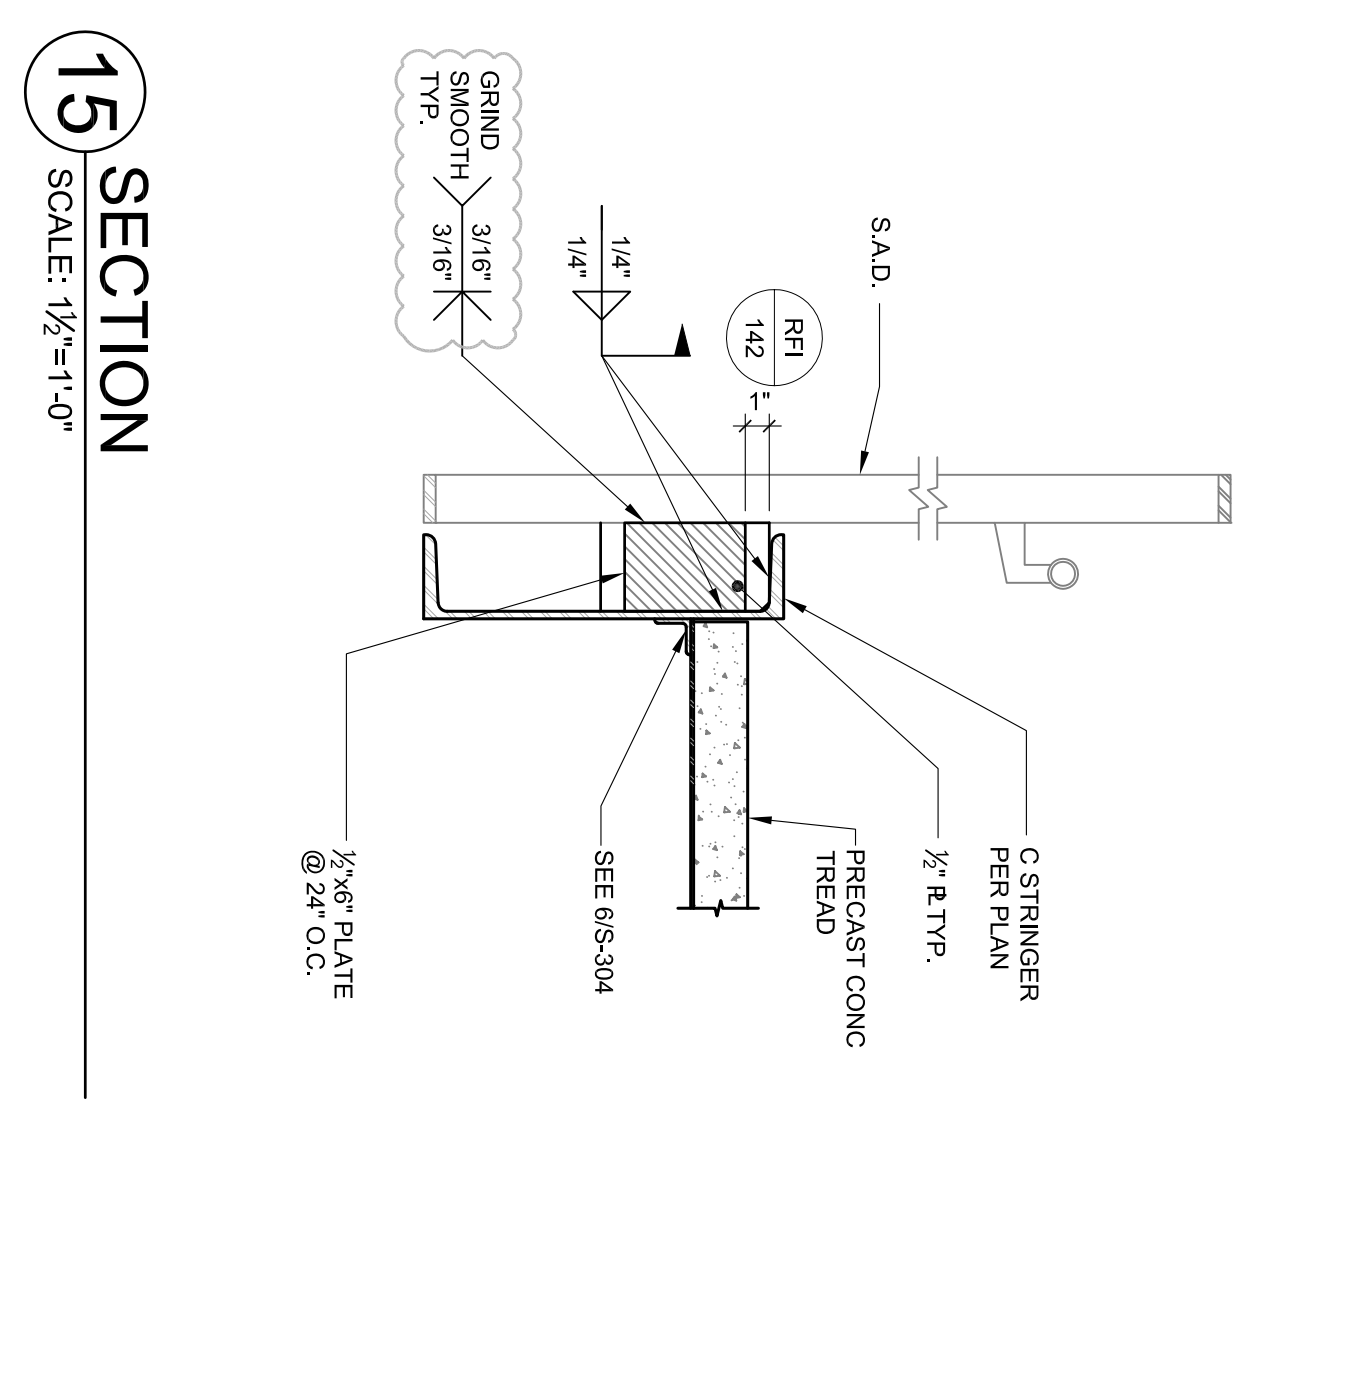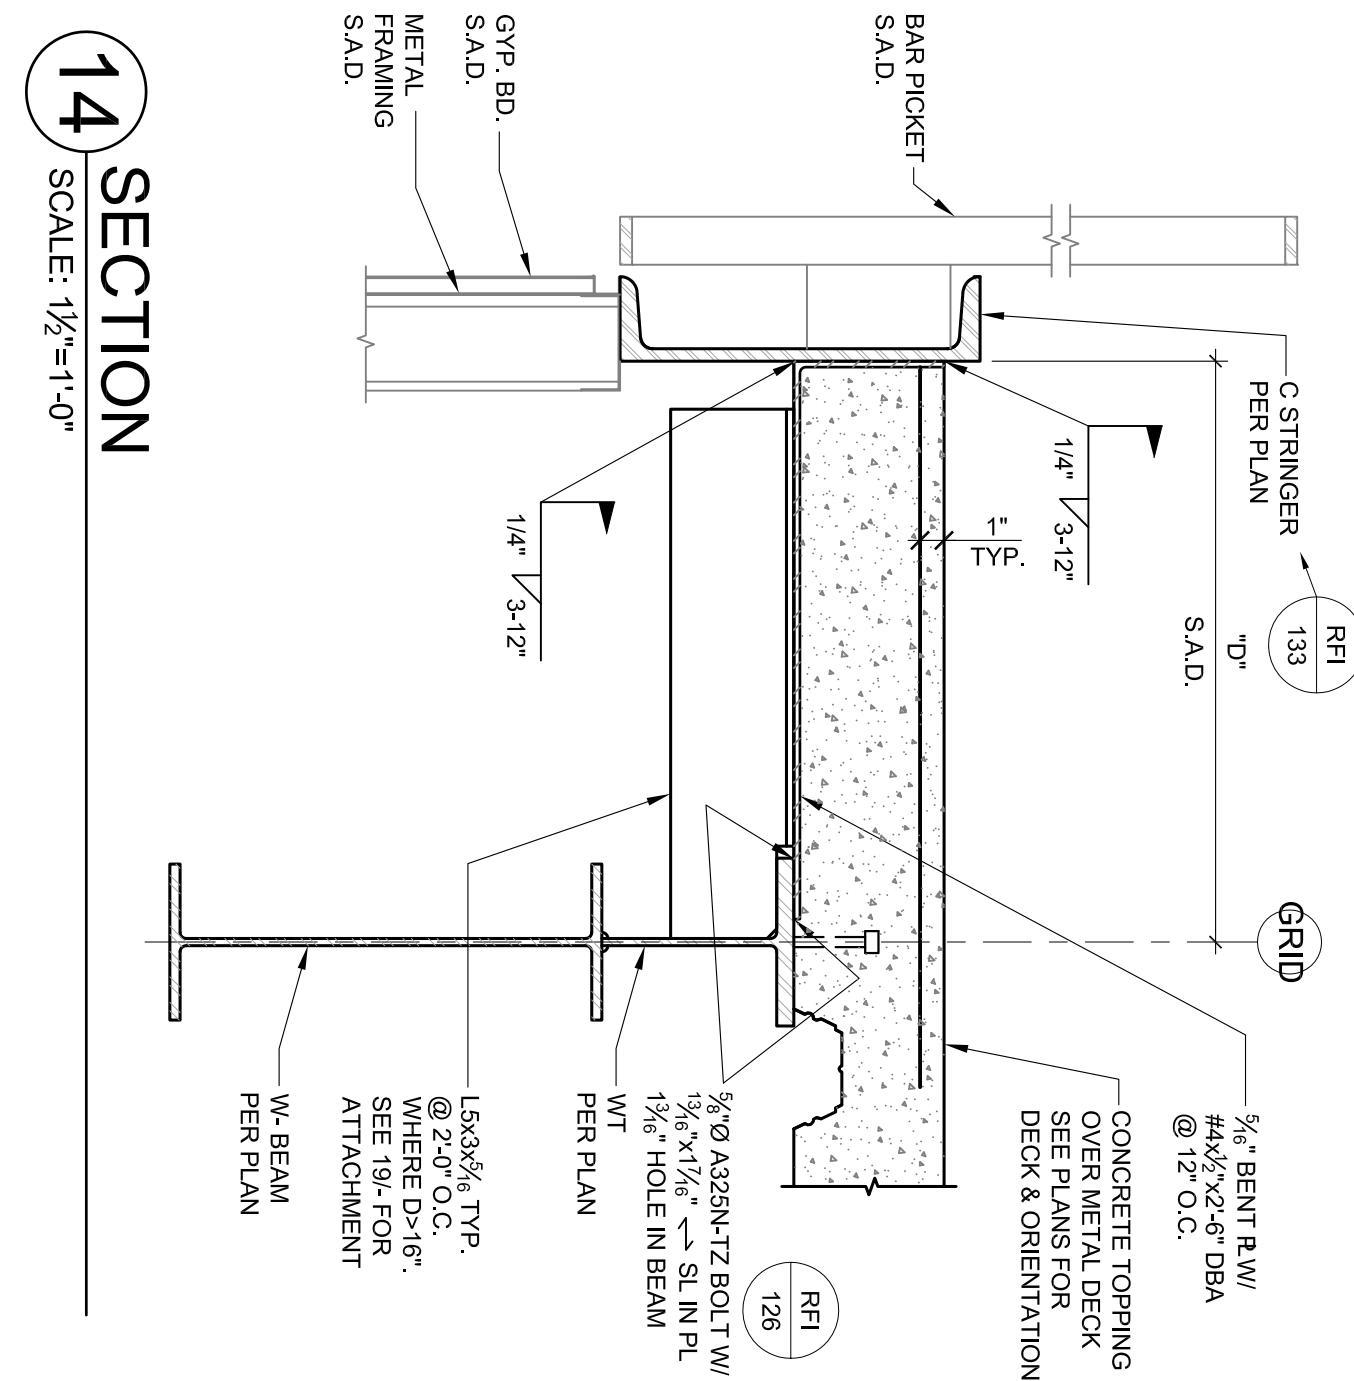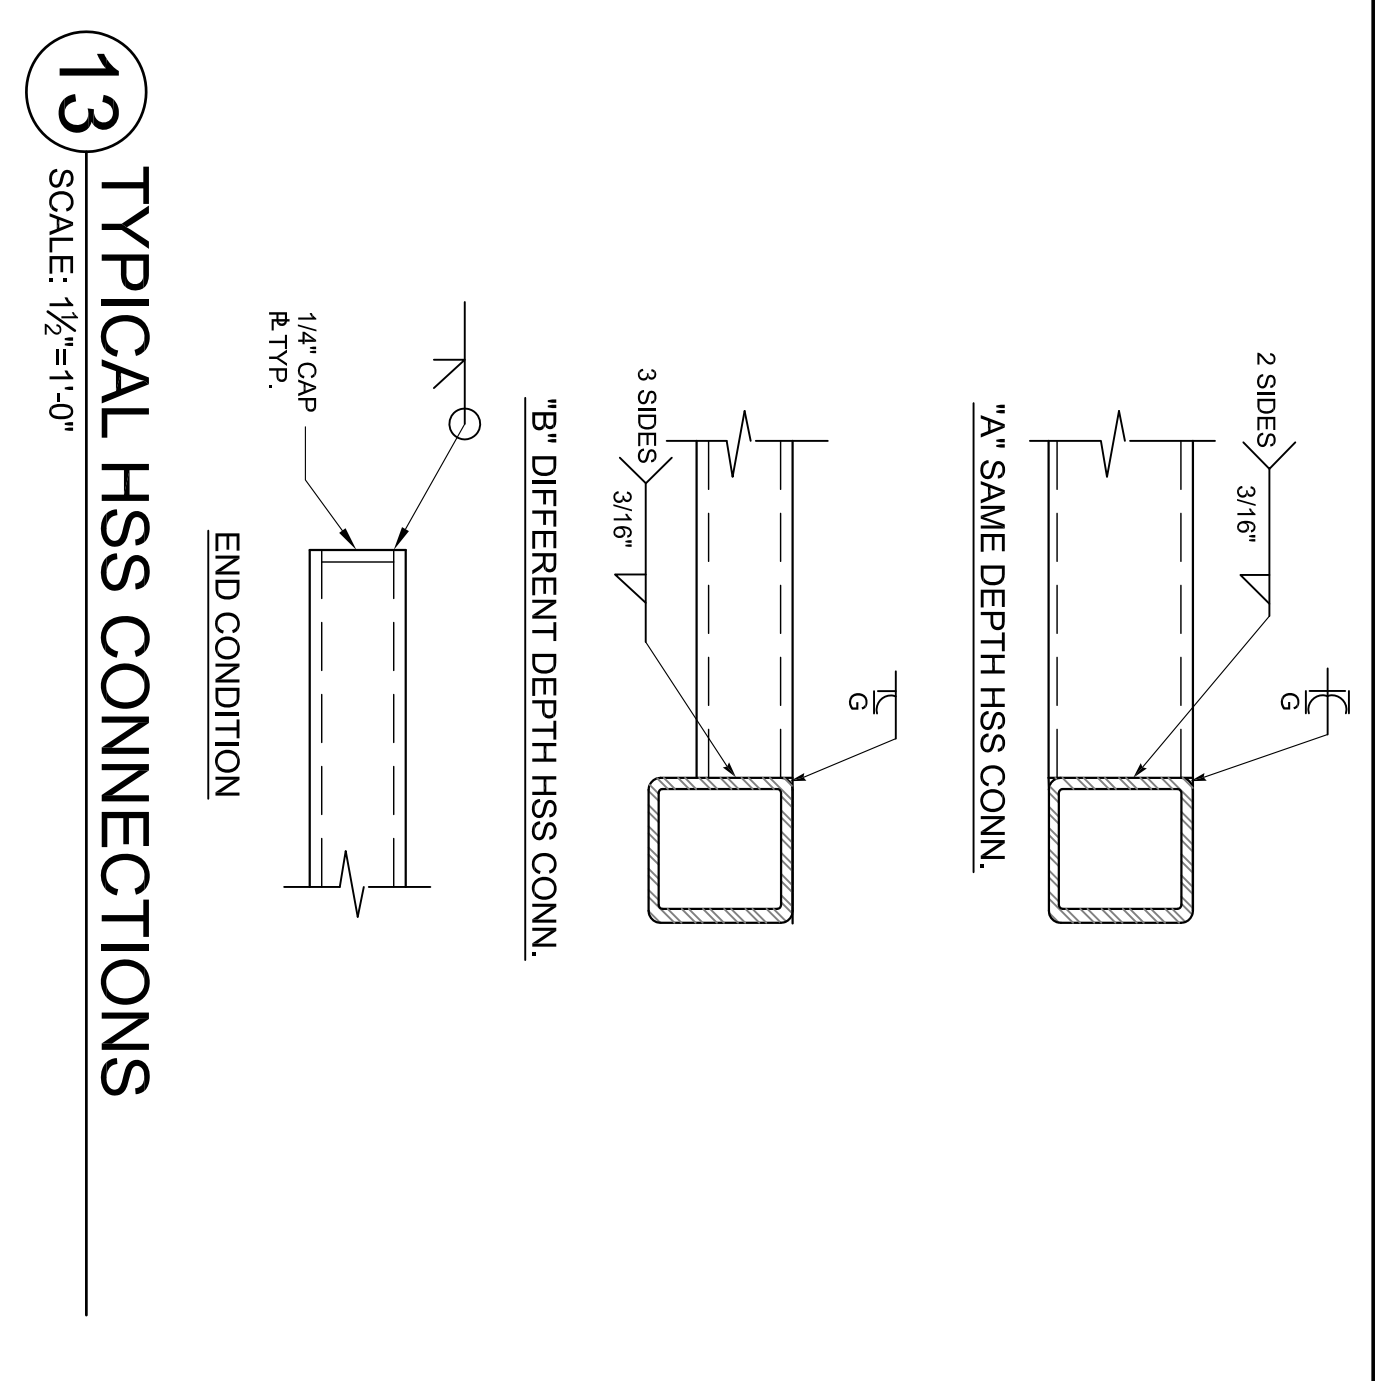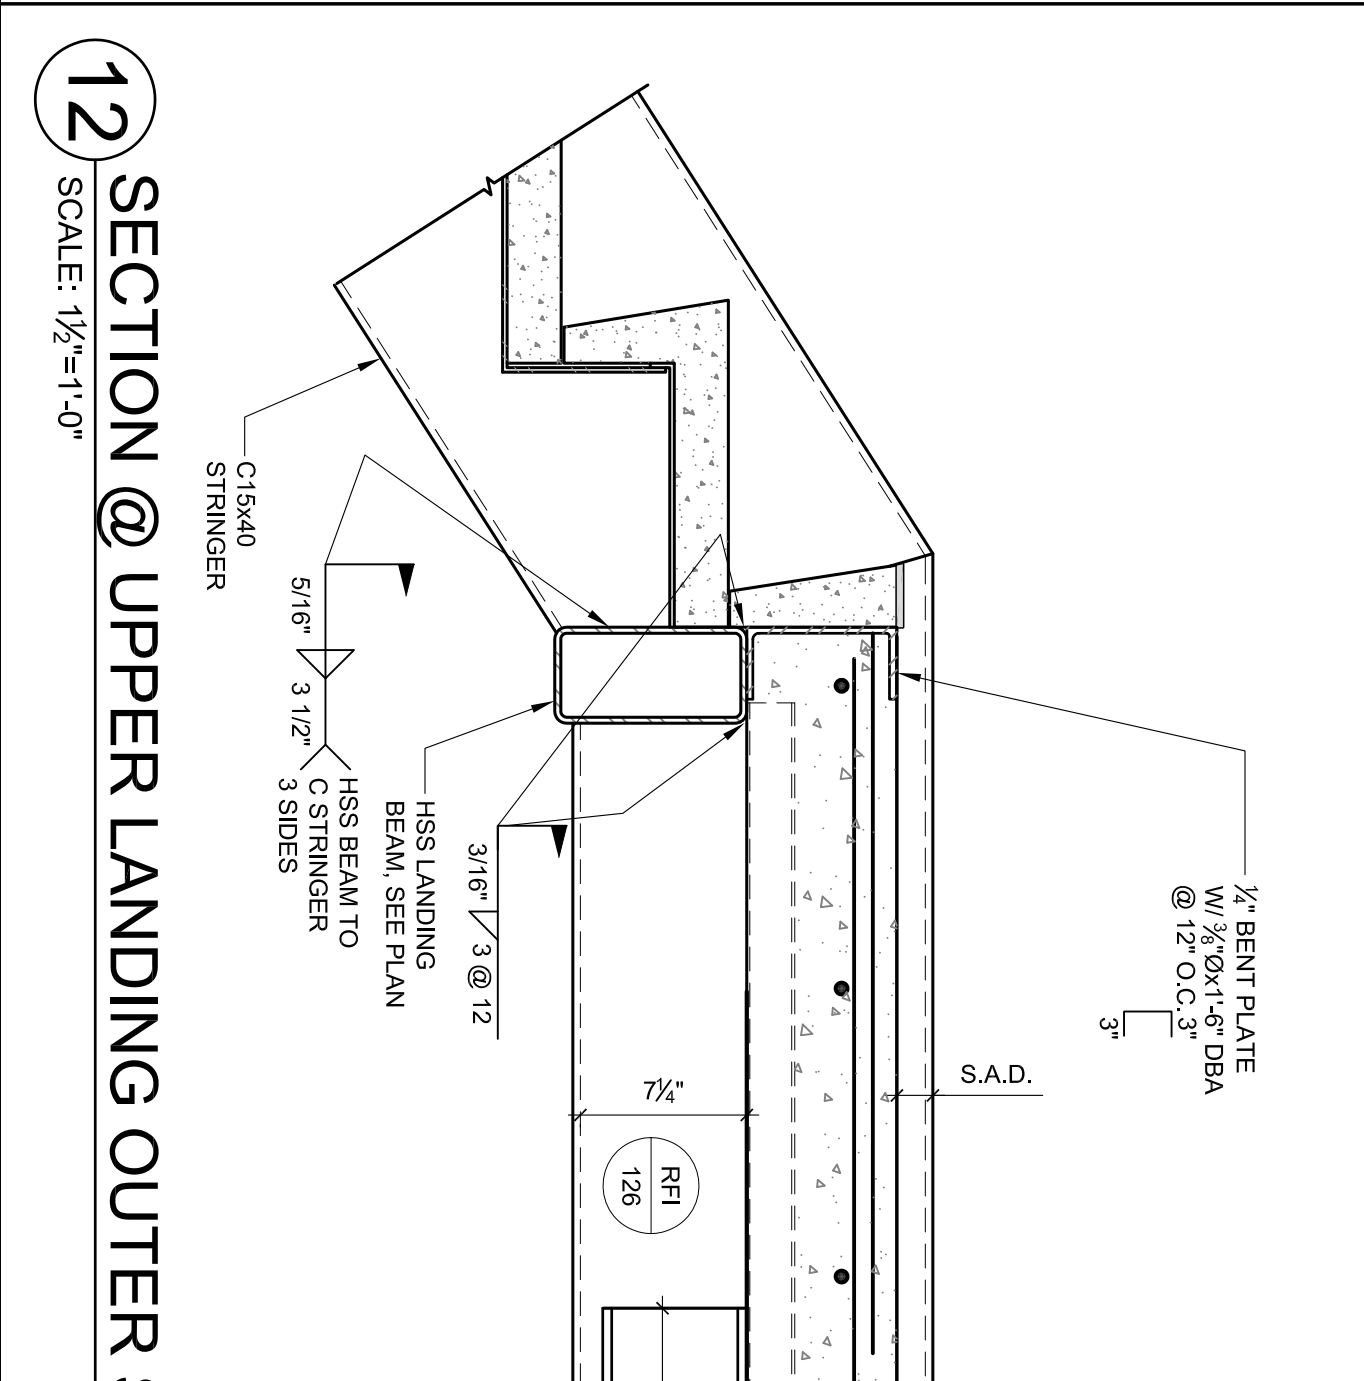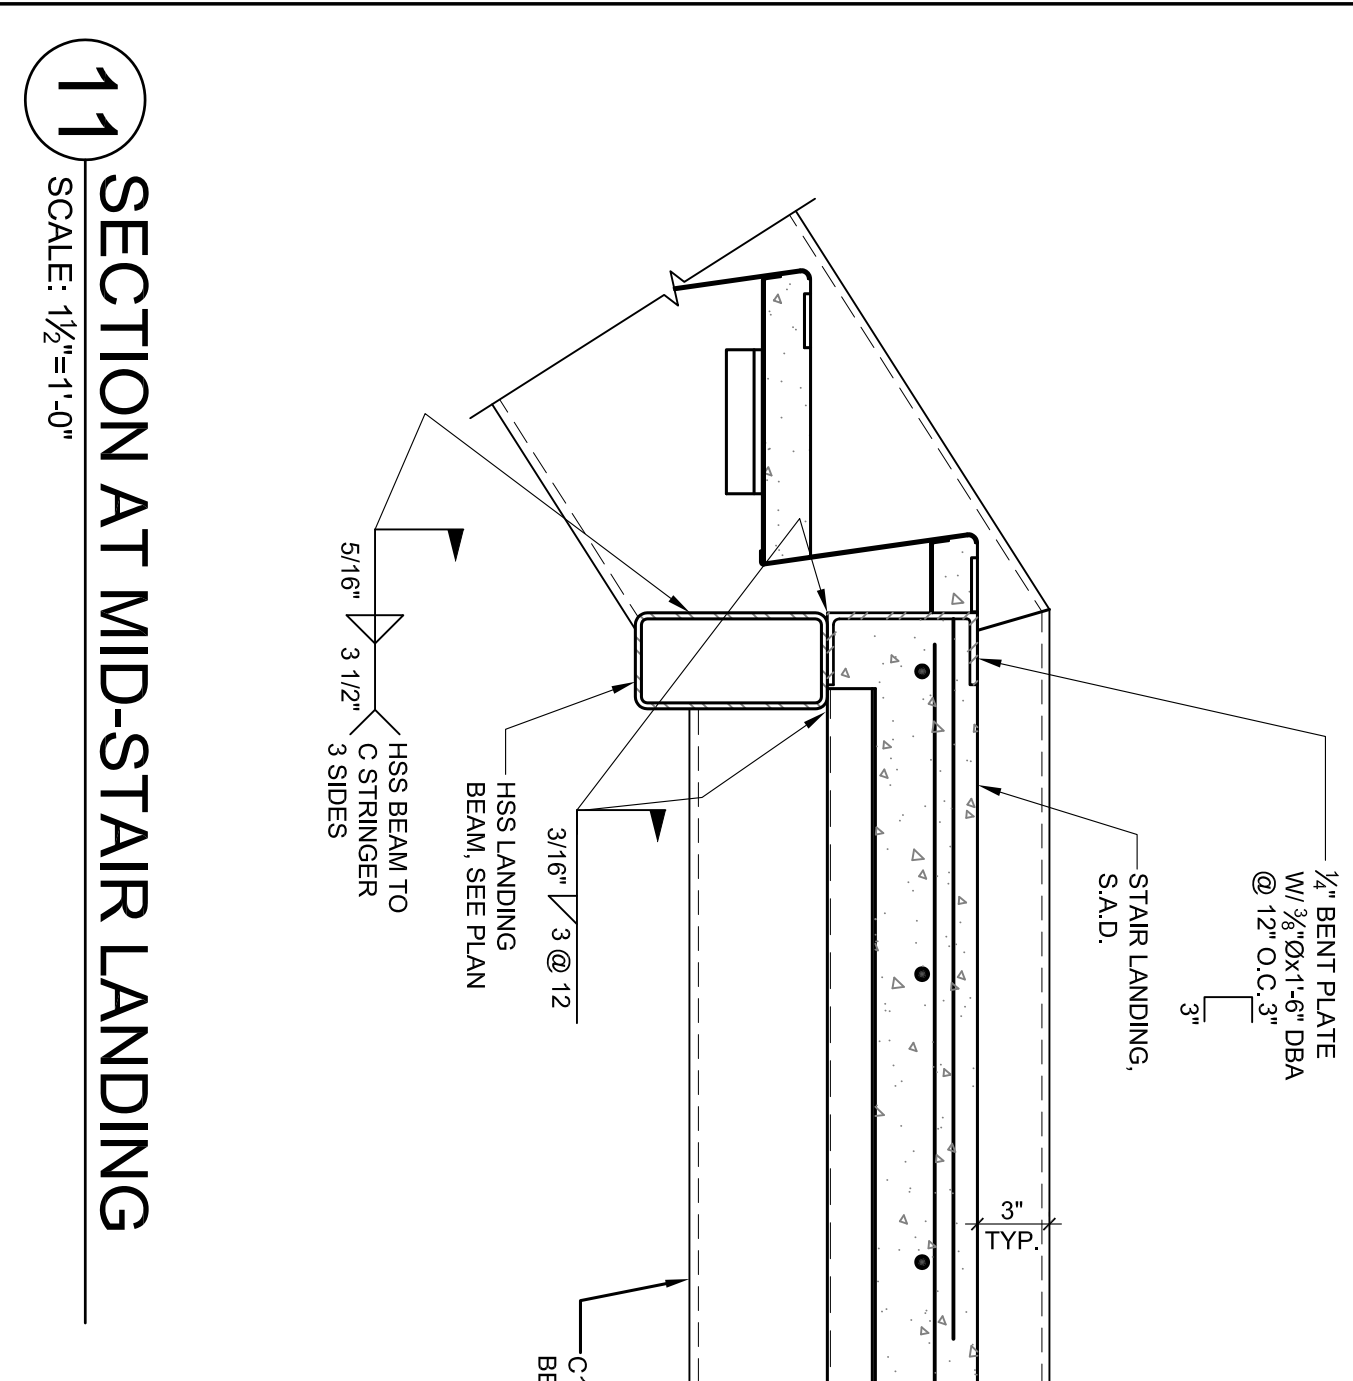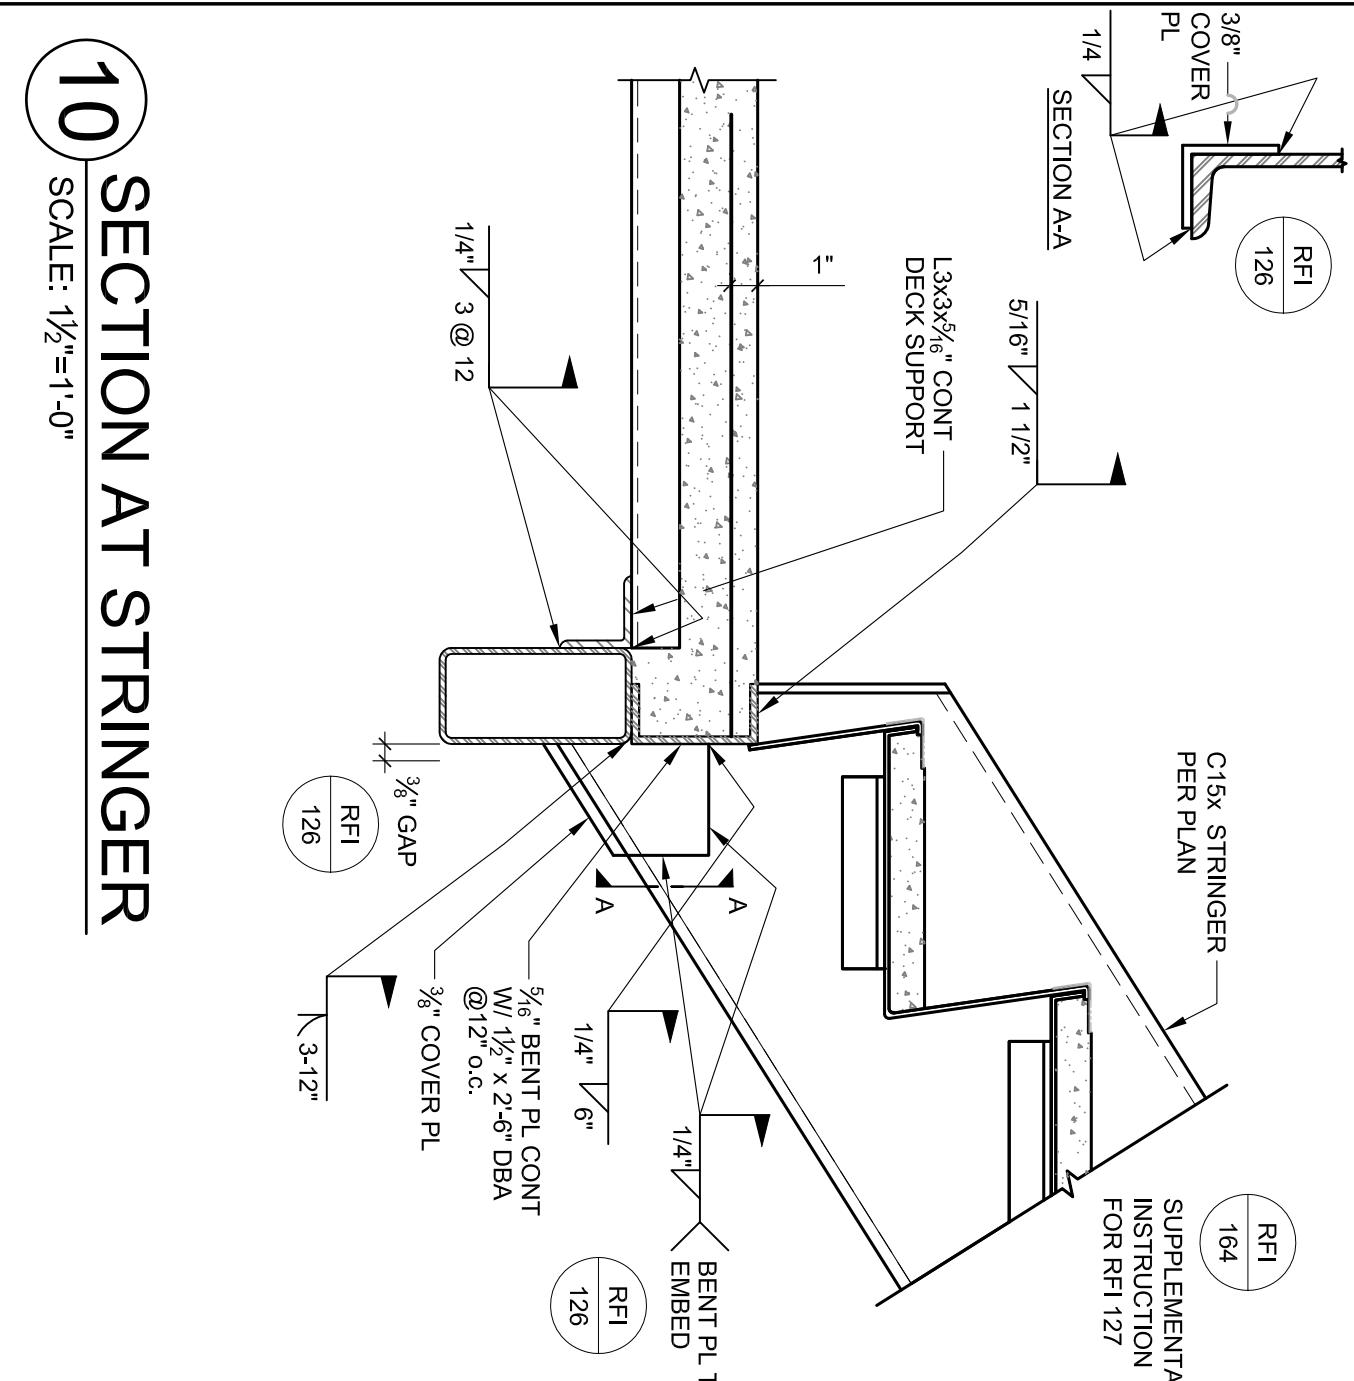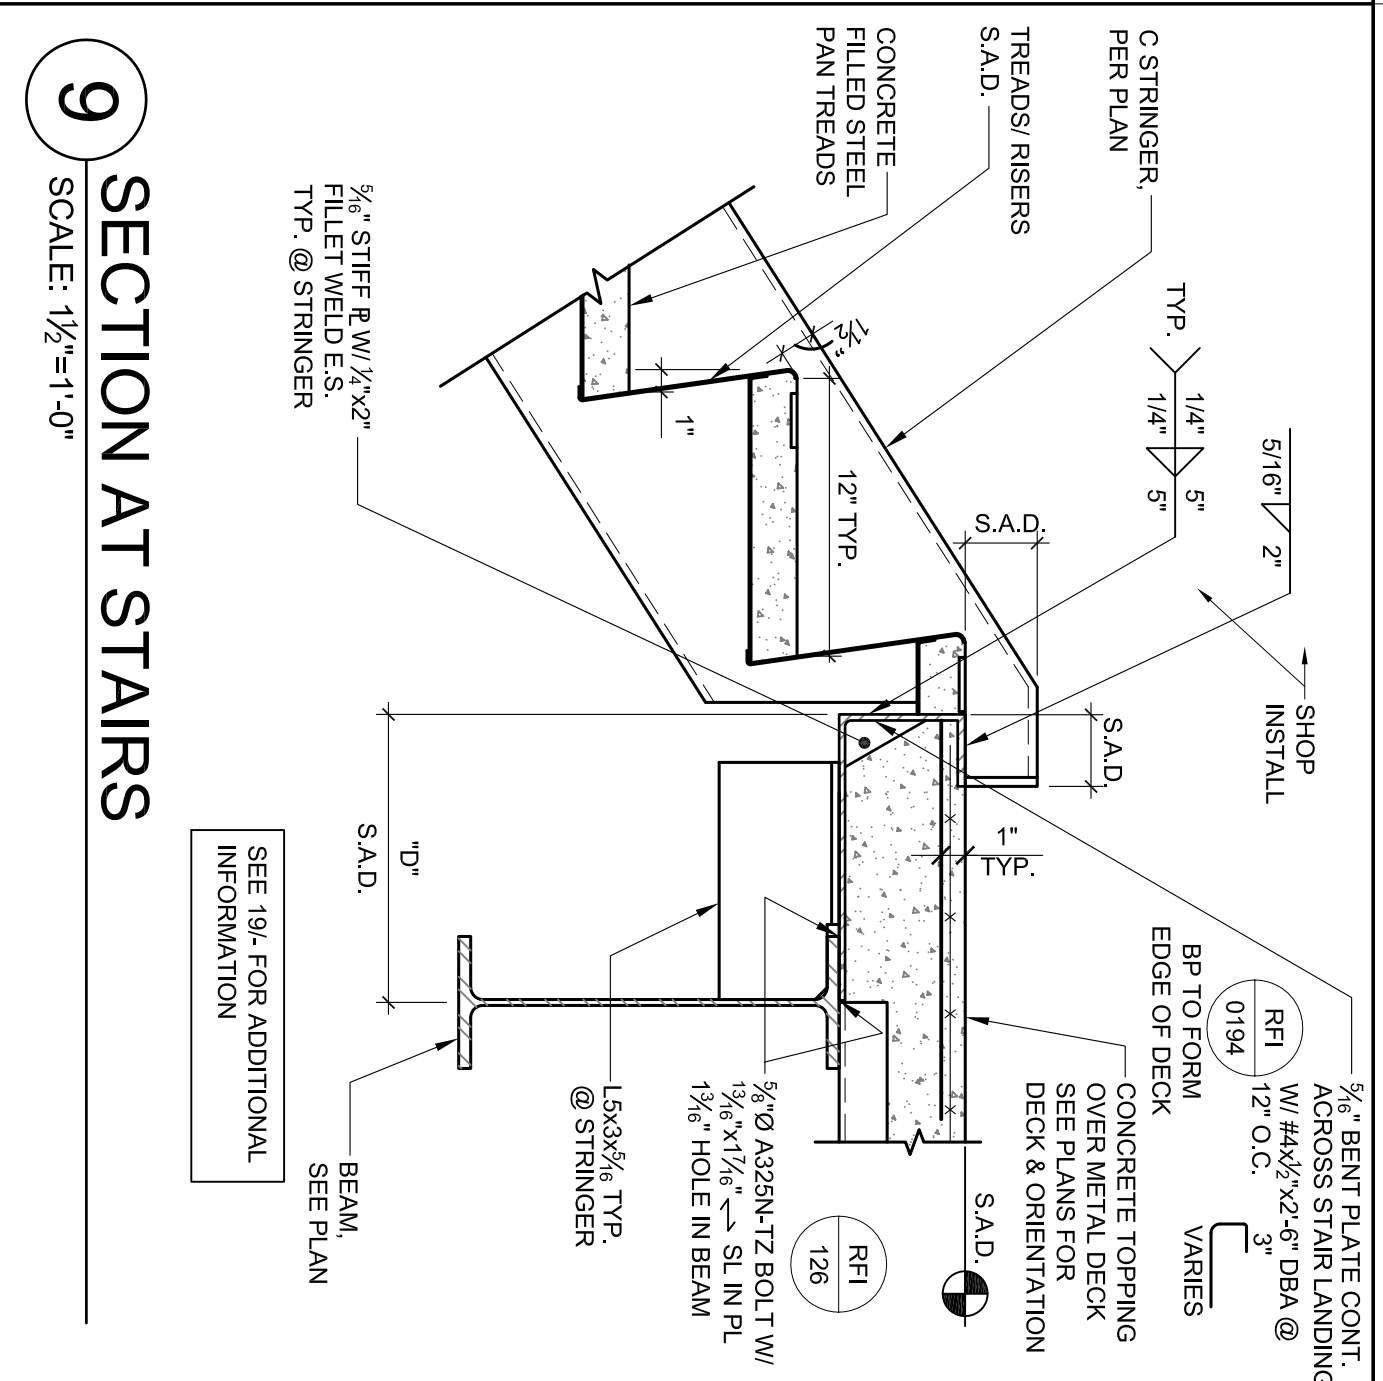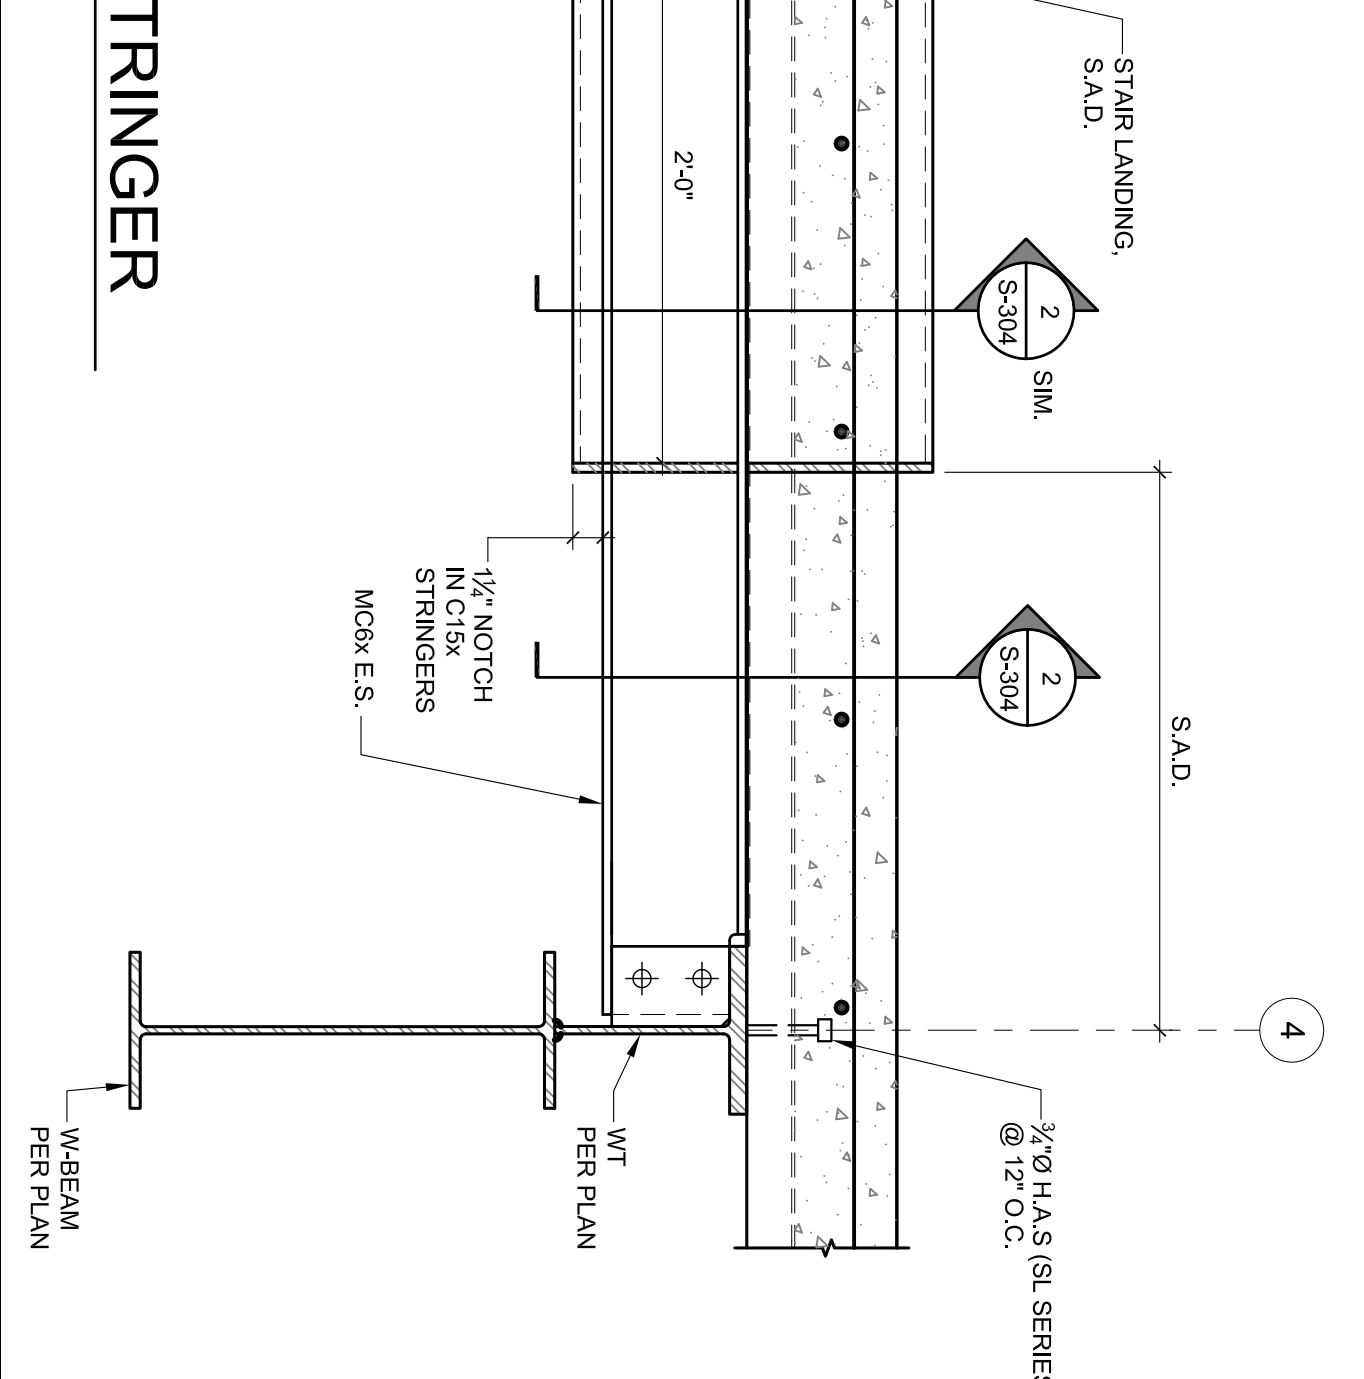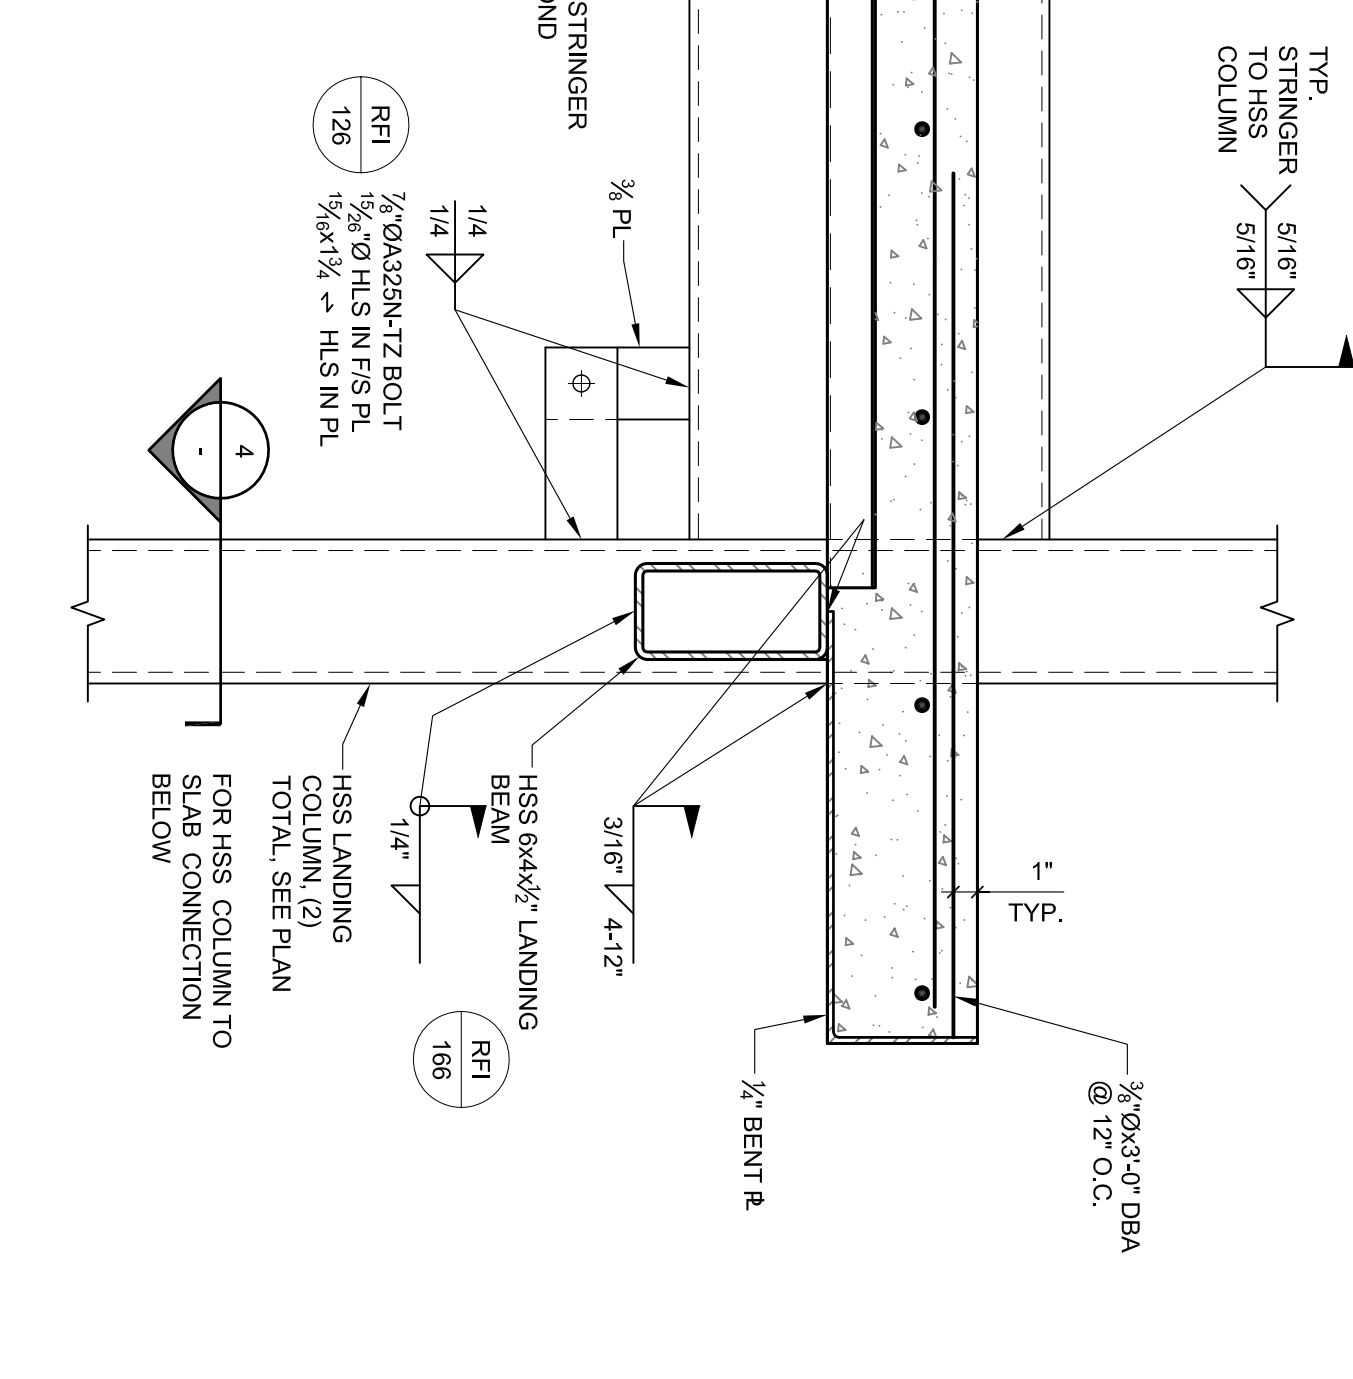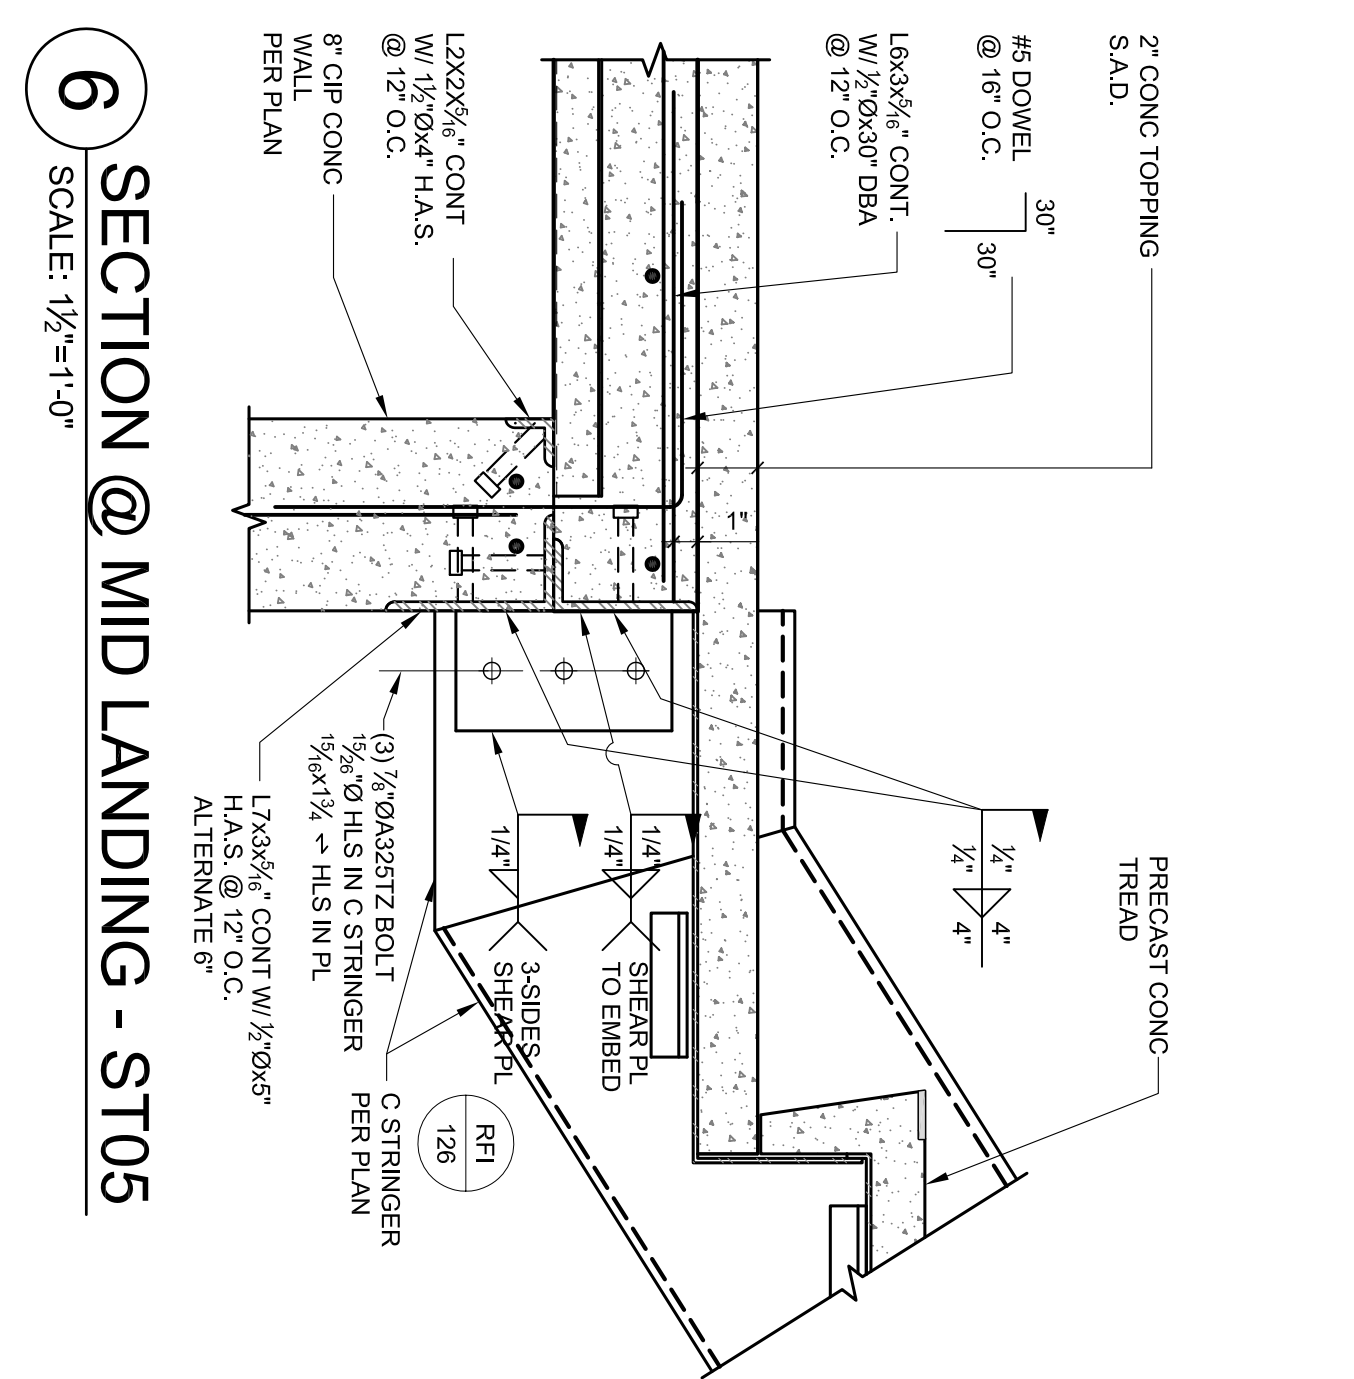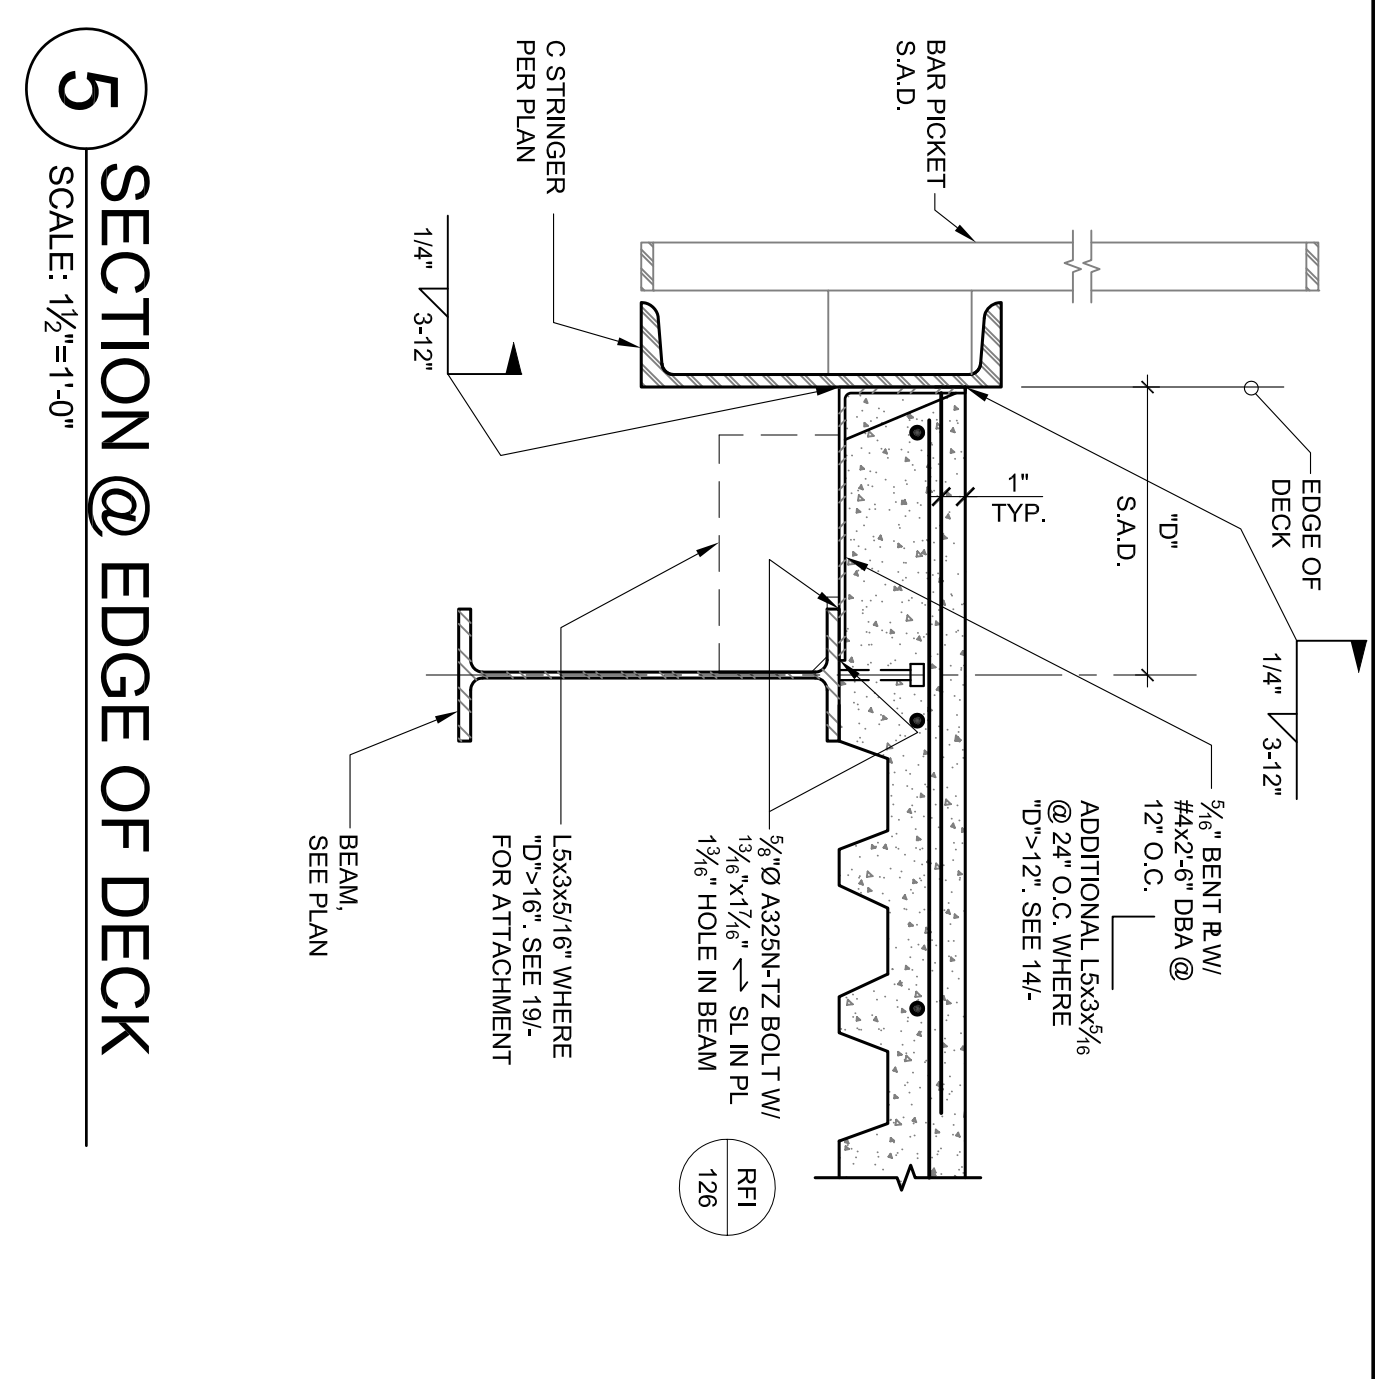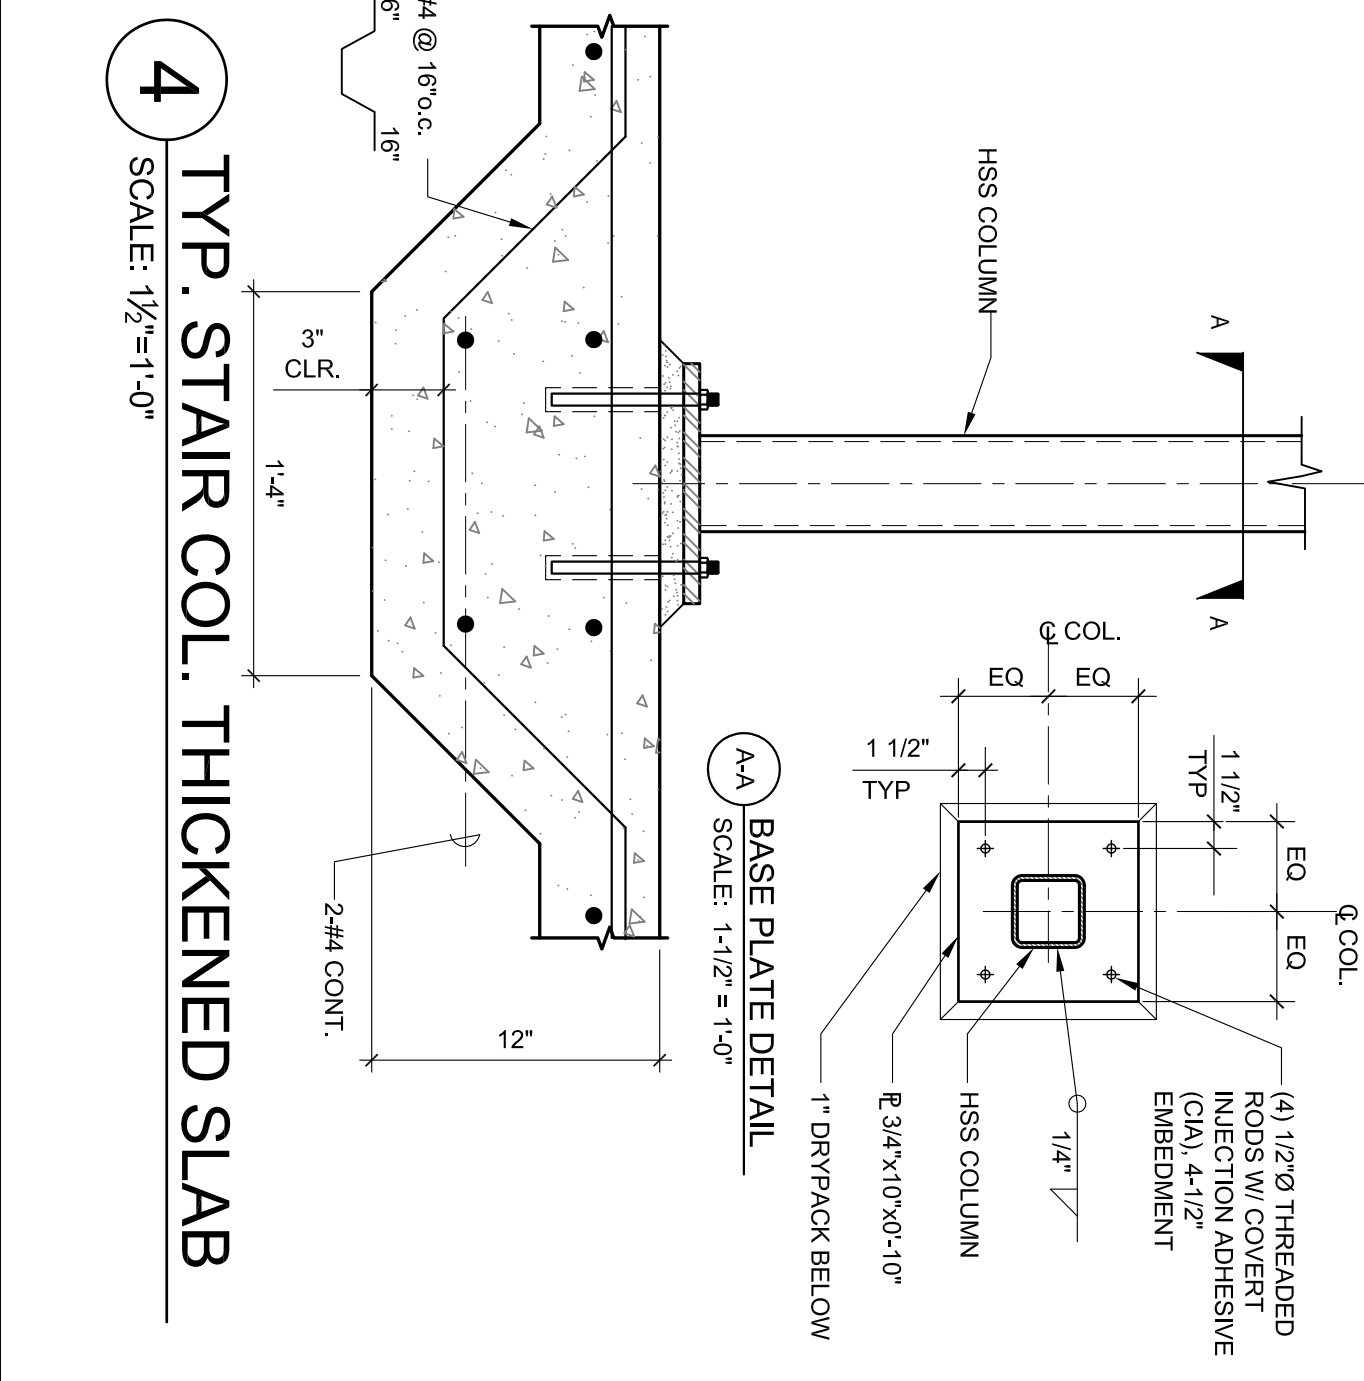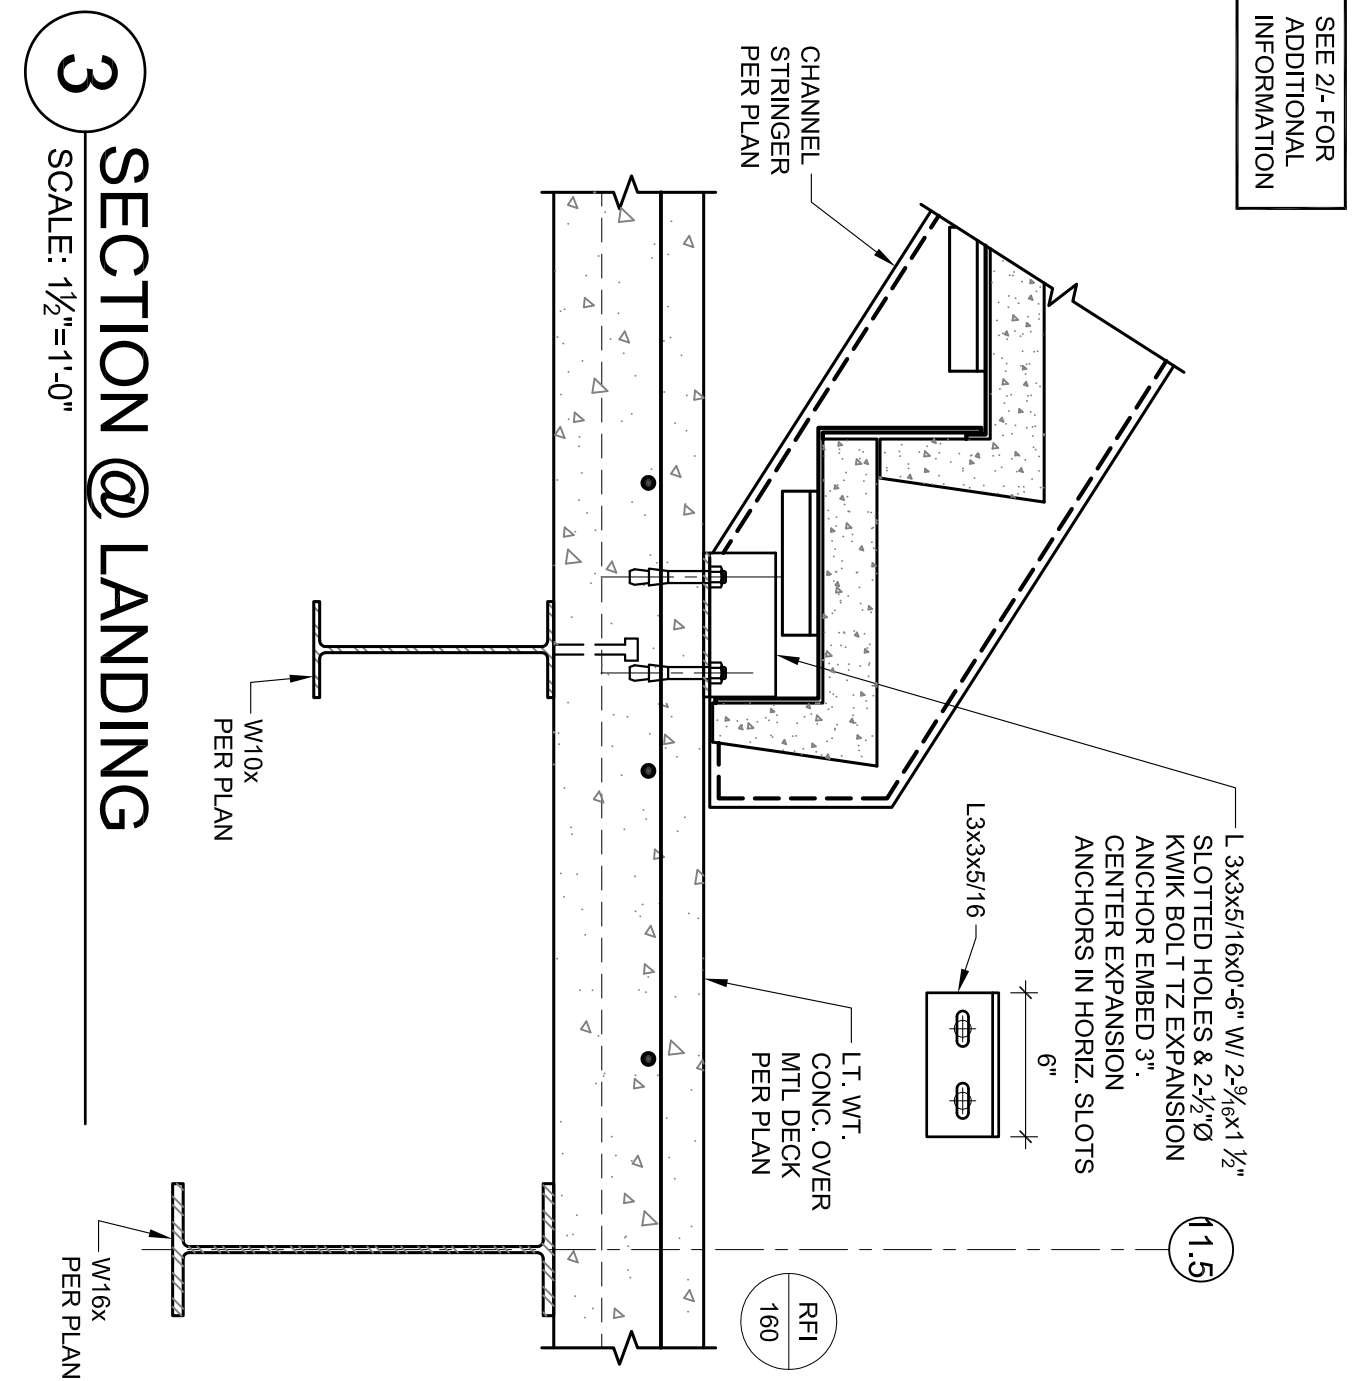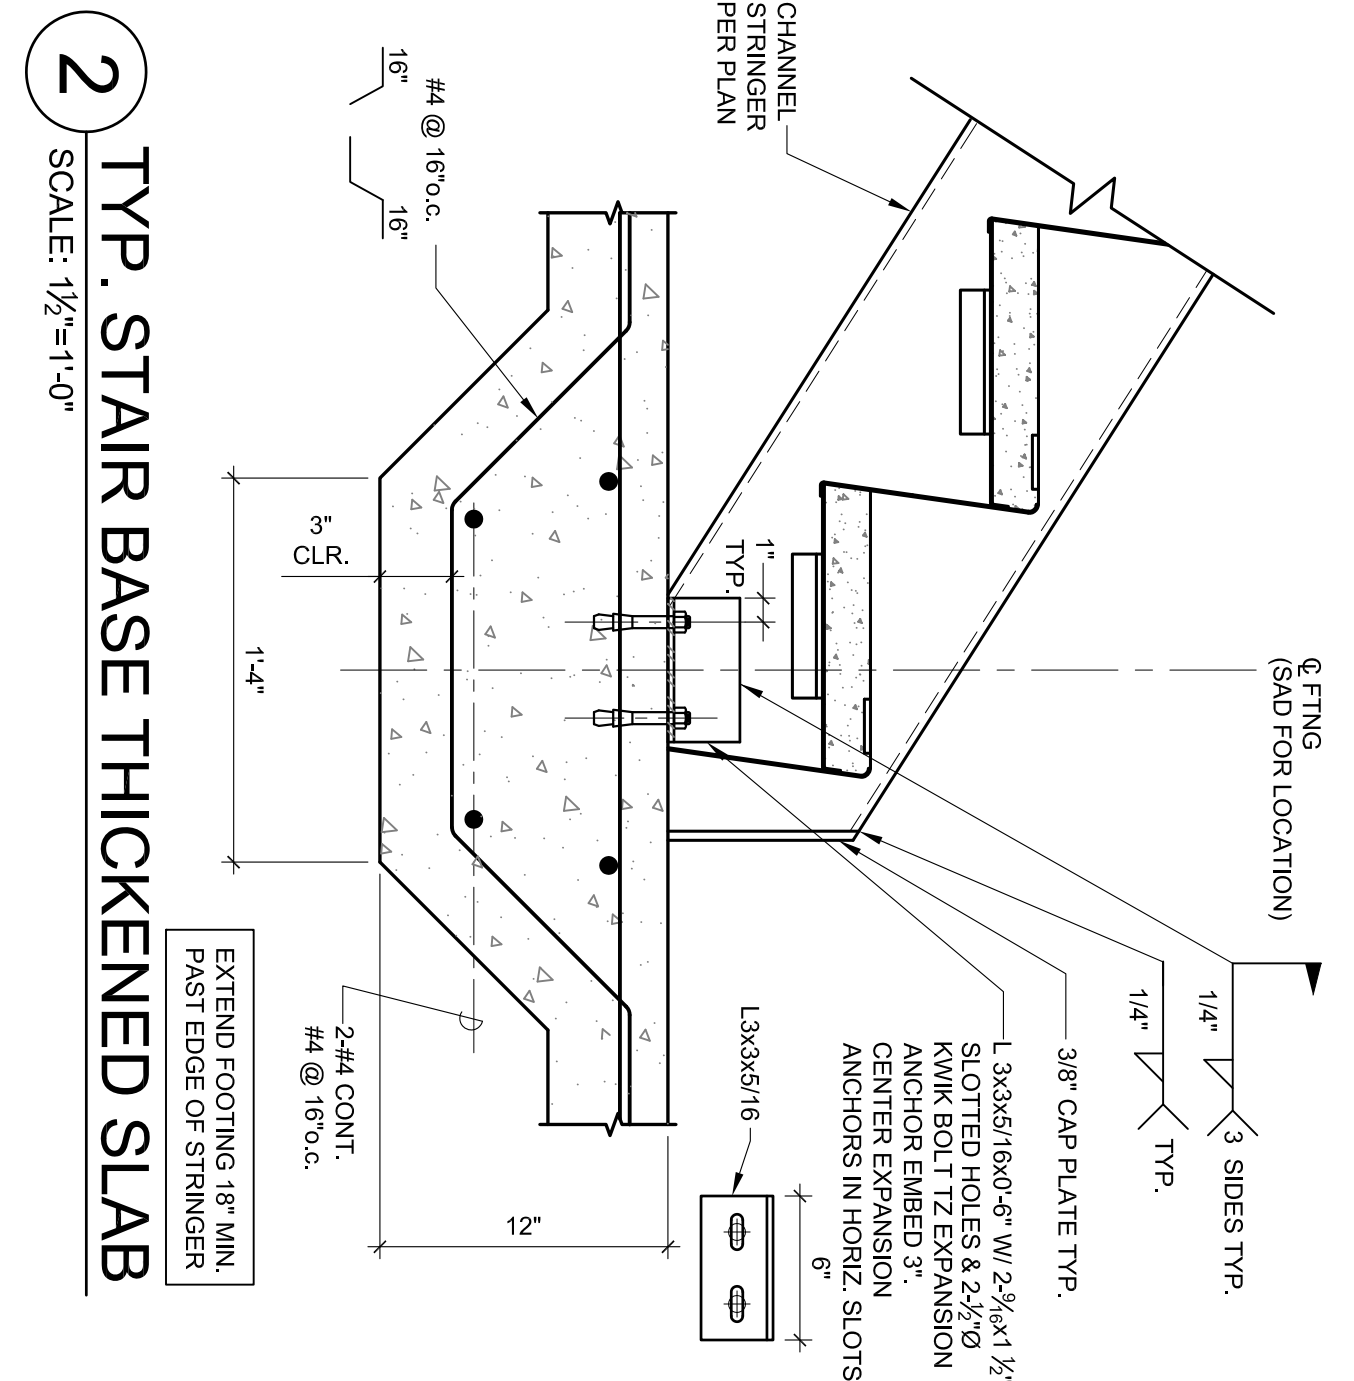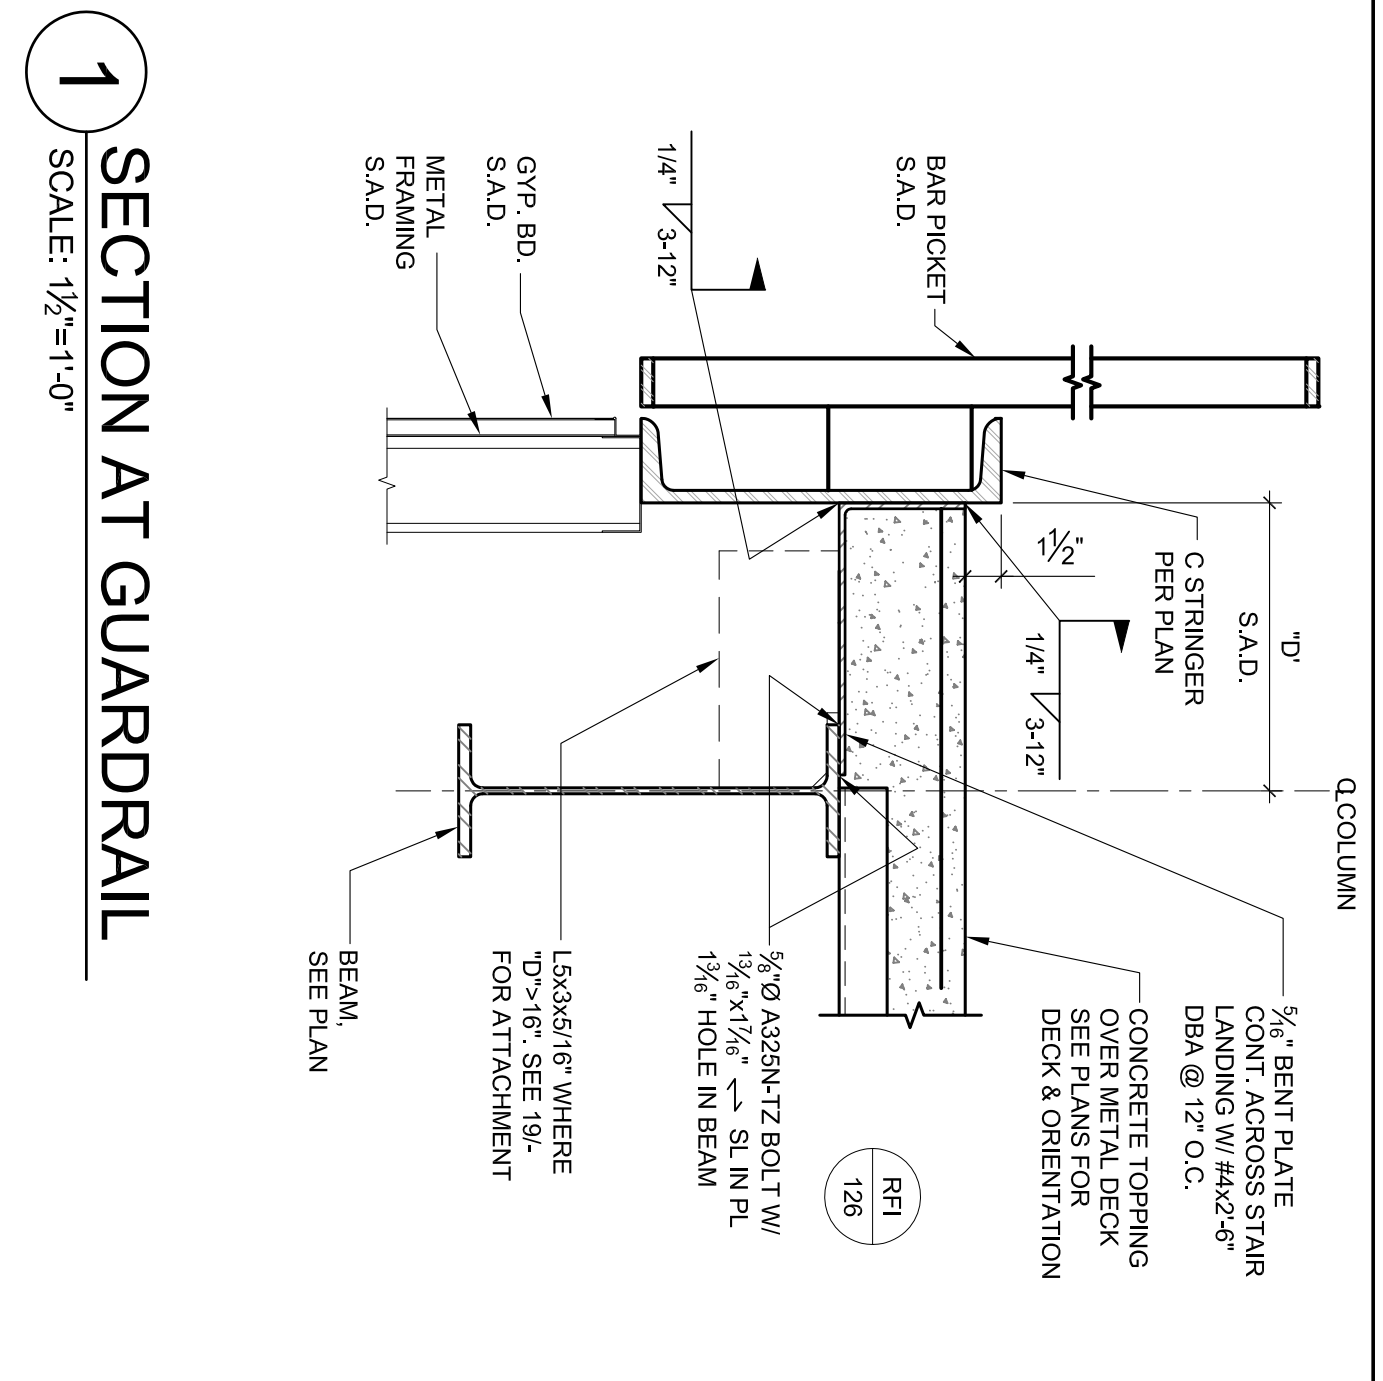


All dimensions and/or other indicated materials herein are standard unless otherwise noted. The contractor shall be responsible for verifying the accuracy of all dimensions and materials. The architect's intent is shown in this drawing. The contractor shall be responsible for obtaining all necessary permits and approvals. The architect is not responsible for any errors or omissions in this drawing.

This drawing is in 100% scale. The drawing has been prepared from the original data. All dimensions and/or other indicated materials herein are standard unless otherwise noted. The contractor shall be responsible for verifying the accuracy of all dimensions and materials. The architect's intent is shown in this drawing. The contractor shall be responsible for obtaining all necessary permits and approvals. The architect is not responsible for any errors or omissions in this drawing.


SEE RFI FOR  
RESPONSE TO  
INDIVIDUAL NUMBERS

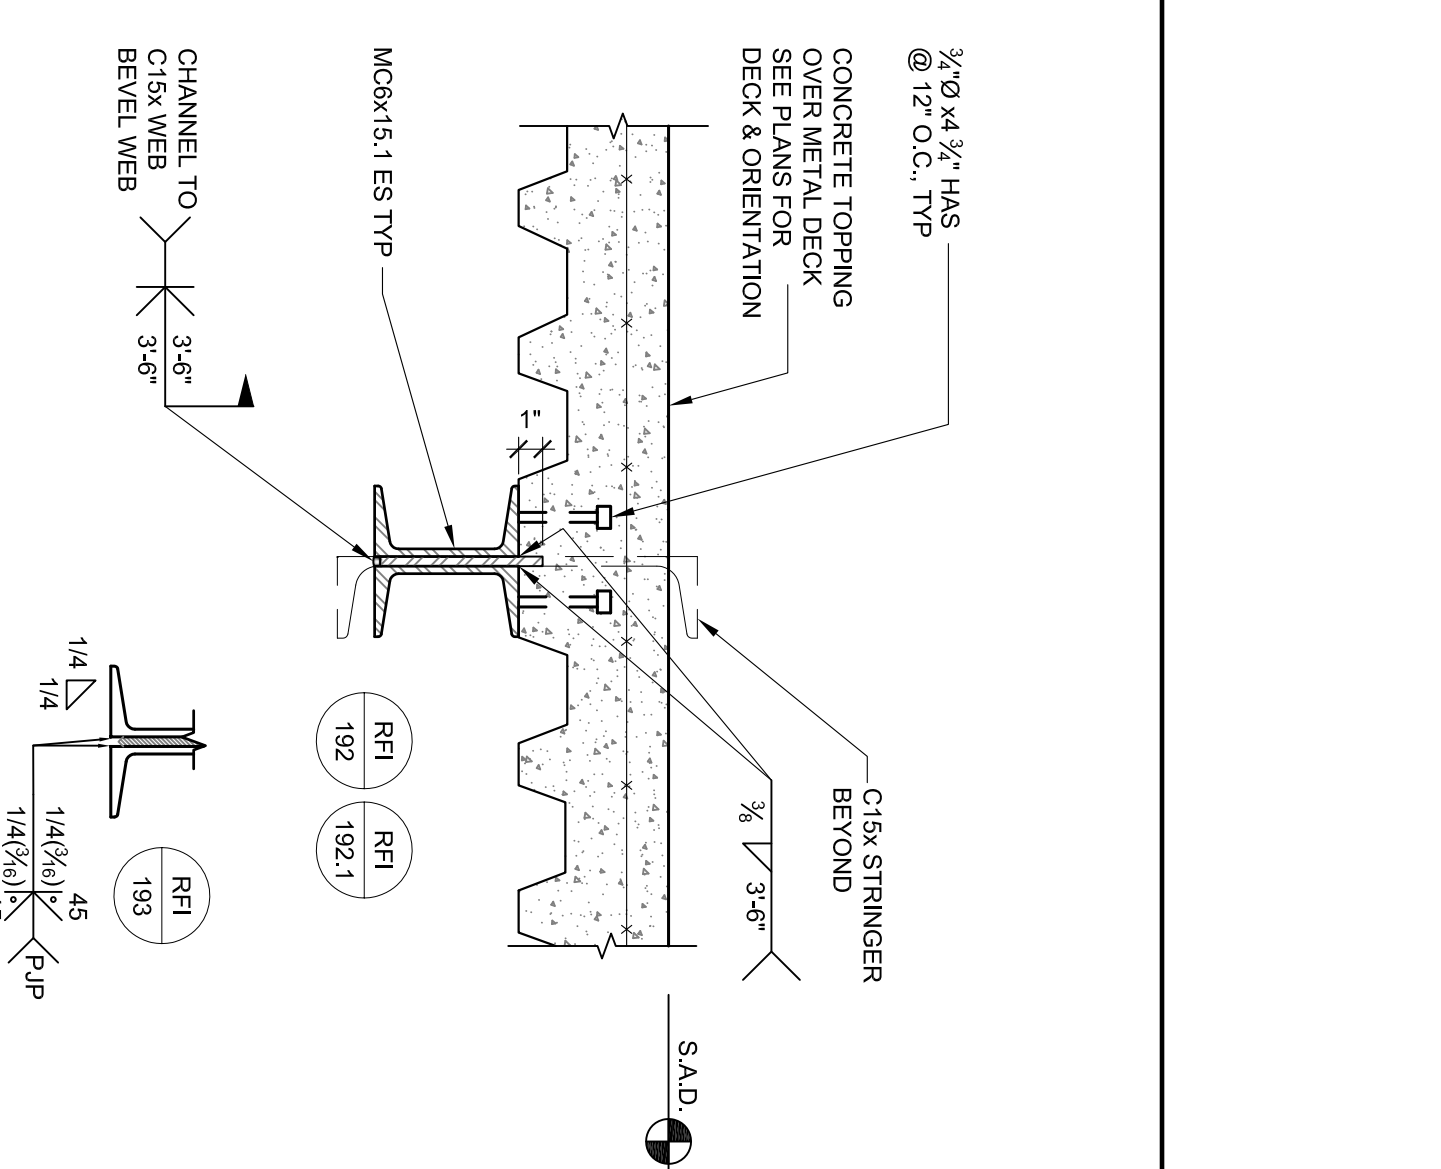

2 DETAIL  
SCALE: 1/2"=1'-0"

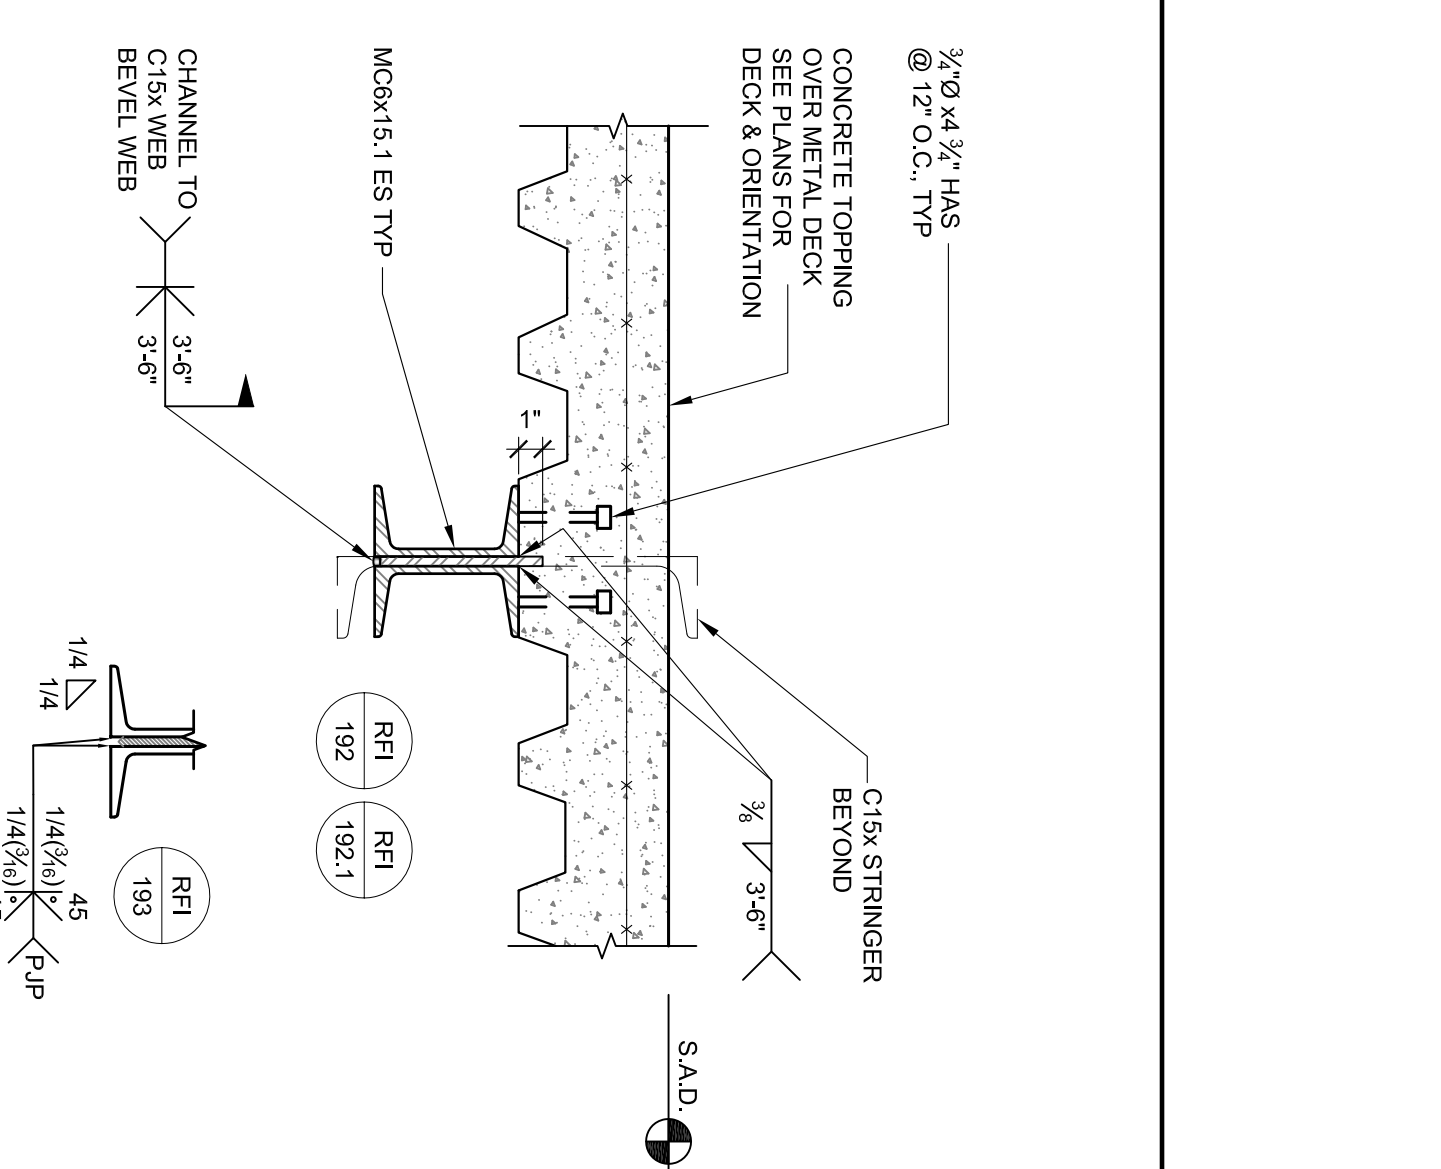


3 SECTION @ MID-STAIR LANDING  
SCALE: 1/2"=1'-0"

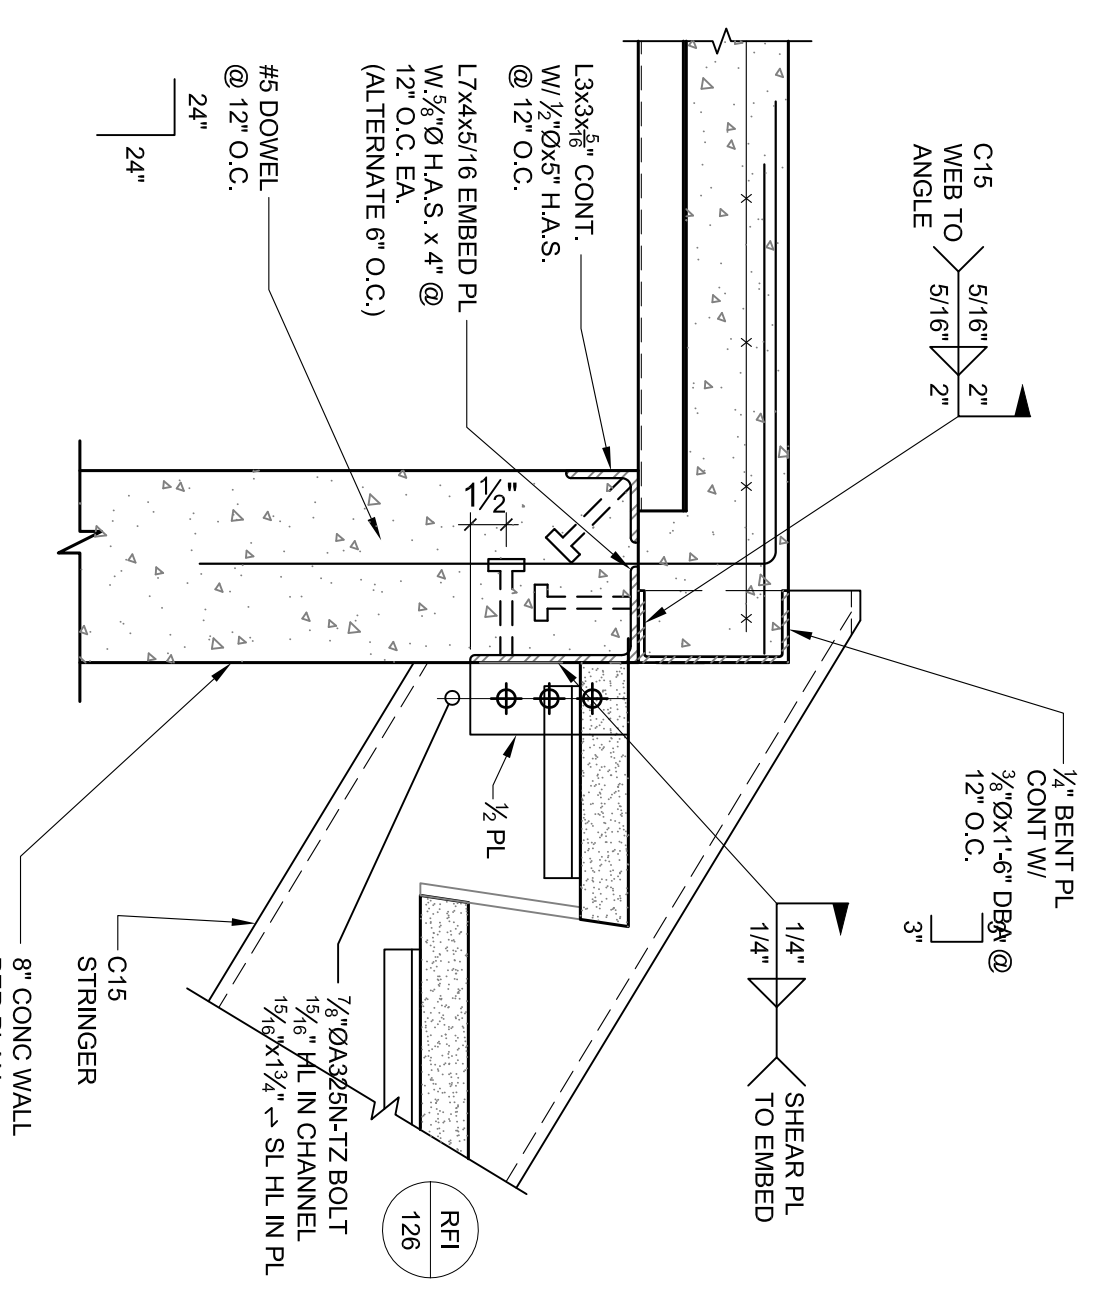


4 STRINGER CONNECTION  
SCALE: 1/2"=1'-0"


5 TYPICAL STRINGER TO  
STRINGER CONNECTION  
SCALE: 1/2"=1'-0"

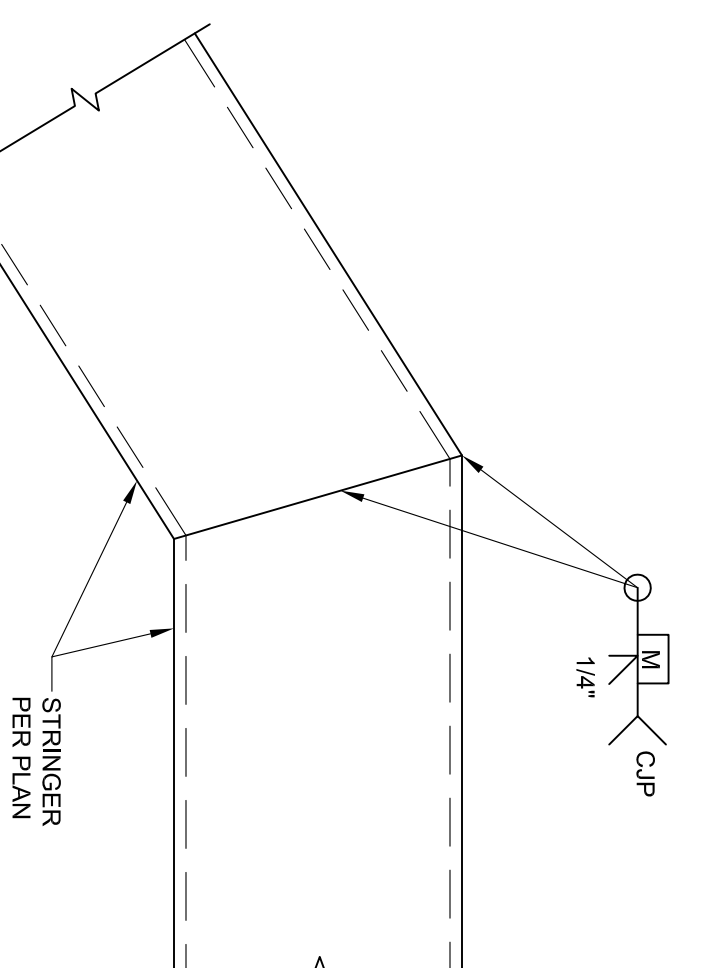


6 TYPICAL PRECAST CONC. TREAD  
SCALE: 1/2"=1'-0"

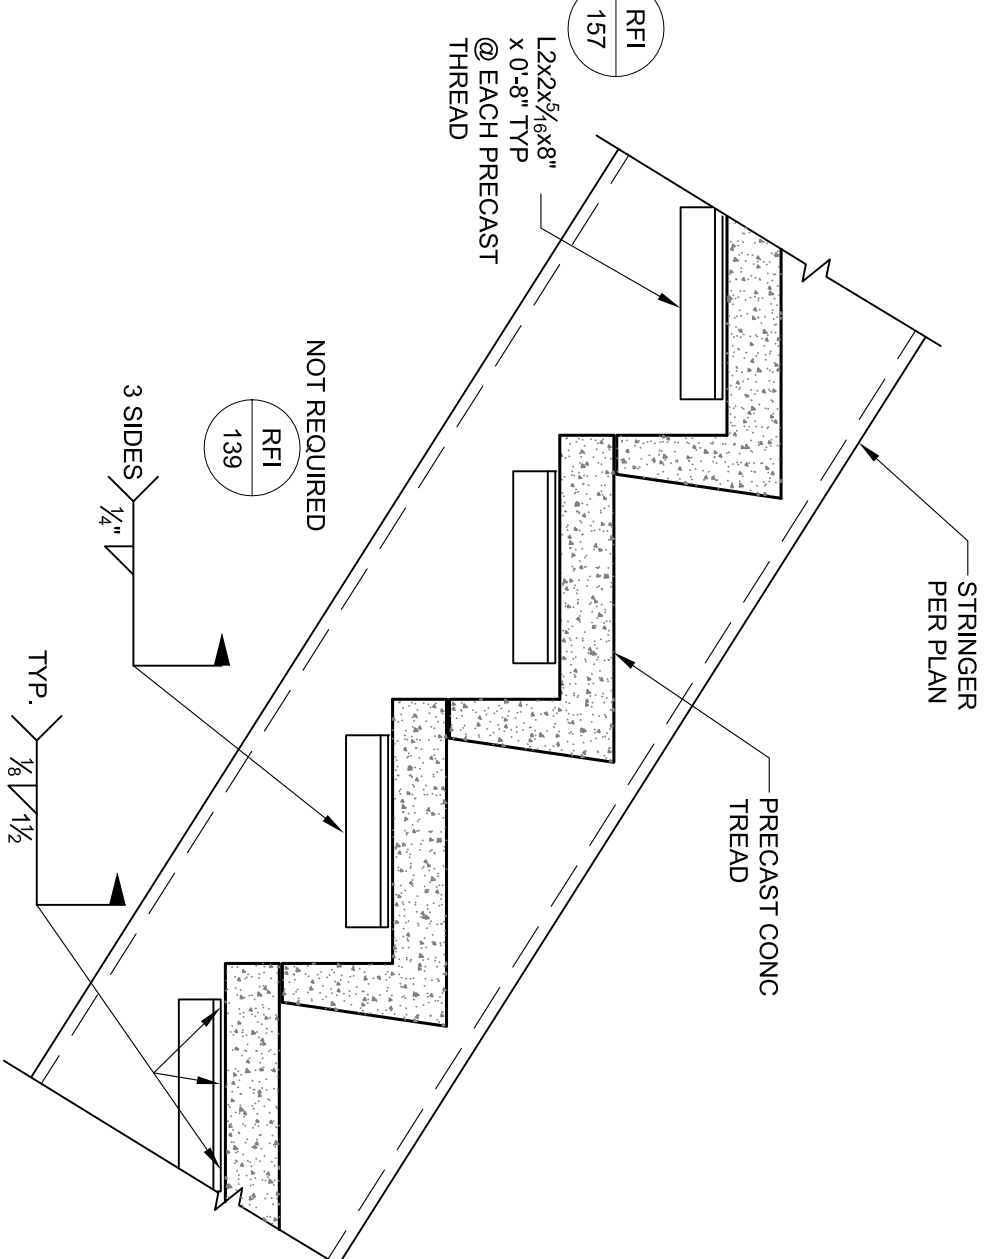


7 TYPICAL METAL PAN TREAD  
SCALE: 1/2"=1'-0"

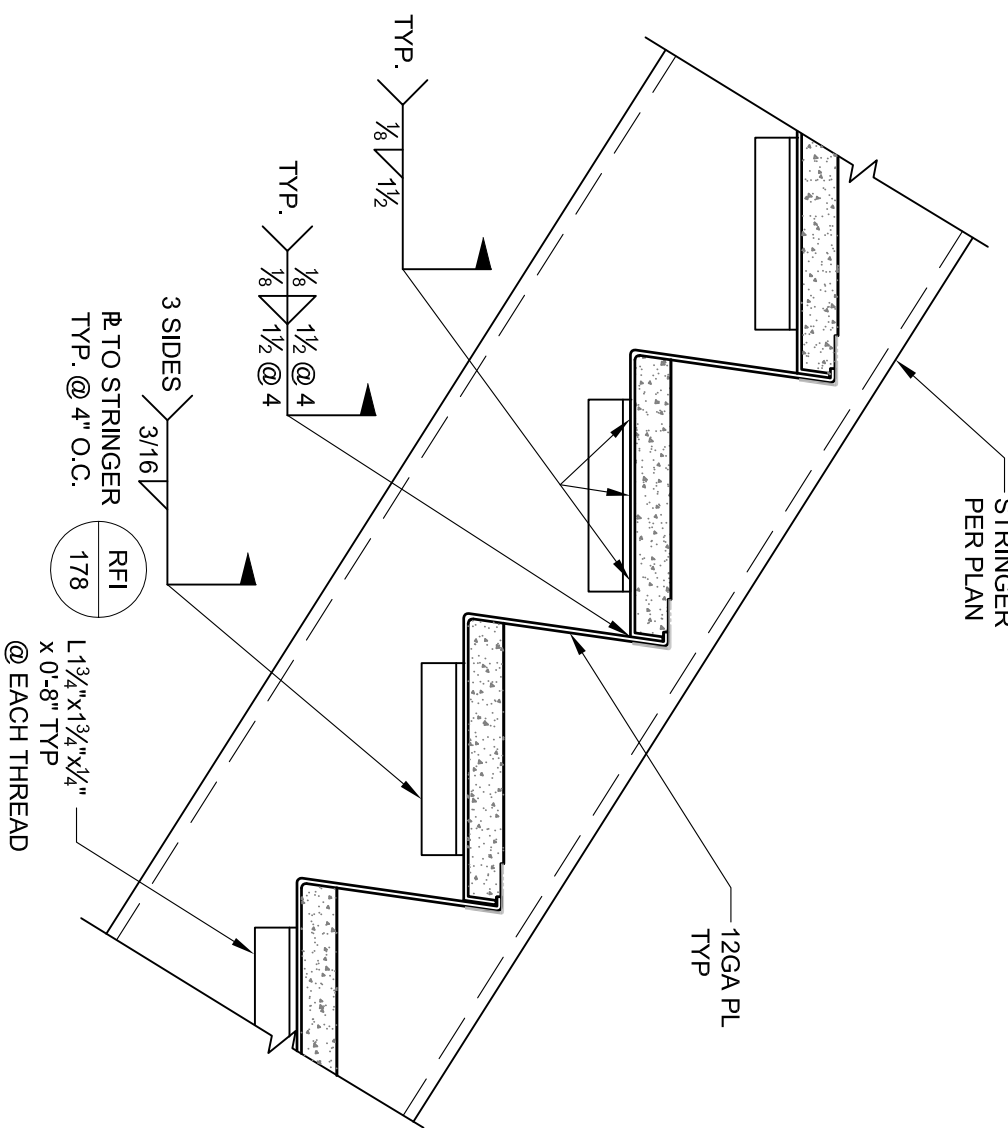


9 SECTION AT MID-STAIR LANDING  
(STAIR #06)  
SCALE: 1/2"=1'-0"

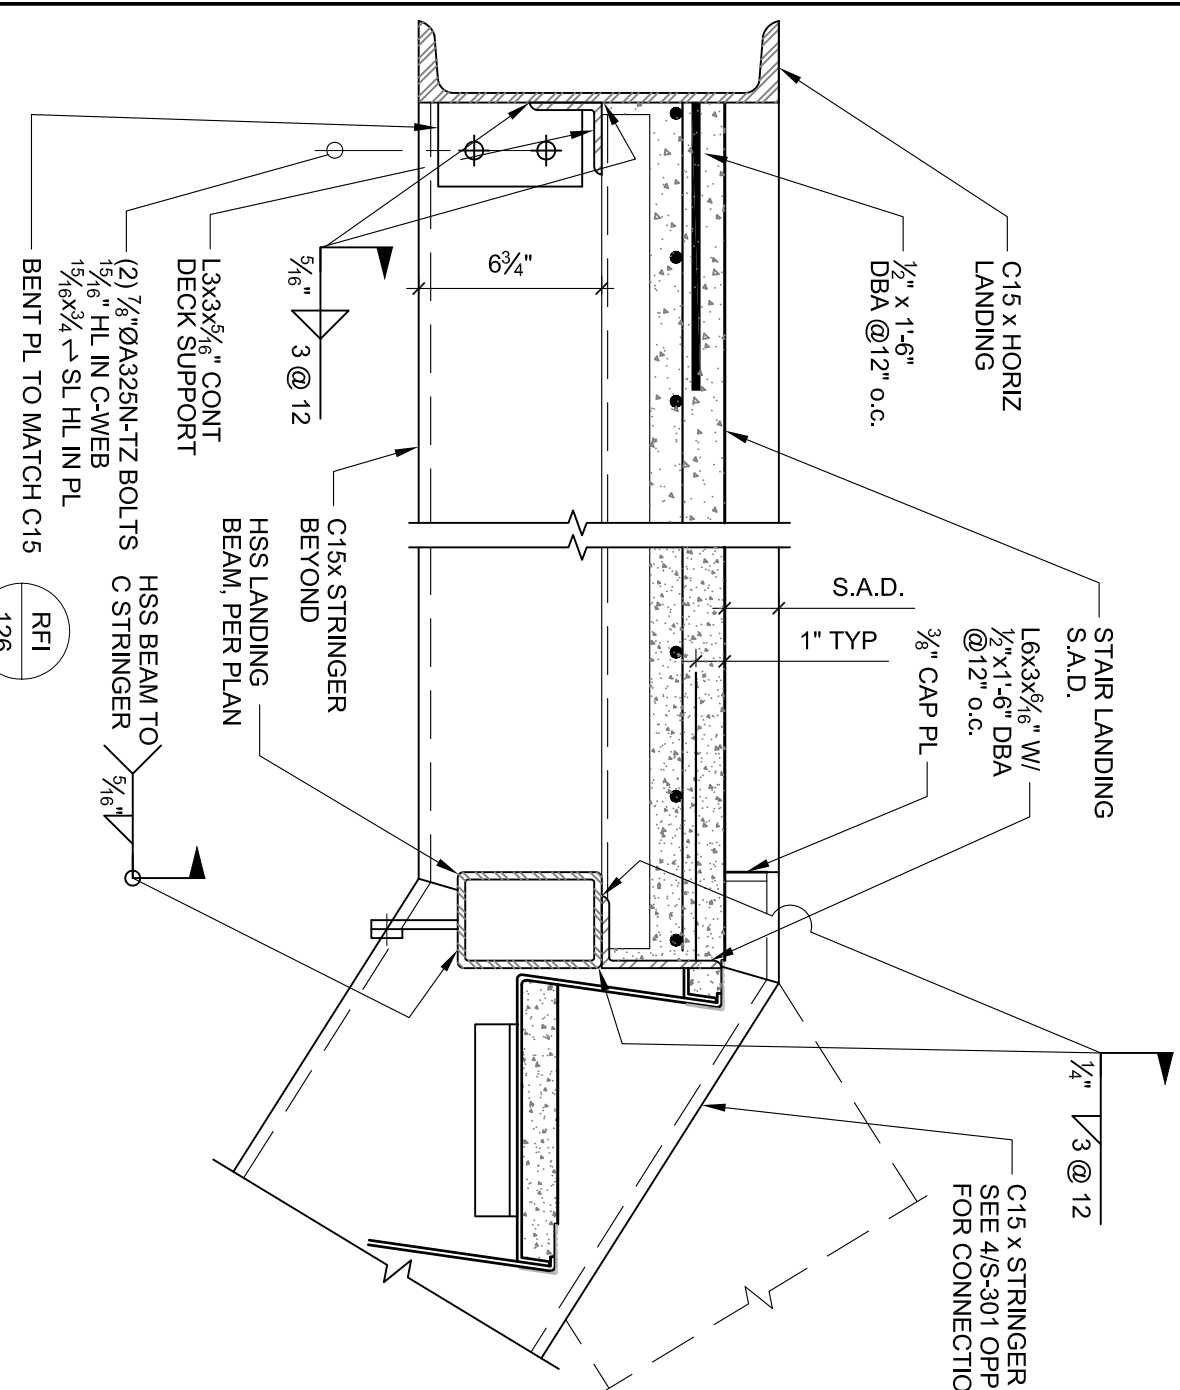


10 SECTION  
SCALE: 1/2"=1'-0"

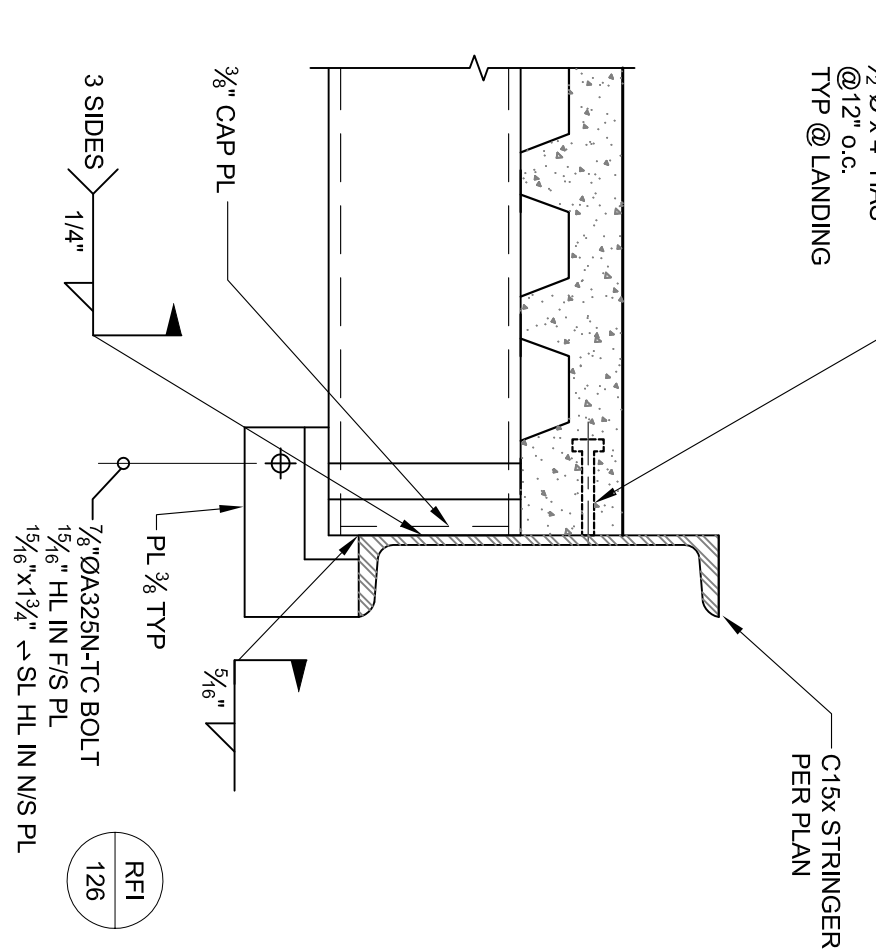


11 SECTION AT MID-STAIR LANDING  
SCALE: 1/2"=1'-0"

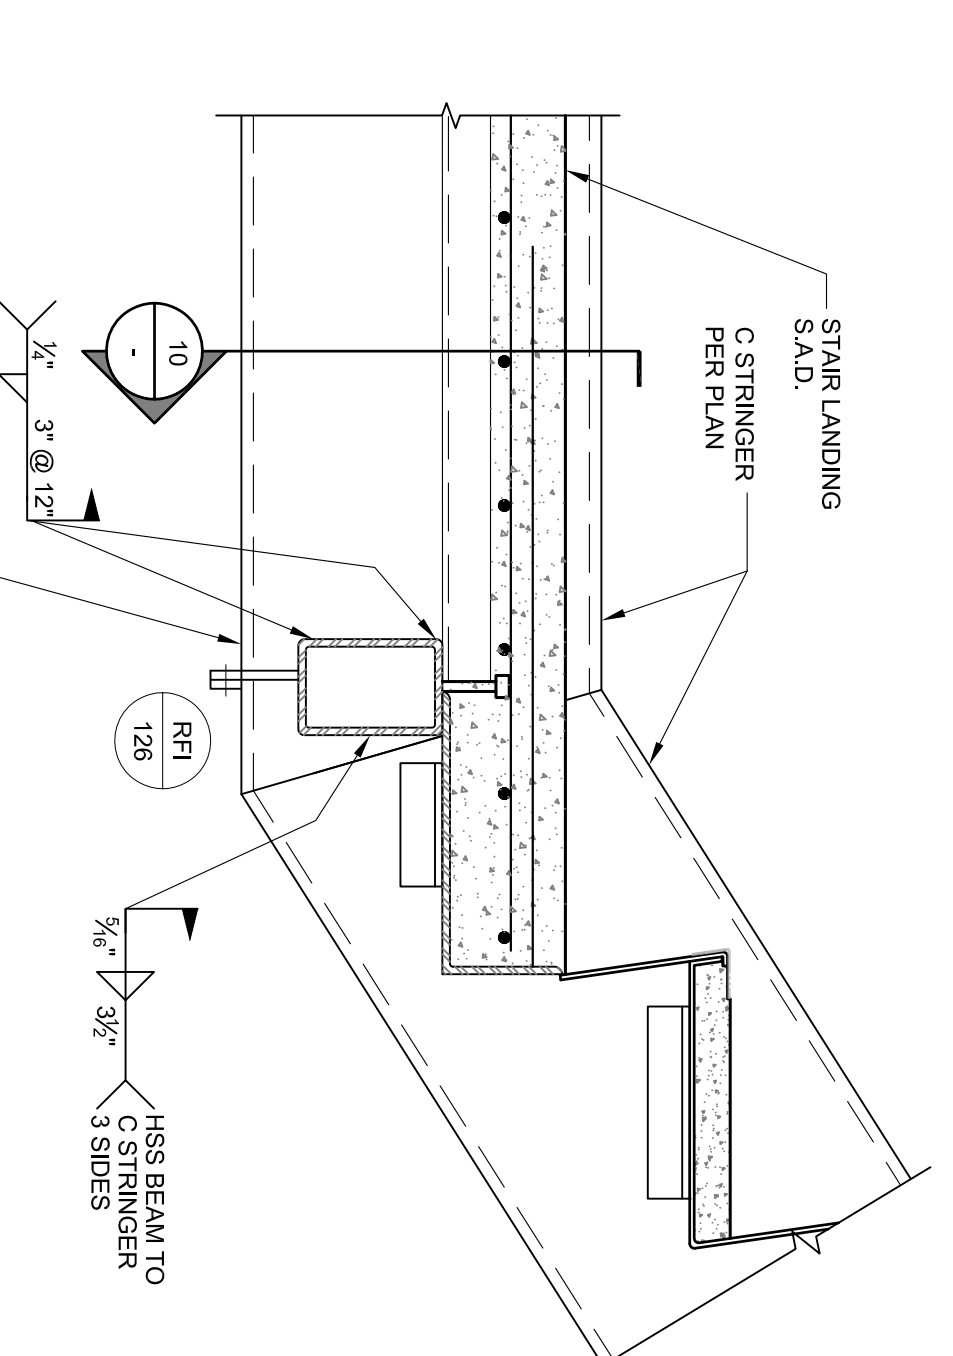


13 SECTION  
SCALE: 1/2"=1'-0"

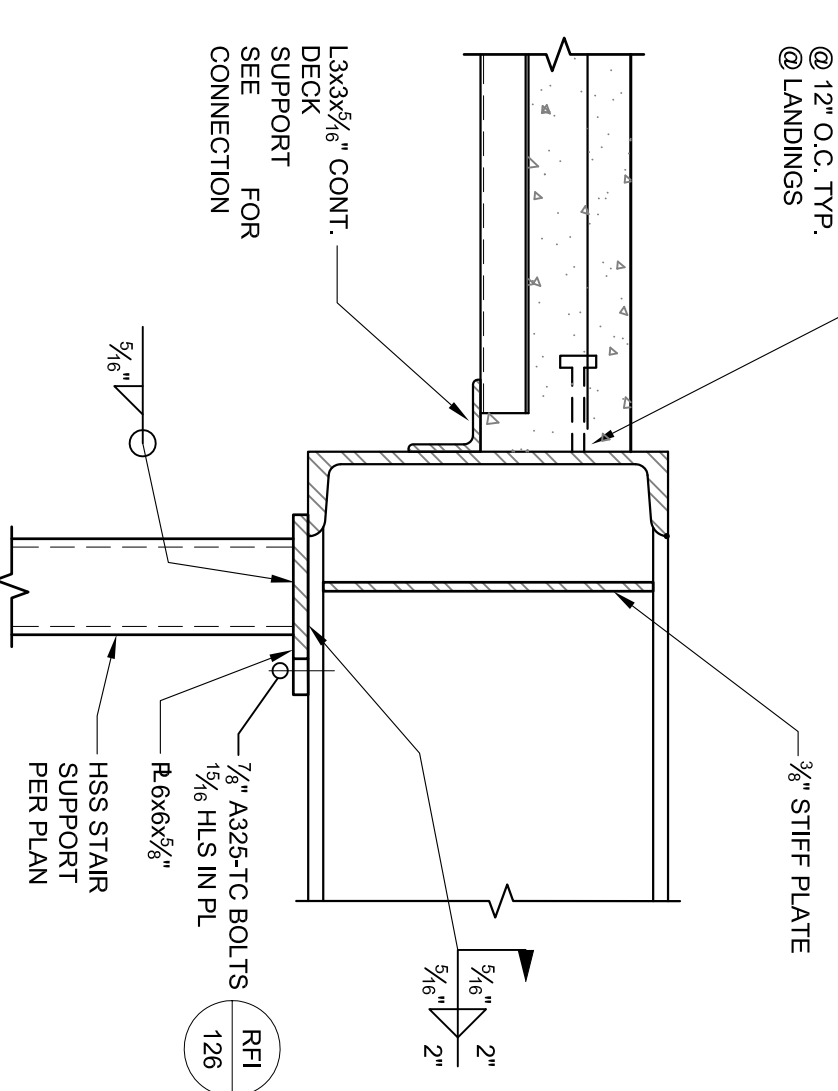


14 STRINGER CONNECTION  
SCALE: 1/2"=1'-0"

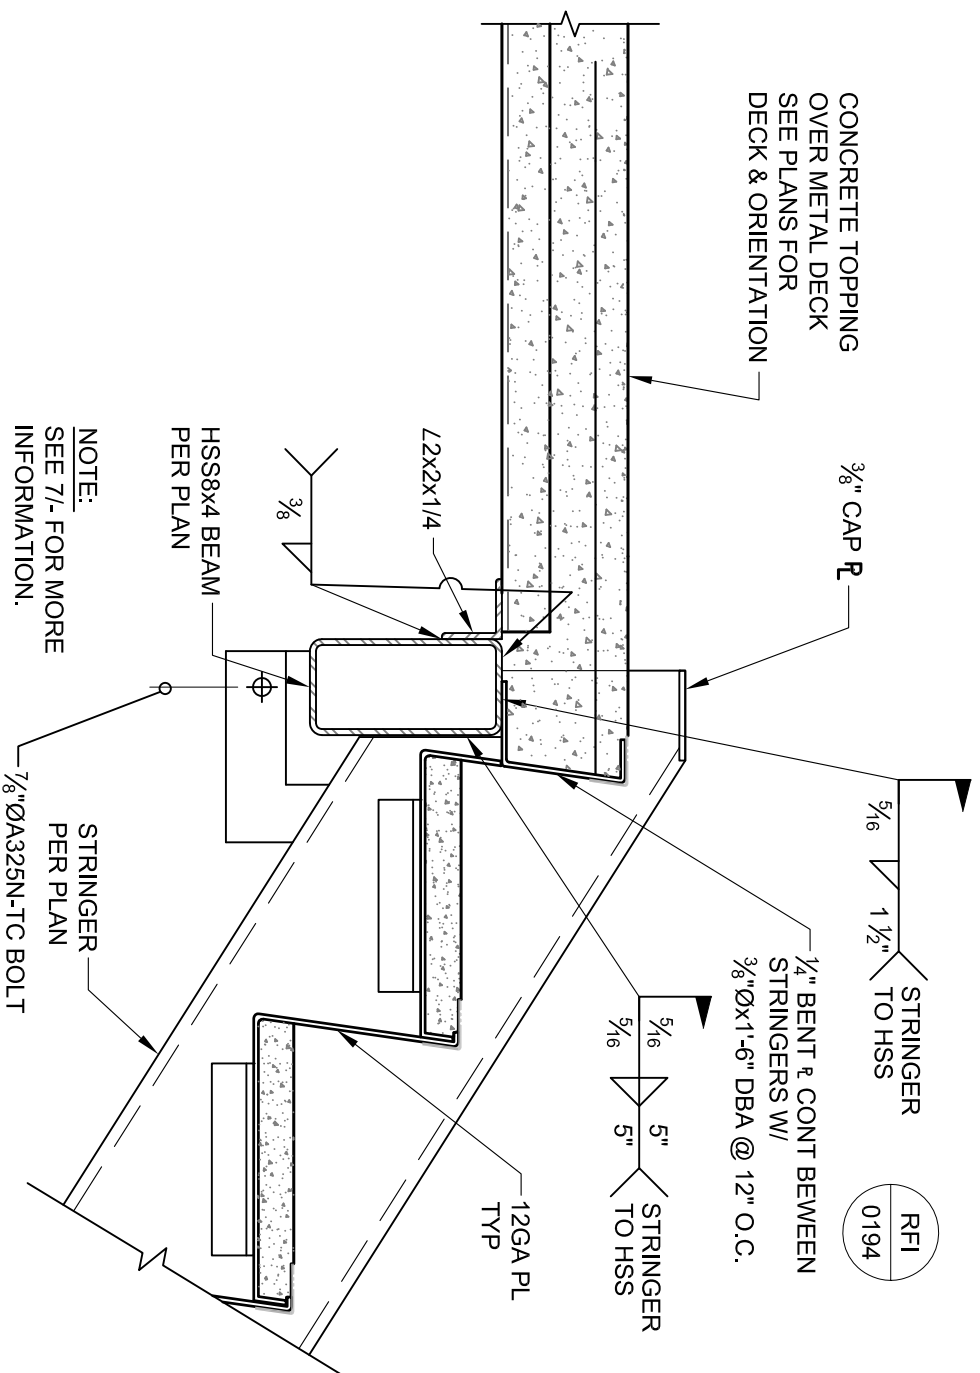


15 SECTION AT MID-STAIR LANDING  
SCALE: 1/2"=1'-0"

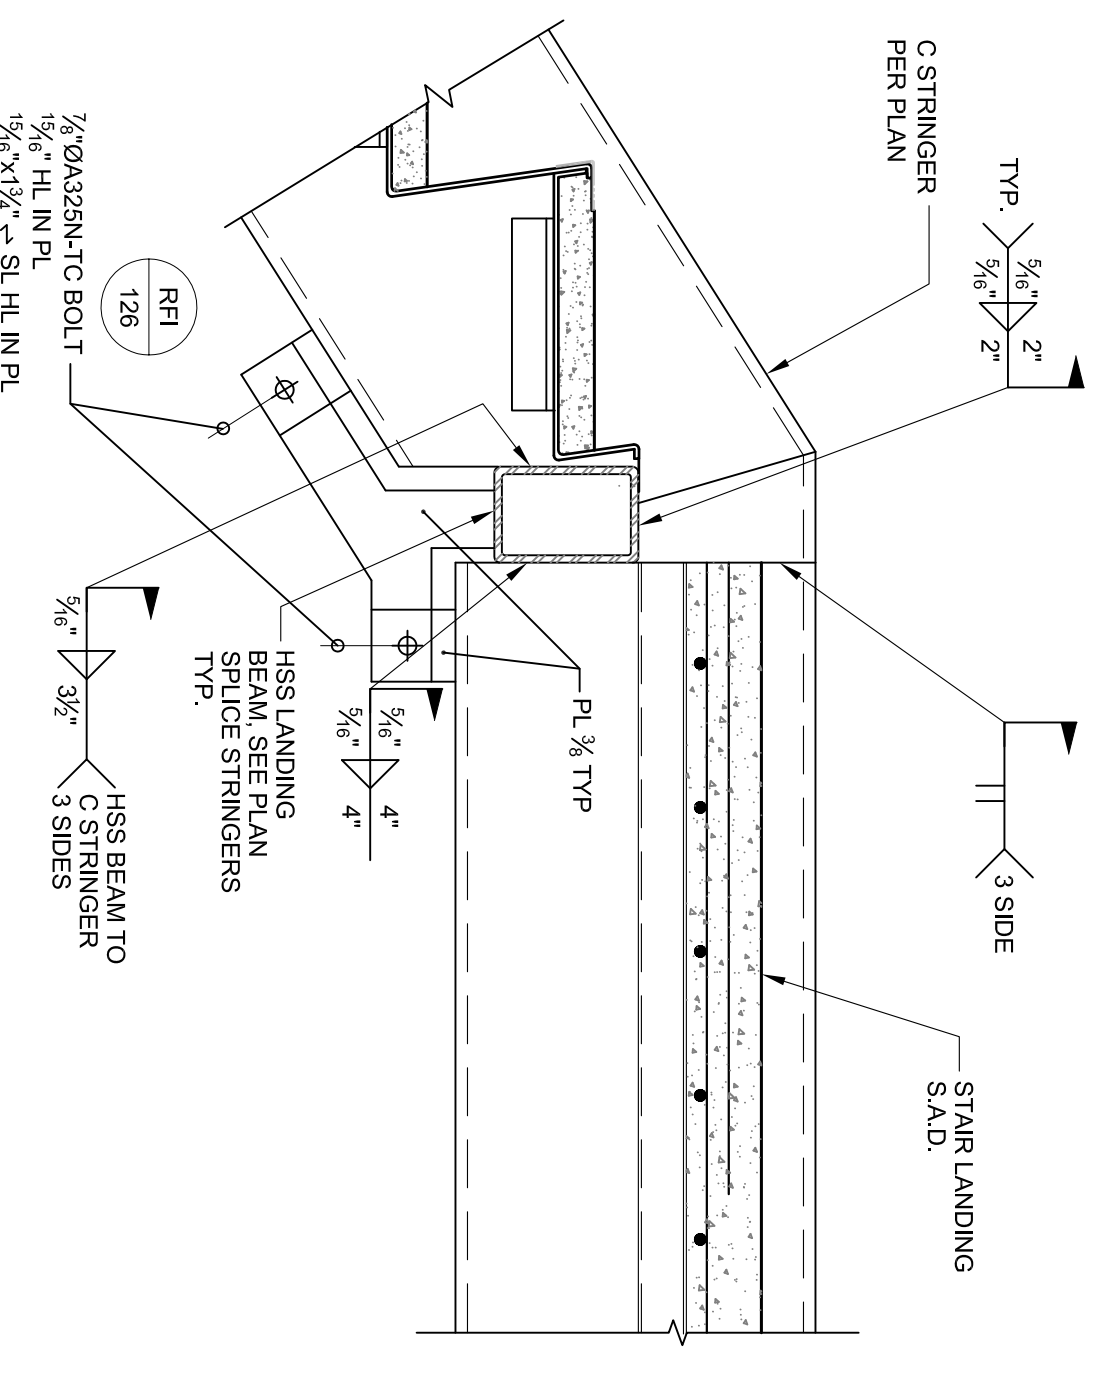


17 ENLARGED PLAN - ST05 - LEVEL 2  
SCALE: 1/2"=1'-0"

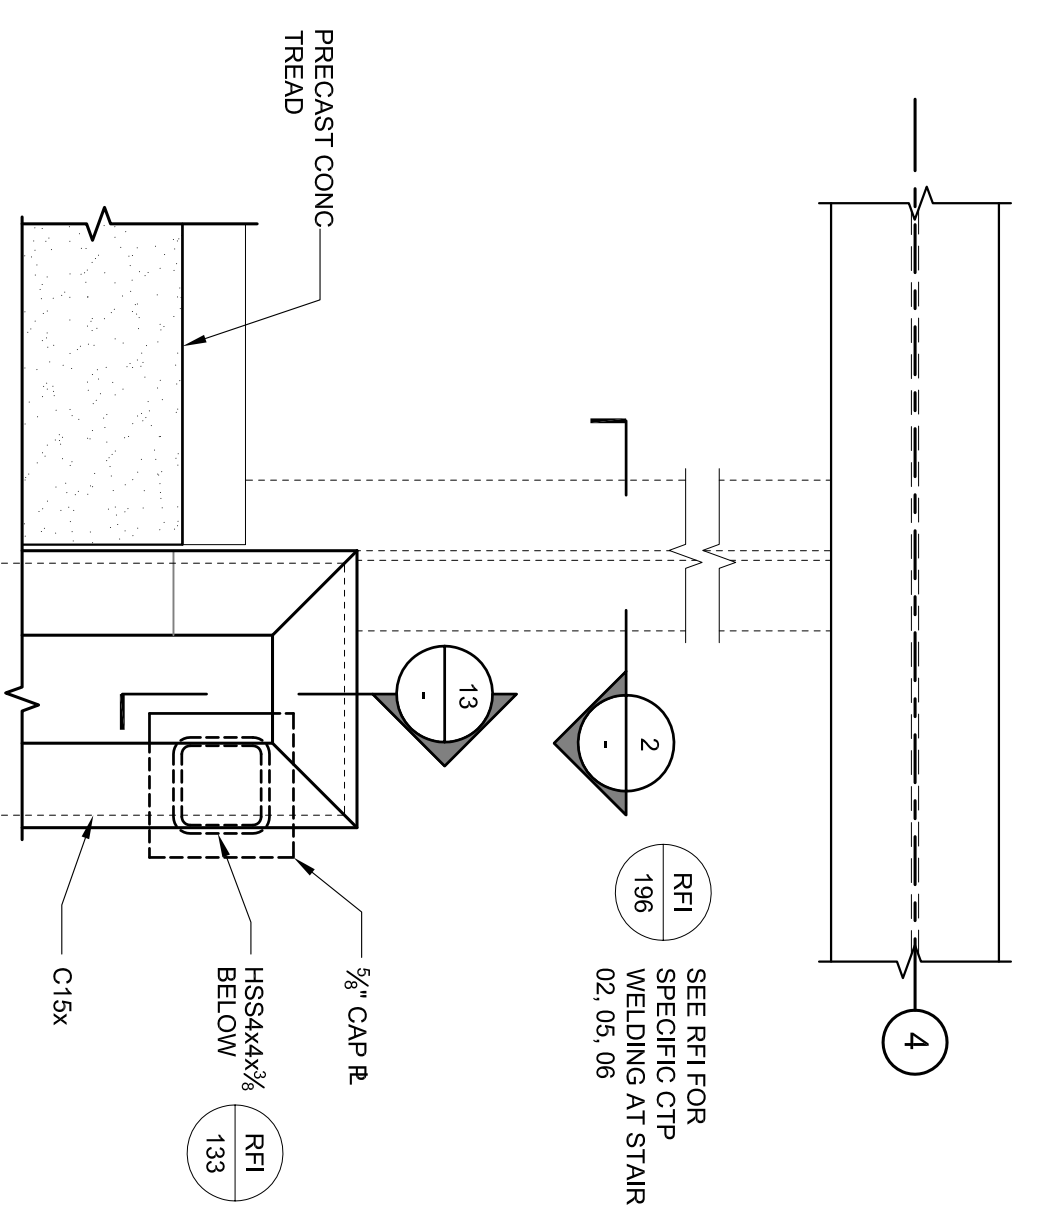


18 DETAIL  
SCALE: 1/2"=1'-0"

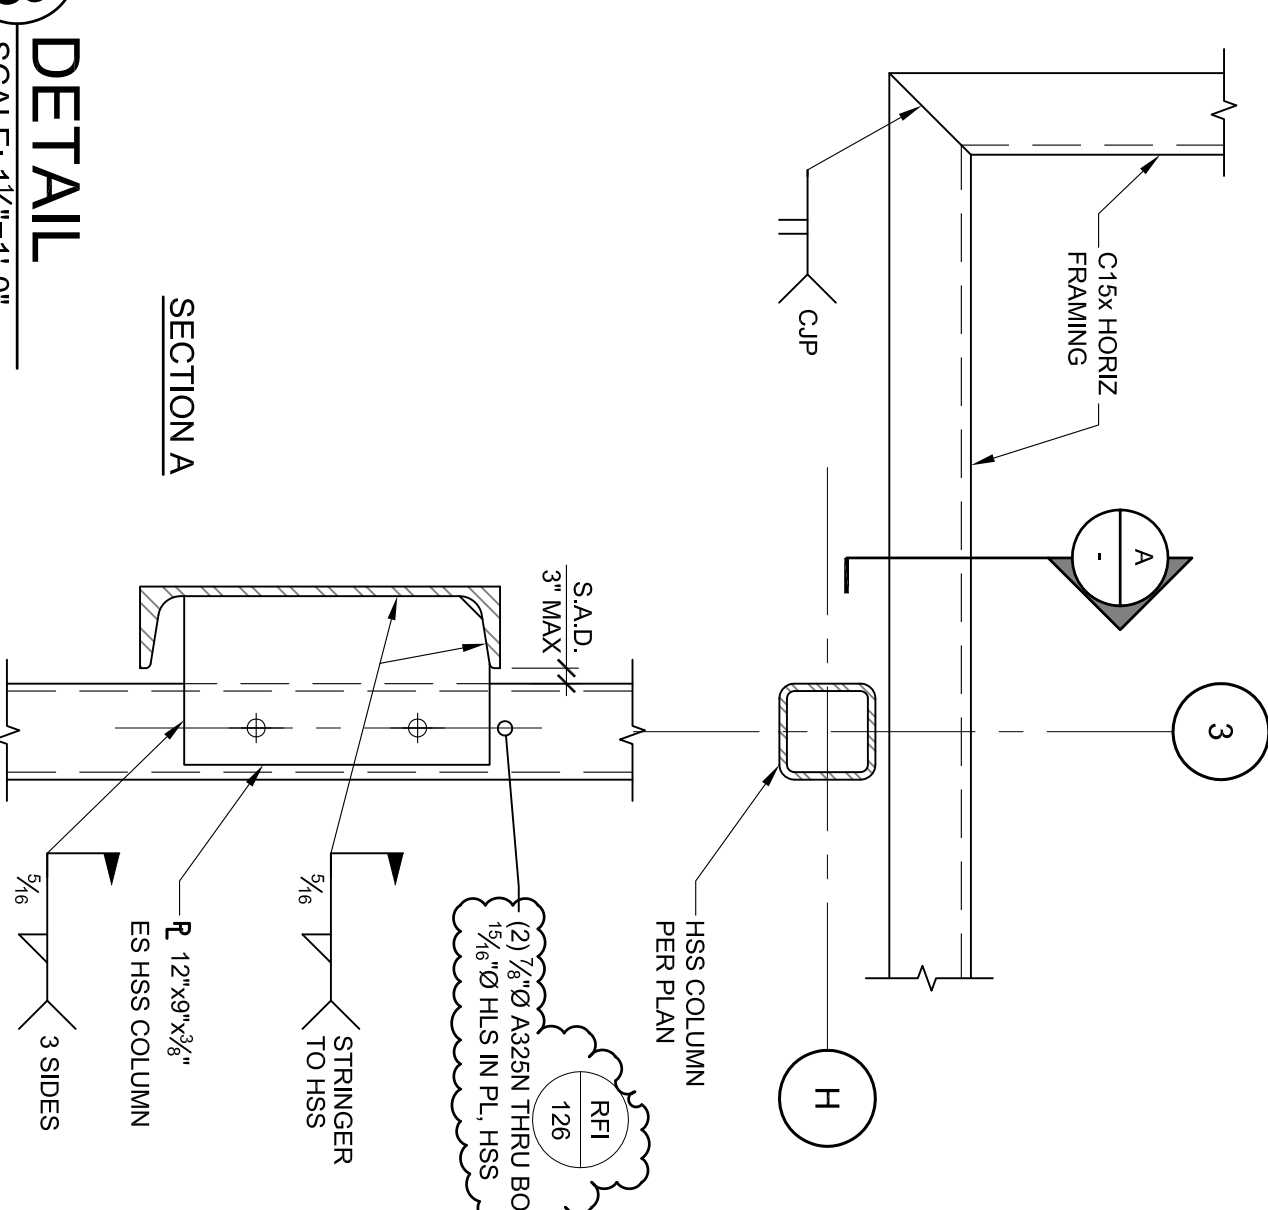


19 SECTION AT POST  
SCALE: 1/2"=1'-0"

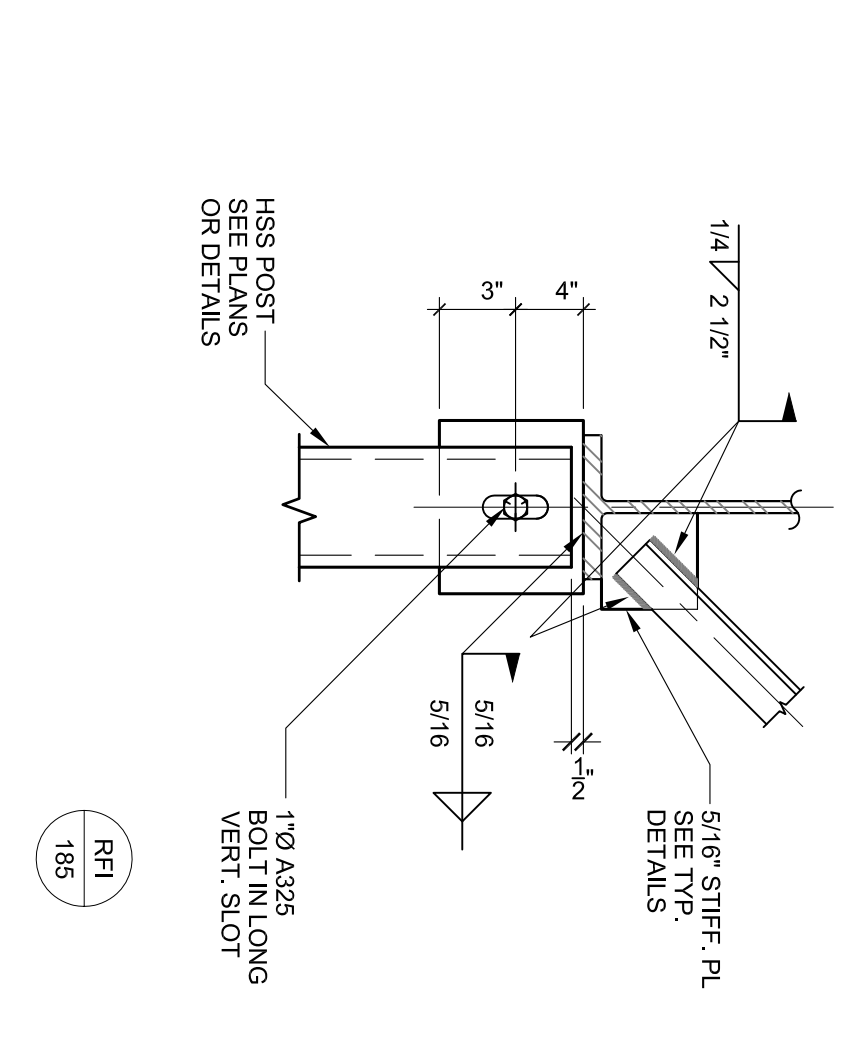


16 SECTION AT LANDING  
SCALE: 1/2"=1'-0"

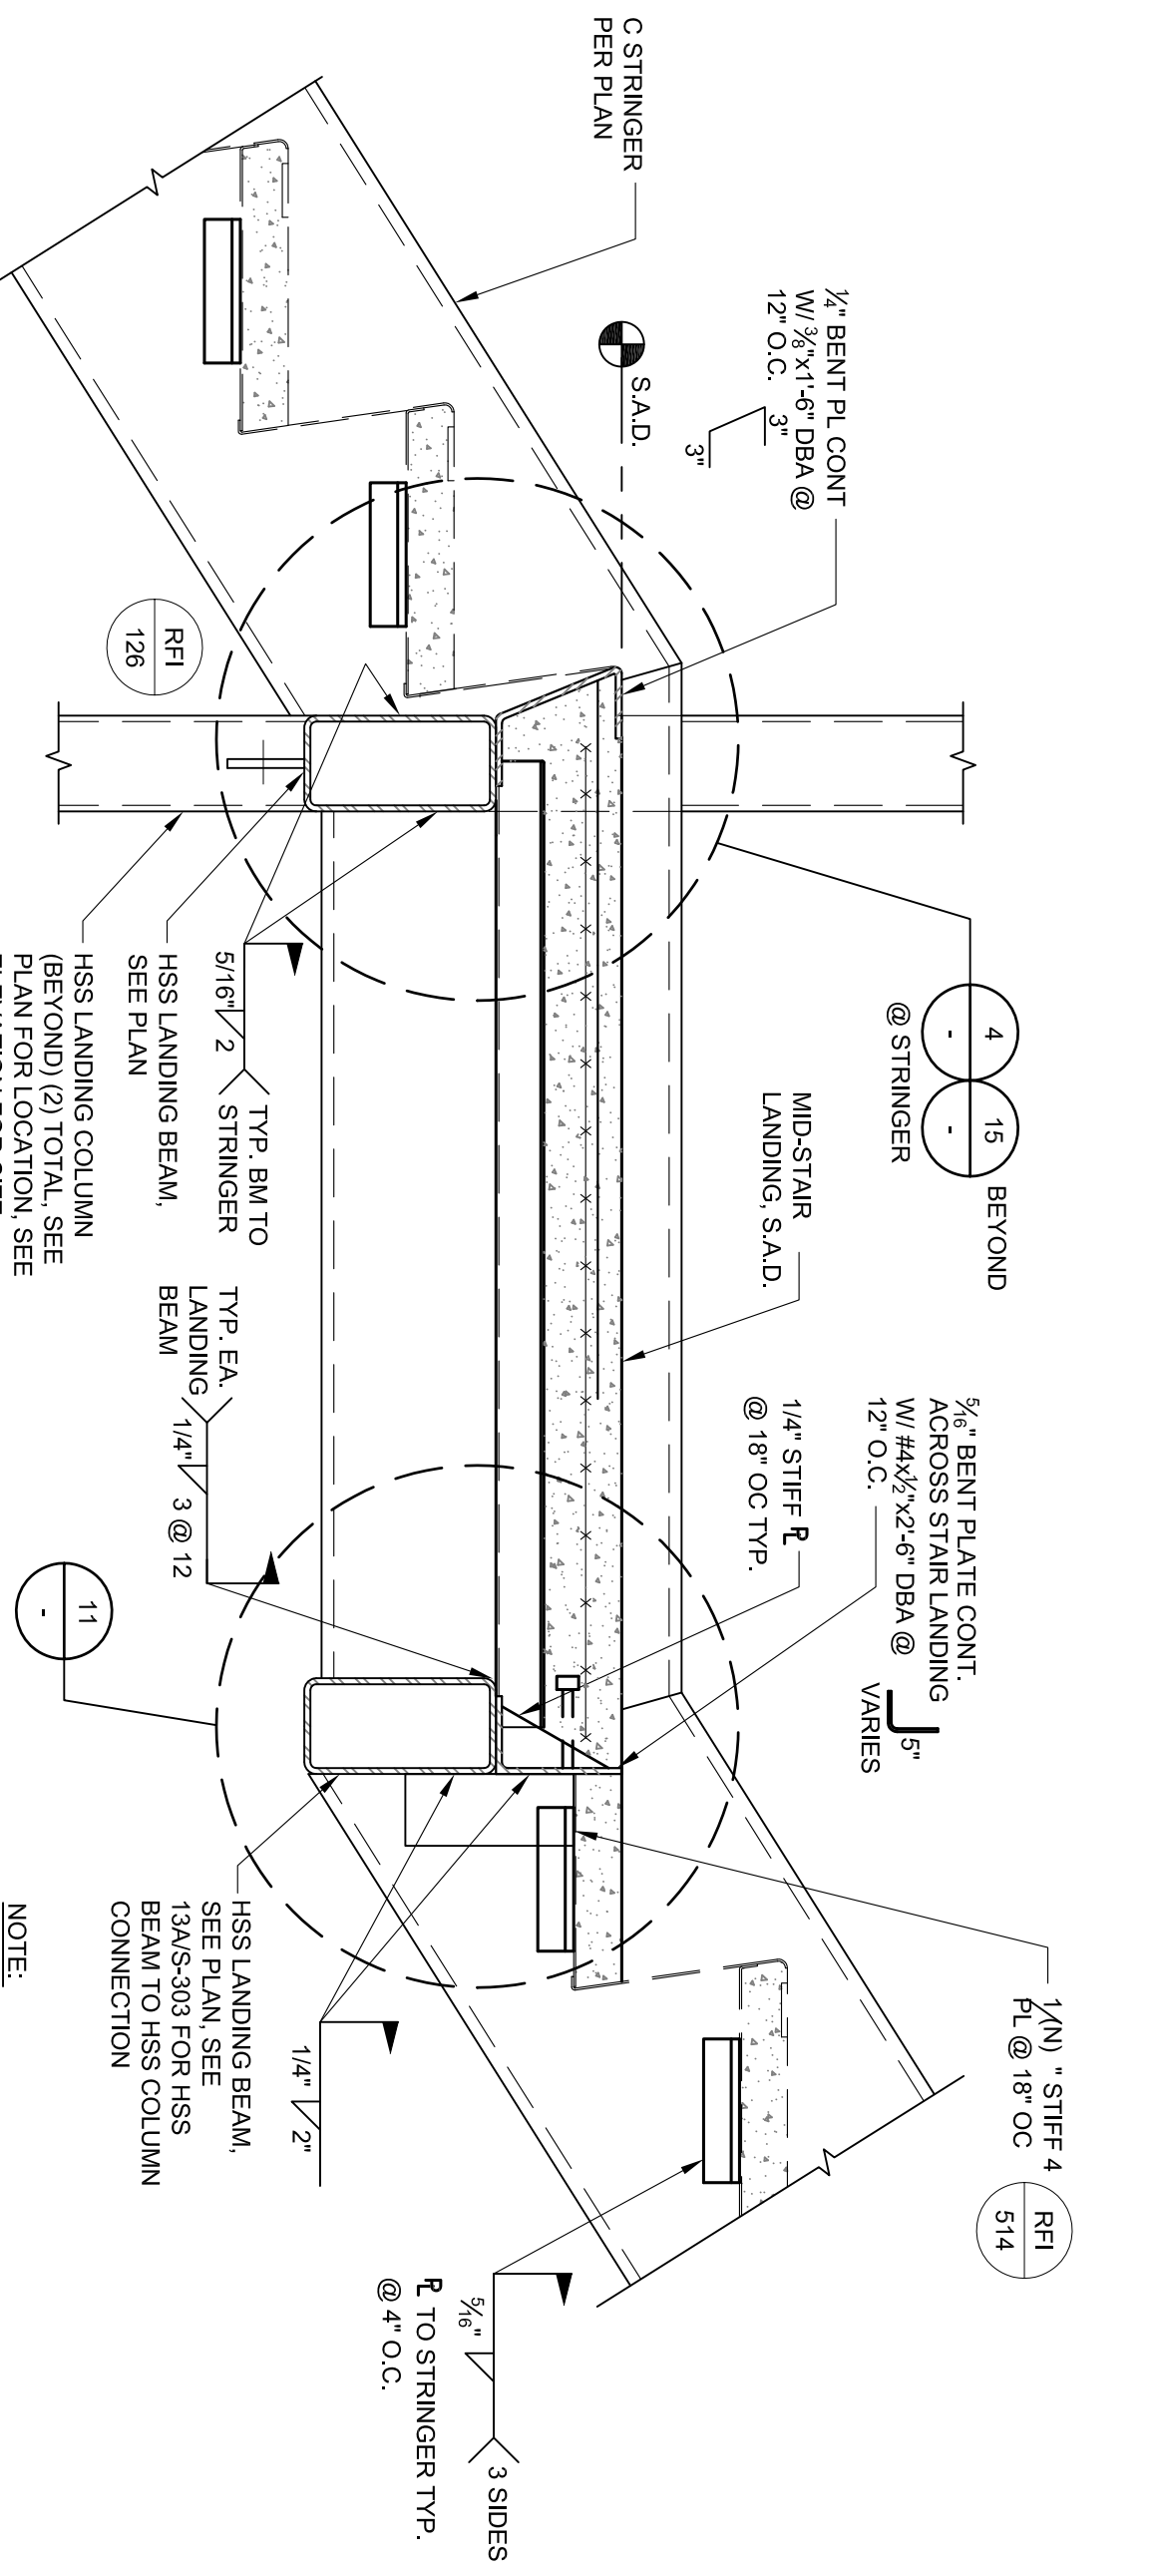


8 SECTION AT STAIR (ST02)  
SCALE: 1/2"=1'-0"

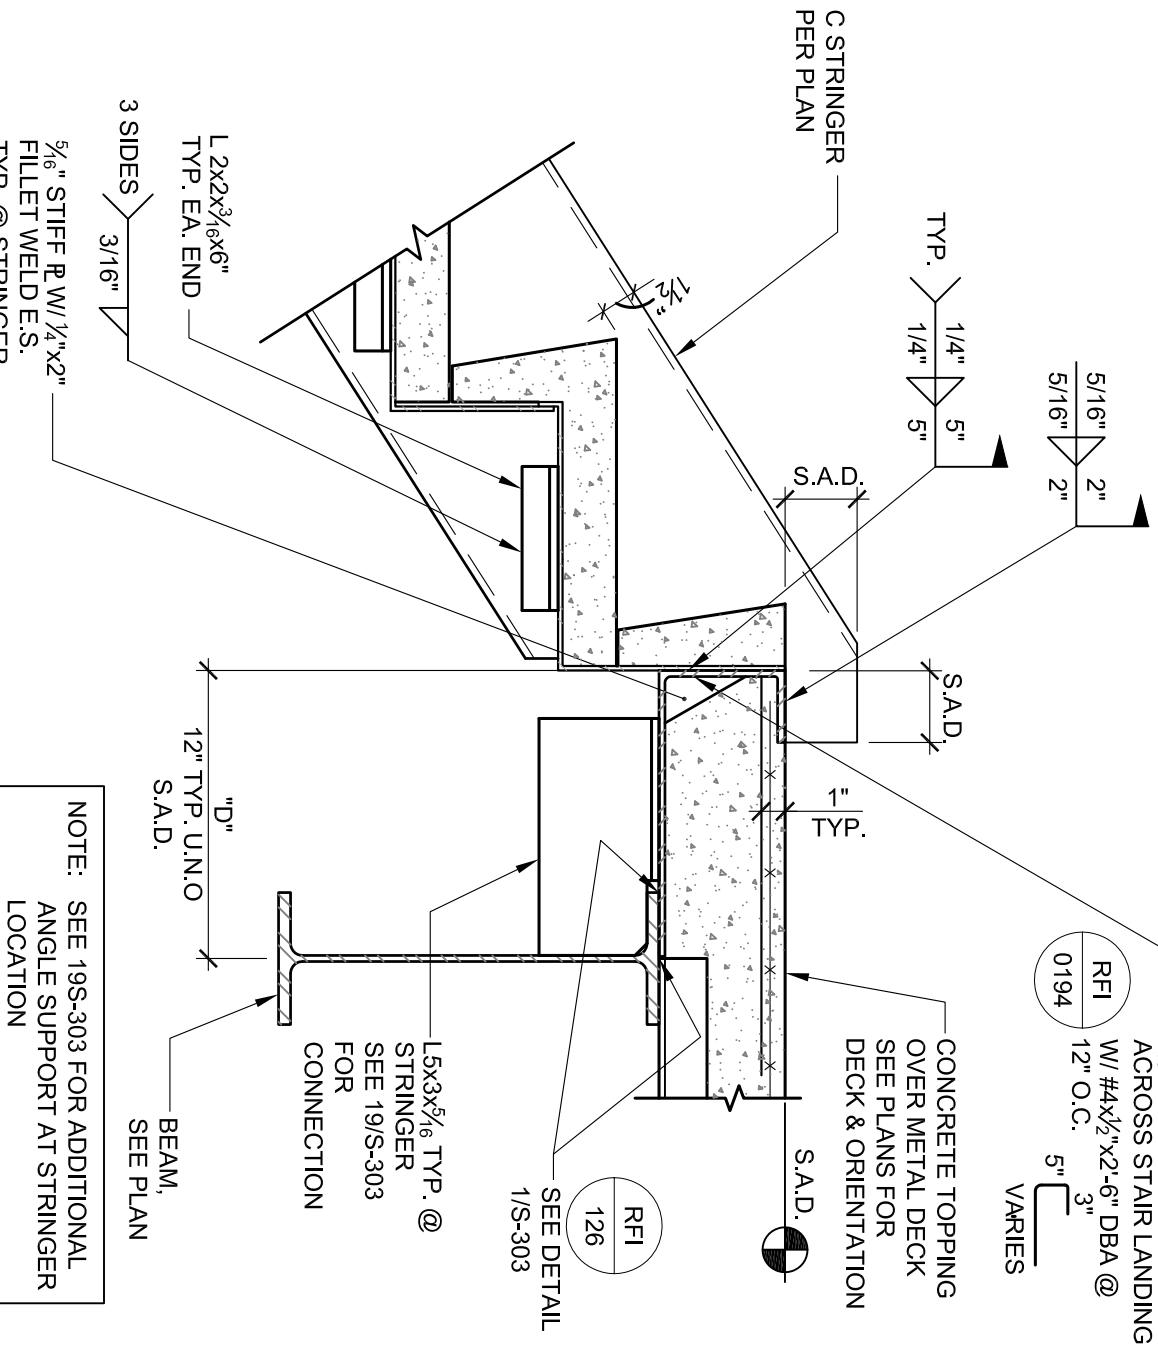


4 STRINGER CONNECTION  
SCALE: 1/2"=1'-0"

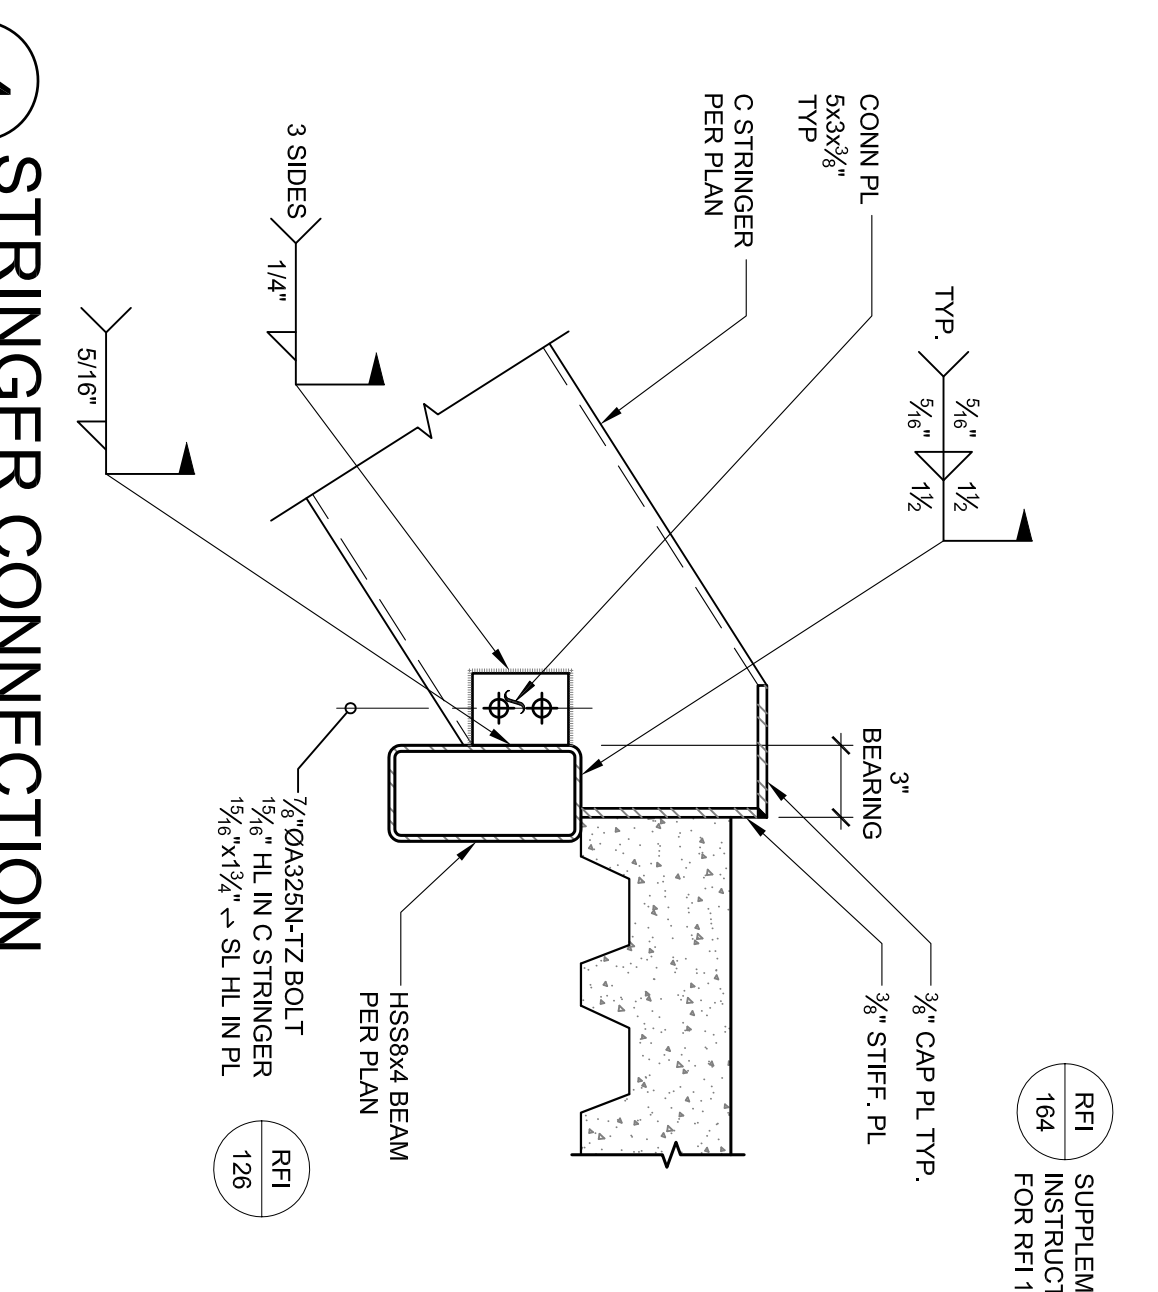


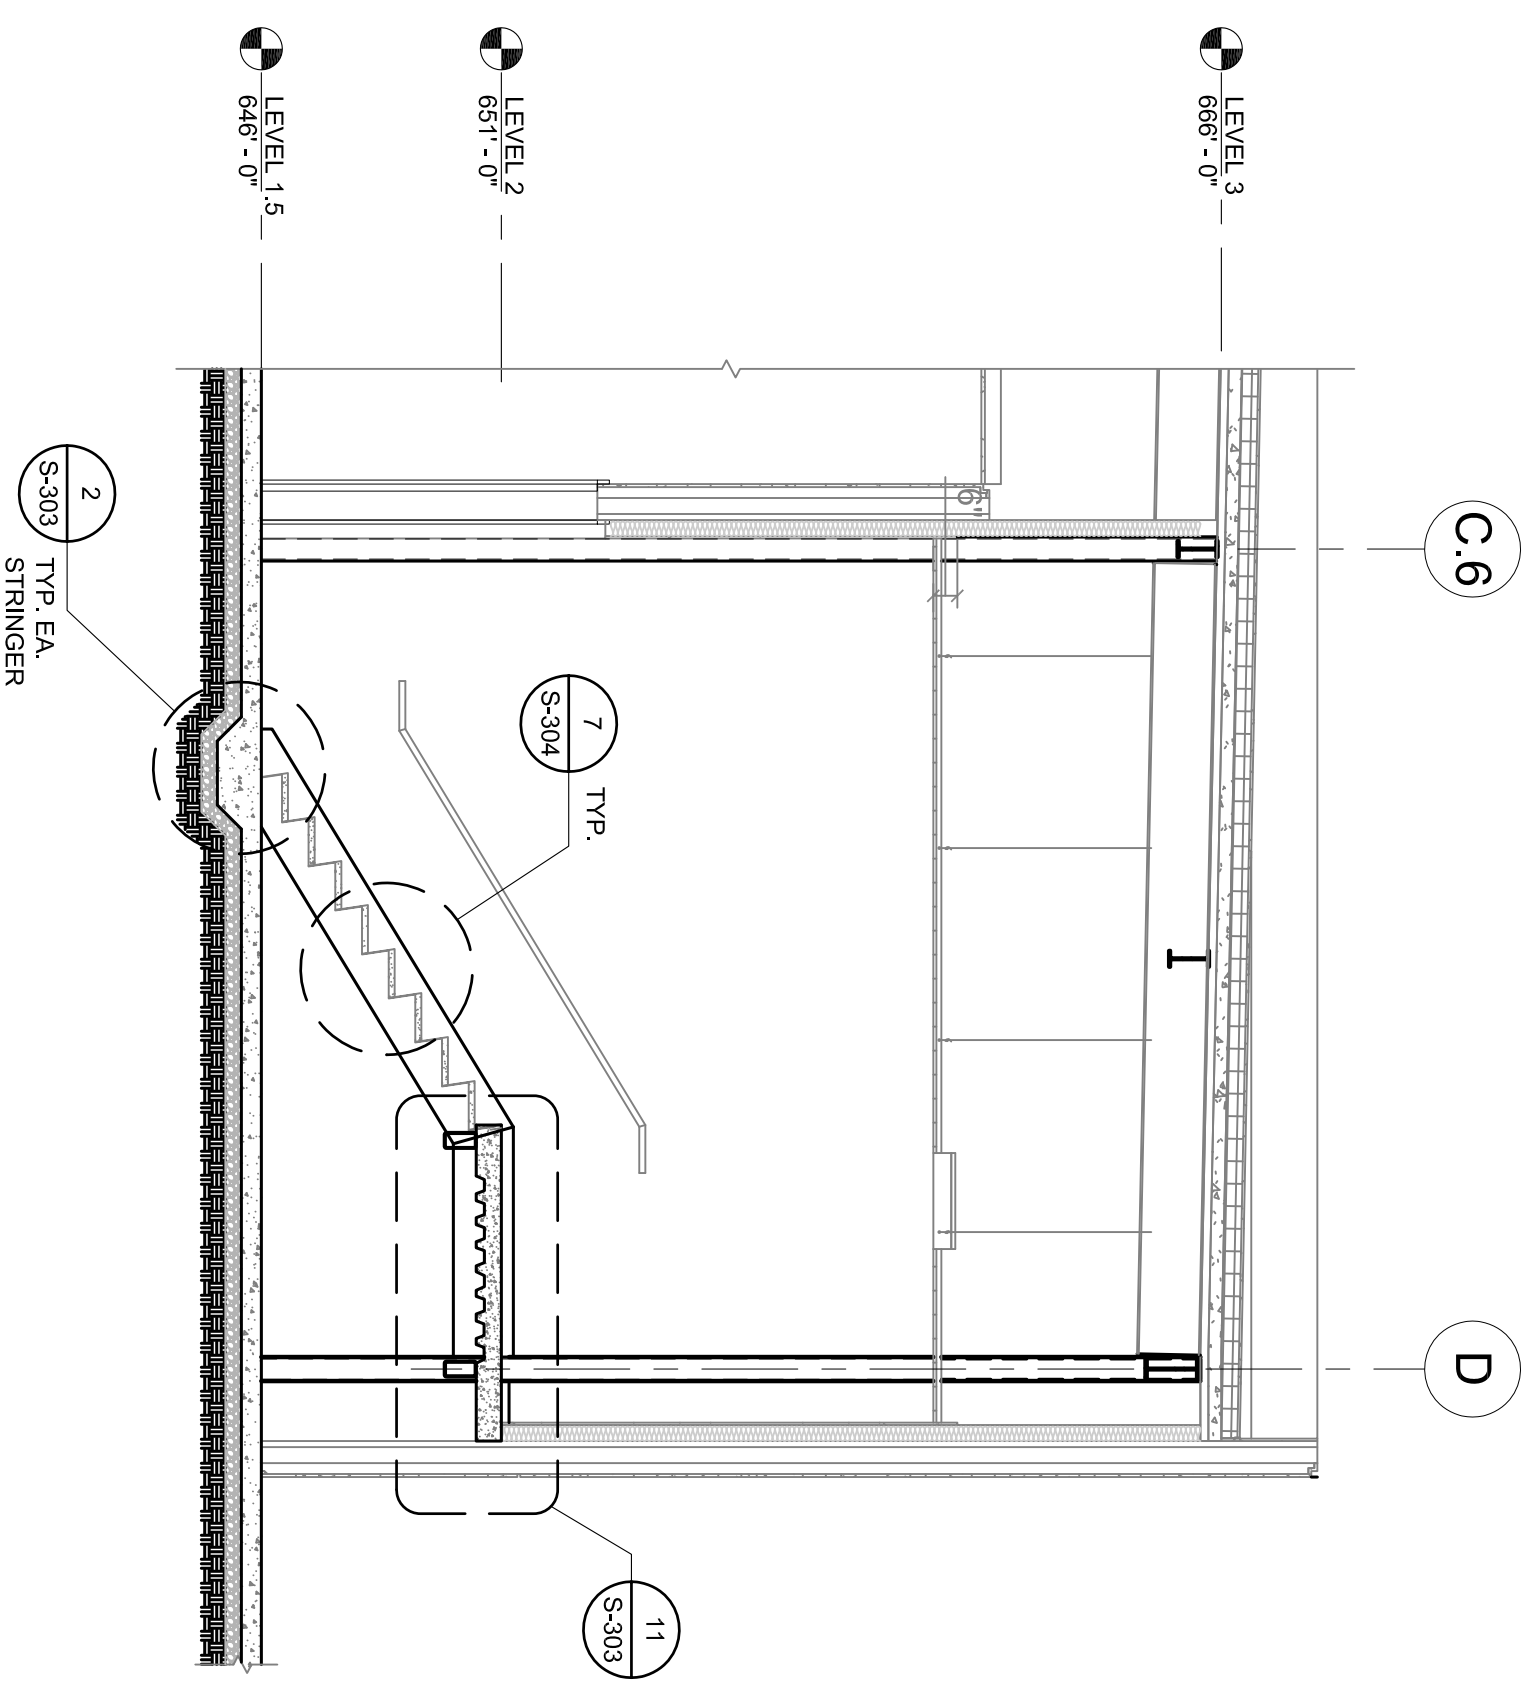


6 NORTHEAST STAIR - ST03  
 1/4" = 1'-0"

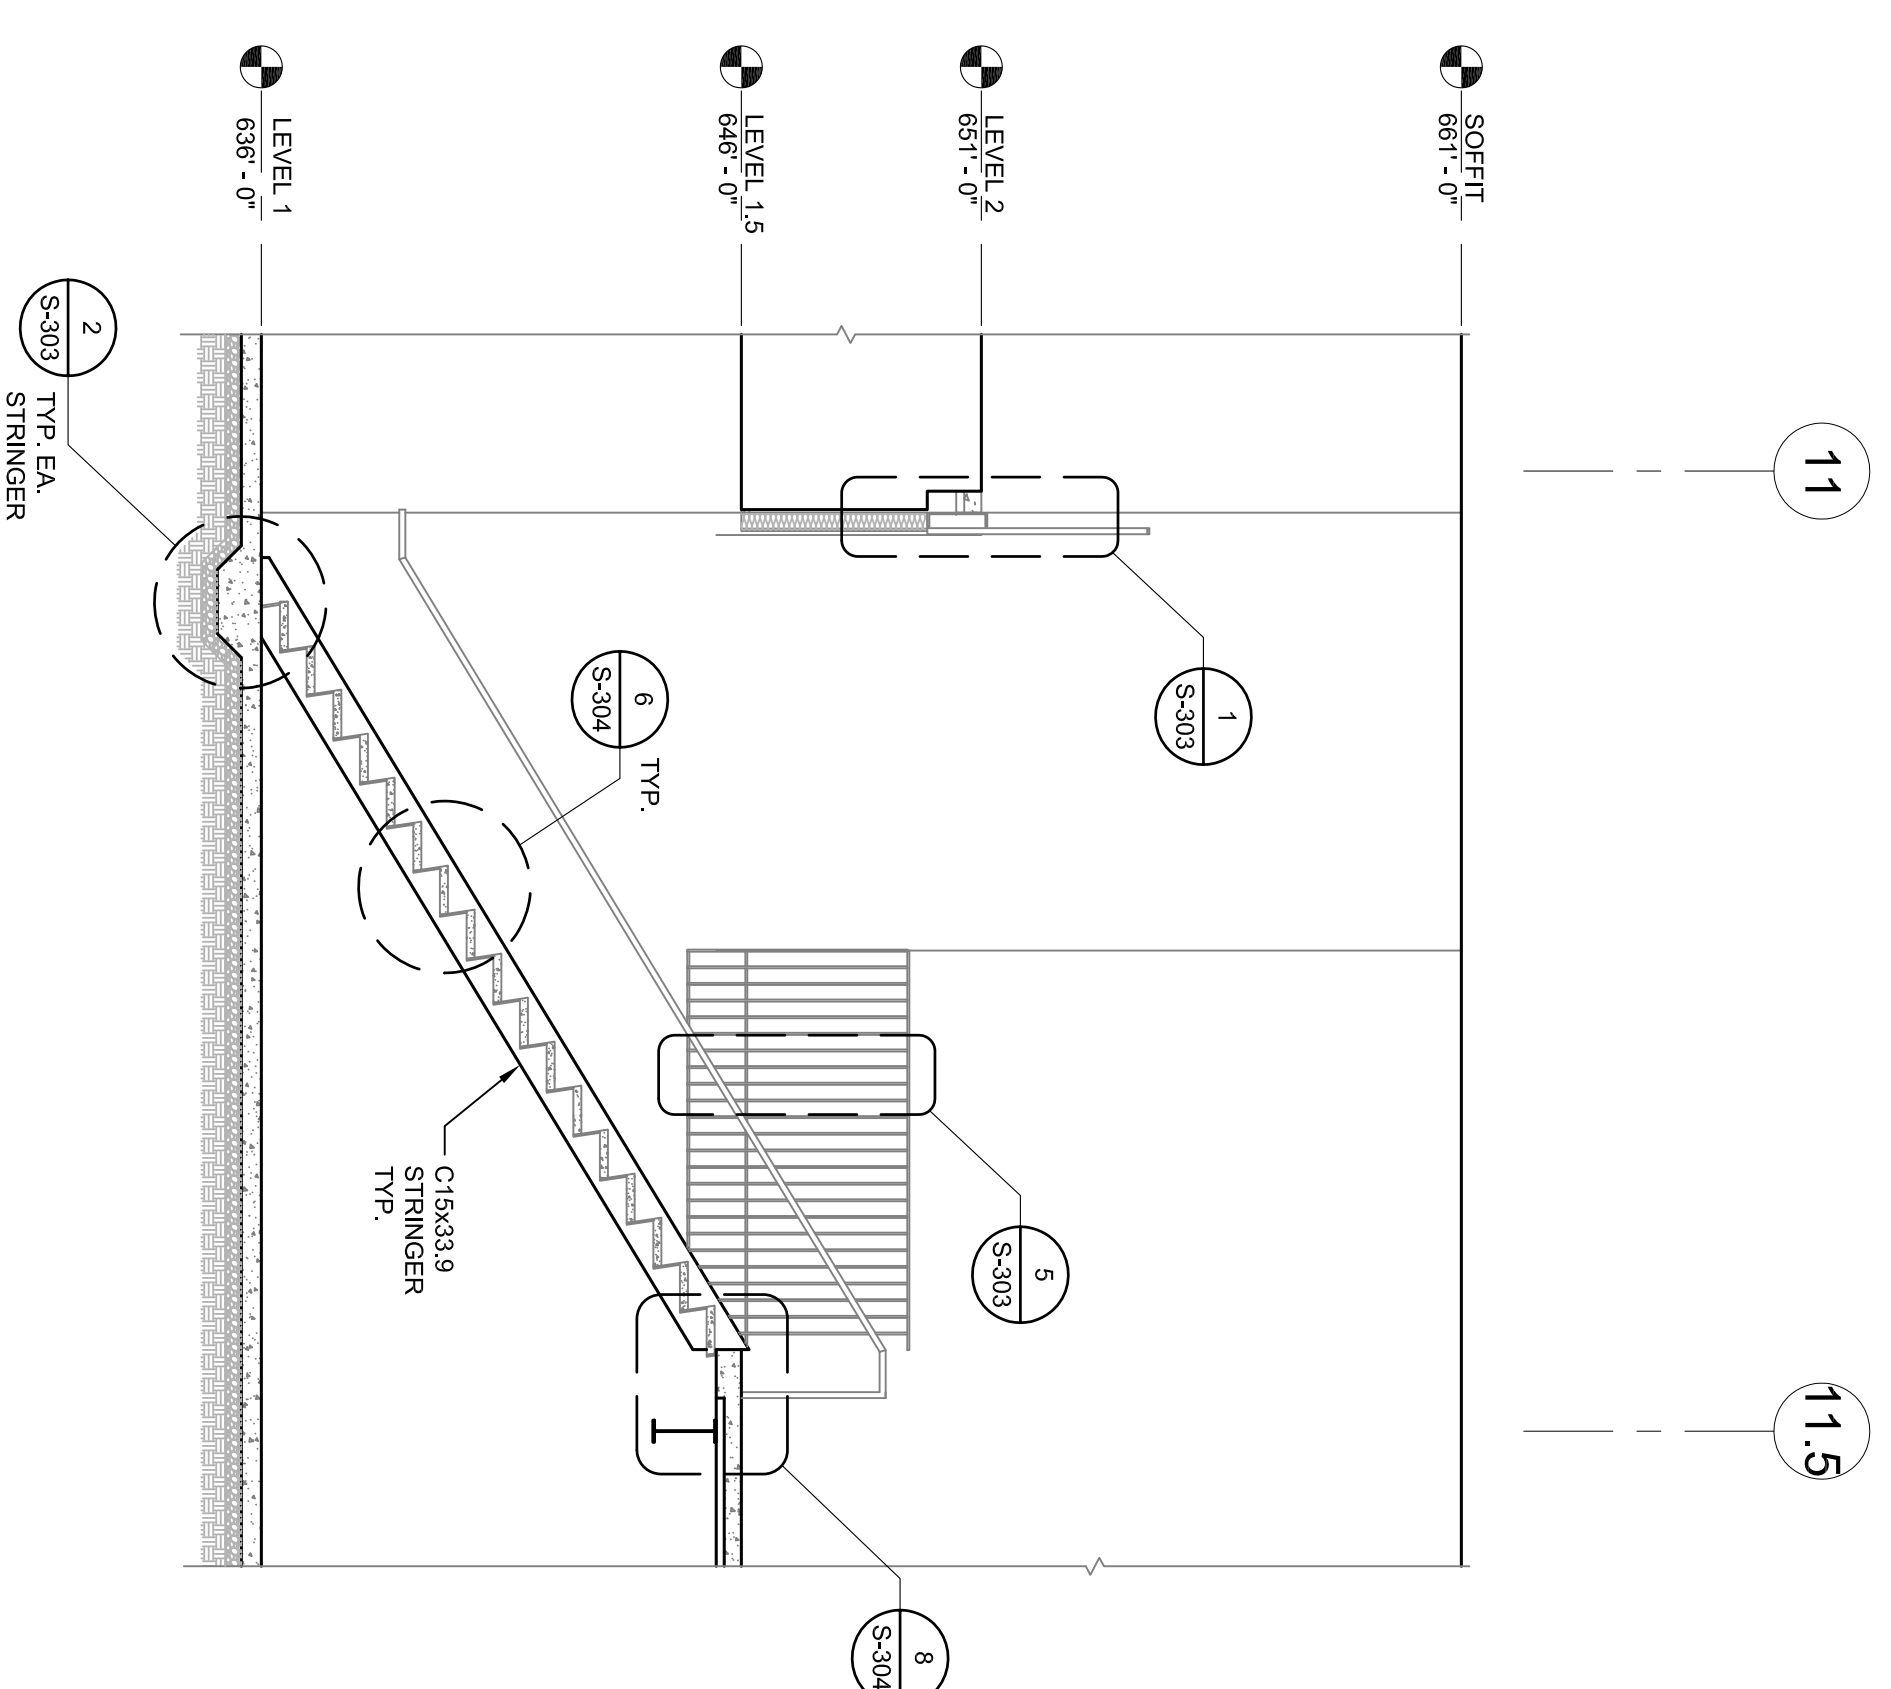


4 NORTH LOBBY STAIR - ST02  
 1/4" = 1'-0"

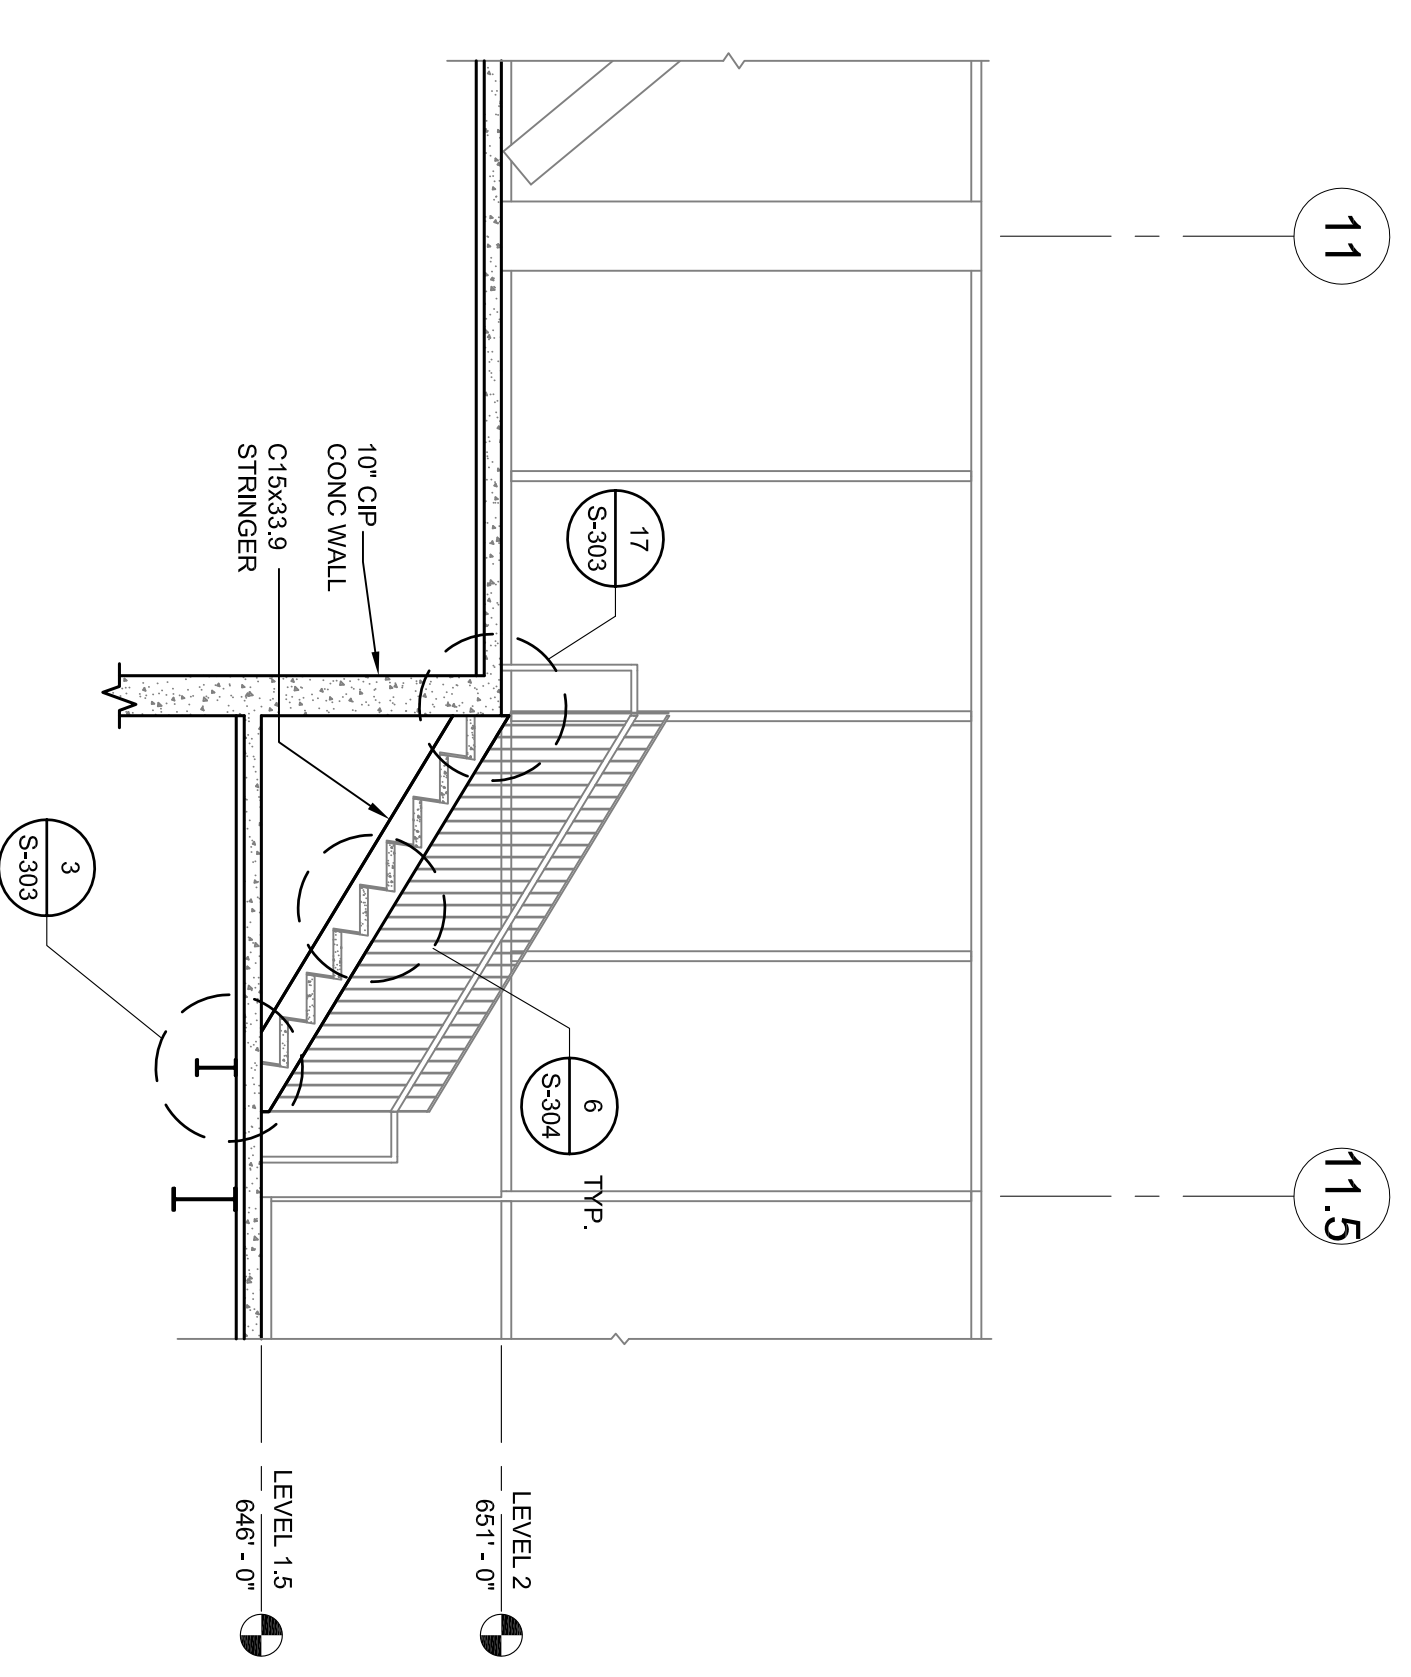


2 NORTH LOBBY STAIR - ST01  
 1/4" = 1'-0"

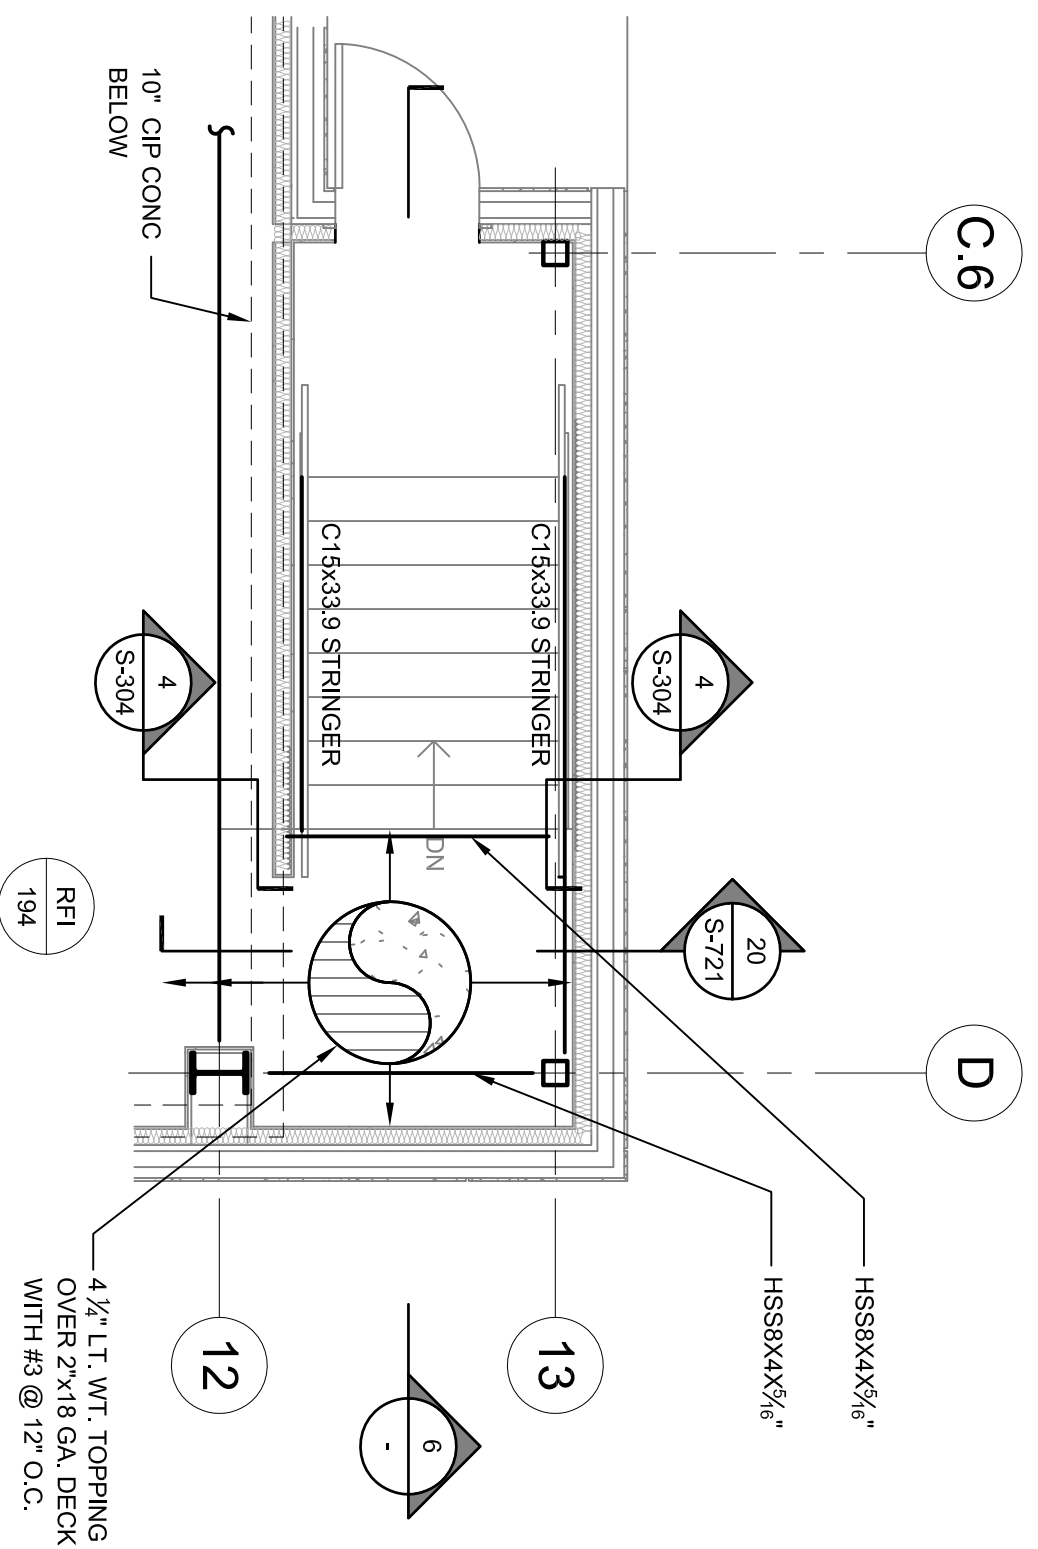

5 NORTHEAST STAIR - ST03 - LEVEL 2  
 1/4" = 1'-0"









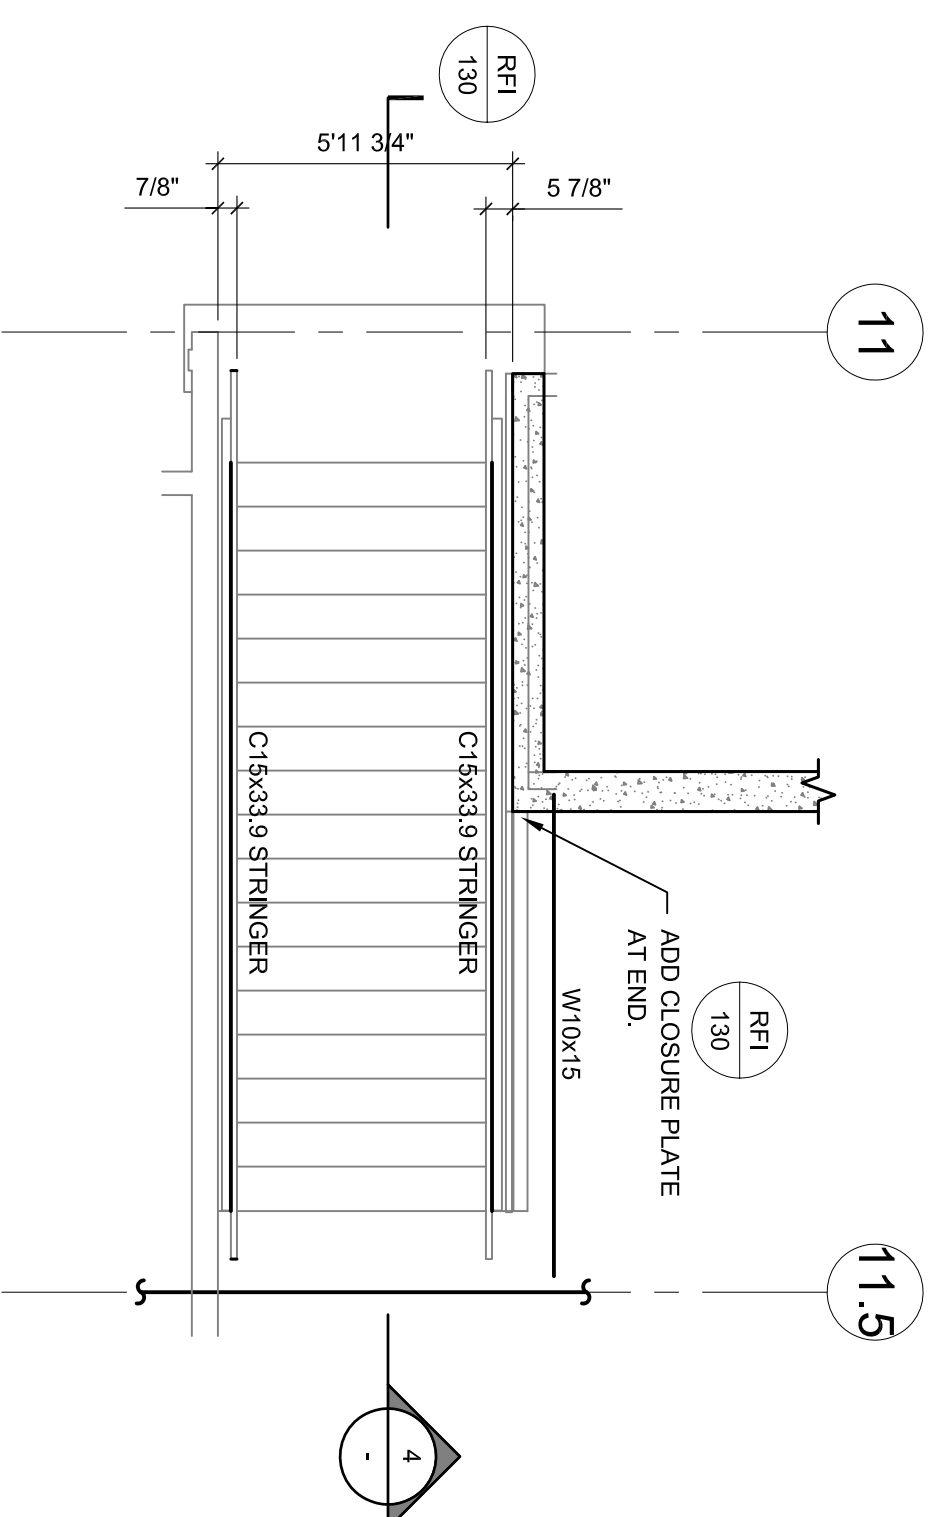


3 NORTH LOBBY STAIR - ST02 - LEVEL 2  
 1/4" = 1'-0"

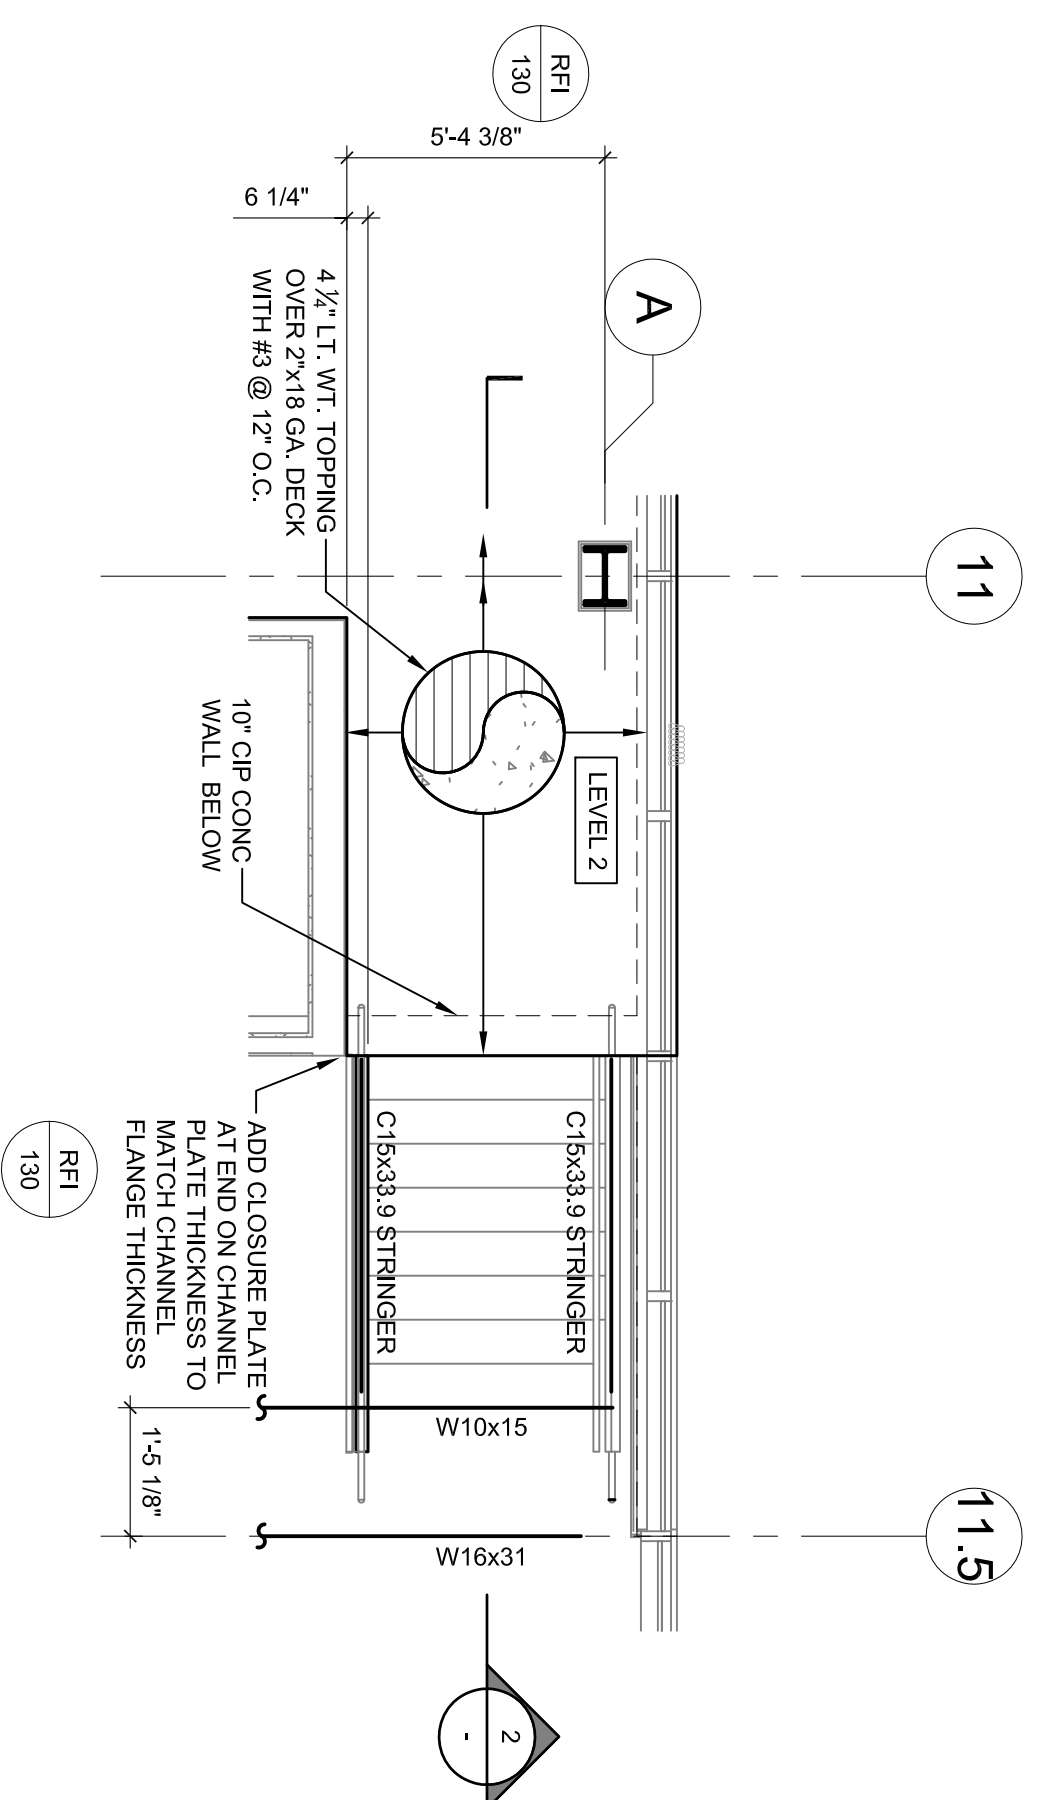

1 NORTH LOBBY STAIR - ST01 - LEVEL 2  
 1/4" = 1'-0"



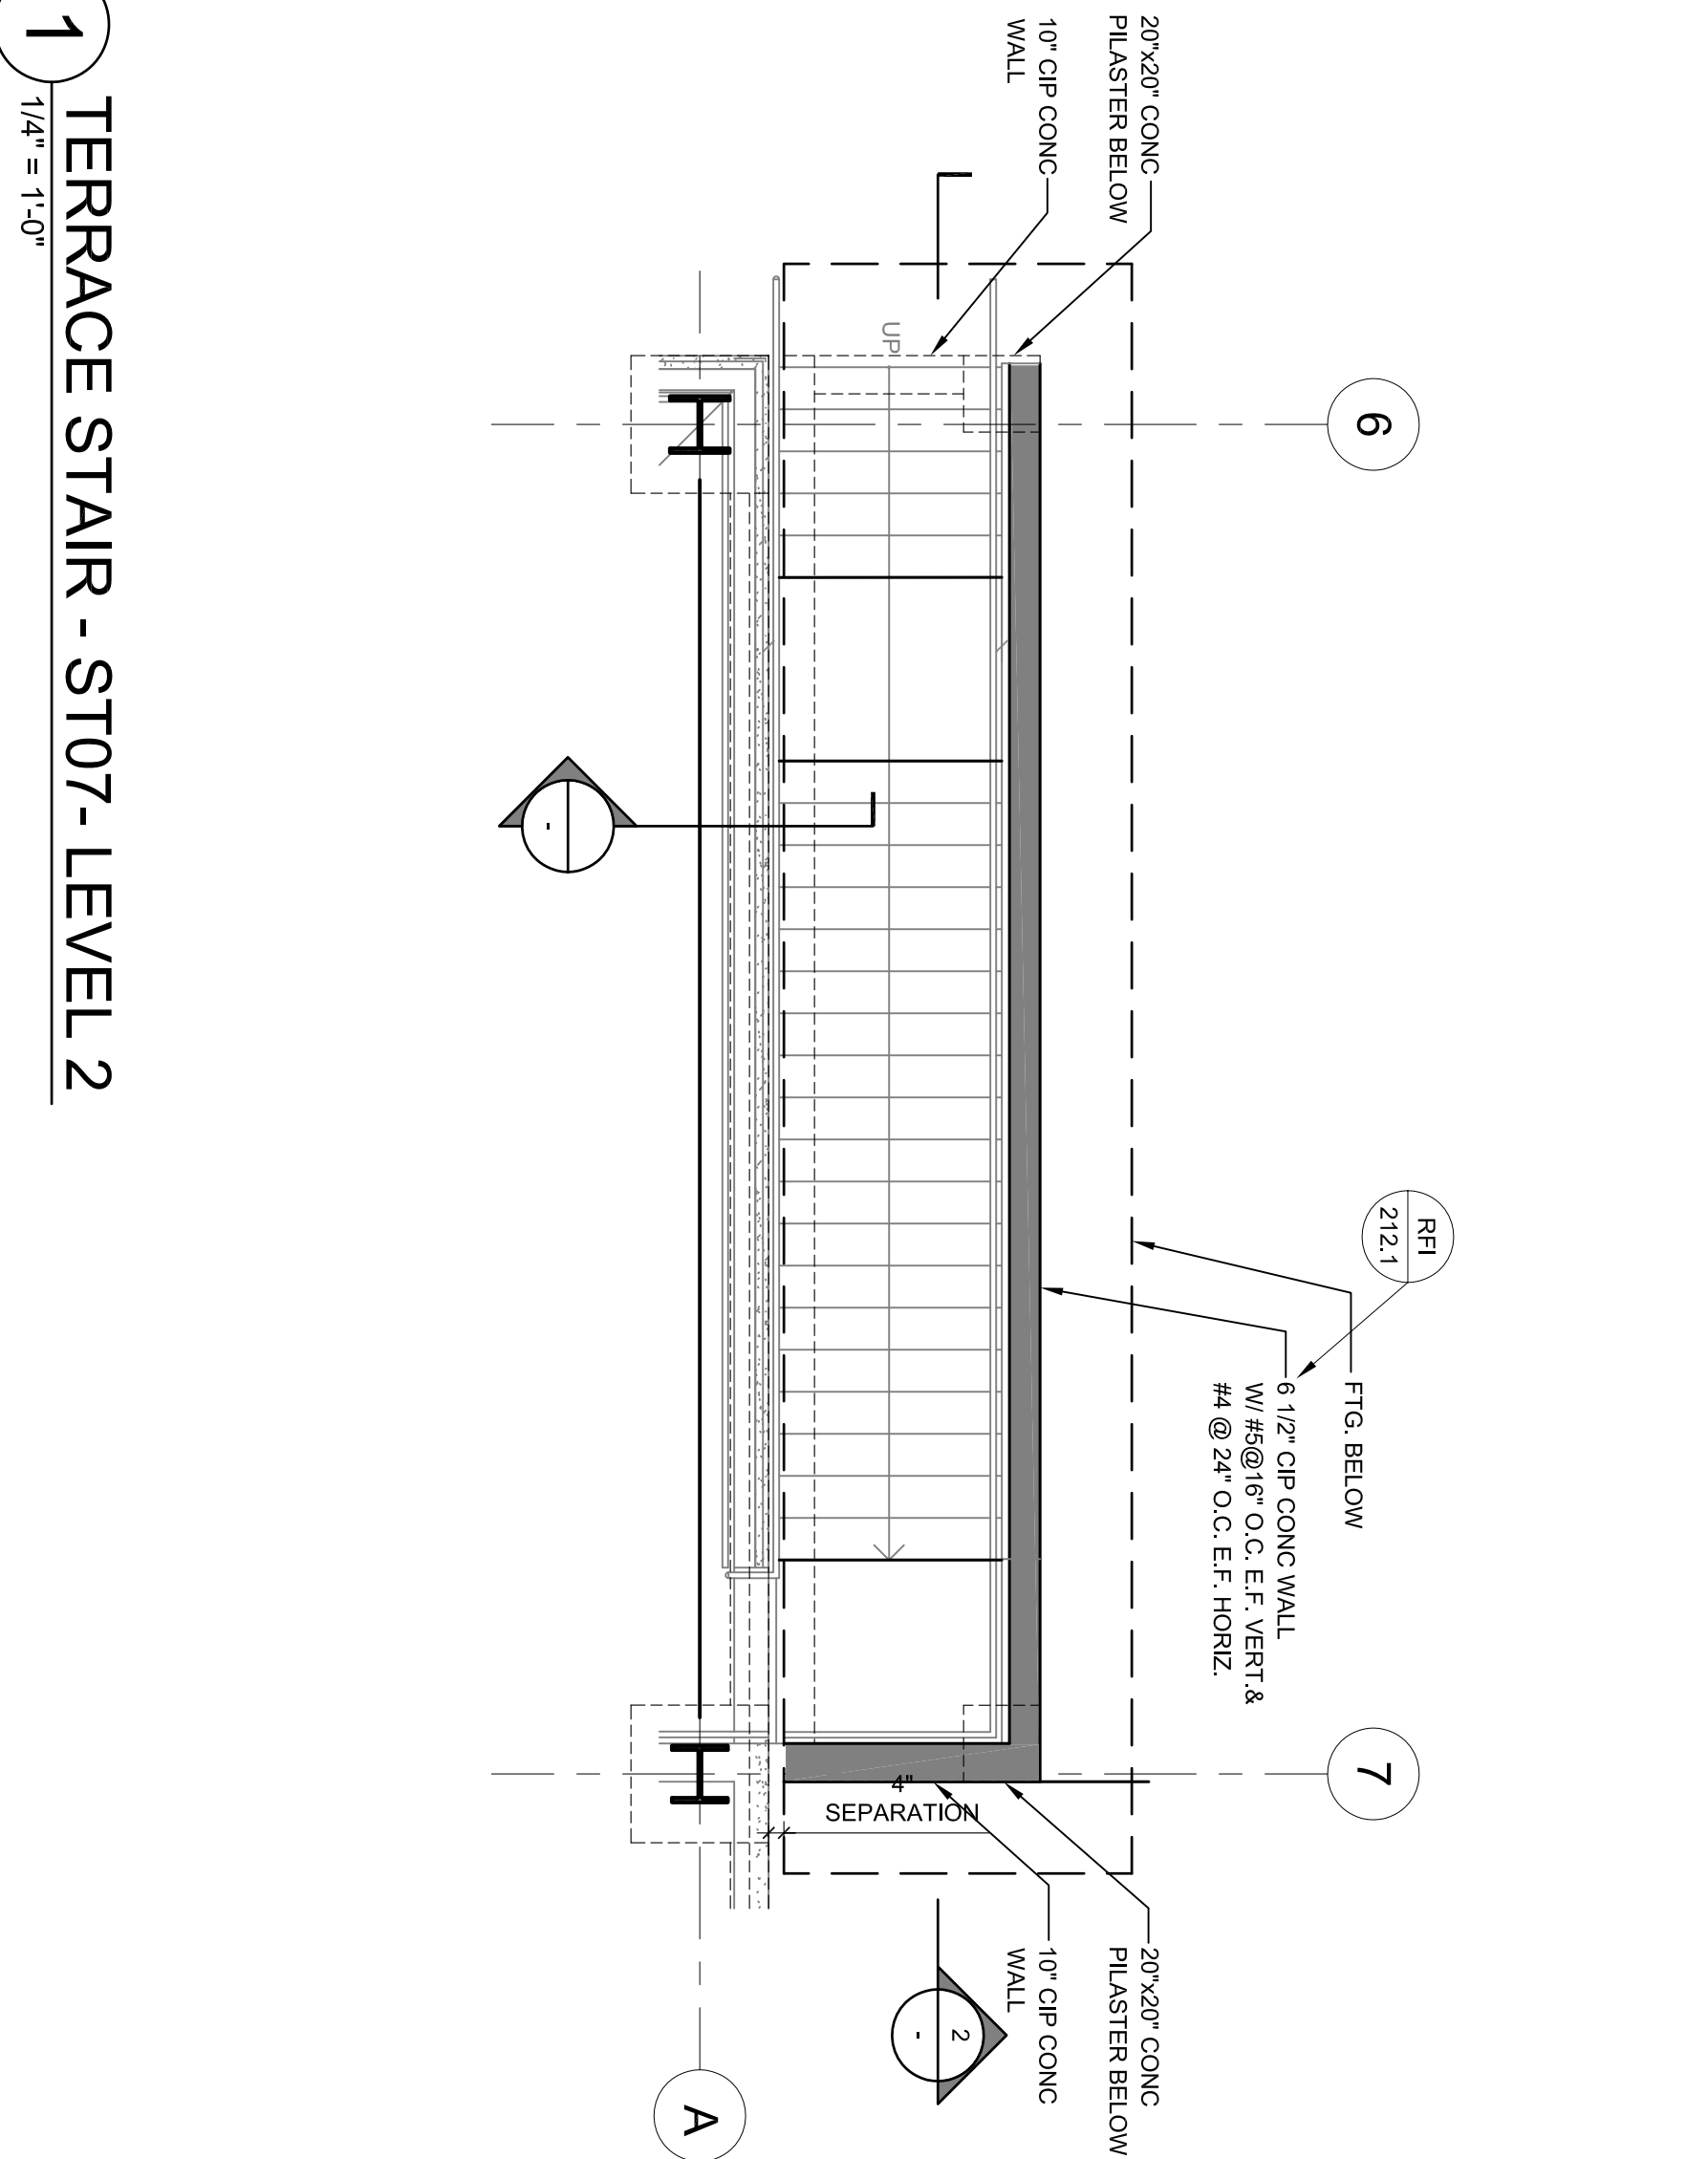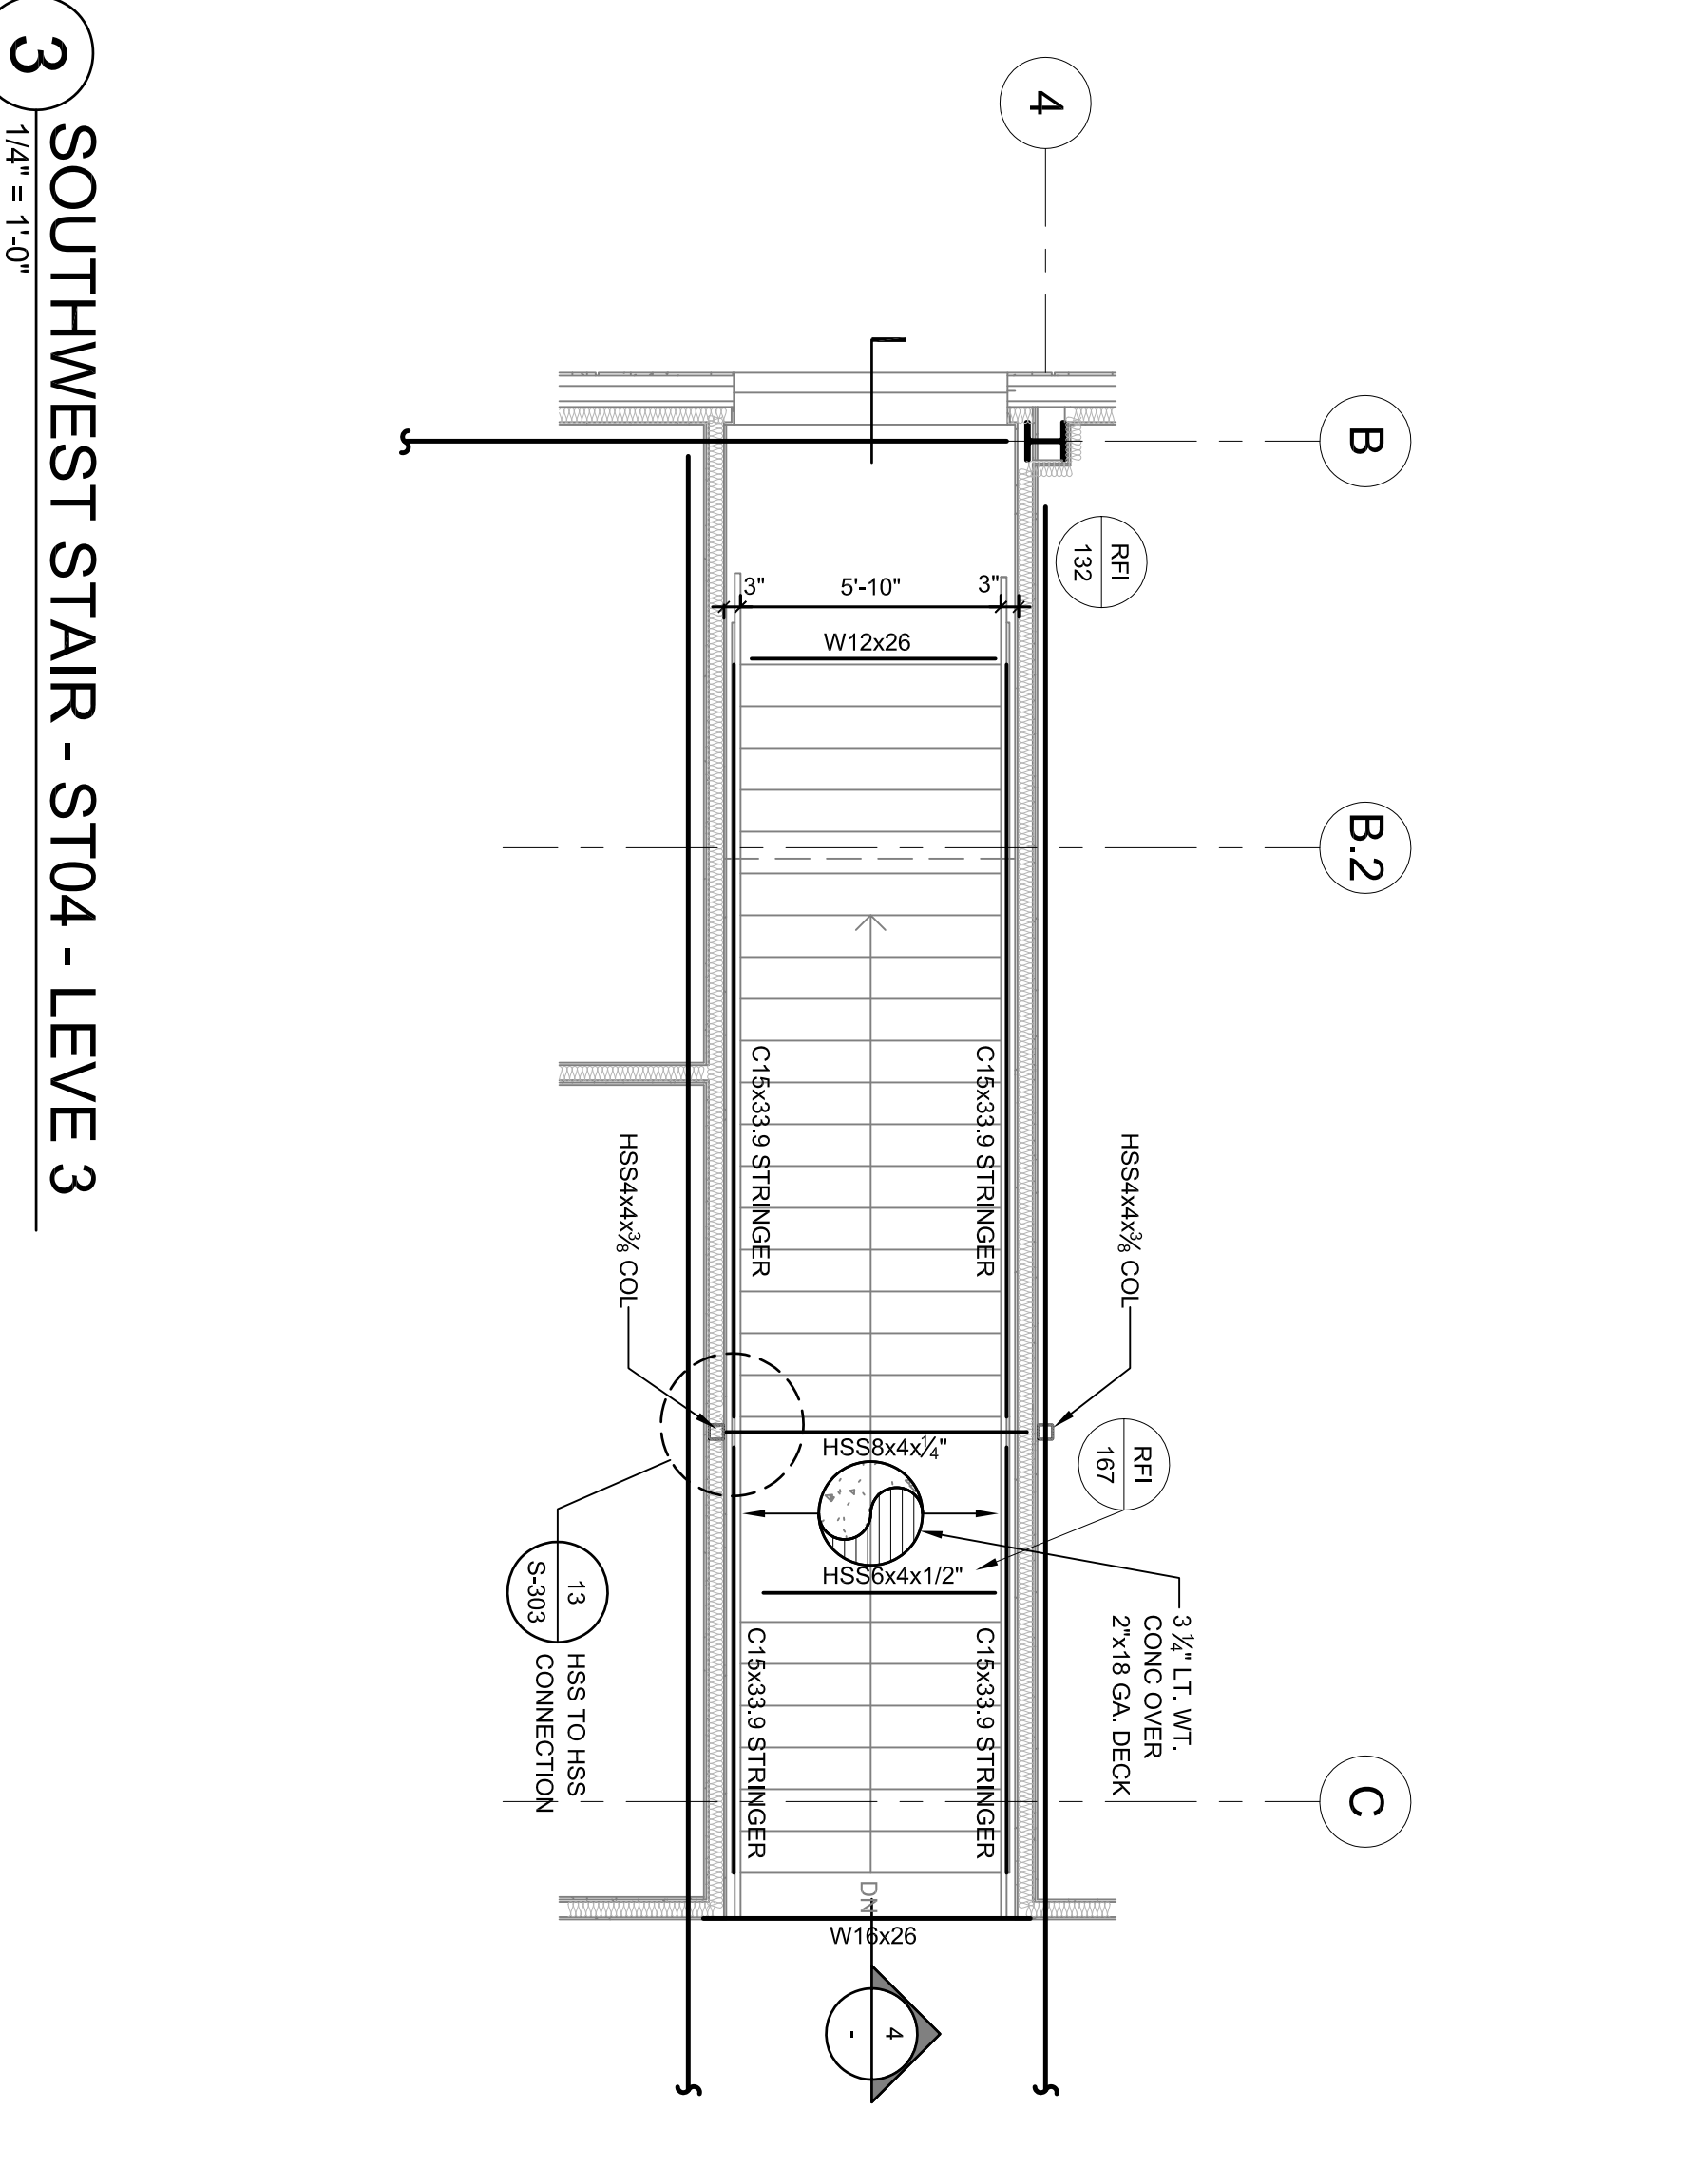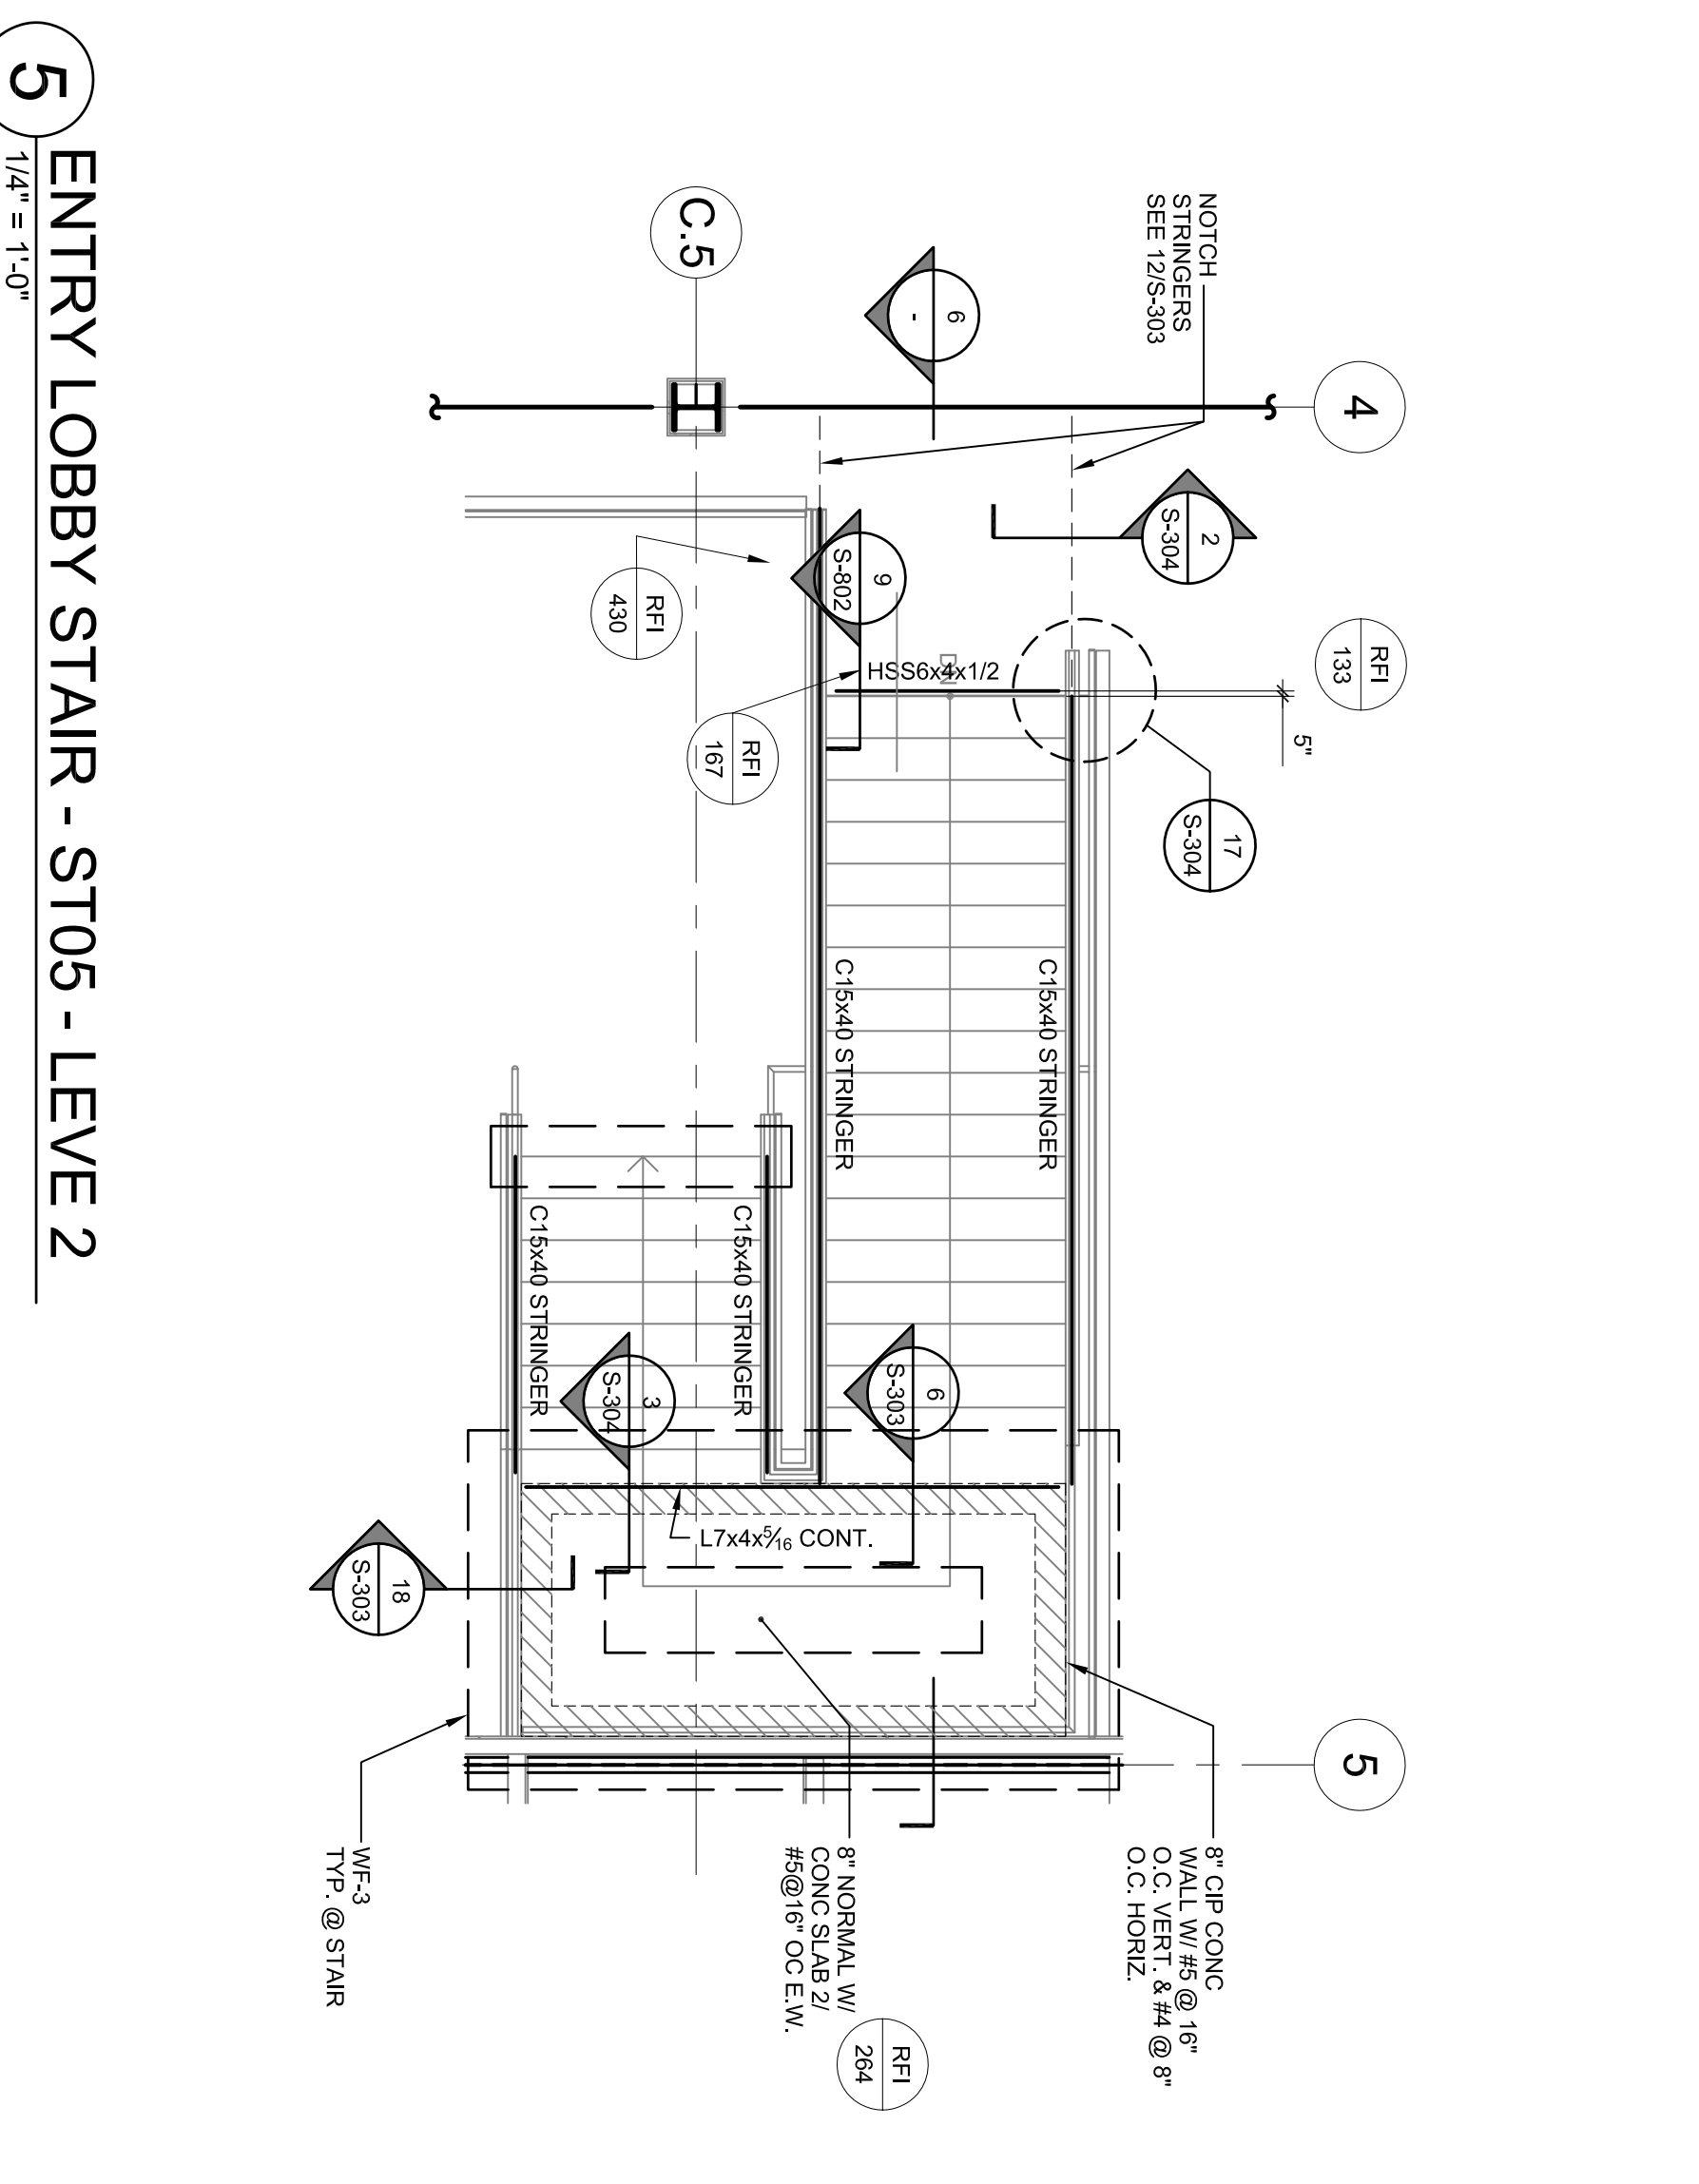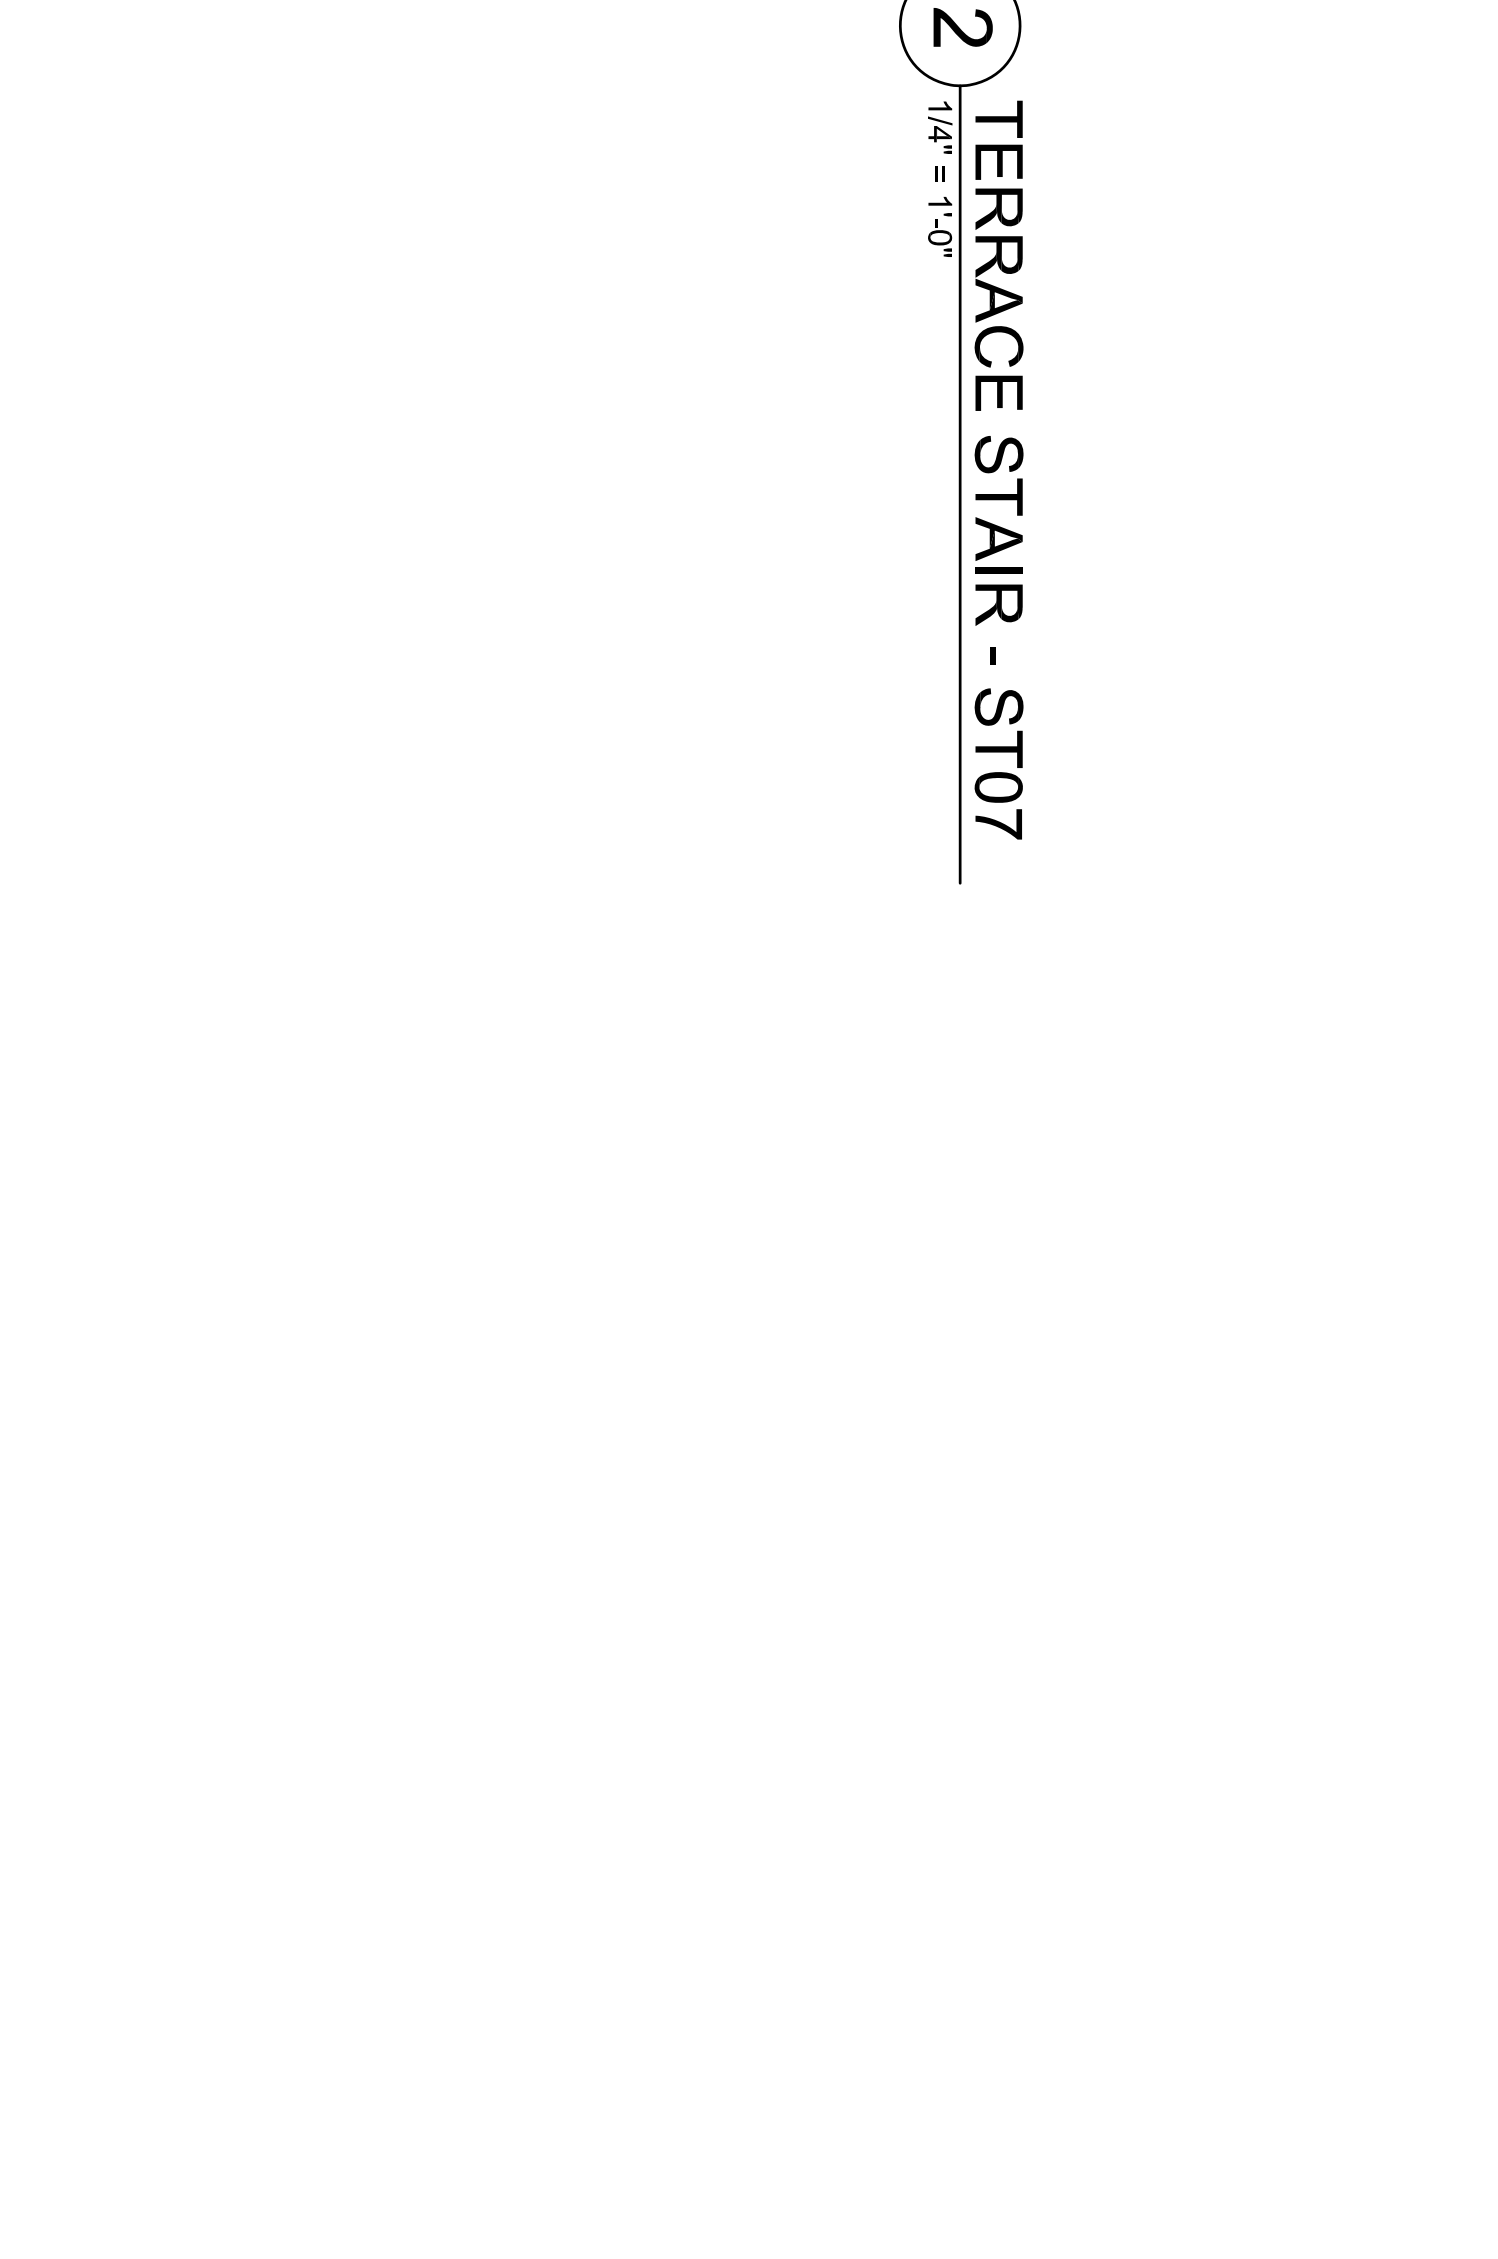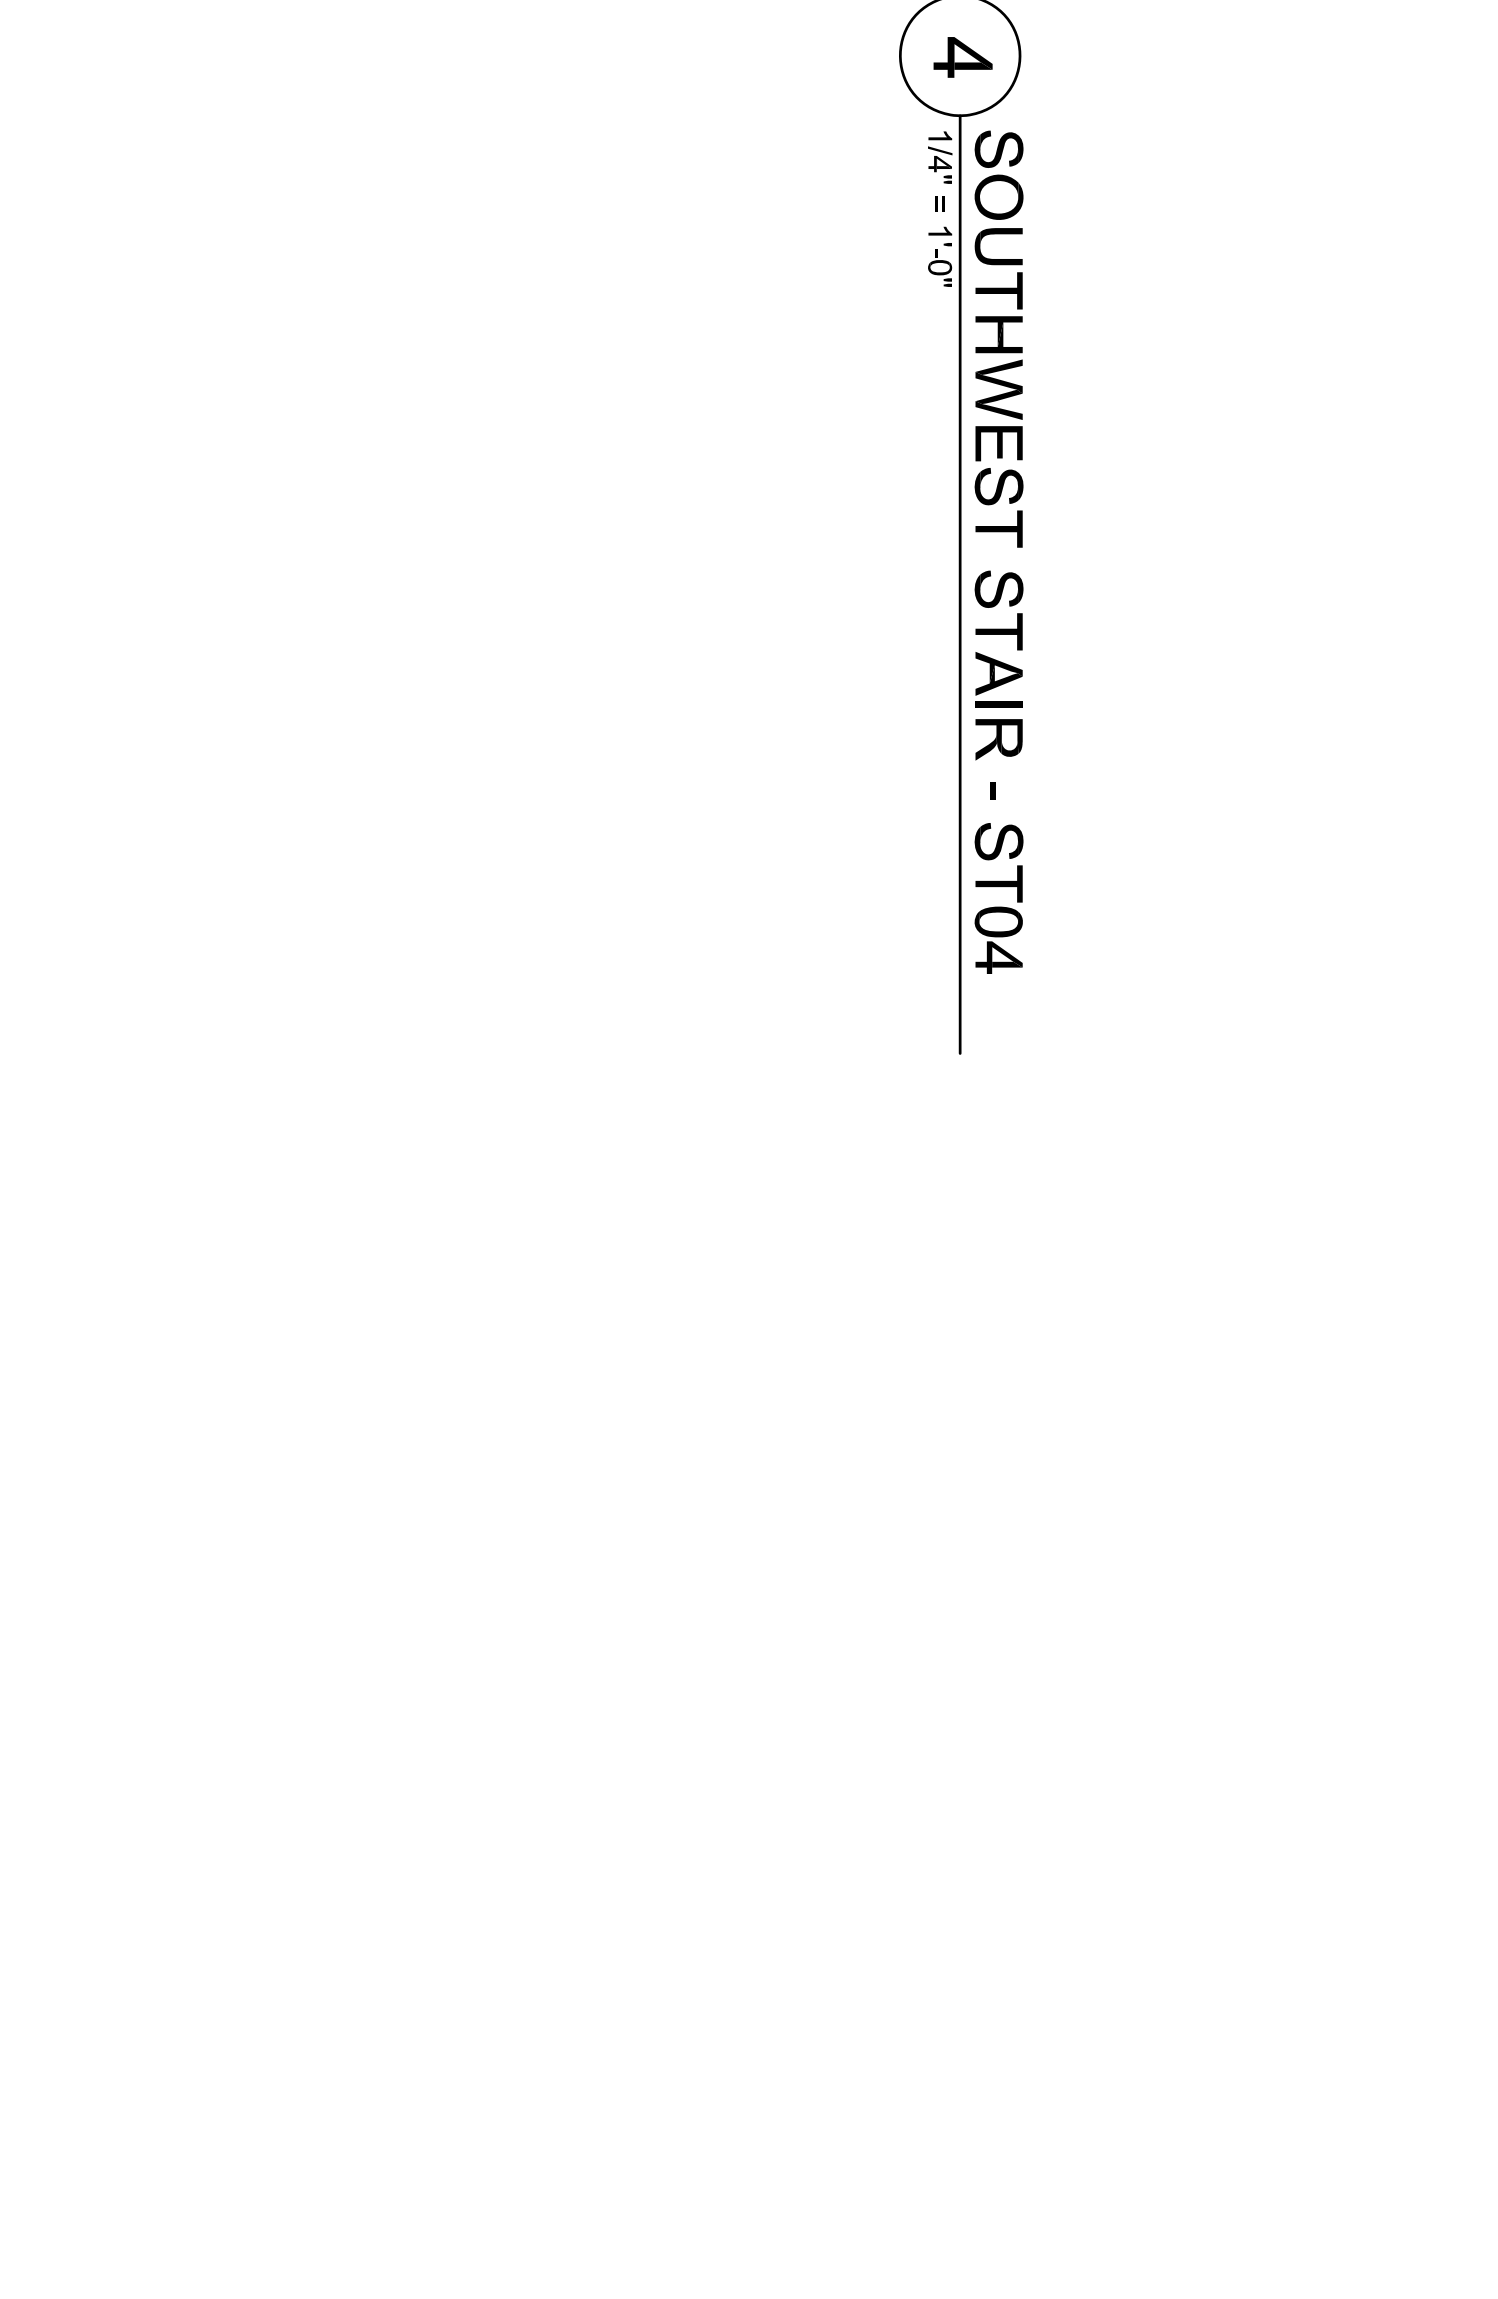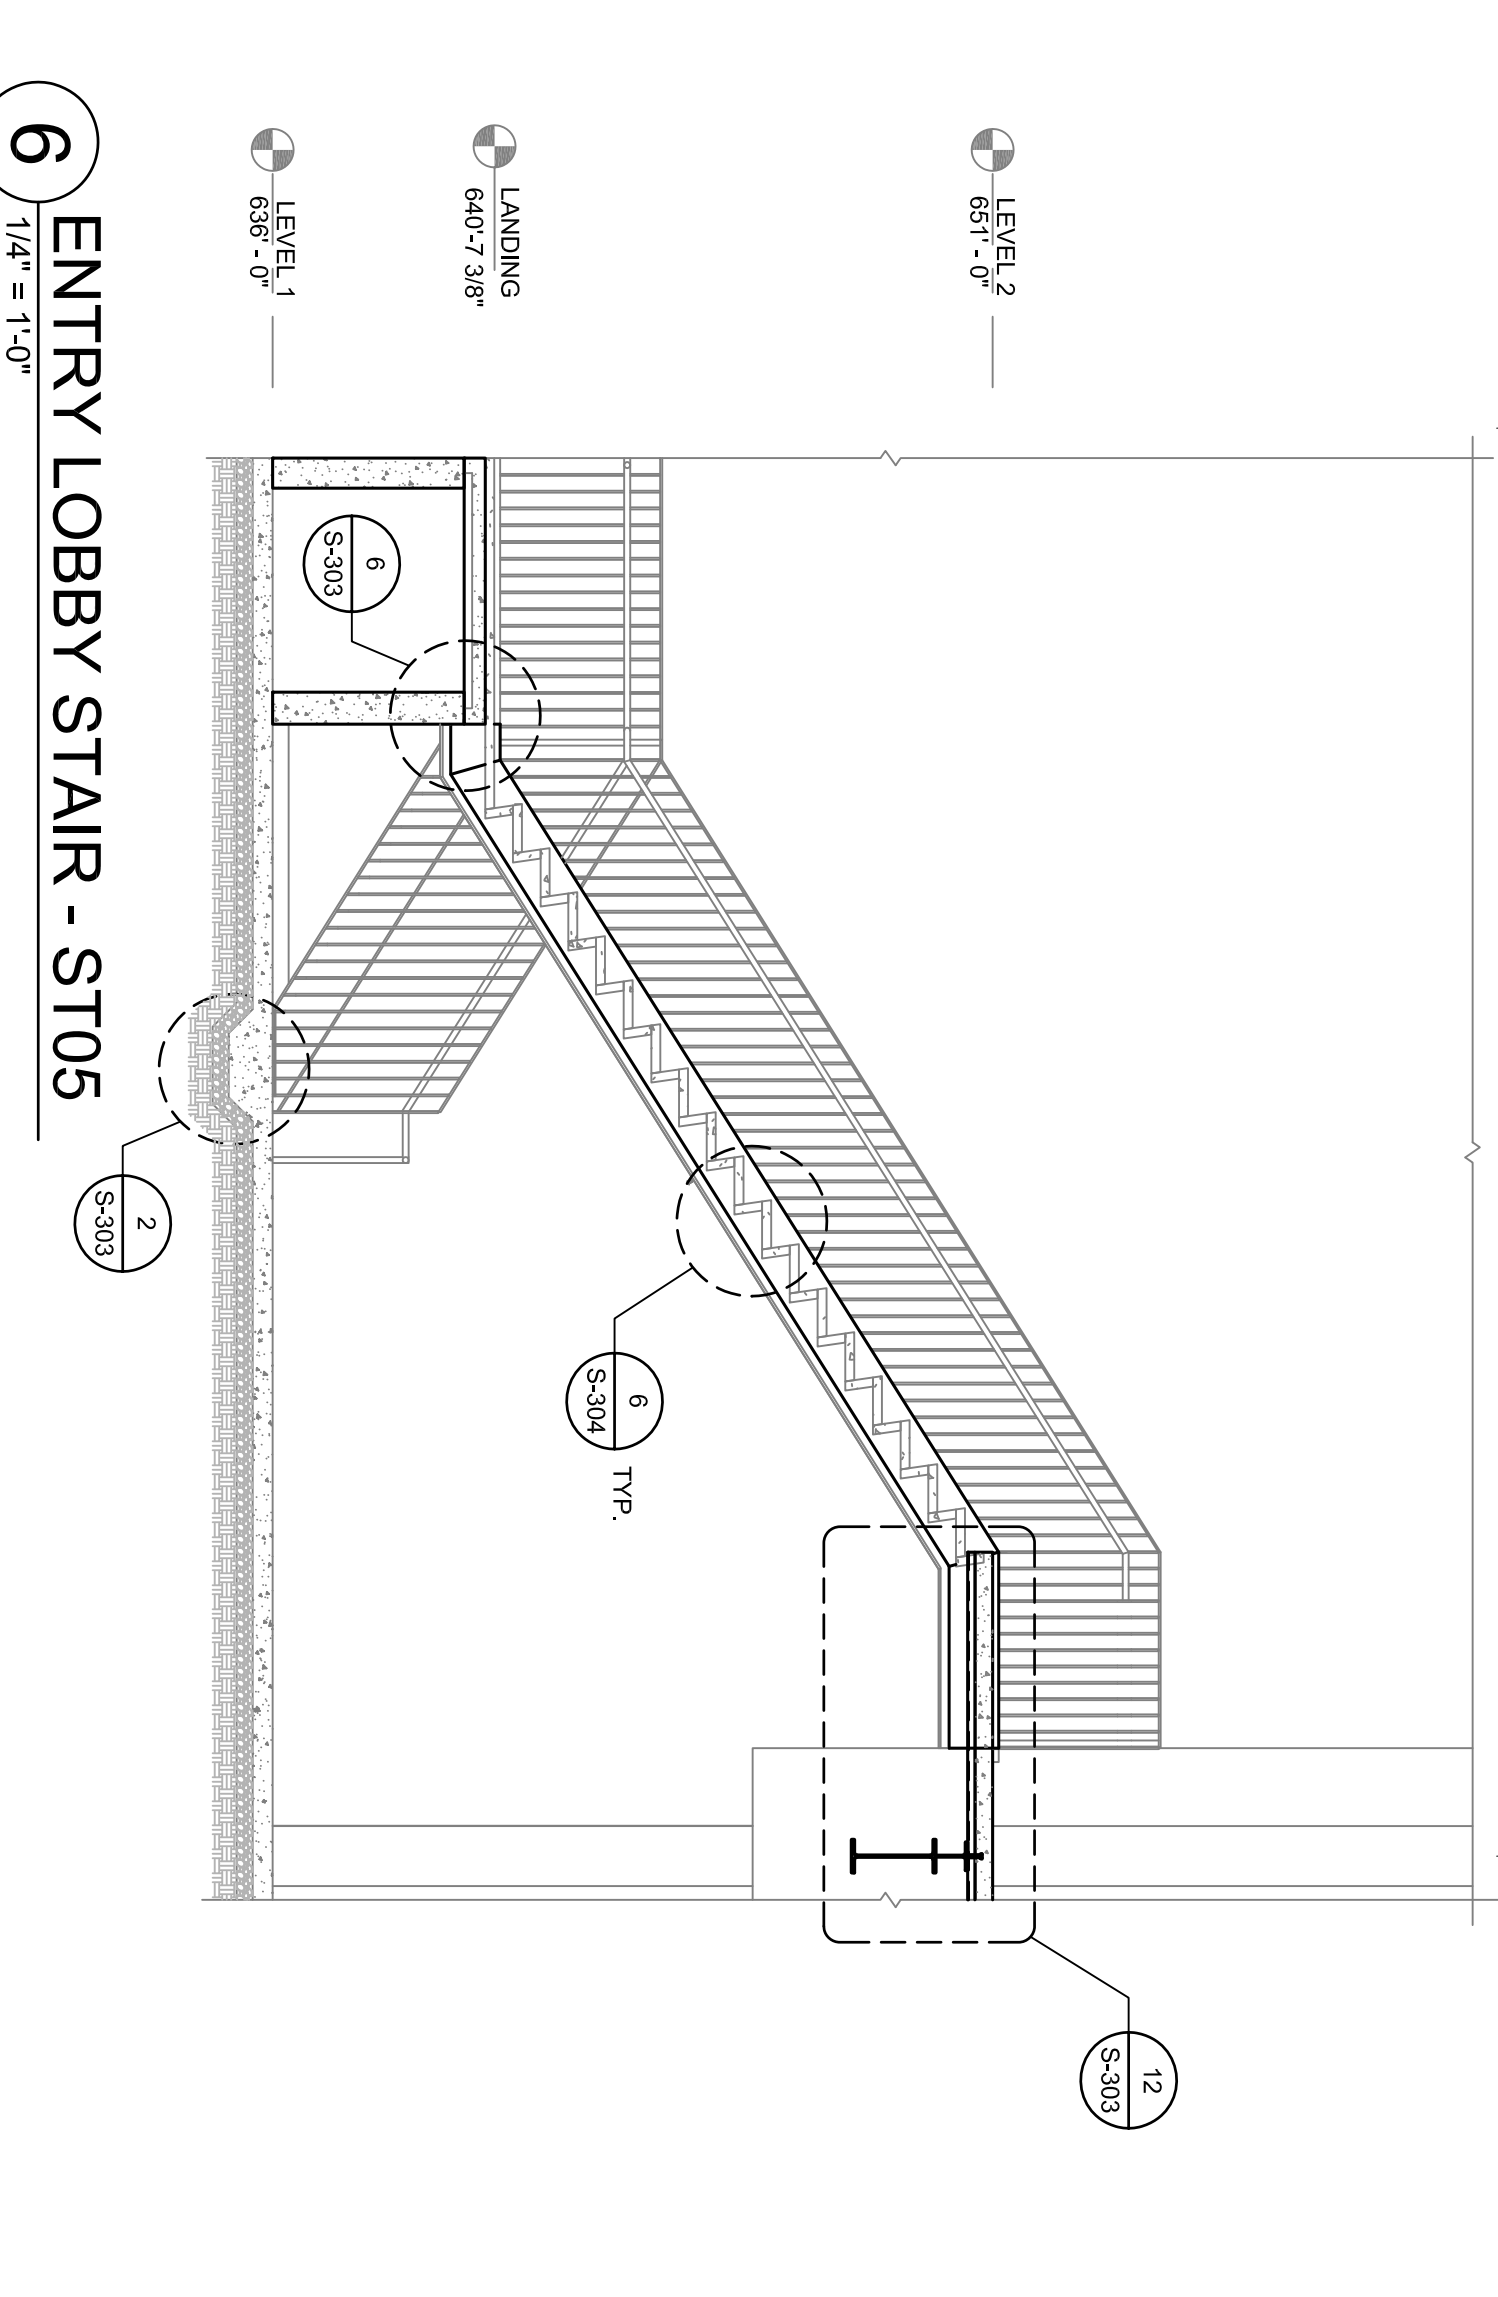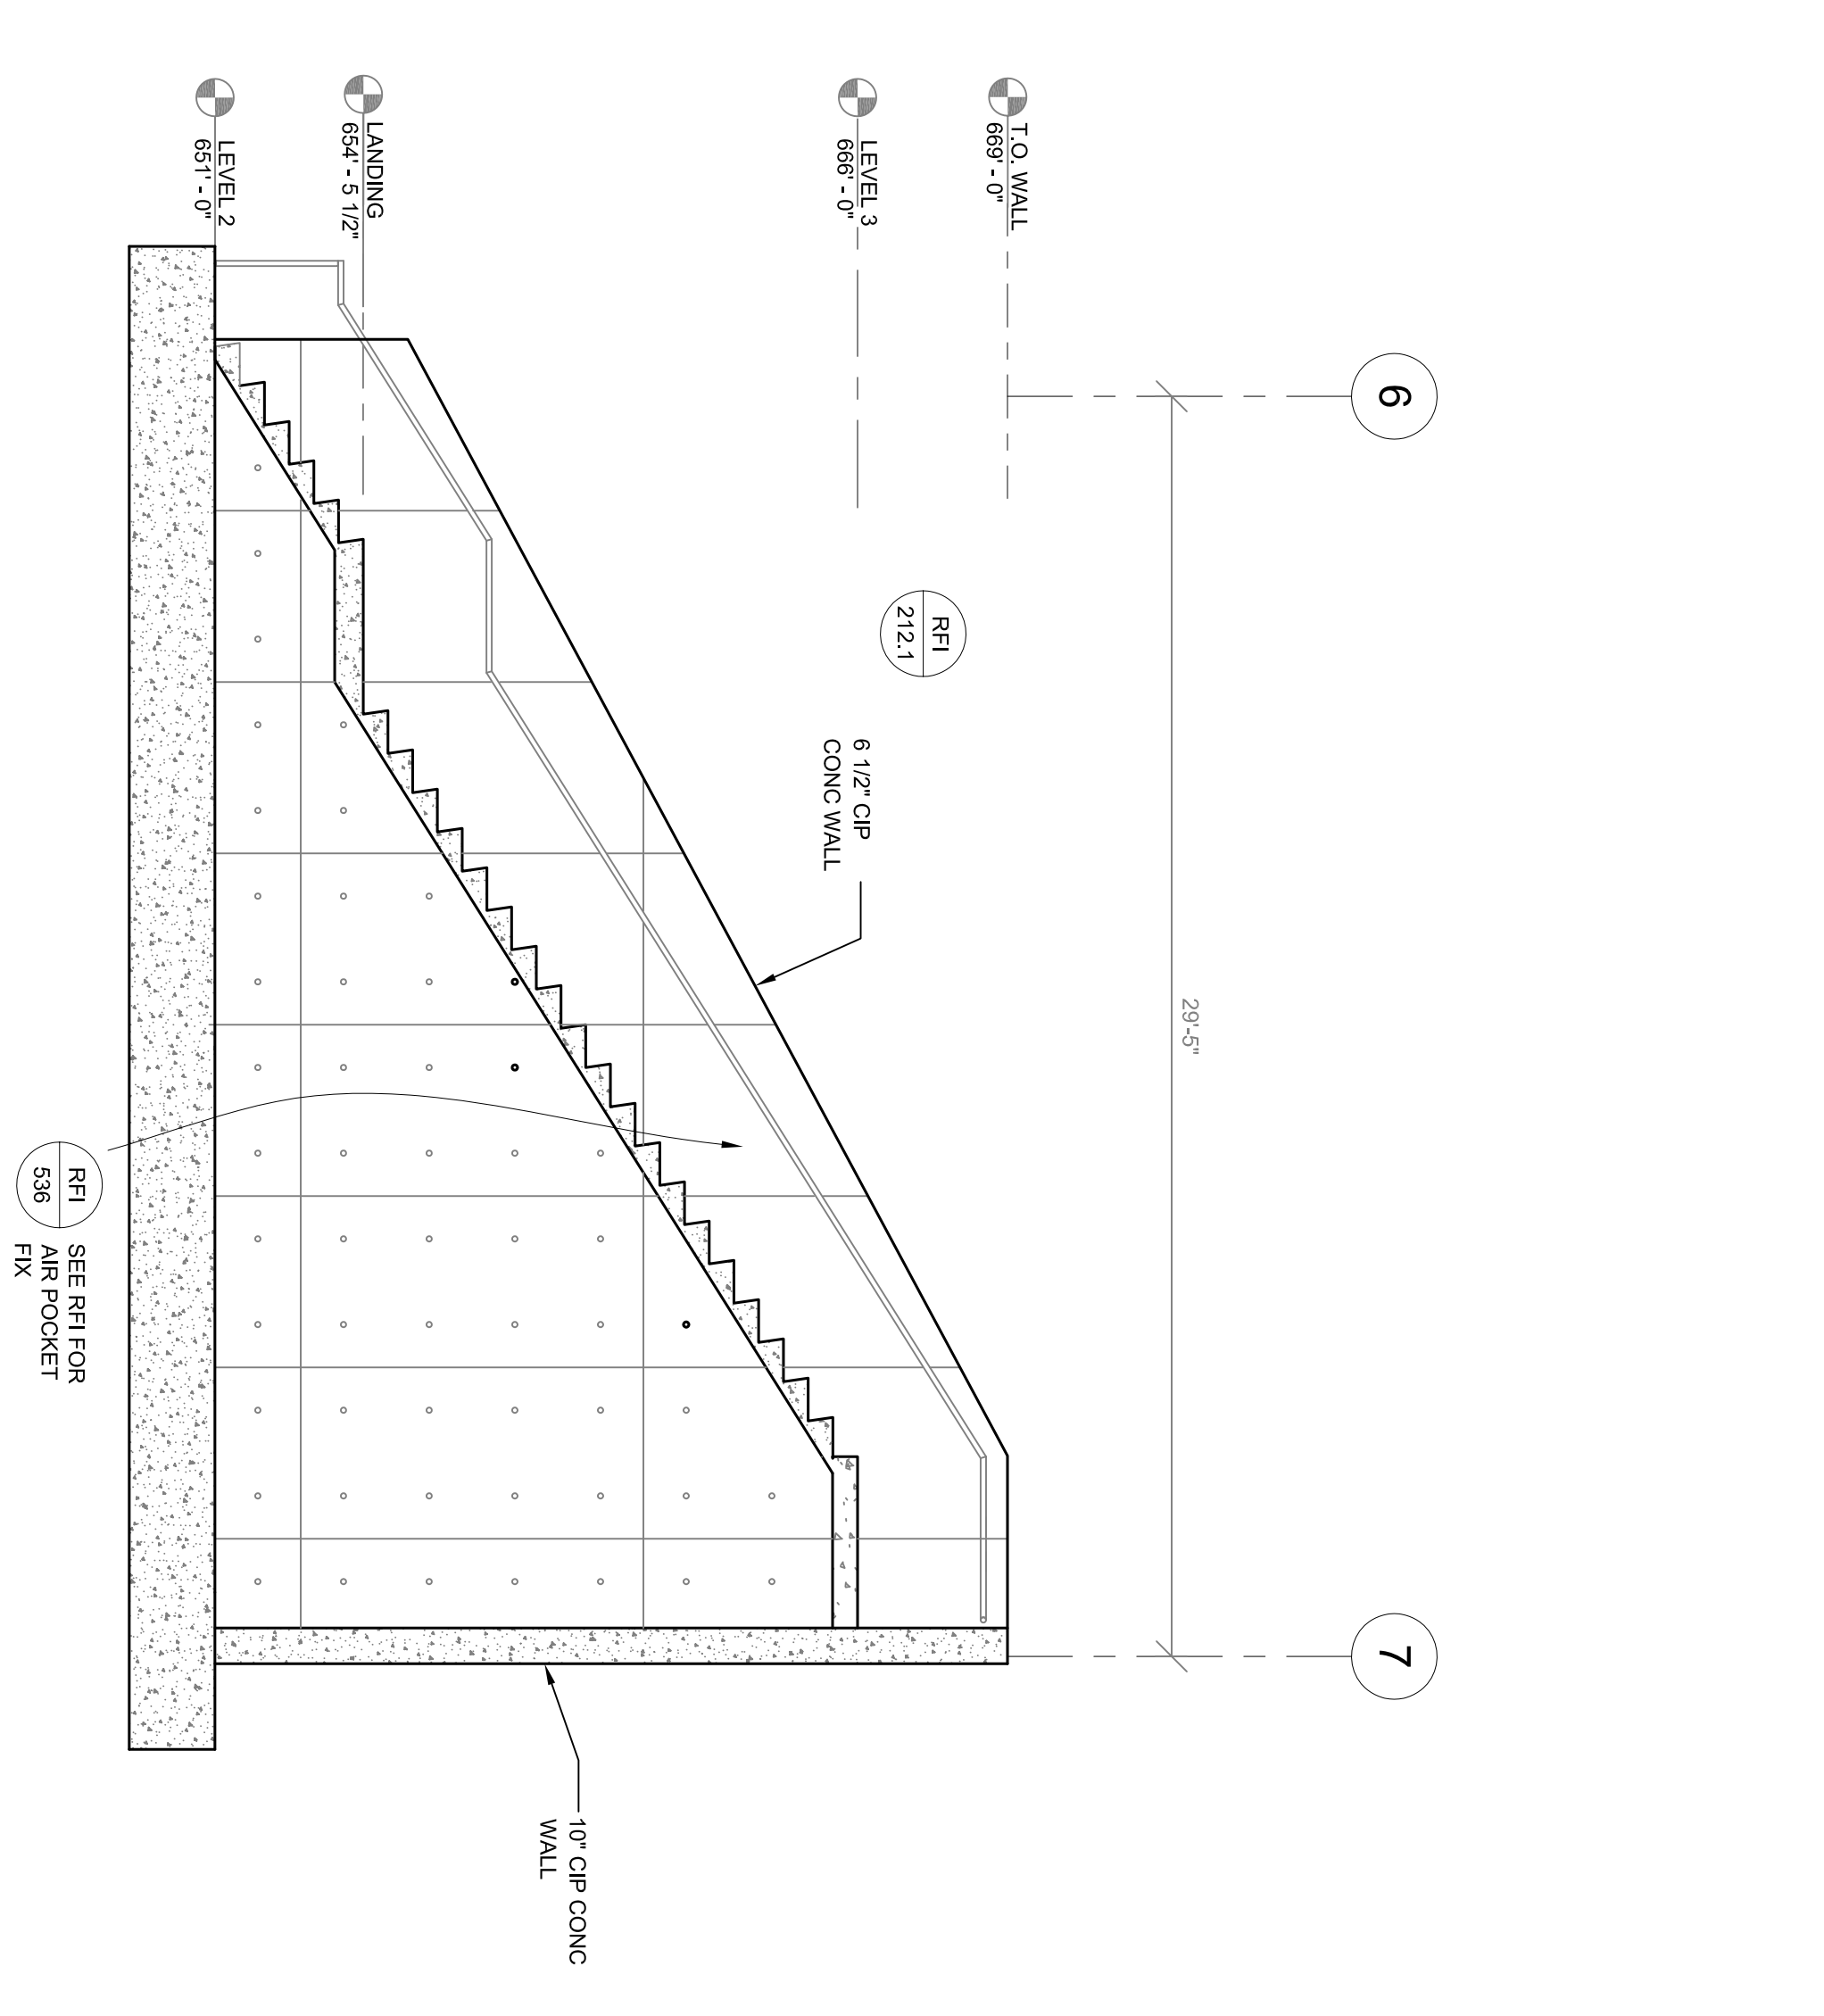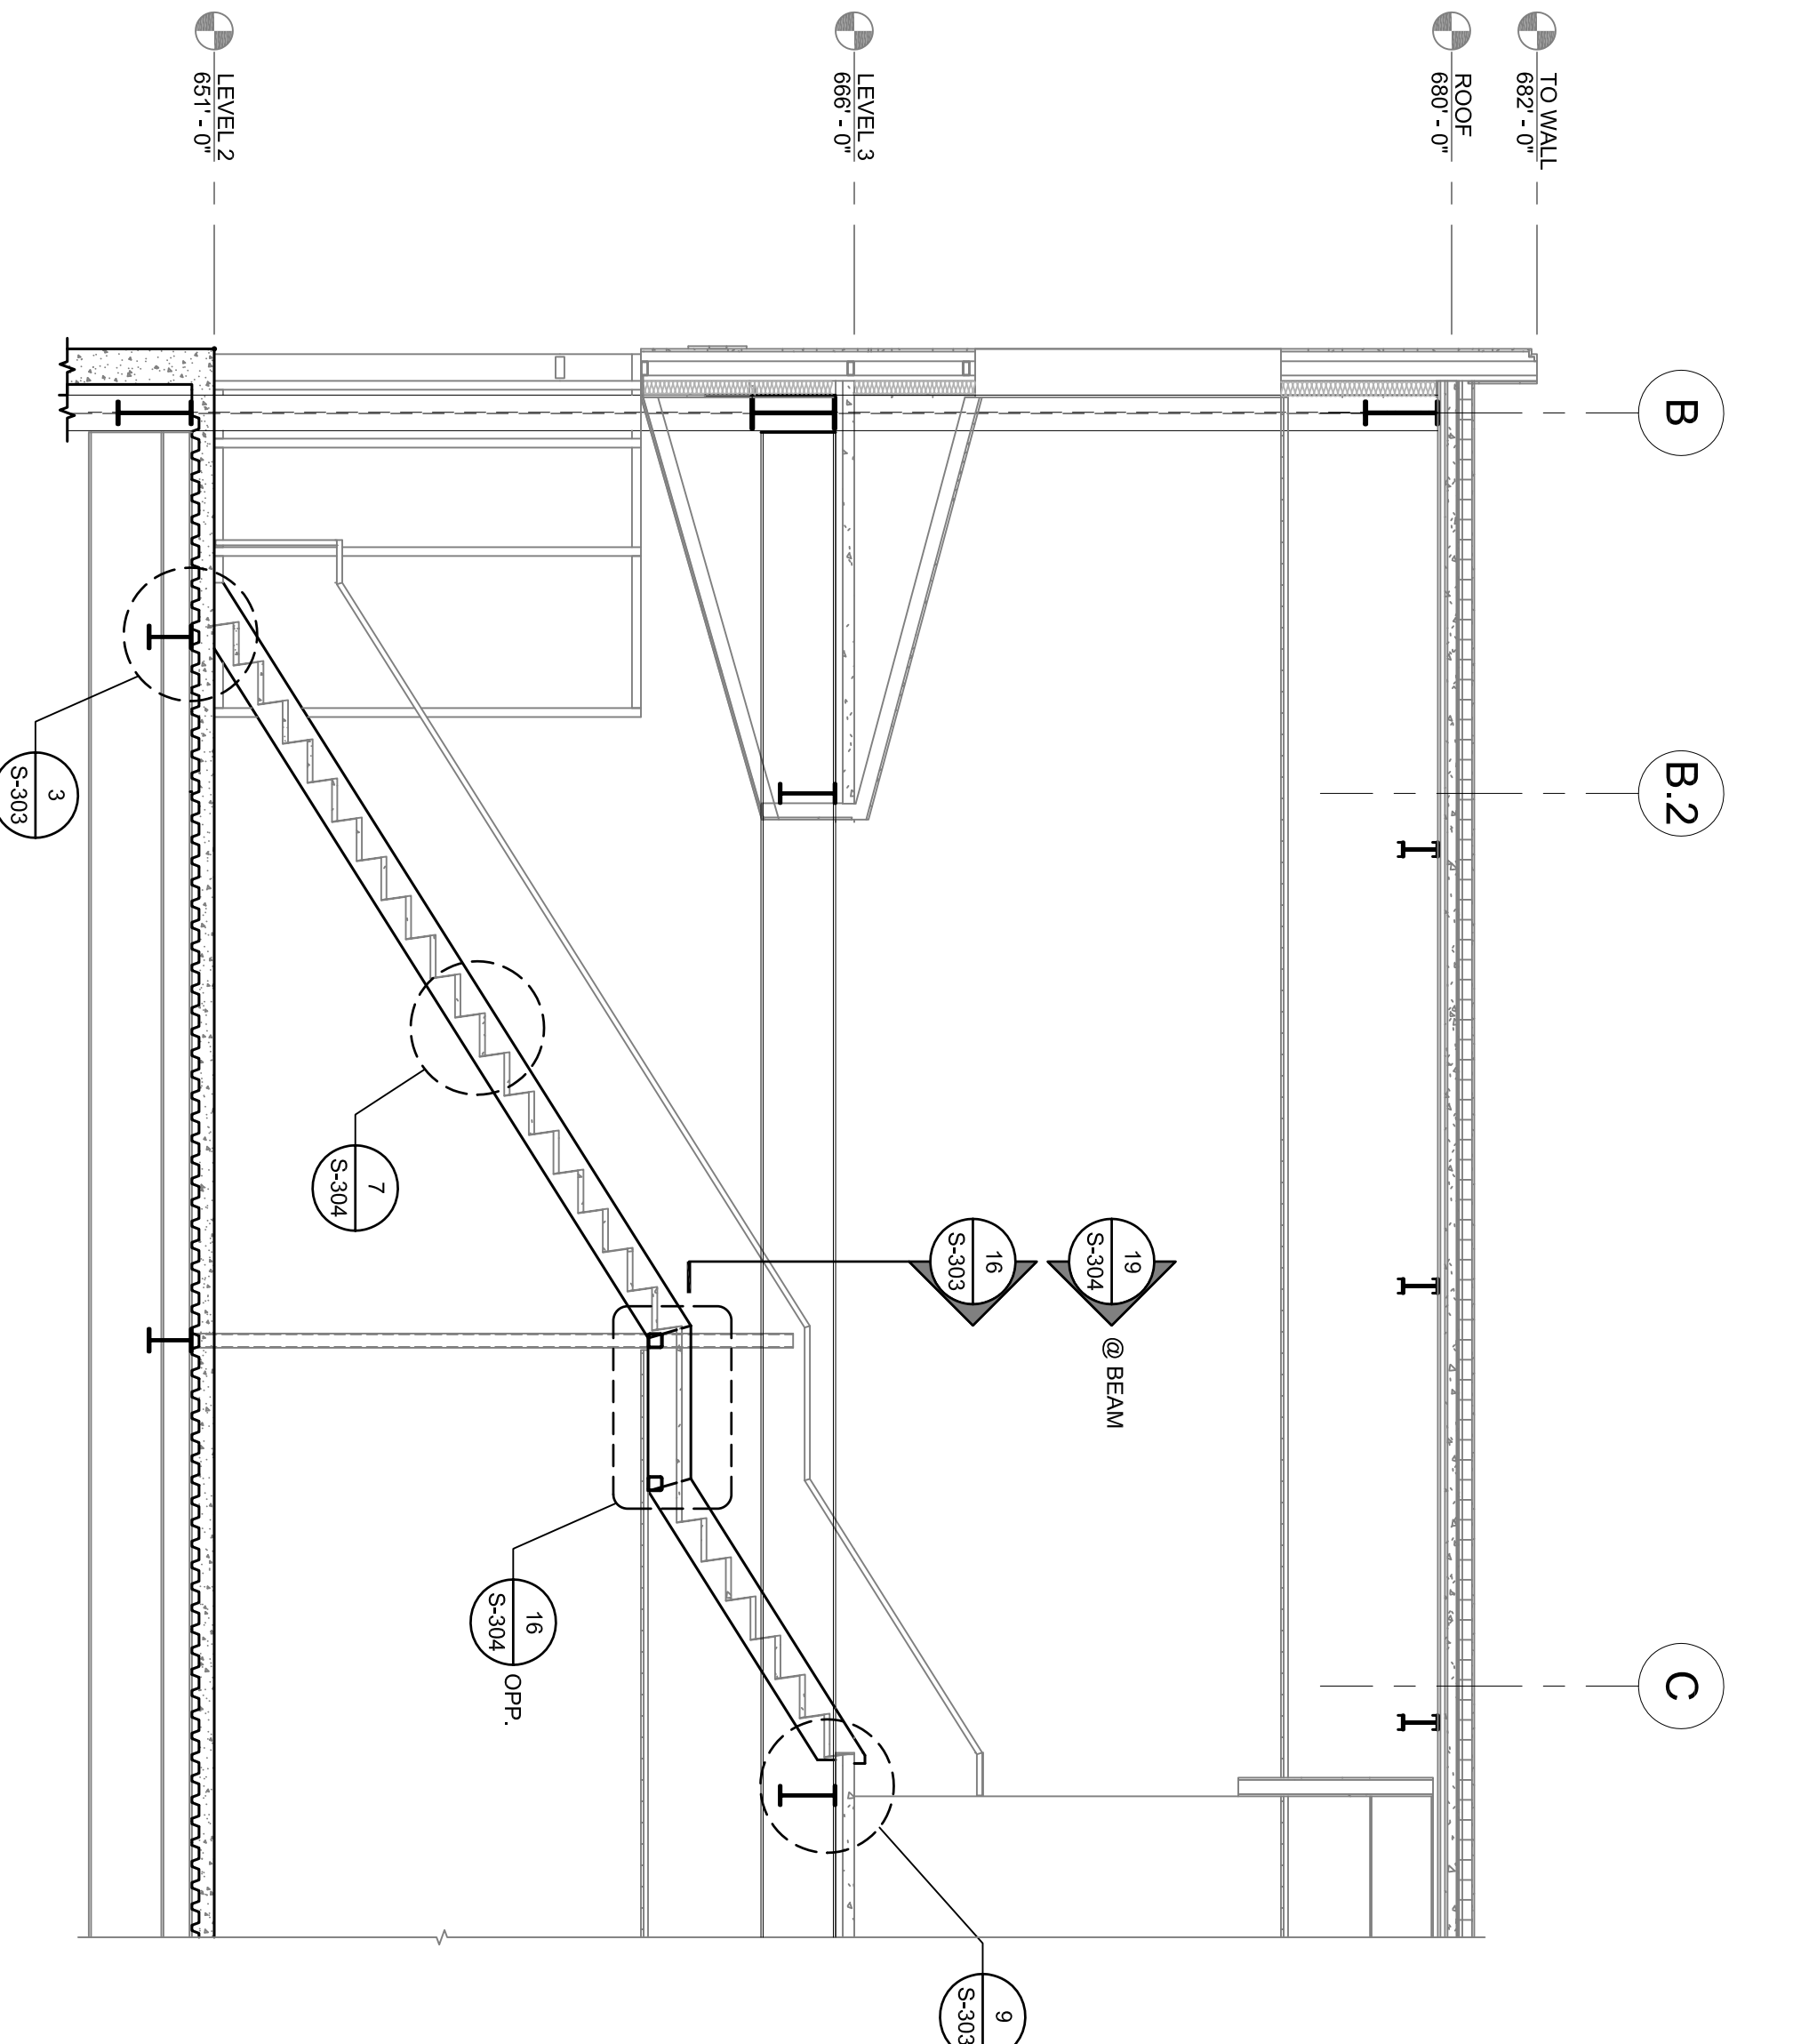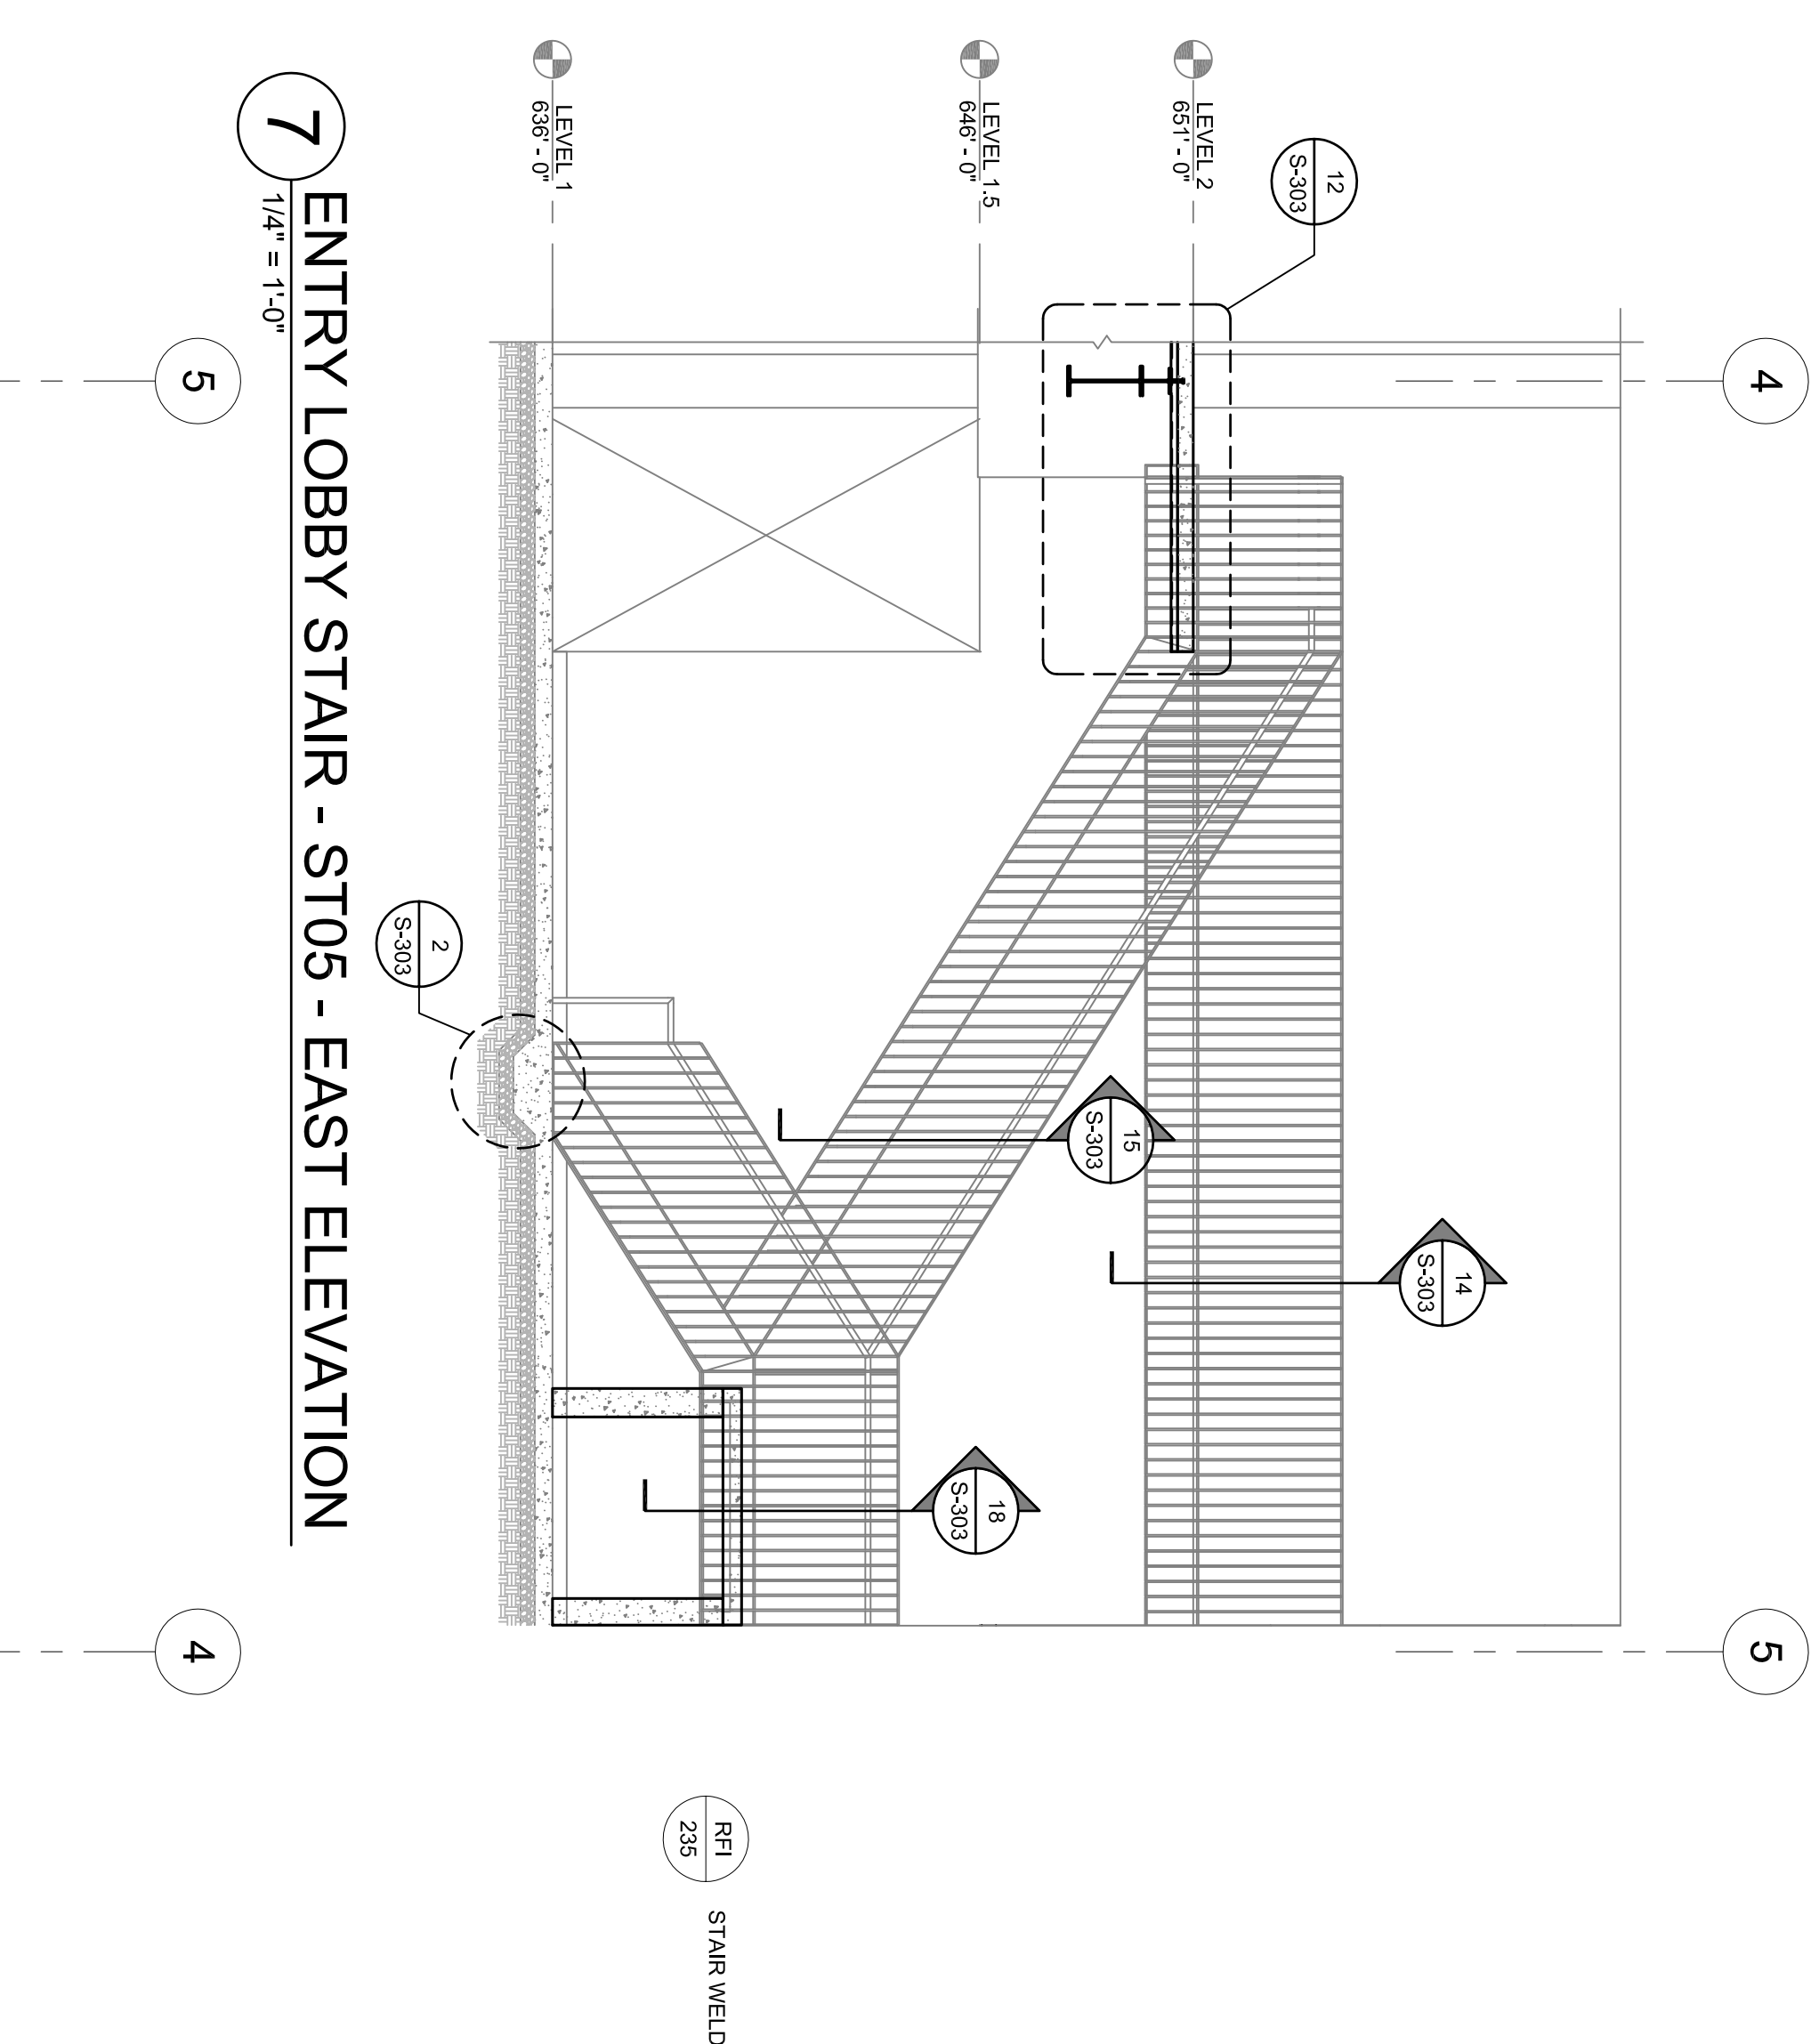


All drawings and notes are the property of Steinberg Architects and shall remain the property of Steinberg Architects. No part of this drawing may be reproduced or transmitted in any form or by any means, electronic or mechanical, including photocopying, recording, or by any information storage and retrieval system, without the prior written permission of Steinberg Architects. Notes scales must be indicated. This line should be equal to one inch.


**PROJECT RECORD SET**

**SKYLINE COLLEGE**  
 SAN MATEO COUNTY  
 COMMUNITY COLLEGE  
 DISTRICT  
**CIP2 DESIGN-BUILD  
 PROJECT  
 BUILDING 4**


PROJECT NO: 0071280 DRAWN BY: AV  
 DATE: 03/08/09 CHECKED BY: CB  
 SCALE:  
 SHEET TITLE:  
**ENLARGED  
 STAIR PLANS**

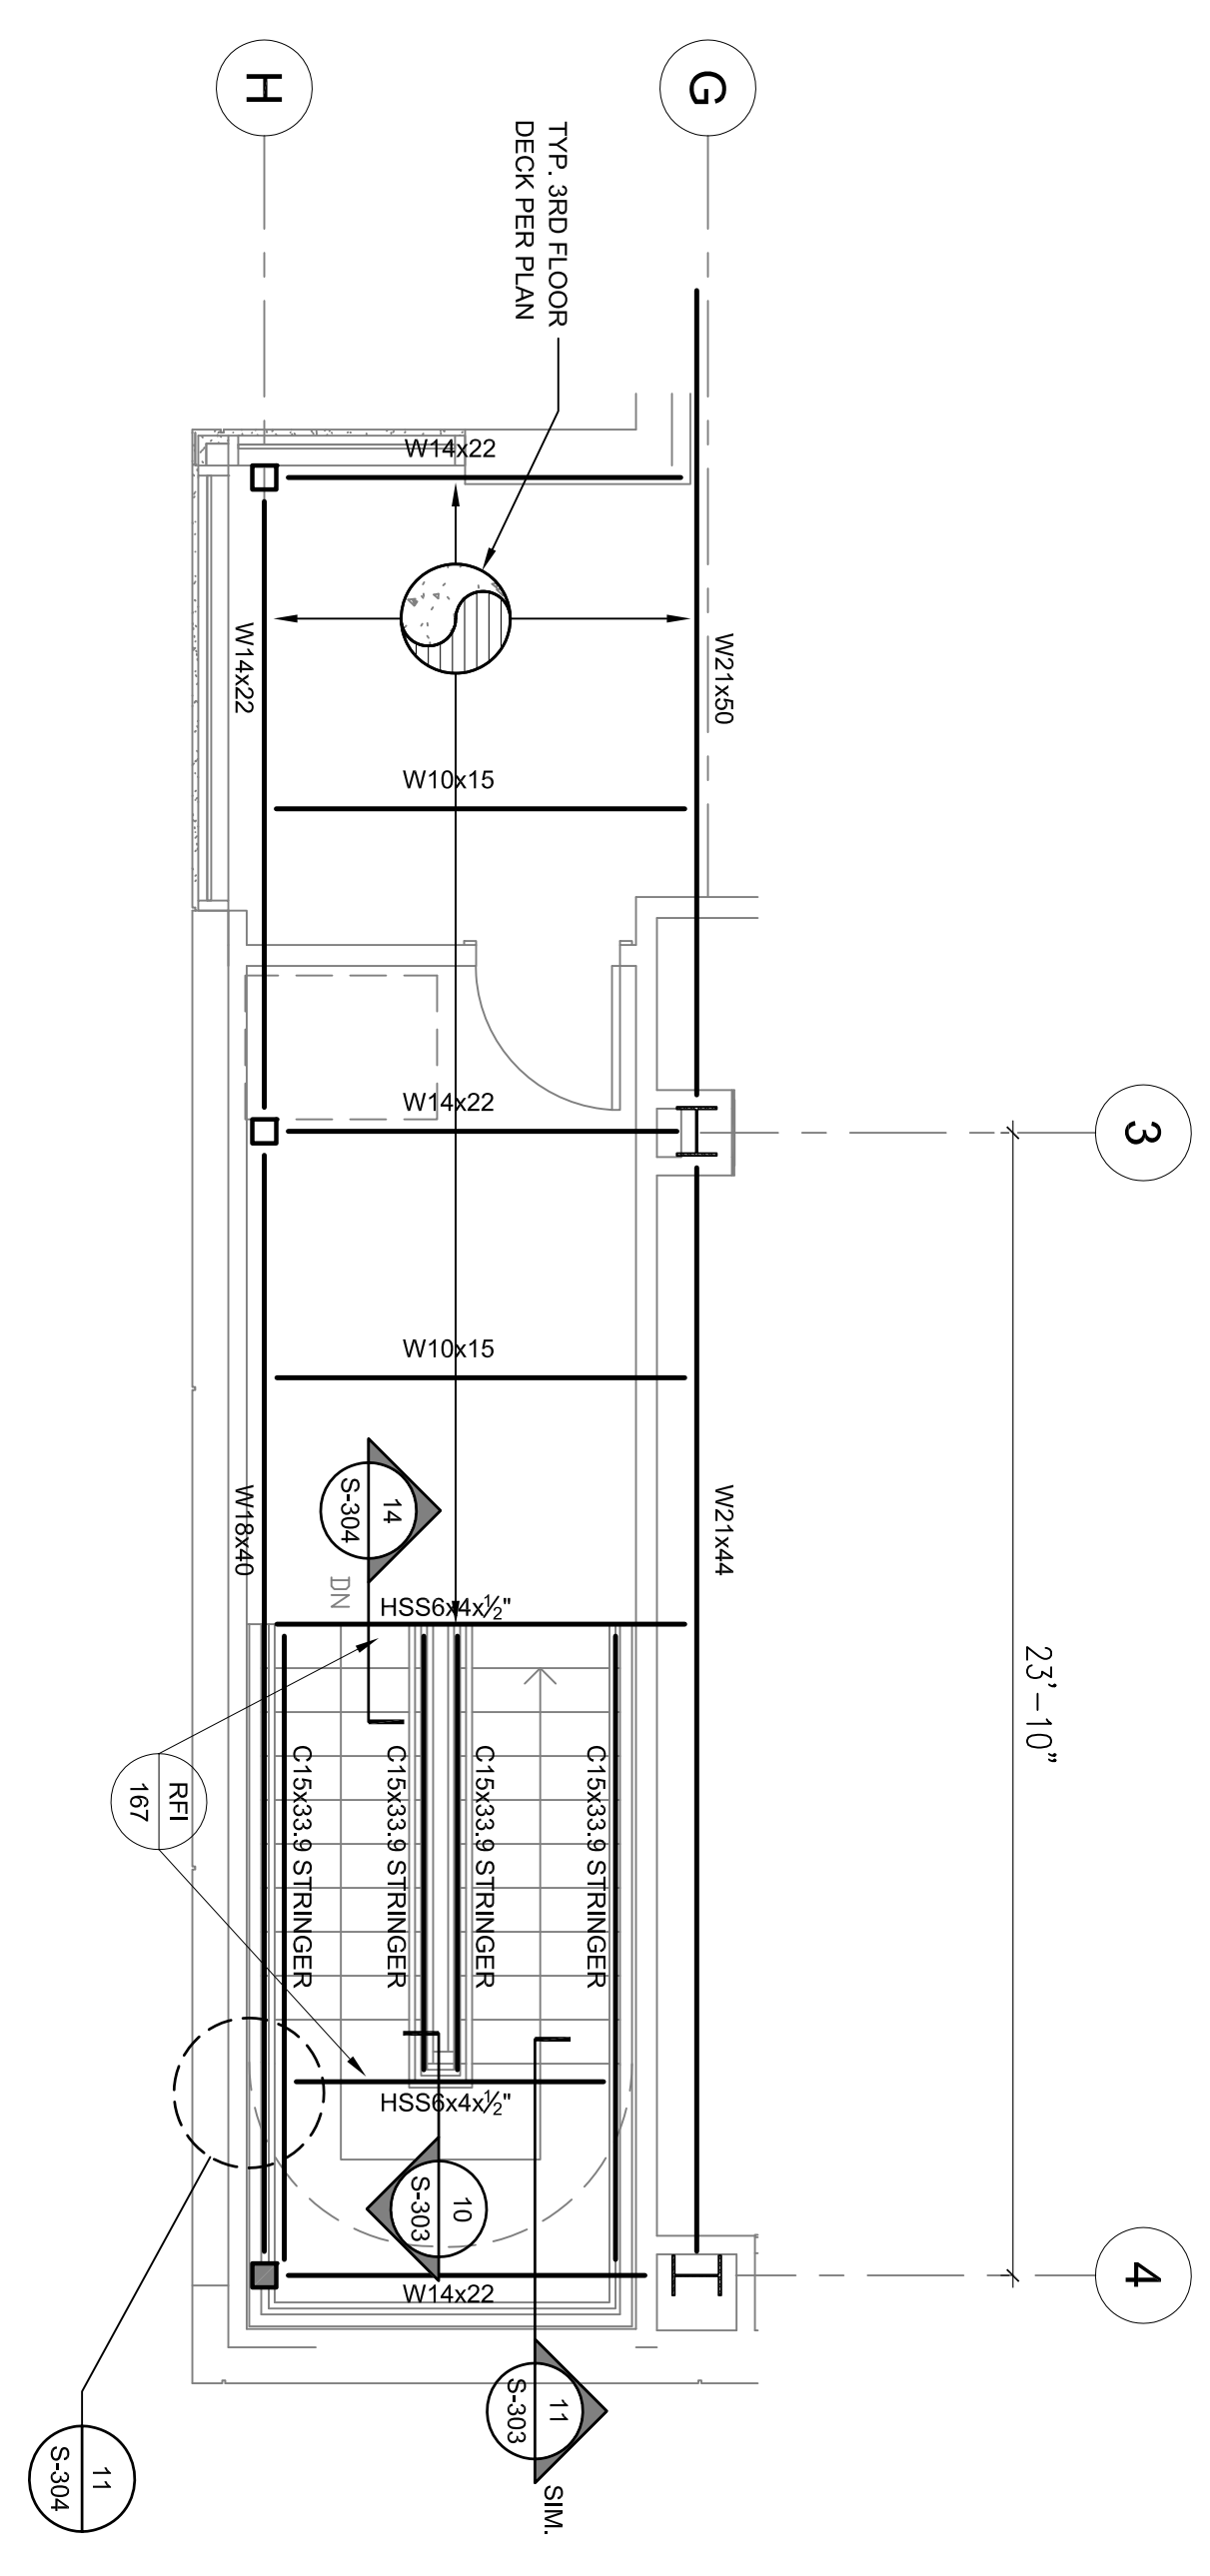


**3** SOUTHEAST STAIR - ST06 - LEVEL 3  
 1/4" = 1'-0"

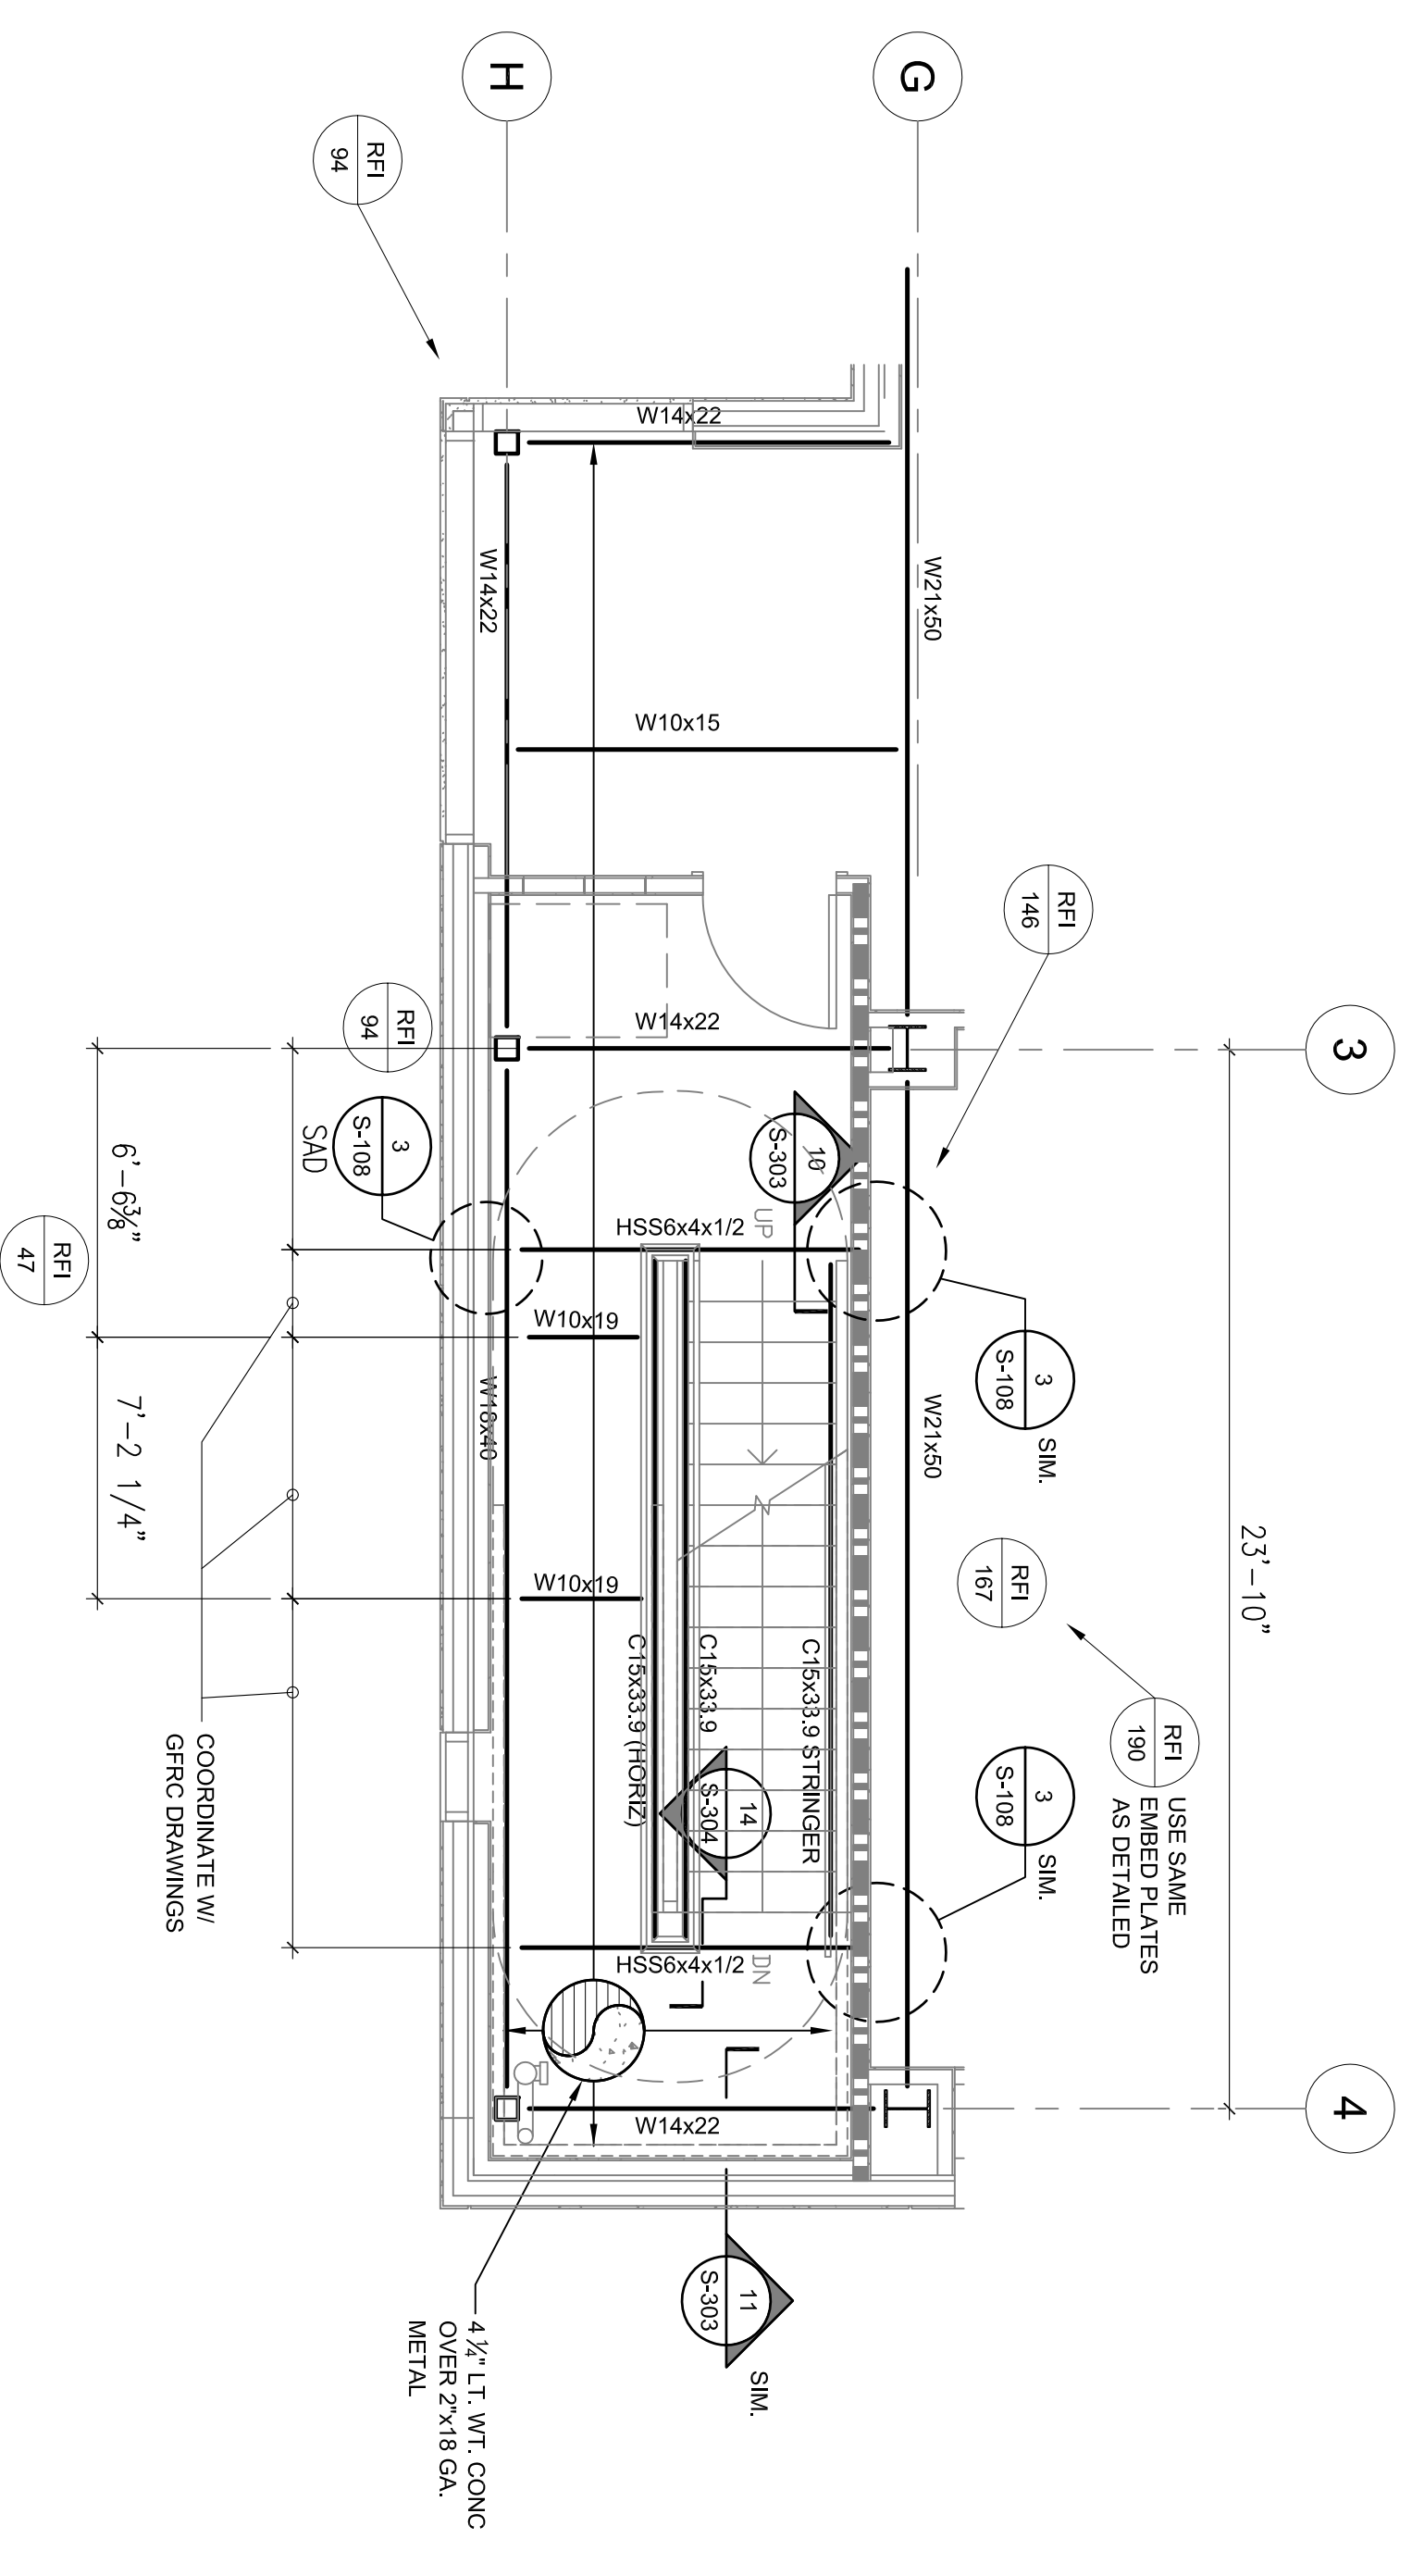


**2** SOUTHEAST STAIR - ST06 - LEVEL 2  
 1/4" = 1'-0"

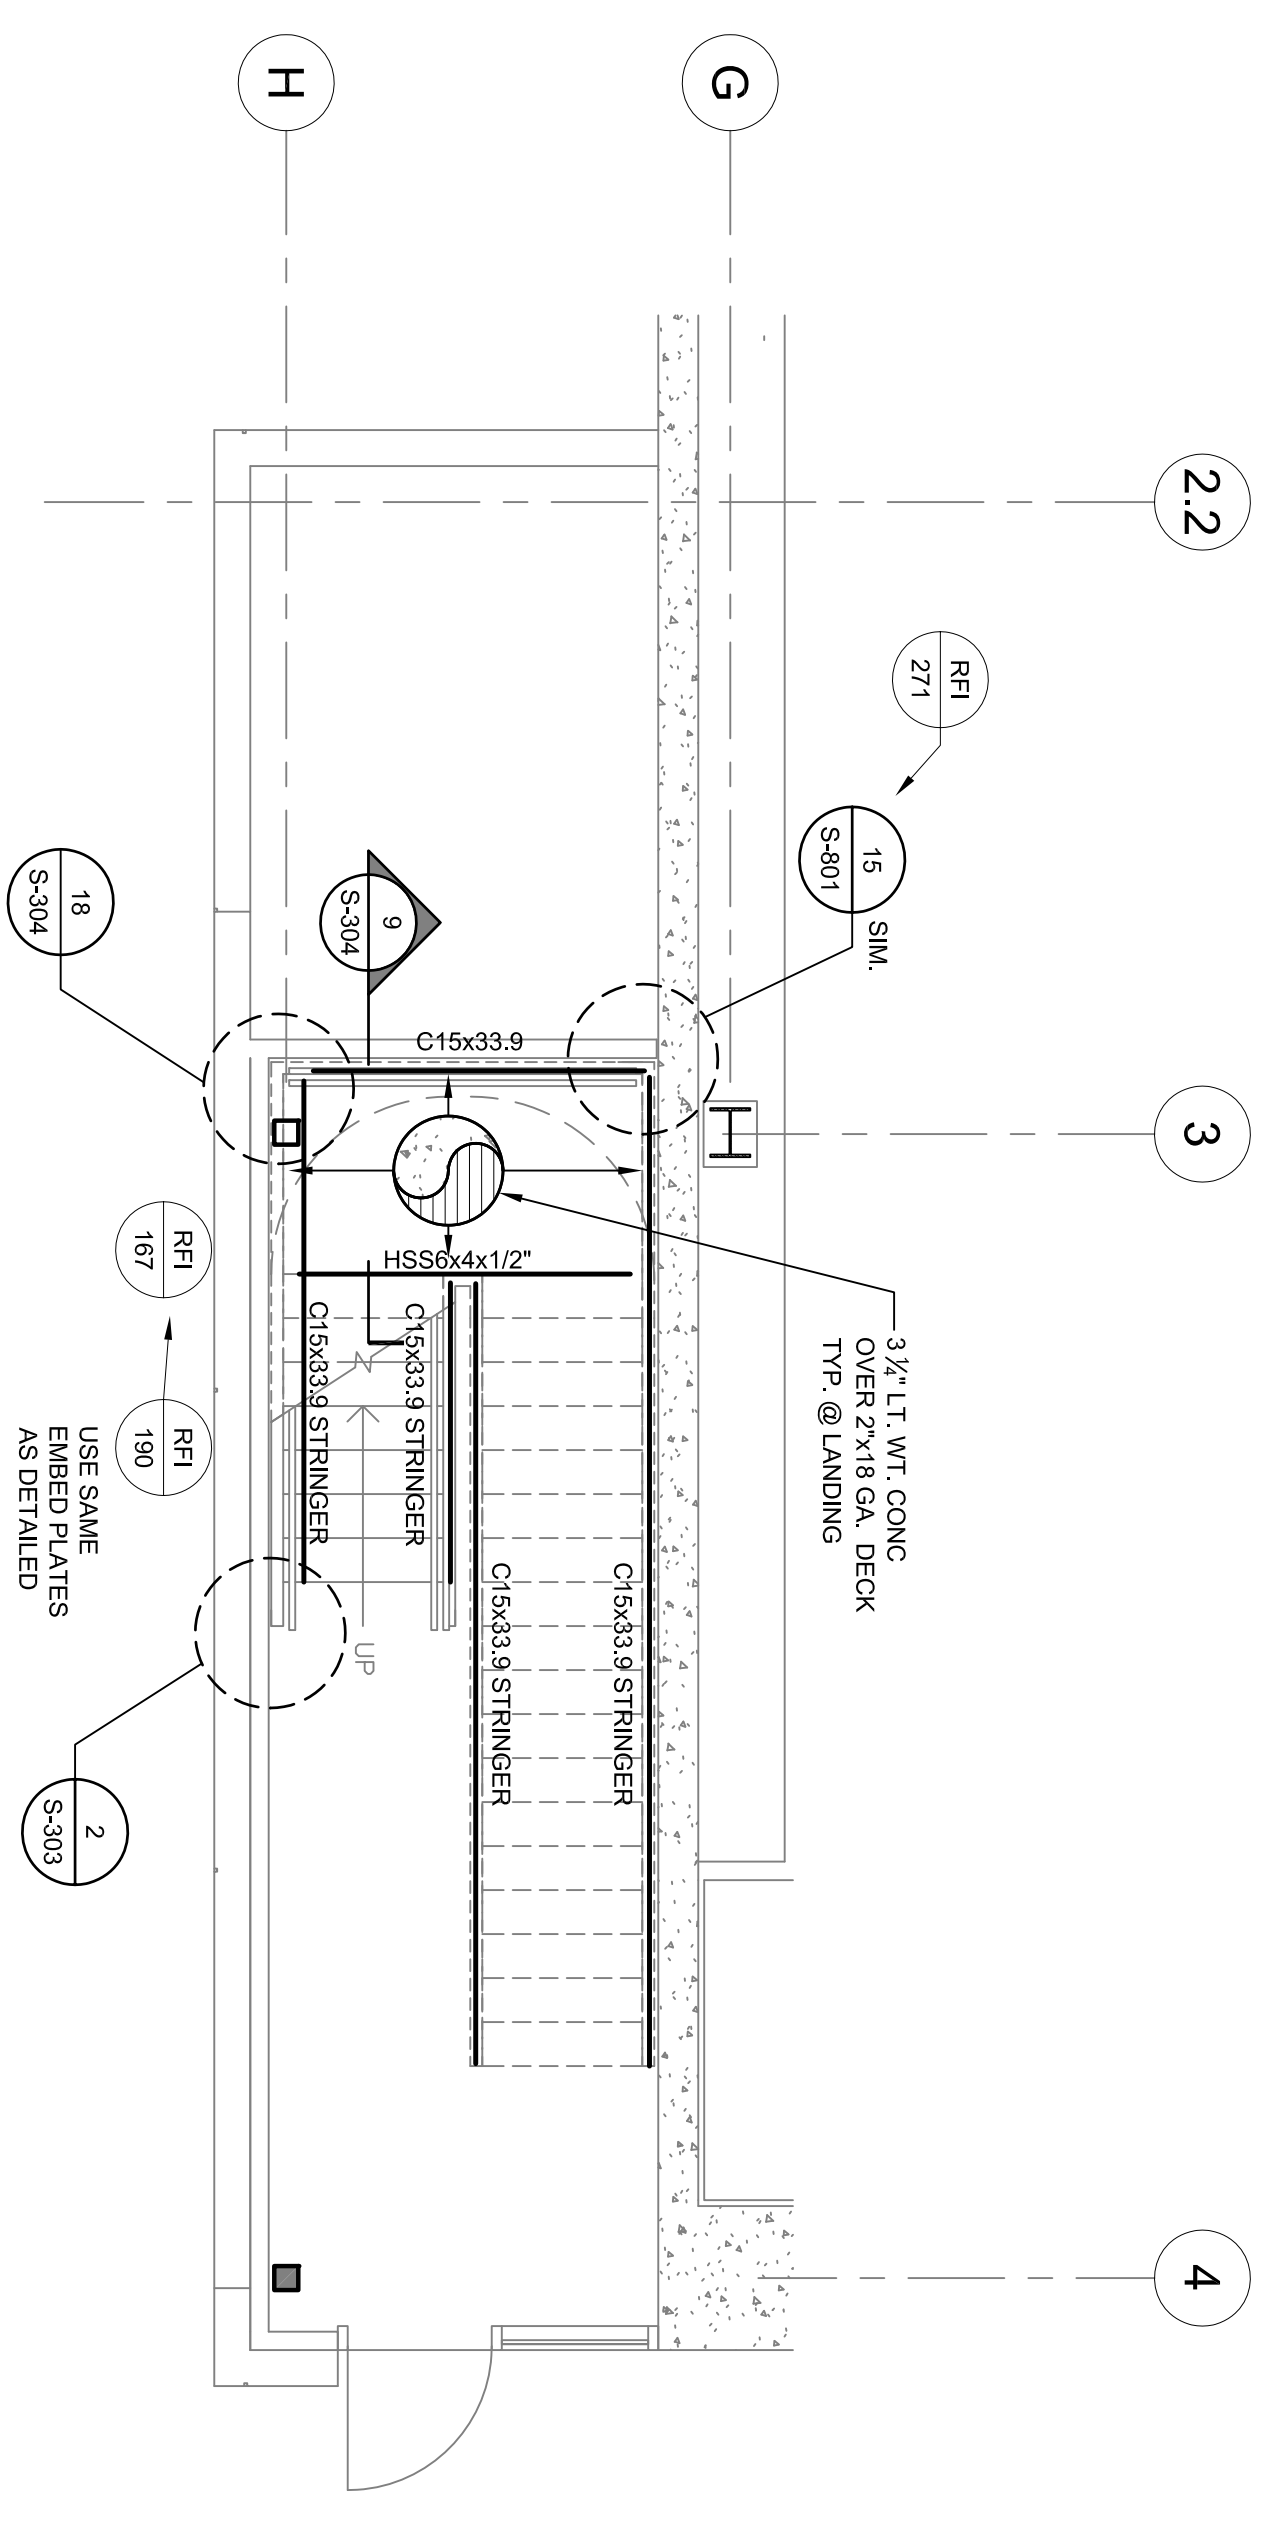


**1** SOUTHEAST STAIR - ST06 - LEVEL 1  
 1/4" = 1'-0"

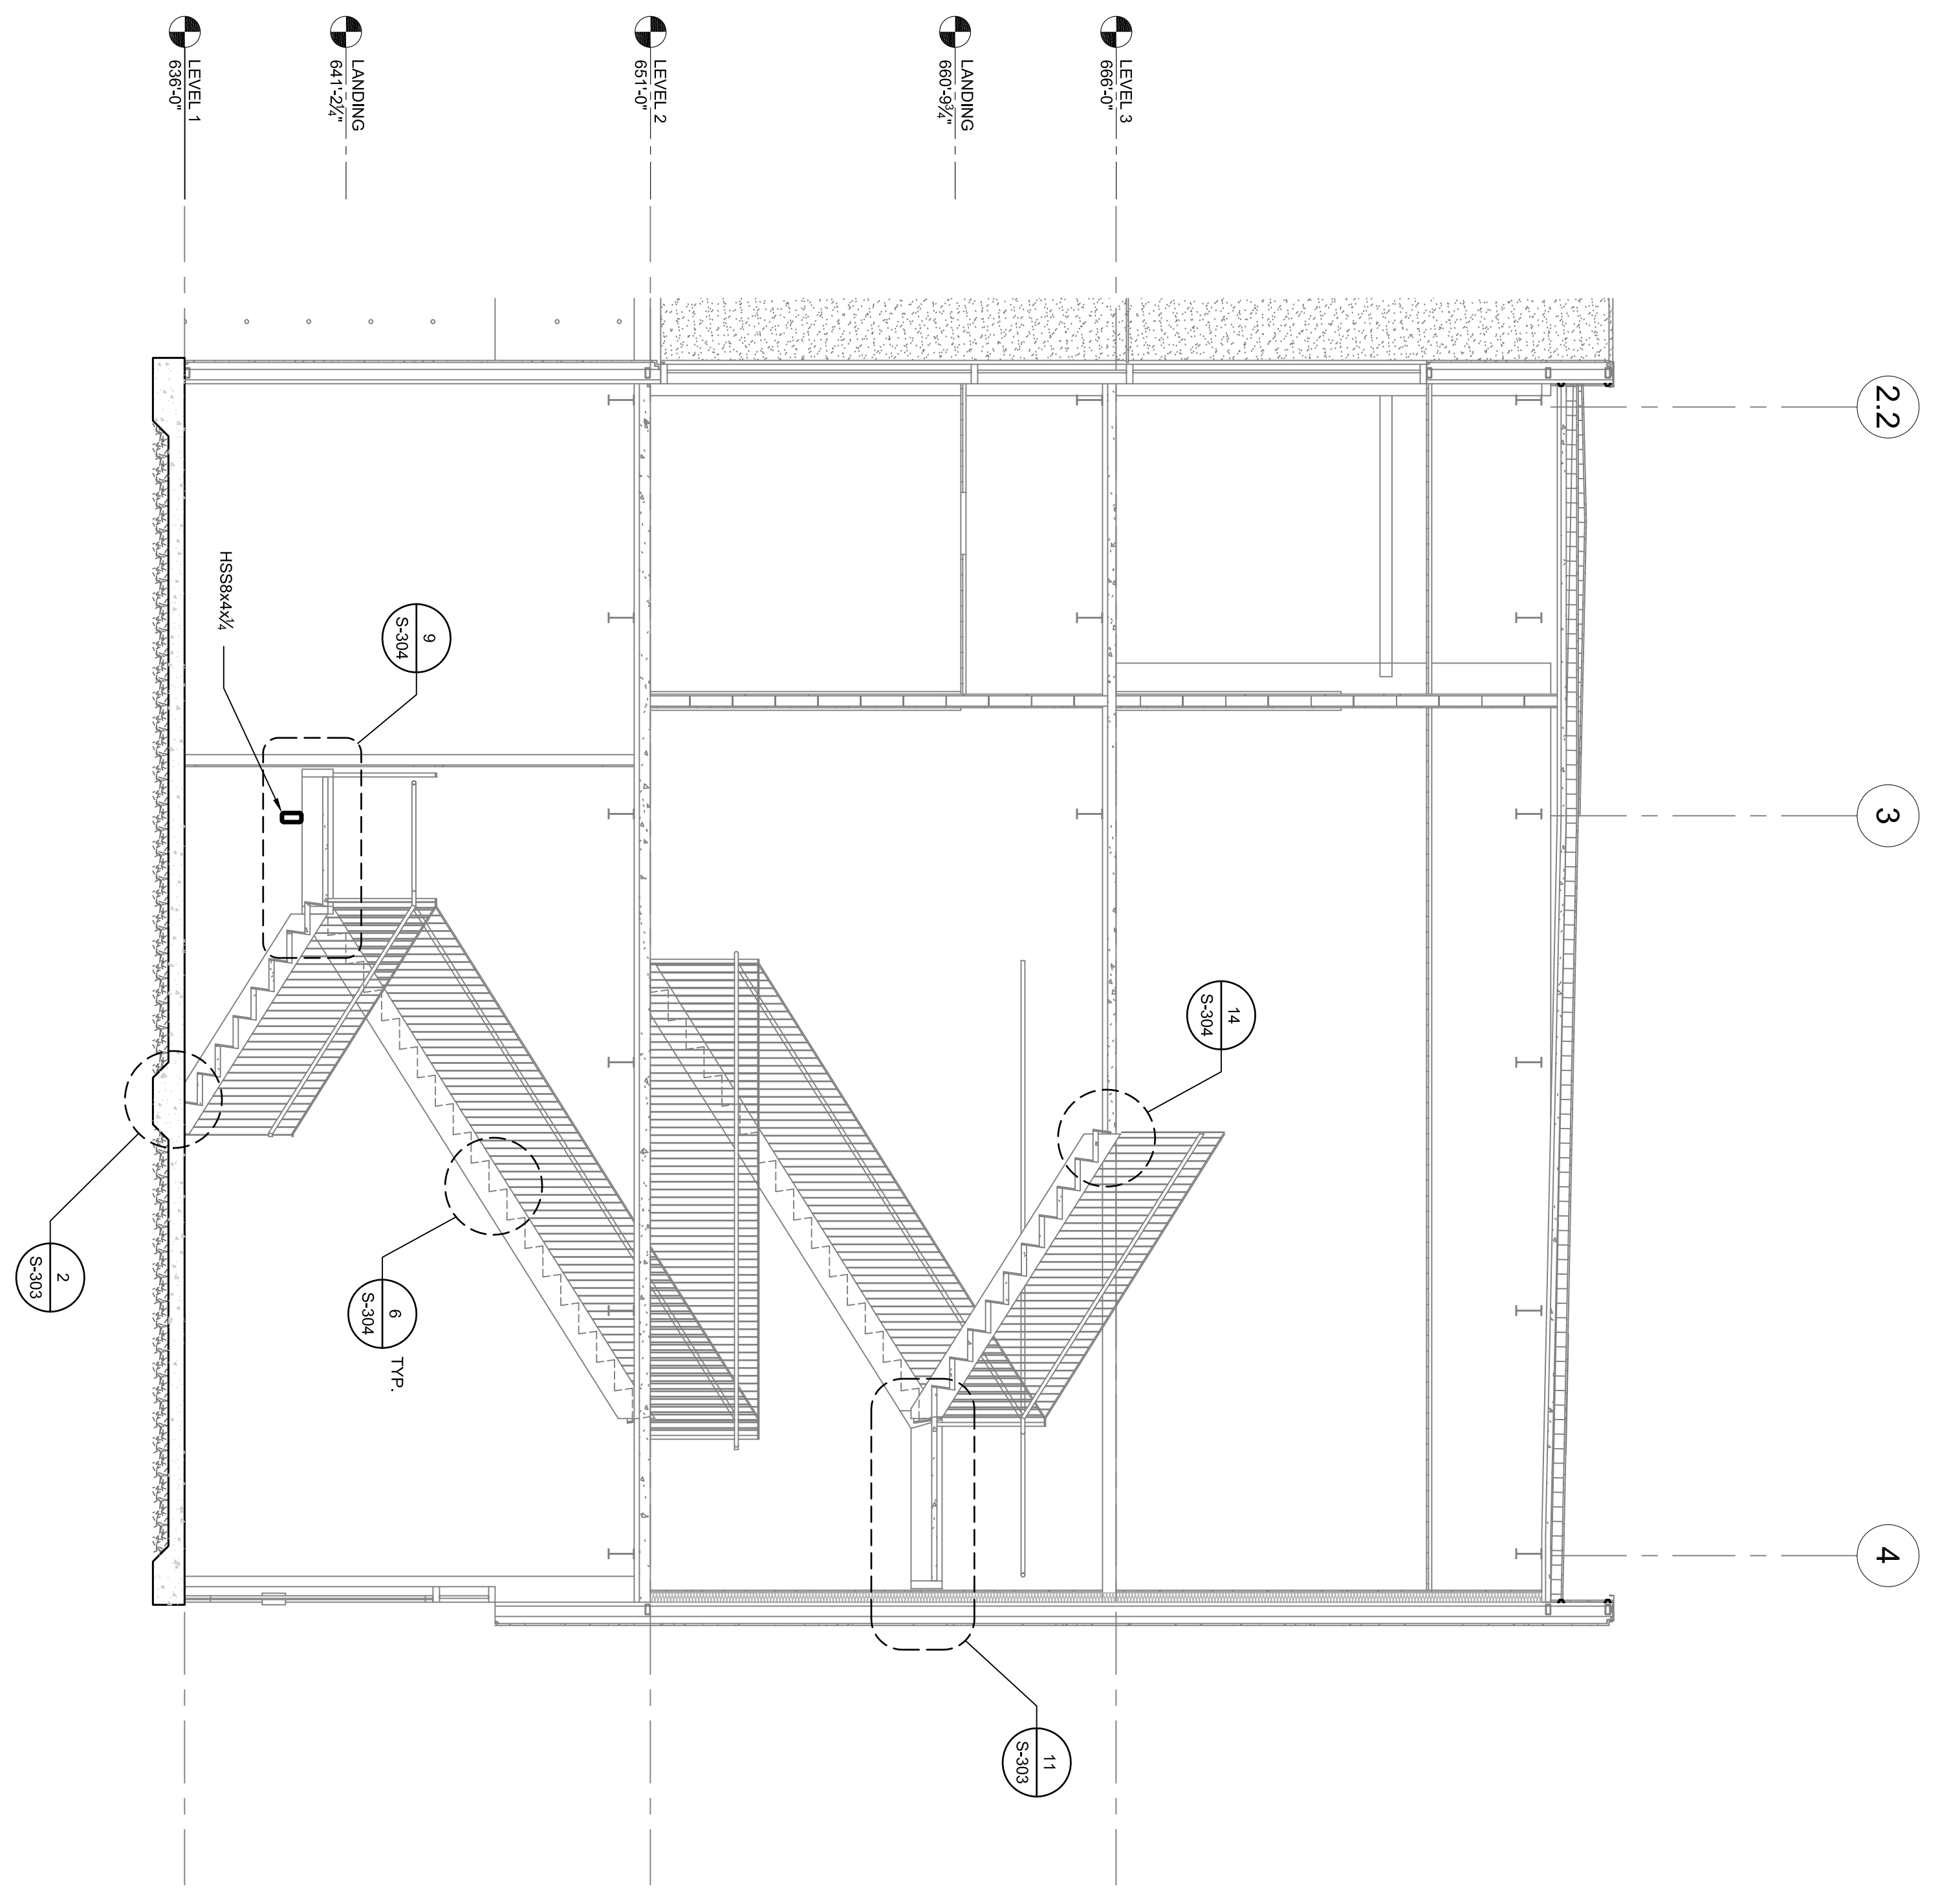


**4** SOUTHEAST STAIR - ST06  
 1/4" = 1'-0"

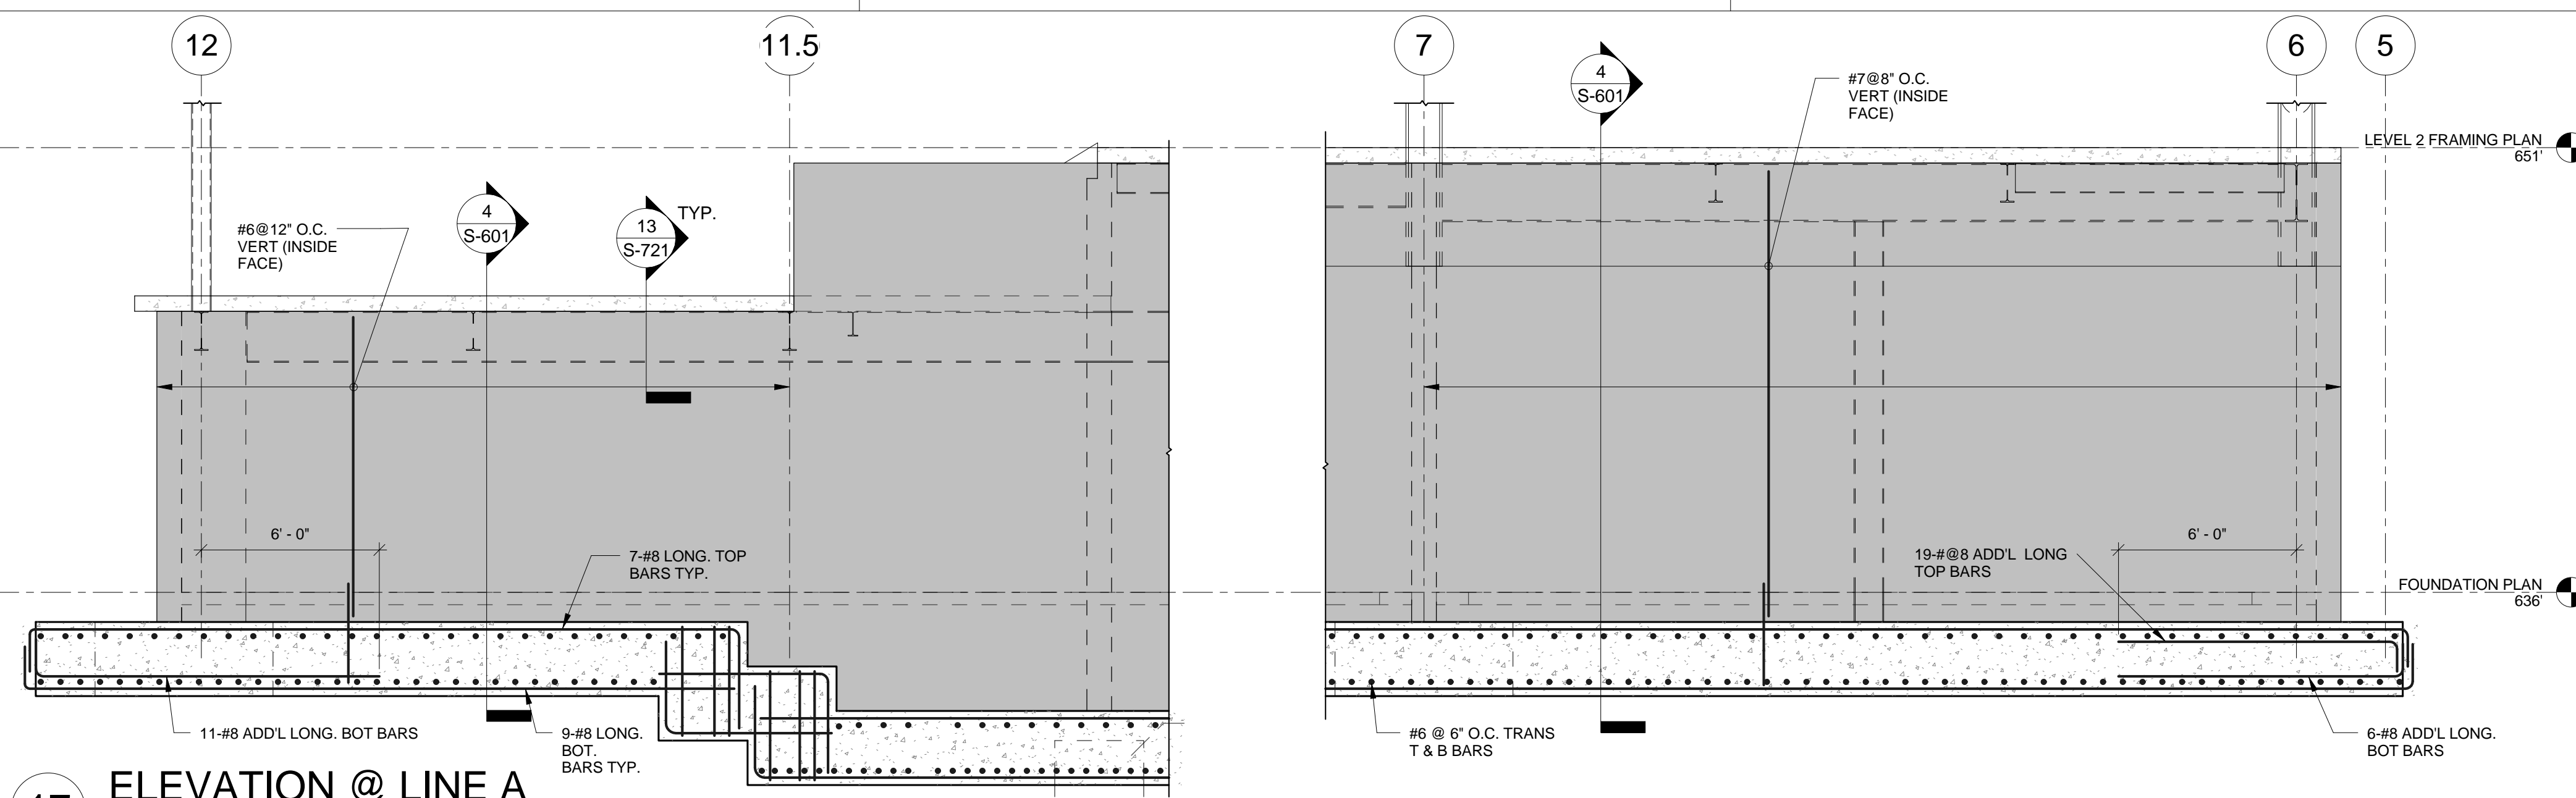


17 ELEVATION @ LINE A  
SCALE: 1/4" = 1'-0"

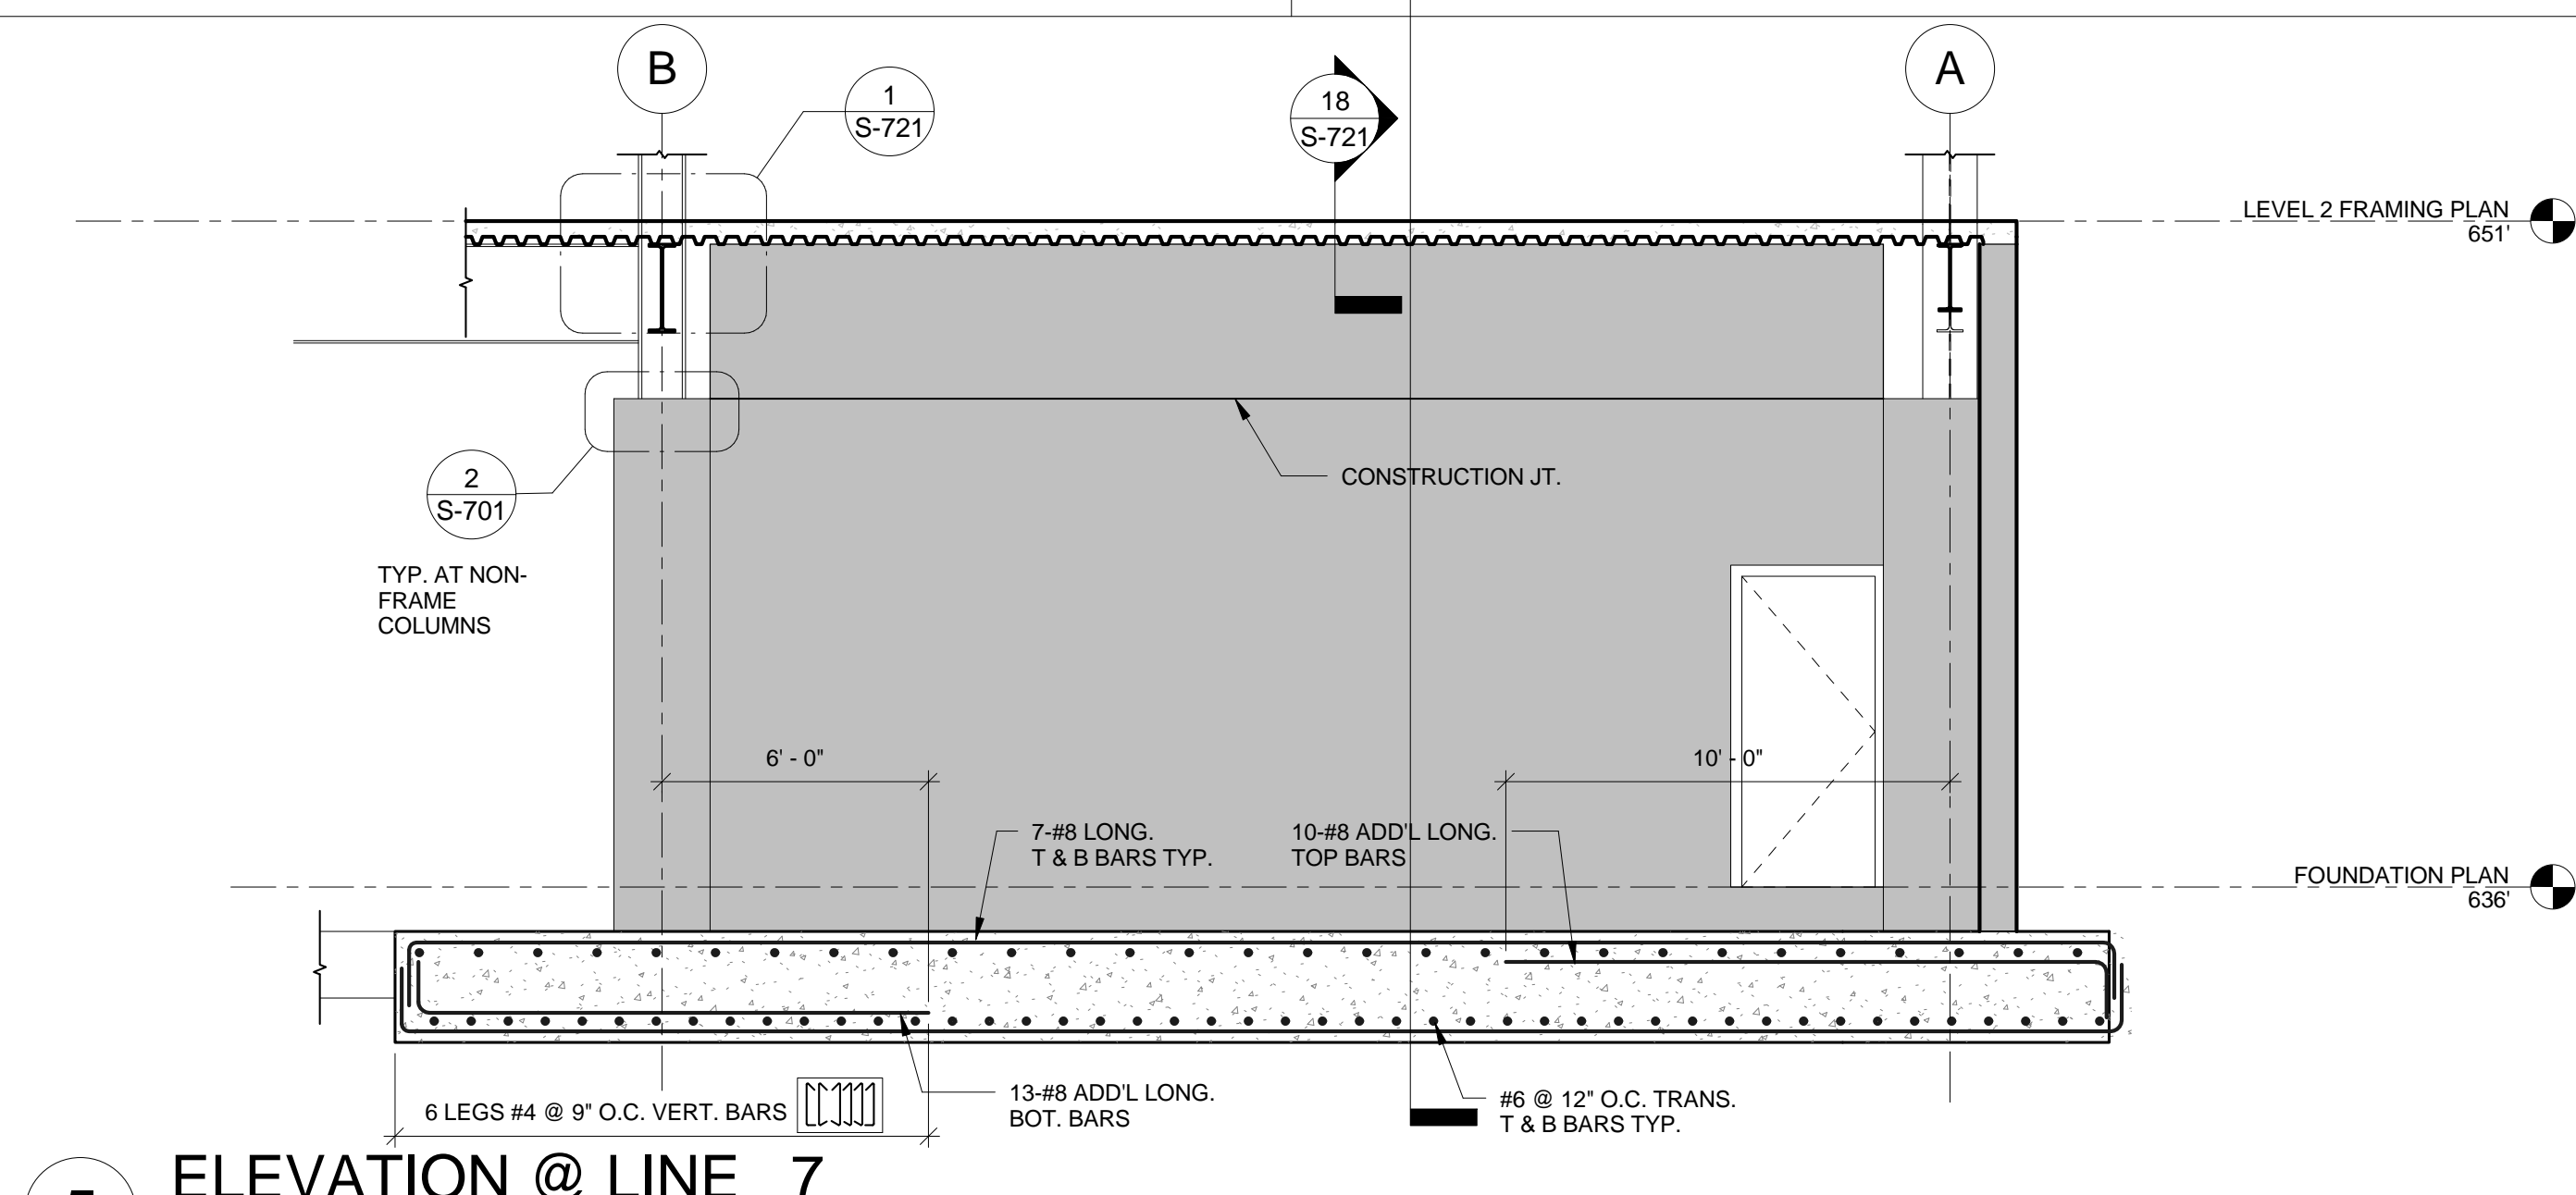


5 ELEVATION @ LINE 7  
SCALE: 1/4" = 1'-0"

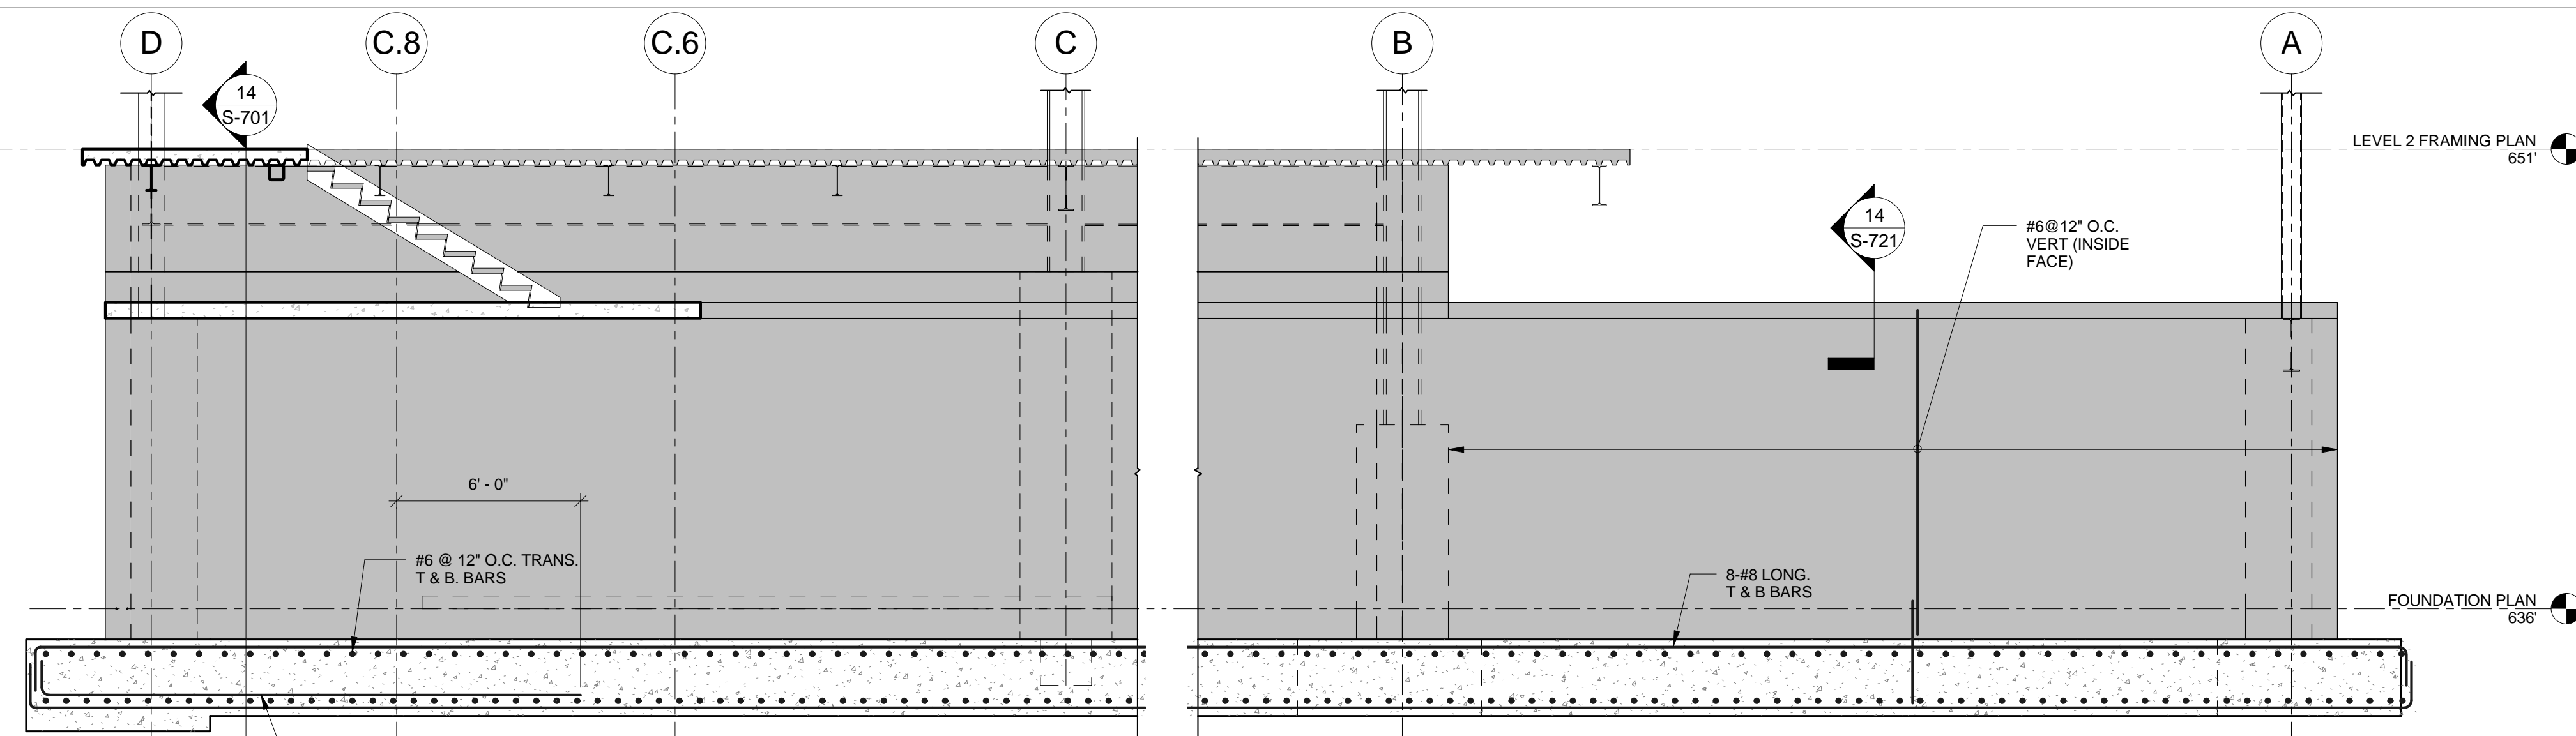

18 ELEVATION @ LINE 12  
SCALE: 1/4" = 1'-0"

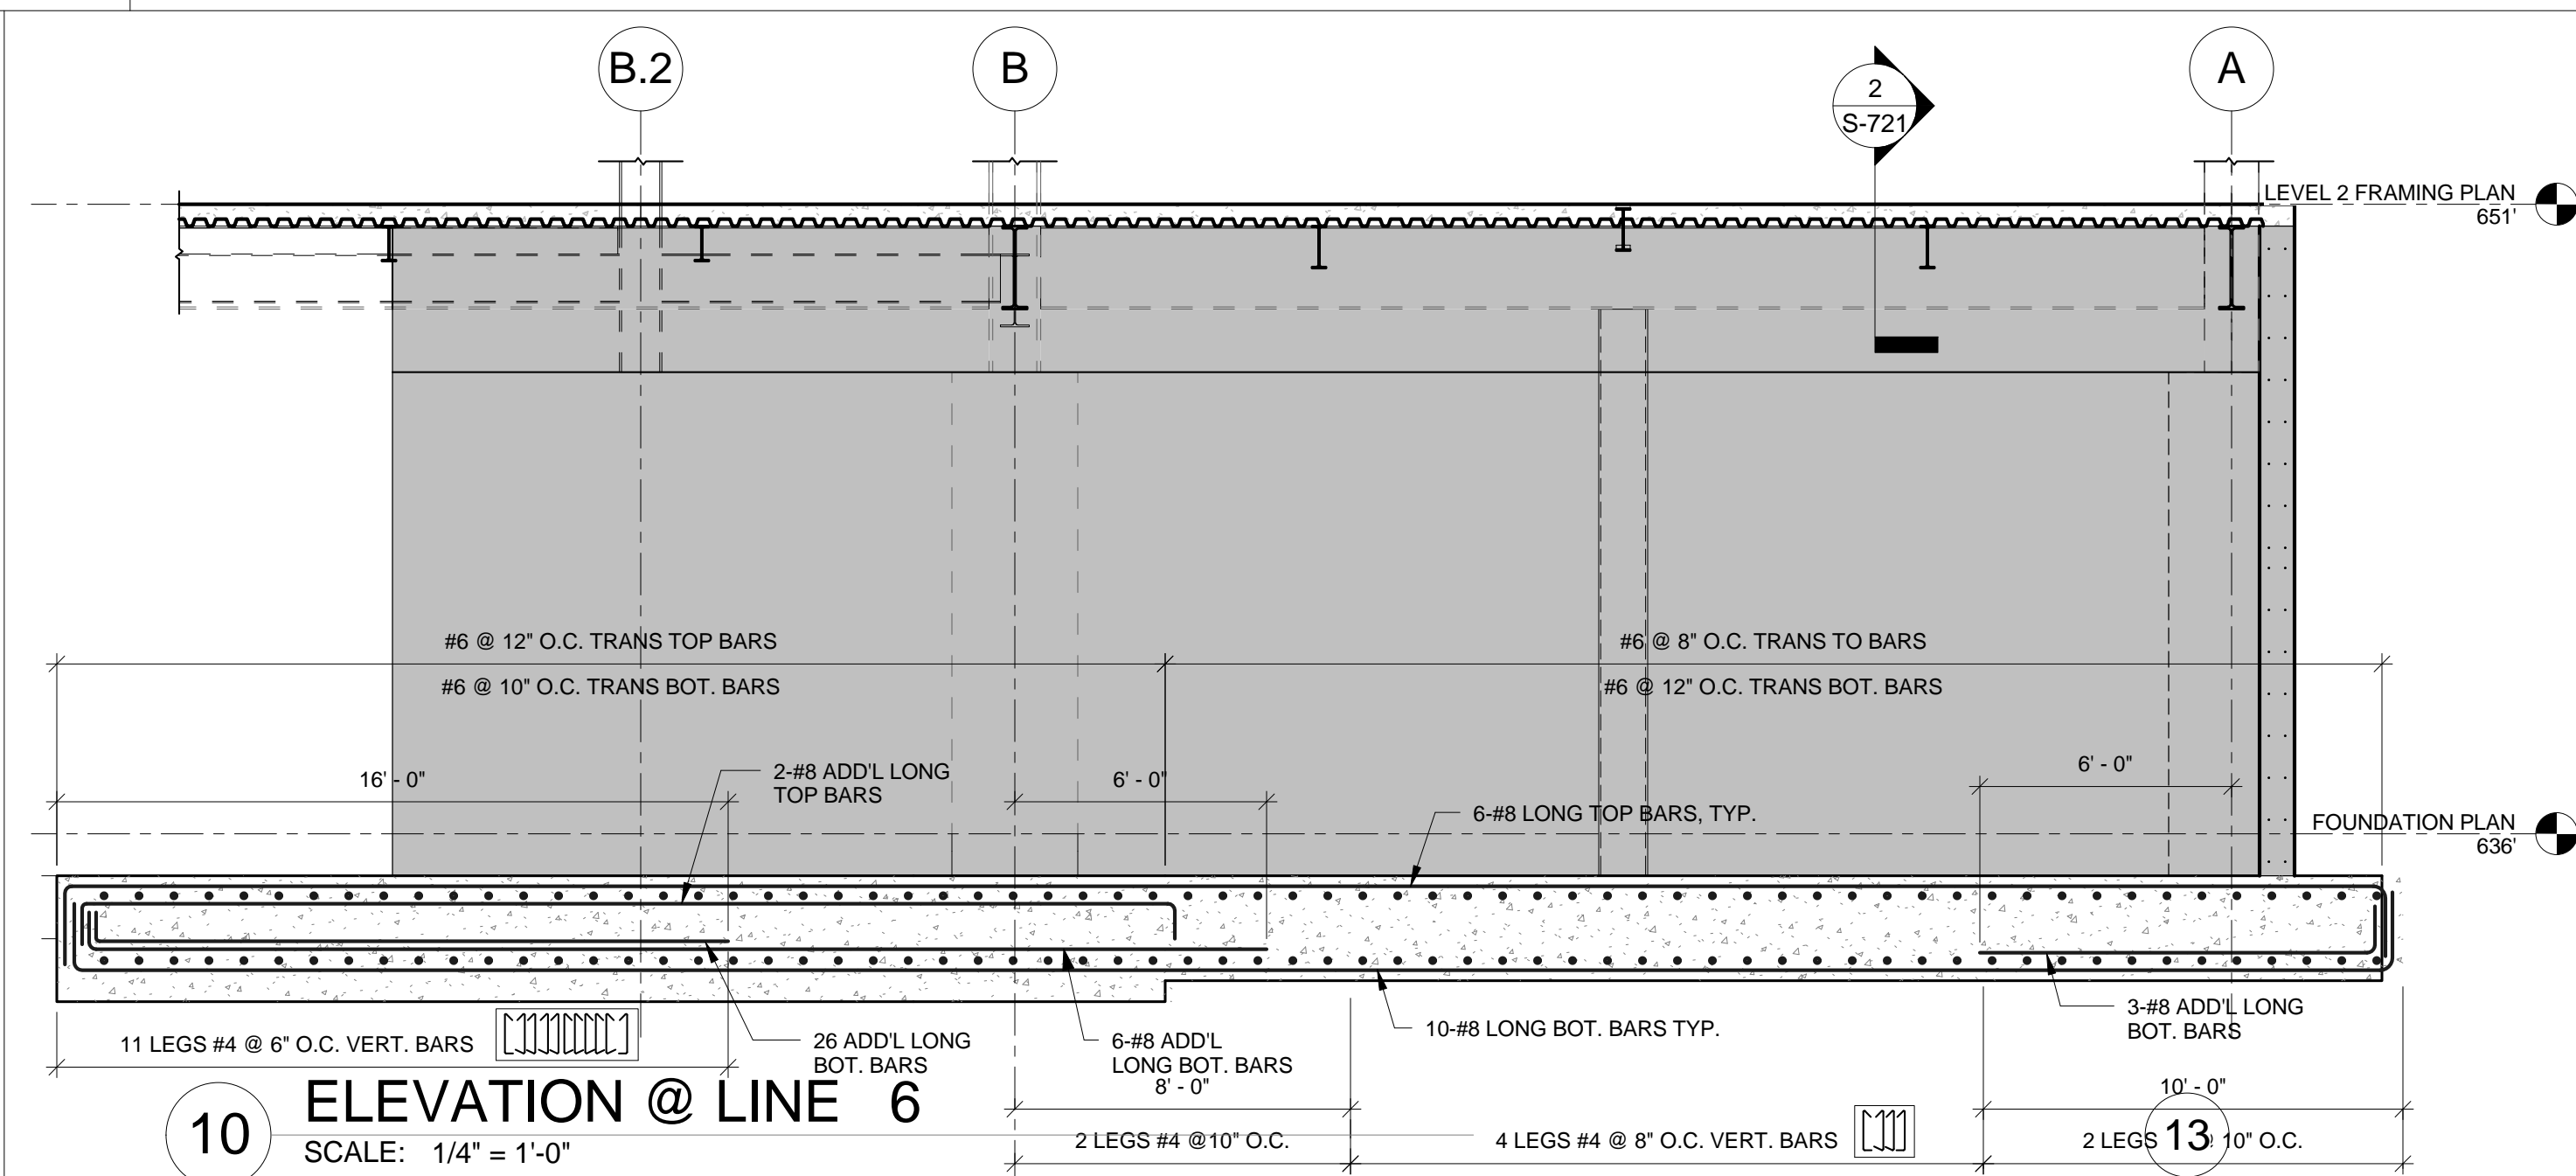


10 ELEVATION @ LINE 6  
SCALE: 1/4" = 1'-0"

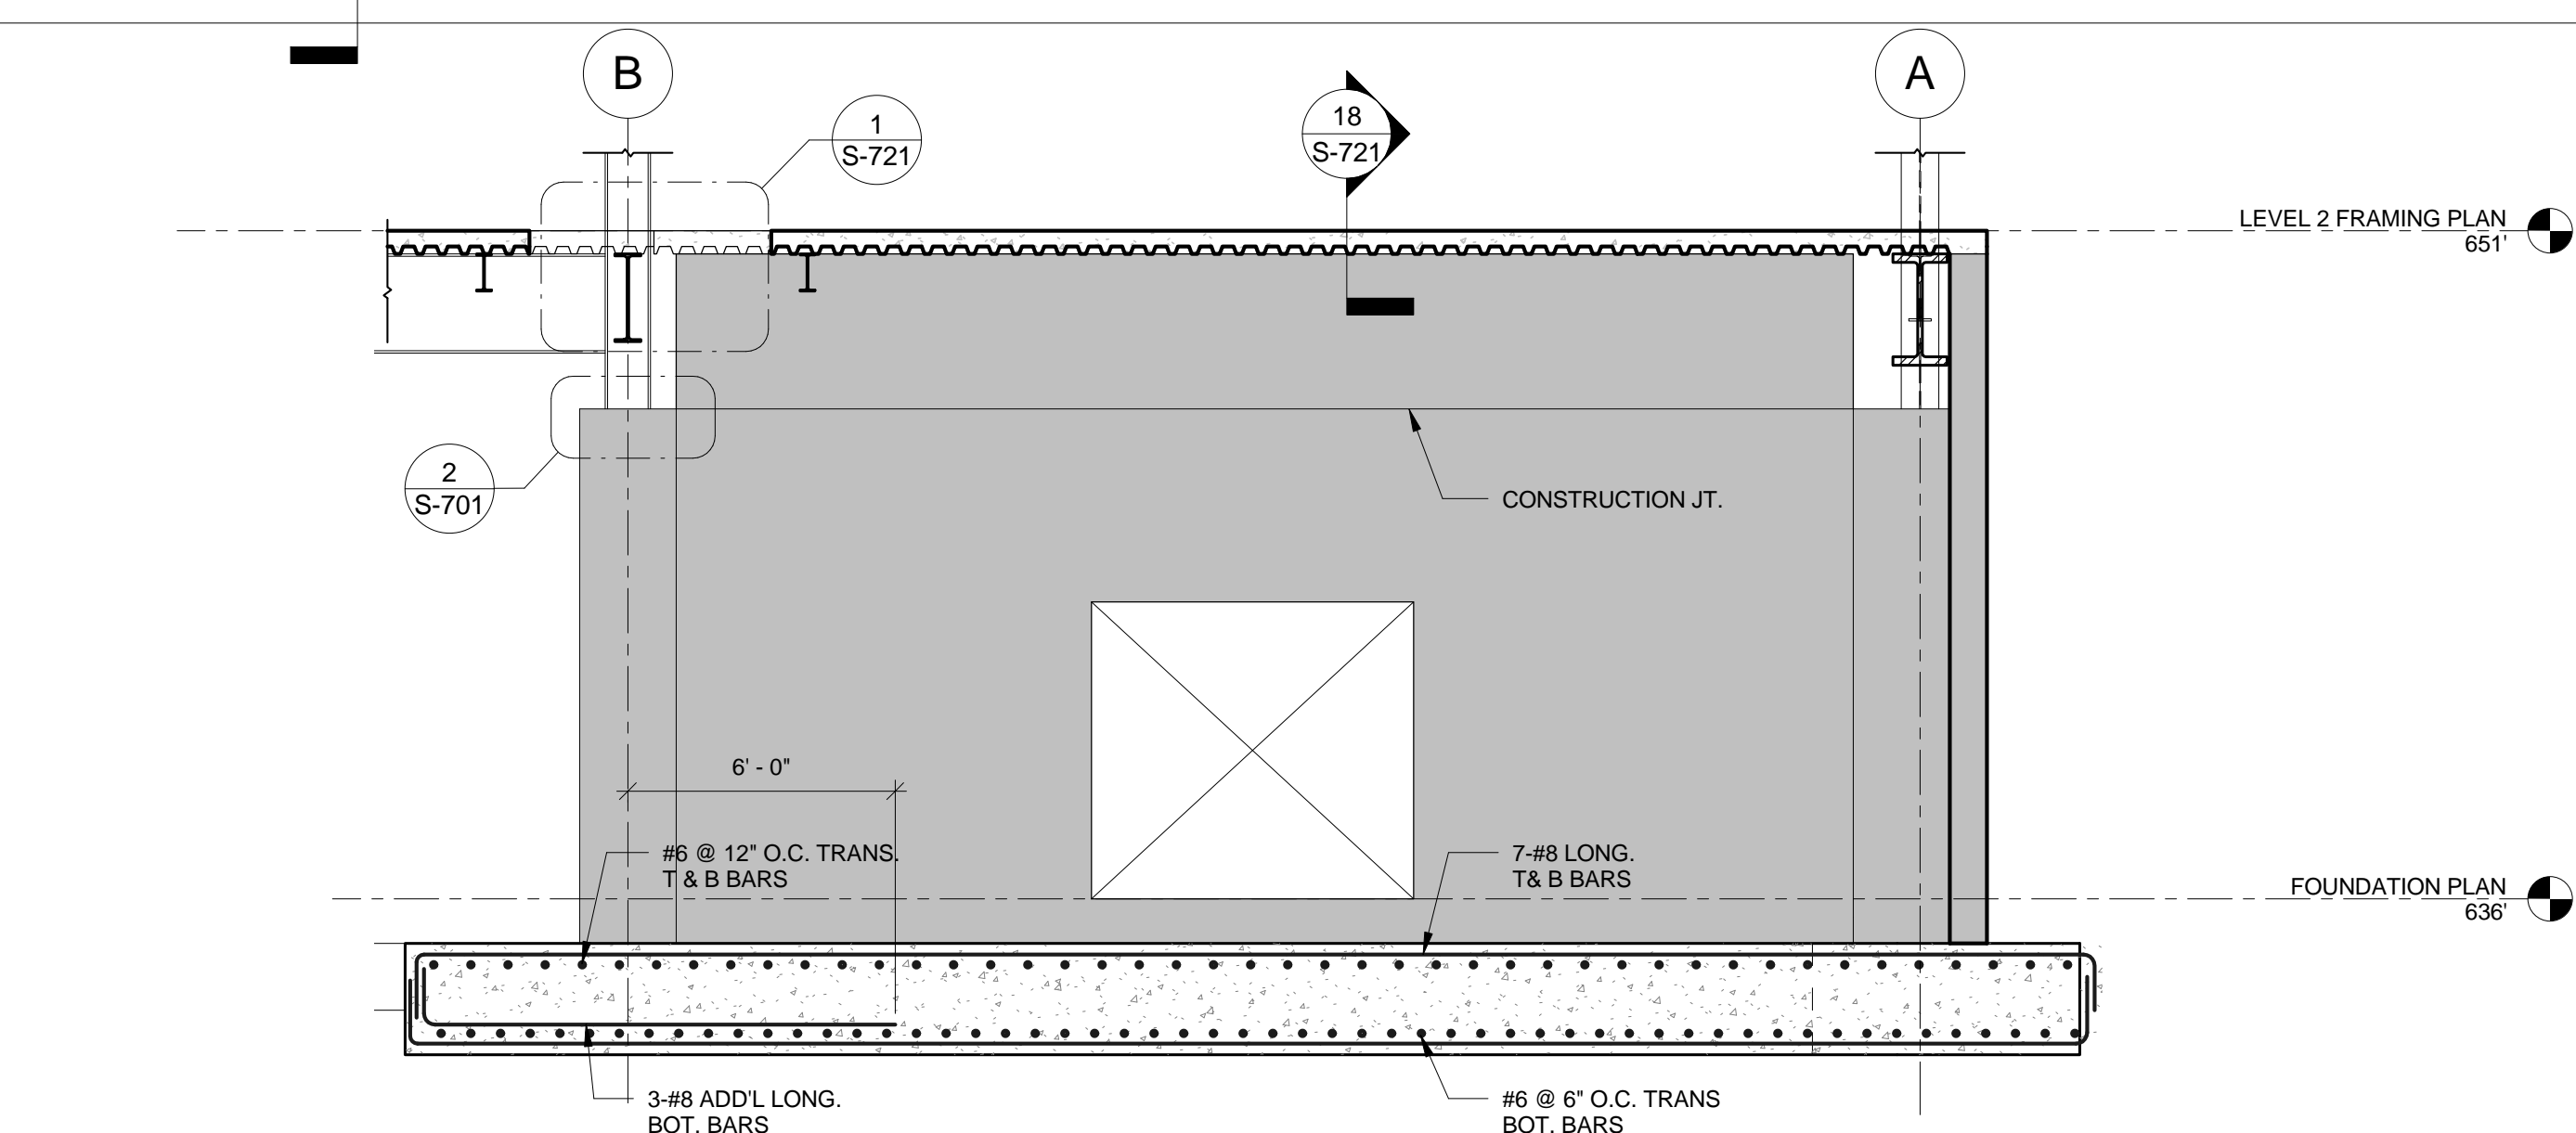


19 ELEVATION @ LINE 10  
SCALE: 1/4" = 1'-0"


- 15 TYPICAL CONCRETE WALL NOTES  
SCALE: 1/4" = 1'-0"
- SEE ARCHITECTURAL DRAWING & SPECIFICATIONS FOR CONCRETE FINISH.
  - ALL FORM TIES TO BE LEFT EXPOSED.
  - SEE S-108 FOR TYPICAL WALL REINFORCING AT OPENINGS & CONSTRUCTION JOINTS.
  - SEE S-601 FOR TYP. WALL REINFORCING.
  - S.A.D. FOR EXTERIOR DRAINAGE SYSTEM.
  - SEE CIVIL DRAWINGS FOR DRAINAGE TIE TO MAIN SYSTEM.

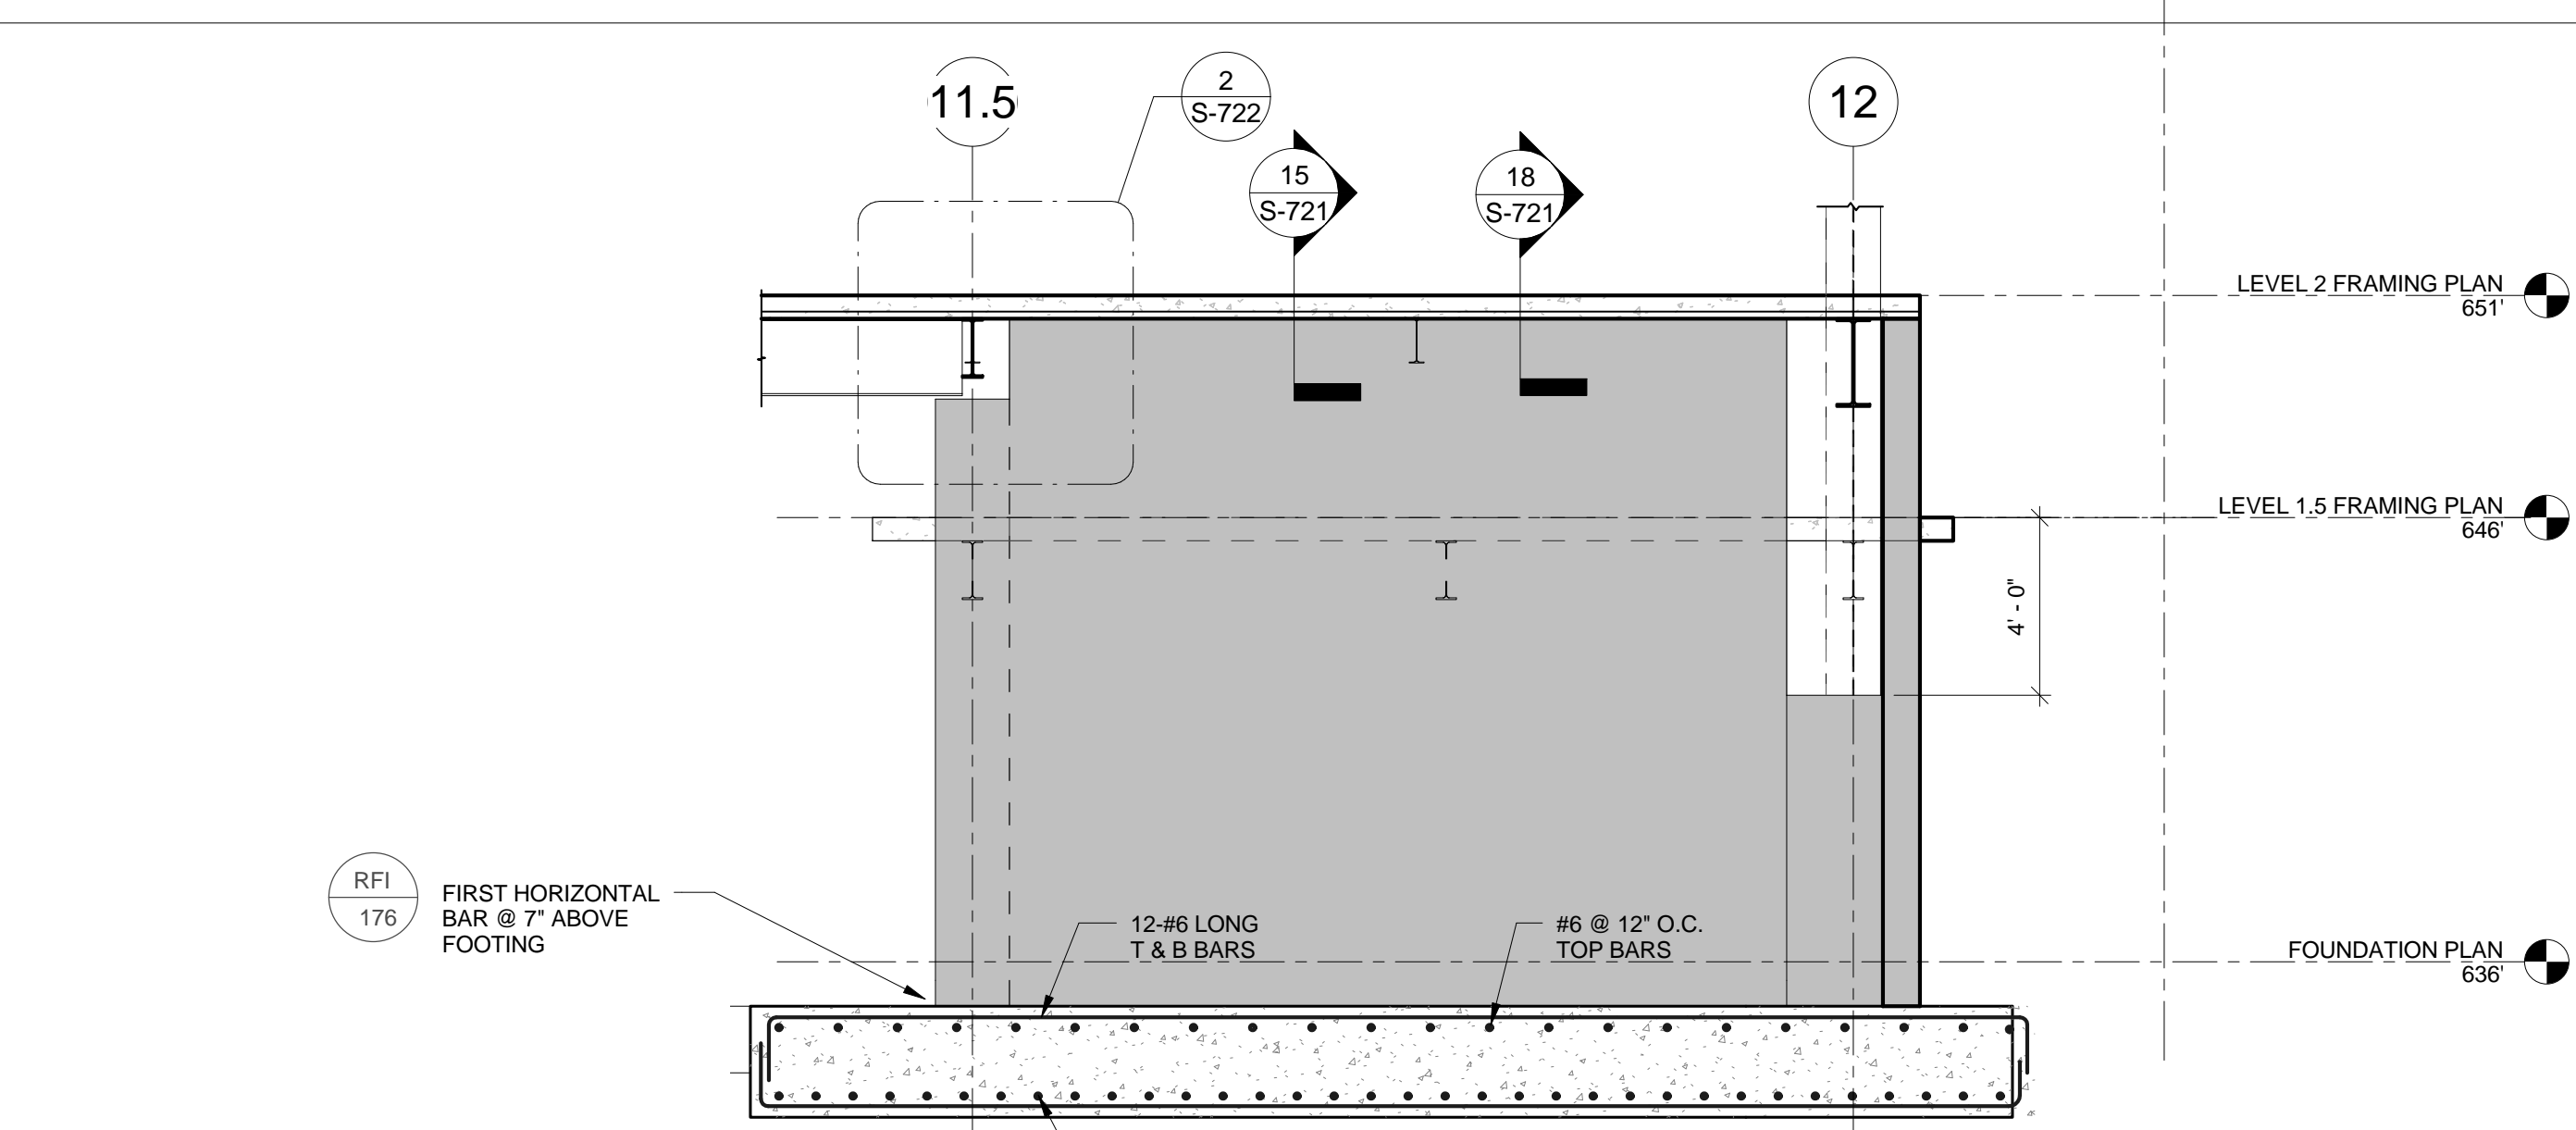

11 ELEVATION @ LINE B  
SCALE: 1/4" = 1'-0"

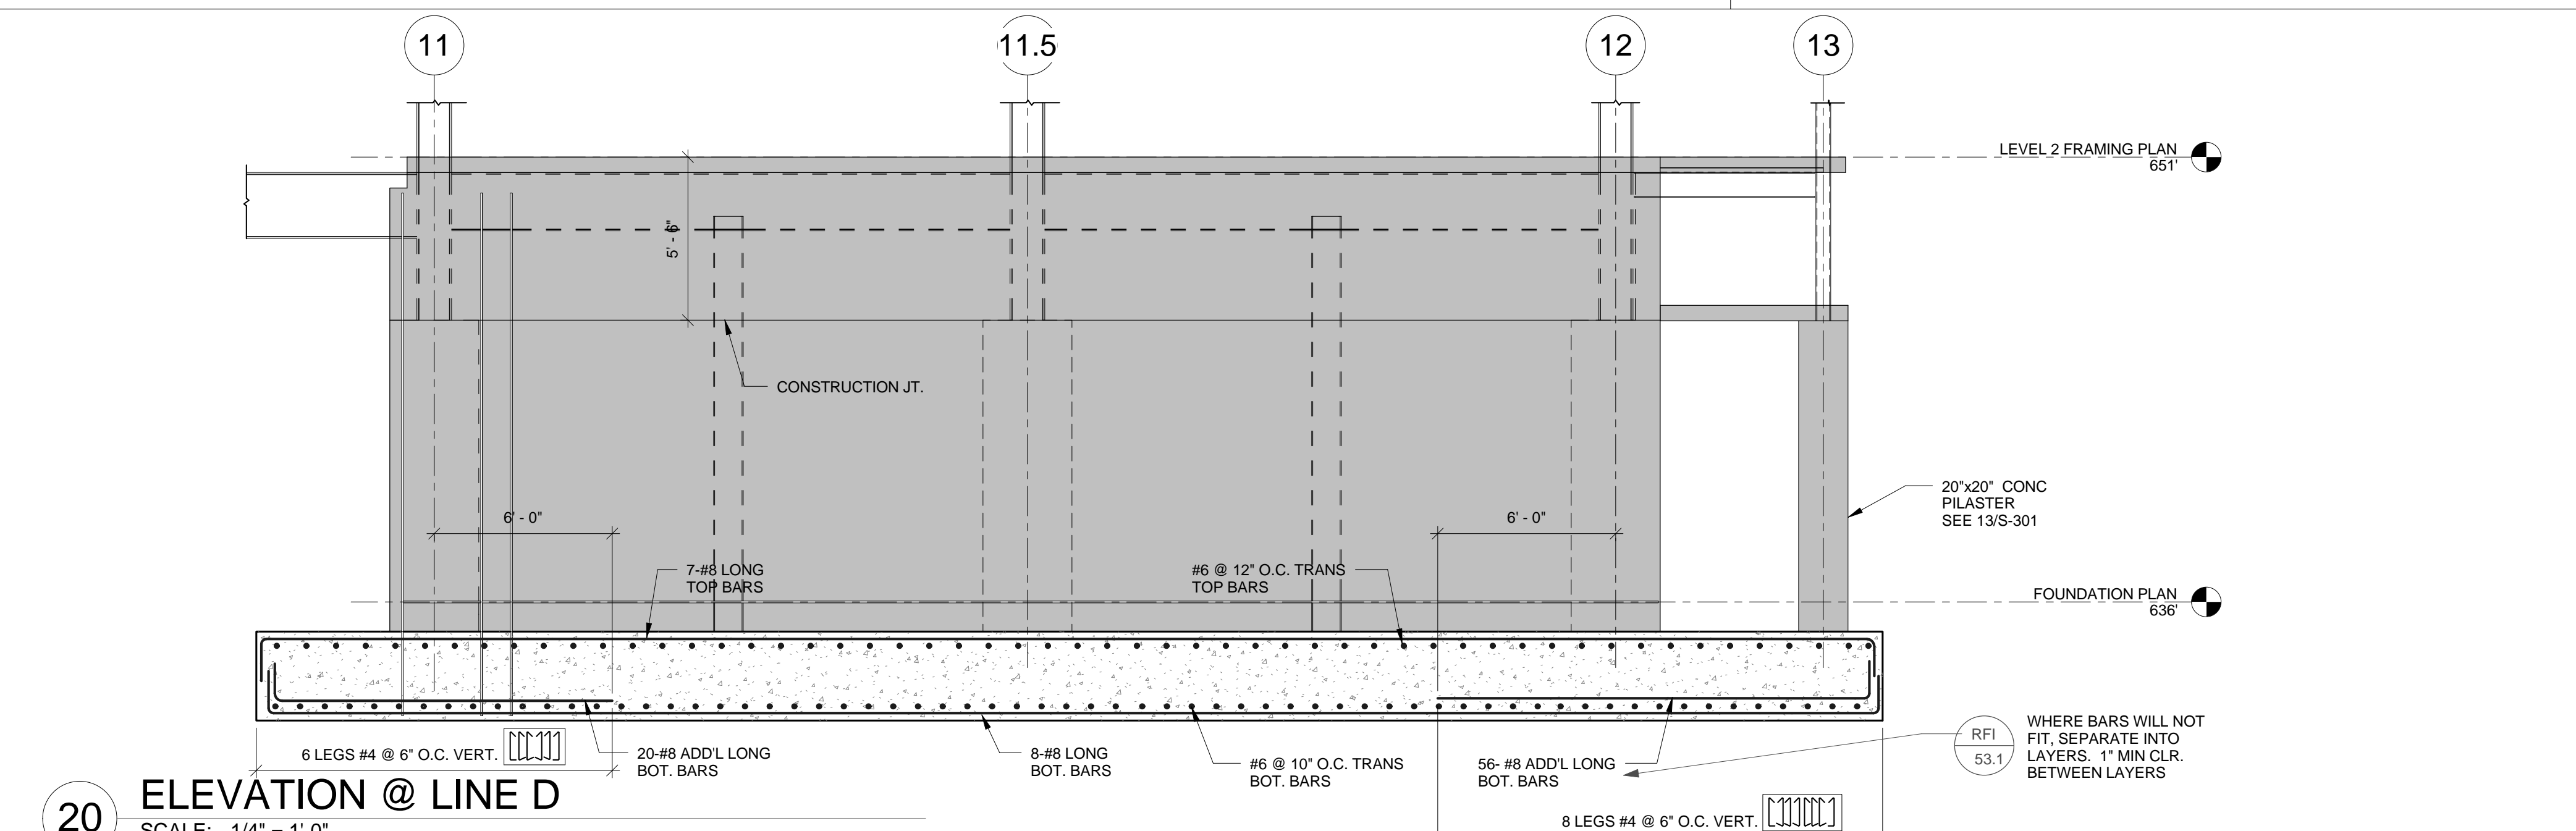

20 ELEVATION @ LINE D  
SCALE: 1/4" = 1'-0"

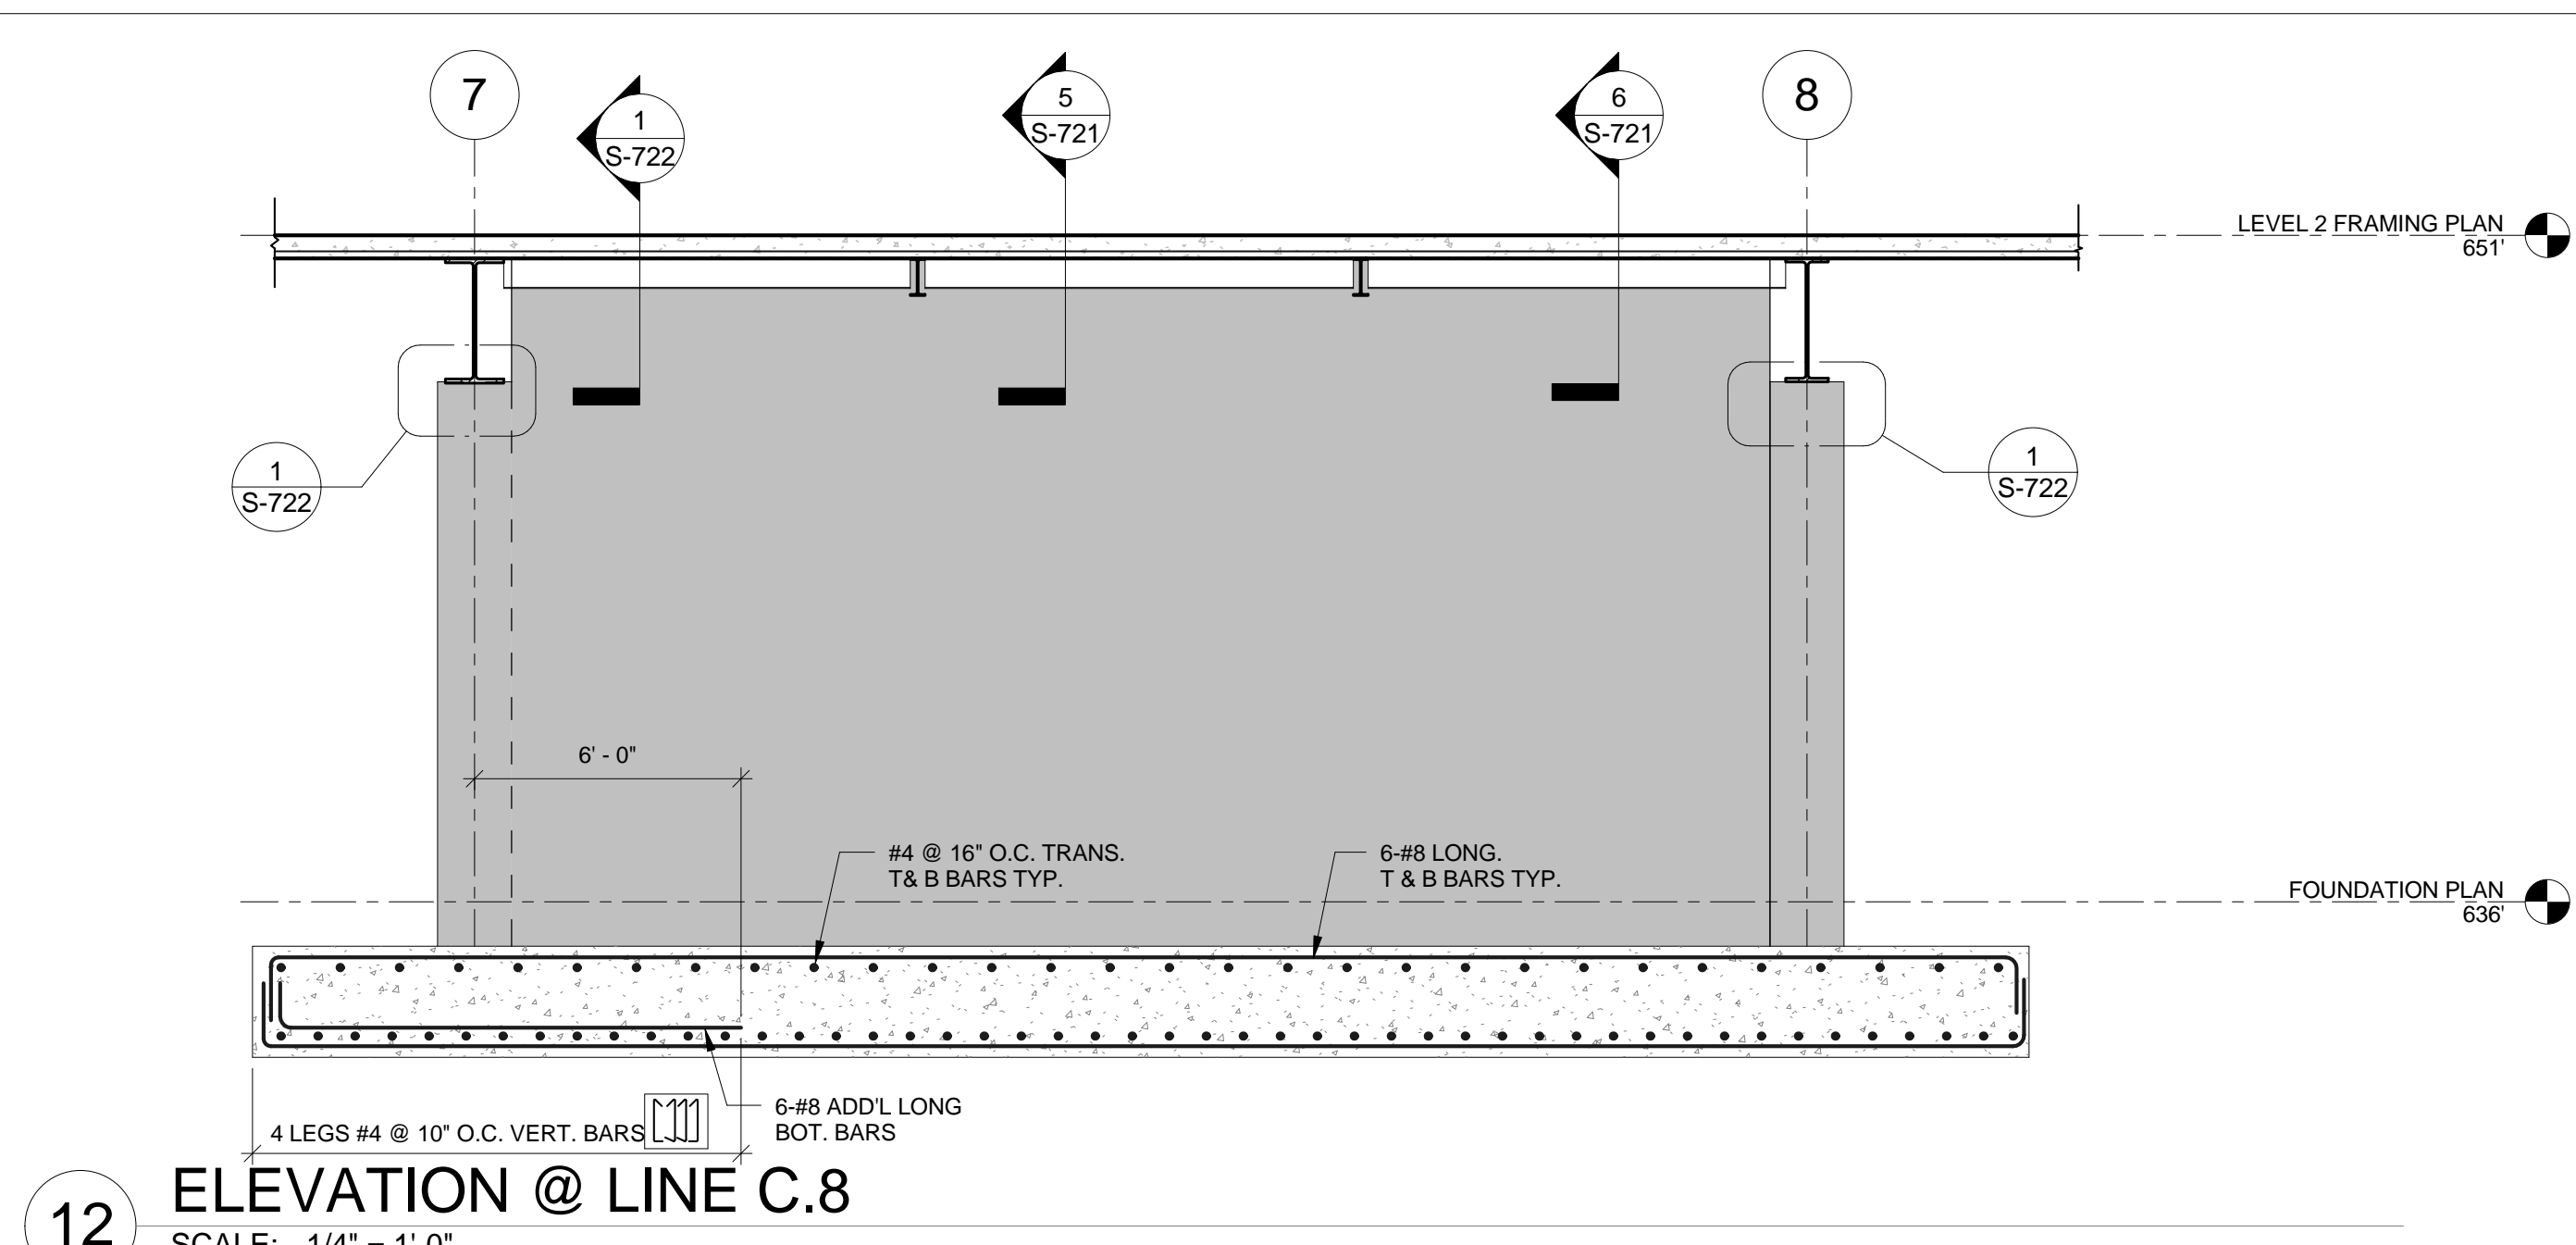

12 ELEVATION @ LINE C.8  
SCALE: 1/4" = 1'-0"

PROJECT RECORD SET

SKYLINE COLLEGE  
SAN MATEO COUNTY  
COMMUNITY COLLEGE  
DISTRICT





CIP2 DESIGN-BUILD  
PROJECT  
BUILDING 4

PROJECT NO: 07055.00 DRAWN BY: AY  
DATE: 07/18/08 CHECKED BY: CB  
SCALE: 1/4" = 1'-0"


SHEET TITLE:  
CONCRETE WALL  
ELEVATIONS

SHEET NO. S-401

All drawings and written material appearing herein constitute original and unpublished work of the Architect/Engineer and may not be duplicated, used or disclosed without consent of Architect/Engineer. If this drawing is not 30"x42", then the drawing has been revised from its original size. Note: scales must be adjusted. This line should be equal to one inch.

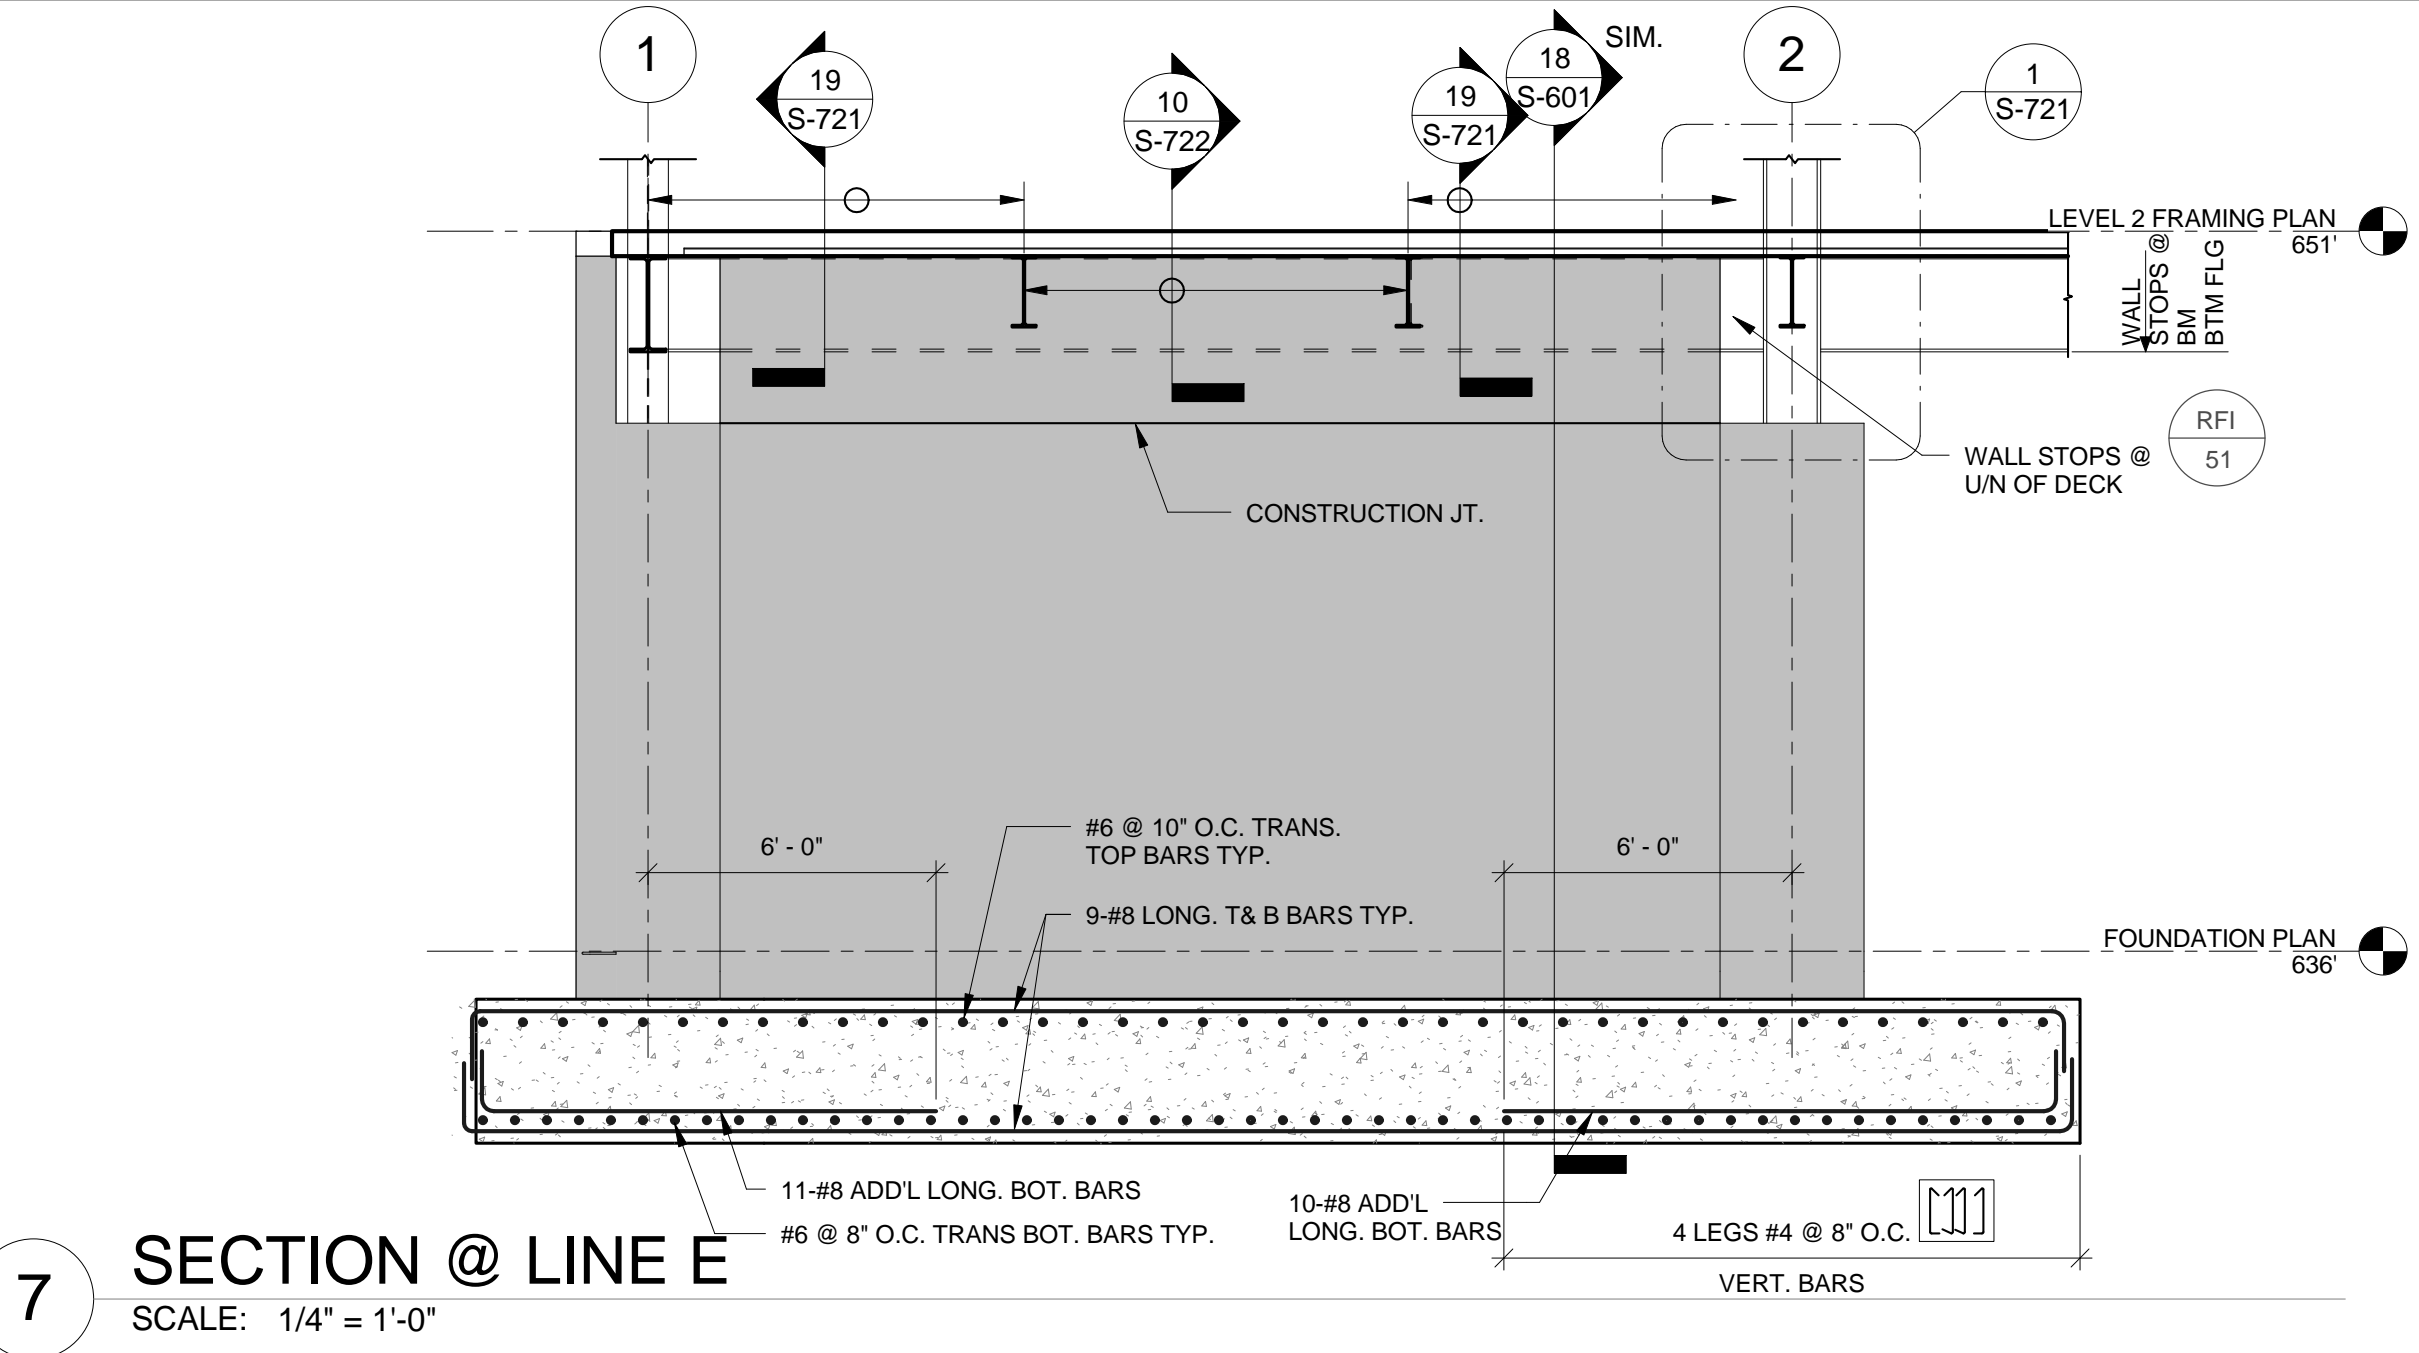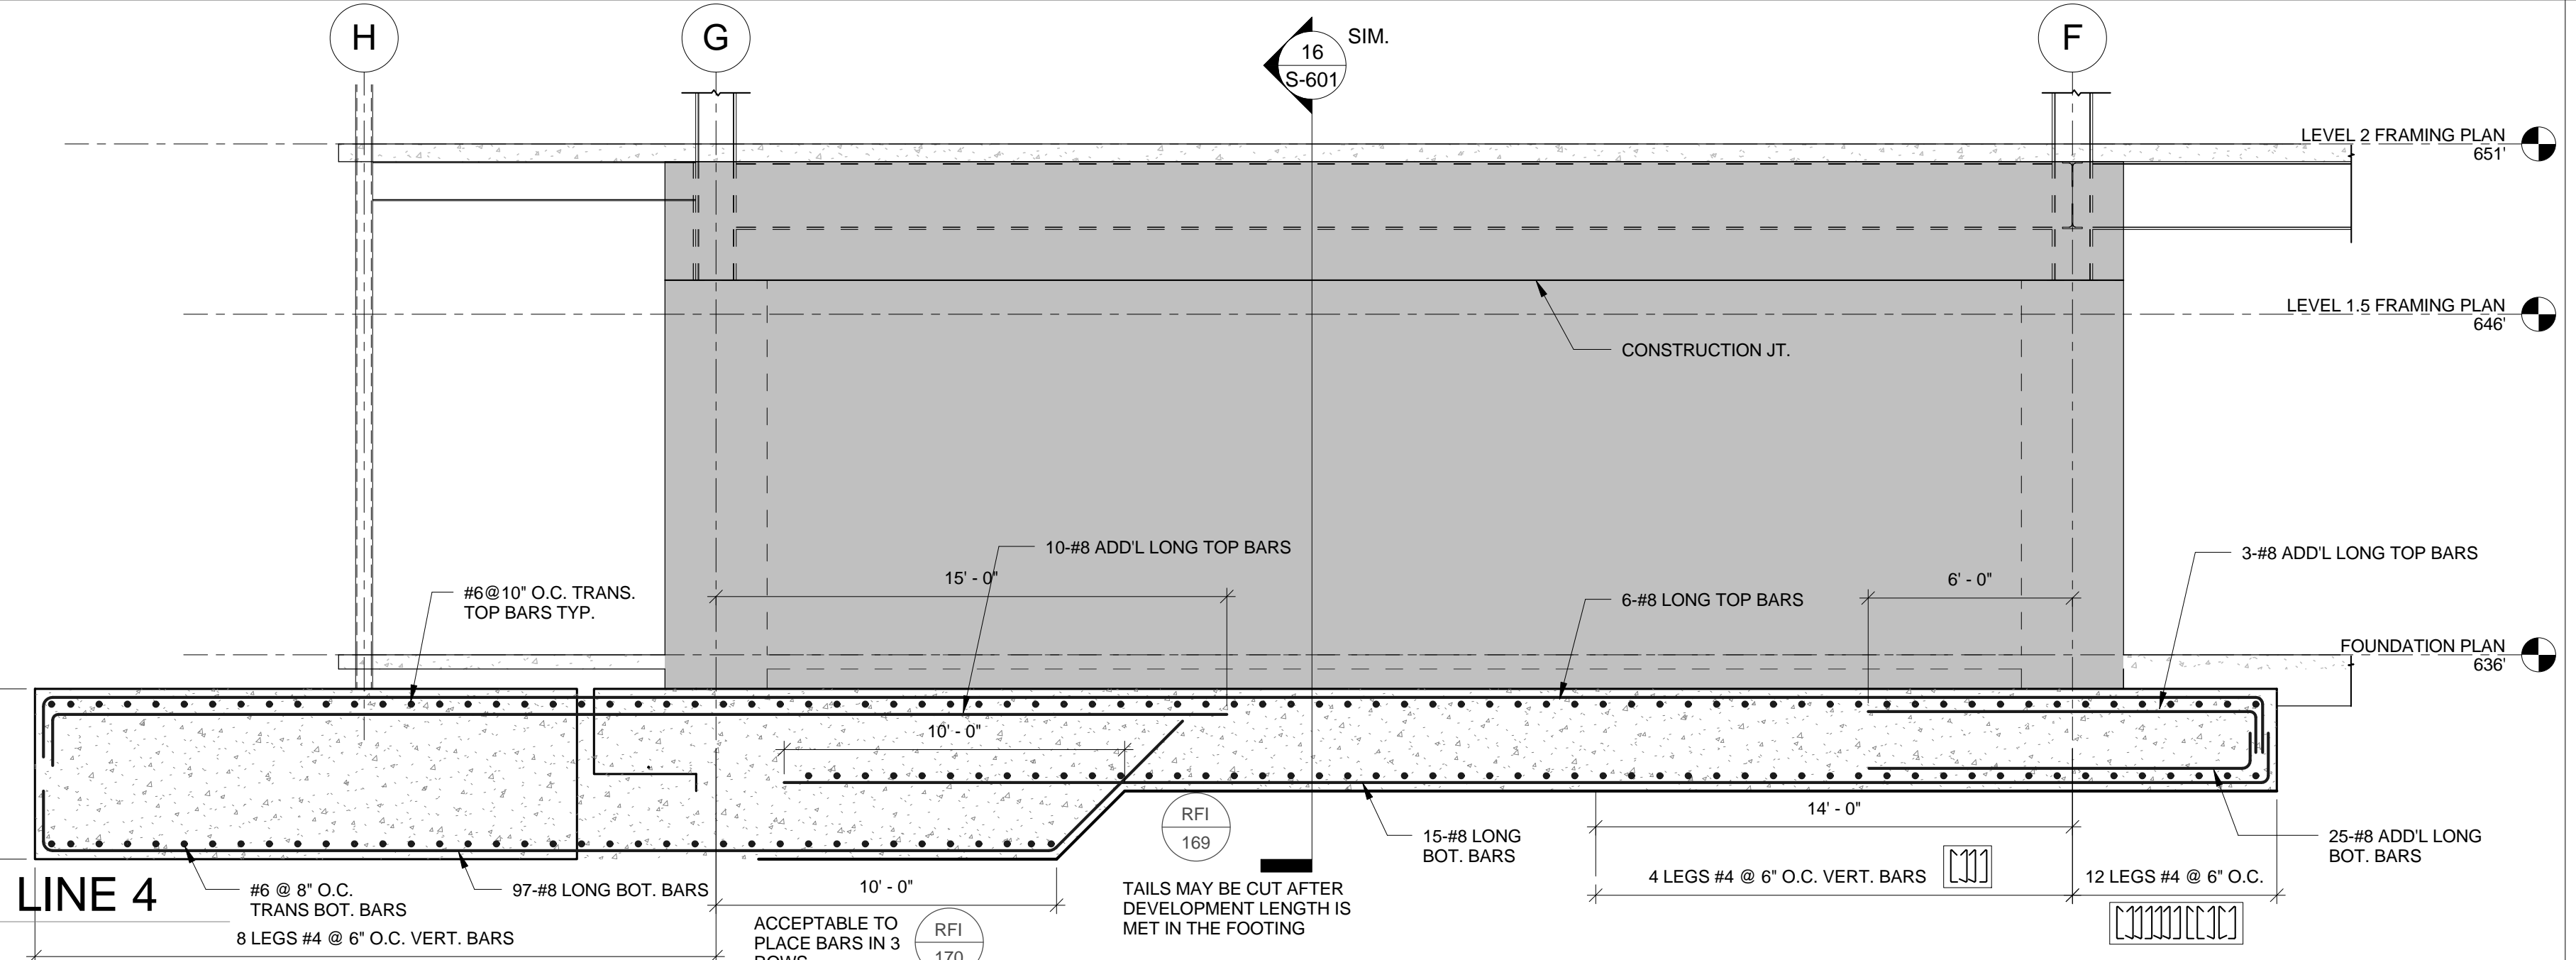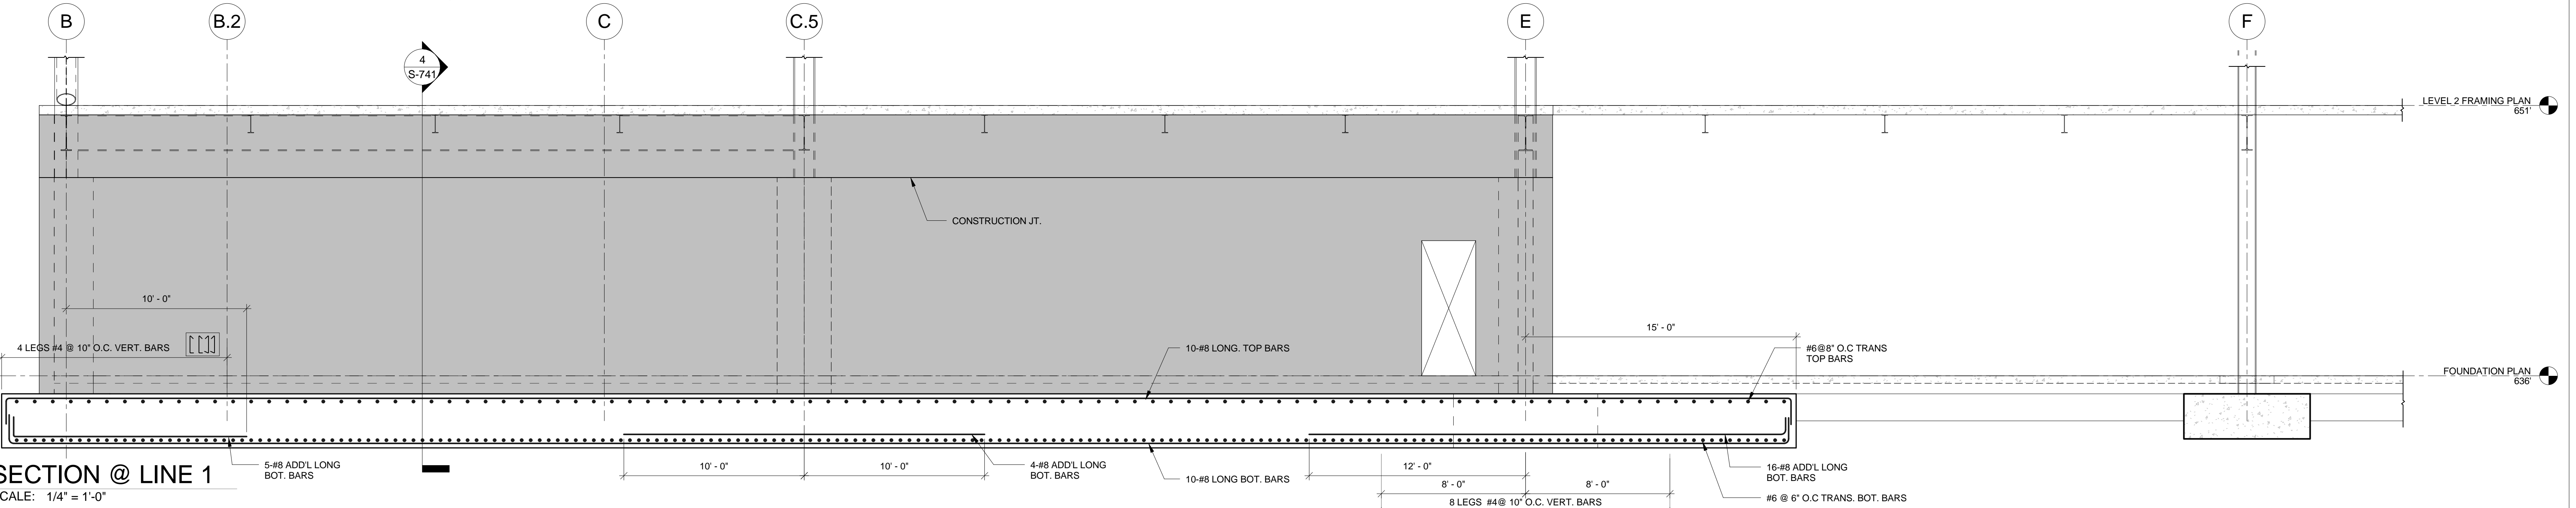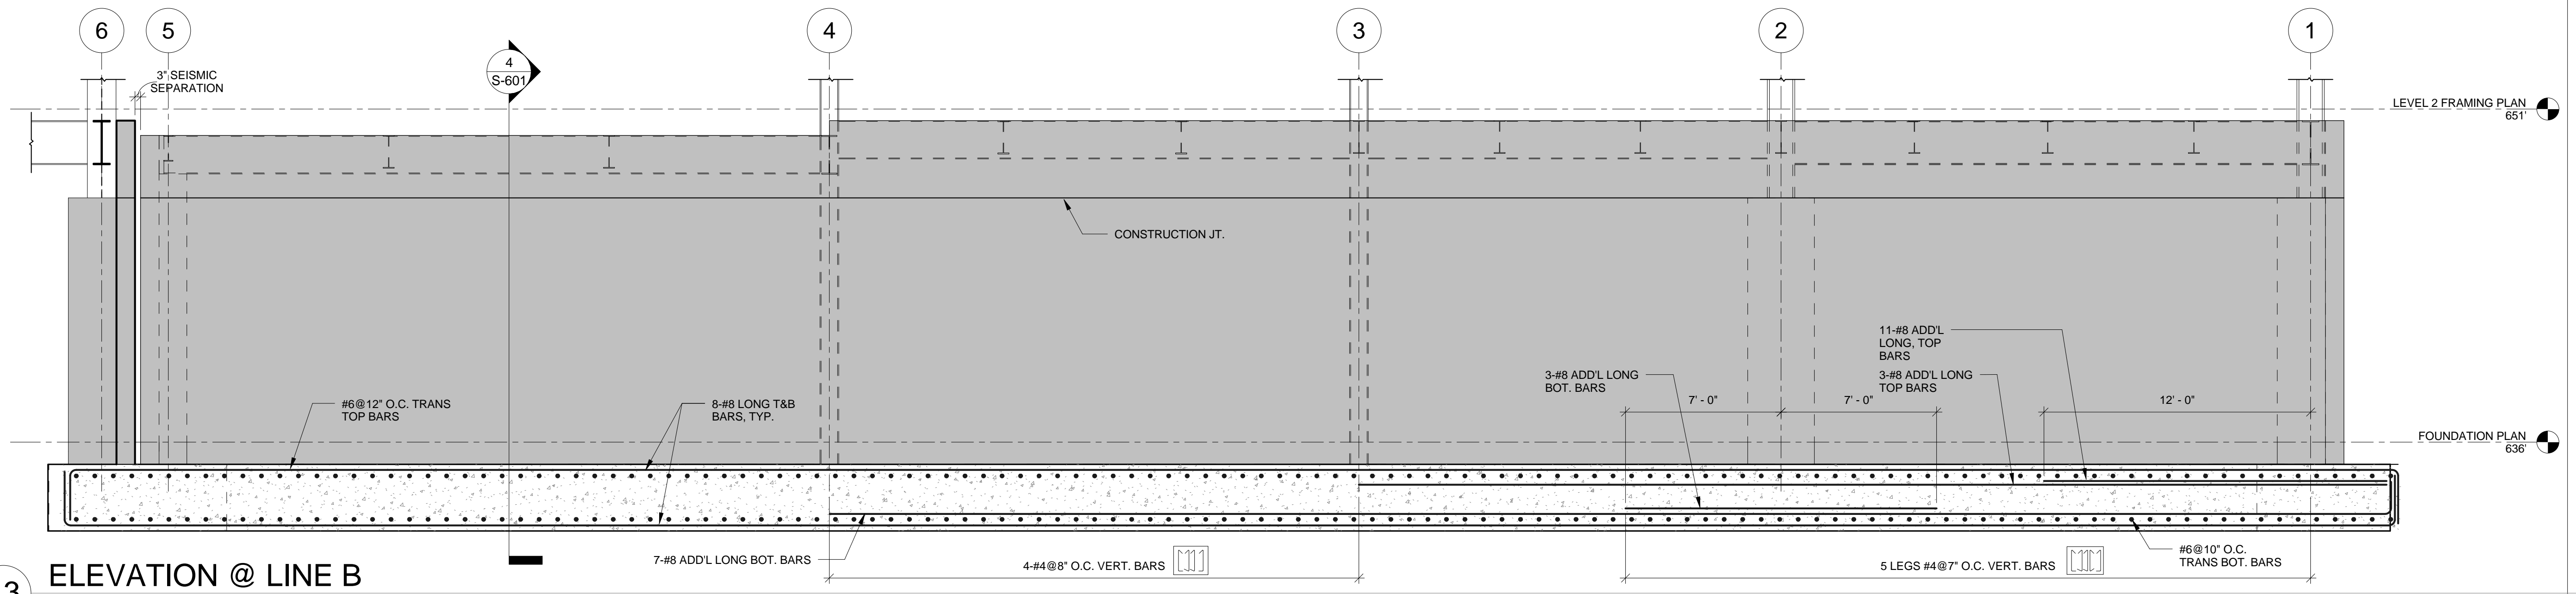

- 16 TYPICAL CONCRETE WALL NOTES  
SCALE: 1/4" = 1'-0"
1. SEE ARCHITECTURAL DRAWING & SPECIFICATIONS FOR CONCRETE FINISH.
  2. ALL FORM TIES TO BE LEFT EXPOSED.
  3. SEE S-108 FOR TYPICAL WALL REINFORCING AT OPENINGS & CONSTRUCTION JOINTS.
  4. SEE S-601 FOR TYP. WALL REINFORCING.
  5. S.A.D. FOR EXTERIOR DRAINAGE SYSTEM.
  6. SEE CIVIL DRAWINGS FOR DRAINAGE TIE TO MAIN SYSTEM.

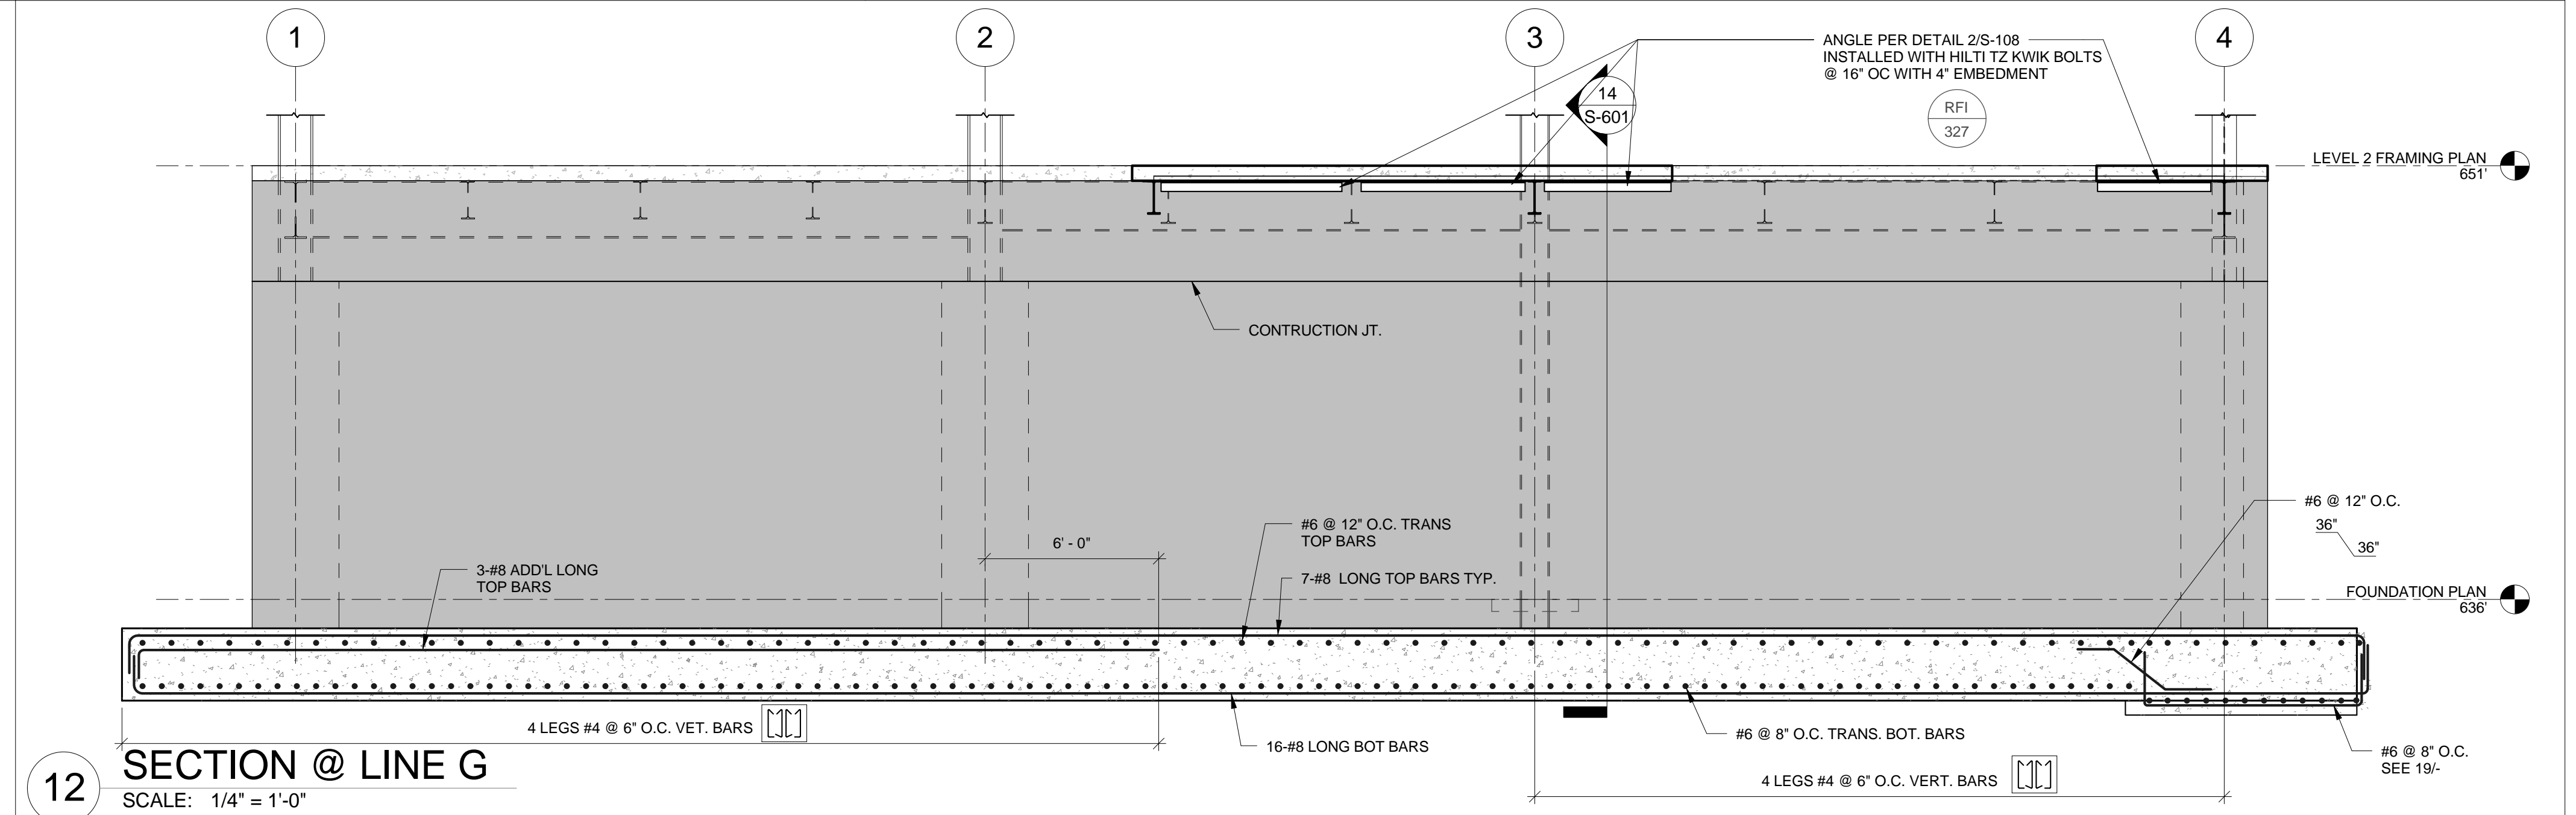

NO. ISSUES/REVISIONS DATE


PROJECT RECORD SET

SKYLINE COLLEGE  
SAN MATEO COUNTY  
COMMUNITY COLLEGE  
DISTRICT  
CIP2 DESIGN-BUILD  
PROJECT  
BUILDING 4


PROJECT NO.: 07055.00 DRAWN BY: AY  
DATE: 05.15.2009 CHECKED BY: CB  
SCALE: 1/4" = 1'-0"

SHEET TITLE:  
CONCRETE WALL ELEVATIONS


SHEET NO. S-402

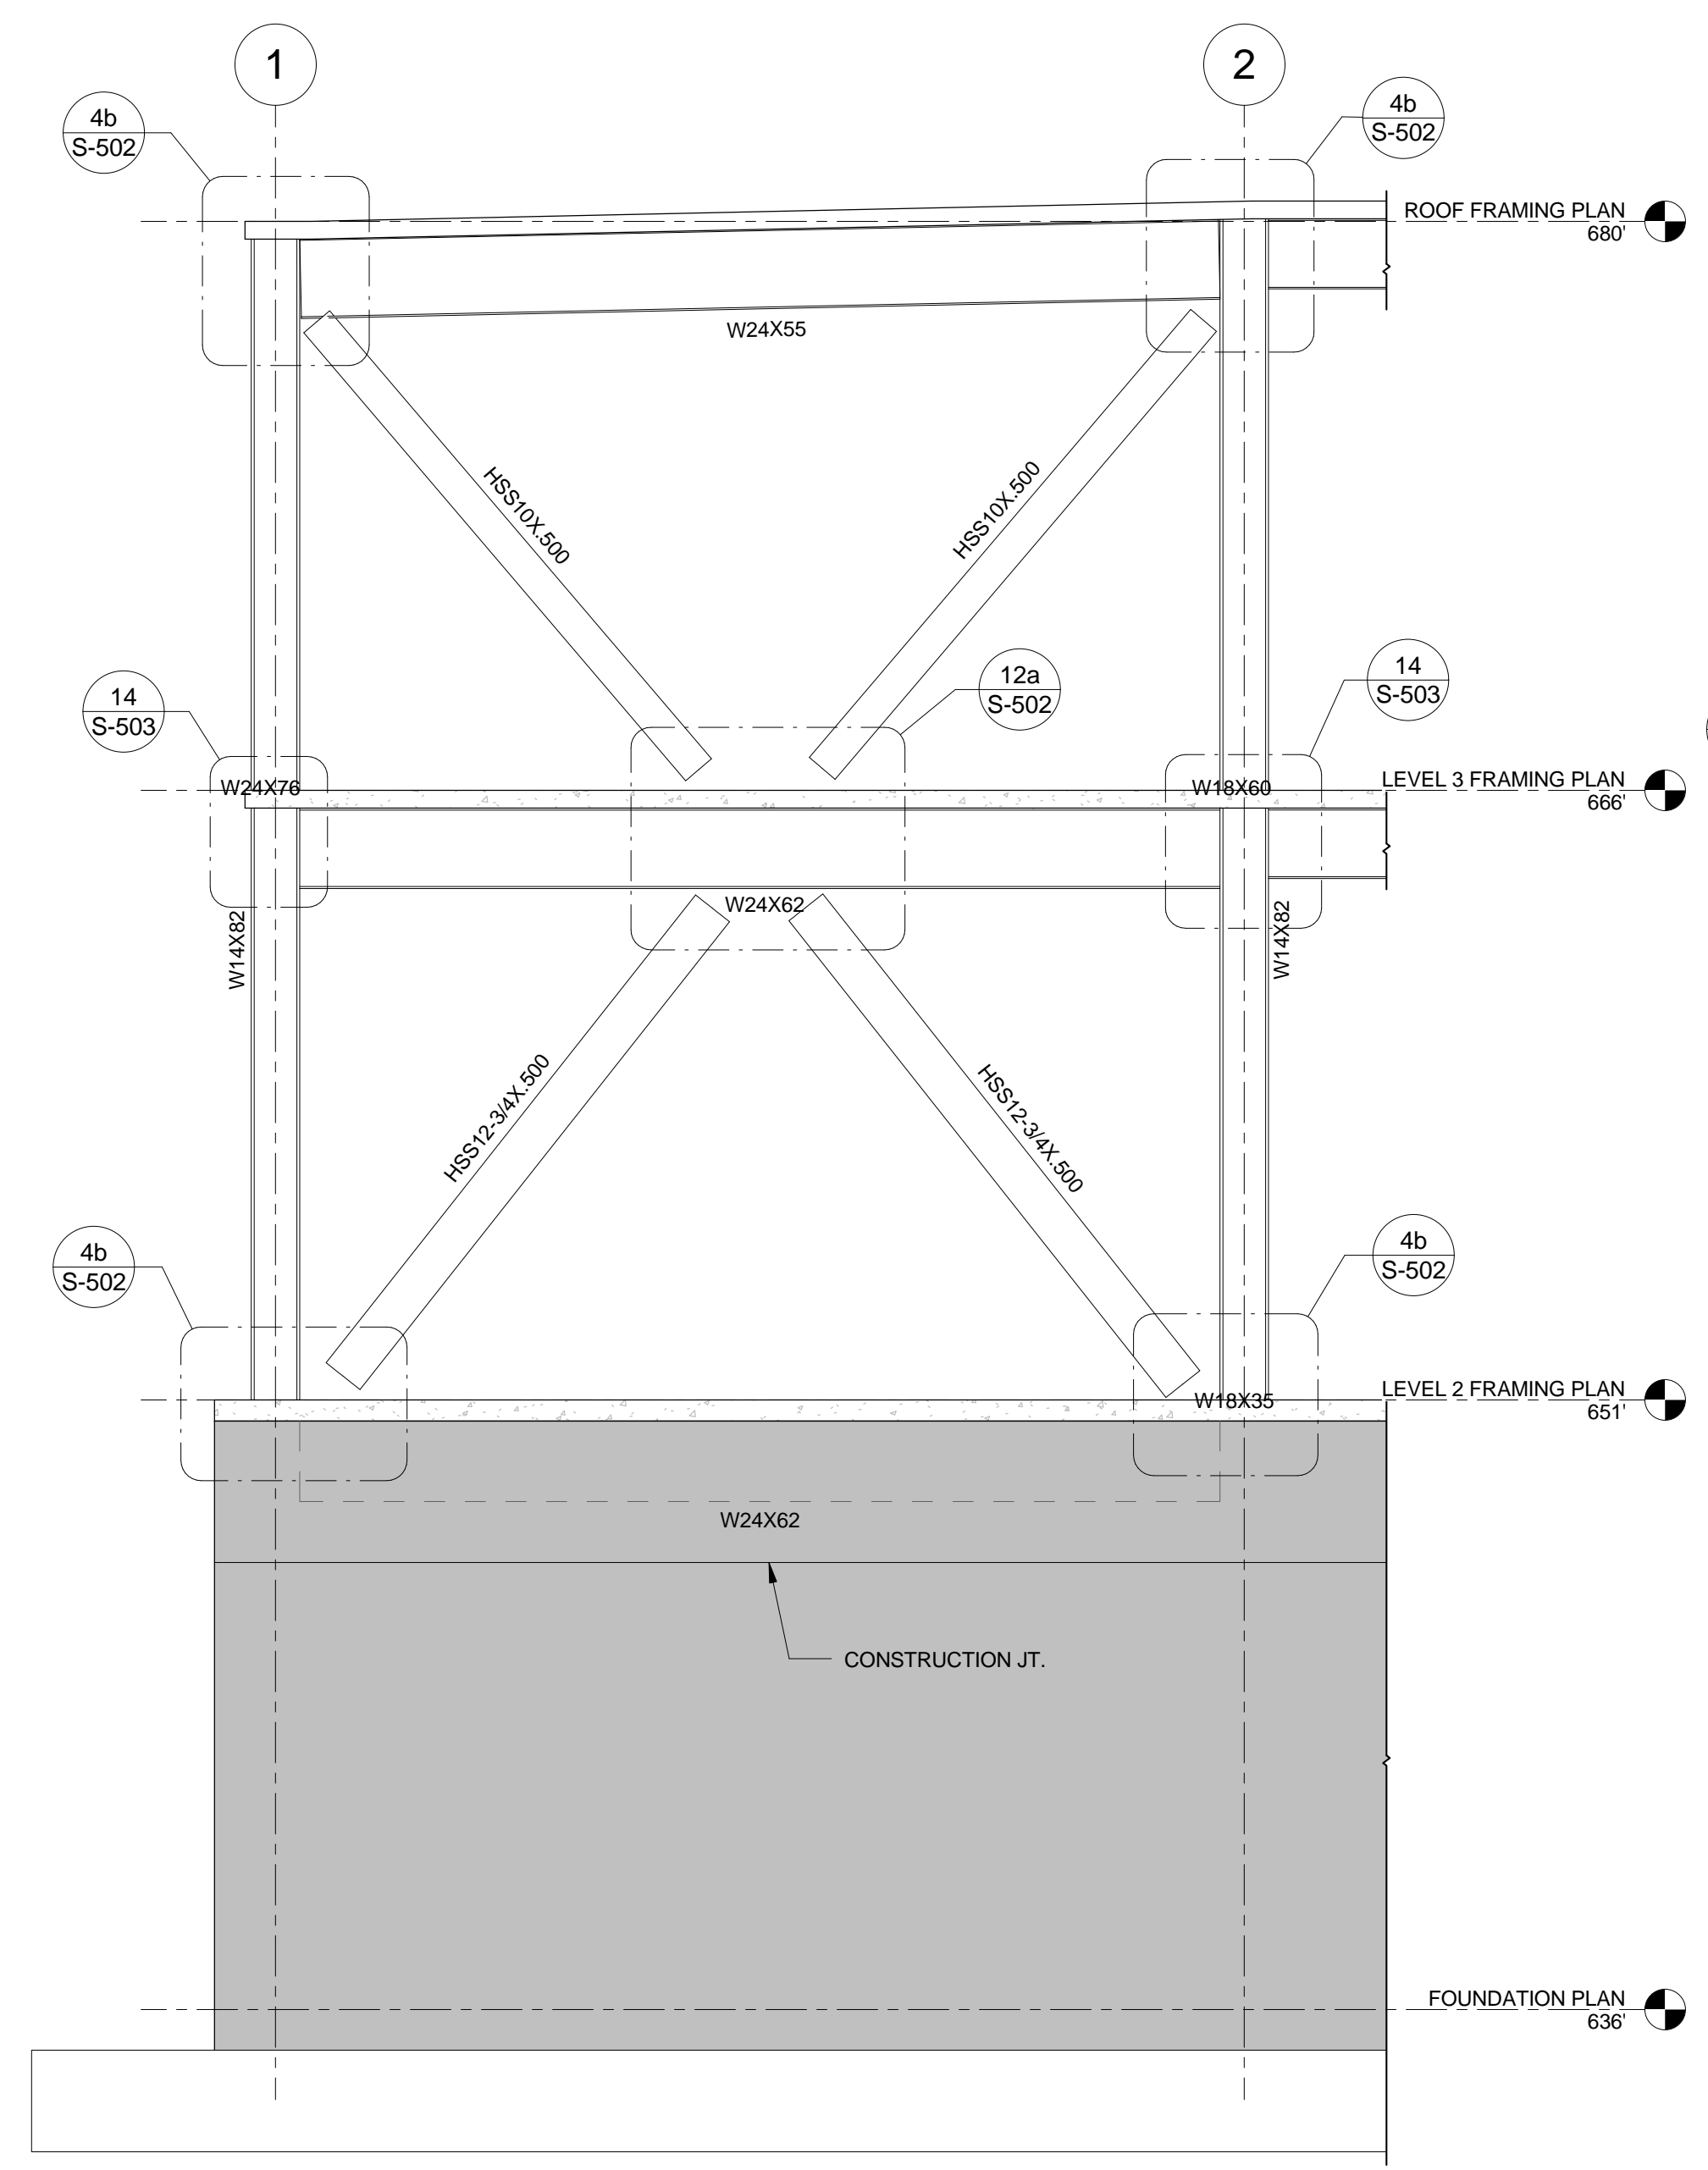


**5 ELEVATION (LINE G)**  
SCALE: 1/4" = 1'-0"

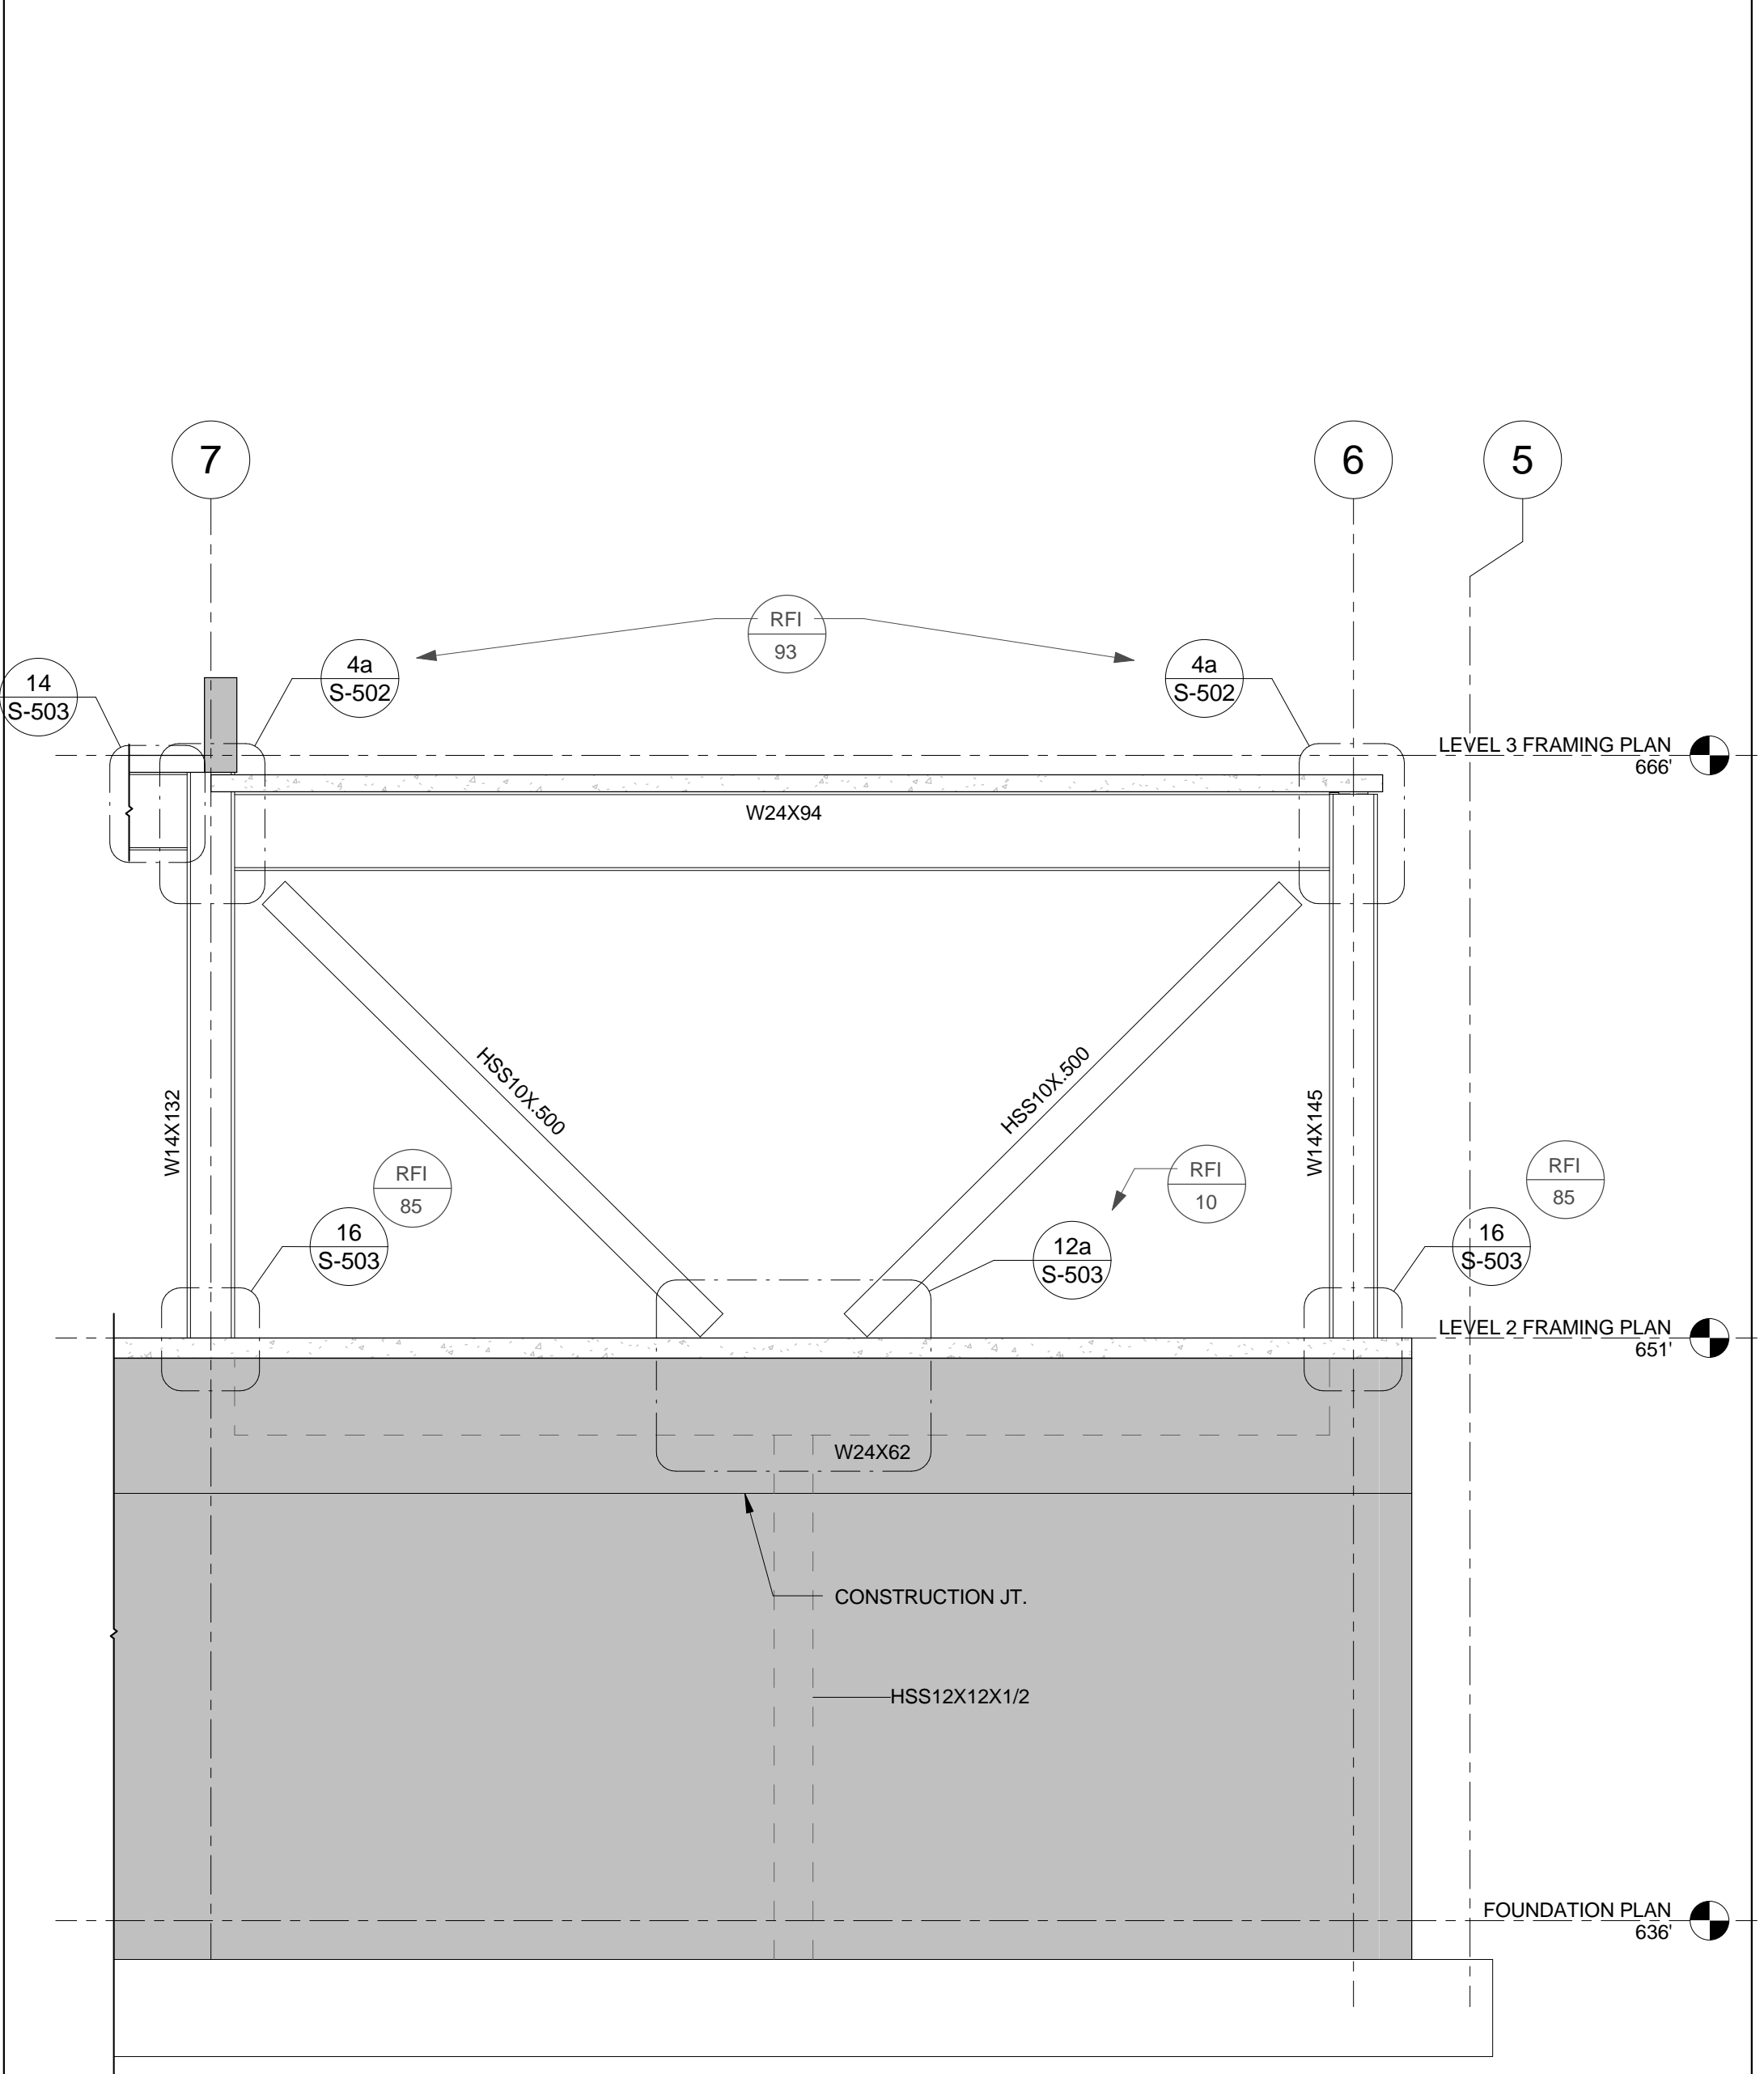


**3 ELEVATION (LINE A)**  
SCALE: 1/4" = 1'-0"

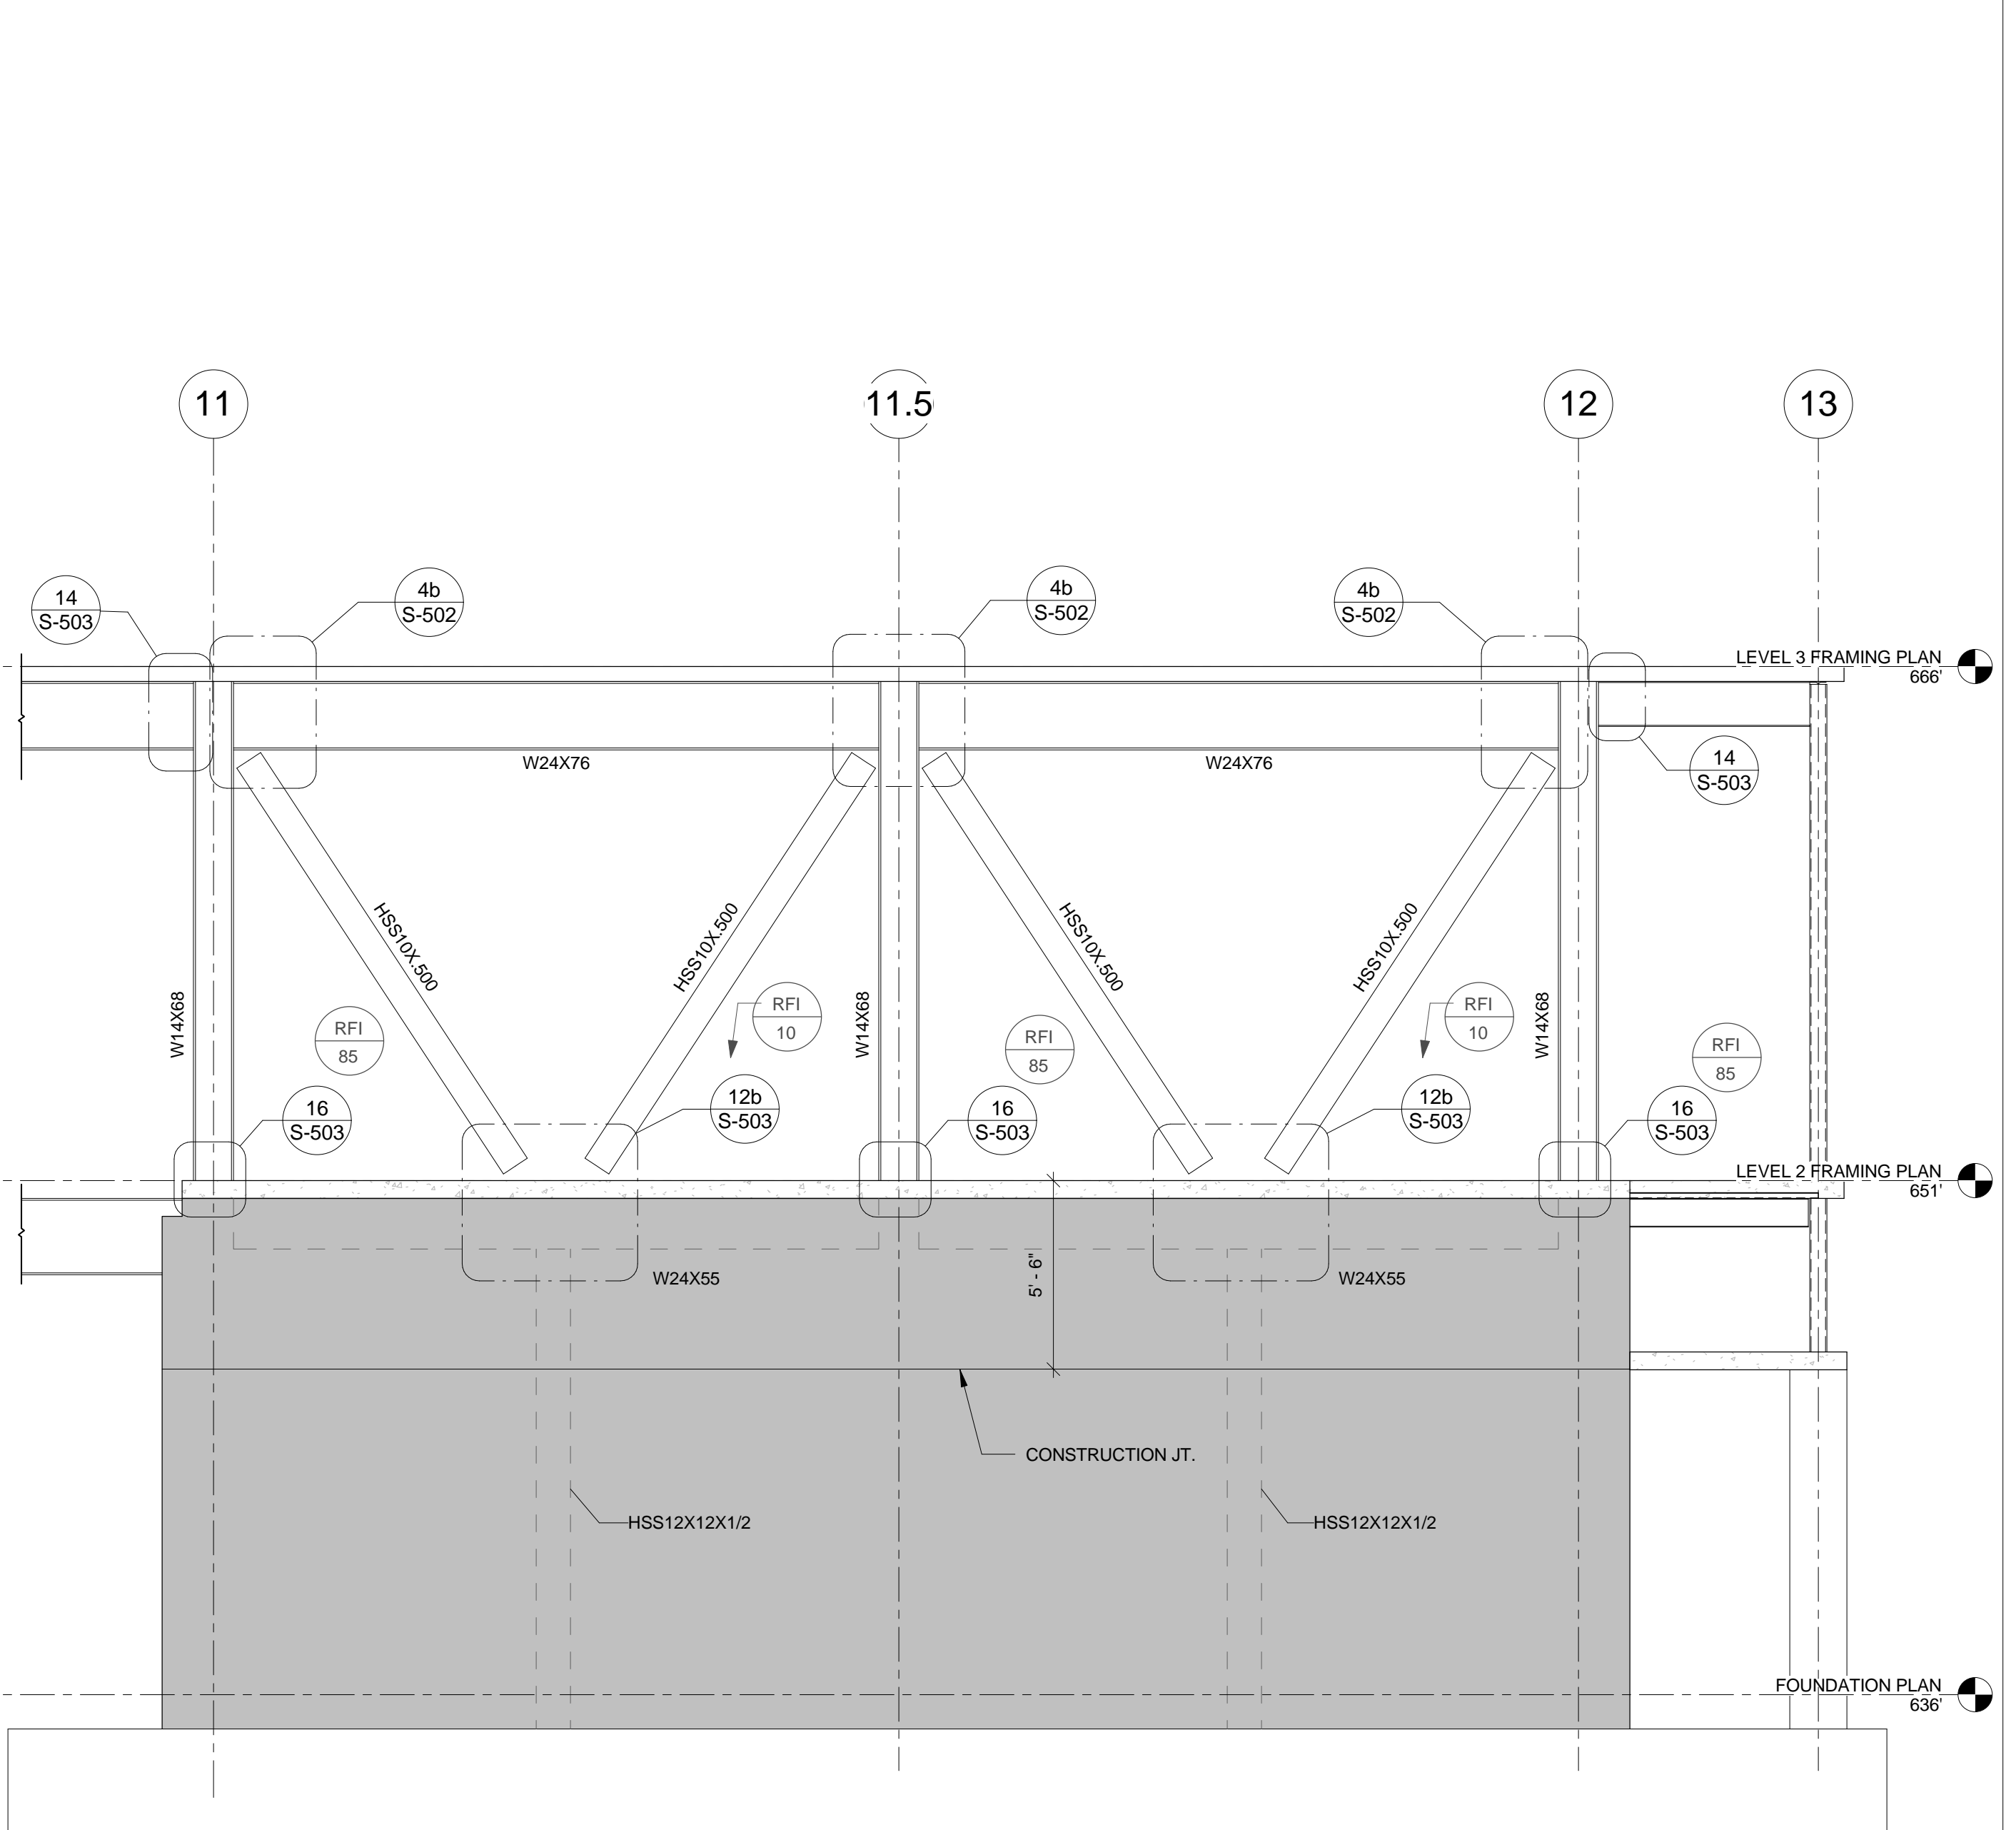


**1 ELEVATION (LINE D)**  
SCALE: 1/4" = 1'-0"

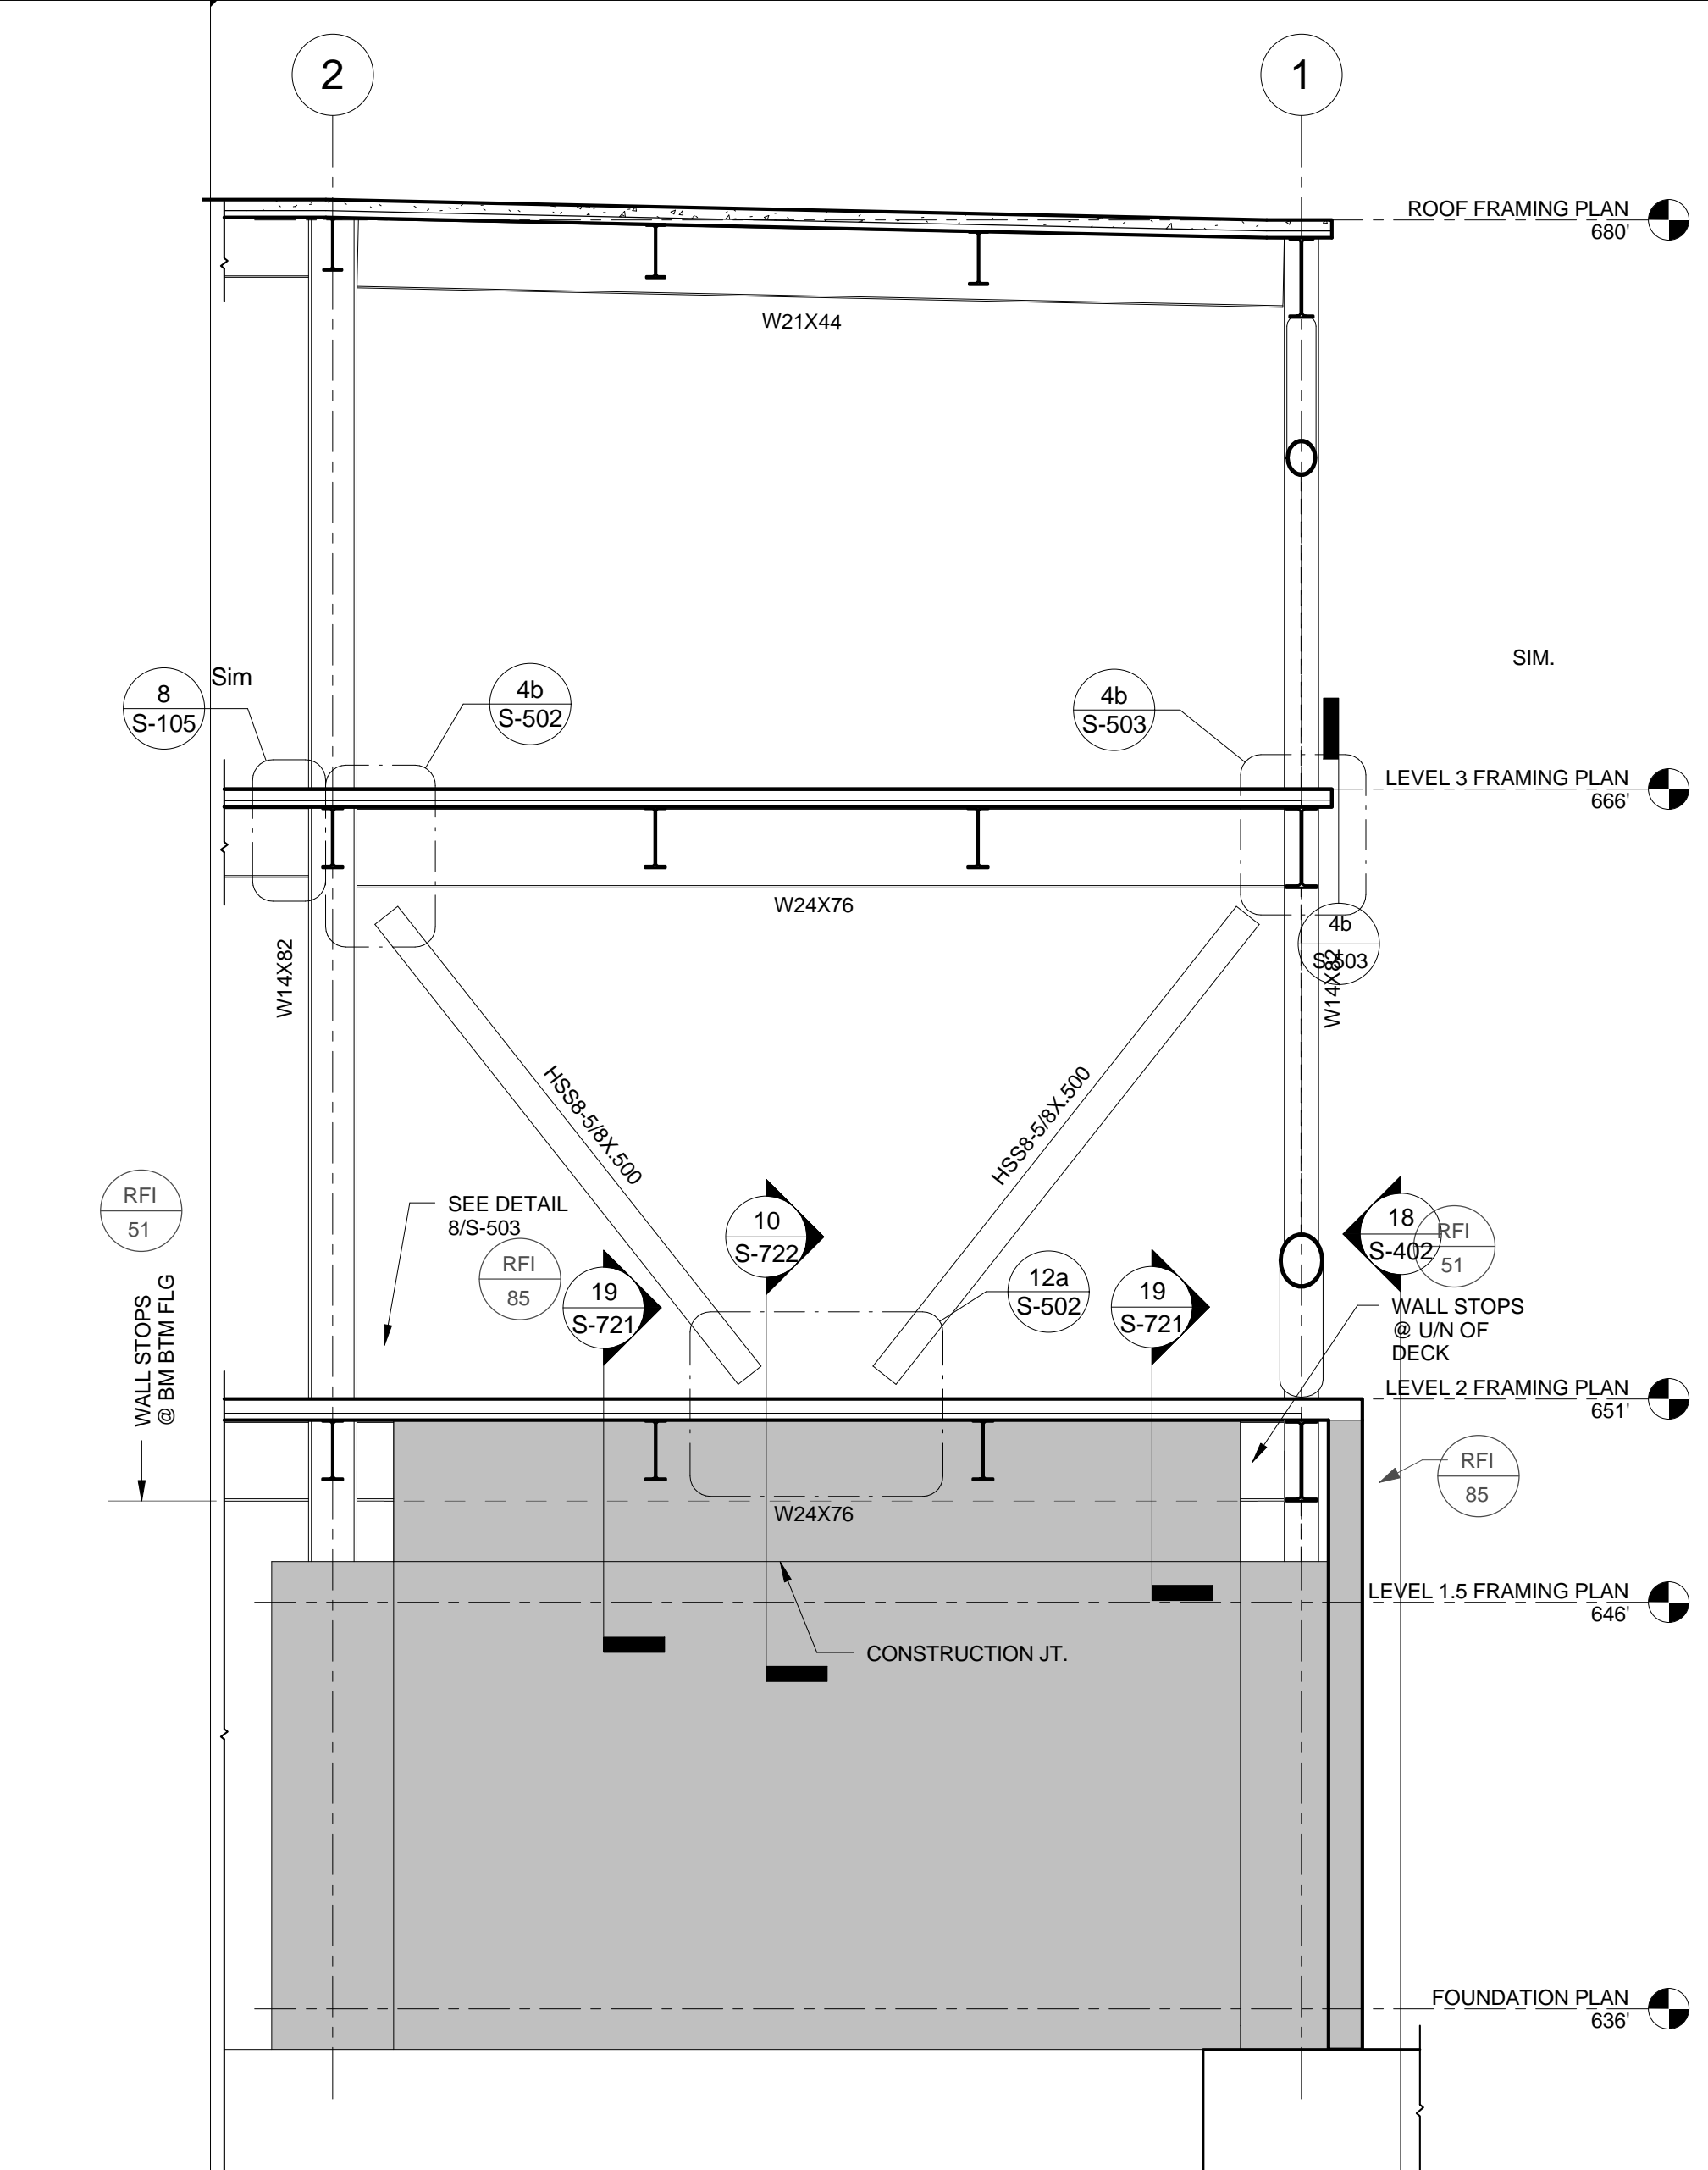

**6 ELEVATION (LINE E)**  
SCALE: 1/4" = 1'-0"

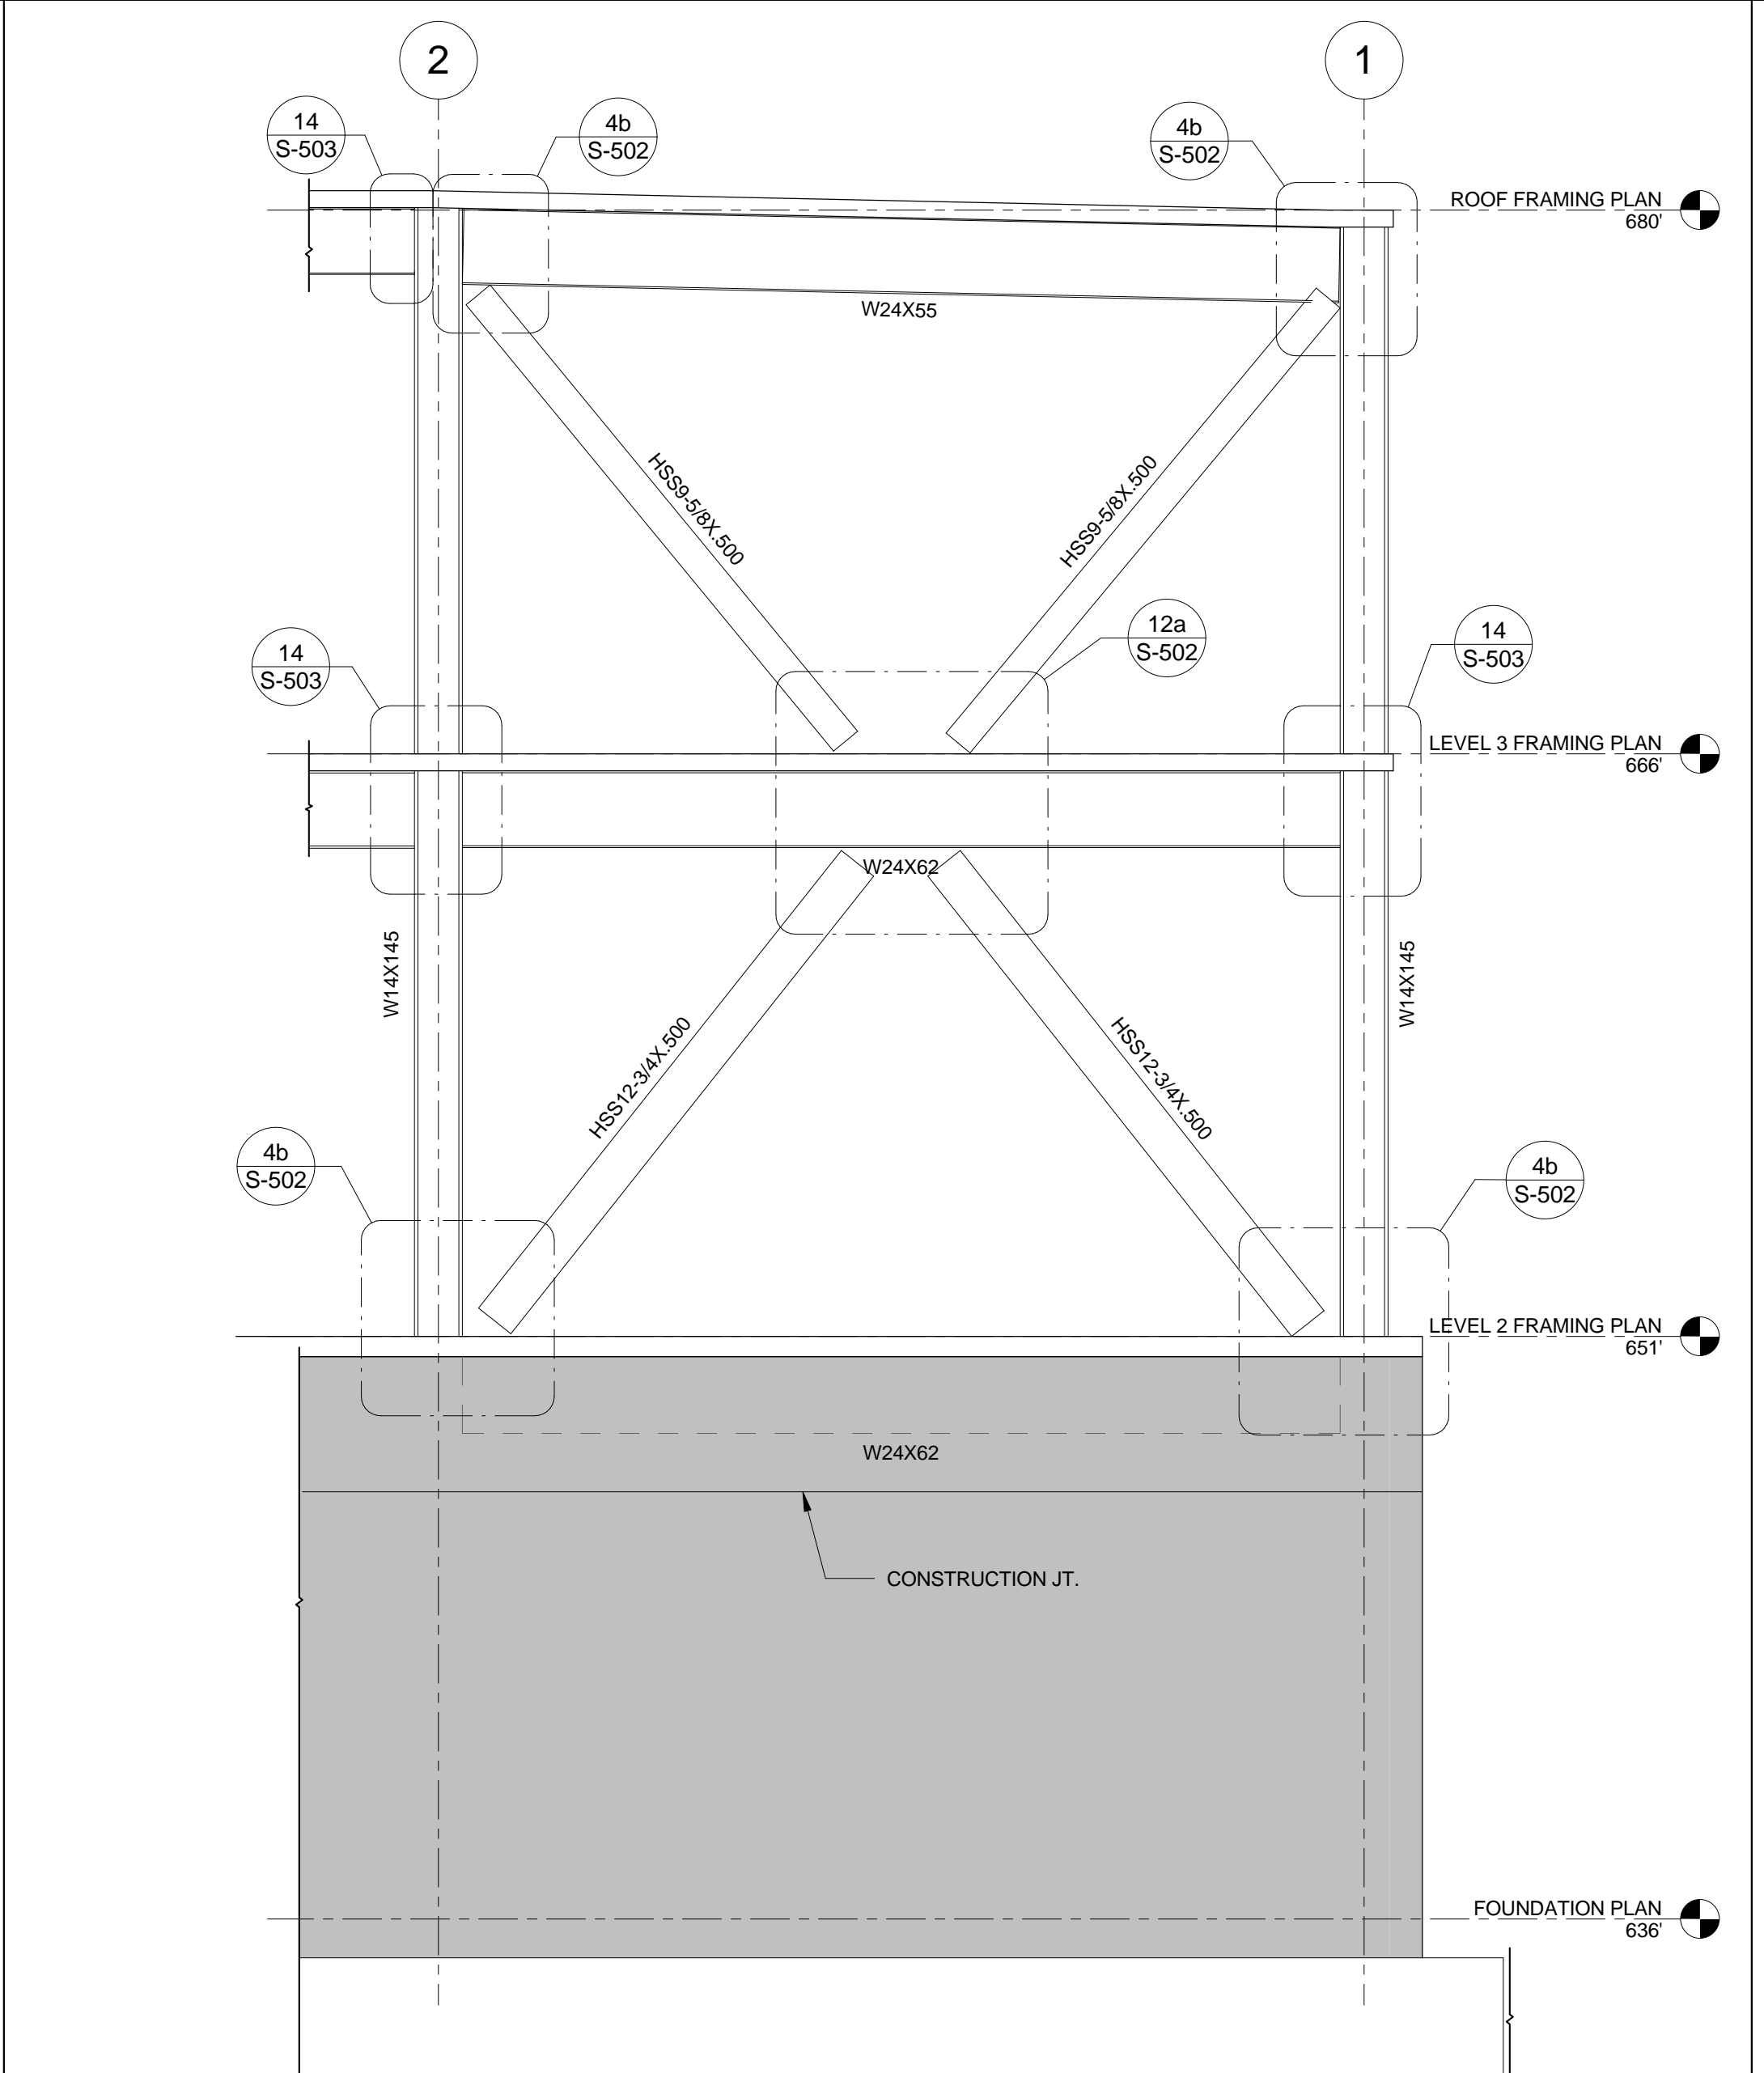


**4 ELEVATION (LINE B)**  
SCALE: 1/4" = 1'-0"

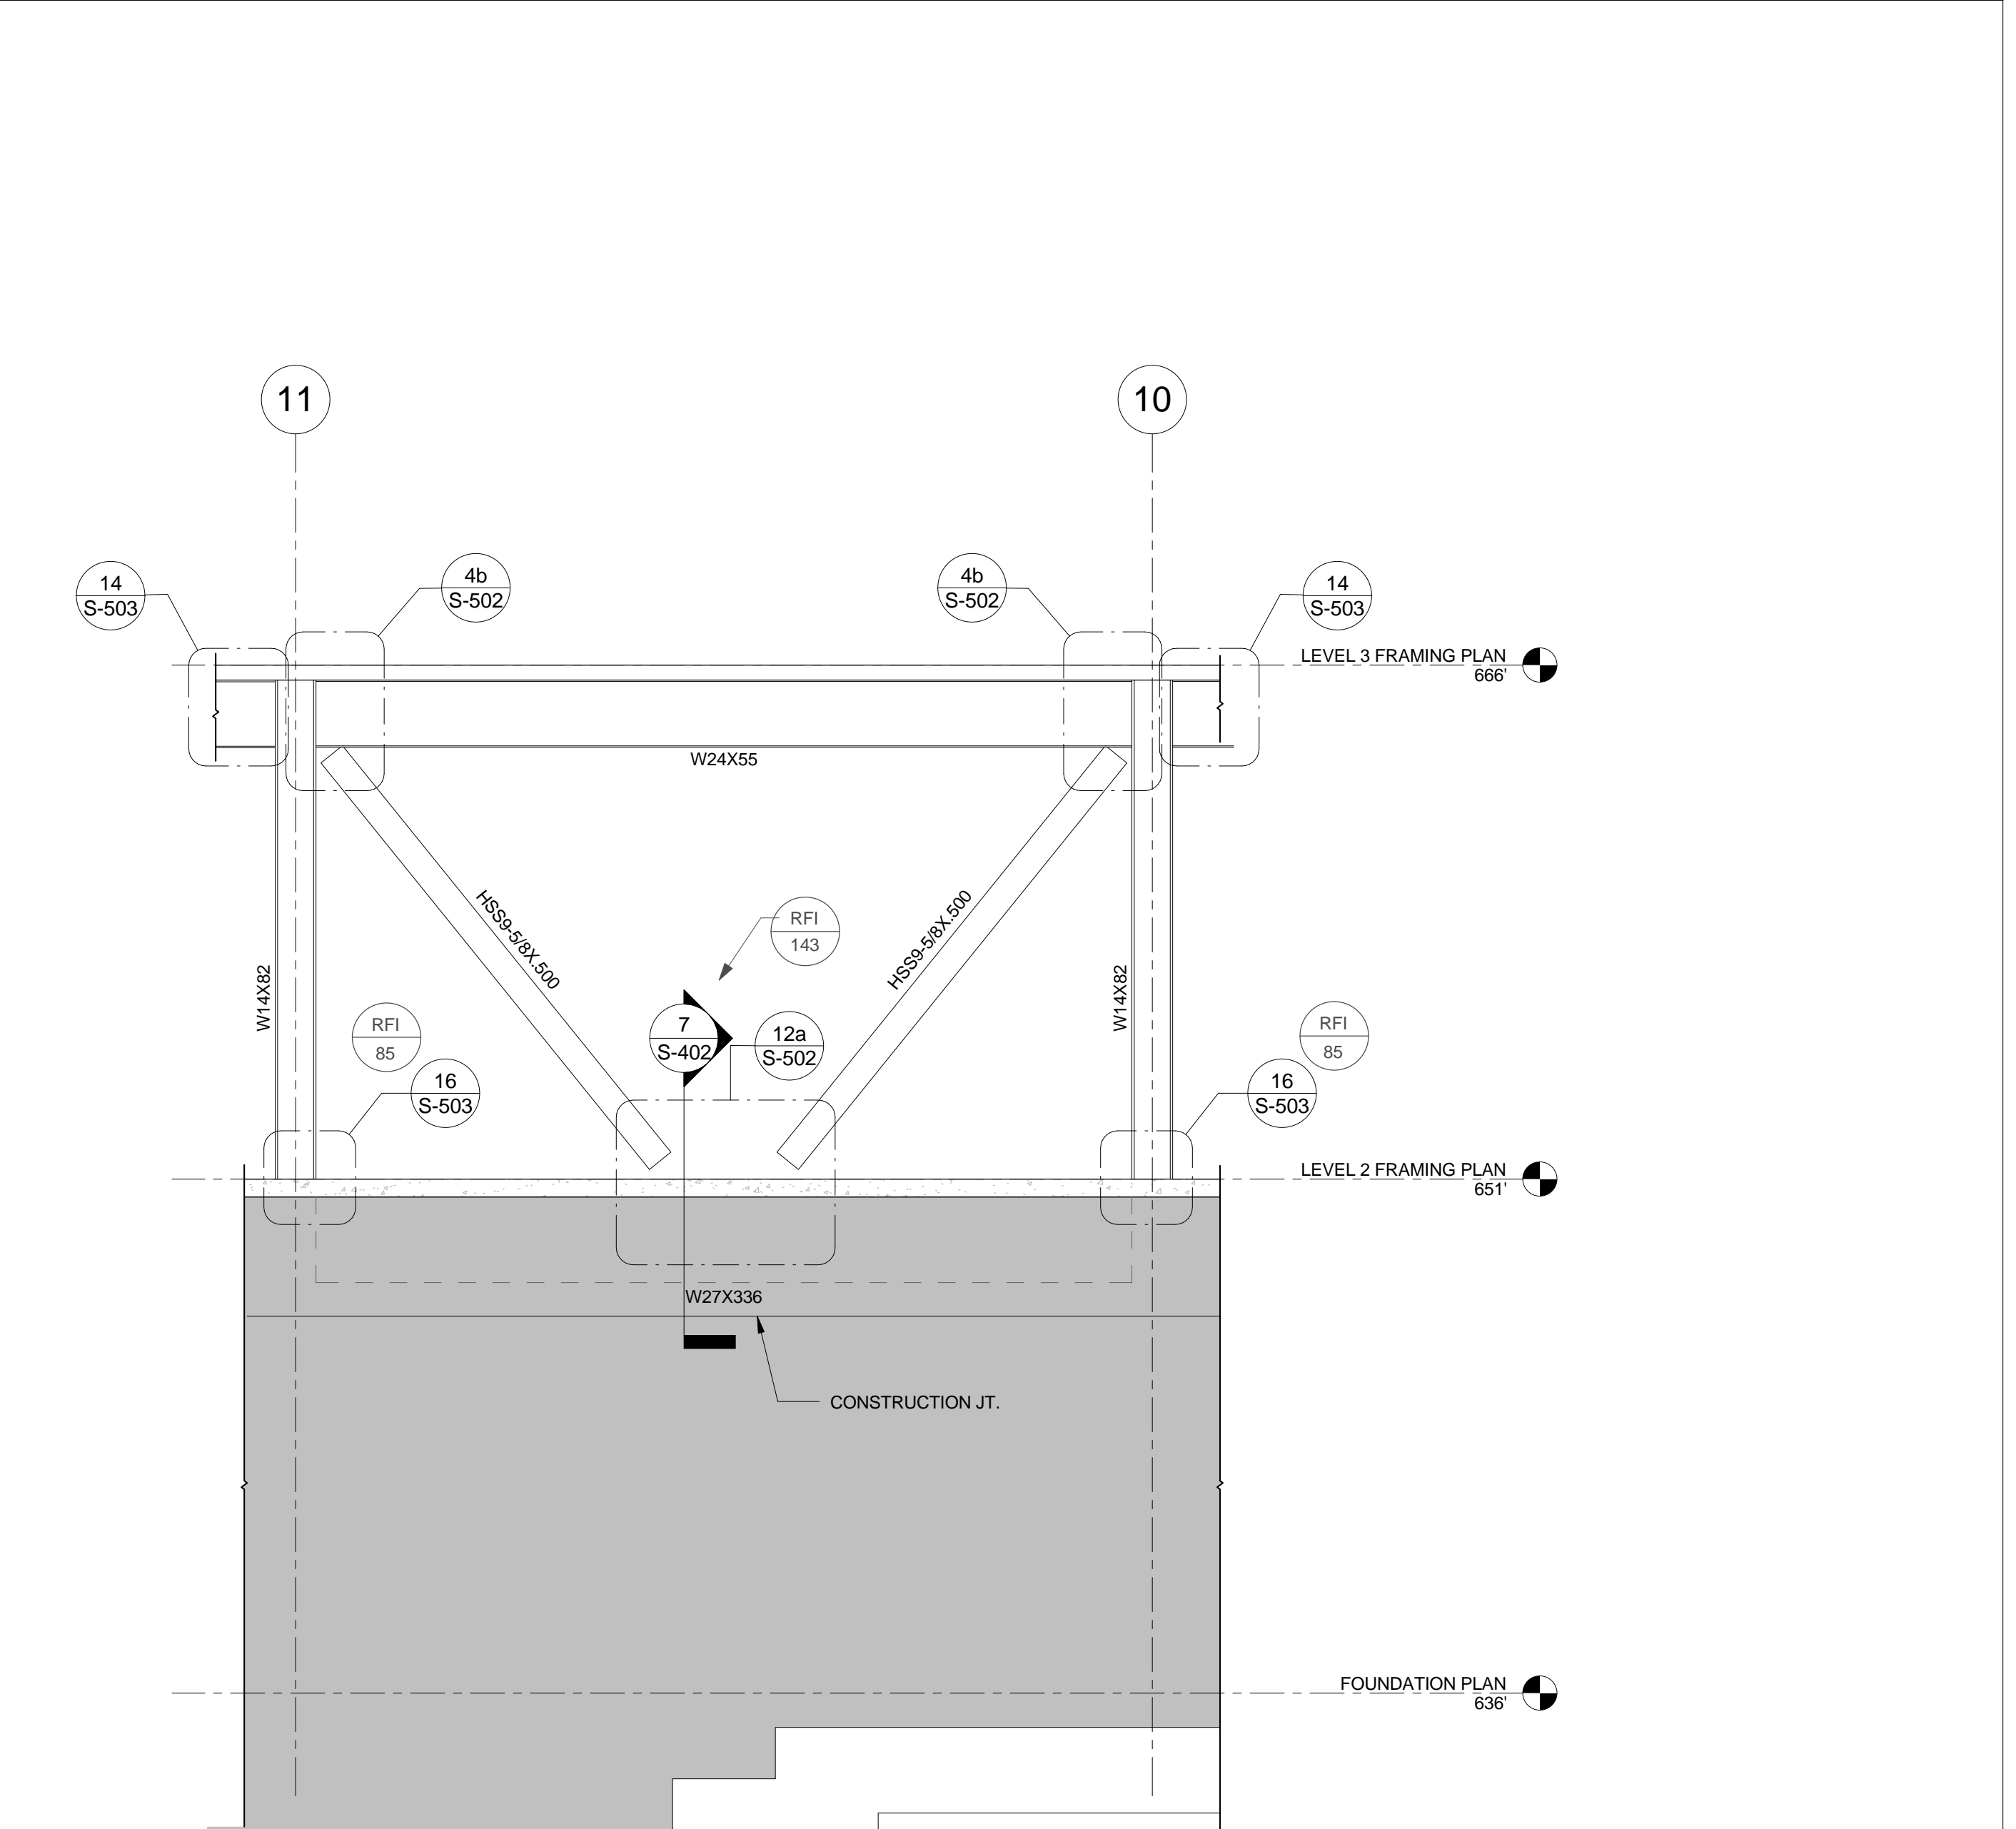


**2 ELEVATION (LINE A)**  
SCALE: 1/4" = 1'-0"


All drawings and written material appearing herein constitute original and unpublished work of the Architect/Engineer and may not be duplicated, used or disclosed without consent of Architect/Engineer. If this drawing is not 30"x42", then the drawing has been revised from its original size. Note: scales must be adjusted. This line should be equal to one inch.

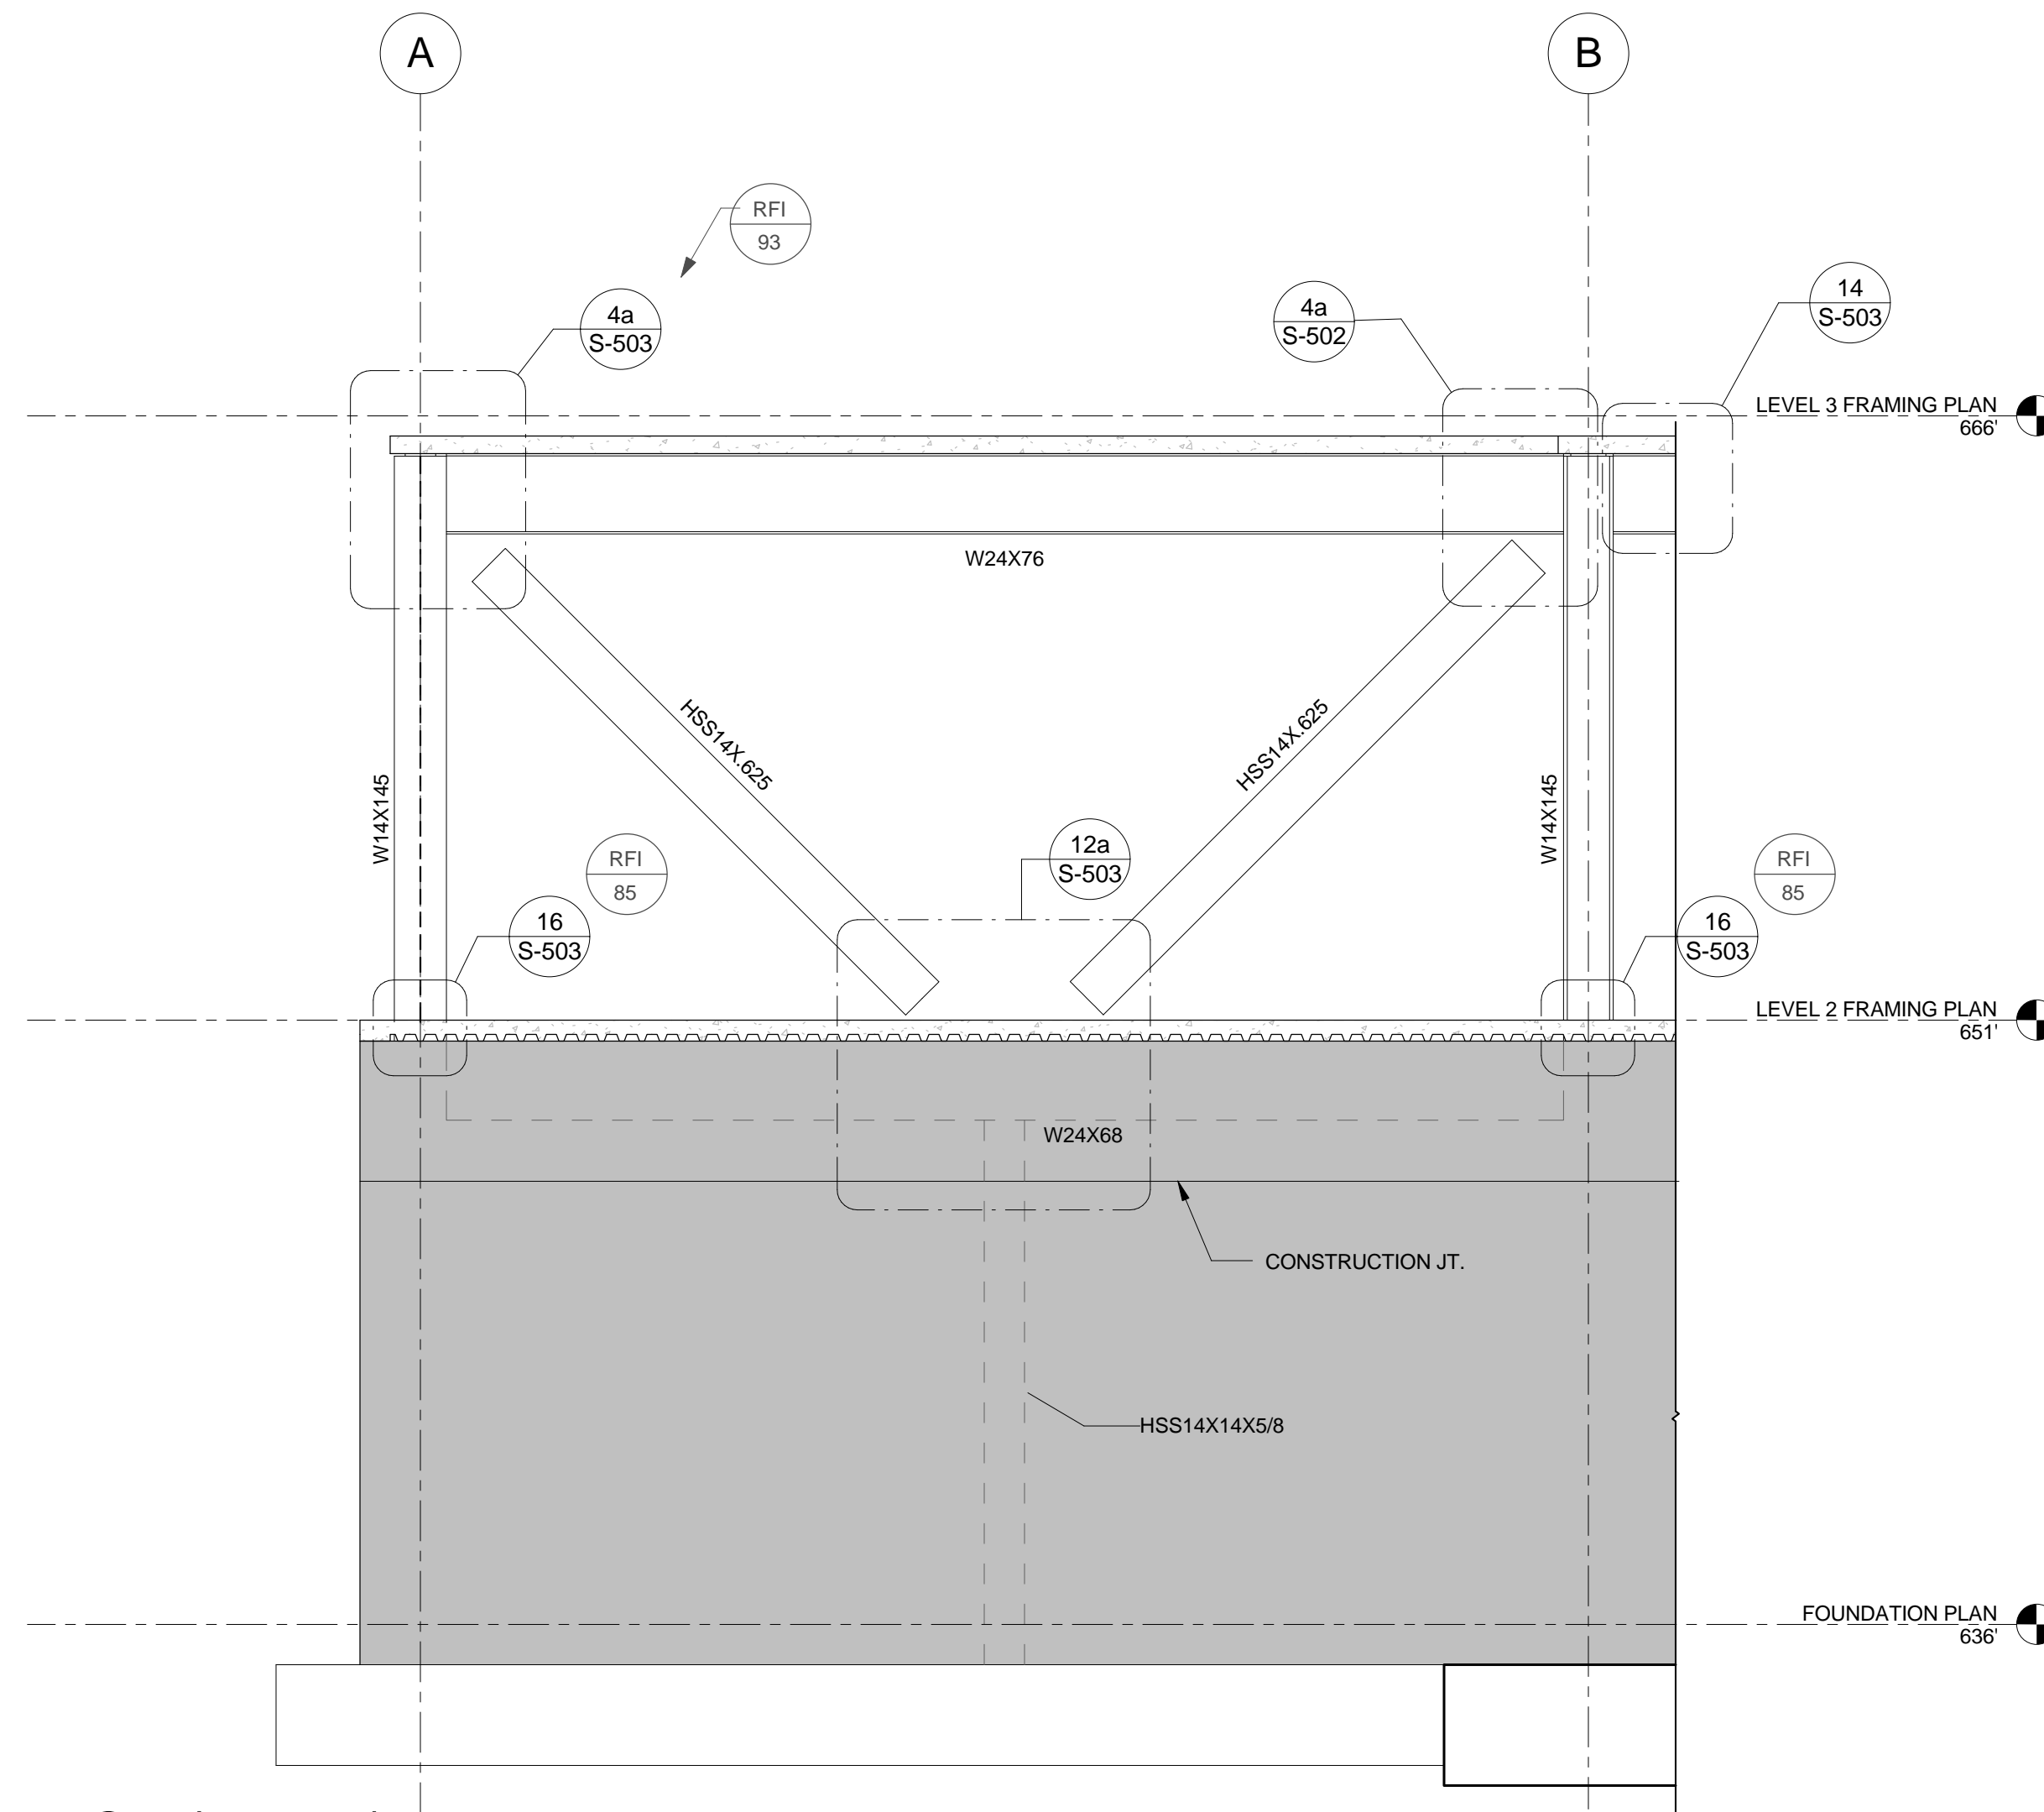


**3** ELEVATION (LINE 6)  
SCALE: 1/4" = 1'-0"

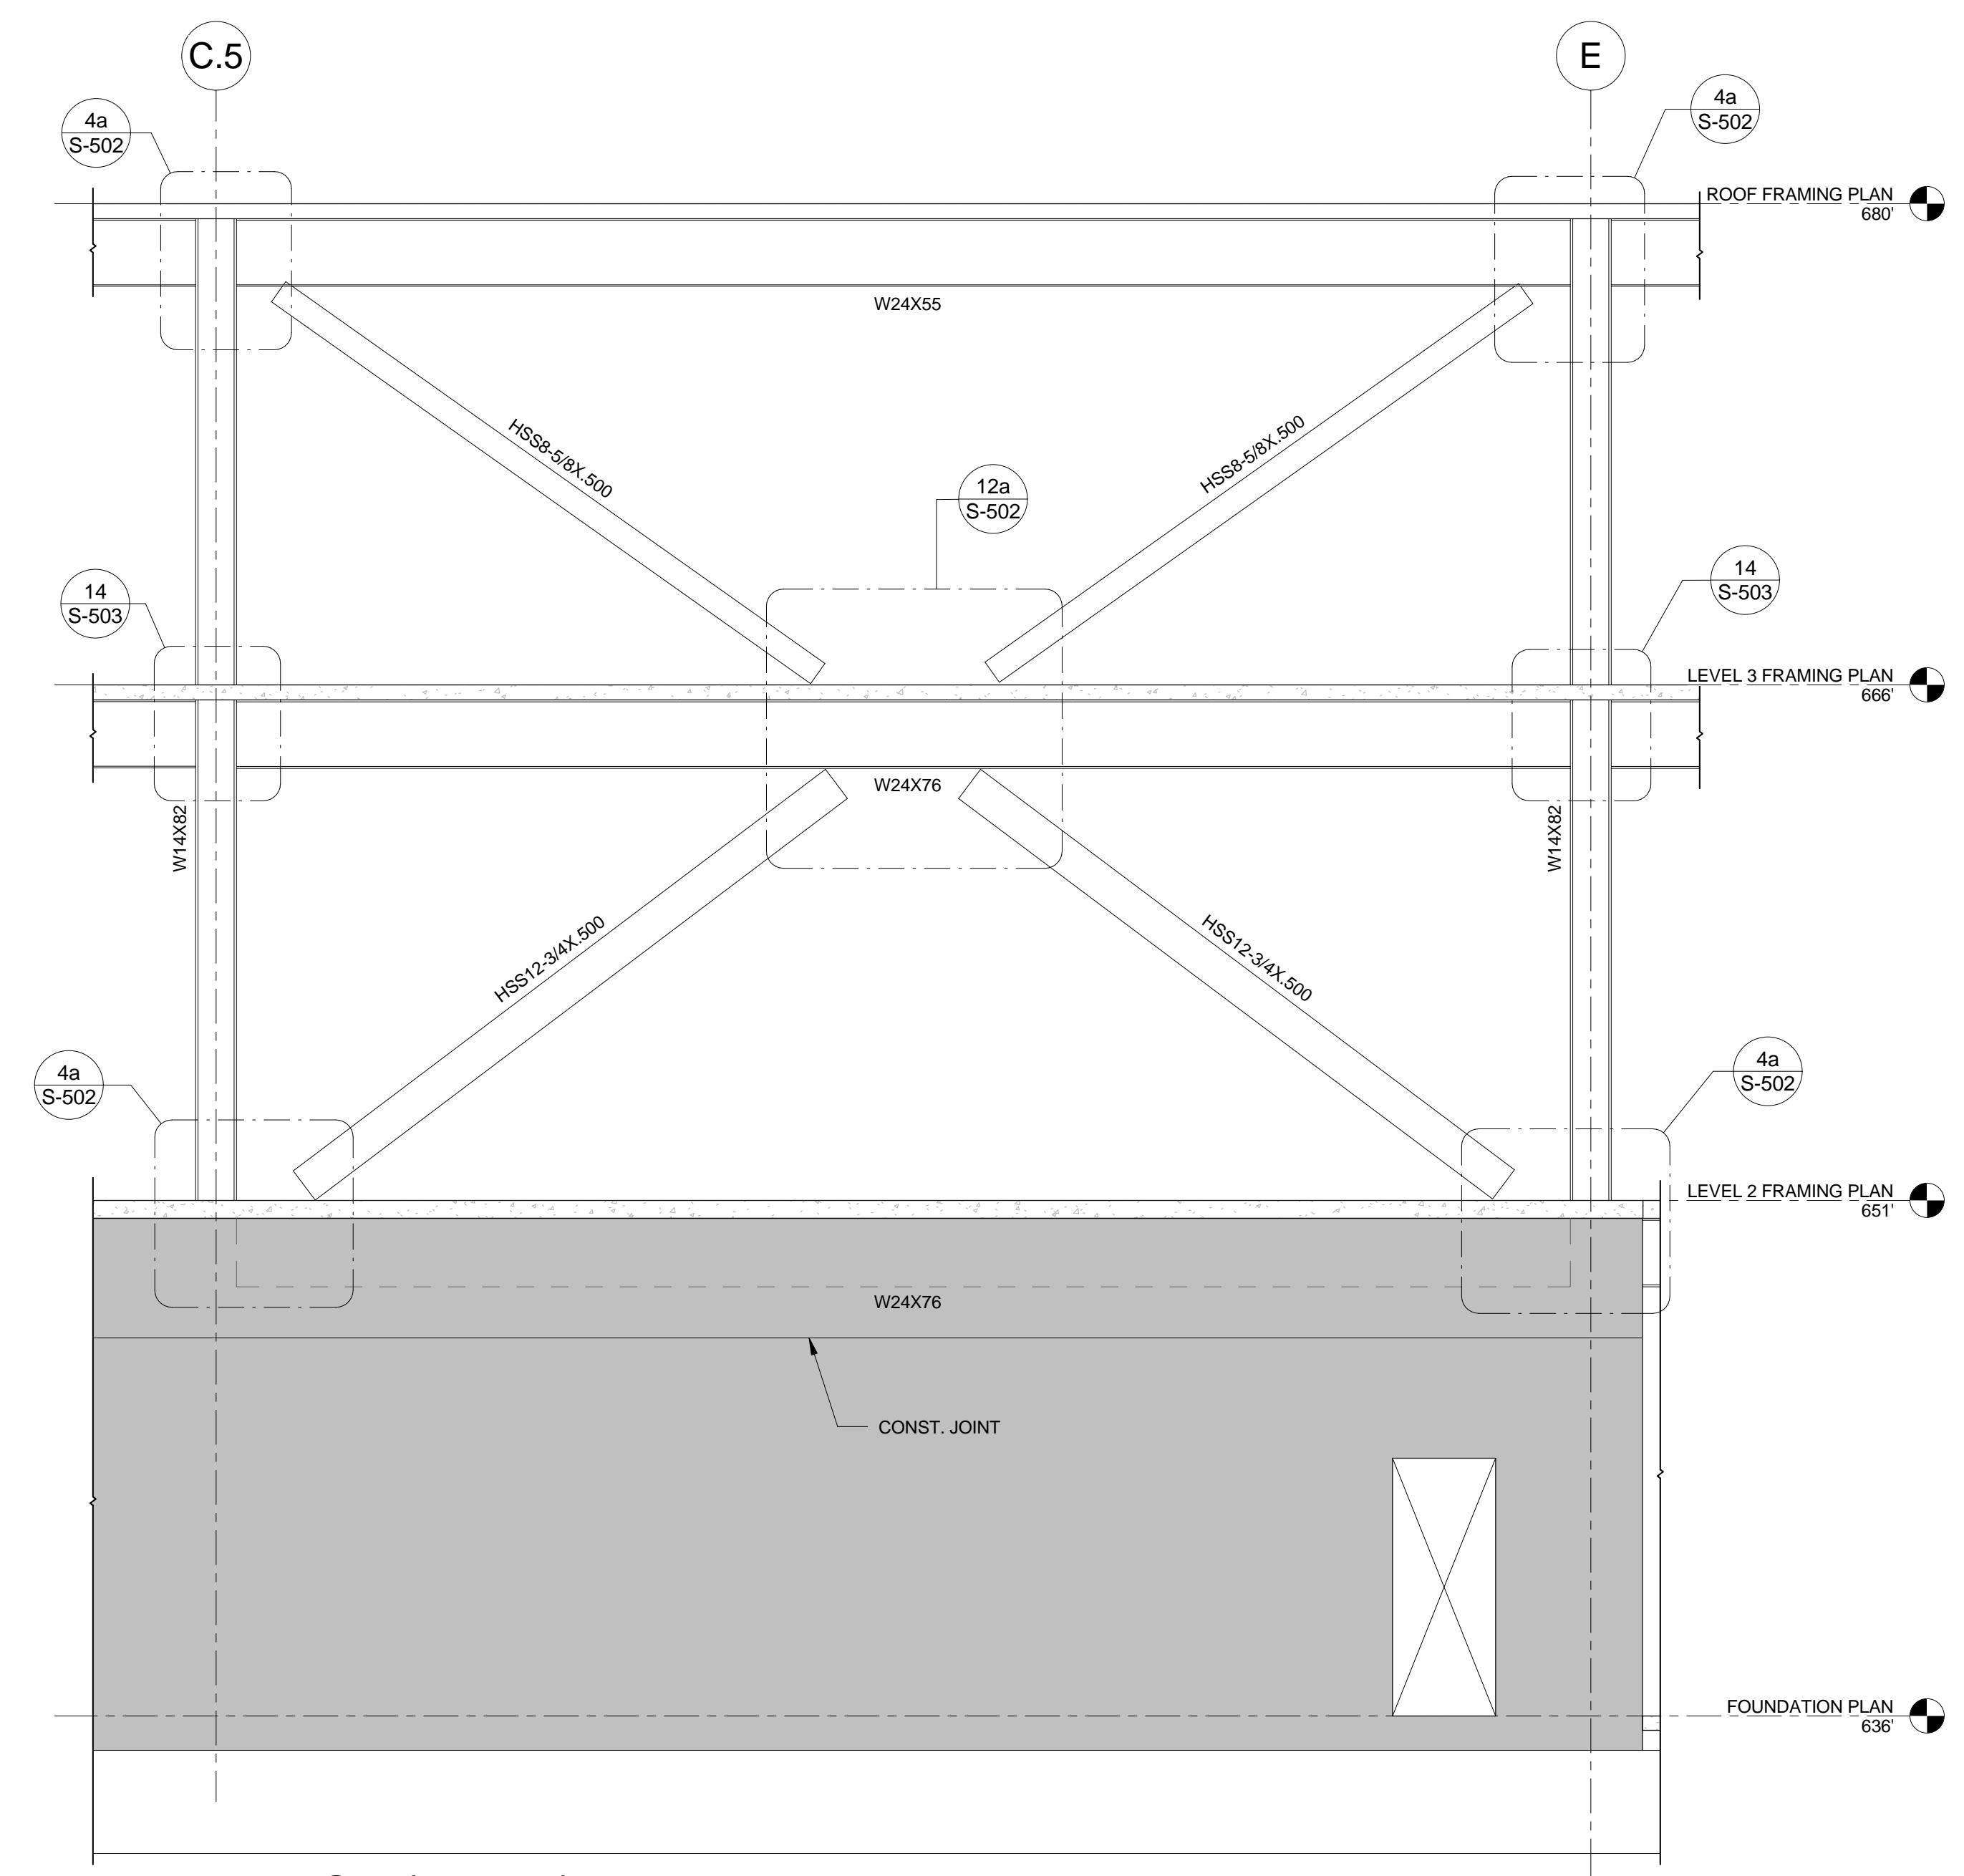

**1** ELEVATION (LINE 1)  
SCALE: 1/4" = 1'-0"

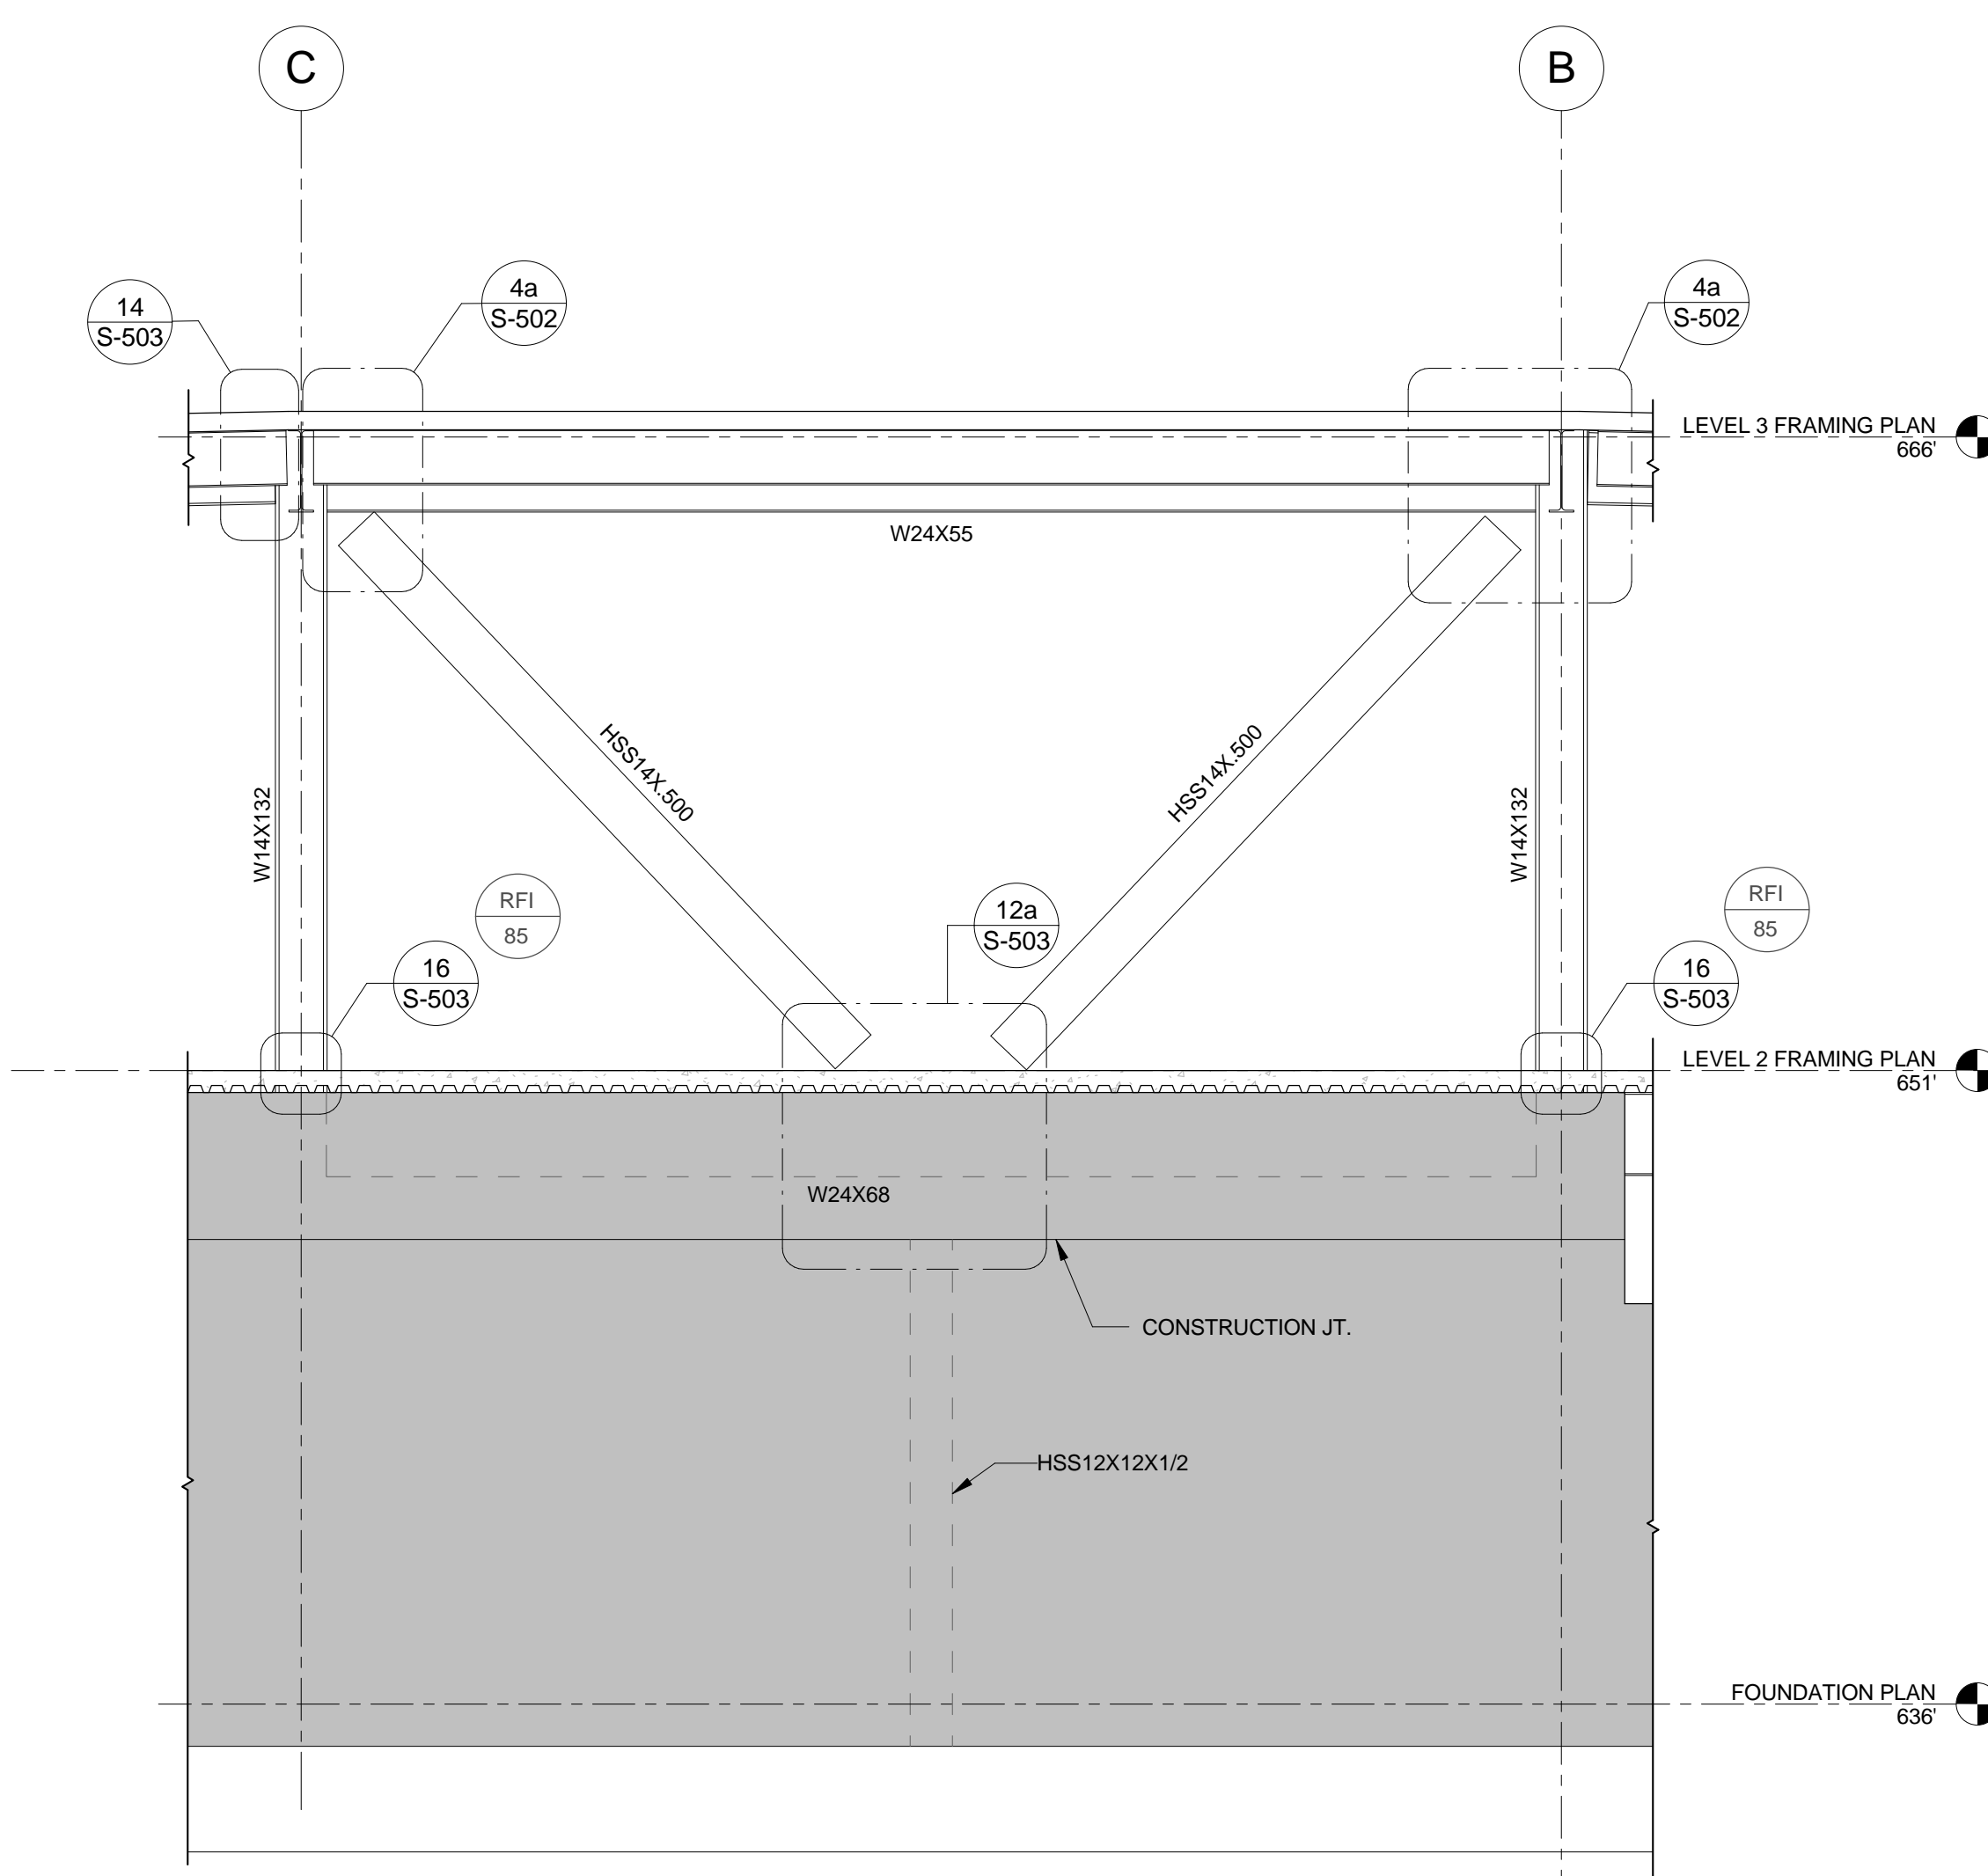

**4** ELEVATION (LINE 12)  
SCALE: 1/4" = 1'-0"

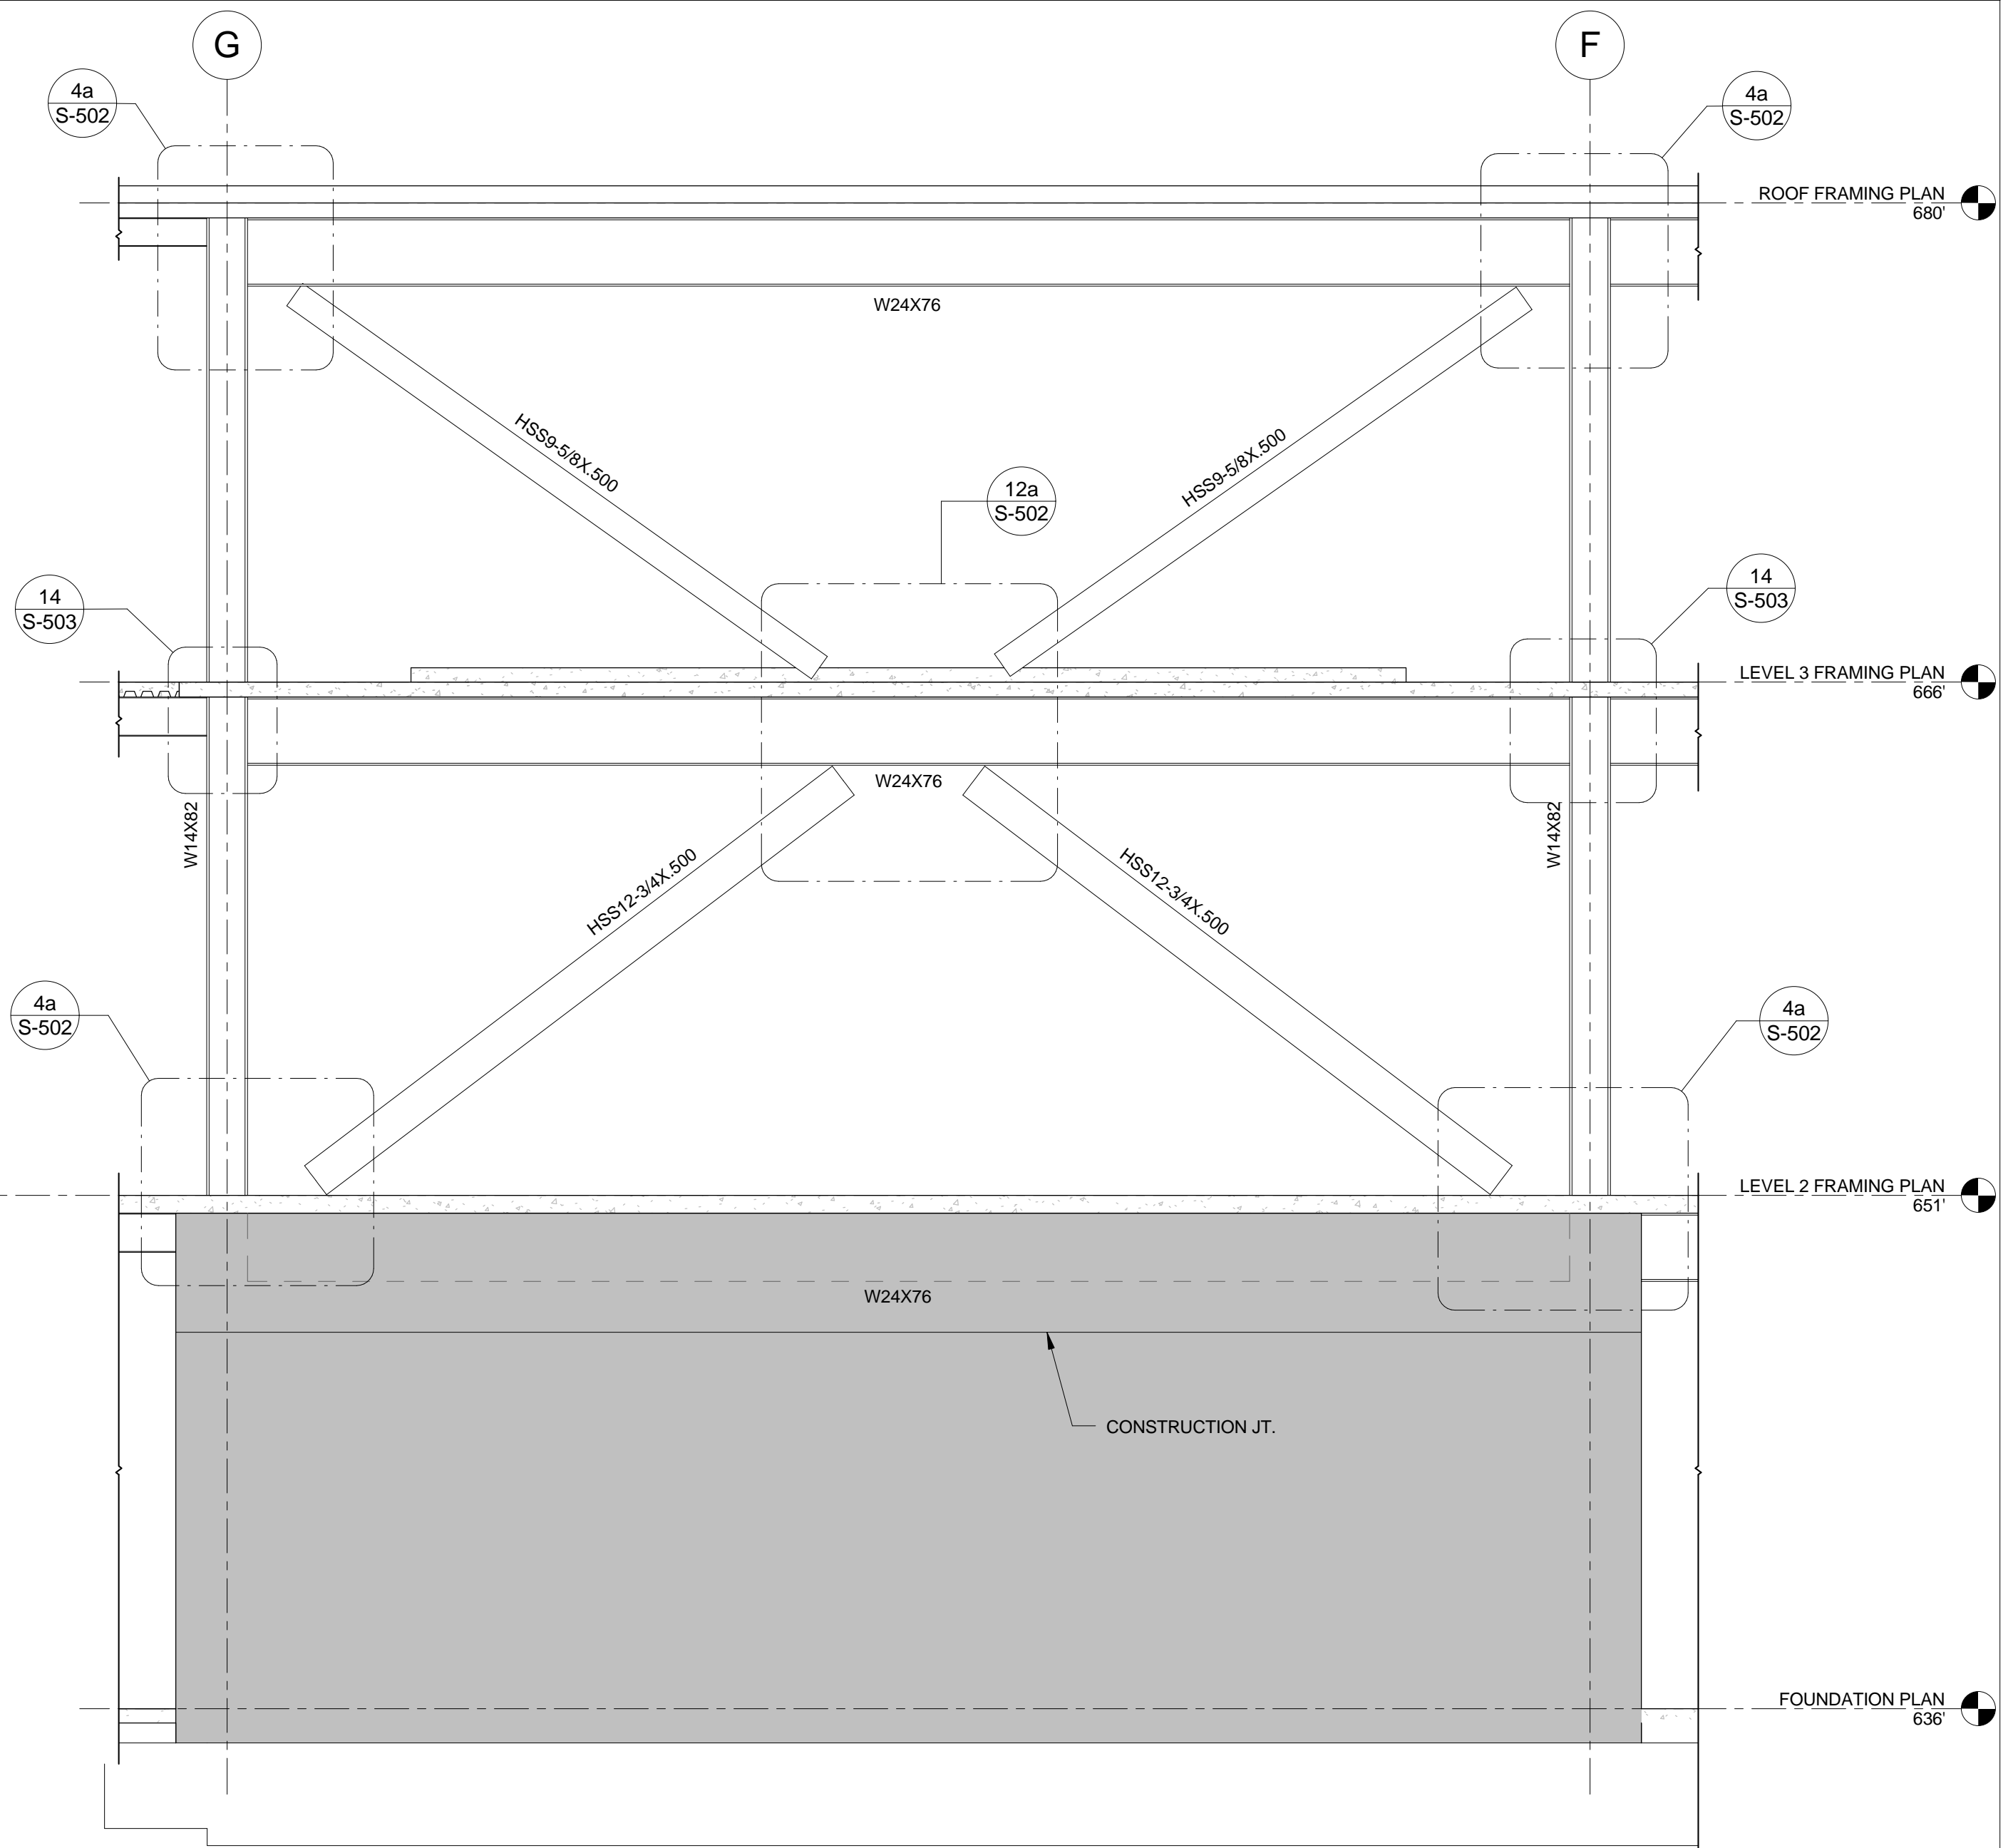

**2** ELEVATION (LINE 4)  
SCALE: 1/4" = 1'-0"

PROJECT  
RECORD SET

SKYLINE COLLEGE  
SAN MATEO COUNTY  
COMMUNITY COLLEGE  
DISTRICT

CIP2 DESIGN-BUILD  
PROJECT  
BUILDING 4

PROJECT NO.: 07055.00 DRAWN BY: AY  
DATE: 05.15.2009 CHECKED BY: CB  
SCALE: 1/4" = 1'-0"

SHEET TITLE:  
**BRACE FRAME  
ELEVATIONS**




PROJECT  
RECORD SET

SKYLINE COLLEGE  
SAN MATEO COUNTY  
COMMUNITY COLLEGE  
DISTRICT


CIP2 DESIGN-BUILD  
PROJECT  
BUILDING 4

BRACE FRAME  
DETAILS

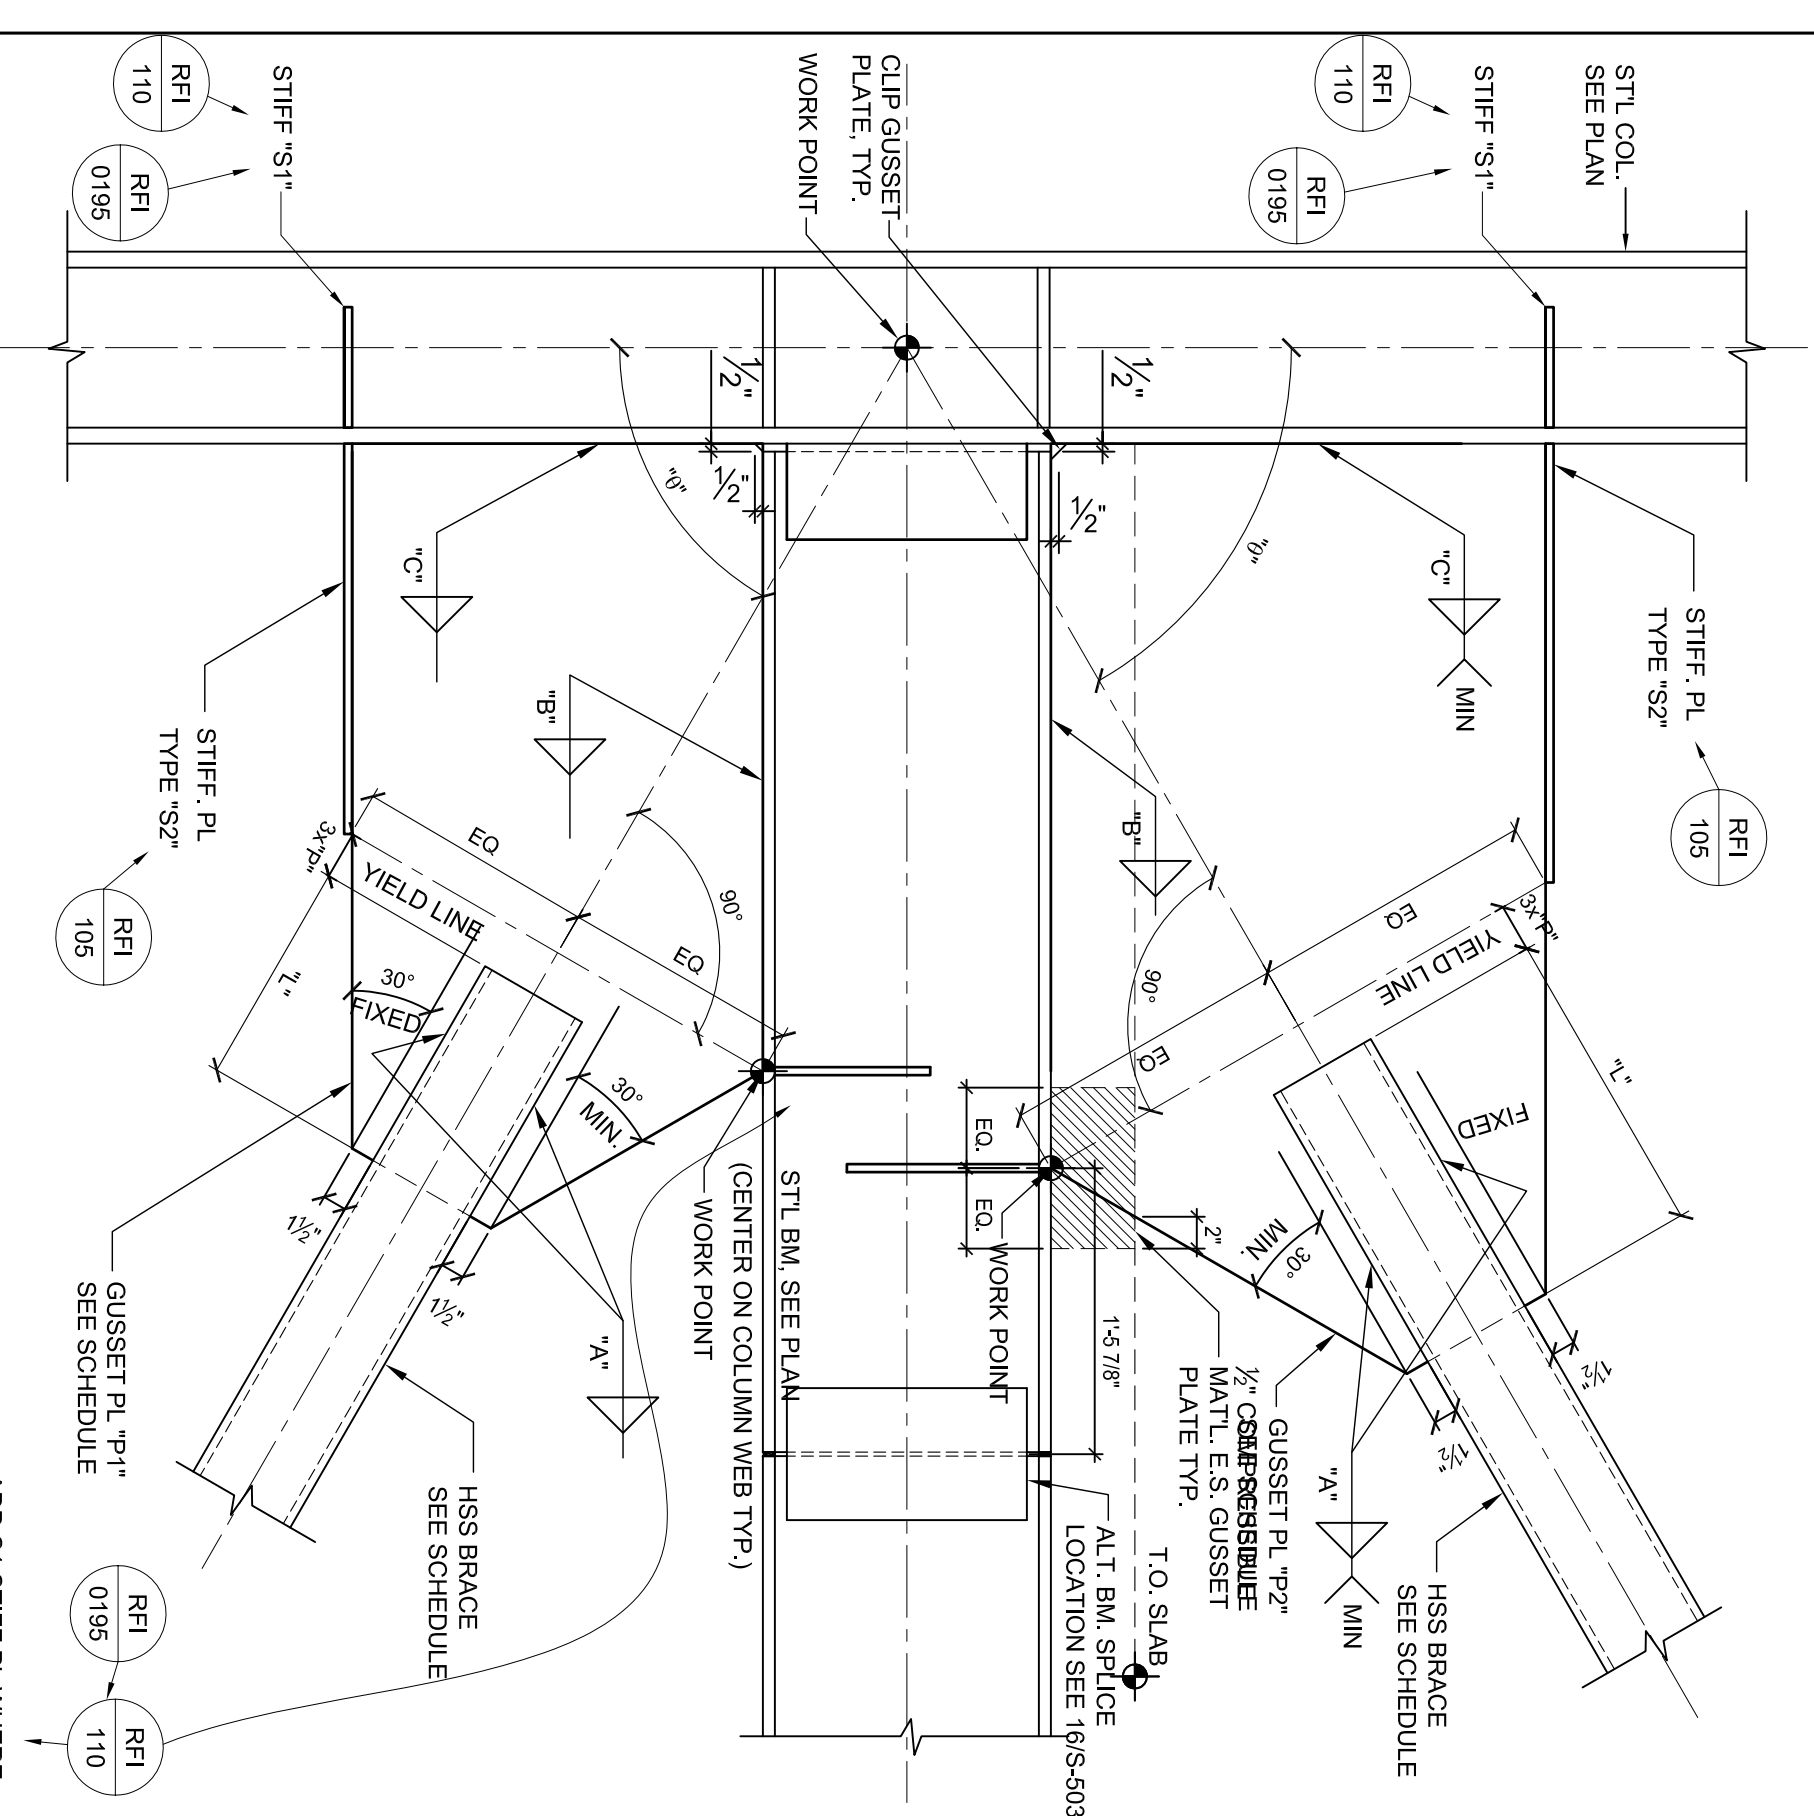

NOTE:  
LENGTH OF WELD 'C' IS PER SCHEDULE  
LENGTH OF WELD 'B' IS A MINIMUM PER  
THE SCHEDULE.  
SEE 161 FOR REINFORCEMENT PLATES


1 YIELD LINES START AT THE TOP OF BEAM

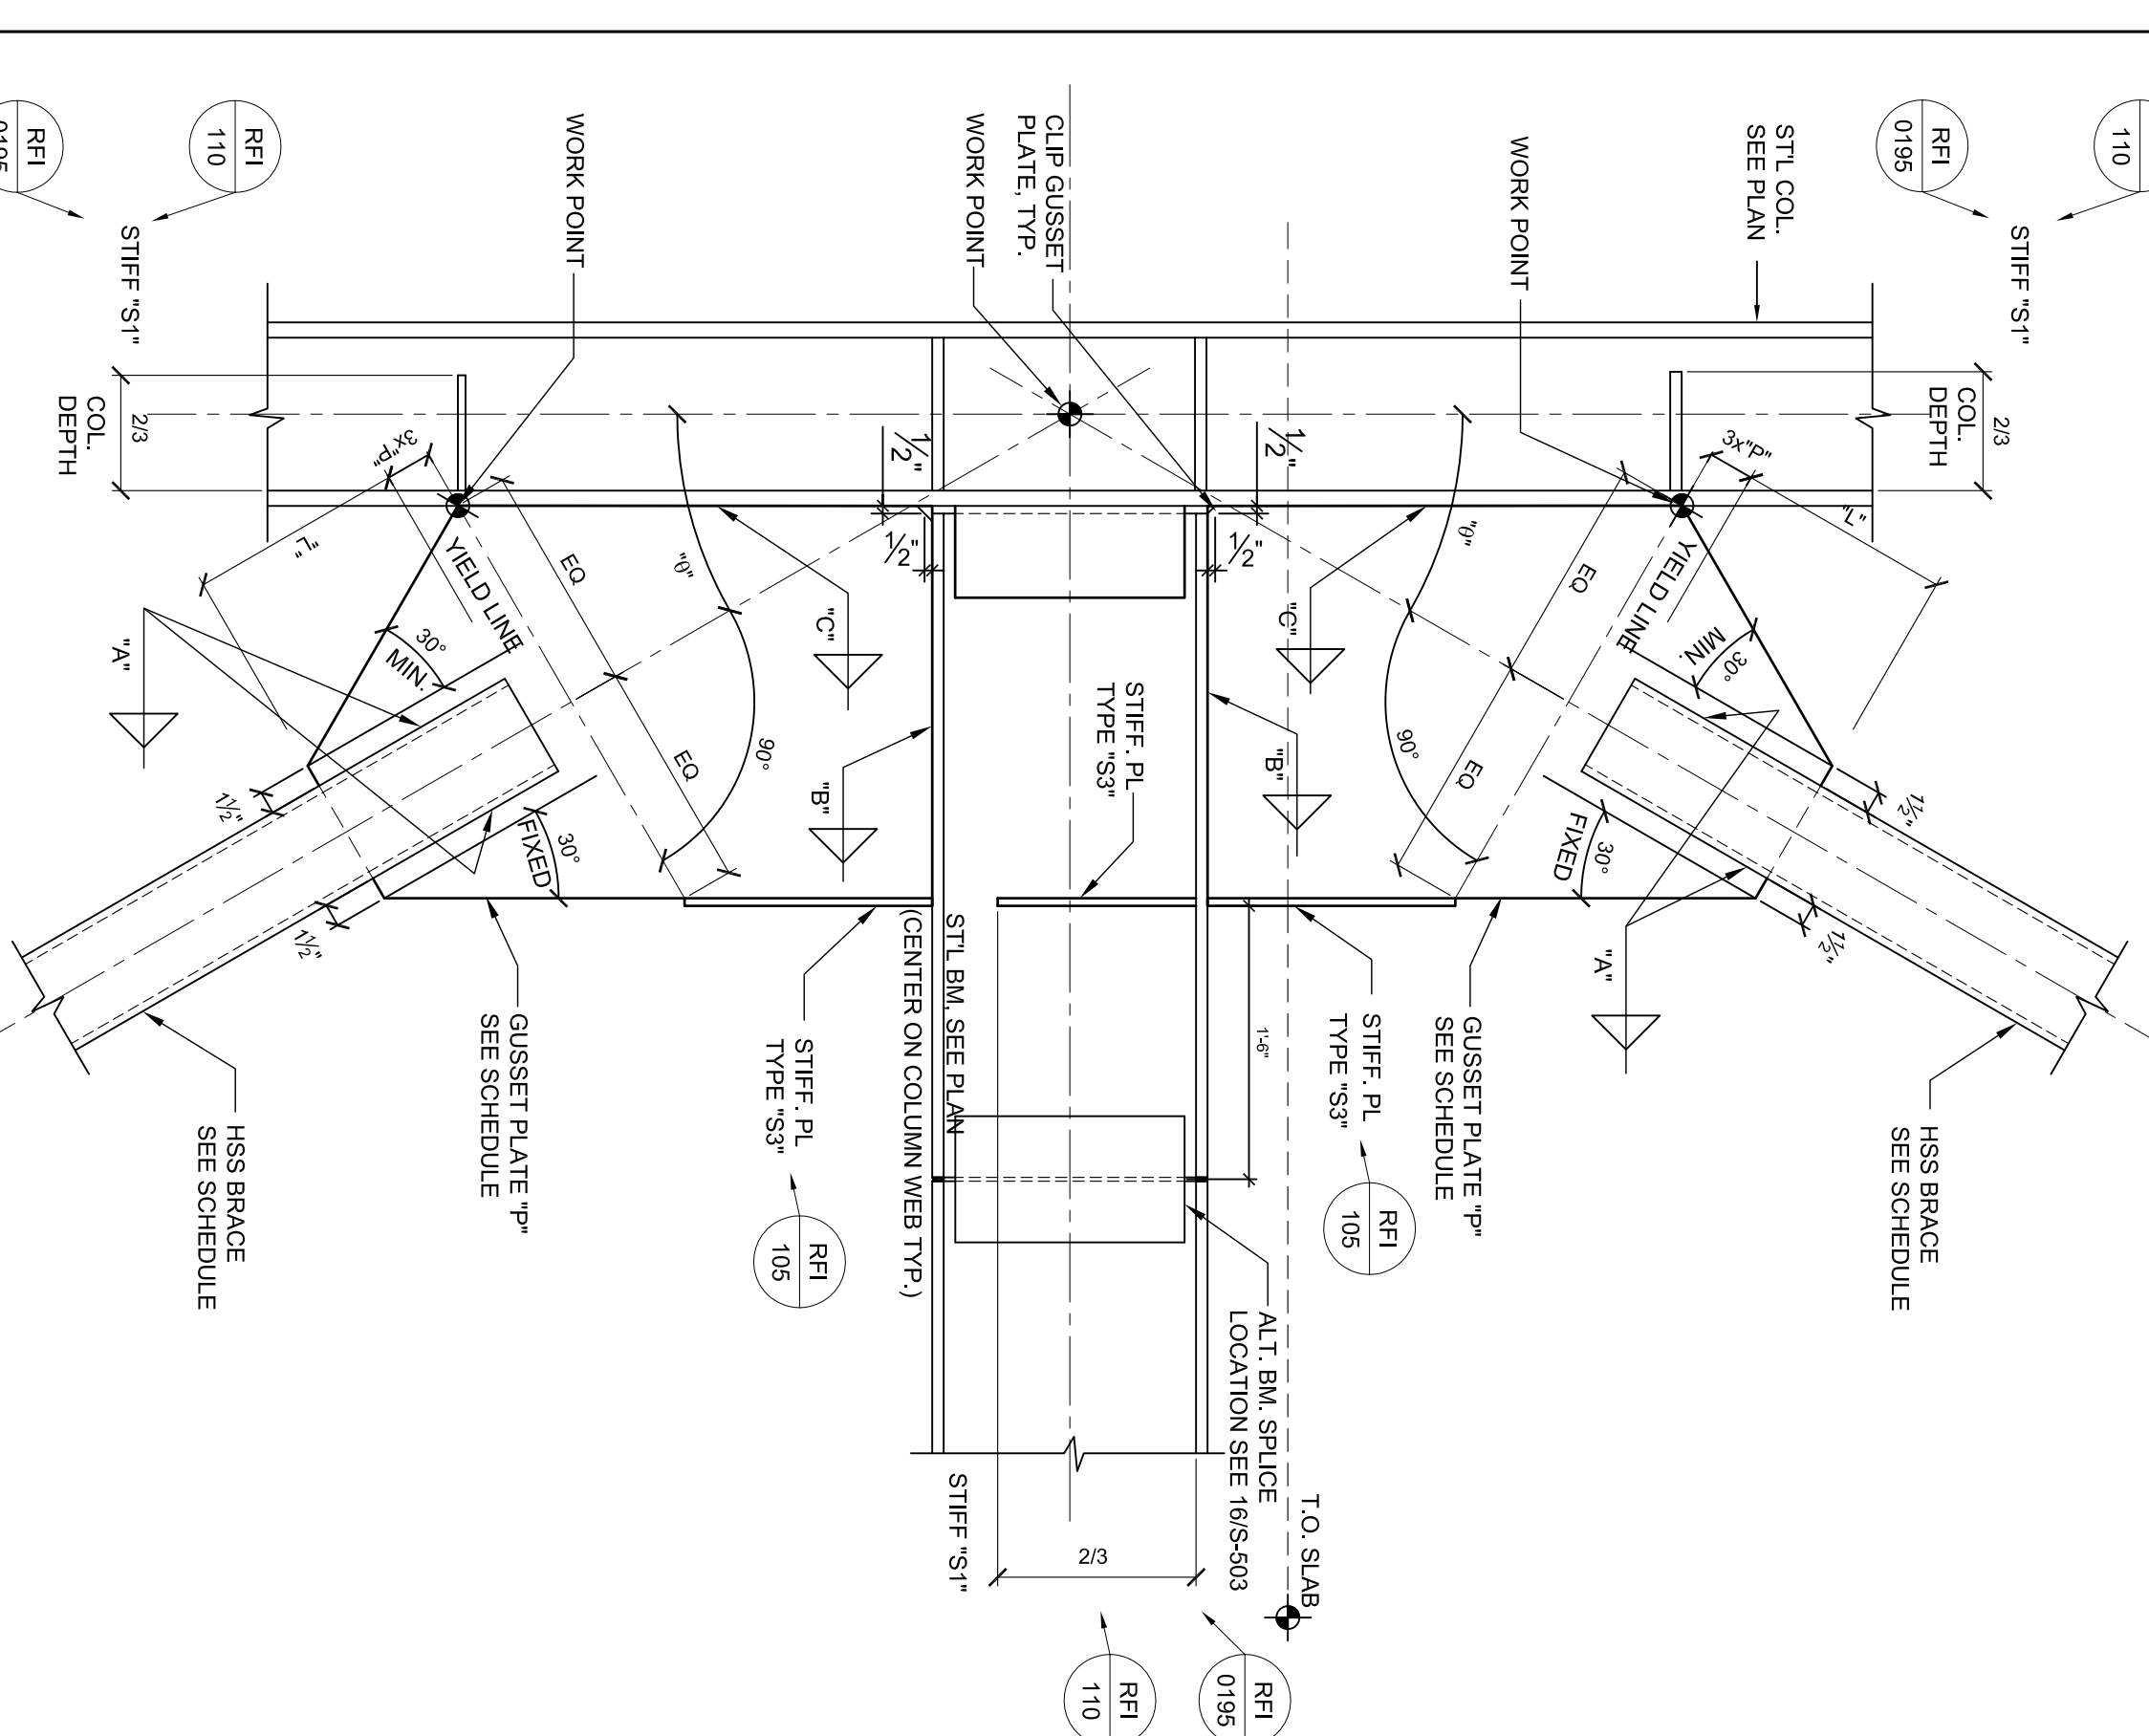

NOTE:  
SEE DETAIL 161 FOR OVER-SLOT  
LENGTH OF WELD 'C' IS PER SCHEDULE  
LENGTH OF WELD 'B' IS A MINIMUM PER  
THE SCHEDULE.  
CONN. TYP. @ ALL LOCATIONS


2 YIELD LINES START AT THE FLANGE OF COLUMN

4 TYPICAL TWO-SIDED BRACE  
TO BEAM/COLUMN CONNECTION  
SCALE: 1/4"=1'-0"

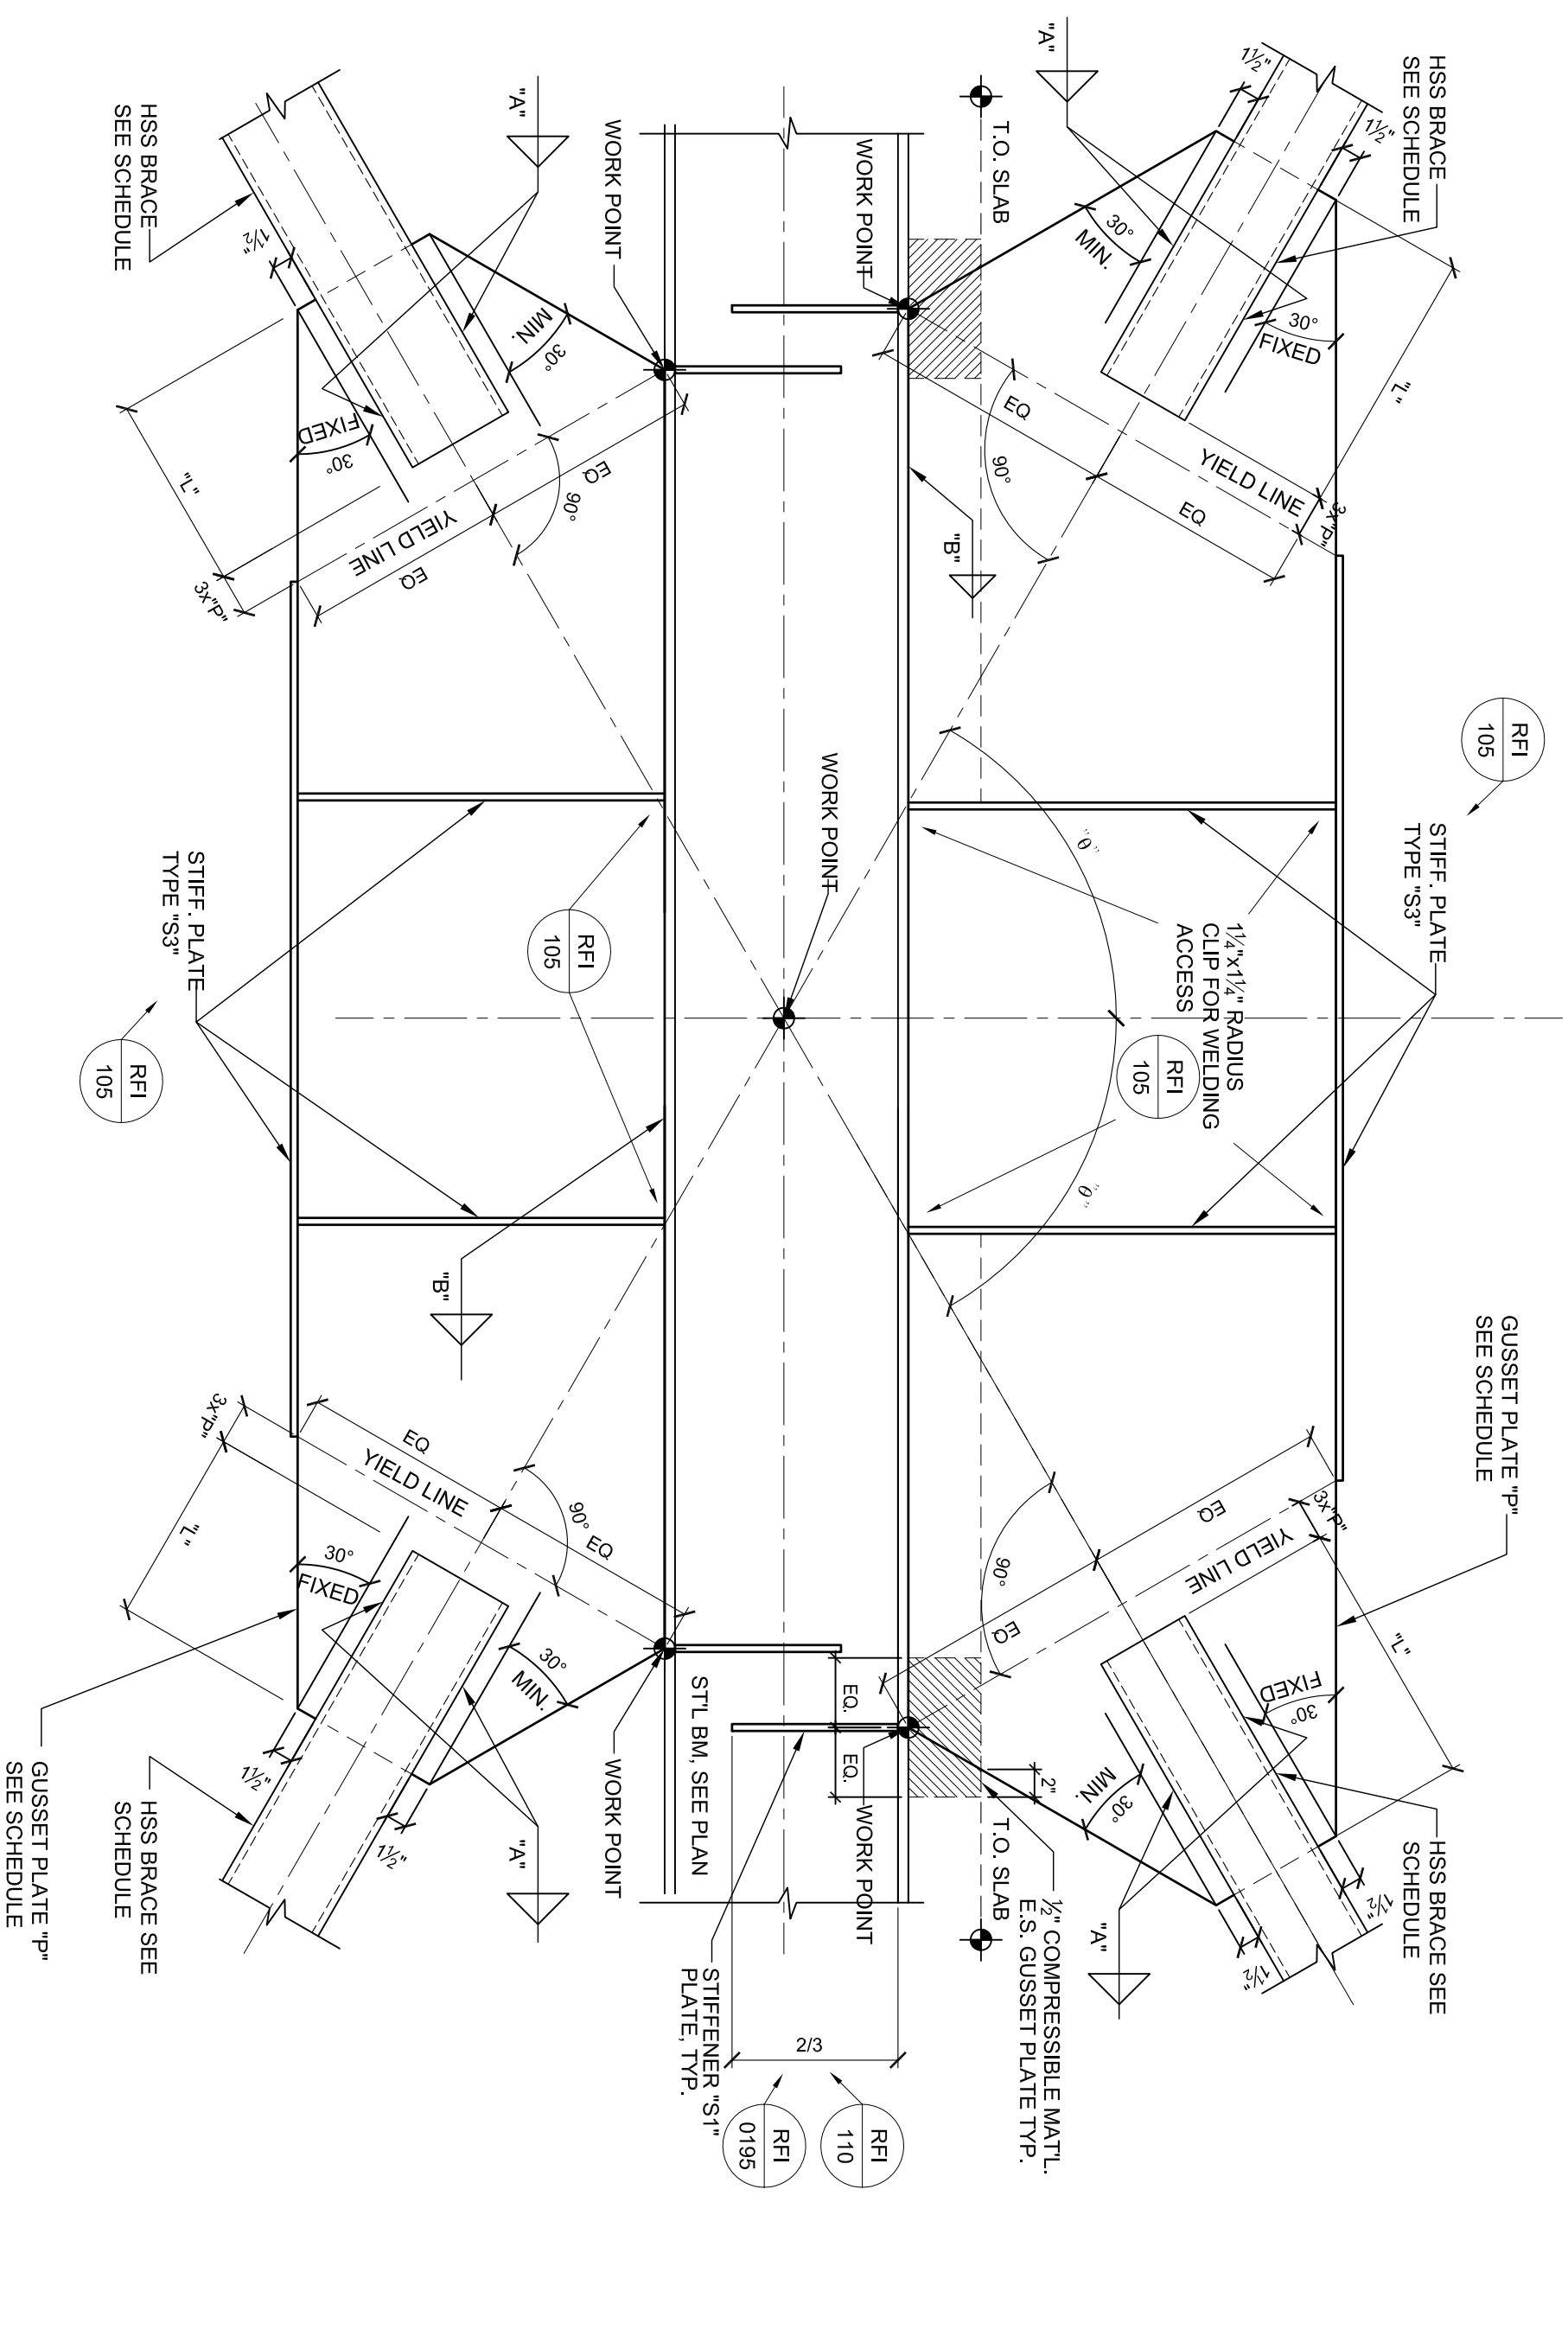

NOTE:  
LENGTH OF WELD 'C' IS PER SCHEDULE  
LENGTH OF WELD 'B' IS A MINIMUM PER  
THE SCHEDULE.  
SEE 161 FOR REINFORCEMENT PLATES


3 YIELD LINES START AT THE FLANGE OF BEAM/TOP OF FLOOR SLAB

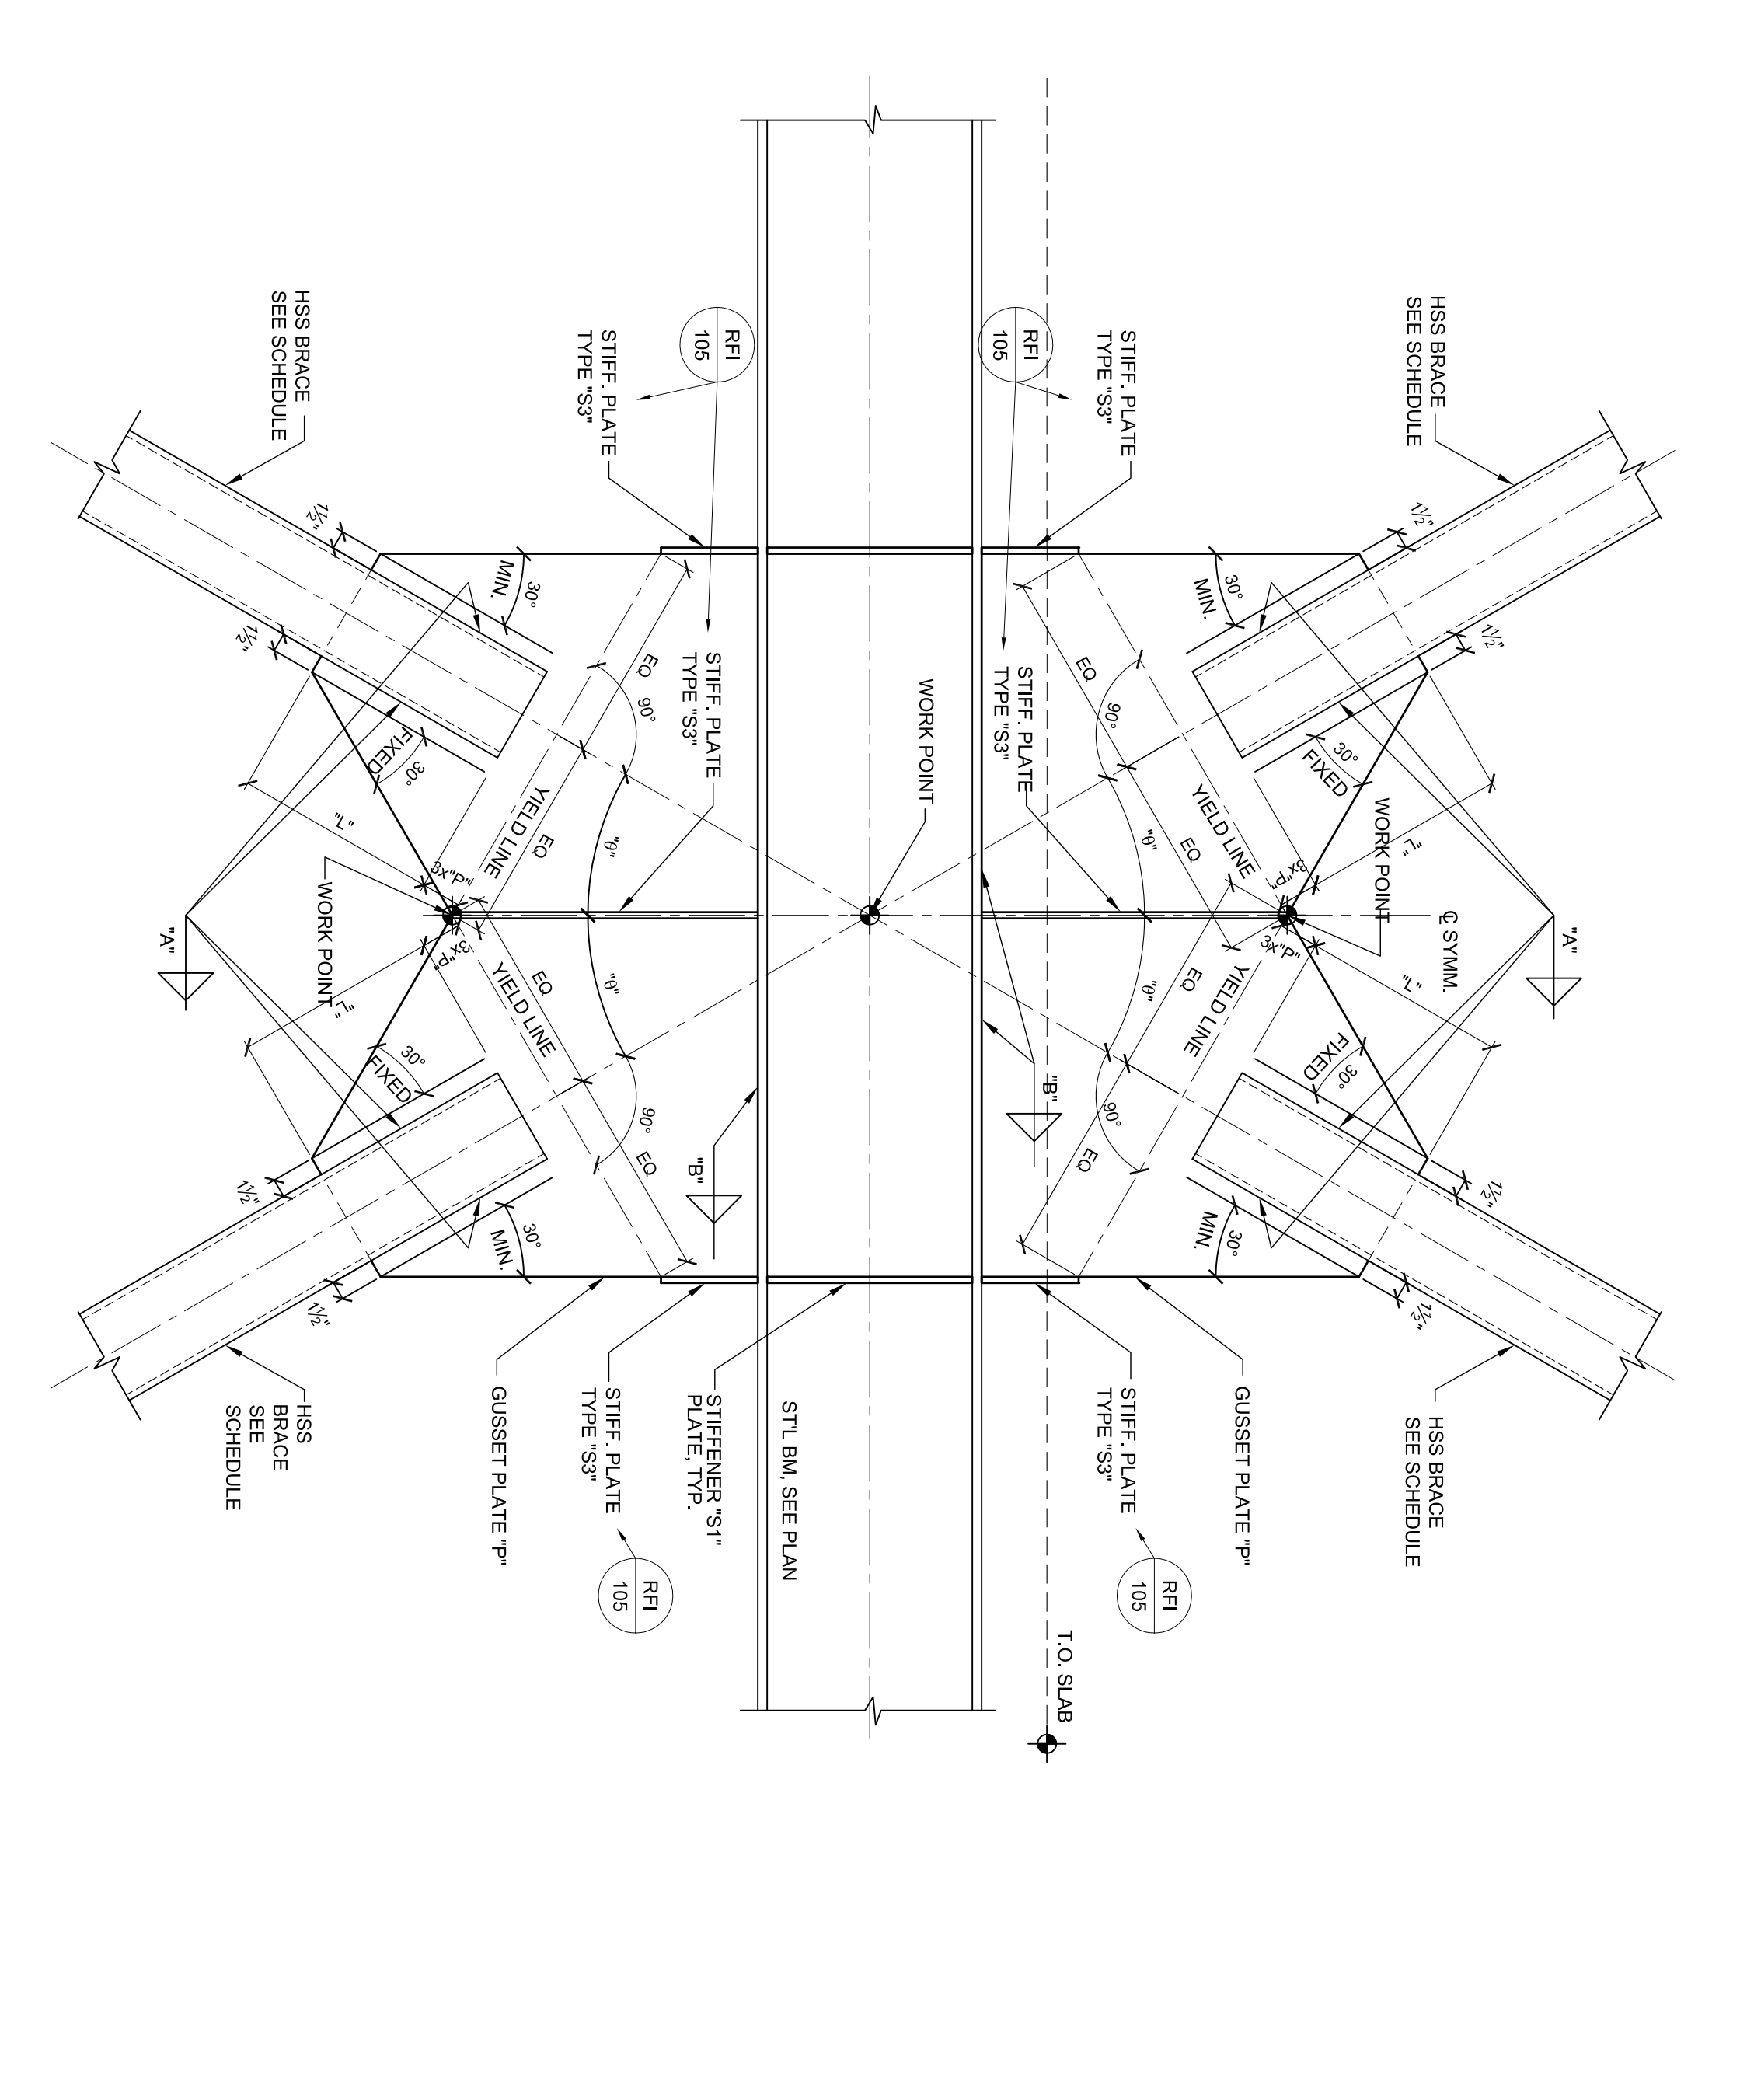

NOTE:  
LENGTH OF WELD 'C' IS PER SCHEDULE  
LENGTH OF WELD 'B' IS A MINIMUM PER  
THE SCHEDULE.


4 YIELD LINES START AT THE CENTERLINE OF GUSSET PLATES

12 TYPICAL TWO-SIDED BRACE TO BEAM CONNECTION  
SCALE: 1/4"=1'-0"

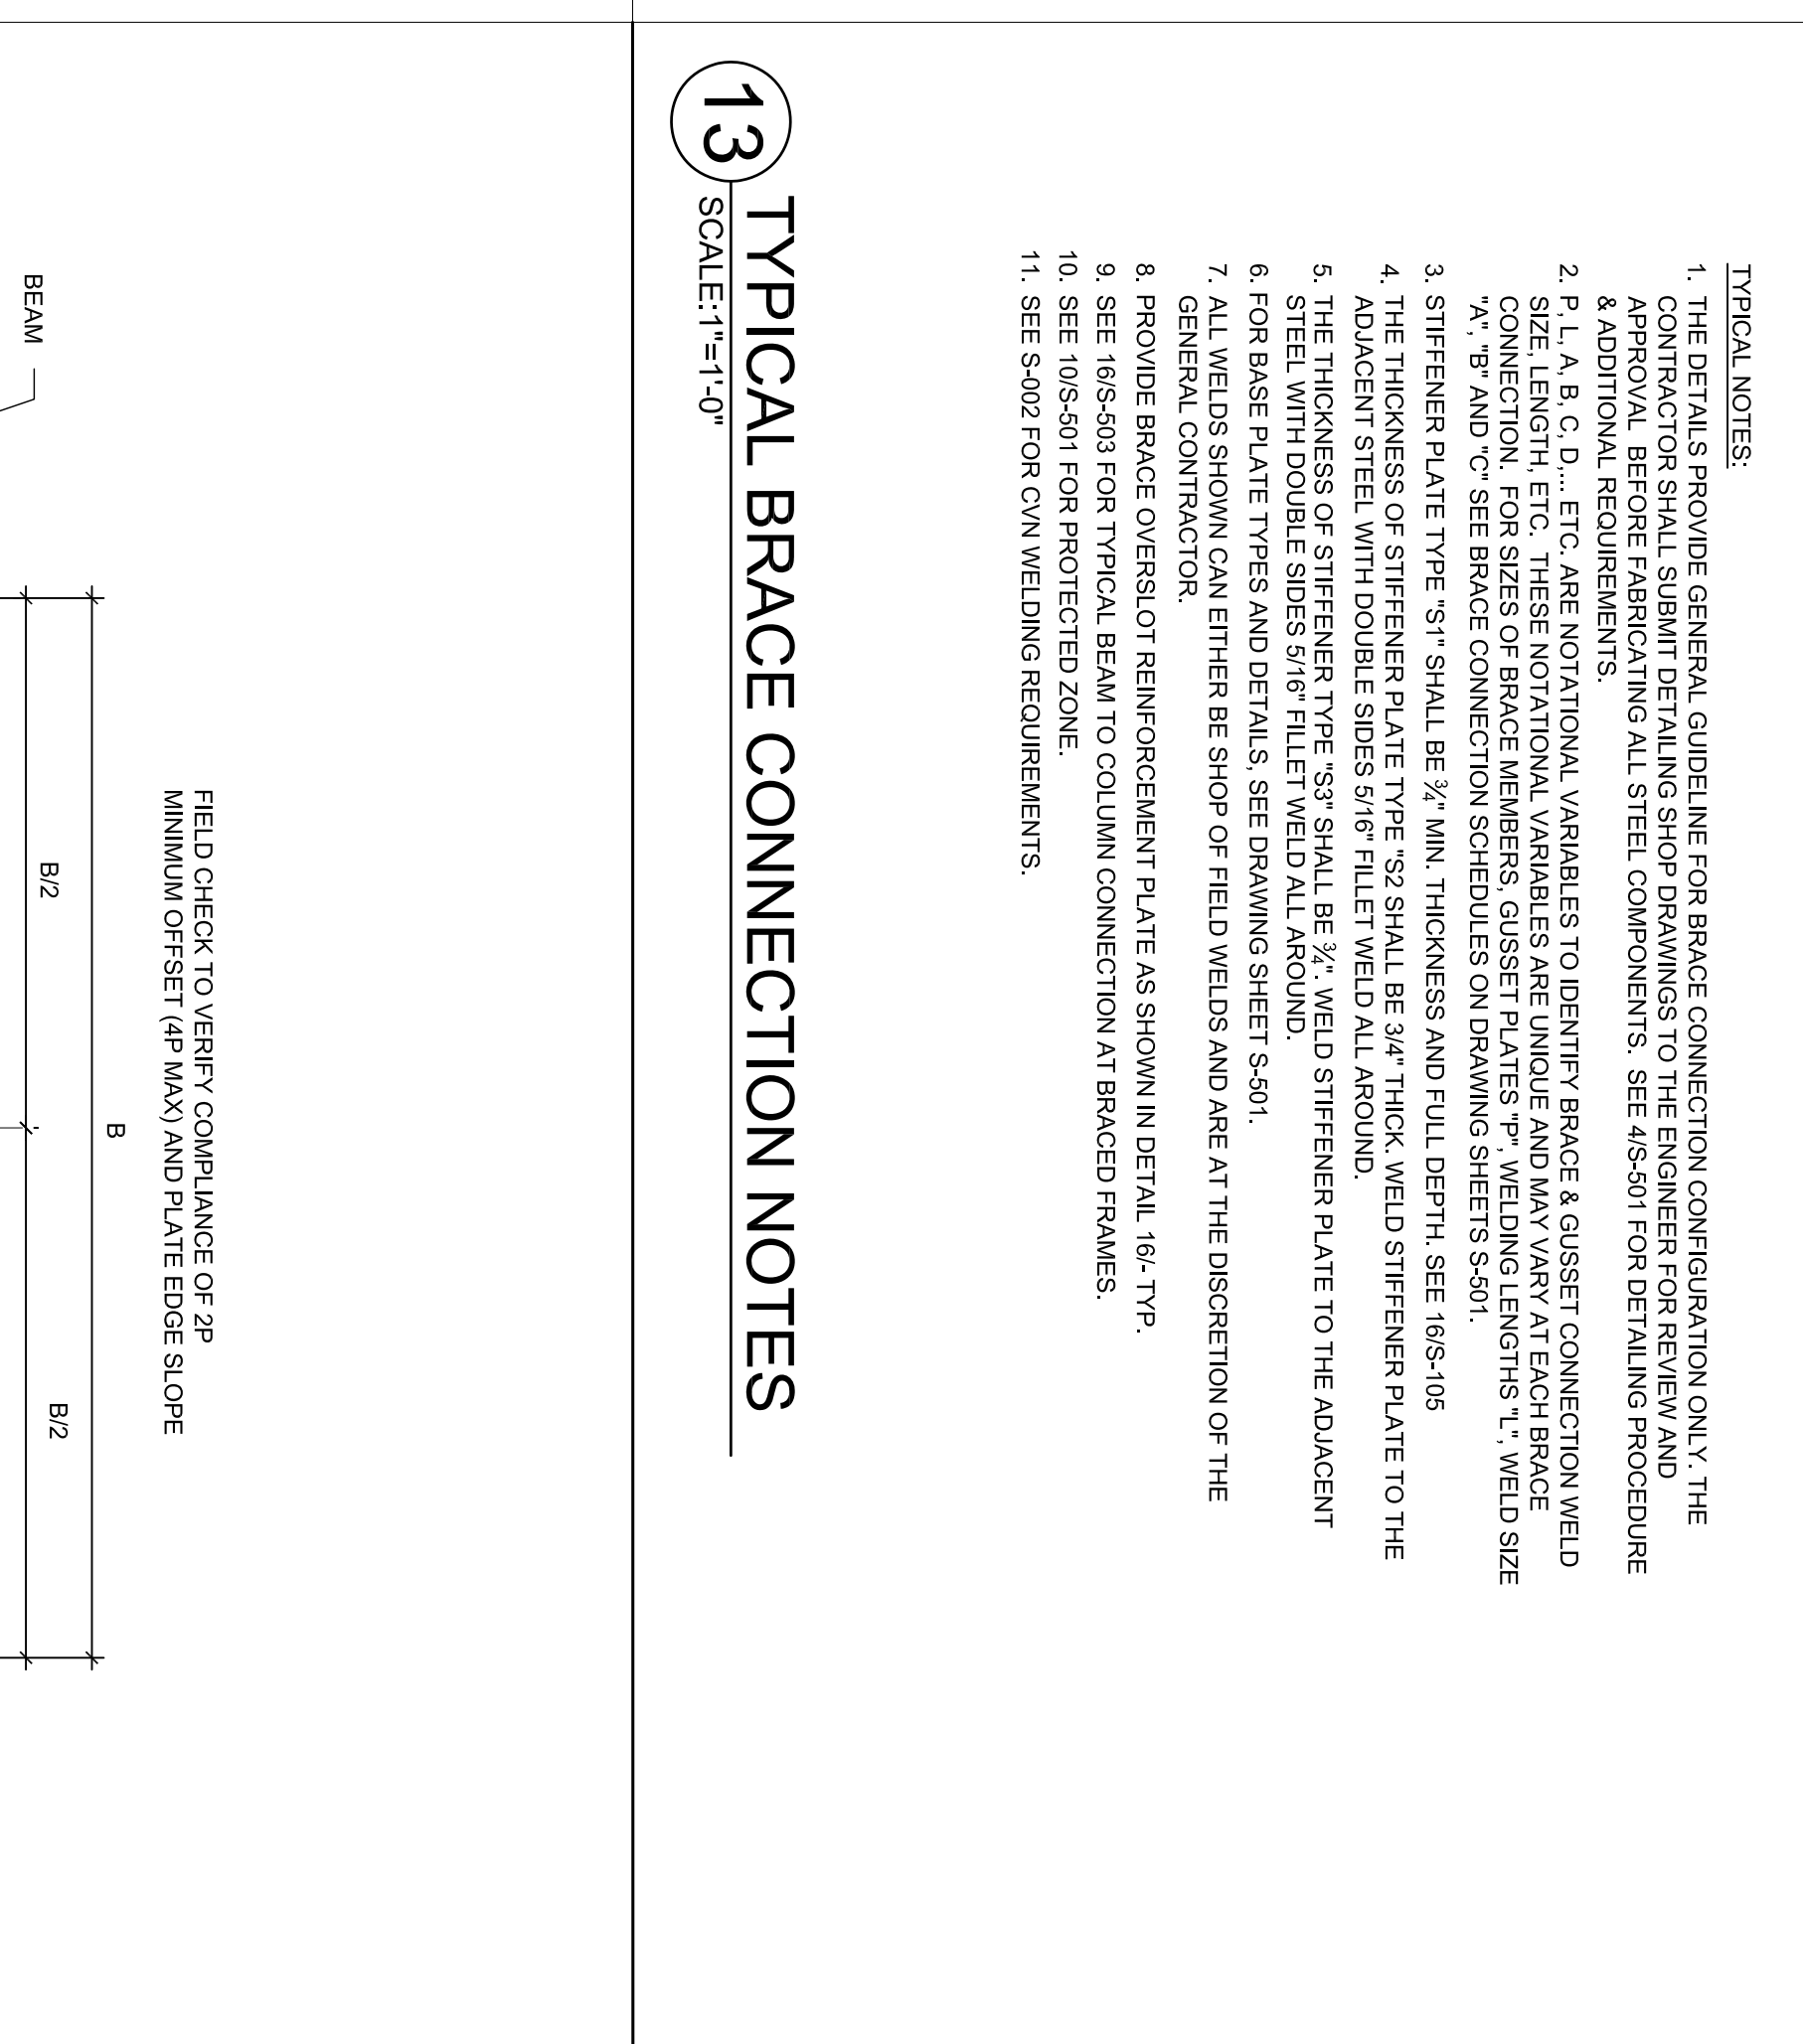

- TYPICAL NOTES:  
1. THE DETAILS PROVIDE GENERAL GUIDELINE FOR BRACE CONNECTION CONFIGURATION ONLY. THE CONTRACTOR SHALL SUBMIT DETAILED SHOP DRAWINGS TO THE ENGINEER FOR REVIEW AND APPROVAL BEFORE PROCEEDING.  
2. P, L, A, B, C, D, ETC. THESE NOTATIONAL VARIABLES ARE UNIQUE AND MAY VARY AT EACH BRACE SIZE, LENGTH, ETC. THESE NOTATIONAL VARIABLES ARE UNIQUE AND MAY VARY AT EACH BRACE SIZE, LENGTH, ETC.  
3. STIFFENER PLATE TYPE 'S1' SHALL BE 1/2" MIN. THICKNESS AND FULL DEPTH. SEE 165-105  
4. THE THICKNESS OF STIFFENER PLATE TYPE 'S2' SHALL BE 3/4" THICK WELD STIFFENER PLATE TO THE ADJACENT STEEL WITH DOUBLE SIDES 5/16" FILLET WELD ALL AROUND.  
5. THE THICKNESS OF STIFFENER TYPE 'S3' SHALL BE 1/2" WELD STIFFENER PLATE TO THE ADJACENT STEEL WITH DOUBLE SIDES 5/16" FILLET WELD ALL AROUND.  
6. FOR BASE PLATE TYPES AND DETAILS, SEE DRAWING SHEET S-501.  
7. ALL WELDS SHOWN CAN EITHER BE SHOP OF FIELD WELDS AND ARE AT THE DISCRETION OF THE GENERAL CONTRACTOR.  
8. PROVIDE BRACE OVERSLOT REINFORCEMENT PLATE AS SHOWN IN DETAIL 161-TYP.  
9. SEE 165-503 FOR TYPICAL BEAM TO COLUMN CONNECTION AT BRACED FRAMES.  
10. SEE 105-501 FOR PROTECTED ZONE.  
11. SEE S-502 FOR FOM WELDING REQUIREMENTS.

13 TYPICAL BRACE CONNECTION NOTES  
SCALE: 1/4"=1'-0"

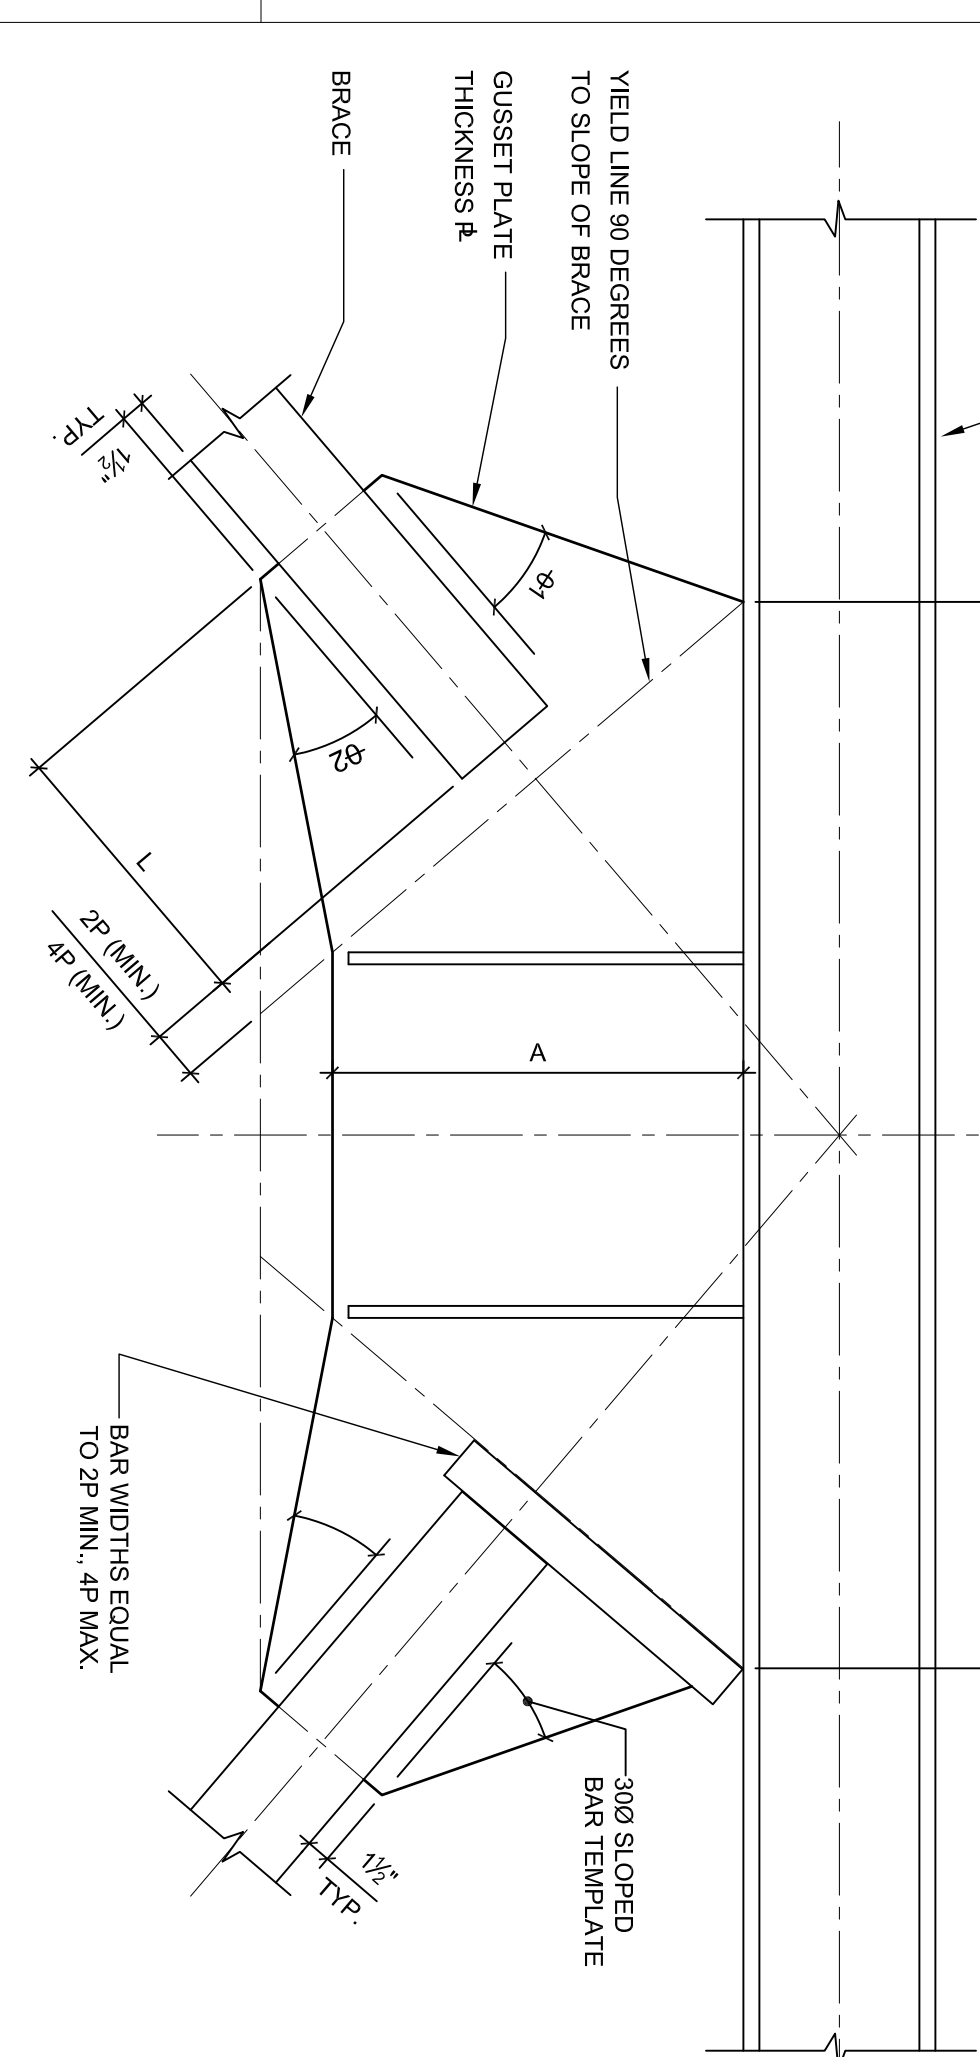

FIELD CHECK TO VERIFY COMPLIANCE OF 2P  
MINIMUM OFFSET (4P MAX) AND 30° EDGE SLOPE

4P = 30° MINIMUM  
4P = 30° FIXED


- 'CORNER OF BAR SHOULD INTERSECT WITH EDGE OF GUSSET PLATE PRIOR TO HITTING BEAM FLANGE

FIELD CHECK NOTES

INSPECTION OF RECORD TO VERIFY:

- 1. THAT THE 2P MINIMUM (4P MAX) OFFSET IS MAINTAINED EACH END OF BRACE BEFORE WELDING OF BRACE AND AFTER WELDING OF BRACE (WELDS ARE SHOWN BY FIELD OF BRACE (4P MAX)).
- 2. VERIFY 1/2° OFFSET AND ANGLE SLOPE ALONG EDGE OF GUSSET PLATE.
- 3. ISOLATION OF GUSSET PLATE YIELD LINE FROM SLAB (IF DETAILED) AND STIFFENER PLATE LOCATIONS PER DET. 289.2.
- 4. DISCUSS INSPECTION CRITERIA WITH STRUCTURAL ENGINEER PRIOR TO WELDING OF BRACES.

15 FIELD CHECKS  
SCALE: 1/4"=1'-0"

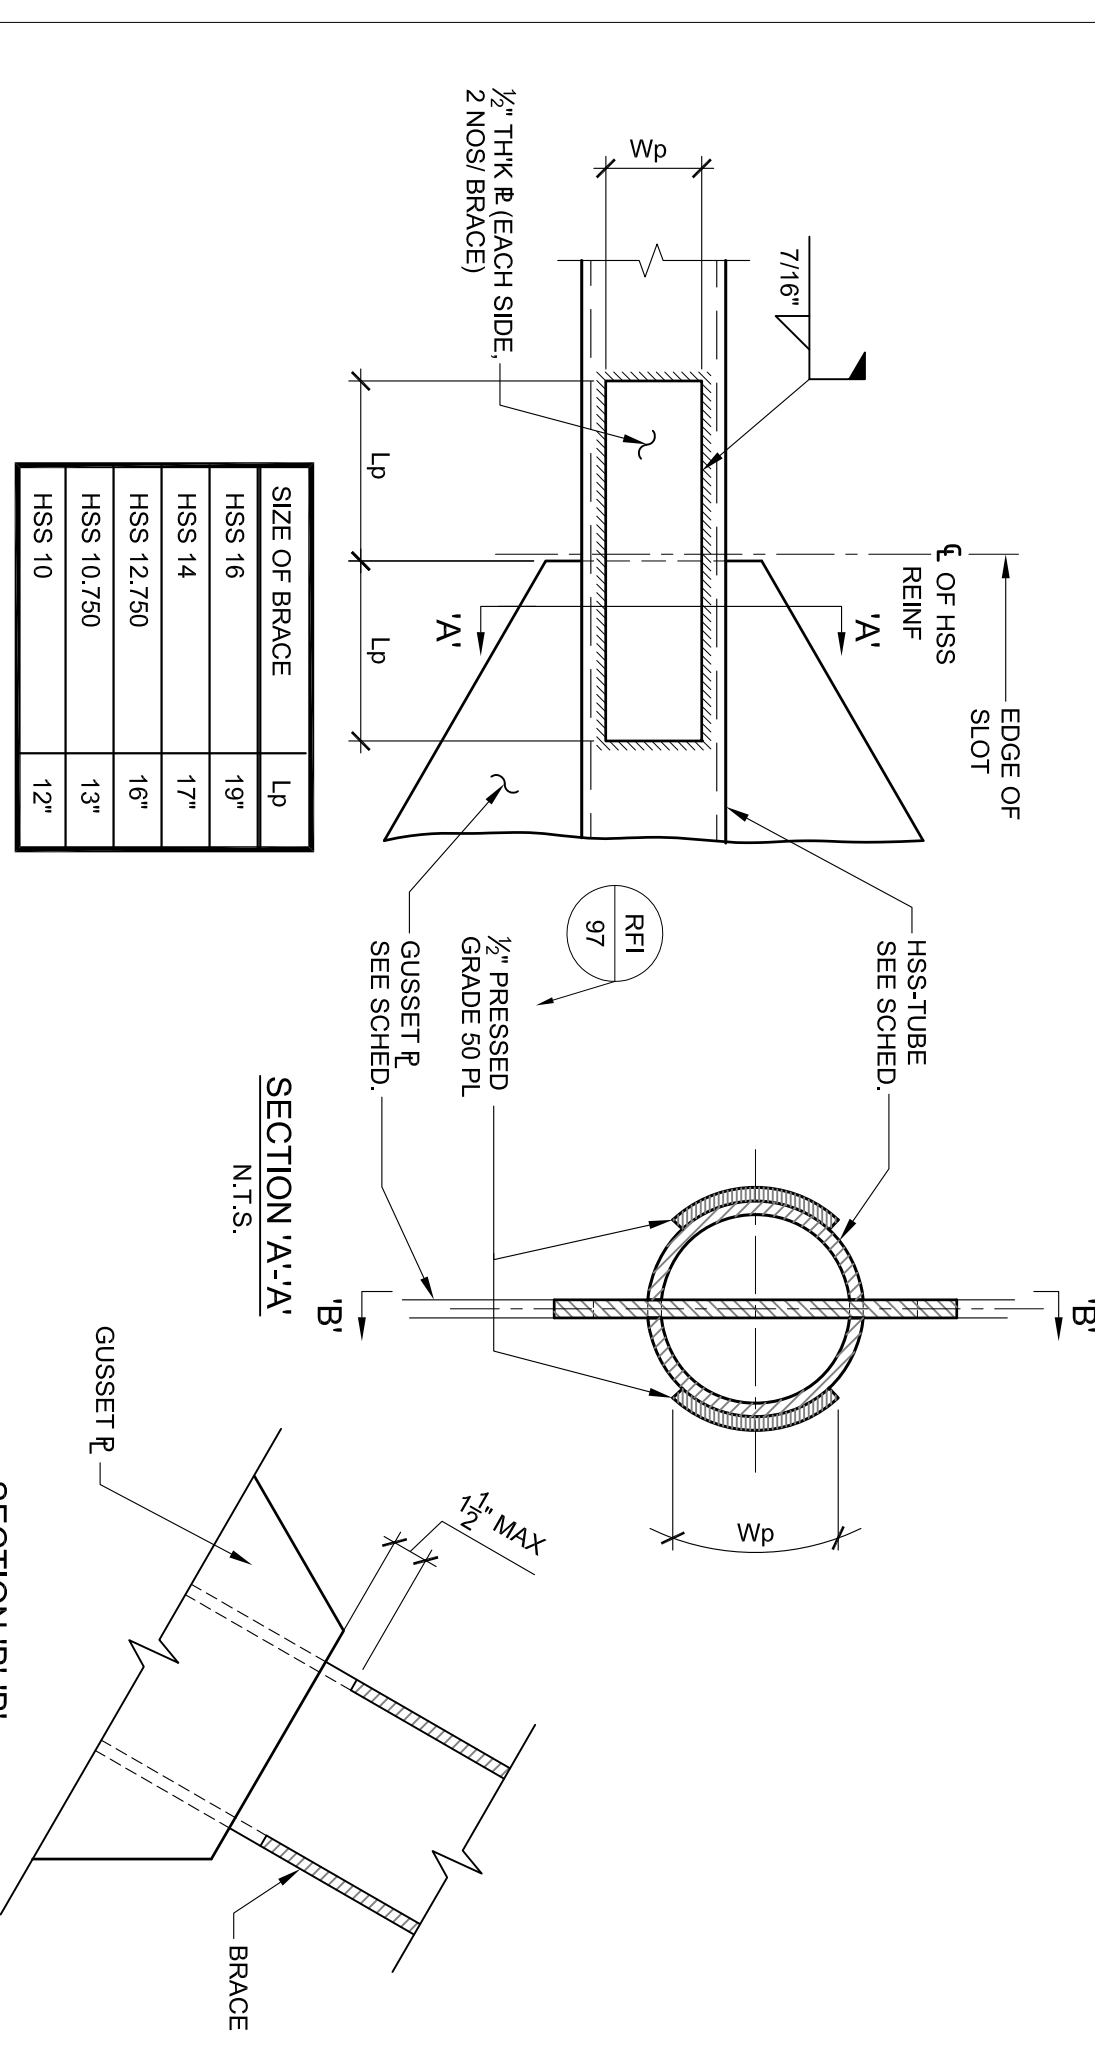

SIZE OF BRACE

HSS 16	18"
HSS 14	17"
HSS 12/20	16"
HSS 10/20	13"
HSS 10	12"

NOTE: BRACE OVER-SLOT NOT TO EXCEED 1 1/2". SEE B'-B'


16 BRACE OVER-SLOT REINFORCEMENT PLATE  
SCALE: 1/4"=1'-0"




**PROJECT RECORD SET**

**SKYLINE COLLEGE**  
 SAN MATEO COUNTY  
 COMMUNITY COLLEGE  
 DISTRICT  
**CIP2 DESIGN-BUILD PROJECT BUILDING 4**  
 2015.07.20

SHEET TITLE:  
**BRACE FRAME BEAM TO COLUMN CONNECTION DETAILS**  
 PROJECT NO. 0701240 DRAWN BY: AV  
 DATE: 03/08/09 CHECKED BY: CB  
 SCALE: \_\_\_\_\_

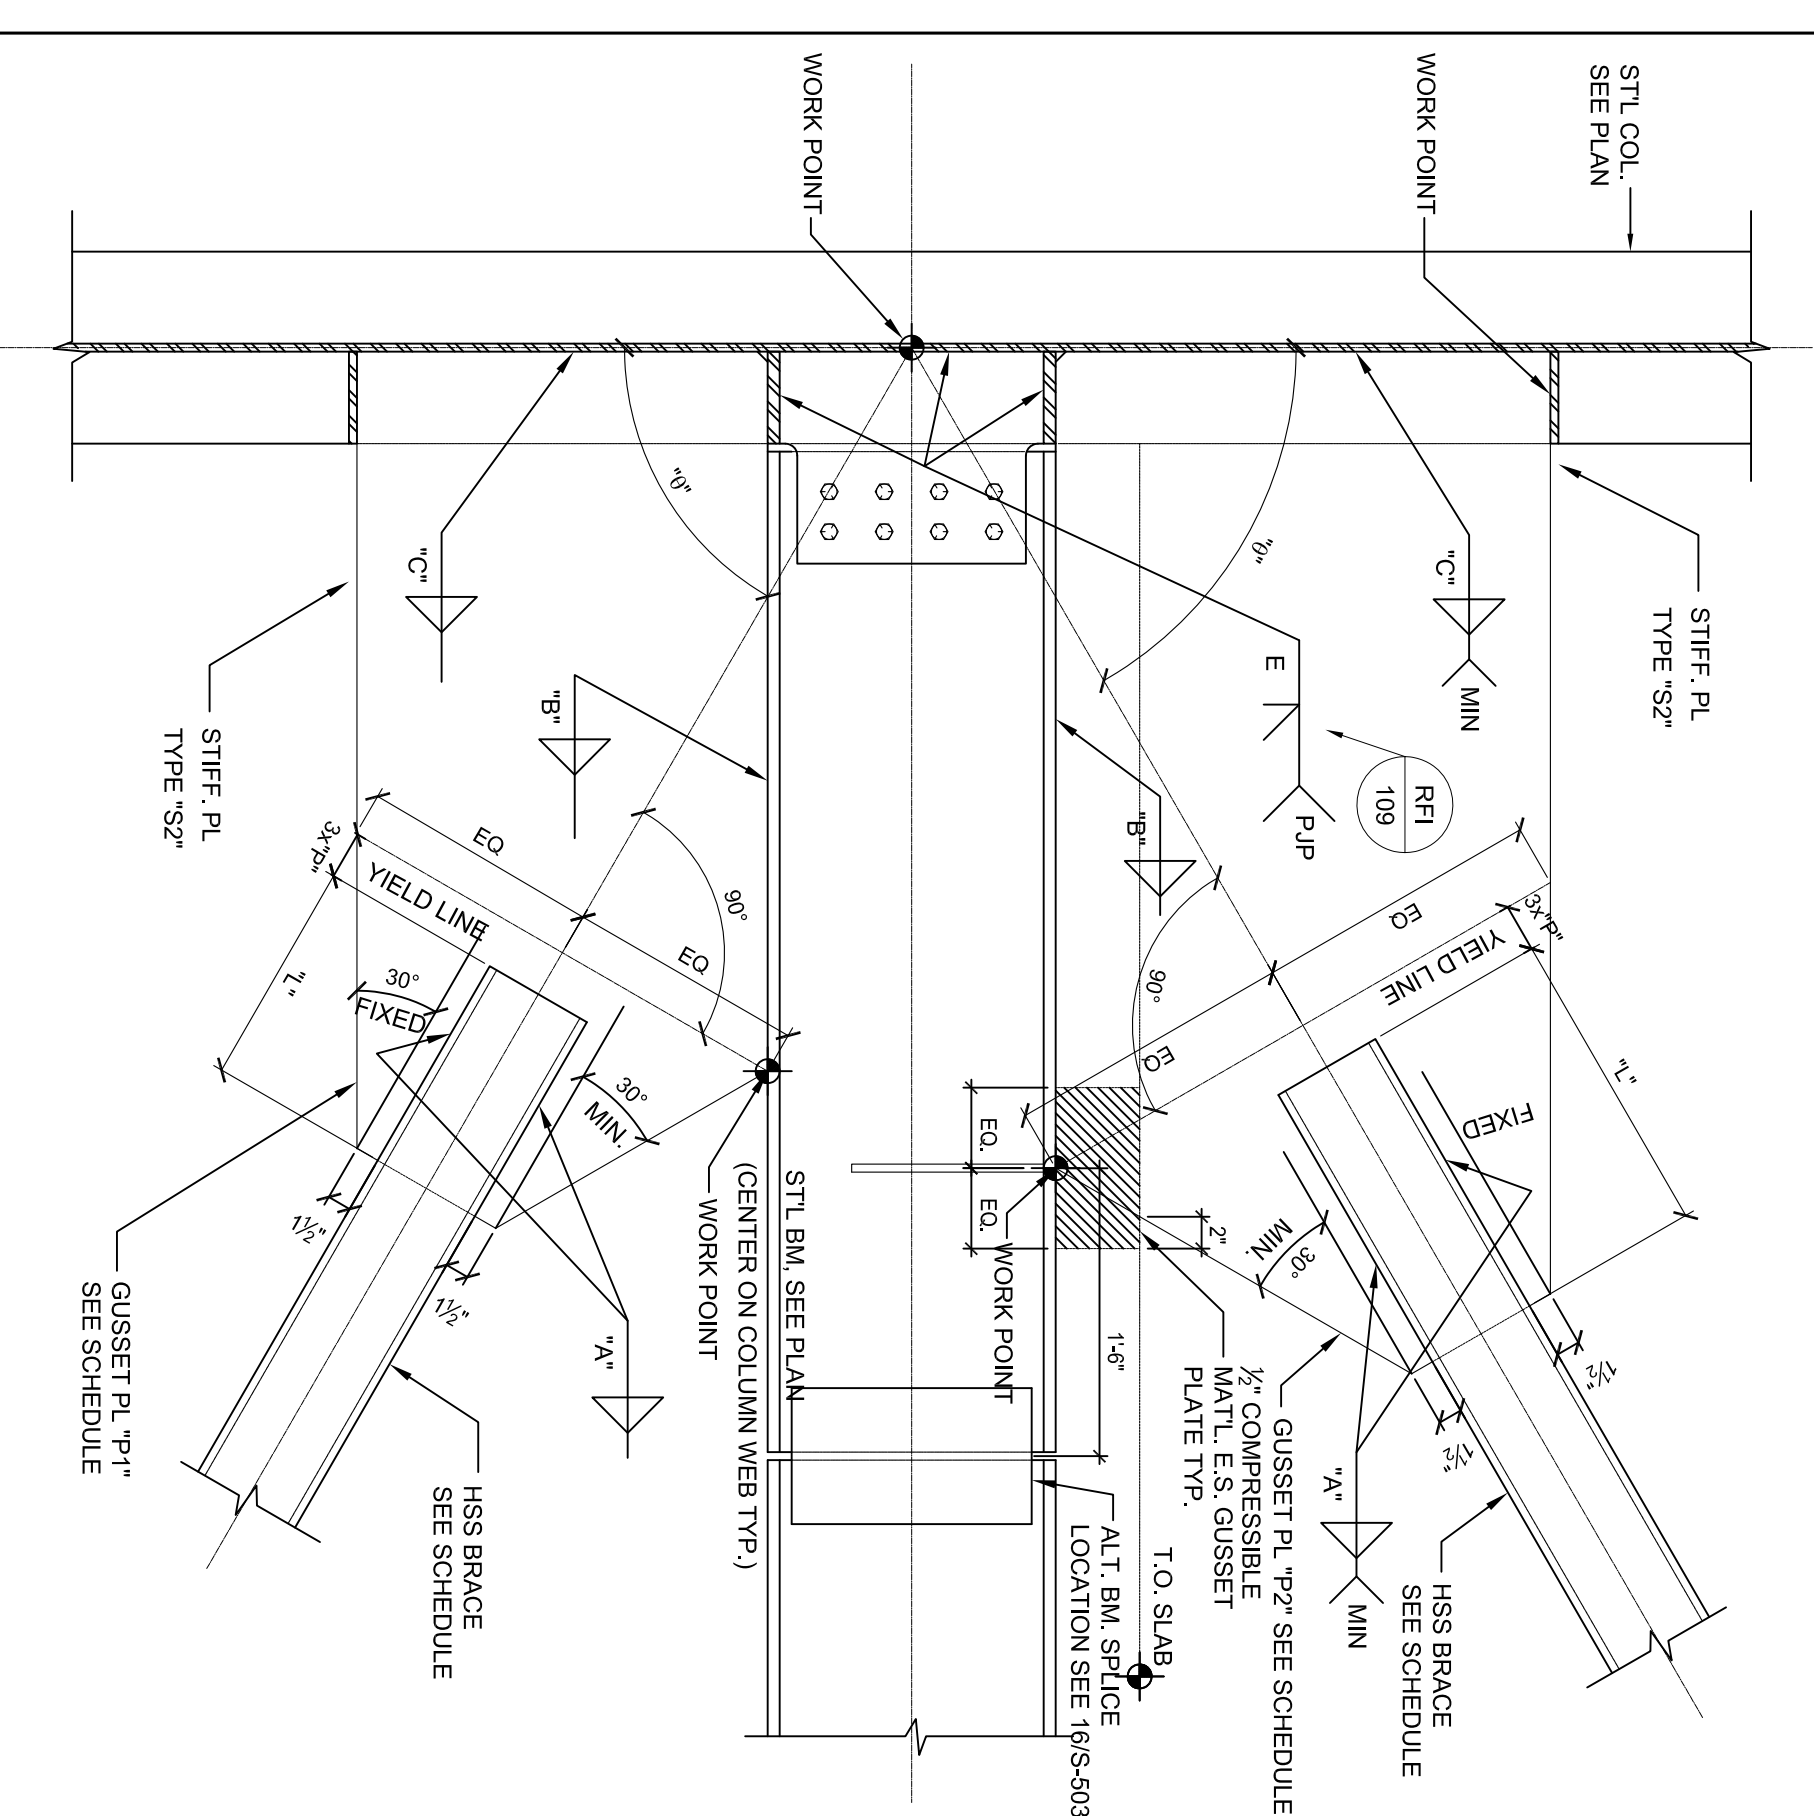


**a** YIELD LINES START AT THE TOP OF FLOOR SLAB/FRANGE OF BEAM

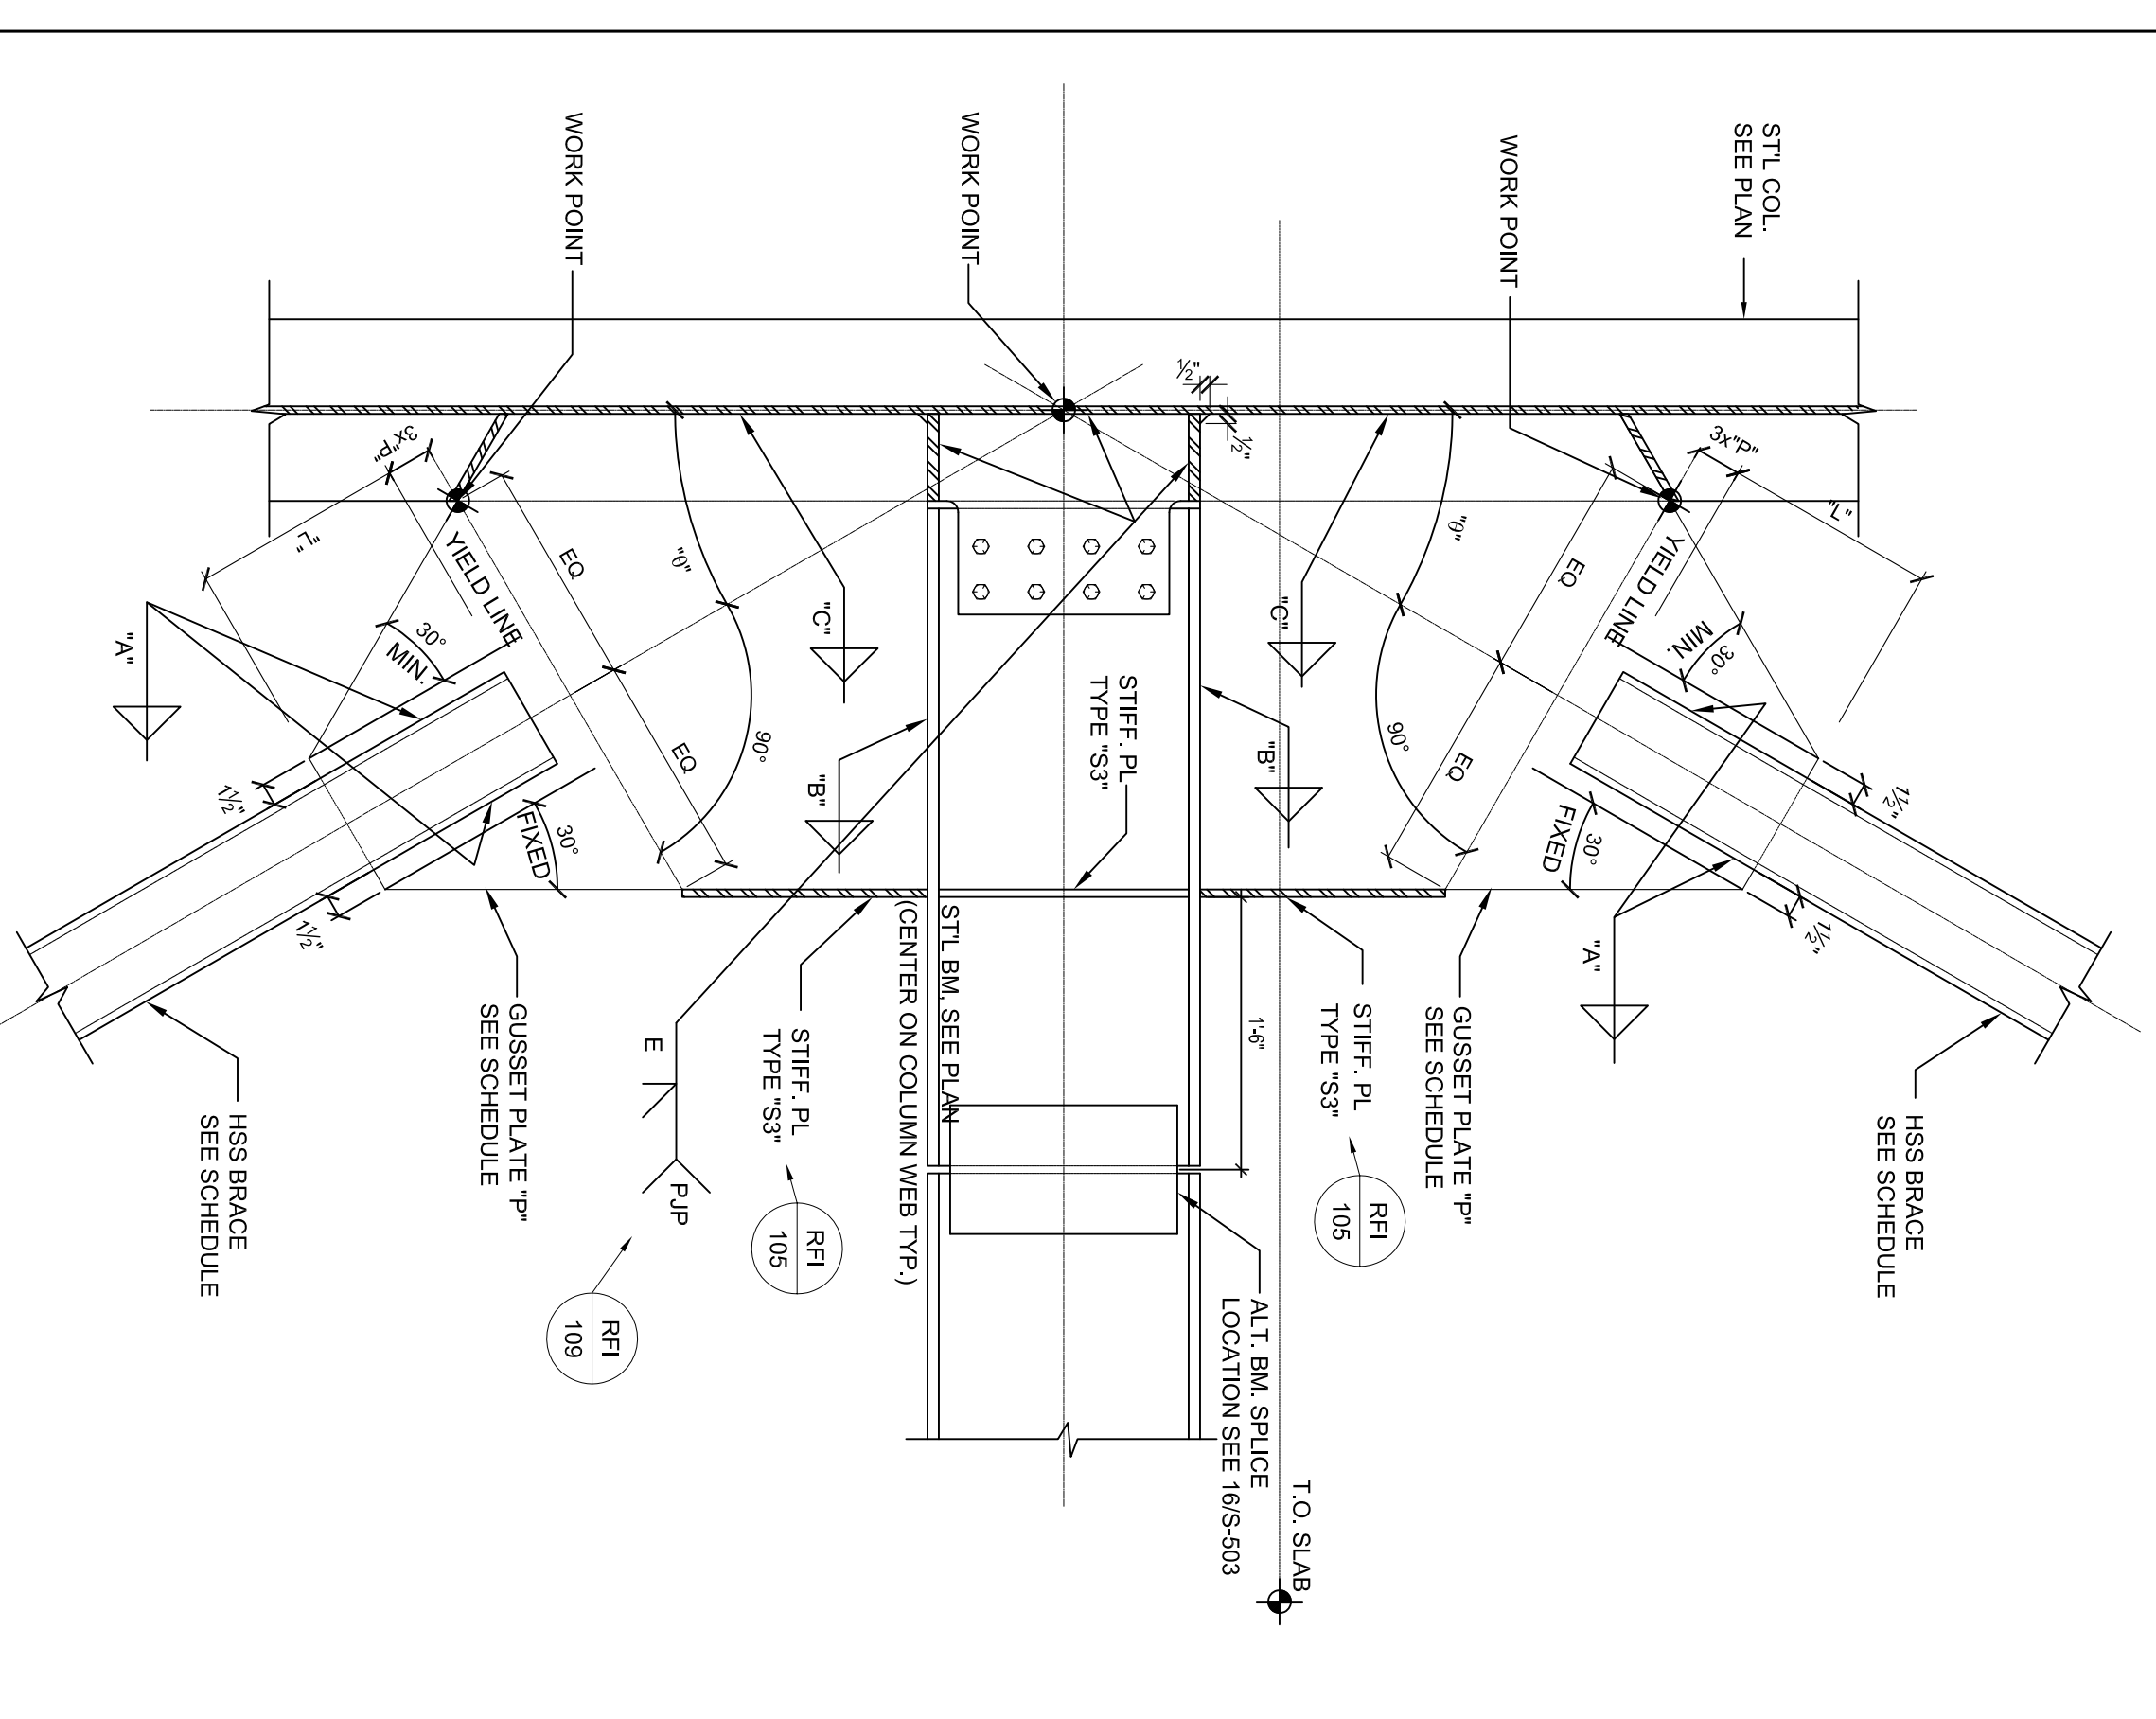


**b** YIELD LINES START AT THE FLANGE OF COLUMN

**4** TYPICAL BRACE TO BEAM/COLUMN (WEAK AXIS)  
 SCALE: 1"=1'-0"




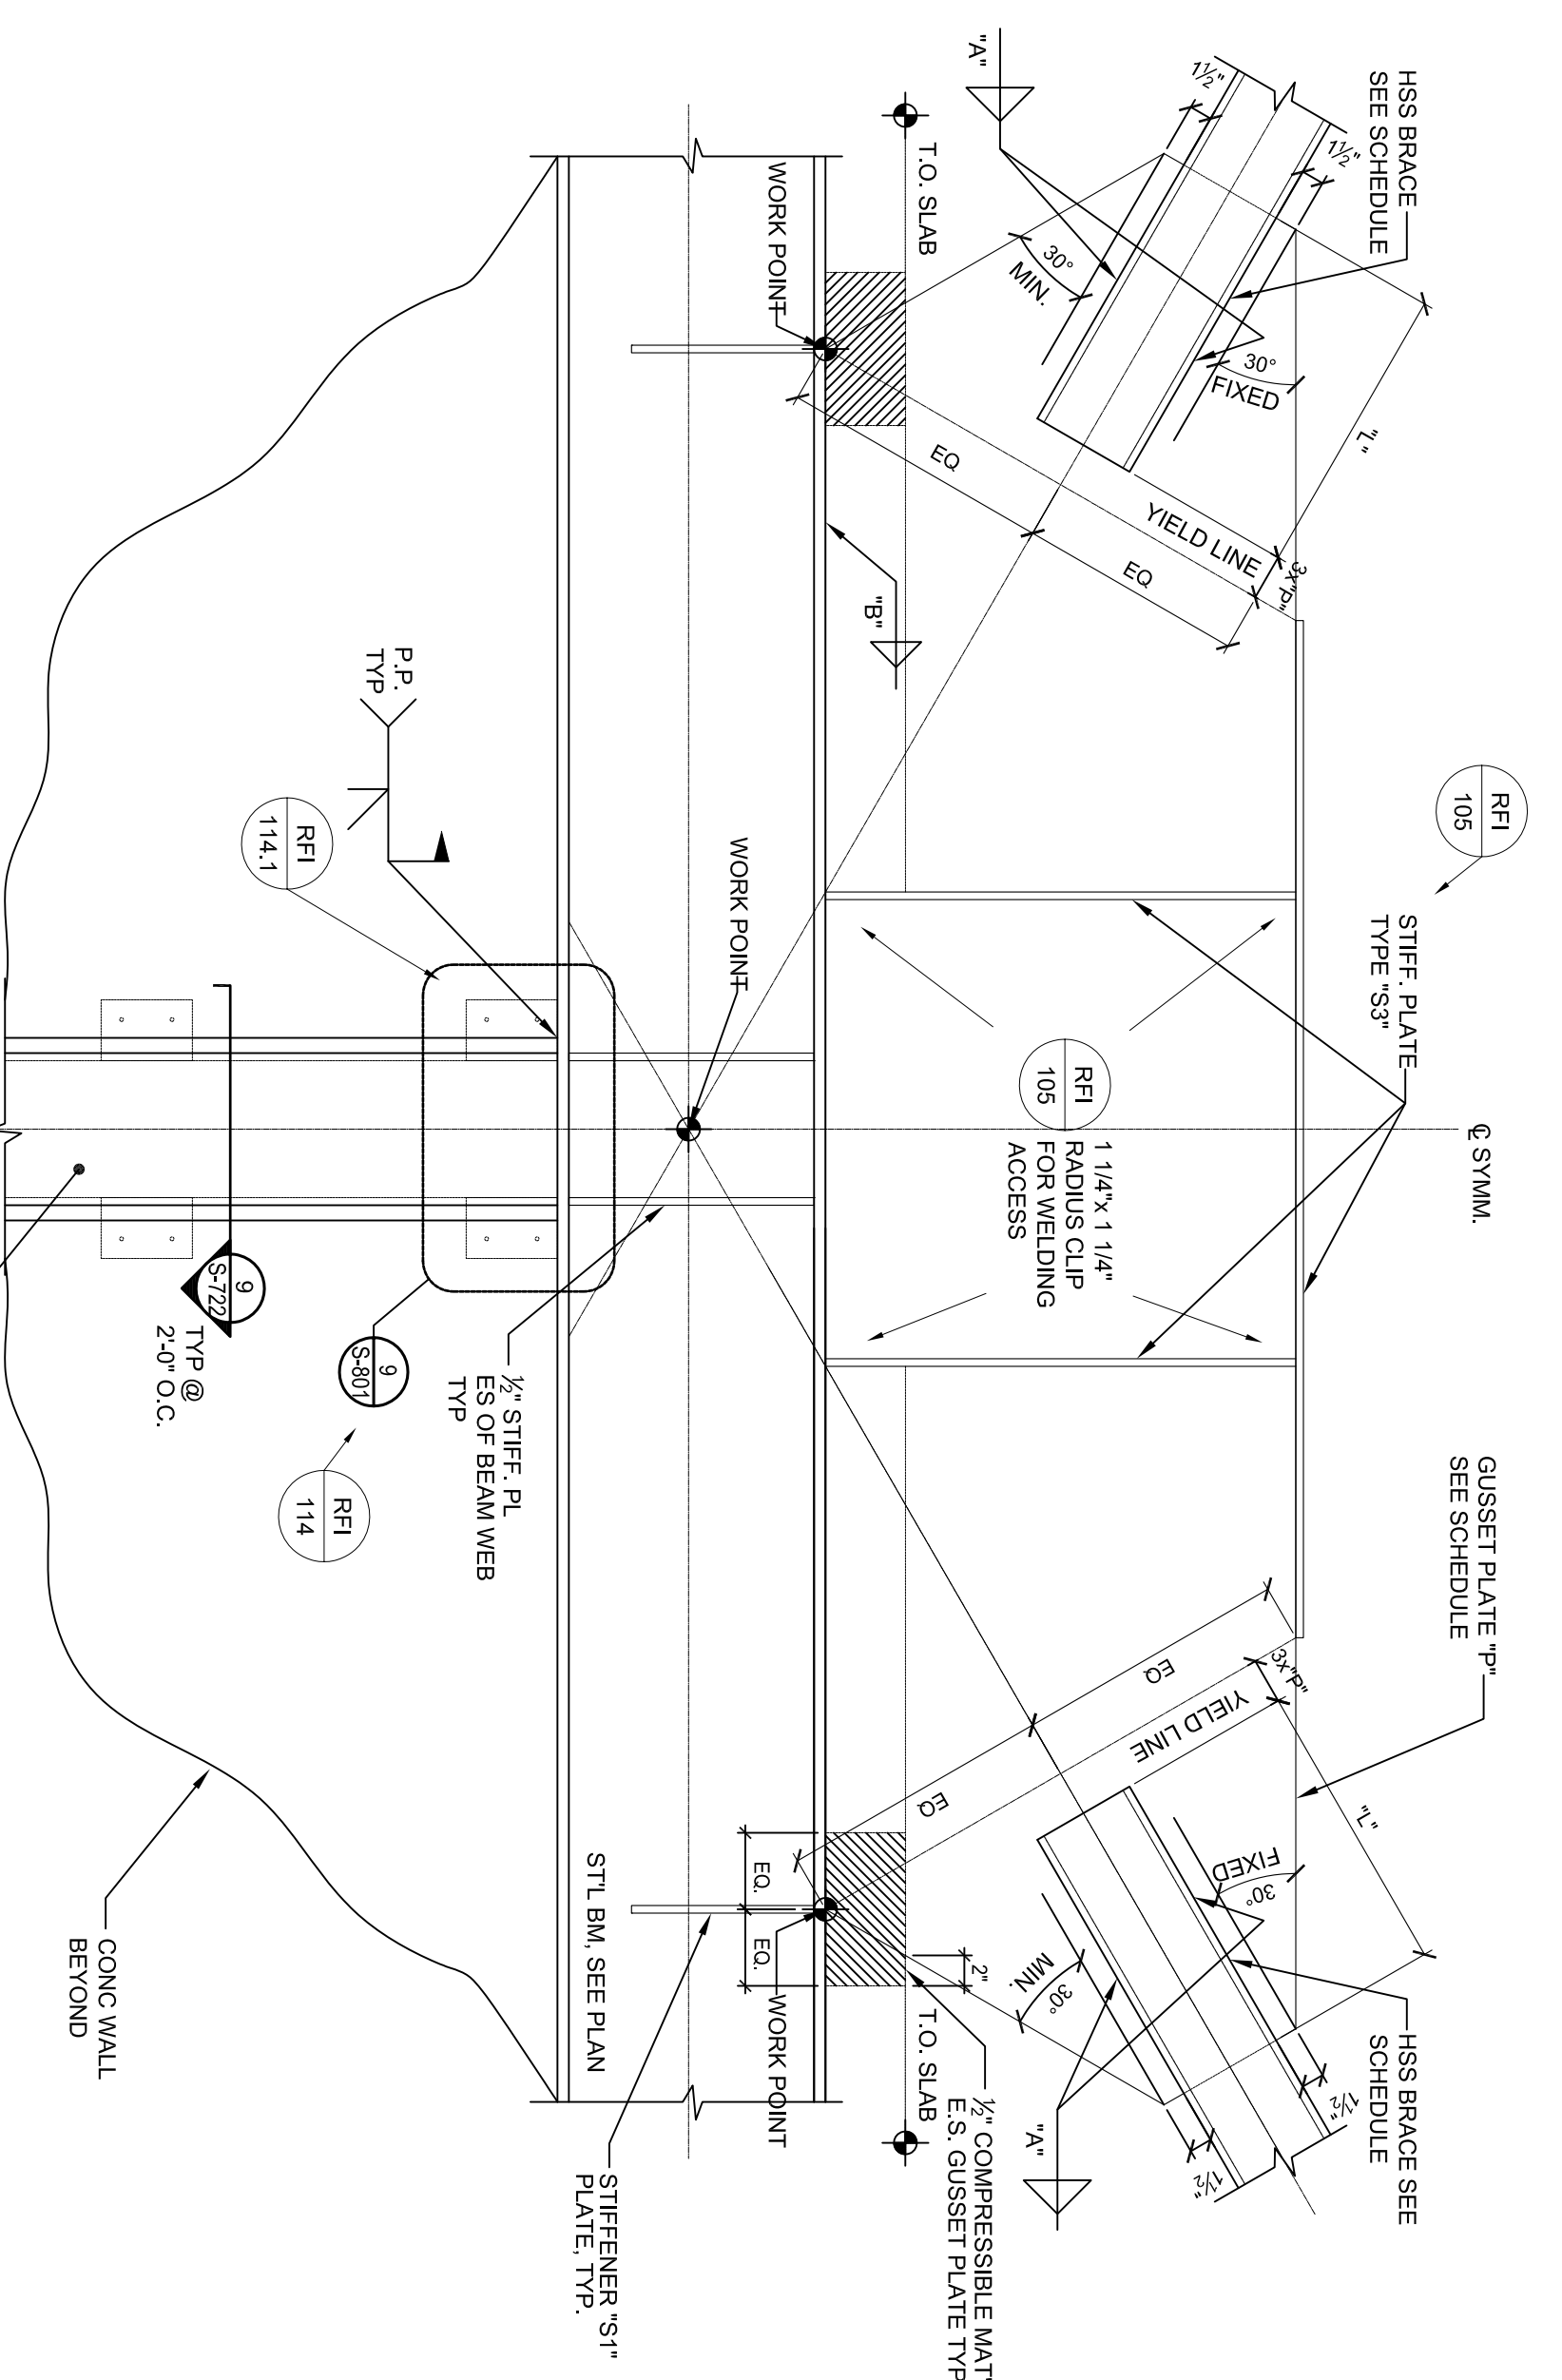


**a** YIELD LINES START AT THE FLANGE OF BEAM/THE TOP OF FLOOR SLAB

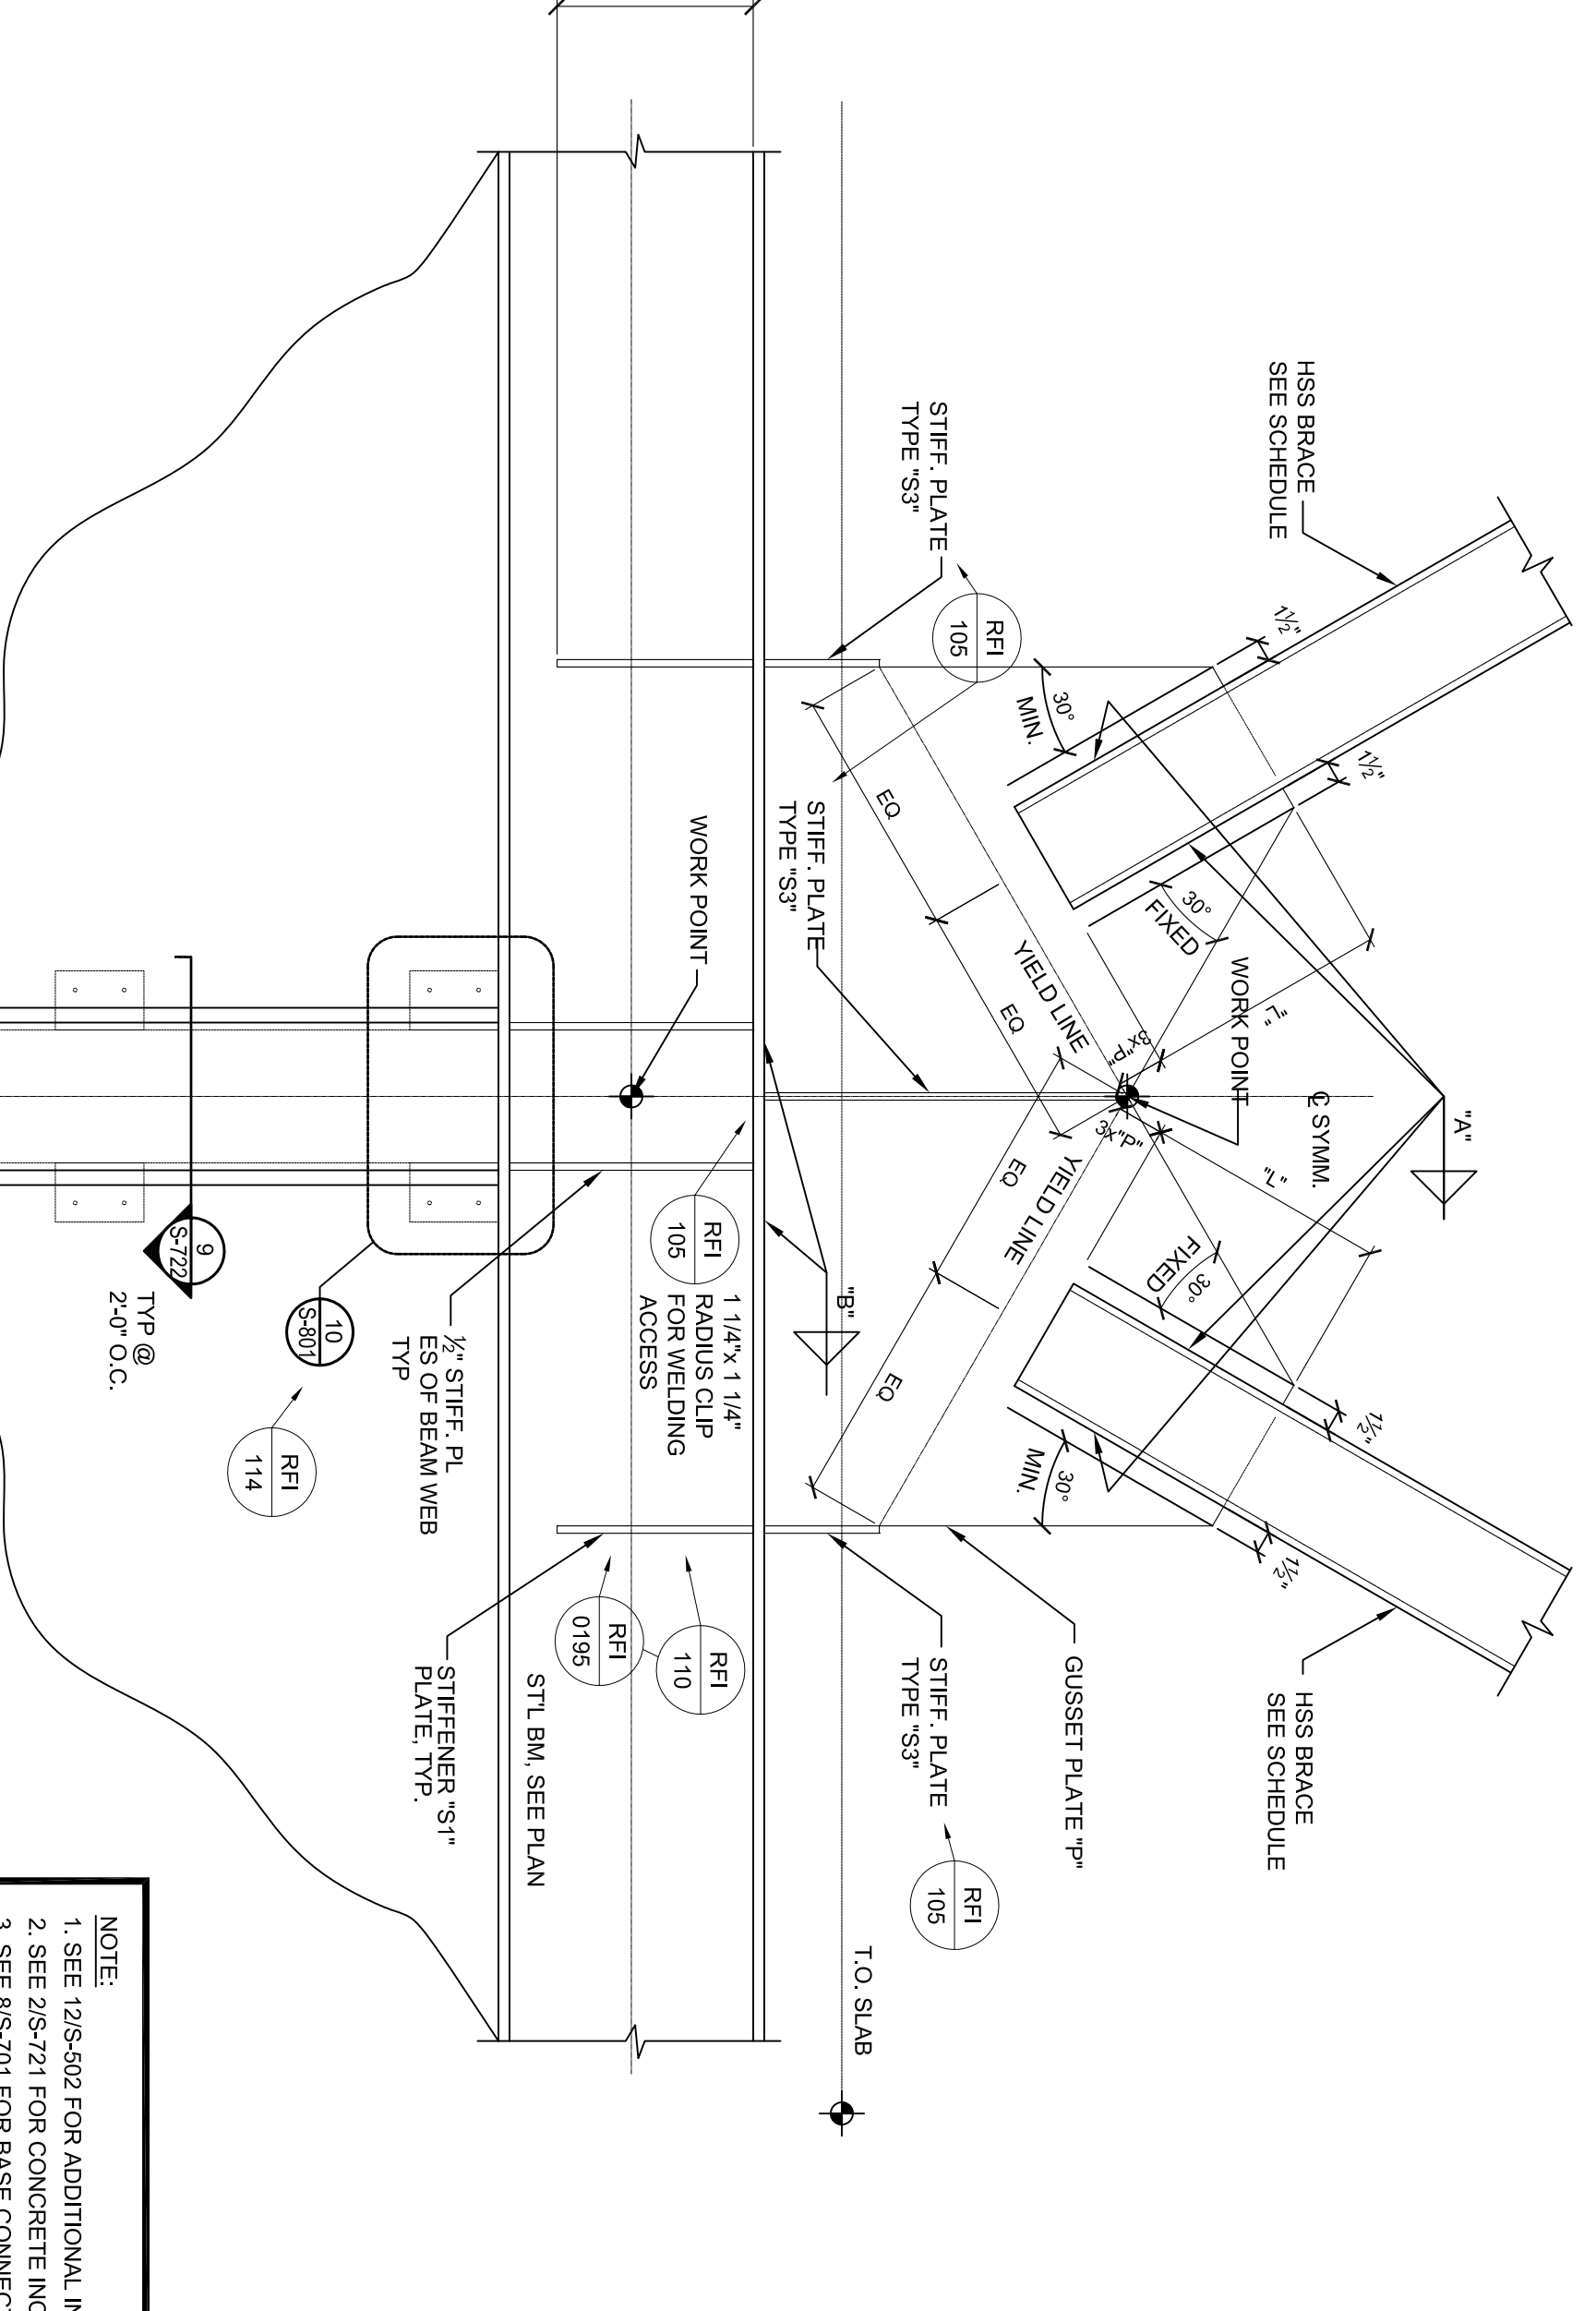

**b** YIELD LINES START AT THE CENTER LINE OF GUSSET PLATES

**12** TYPICAL TWO-SIDED BRACE TO BEAM CONNECTION WITH COLUMN  
 SCALE: 1"=1'-0"

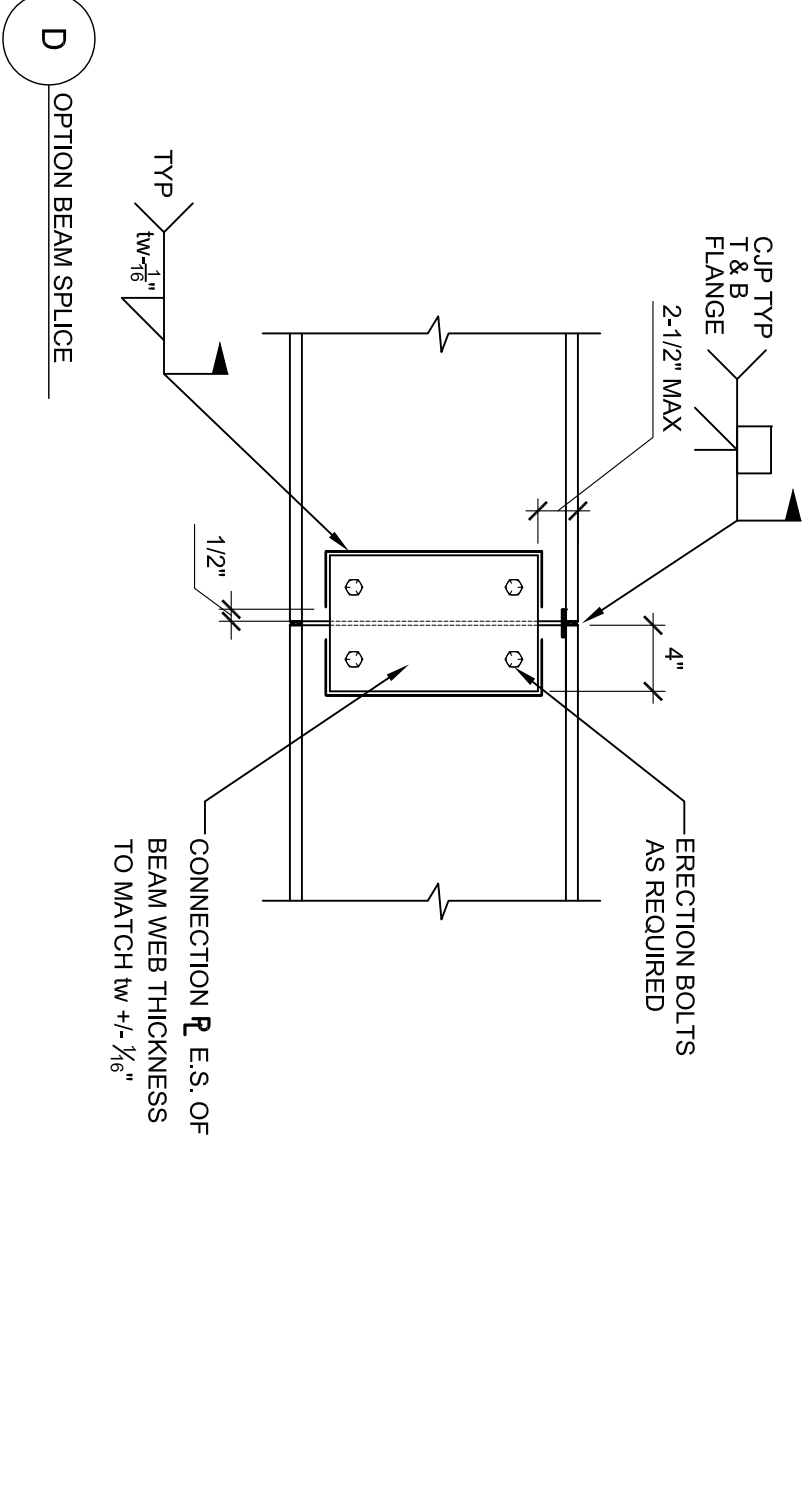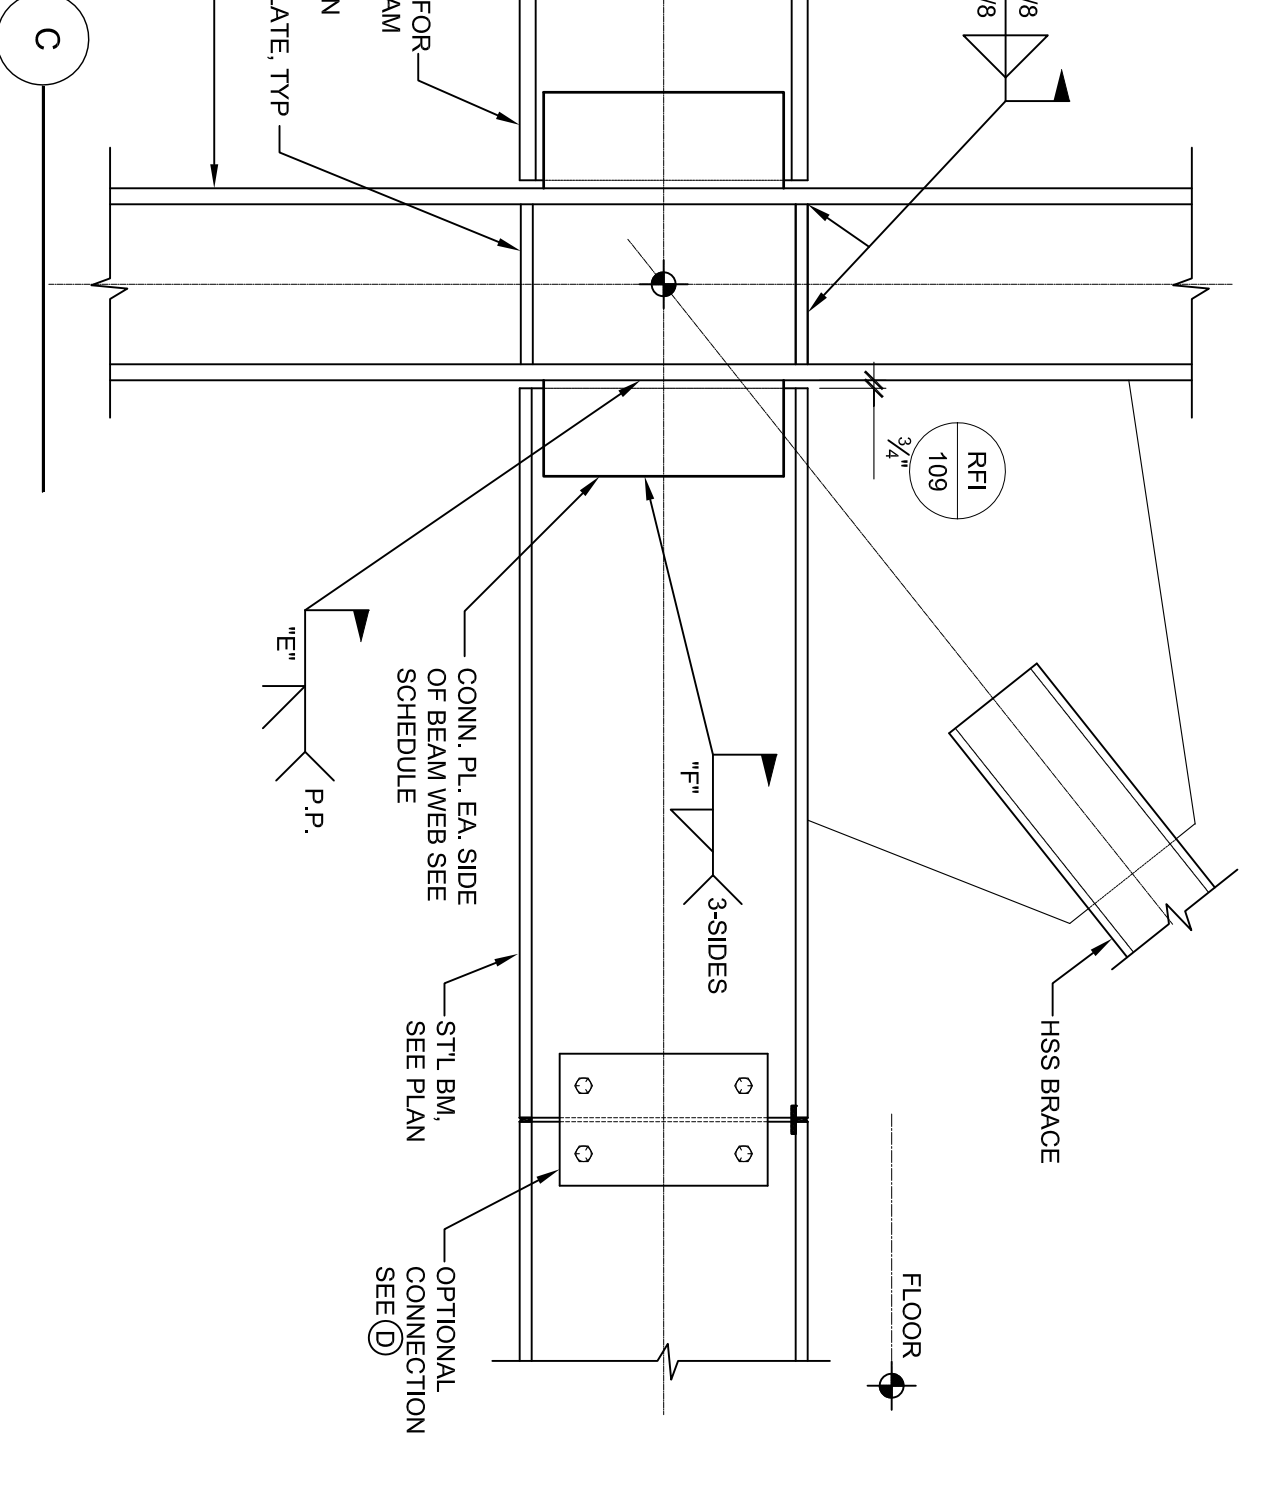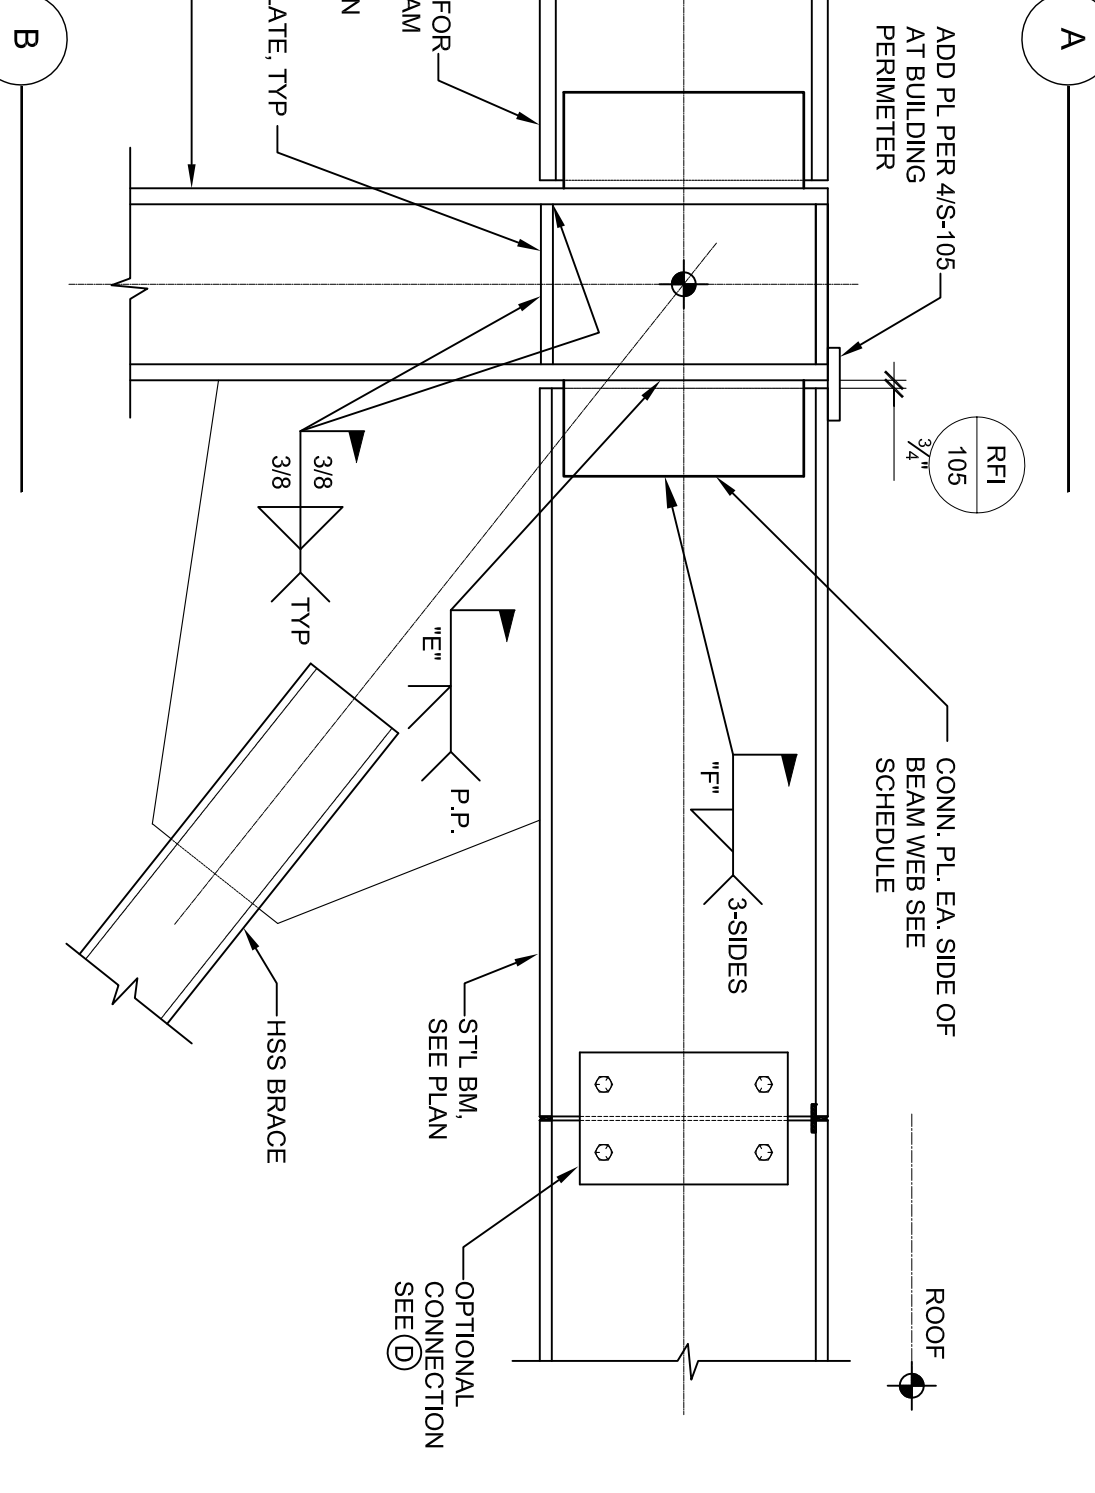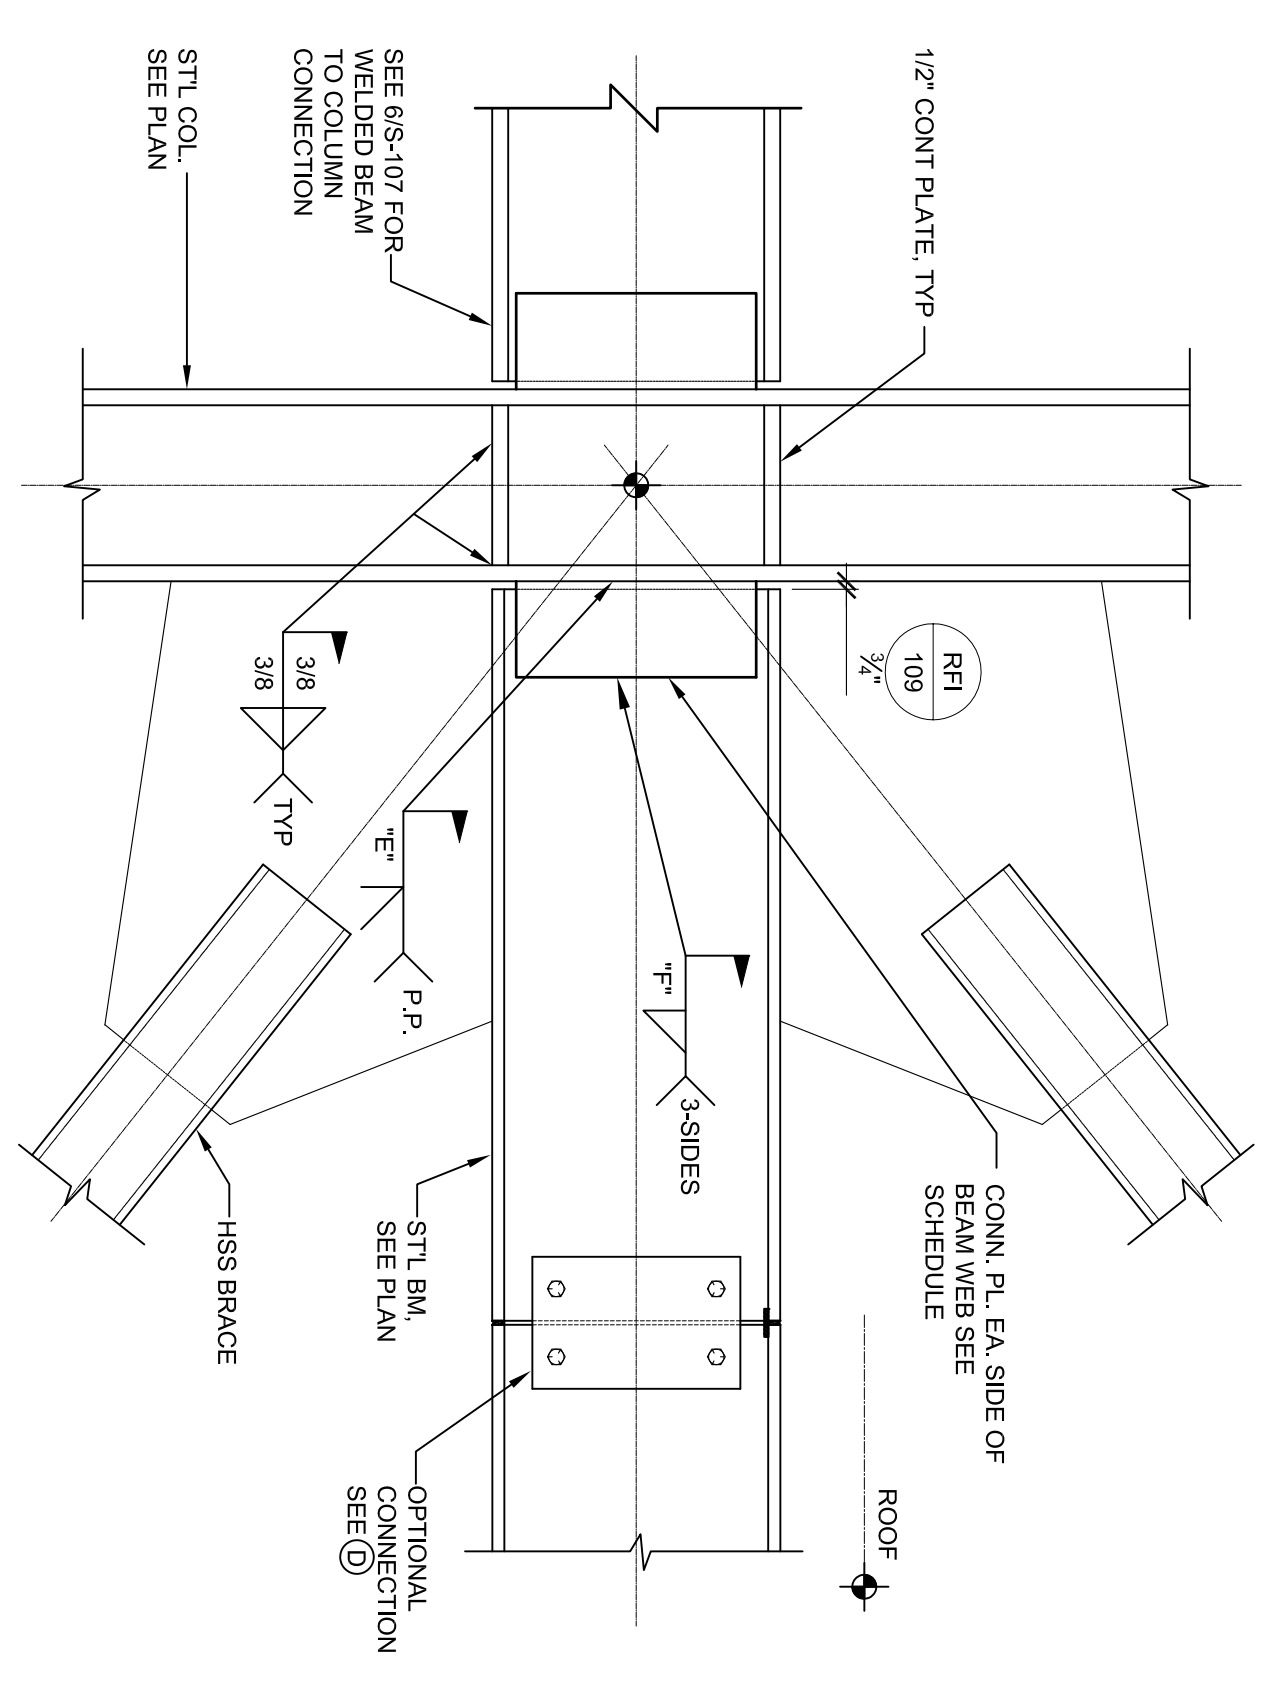


- NOTES:**  
 1. SEE S-401 - S-403 FOR ADDITIONAL BRACE INFORMATION.  
 2. ALL CONNECTION PLATES ARE GRADE 50.


**FRAME BEAM CONNECTION SCHEDULE (ALL WELDED)**

BEAM SIZE	PLATE CONNECTION	STIFFENERS	REMARKS
W16	1/2"x6"x6"	3"x6"	BOTH SIDES
W21	1/2"x6"x6"	3"x6"	BOTH SIDES
W24	1/2"x6"x6"	3"x6"	BOTH SIDES
W27	20"x6"x6"	1/2"	BOTH SIDES


**16** BRACE FRAME BEAM TO COLUMN CONNECTION DETAILS  
 SCALE: 1"=1'-0"

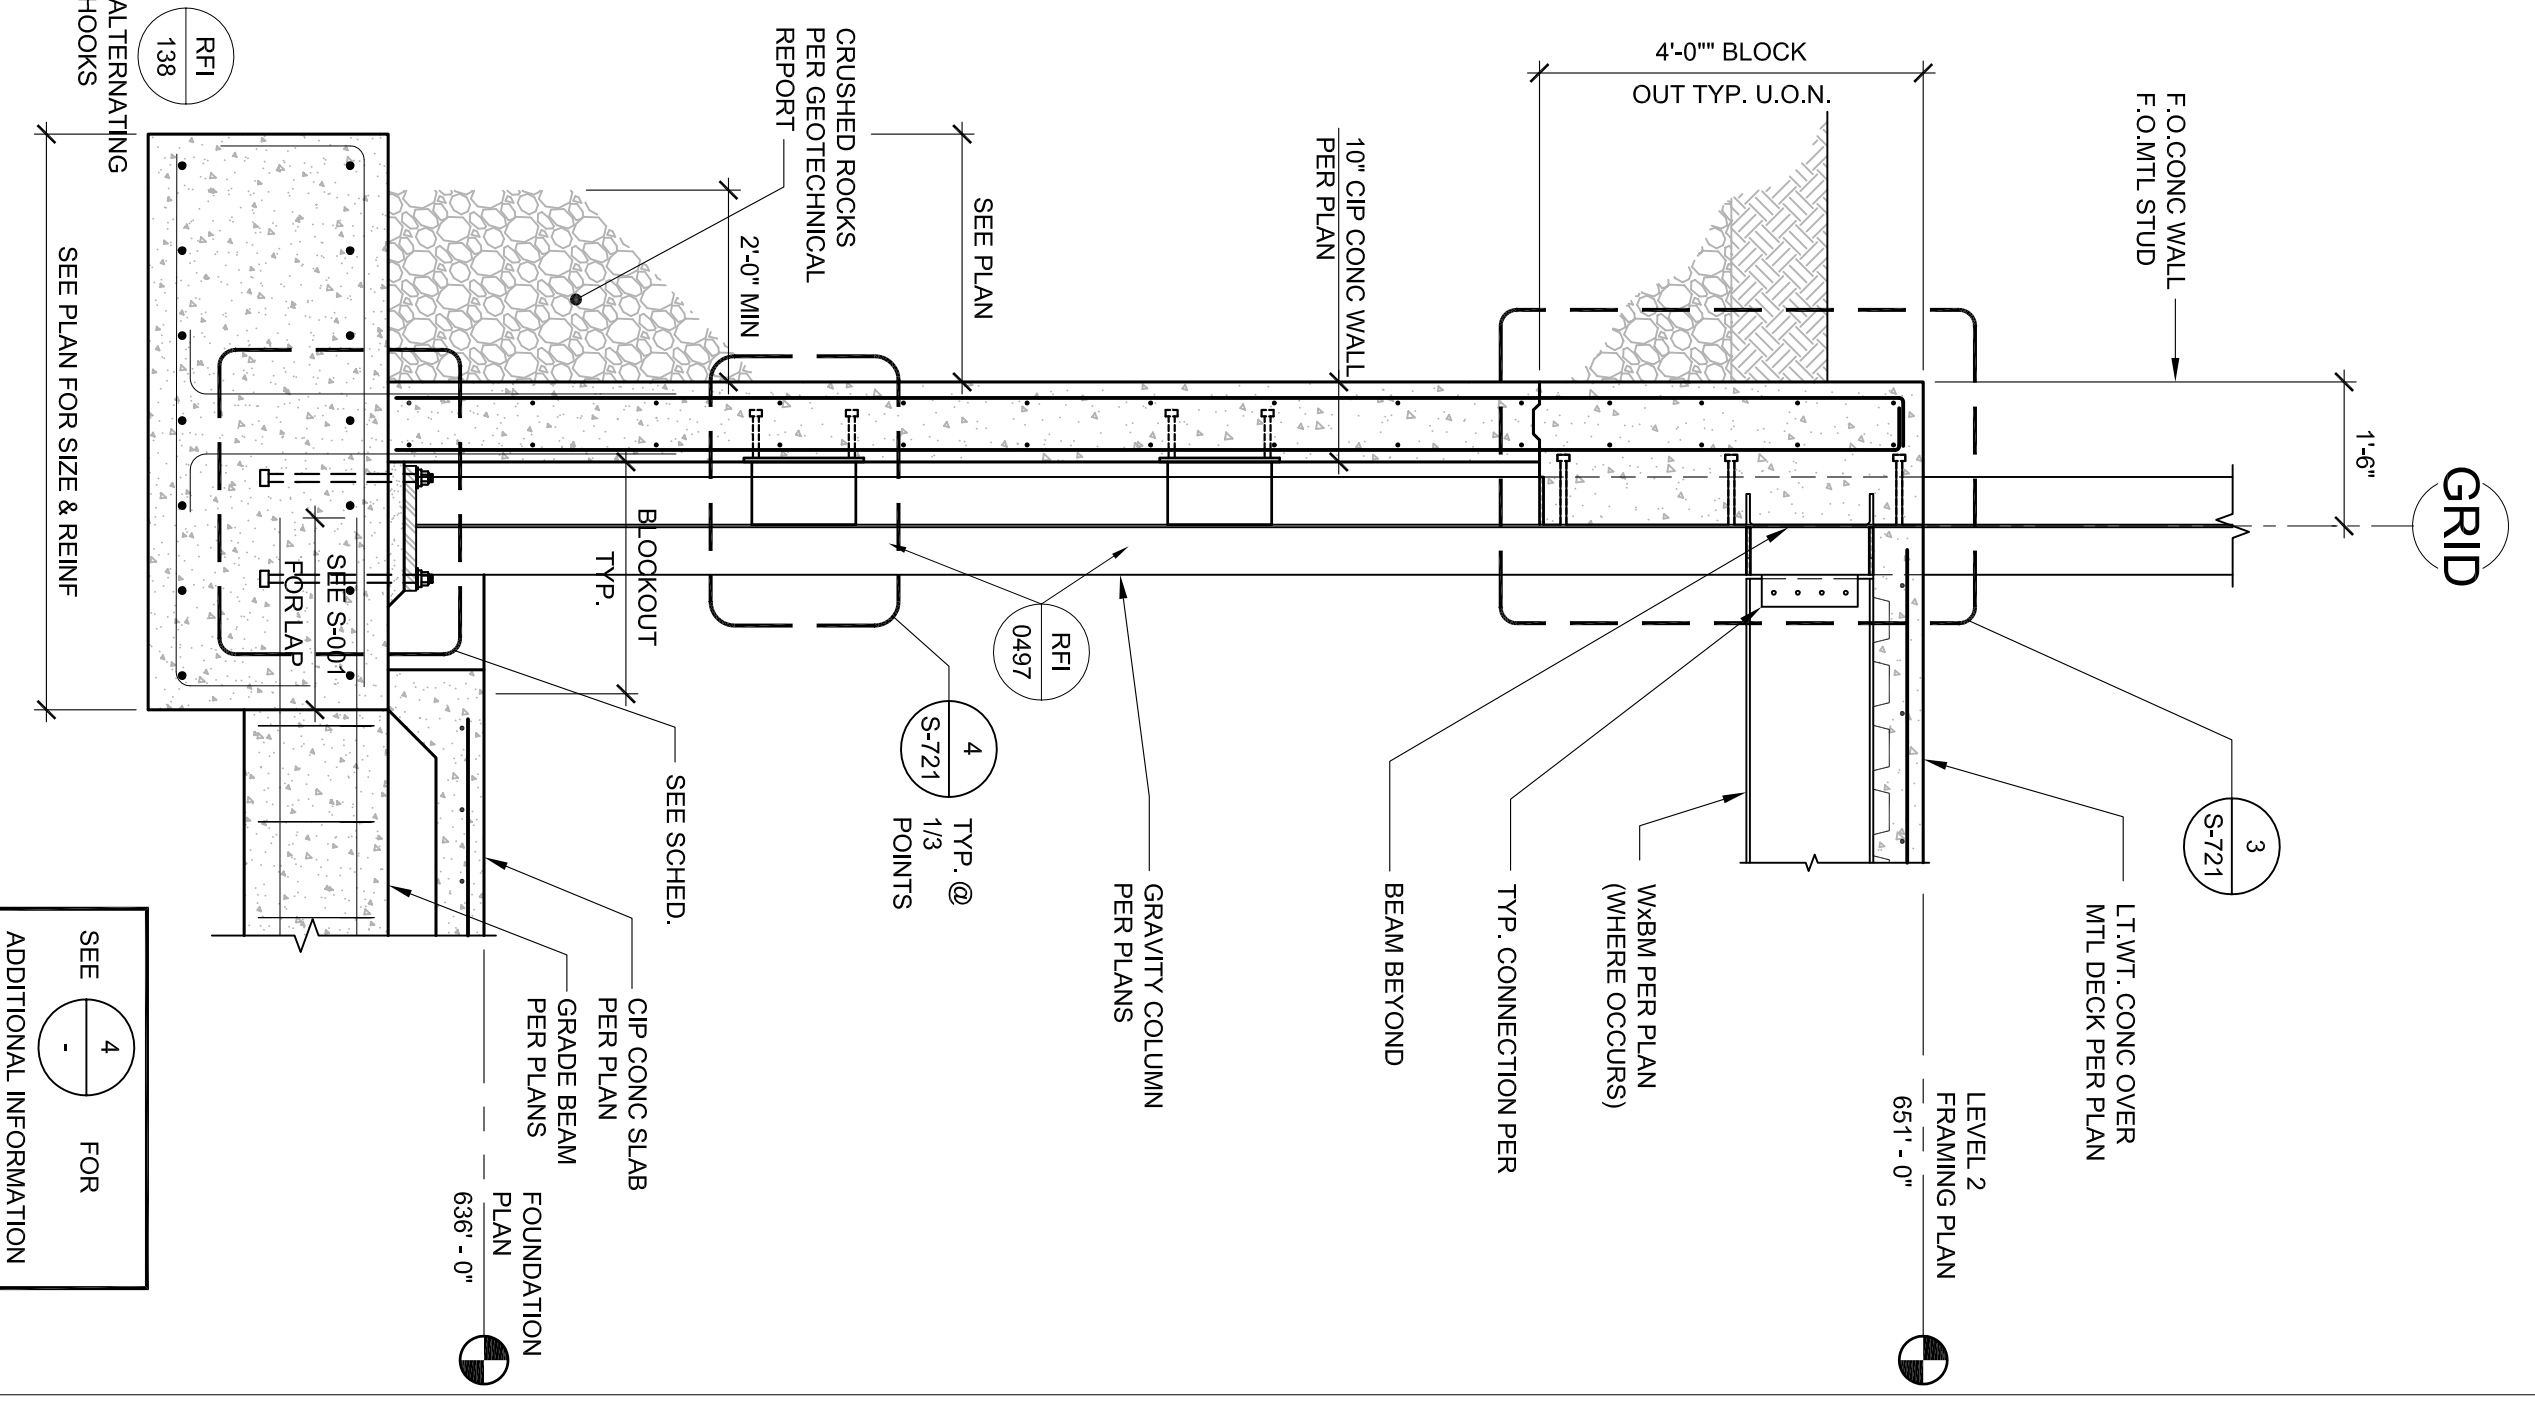


**2 RETAINING WALL SECTION @ COLUMN**  
 SCALE: 1/2"=1'-0"

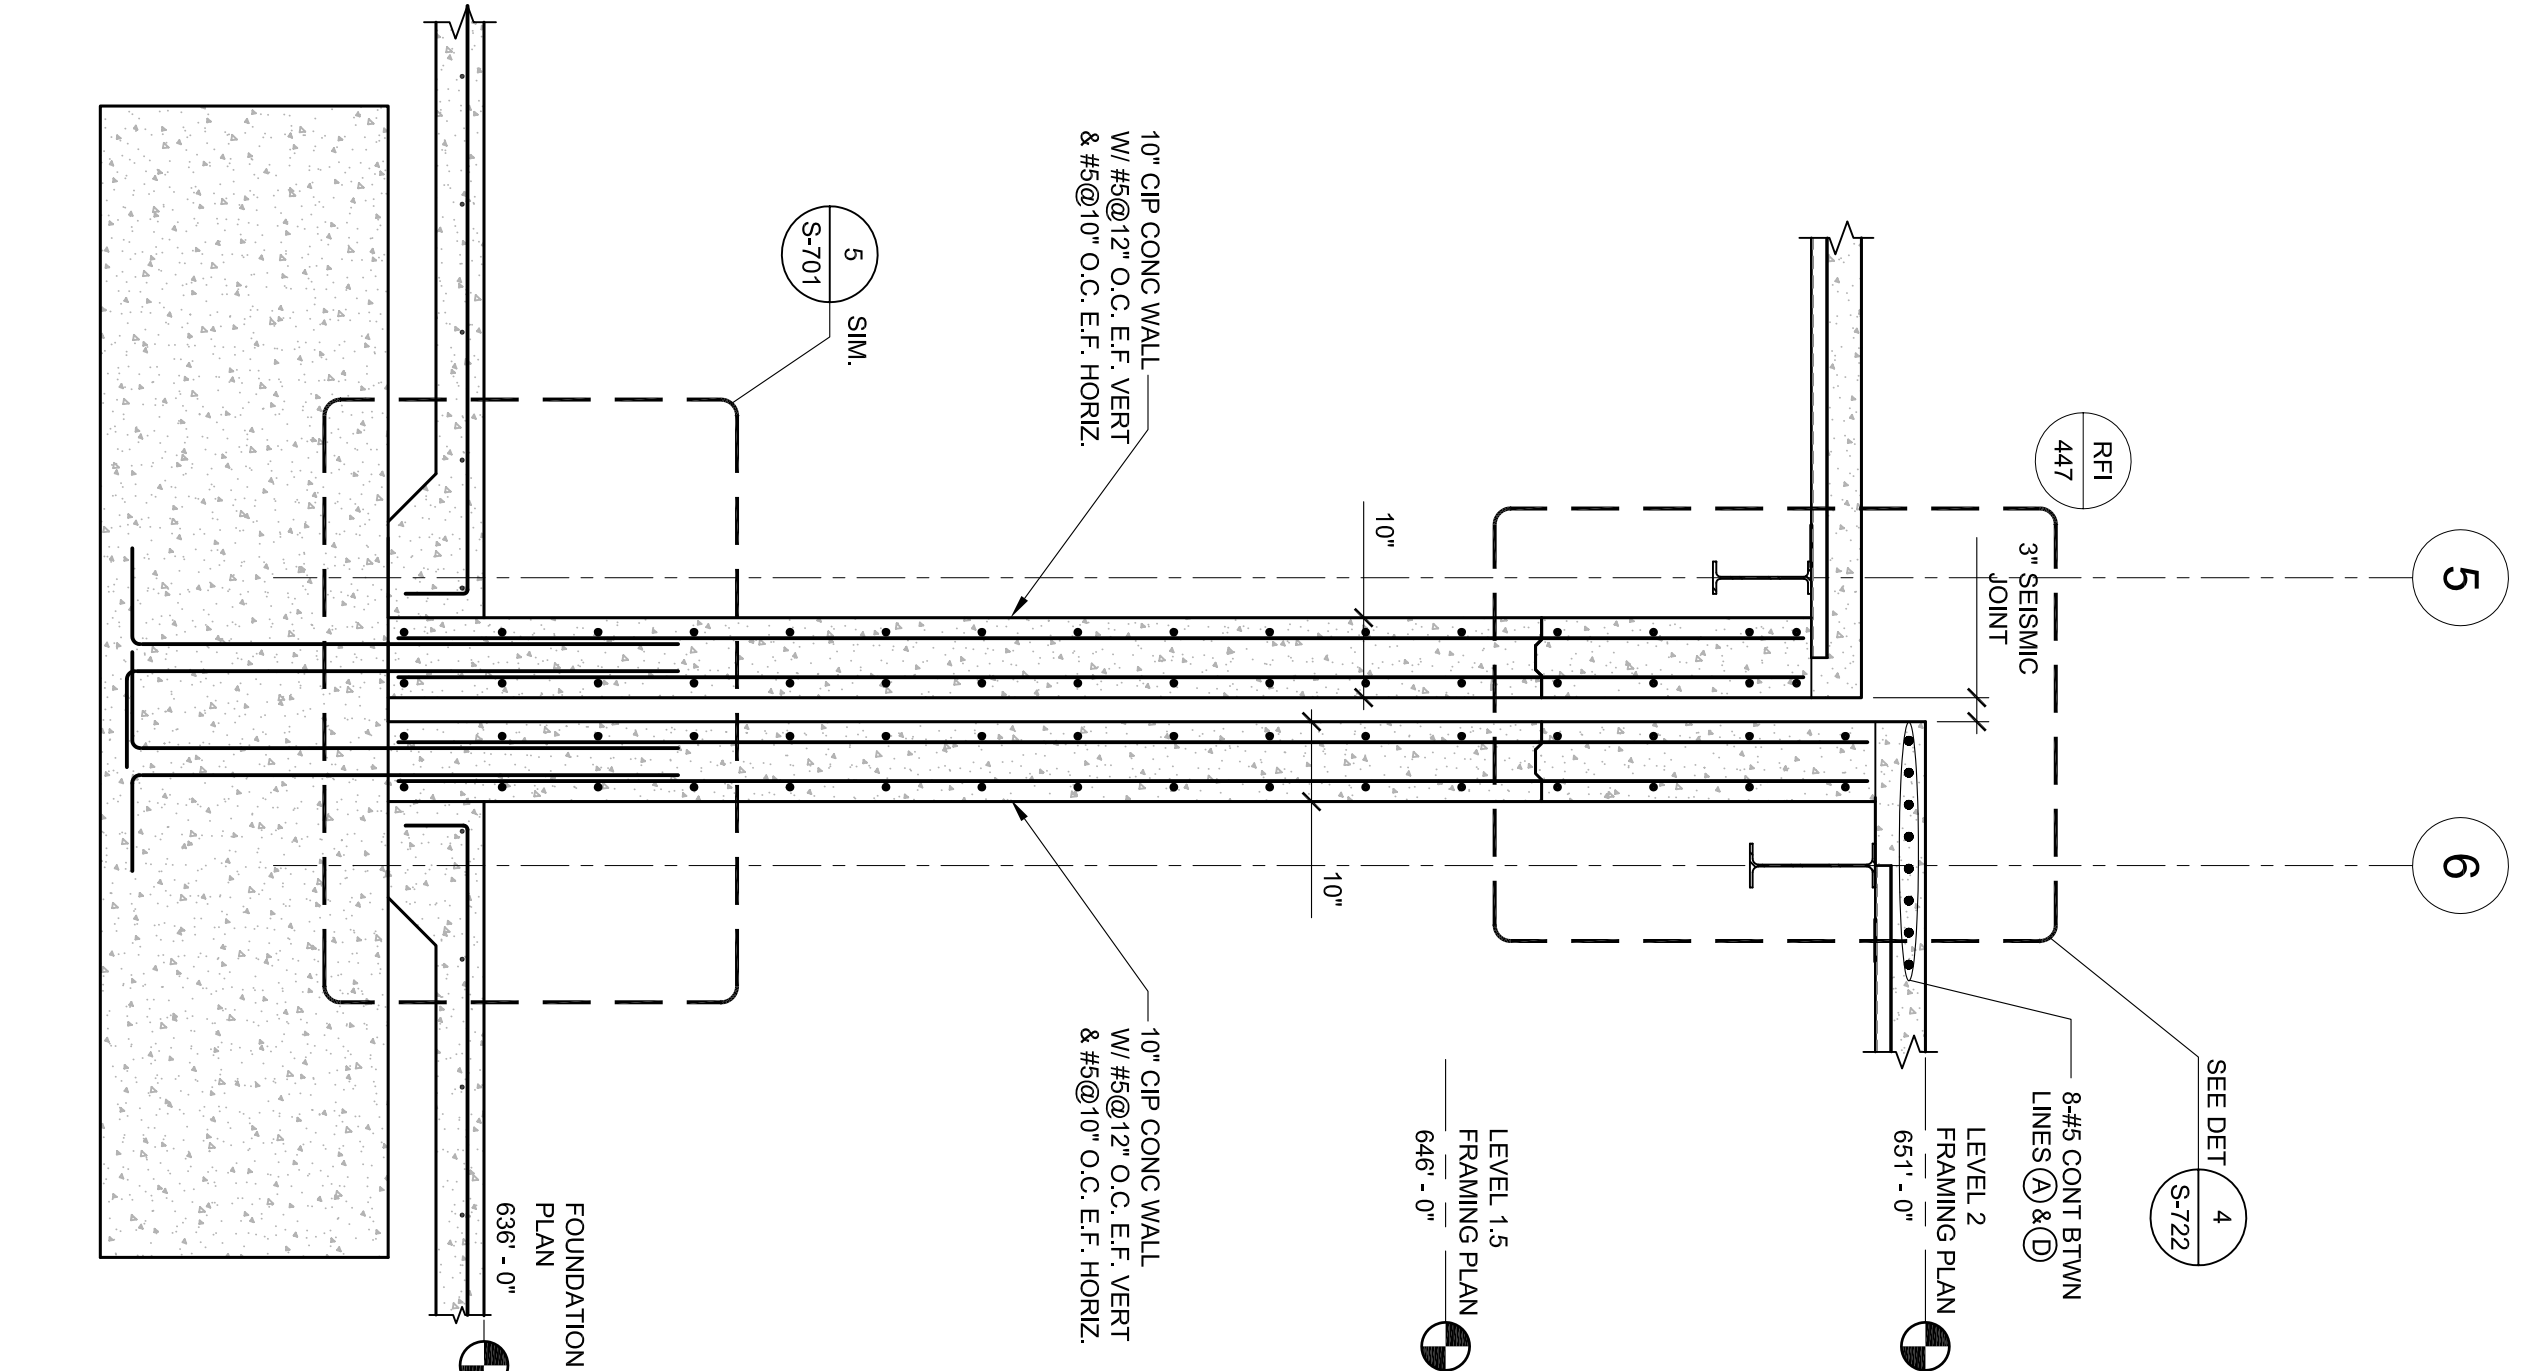


**6 SECTION**  
 SCALE: 1/2"=1'-0"

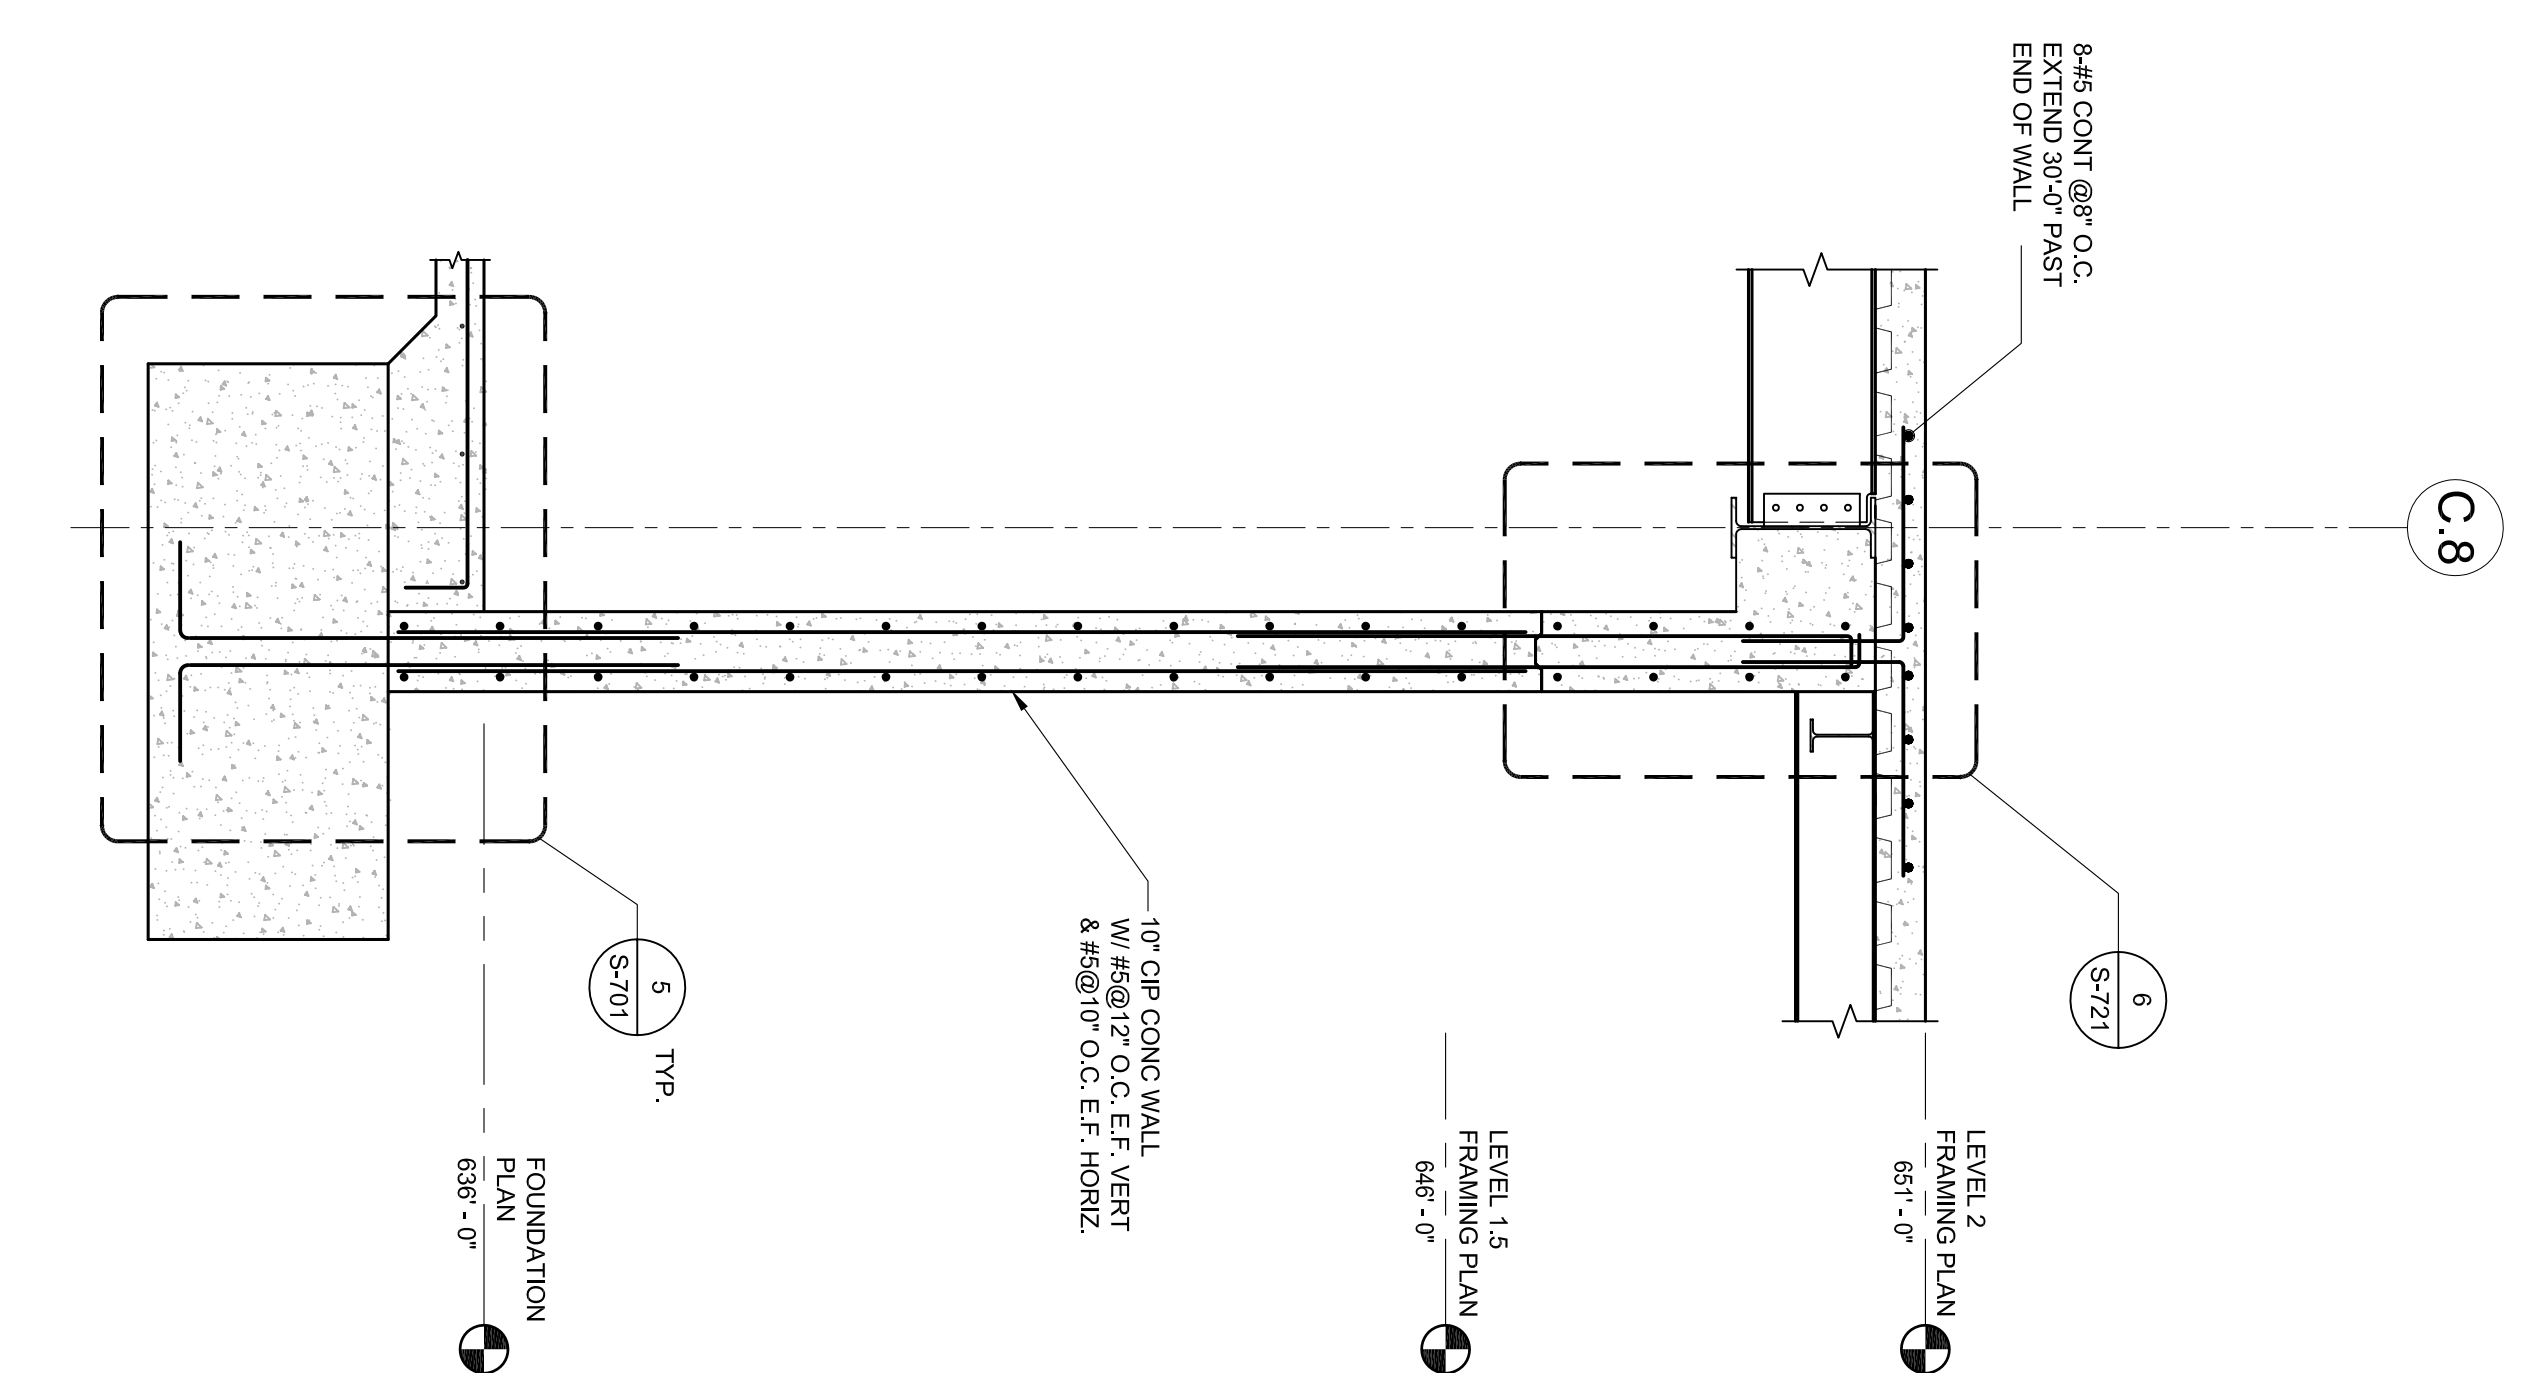


**10 SECTION**  
 SCALE: 1/2"=1'-0"

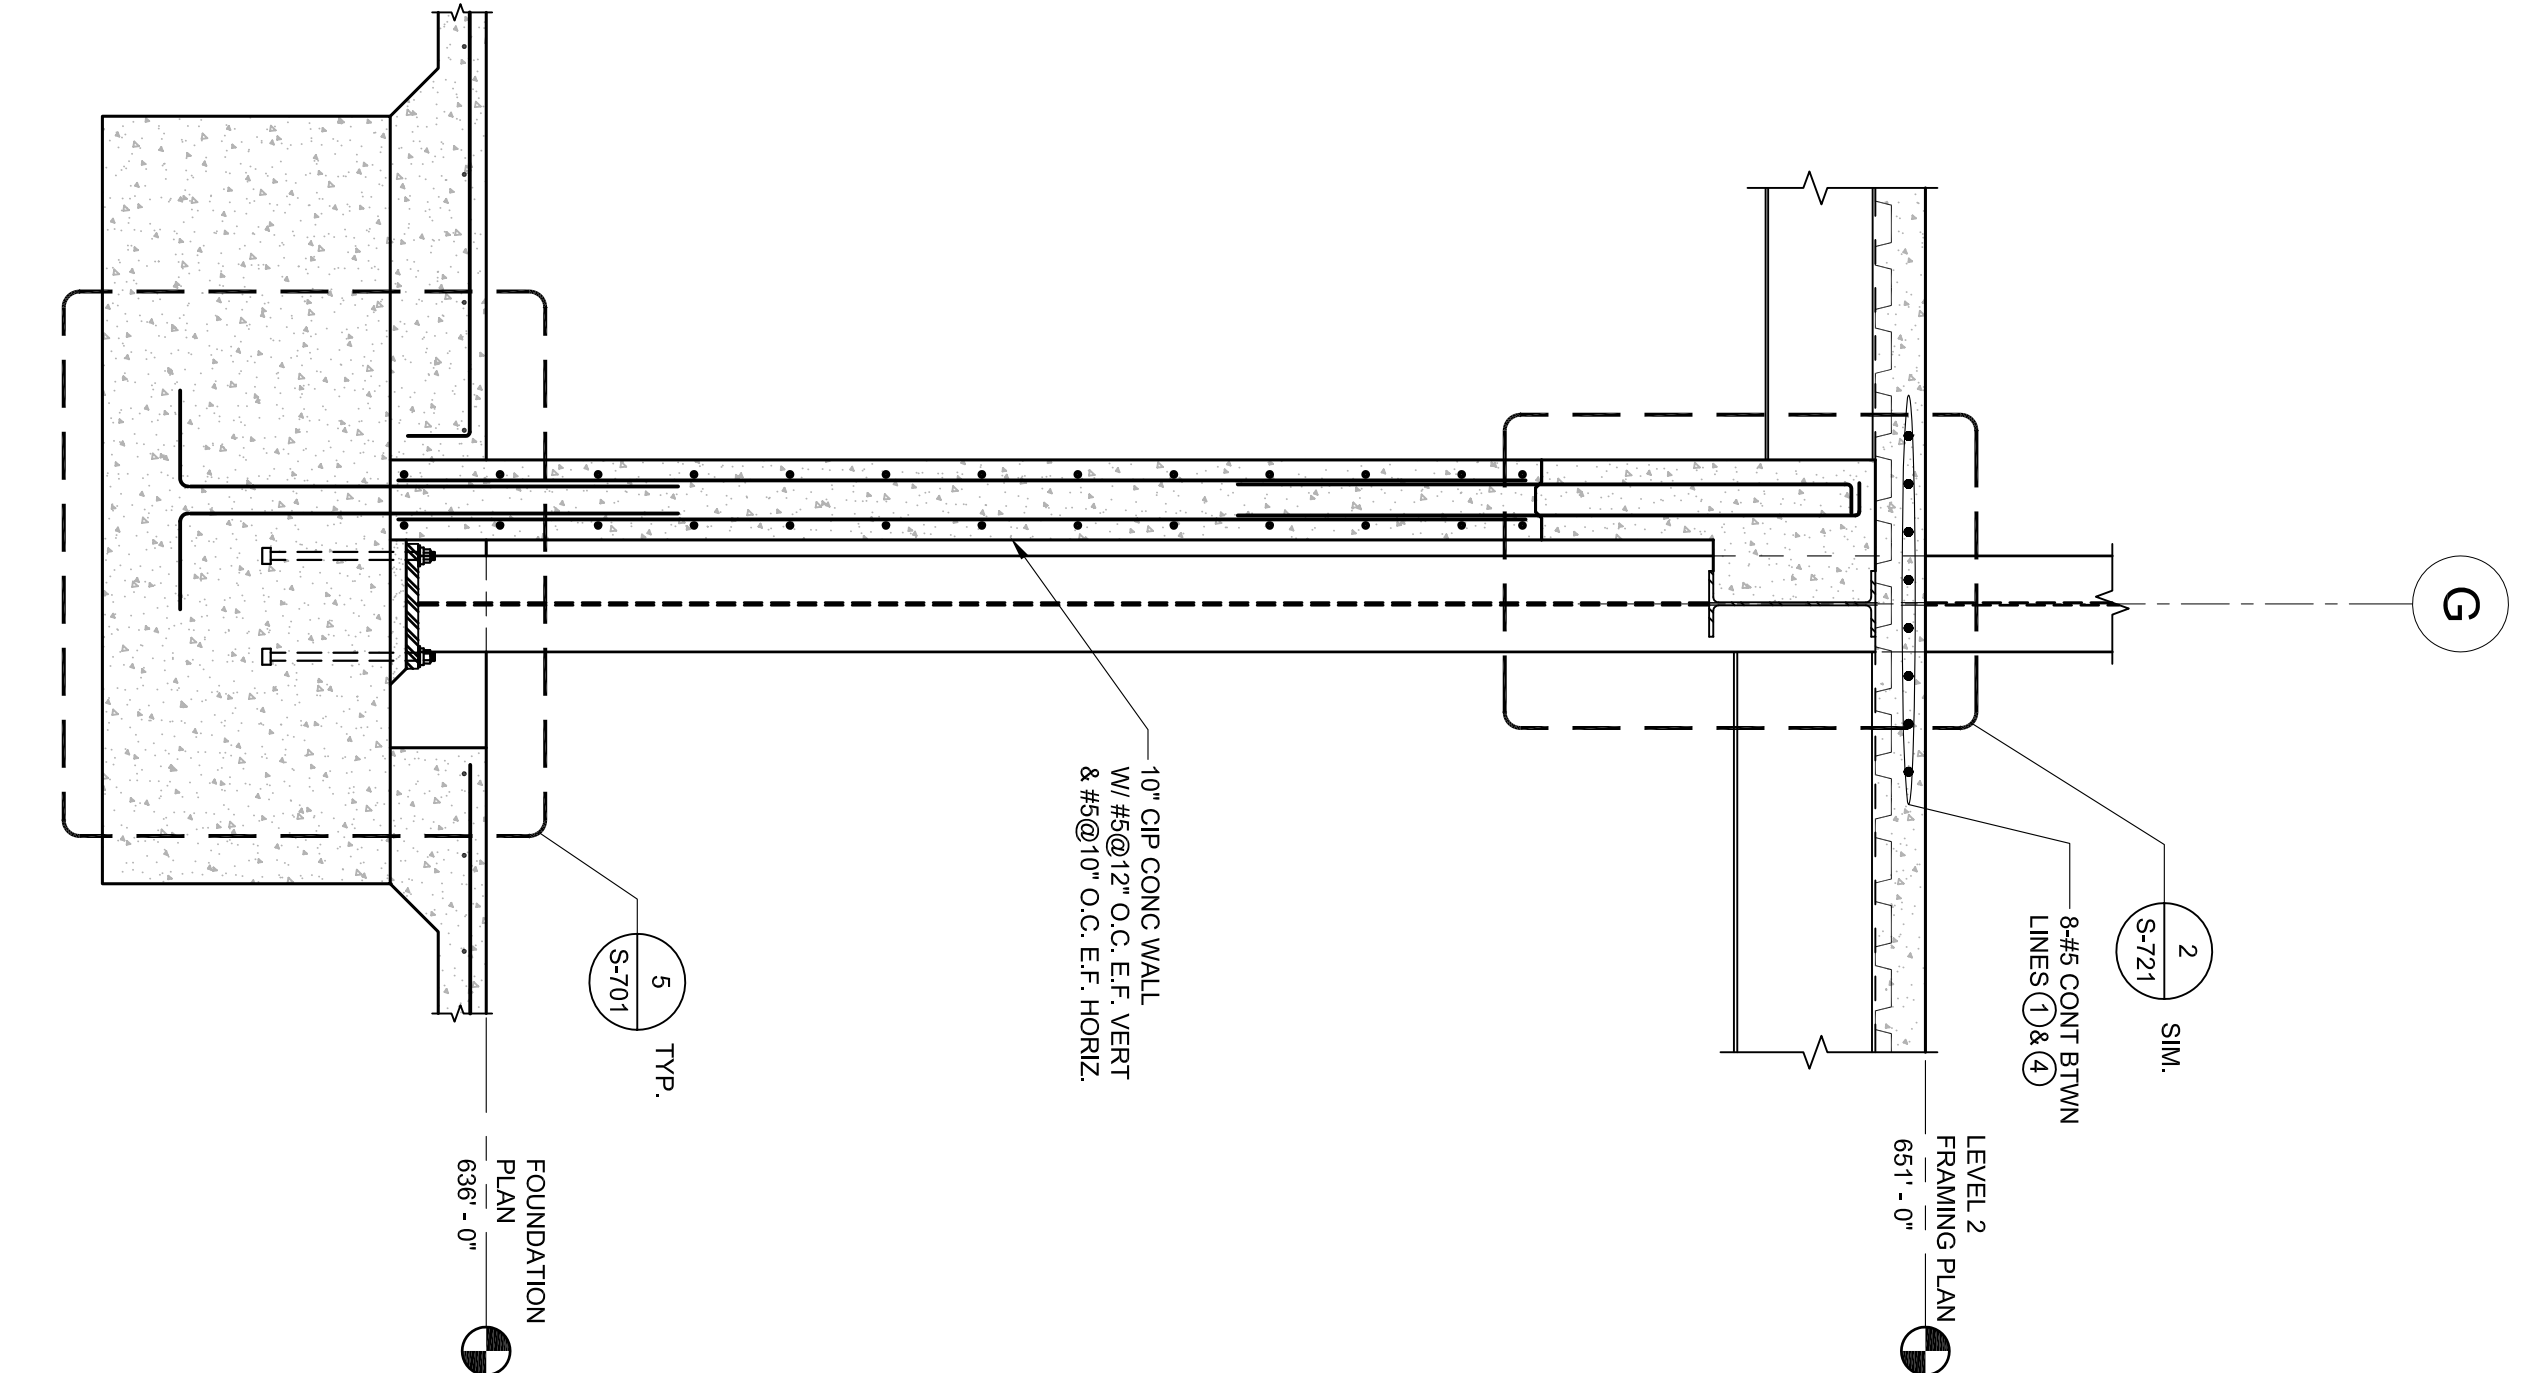


**14 SECTION**  
 SCALE: 1/2"=1'-0"

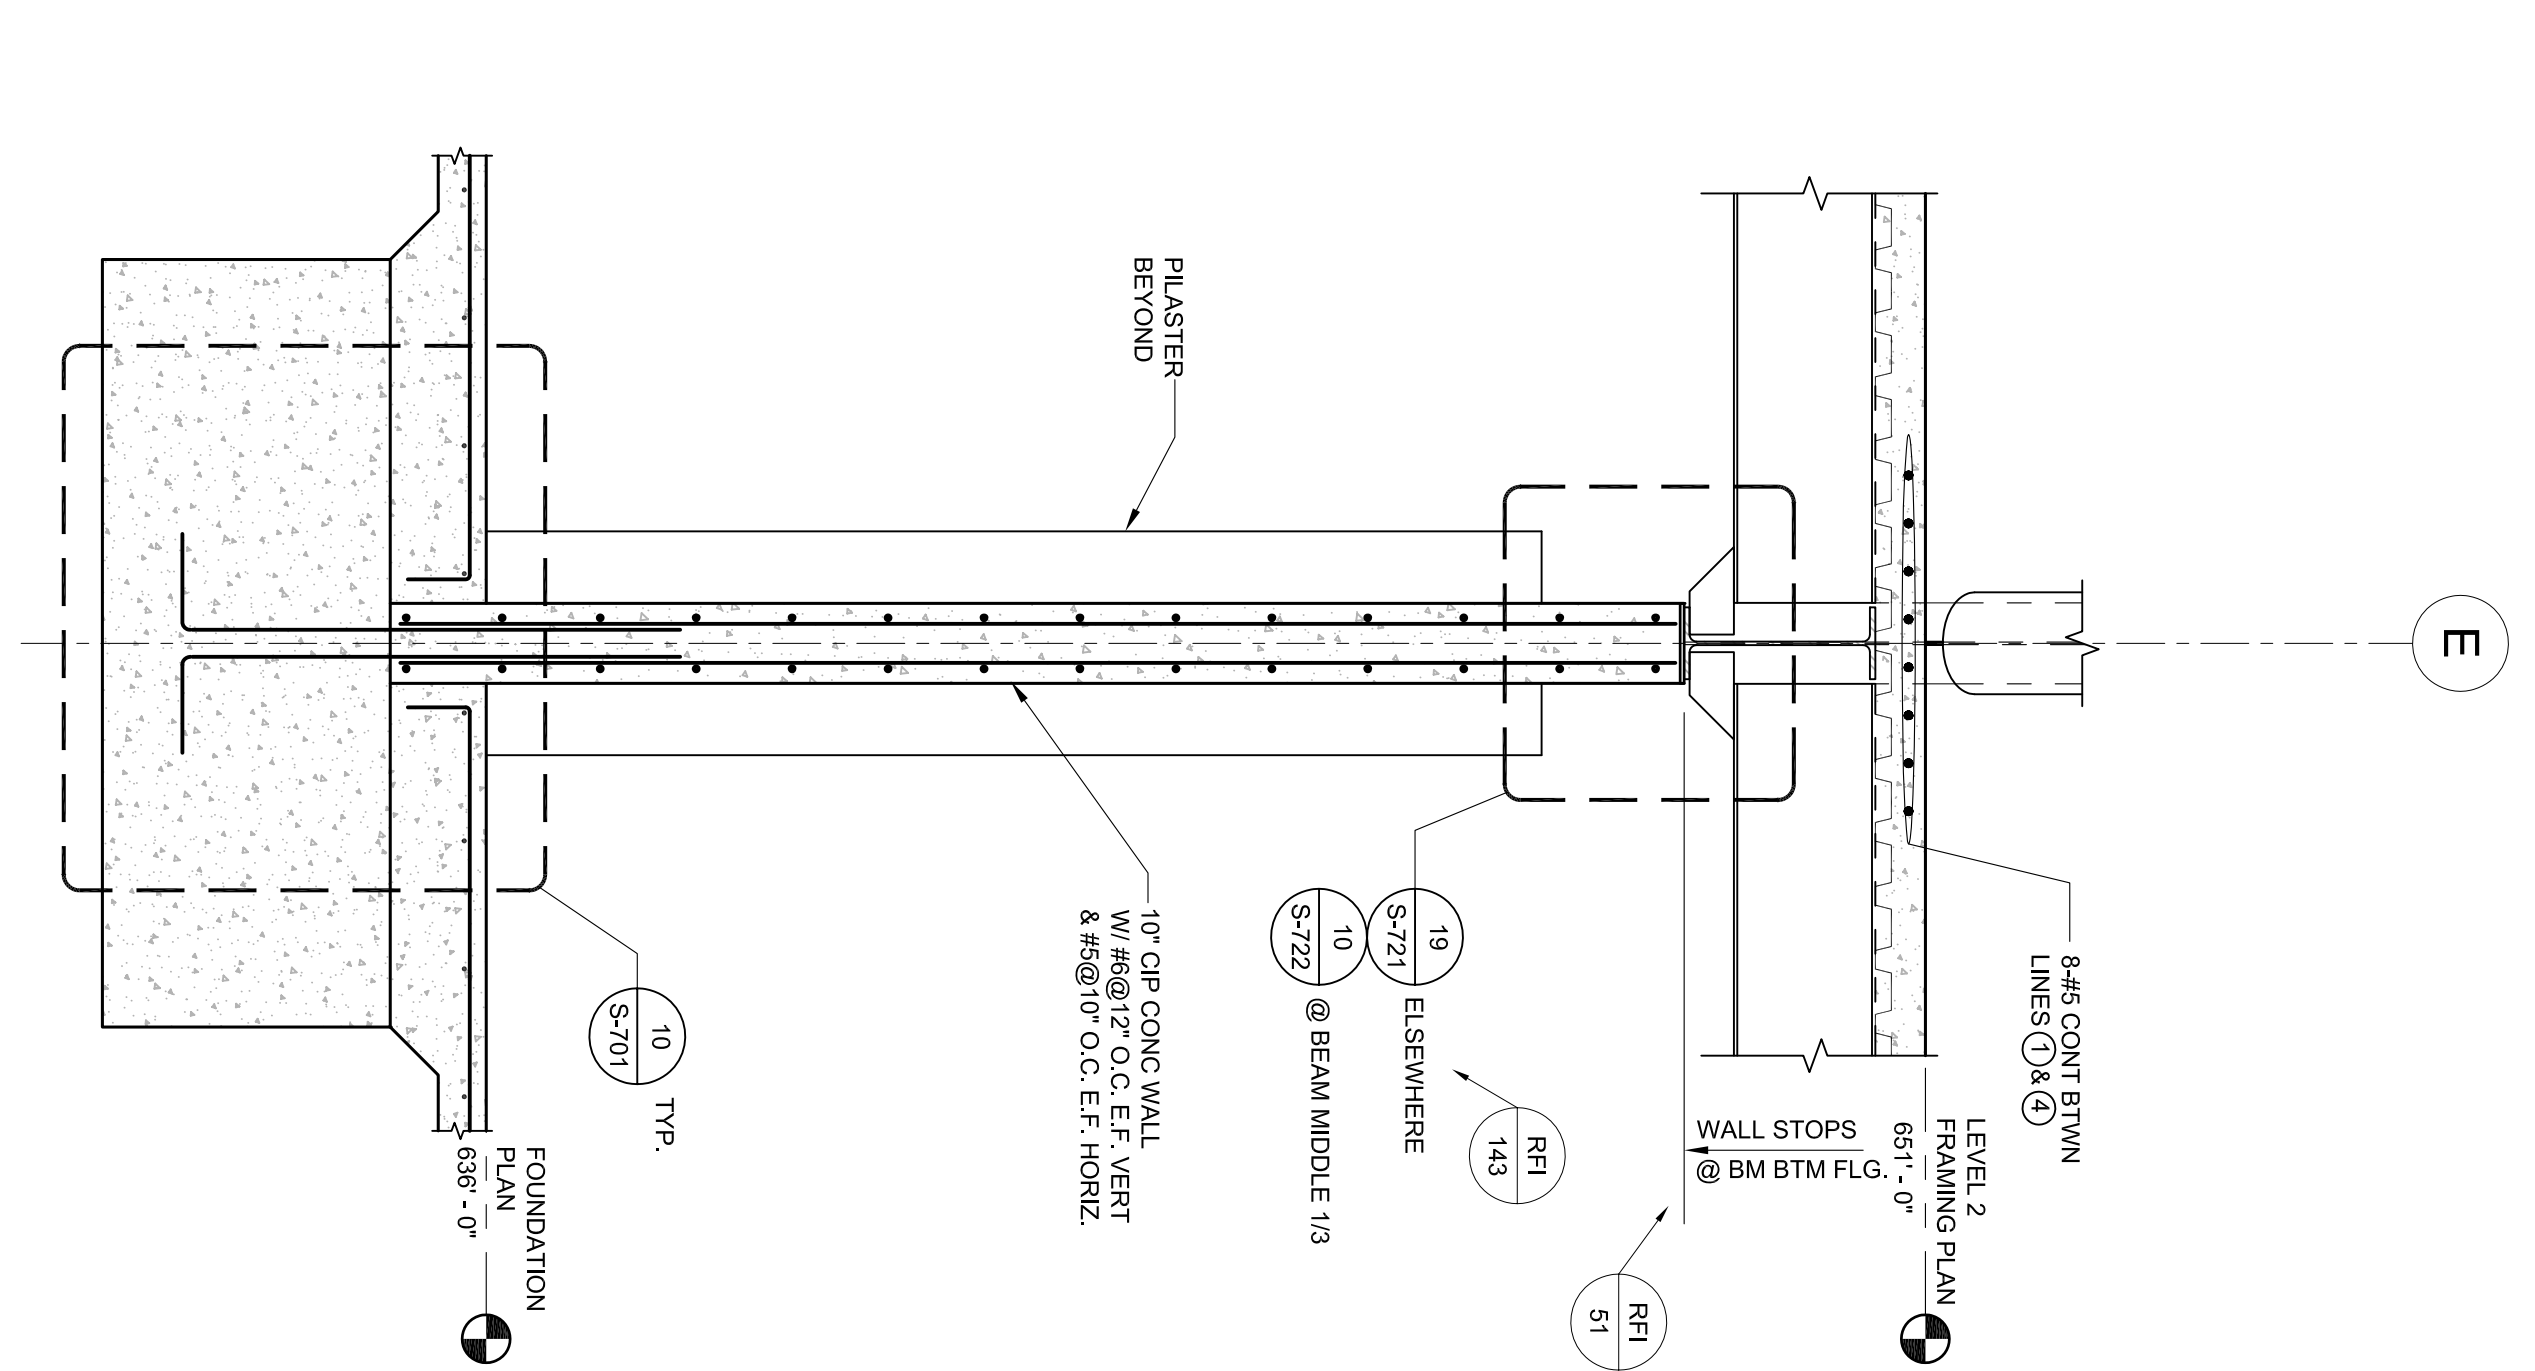


**18 SECTION**  
 SCALE: 1/2"=1'-0"

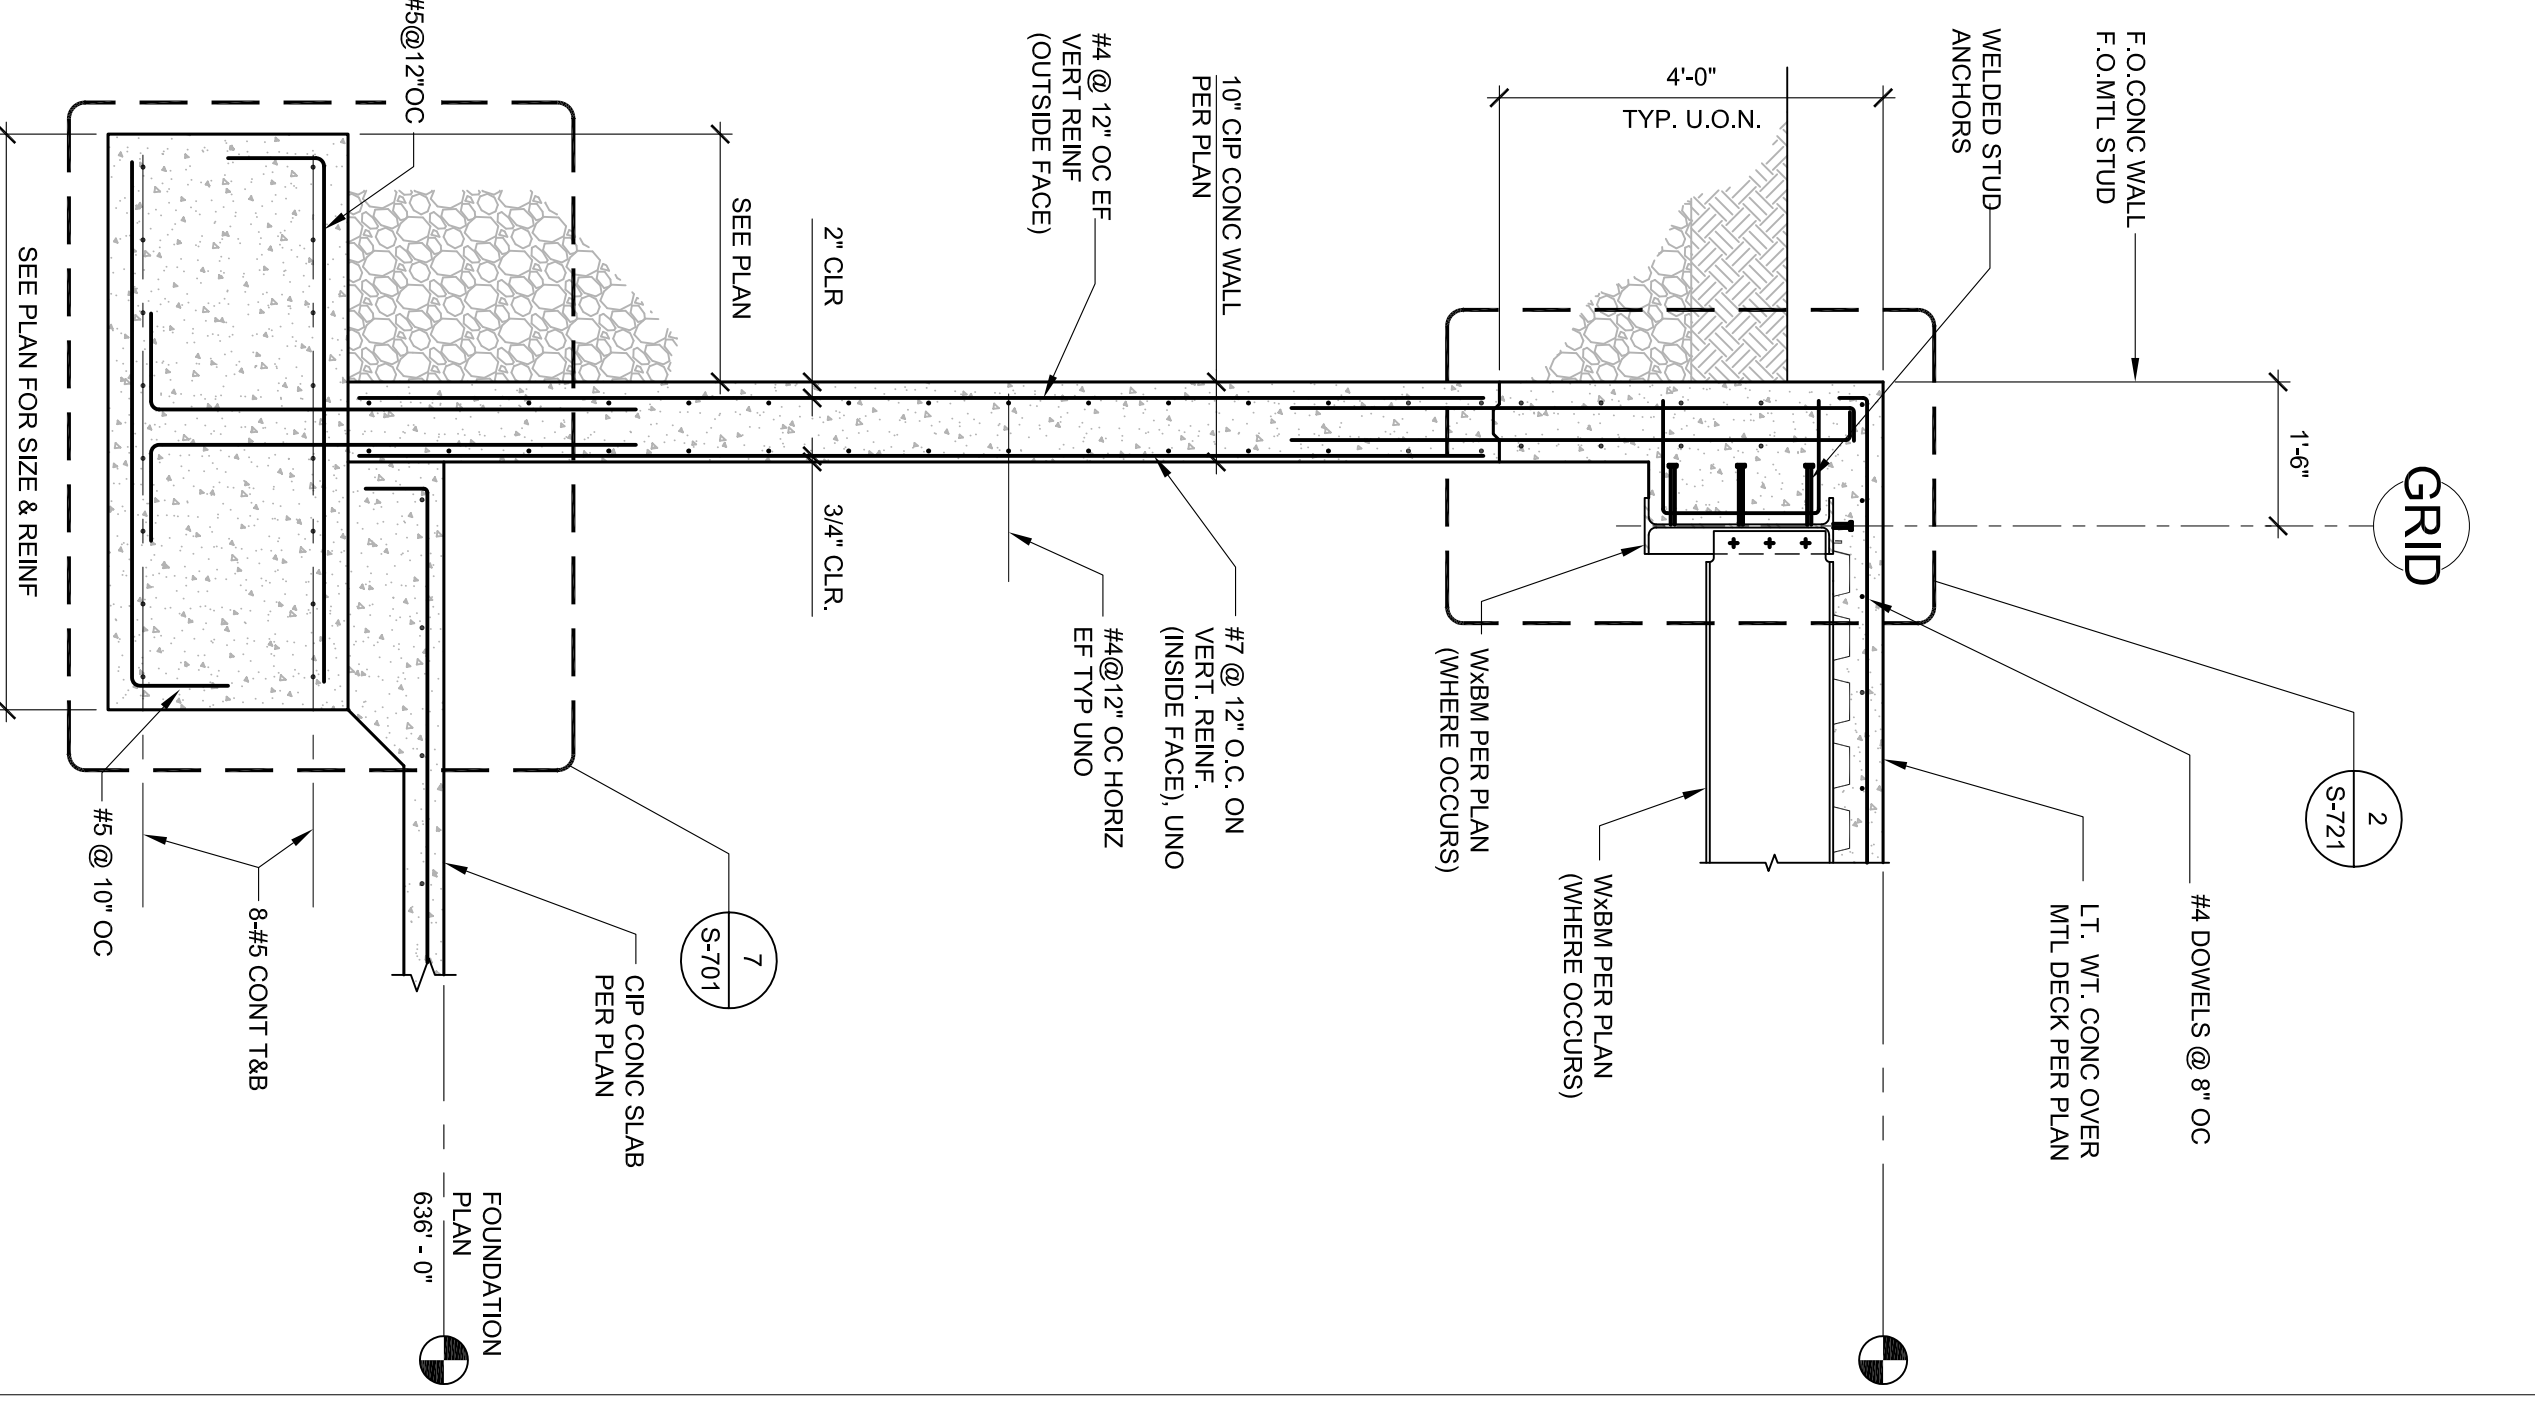


**4 SECTION AT RETAINING WALL**  
 SCALE: 1/2"=1'-0"

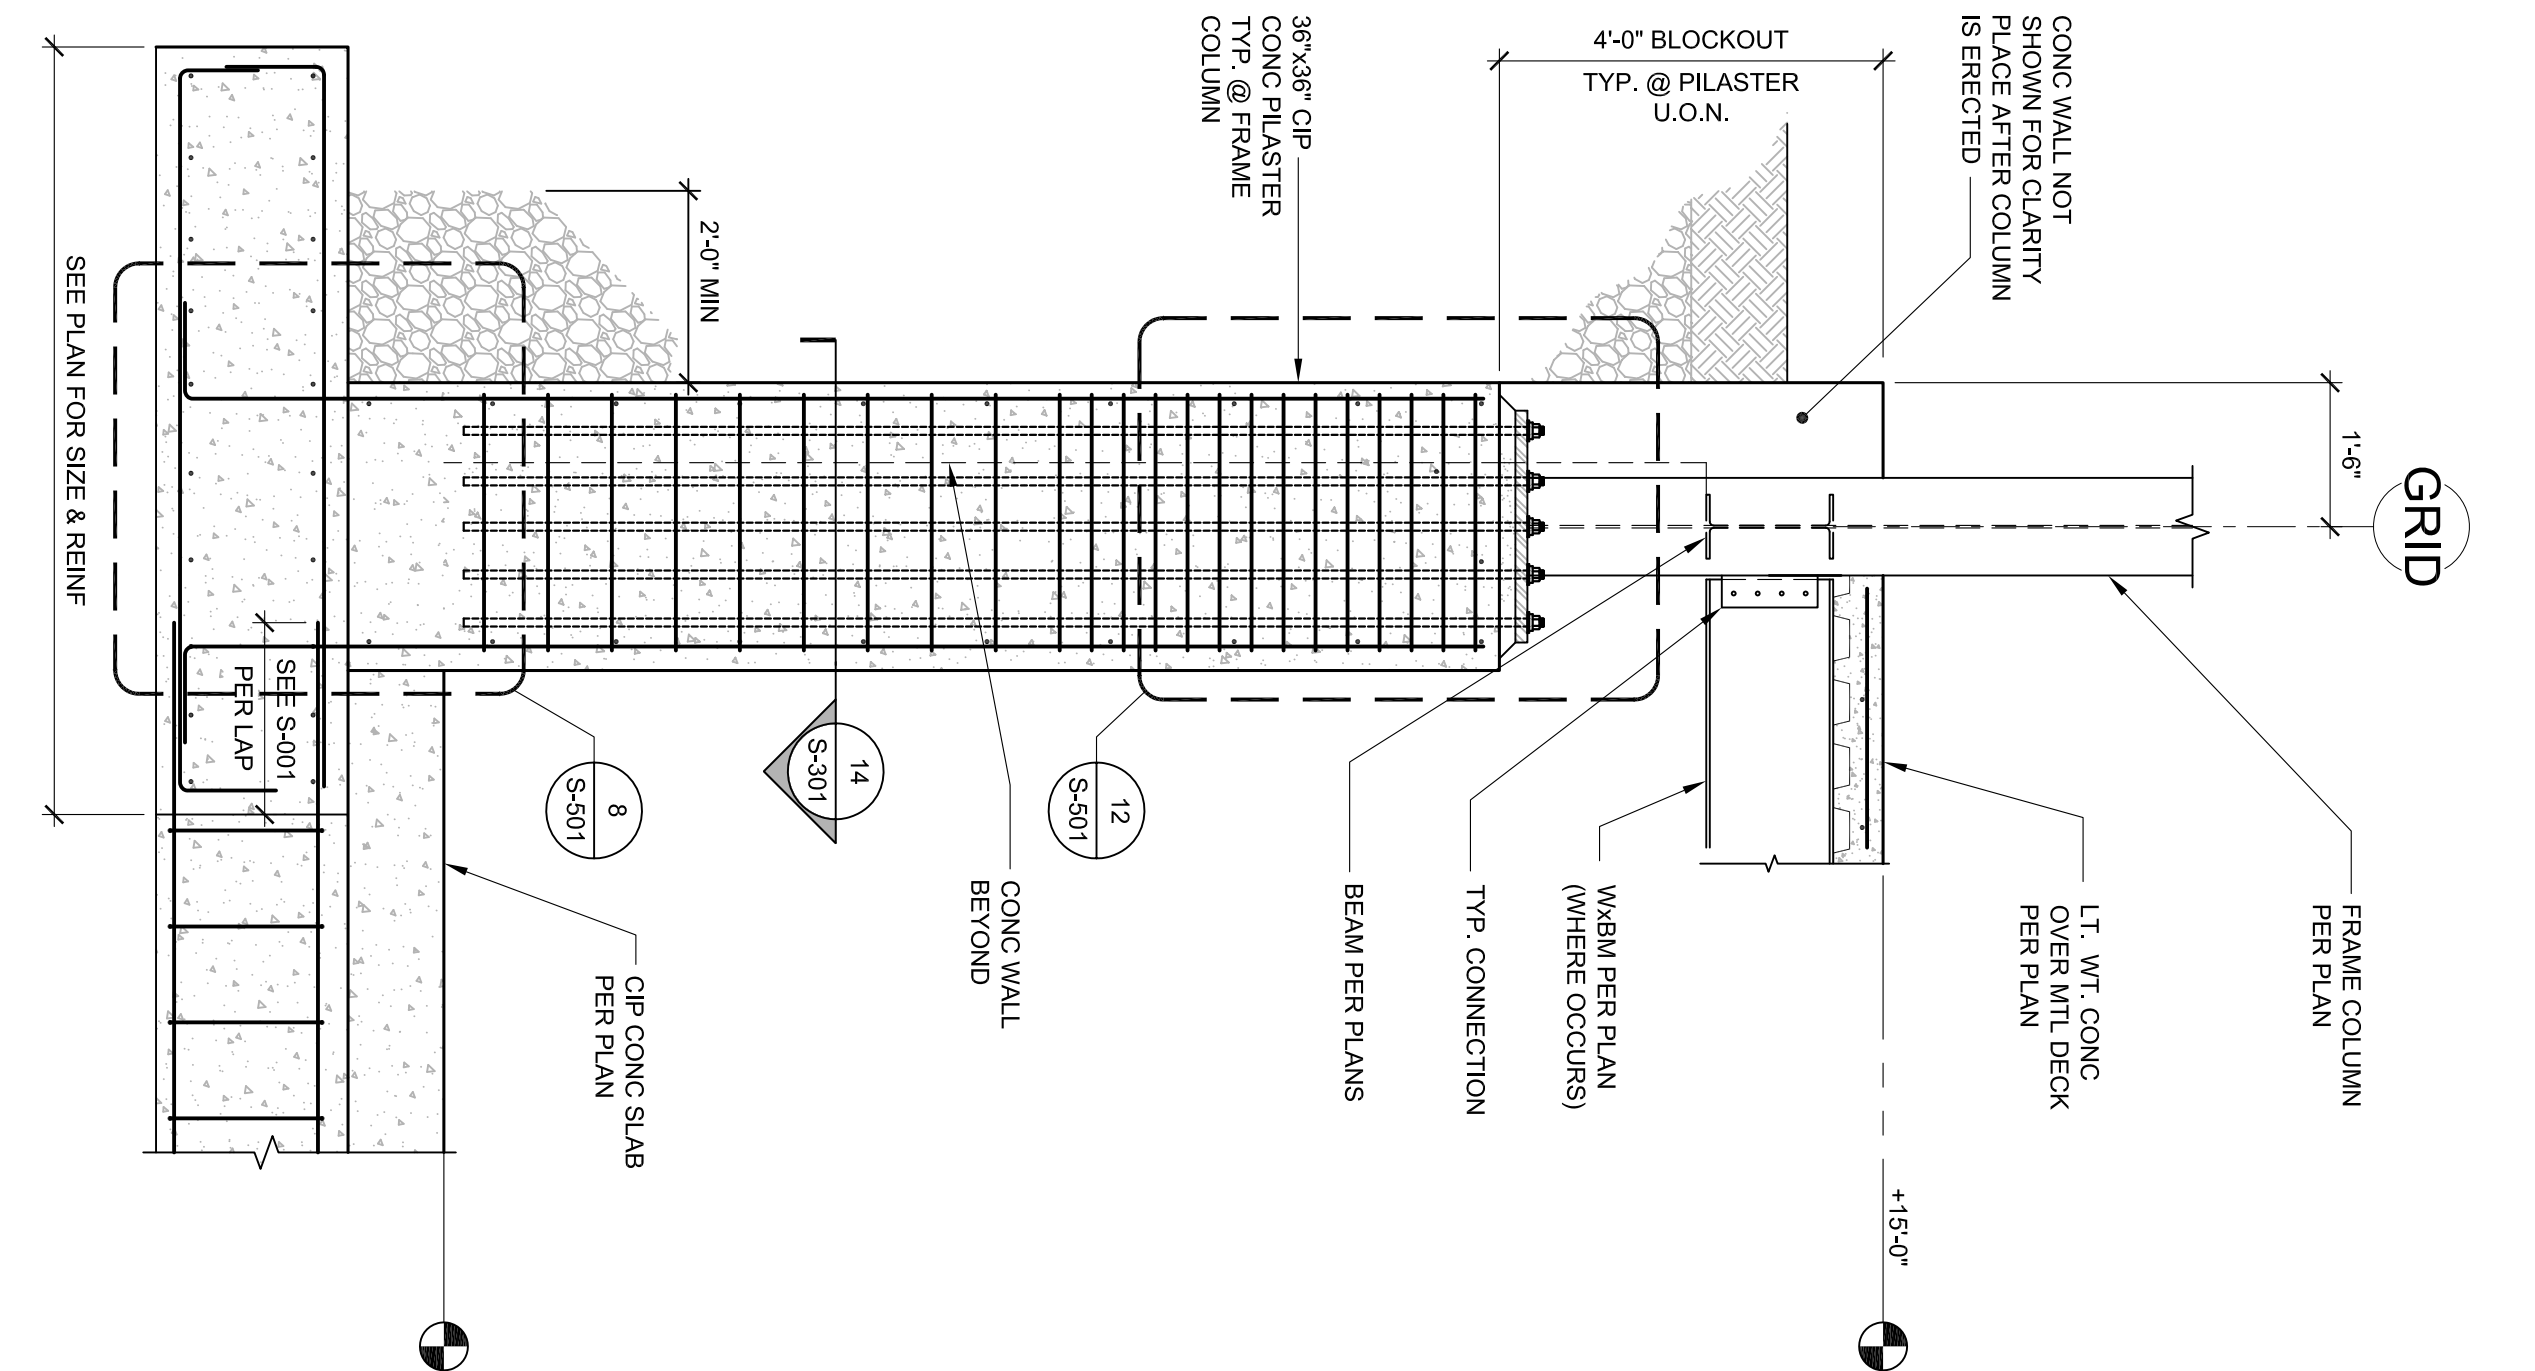


**8 SECTION @ FRAME COLUMN**  
 SCALE: 1/2"=1'-0"

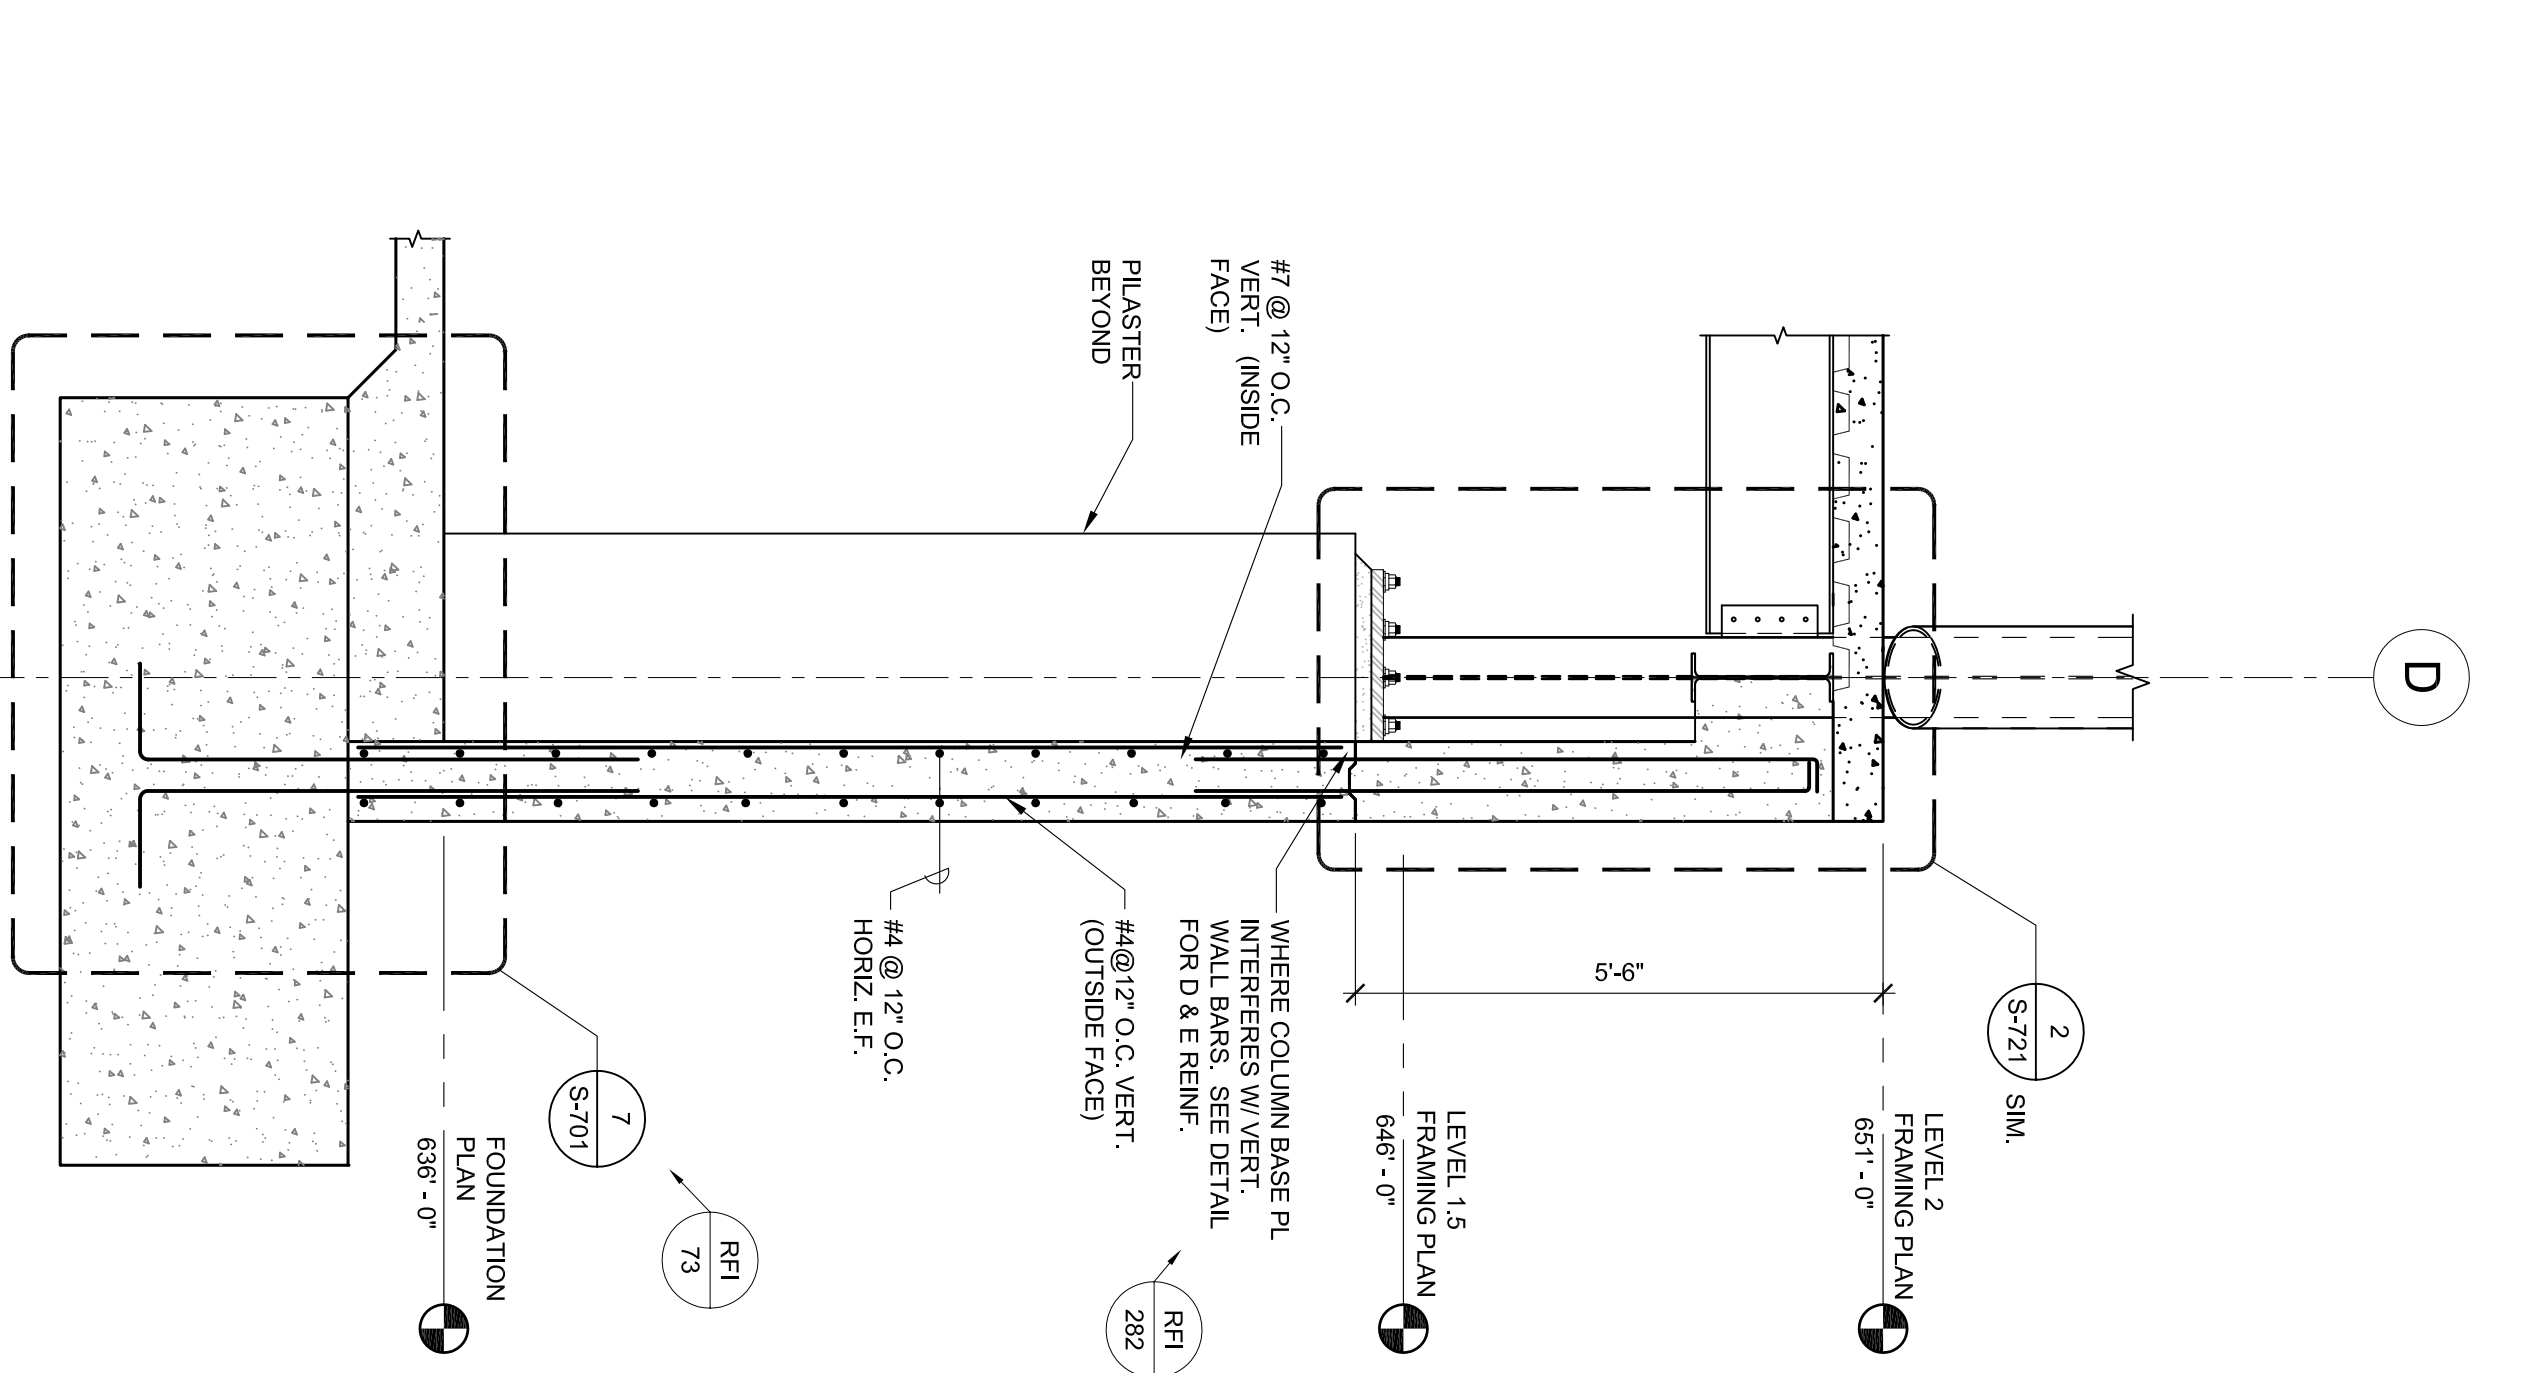

**12 SECTION**  
 SCALE: 1/2"=1'-0"

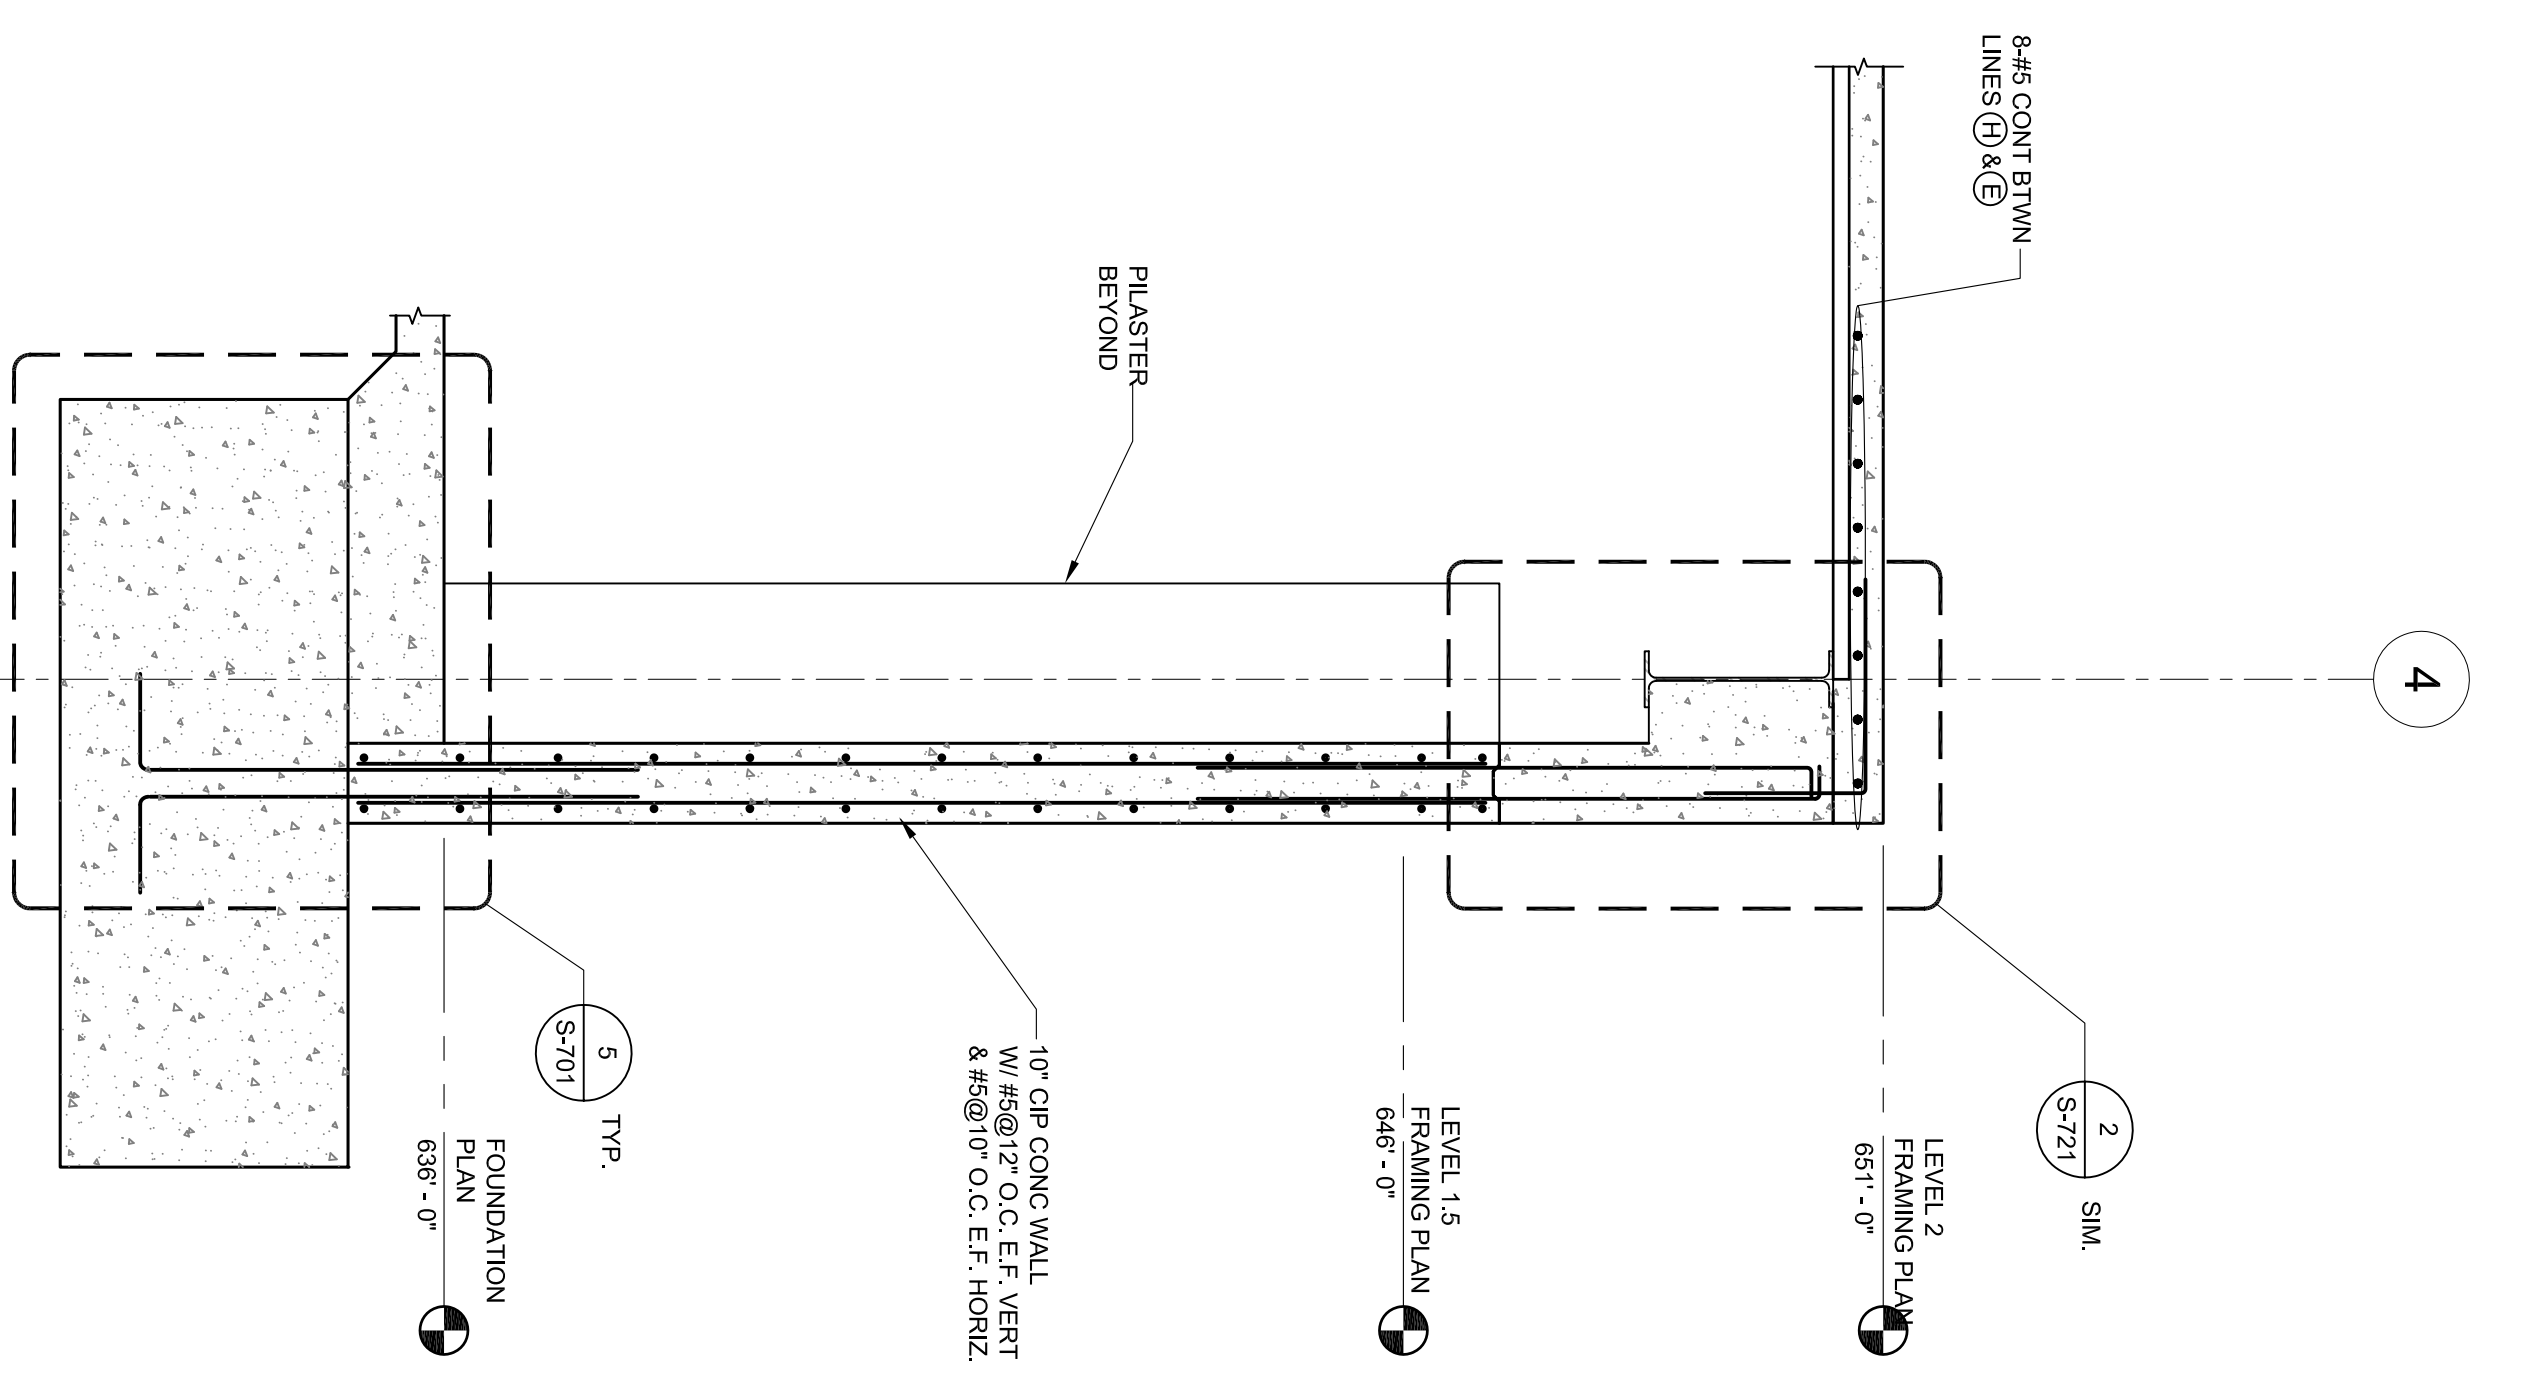

**16 SECTION**  
 SCALE: 1/2"=1'-0"

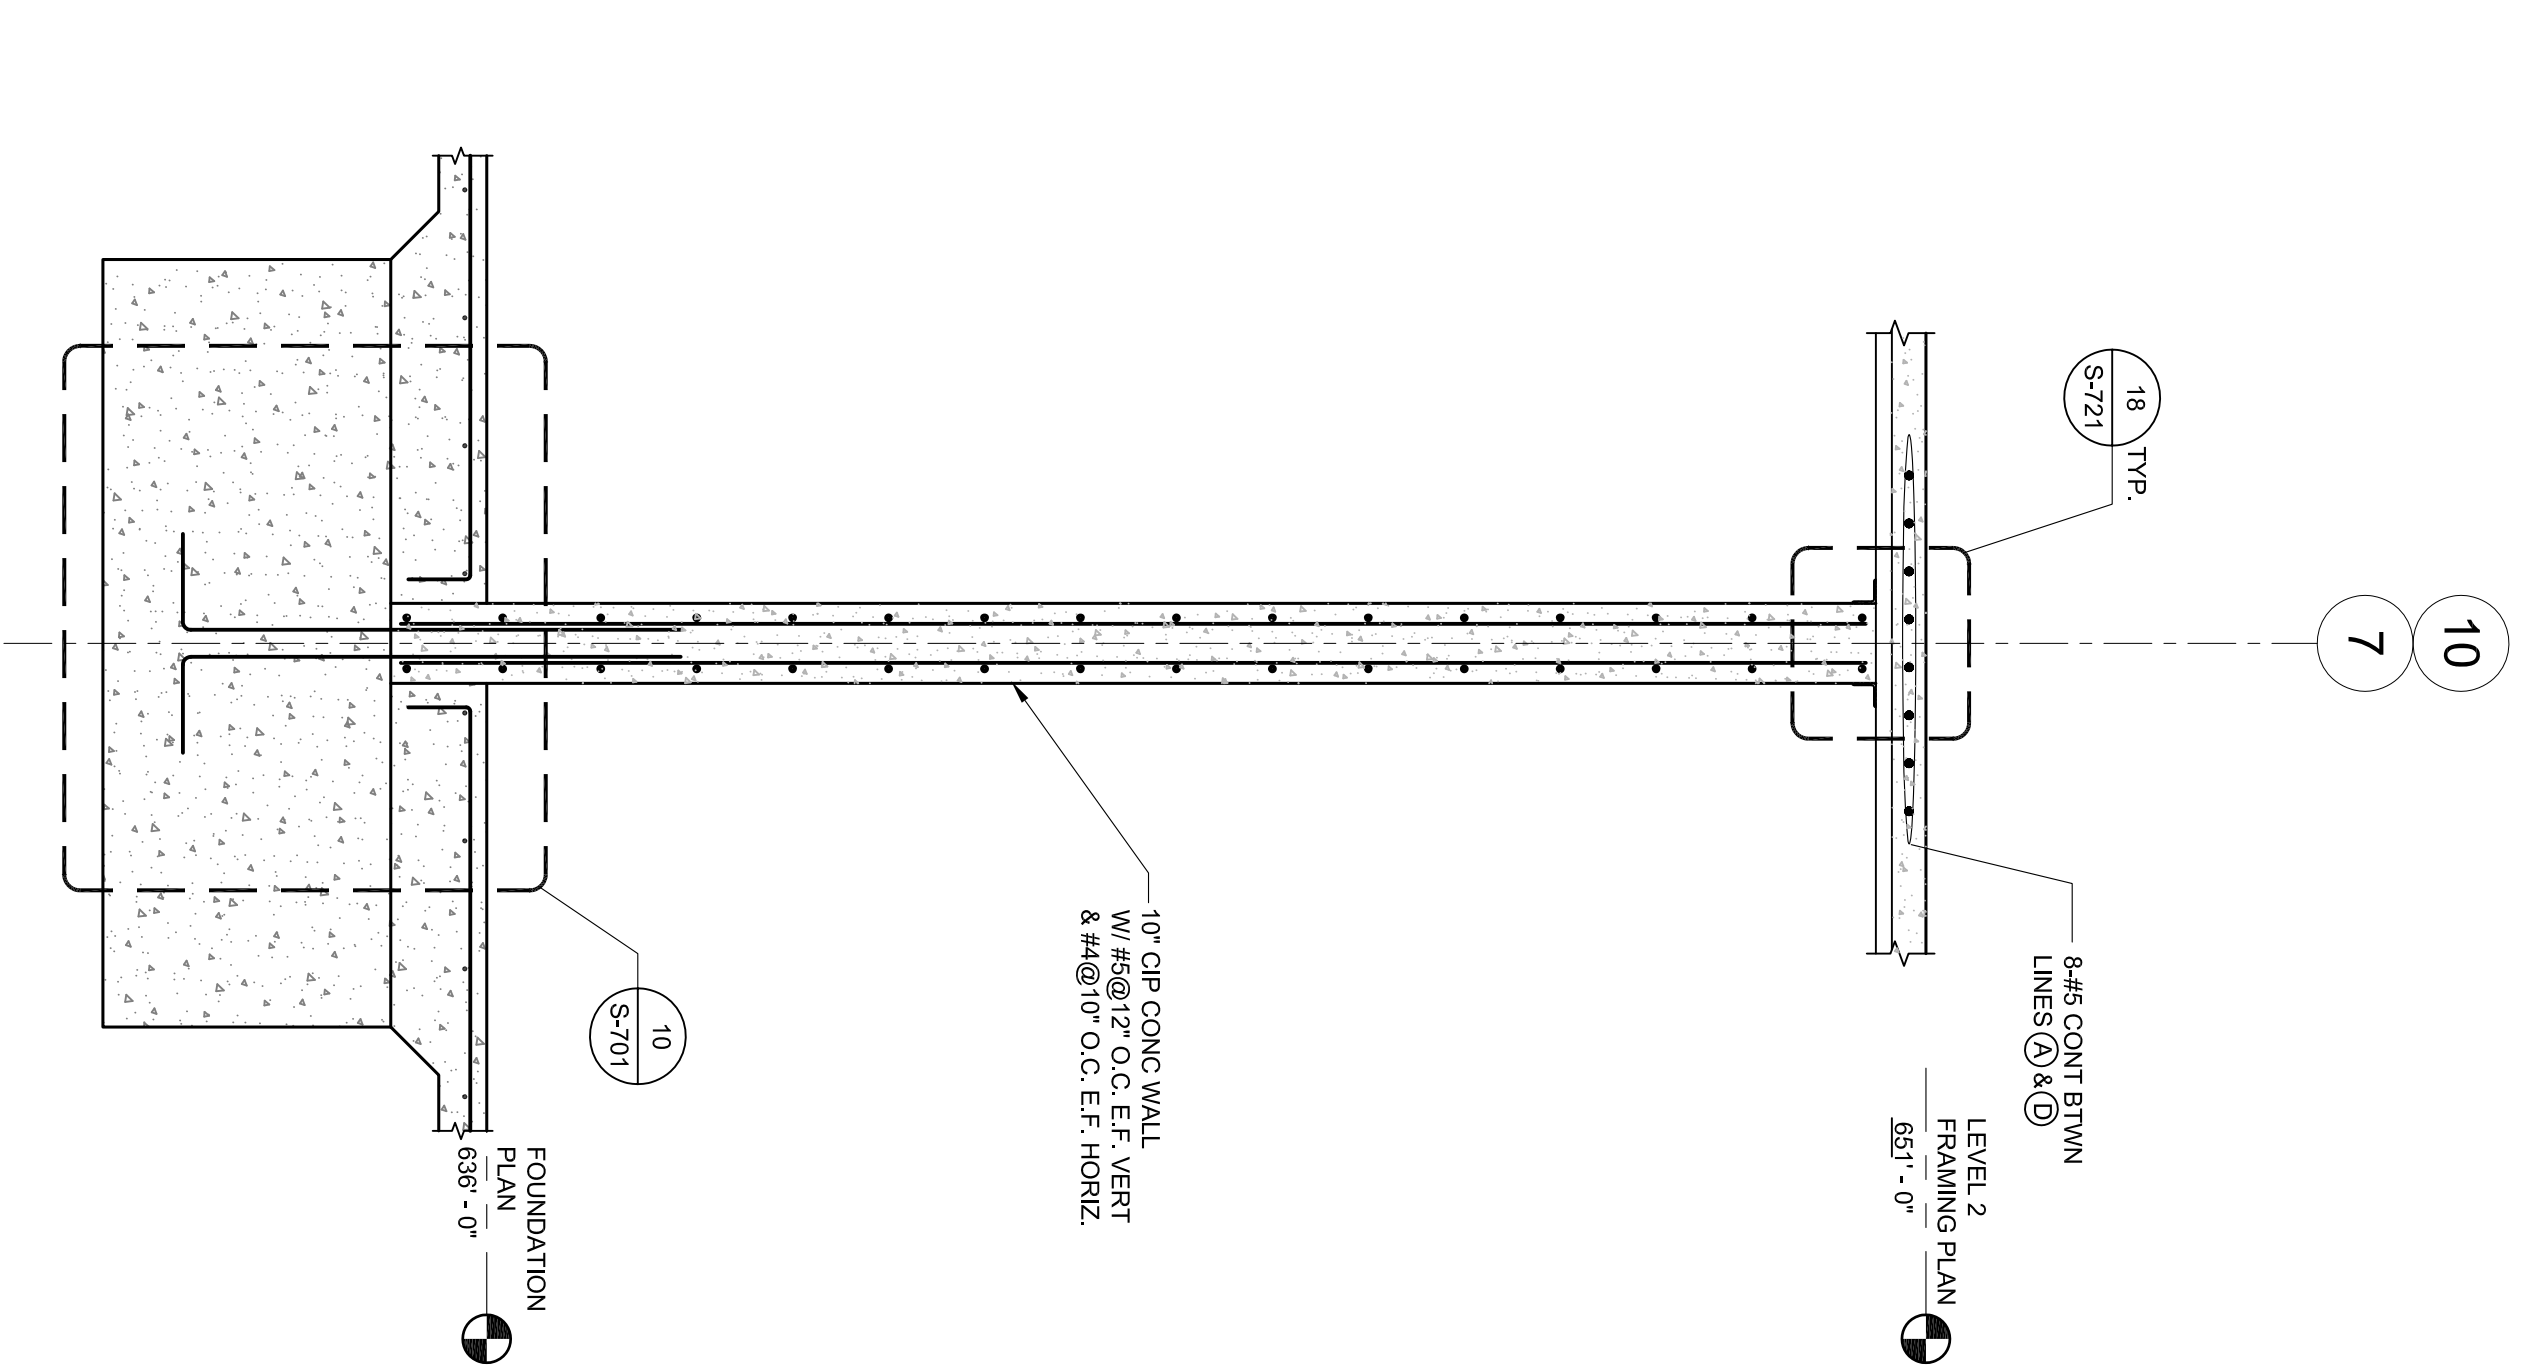


















**20 SECTION**  
 SCALE: 1/2"=1'-0"

All drawings and/or other graphical representations herein constitute a final and published work of the Architect/Engineer and may not be reproduced, used or modified without consent of Architect/Engineer.

1/16" dimension less than 1/32" or 1/8" dimension less than indicated from the original data. Notes should be adjusted. This line should be equal to one inch.

GRAVITY COLUMN BASE PLATE/ANCHOR BOLT SCHEDULE	ANCHOR BOLT	MIN. EMBT.	REMARKS
COLUMN SIZE	PLATE	THK	
HSS34x4x5/16	15"x15"	3/4"	4 - 3/4"Ø 14"
HSS36x8x1/2	17"x17"	3/4"	4 - 3/4"Ø 14"
W10x33	19"x19"	7/8"	4 - 3/4"Ø 14"
W10x54	20"x14"	1 1/4"	4 - 3/4"Ø 14"
W12x58	22"x14"	1 1/4"	4 - 1"Ø 14"
W12x65	22"x22"	1 1/2"	4 - 1"Ø 14"
W12x96	22"x22"	1 1/2"	4 - 1"Ø 14"
HSS12x12x1/2	14"x23 1/2"	2 1/2"	6 - 1 1/4"Ø 24"
HSS14x14x5/8	14"x23 1/2"	2 1/2"	6 - 1 1/4"Ø 24"

   NOTES:  
1. BASE PLATE SIZE ARE TYP. U.O.N.  
2. DIM. A IS PARALLEL TO COLUMN WEB.  
3. I = THICKNESS OF COLUMN WEB OR FLANGE OR WALL (AS APPLICABLE).

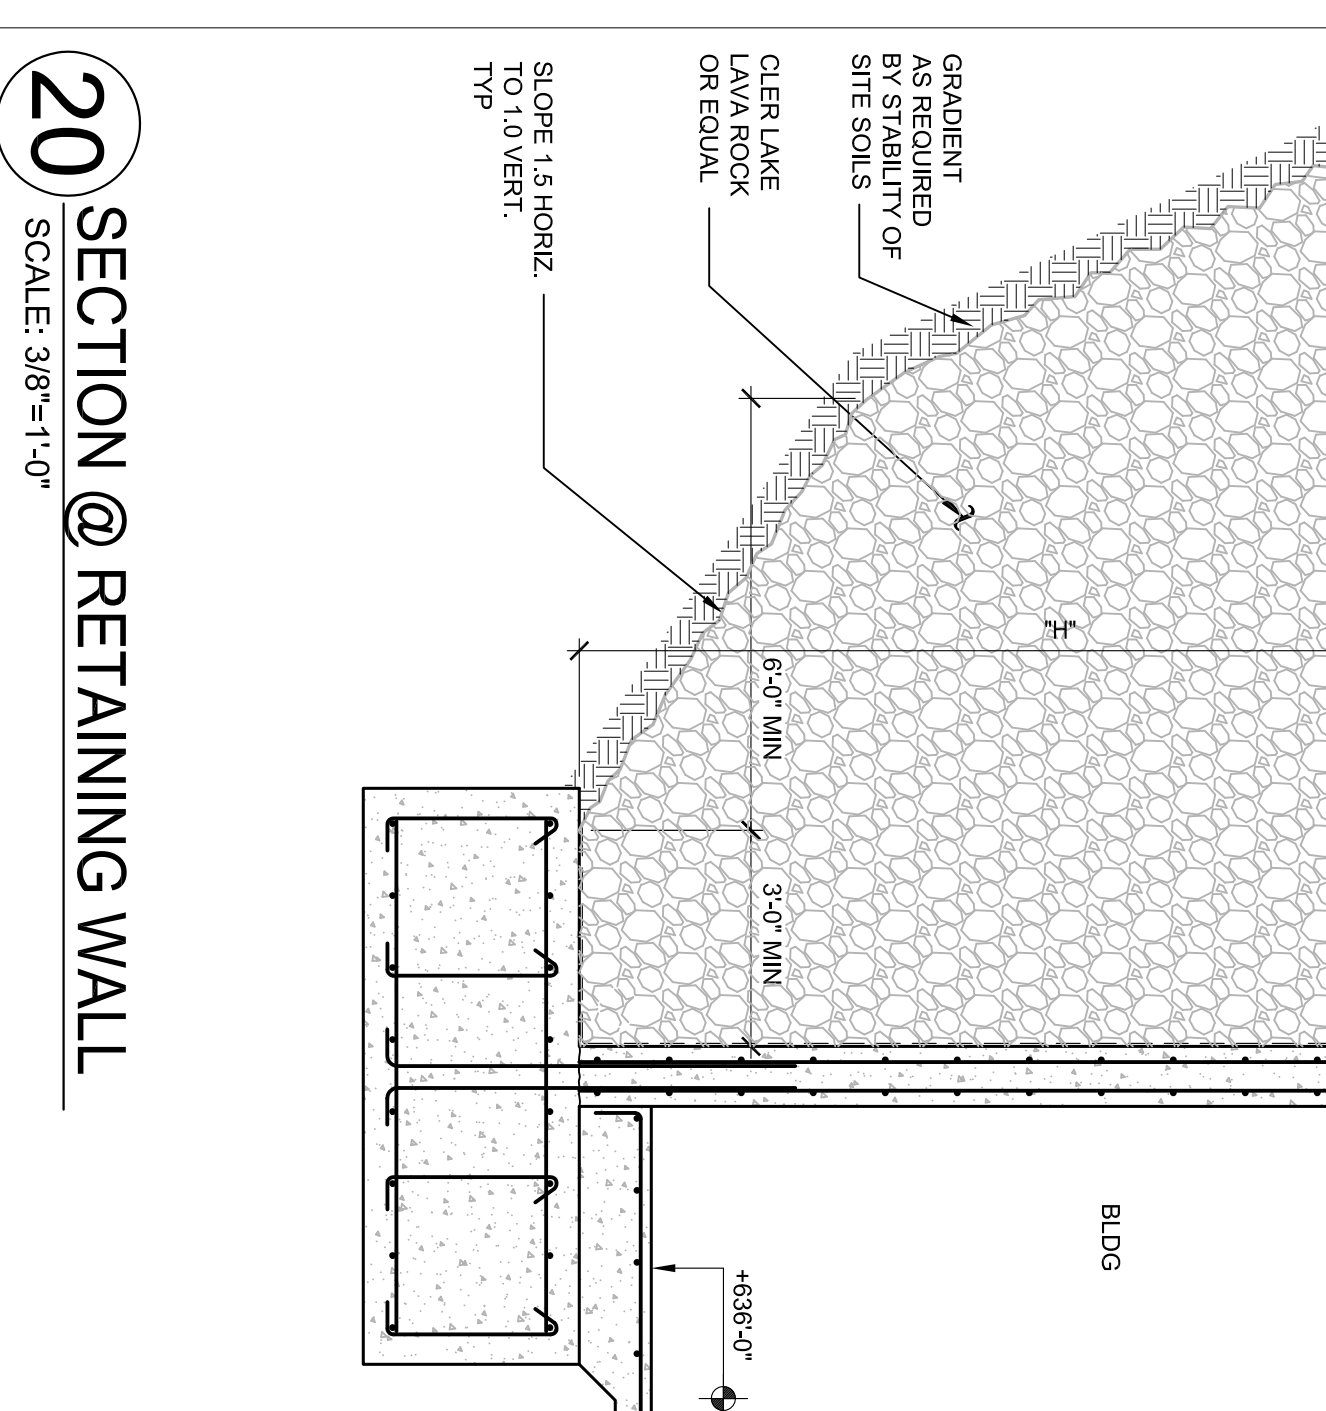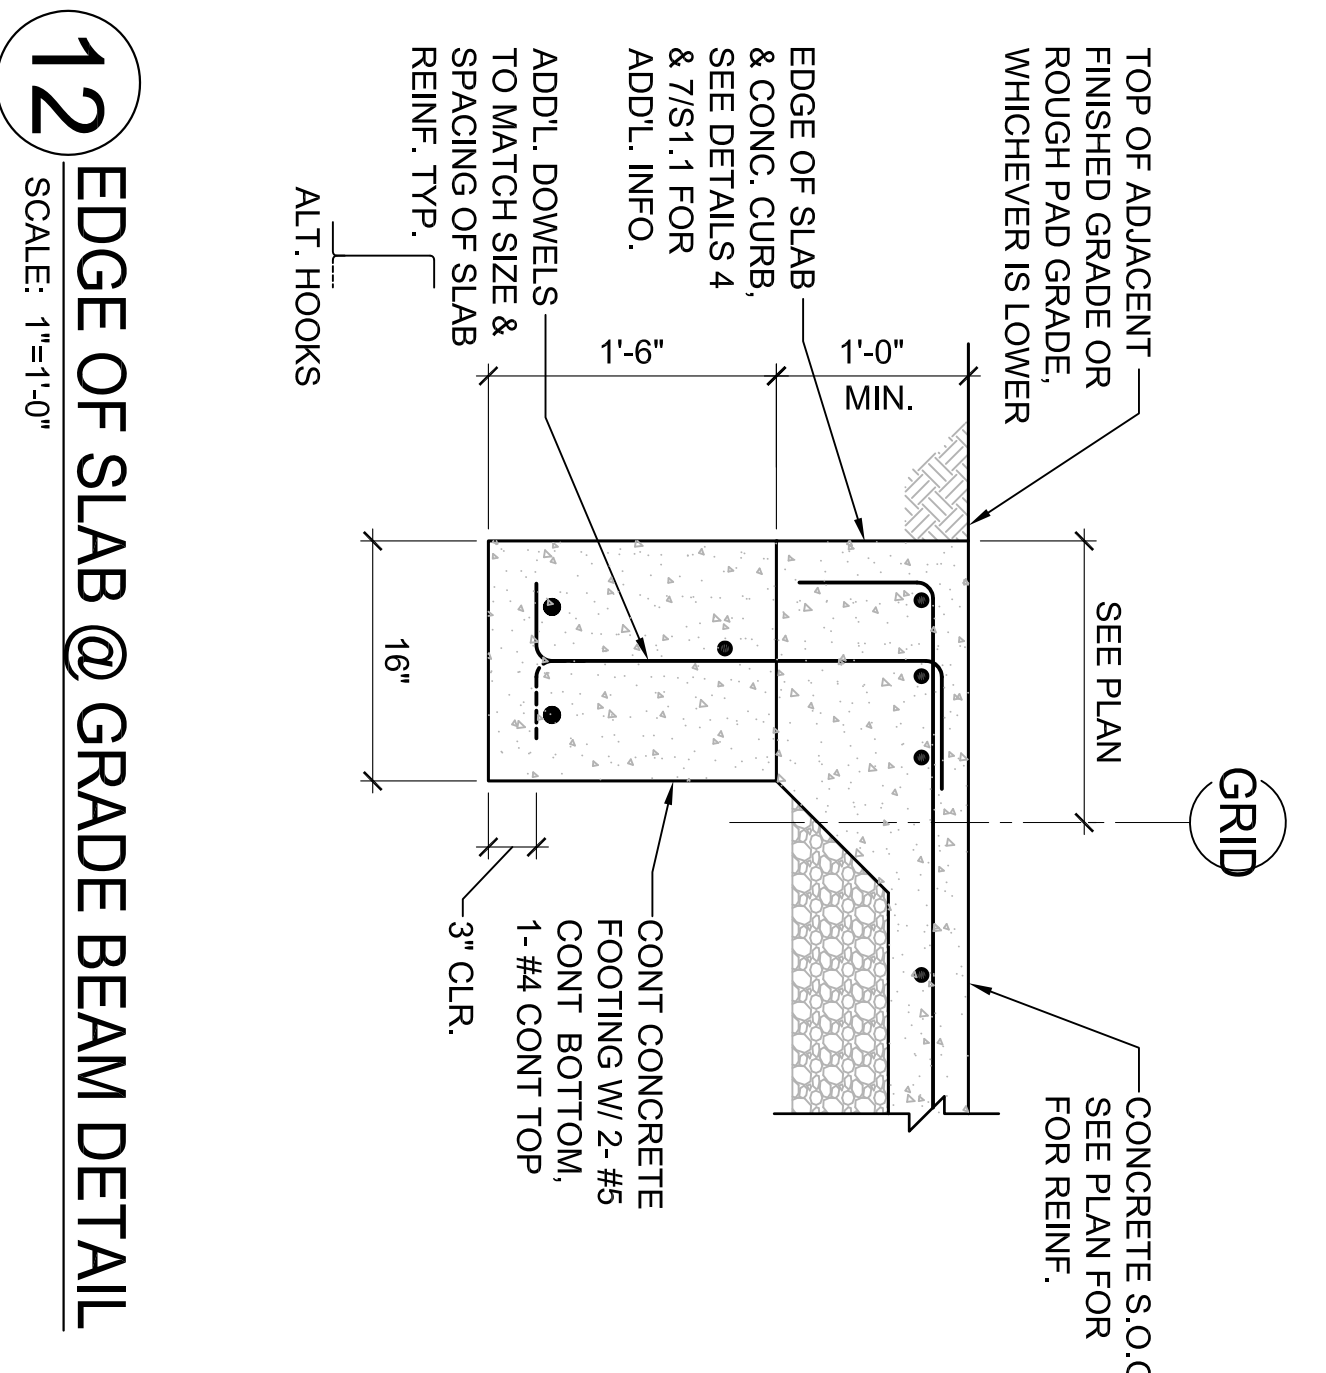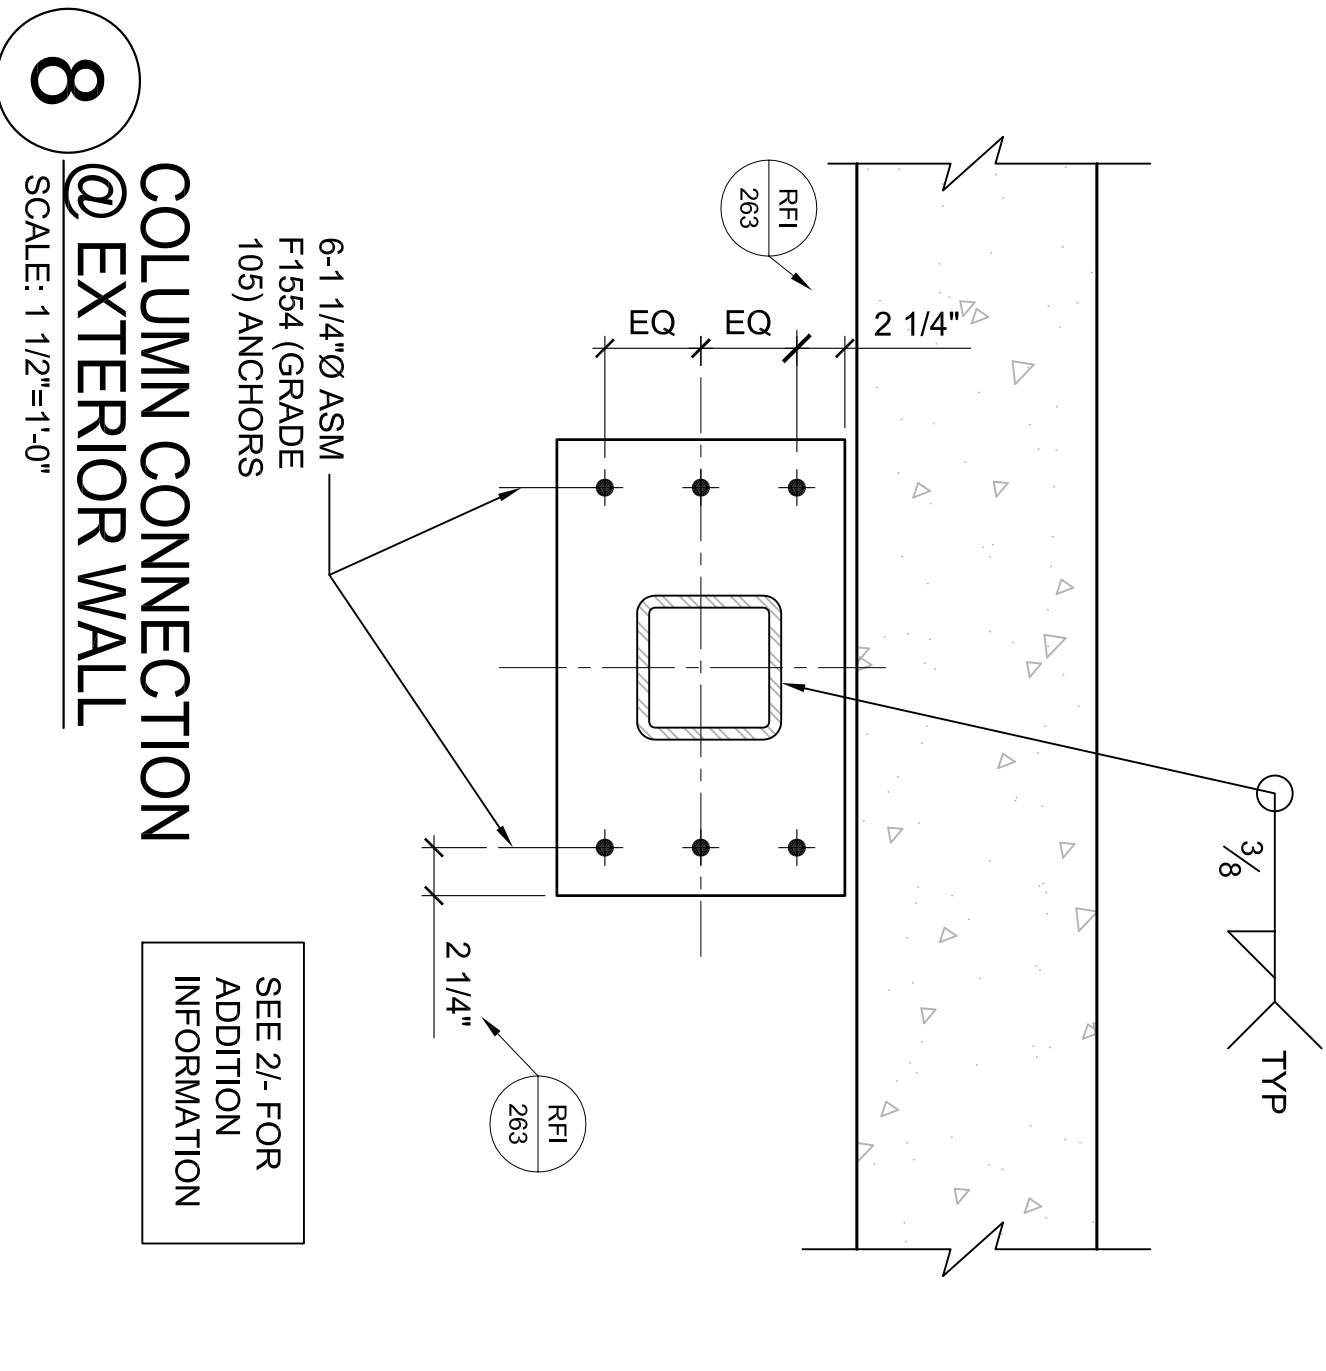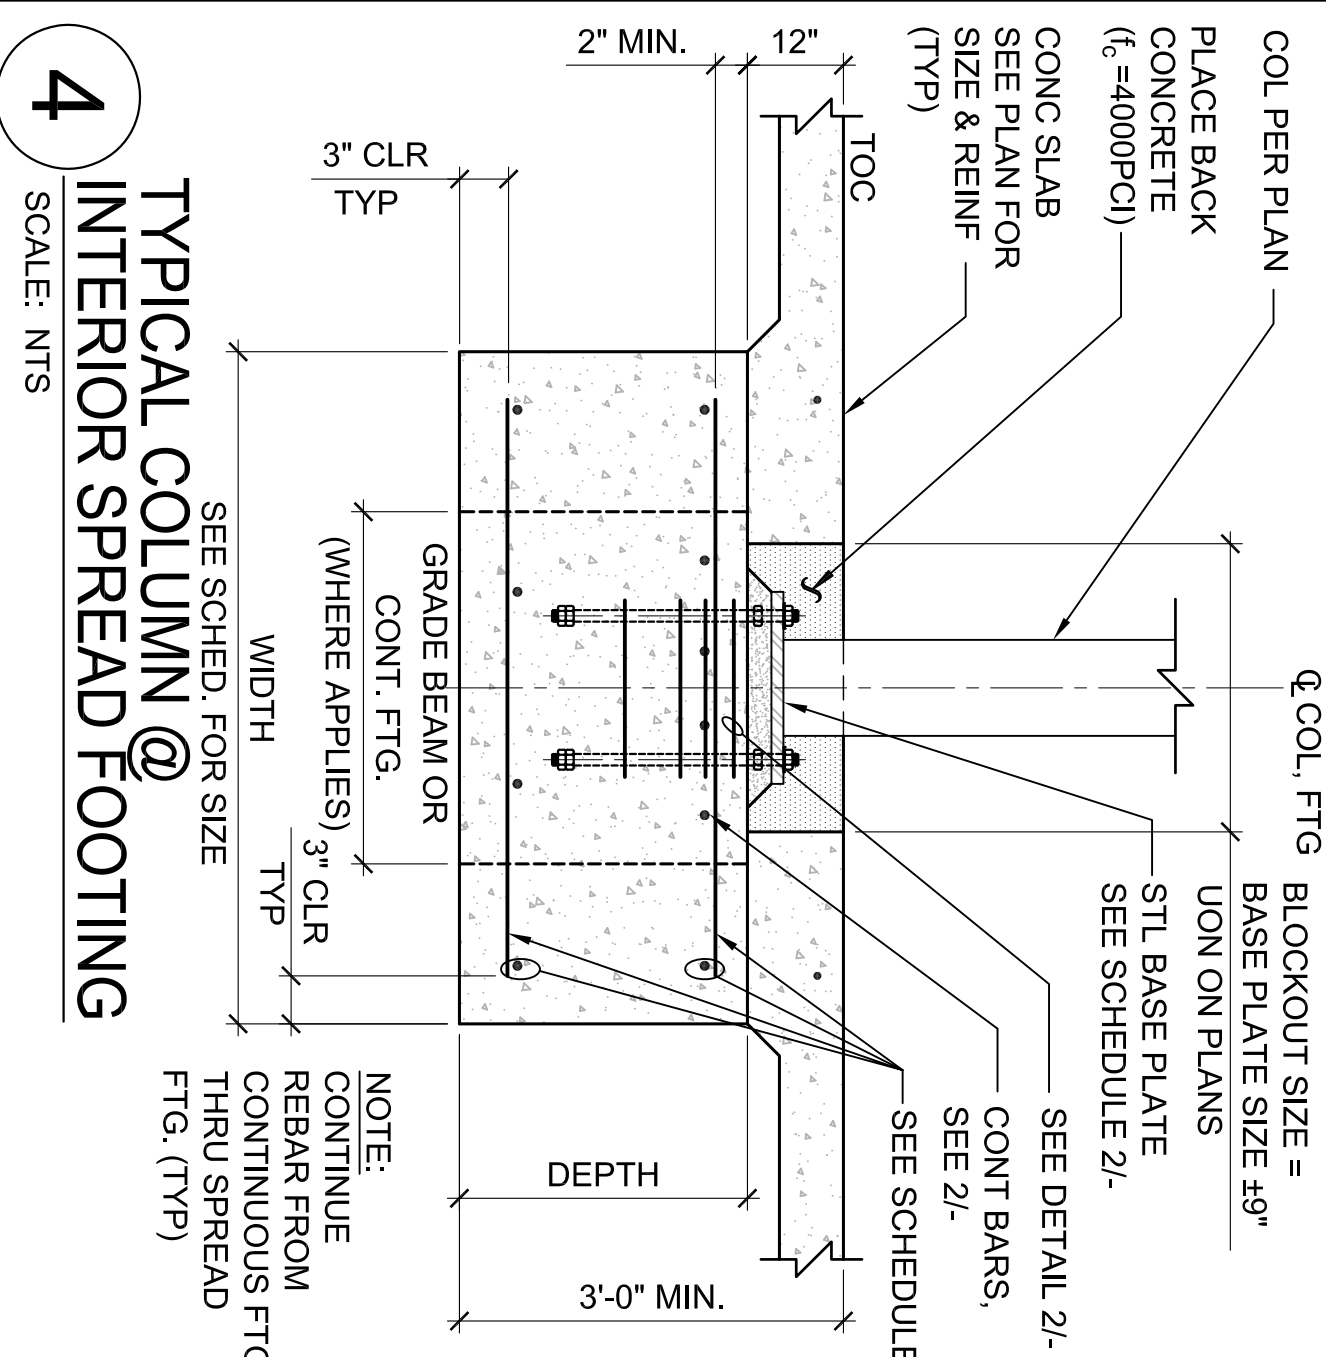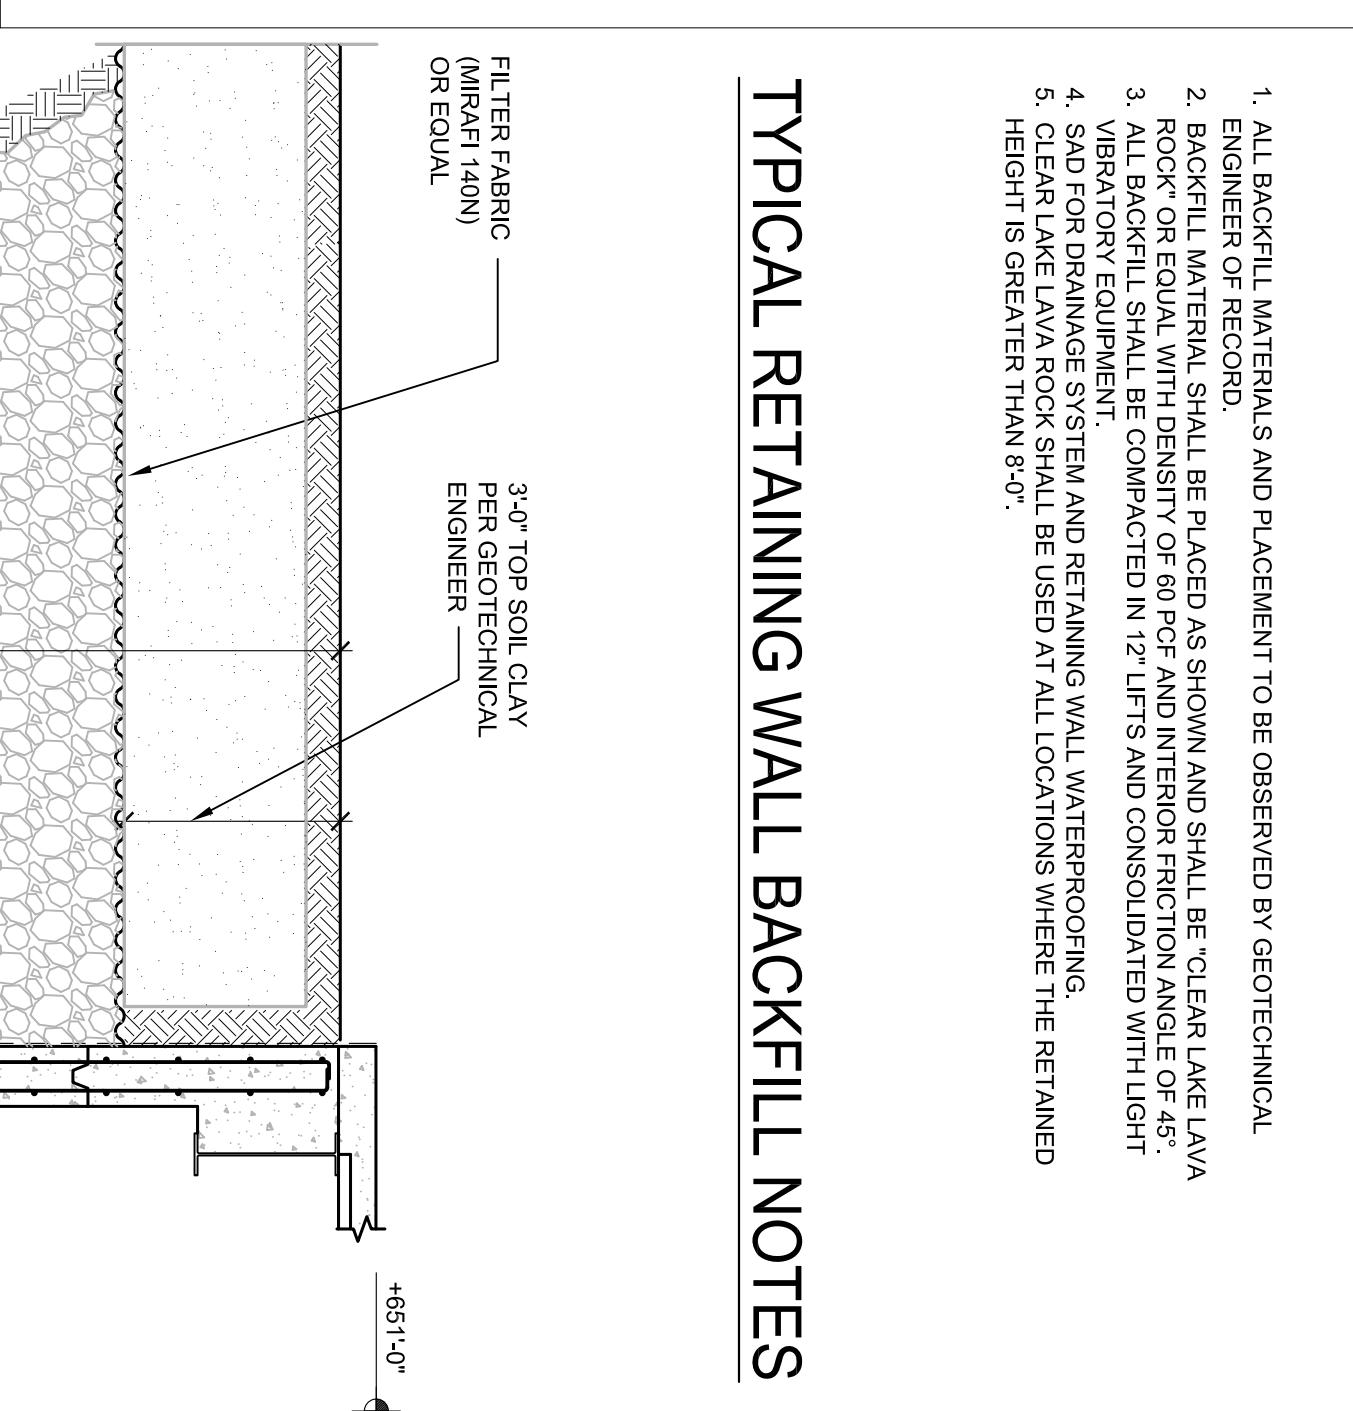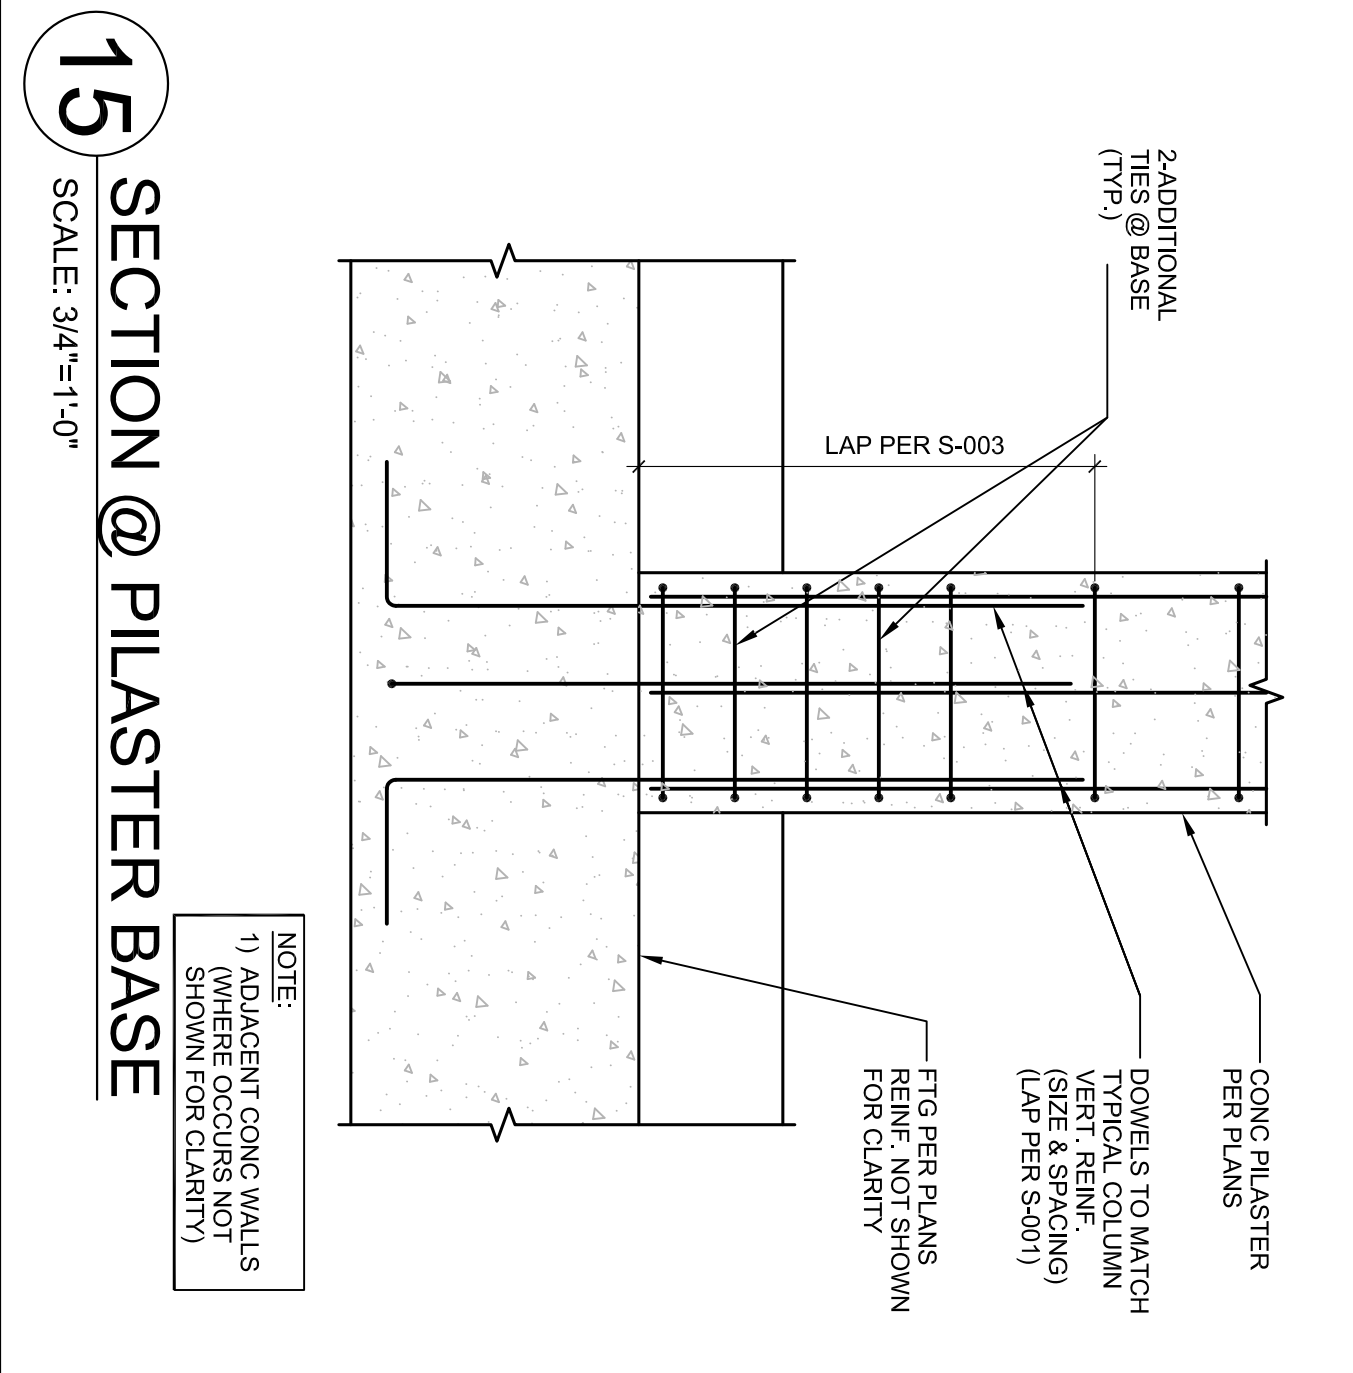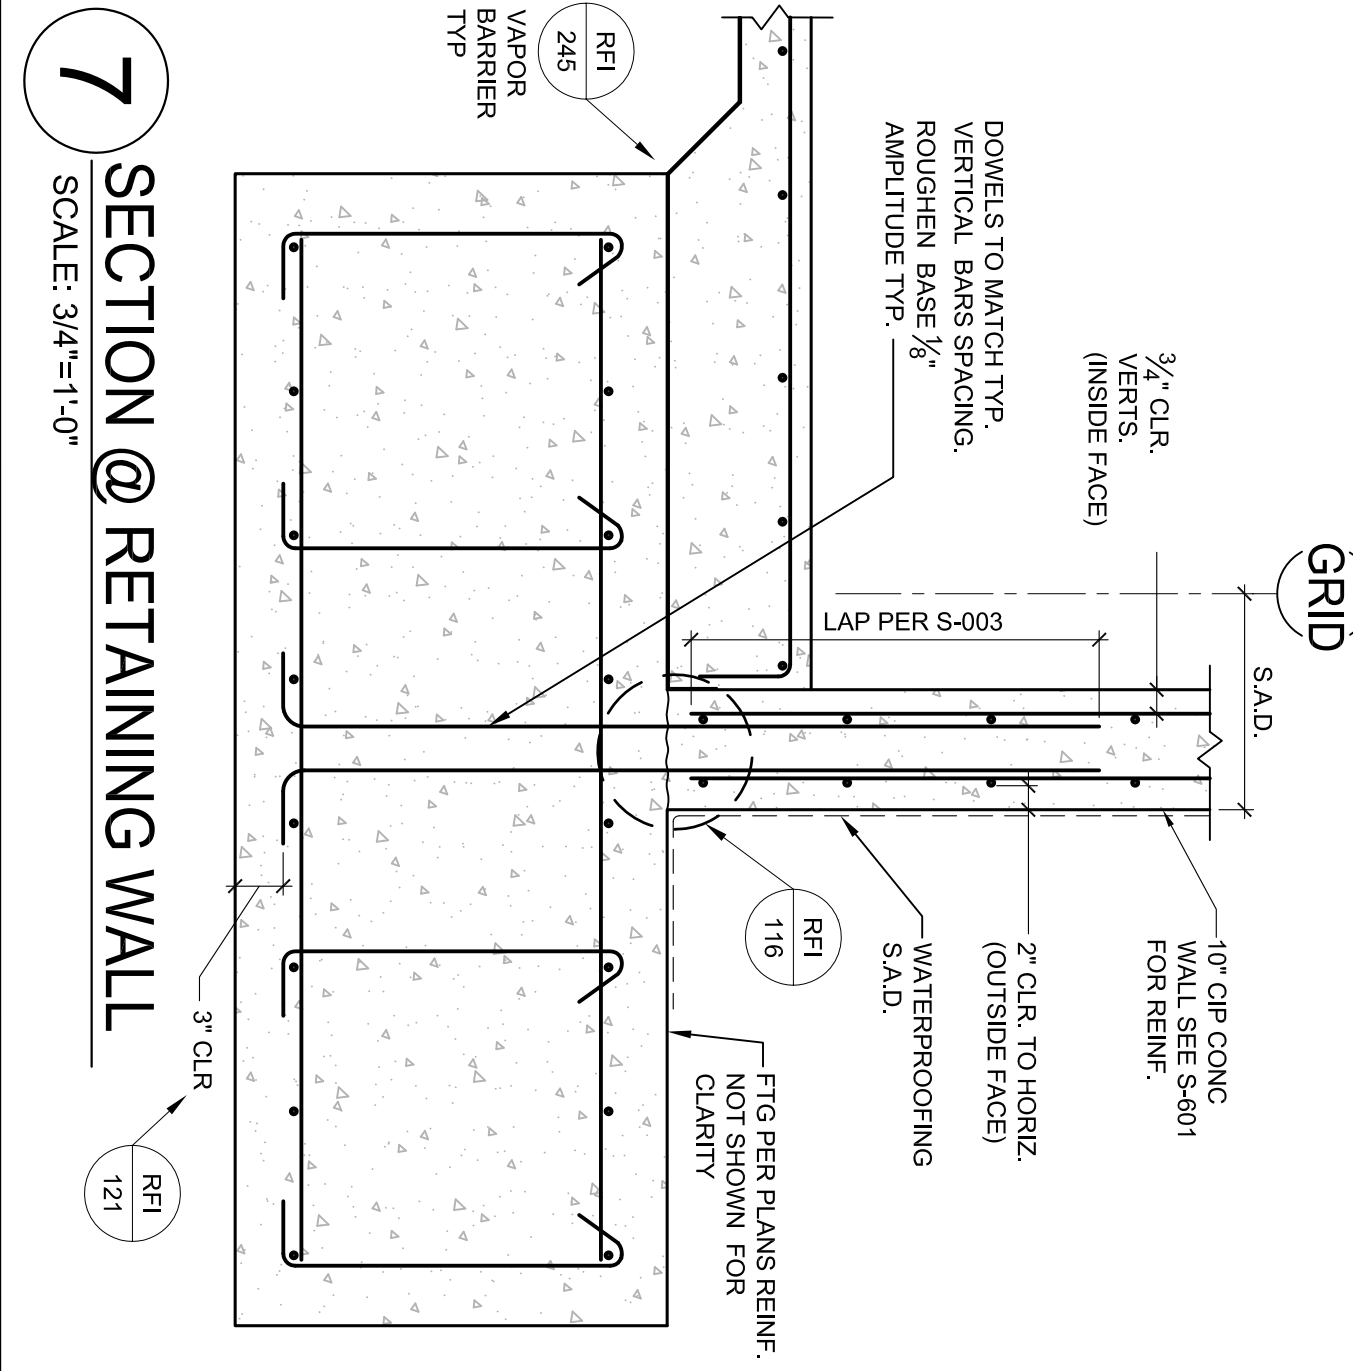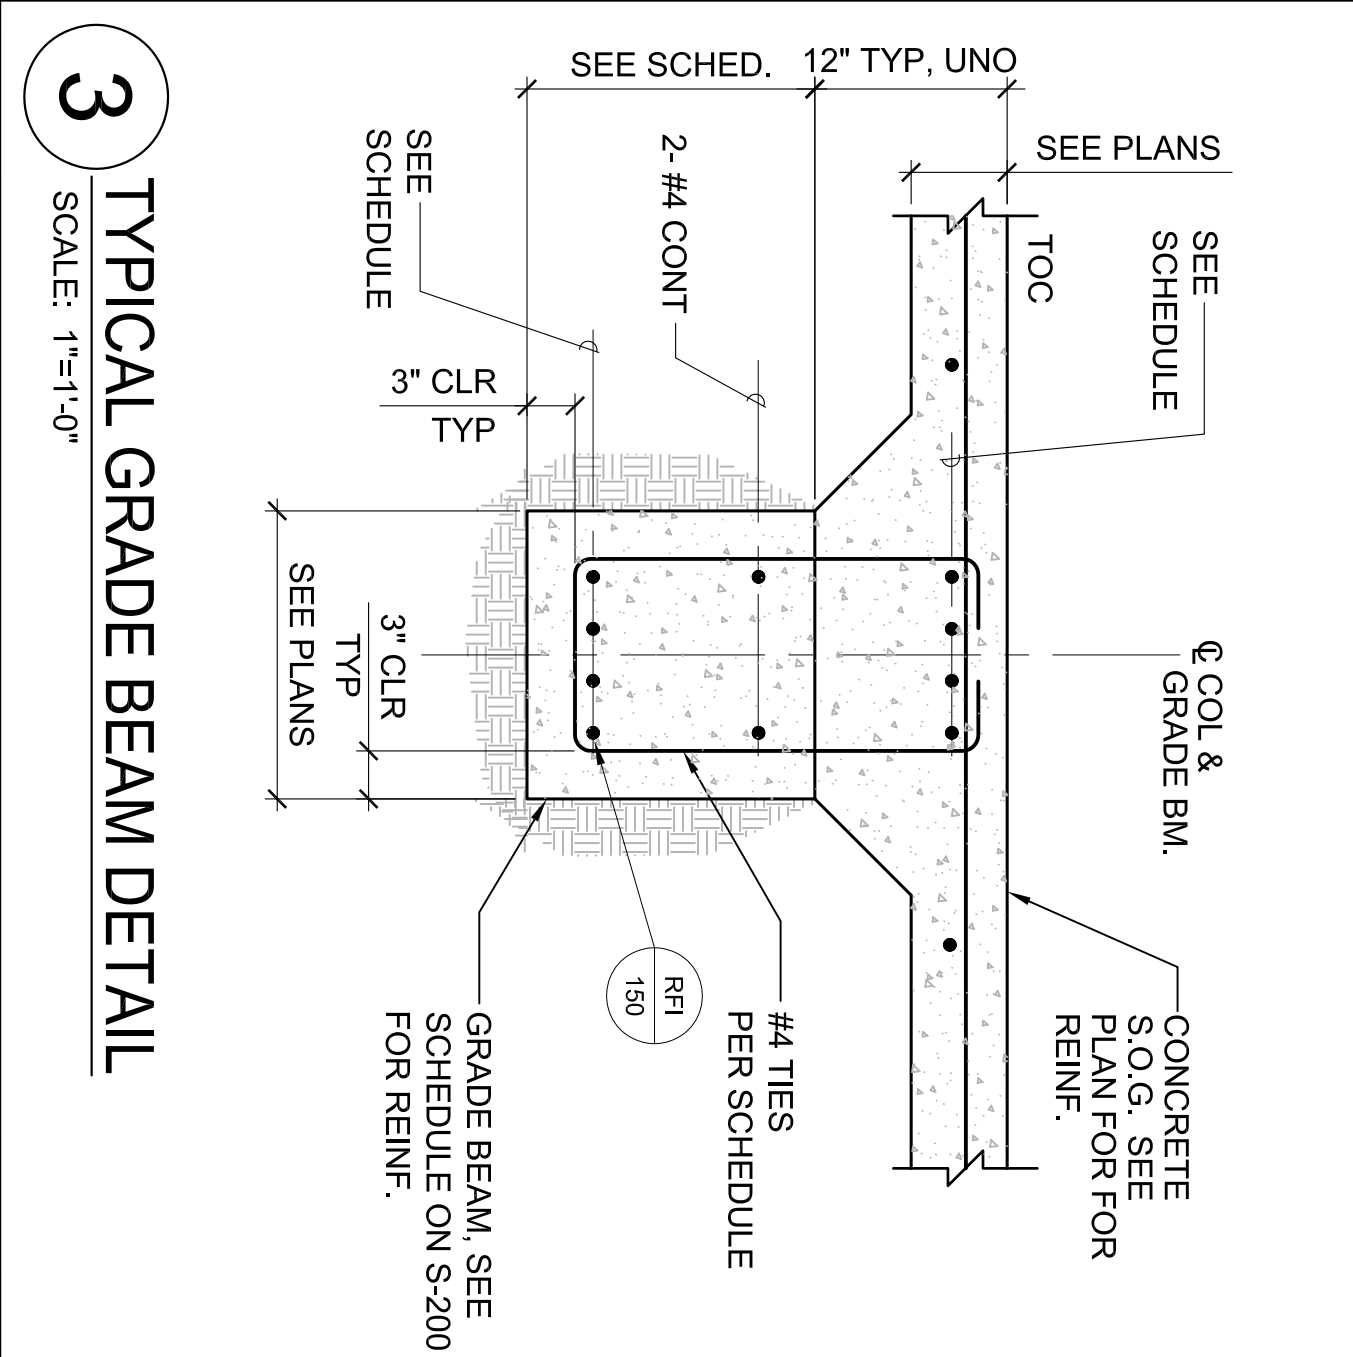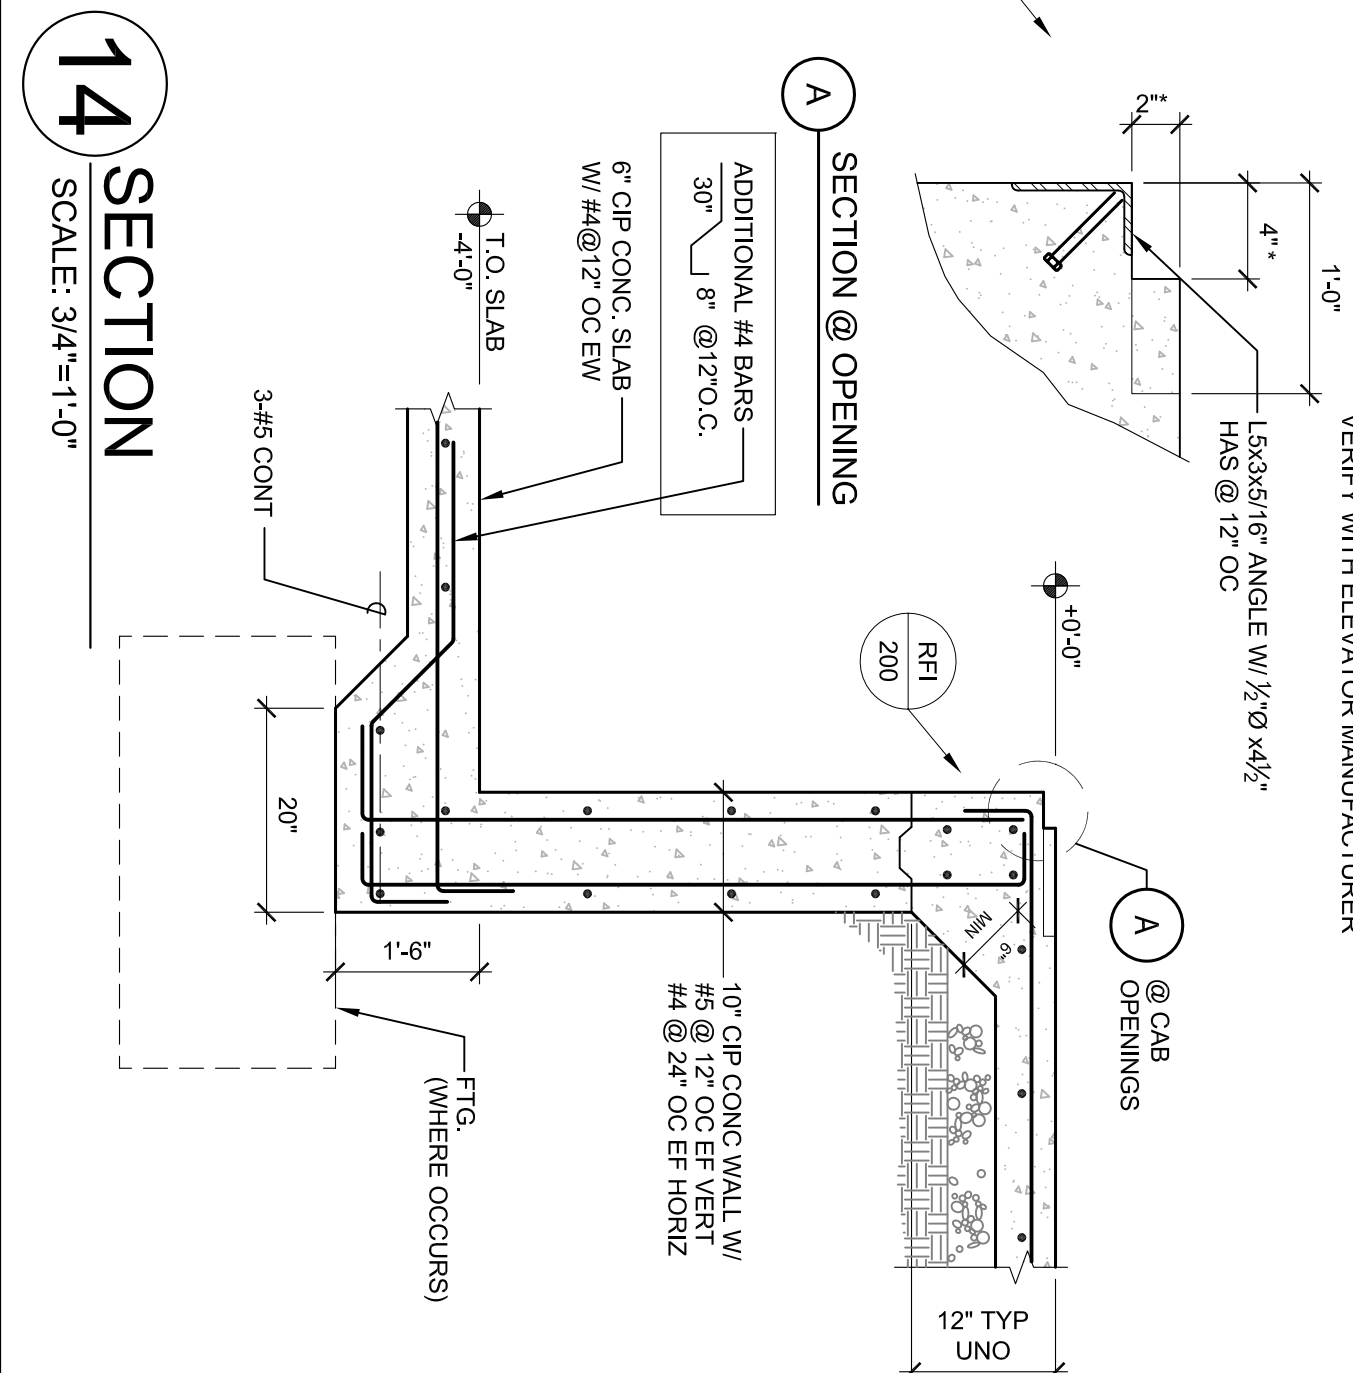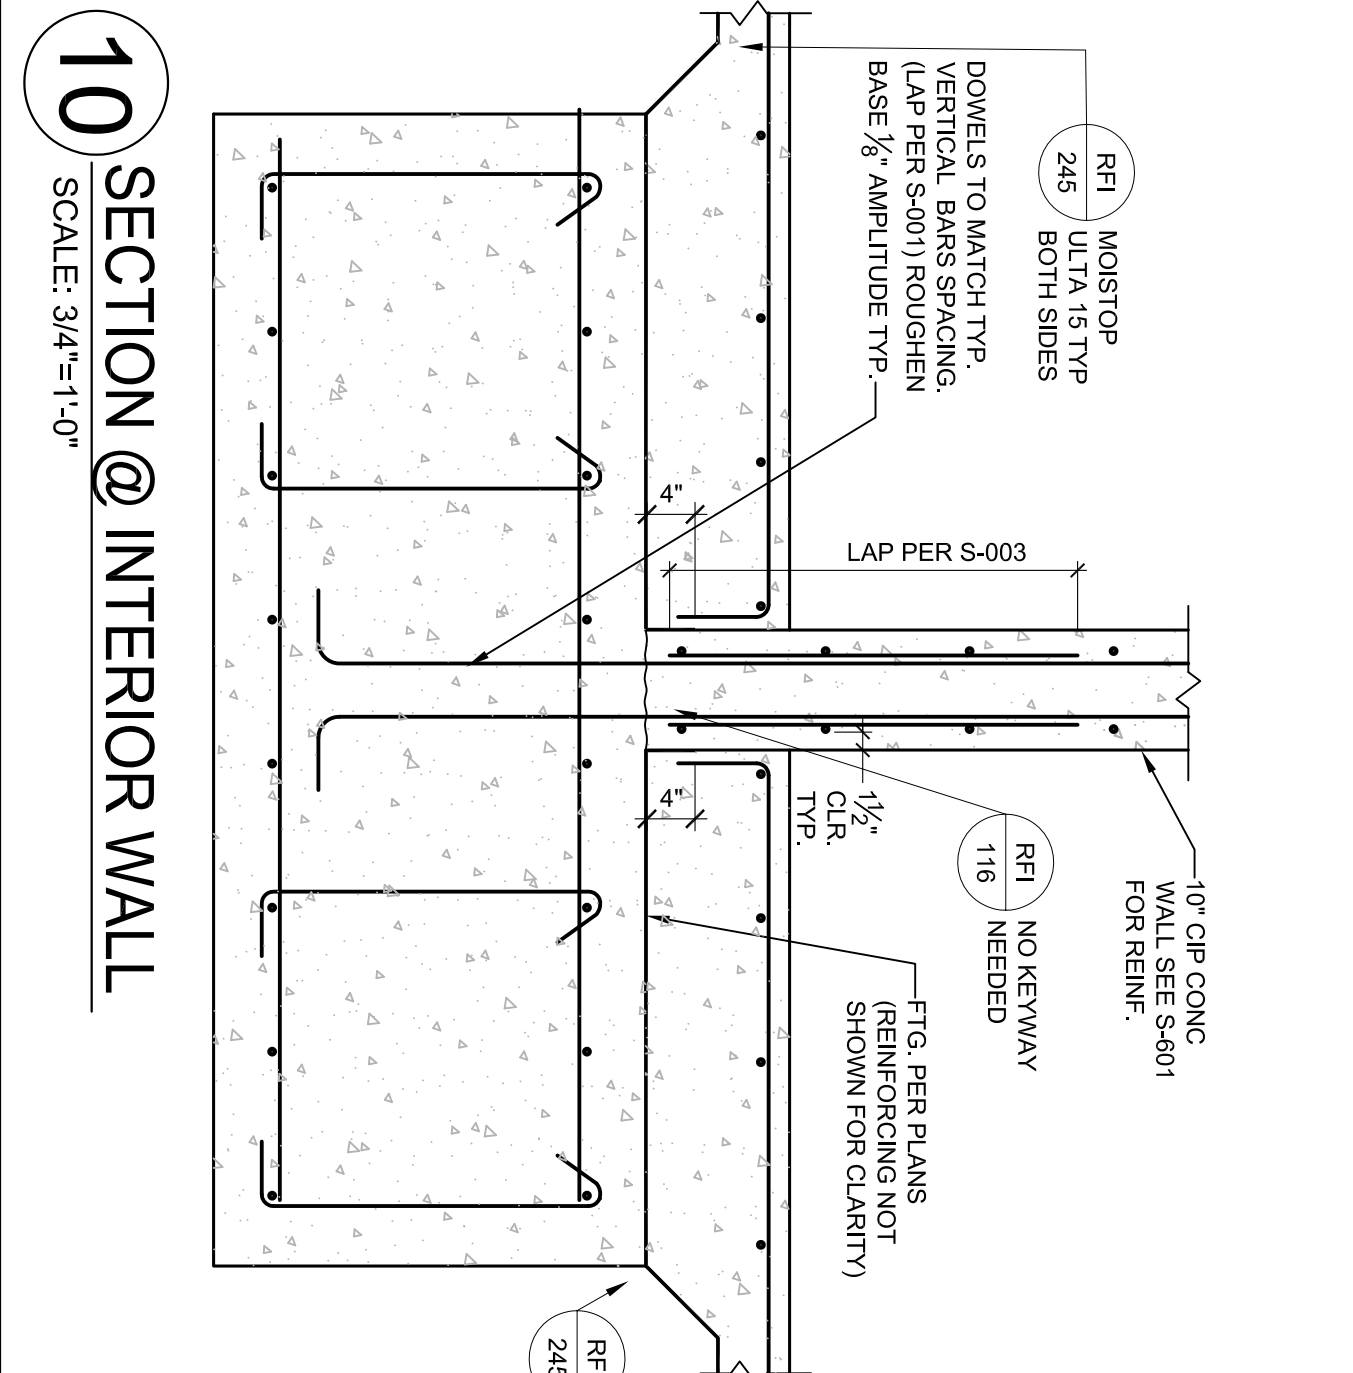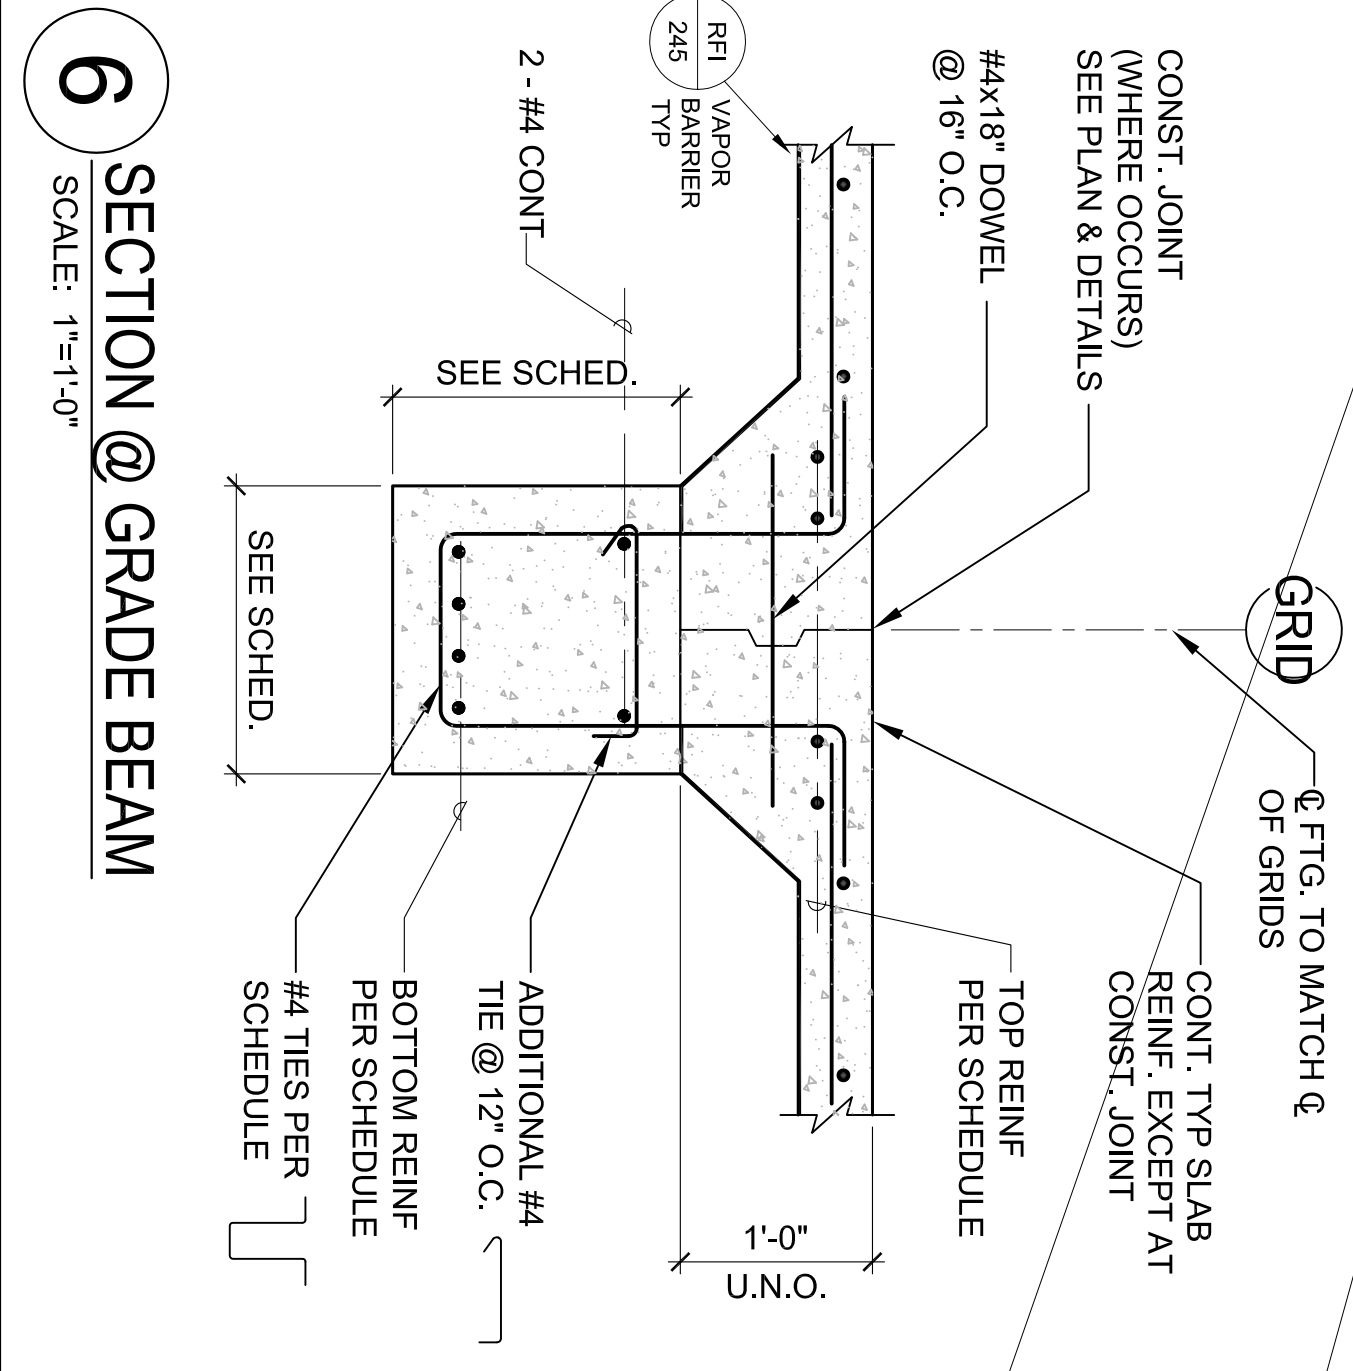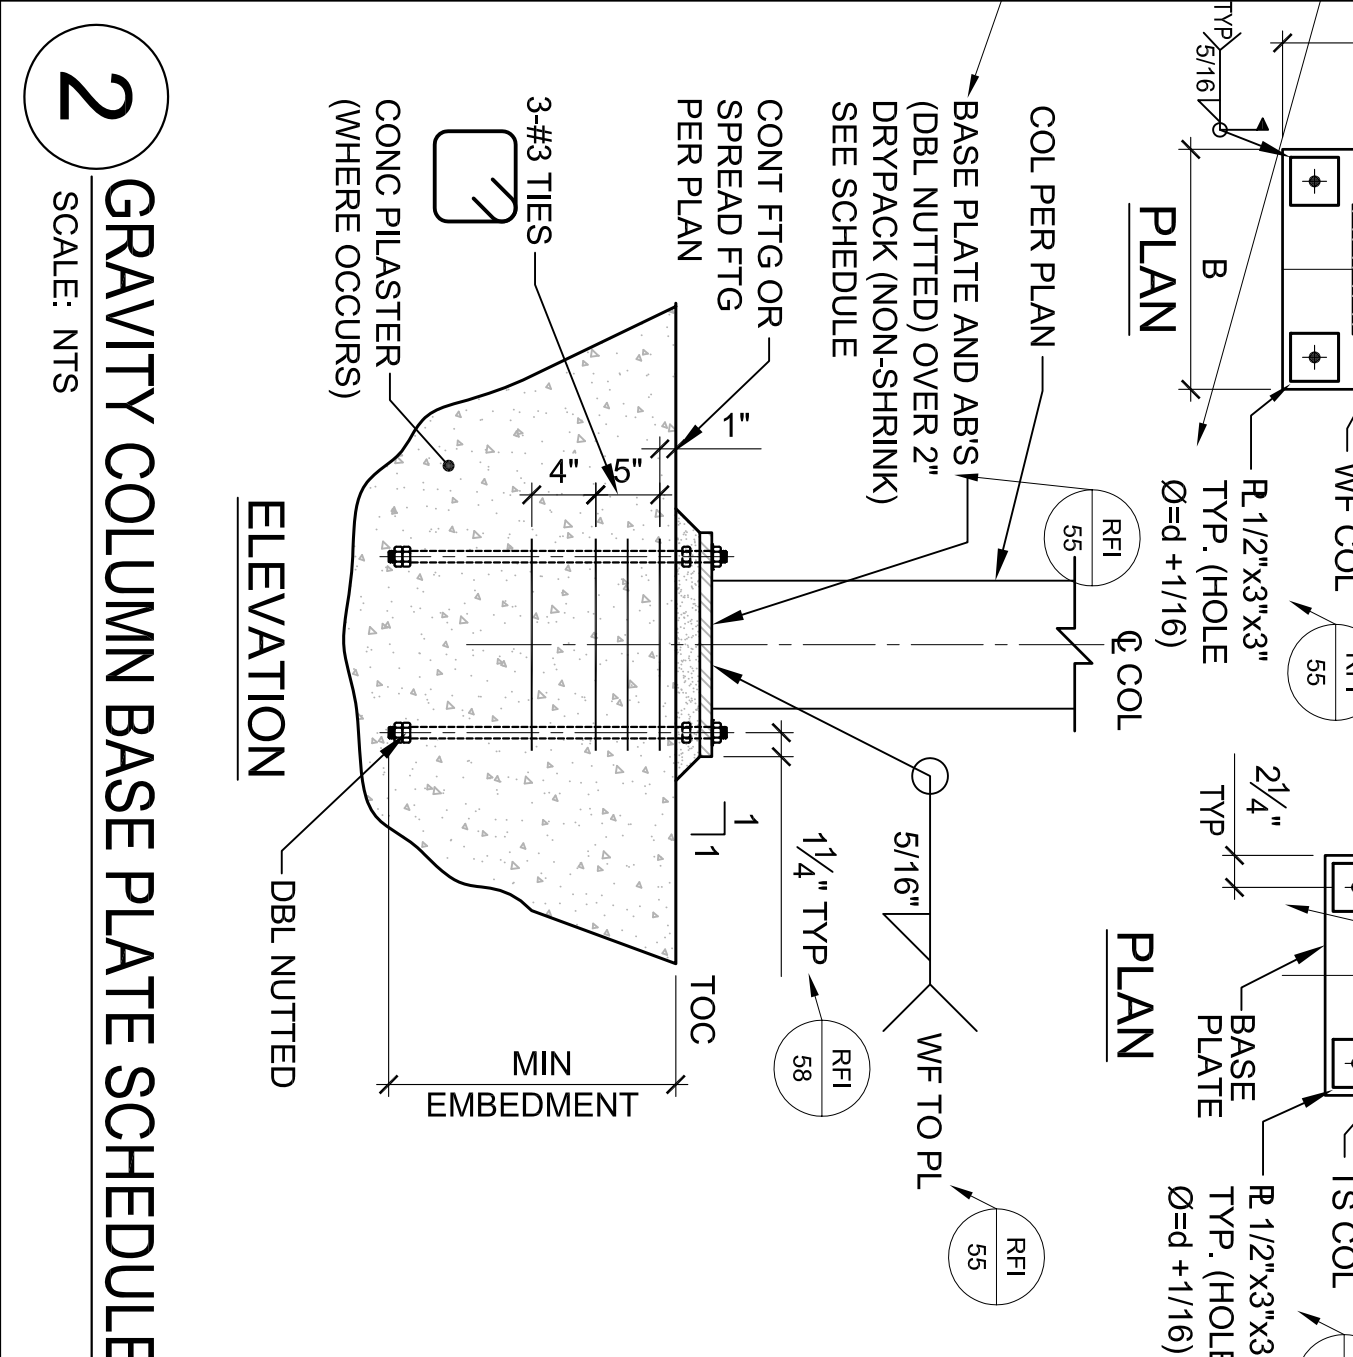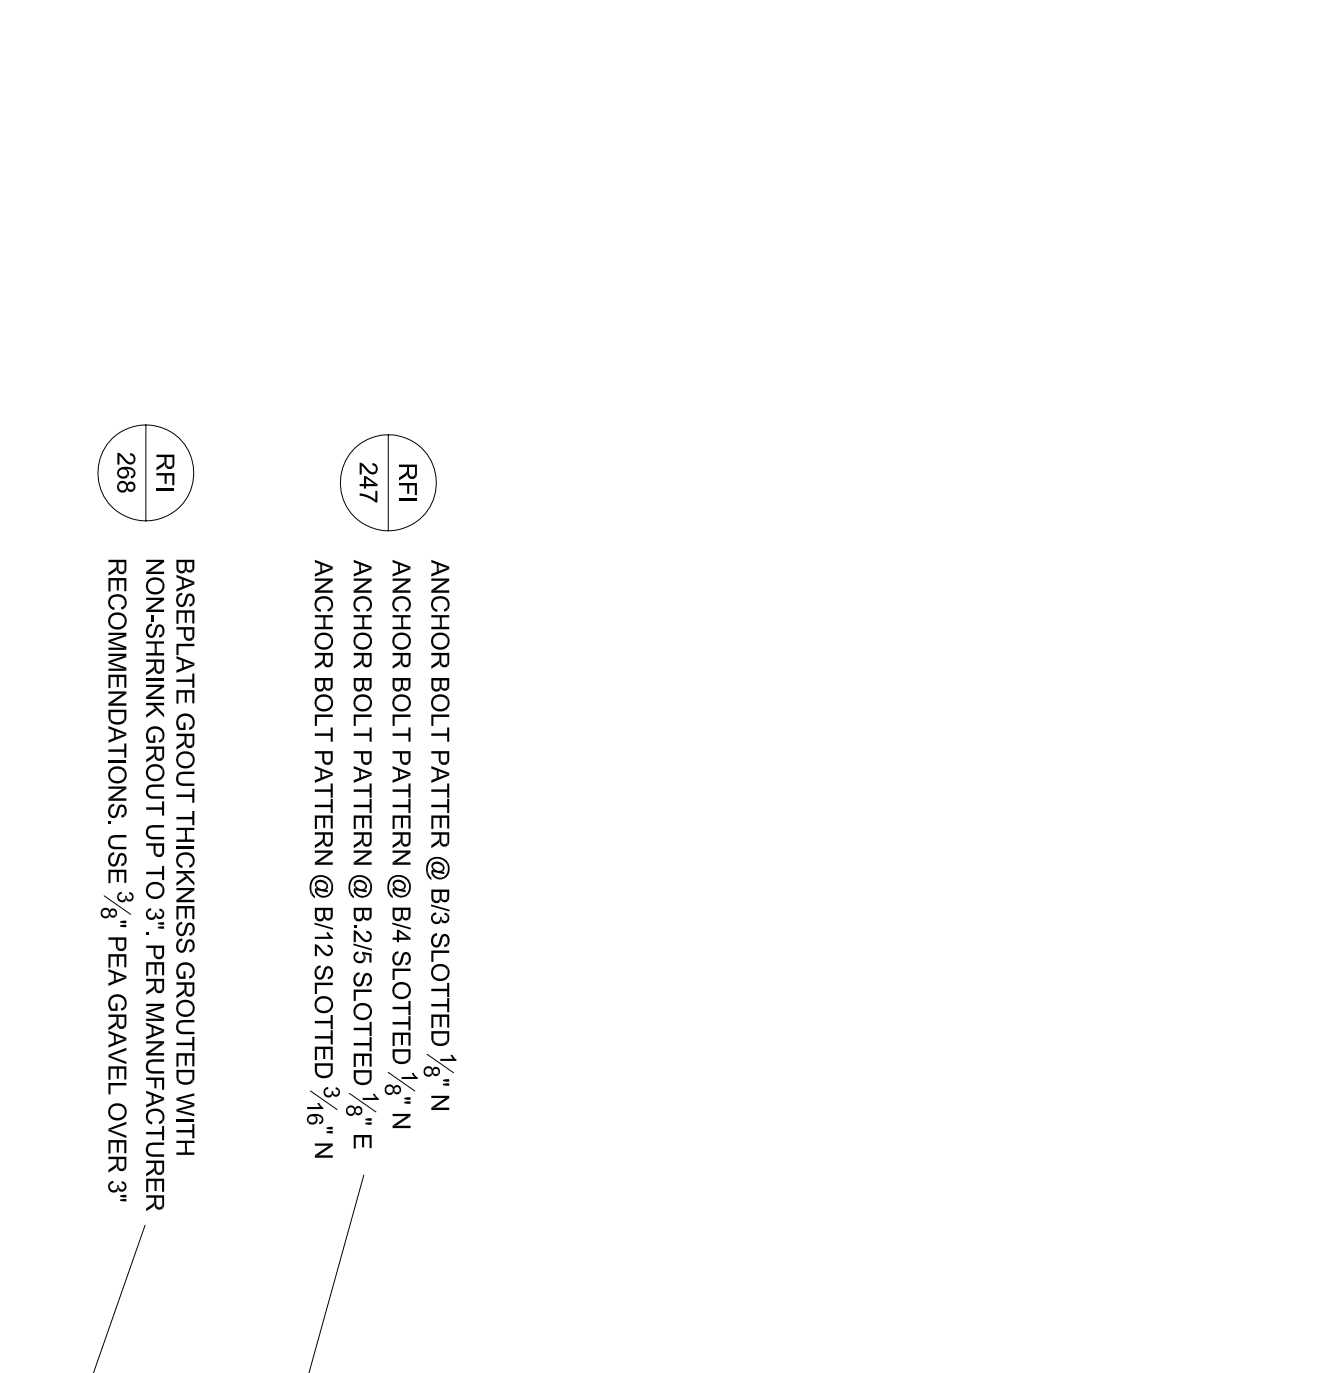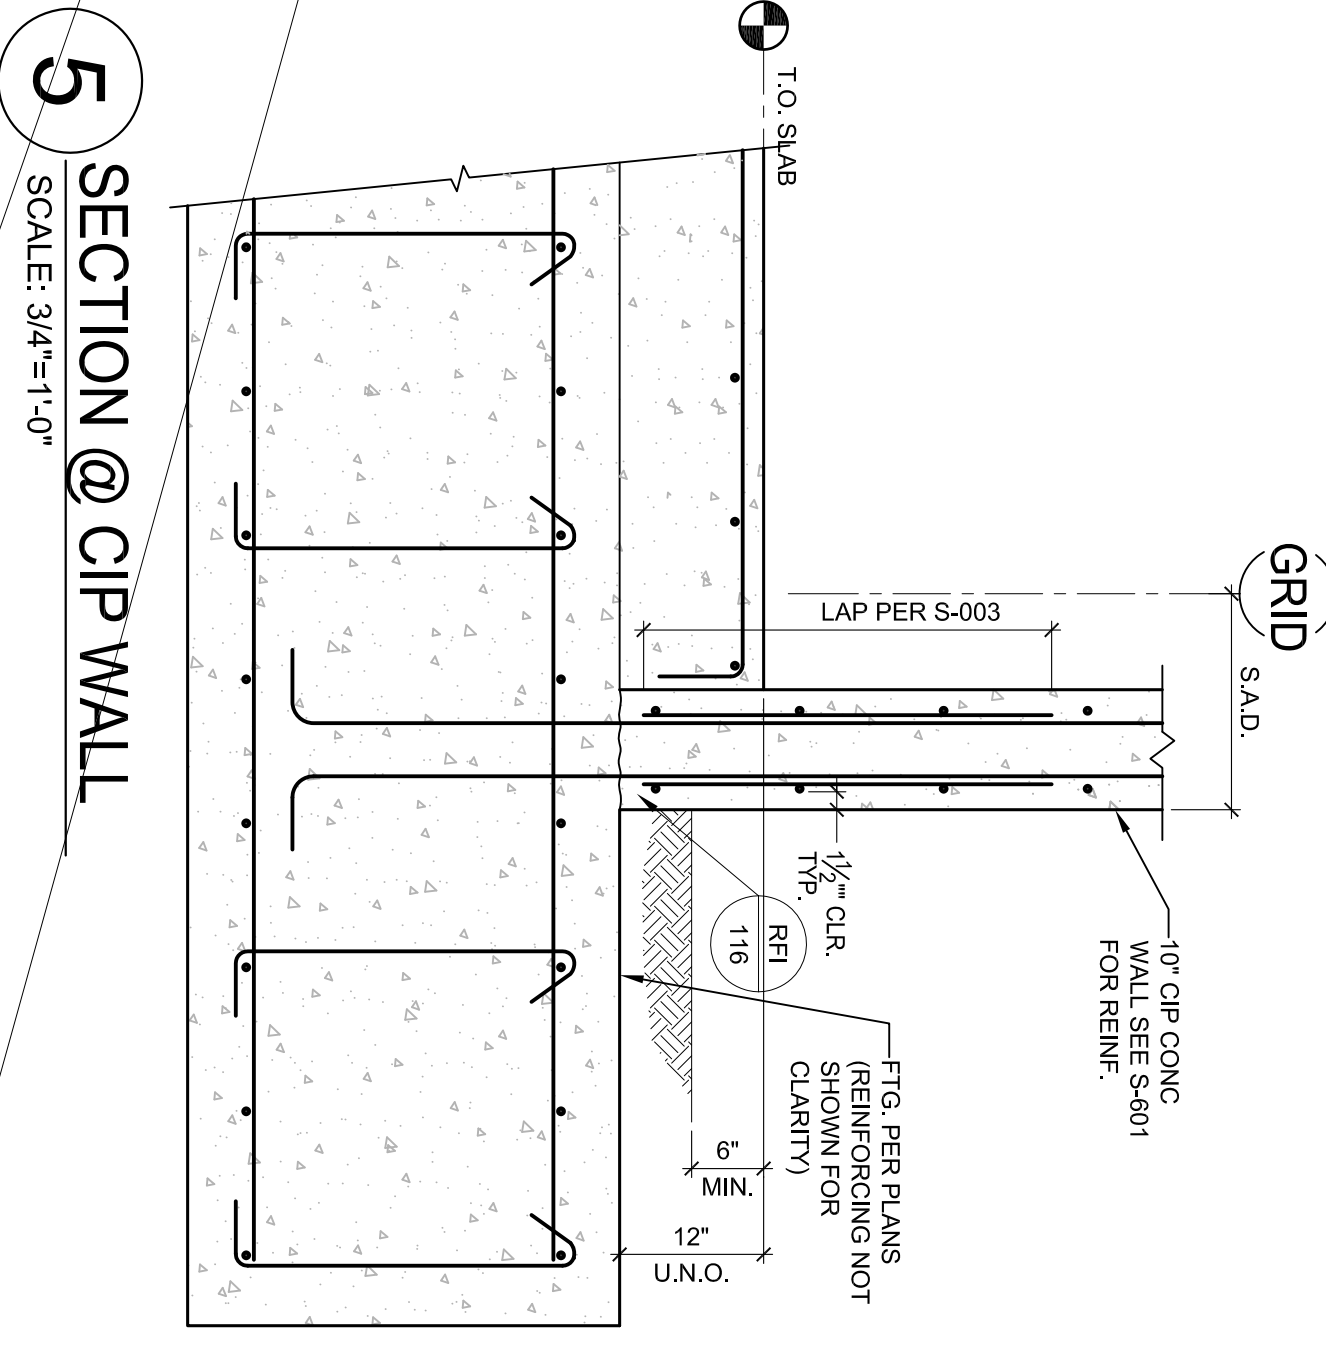




















20 SECTION @ RETAINING WALL  
SCALE: 3/8"=1'-0"













15 SECTION @ PILASTER BASE  
SCALE: 3/4"=1'-0"

12 EDGE OF SLAB @ GRADE BEAM DETAIL  
SCALE: 1"=1'-0"

8 COLUMN CONNECTION @ EXTERIOR WALL  
SCALE: 1 1/2"=1'-0"

4 TYPICAL COLUMN @ INTERIOR SPREAD FOOTING  
SCALE: NTS

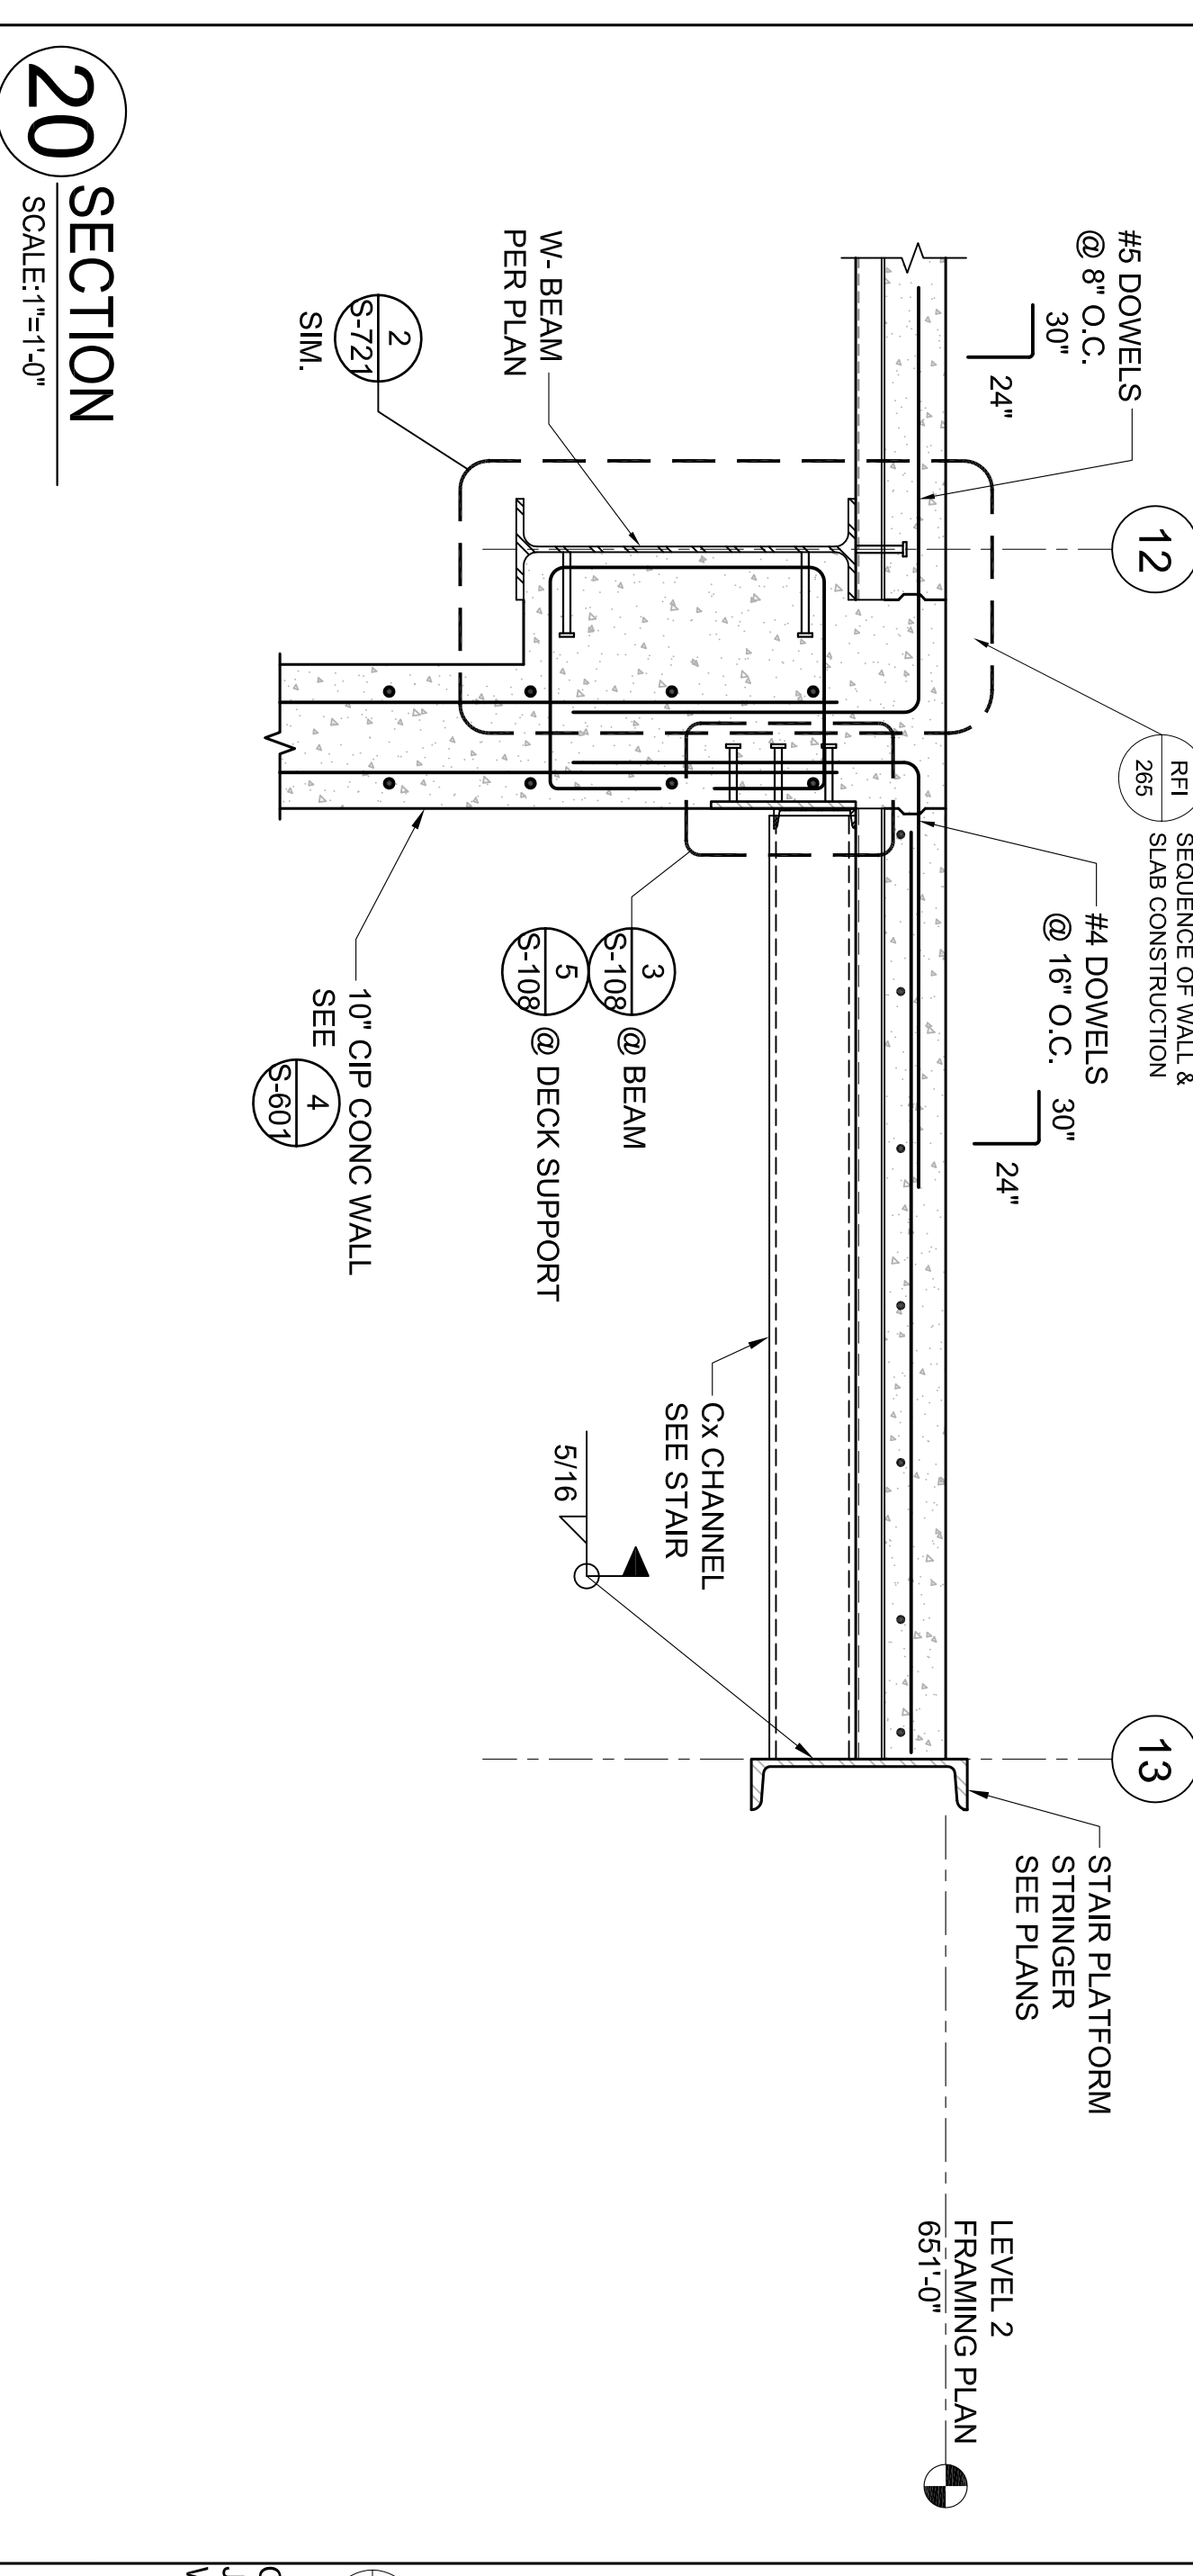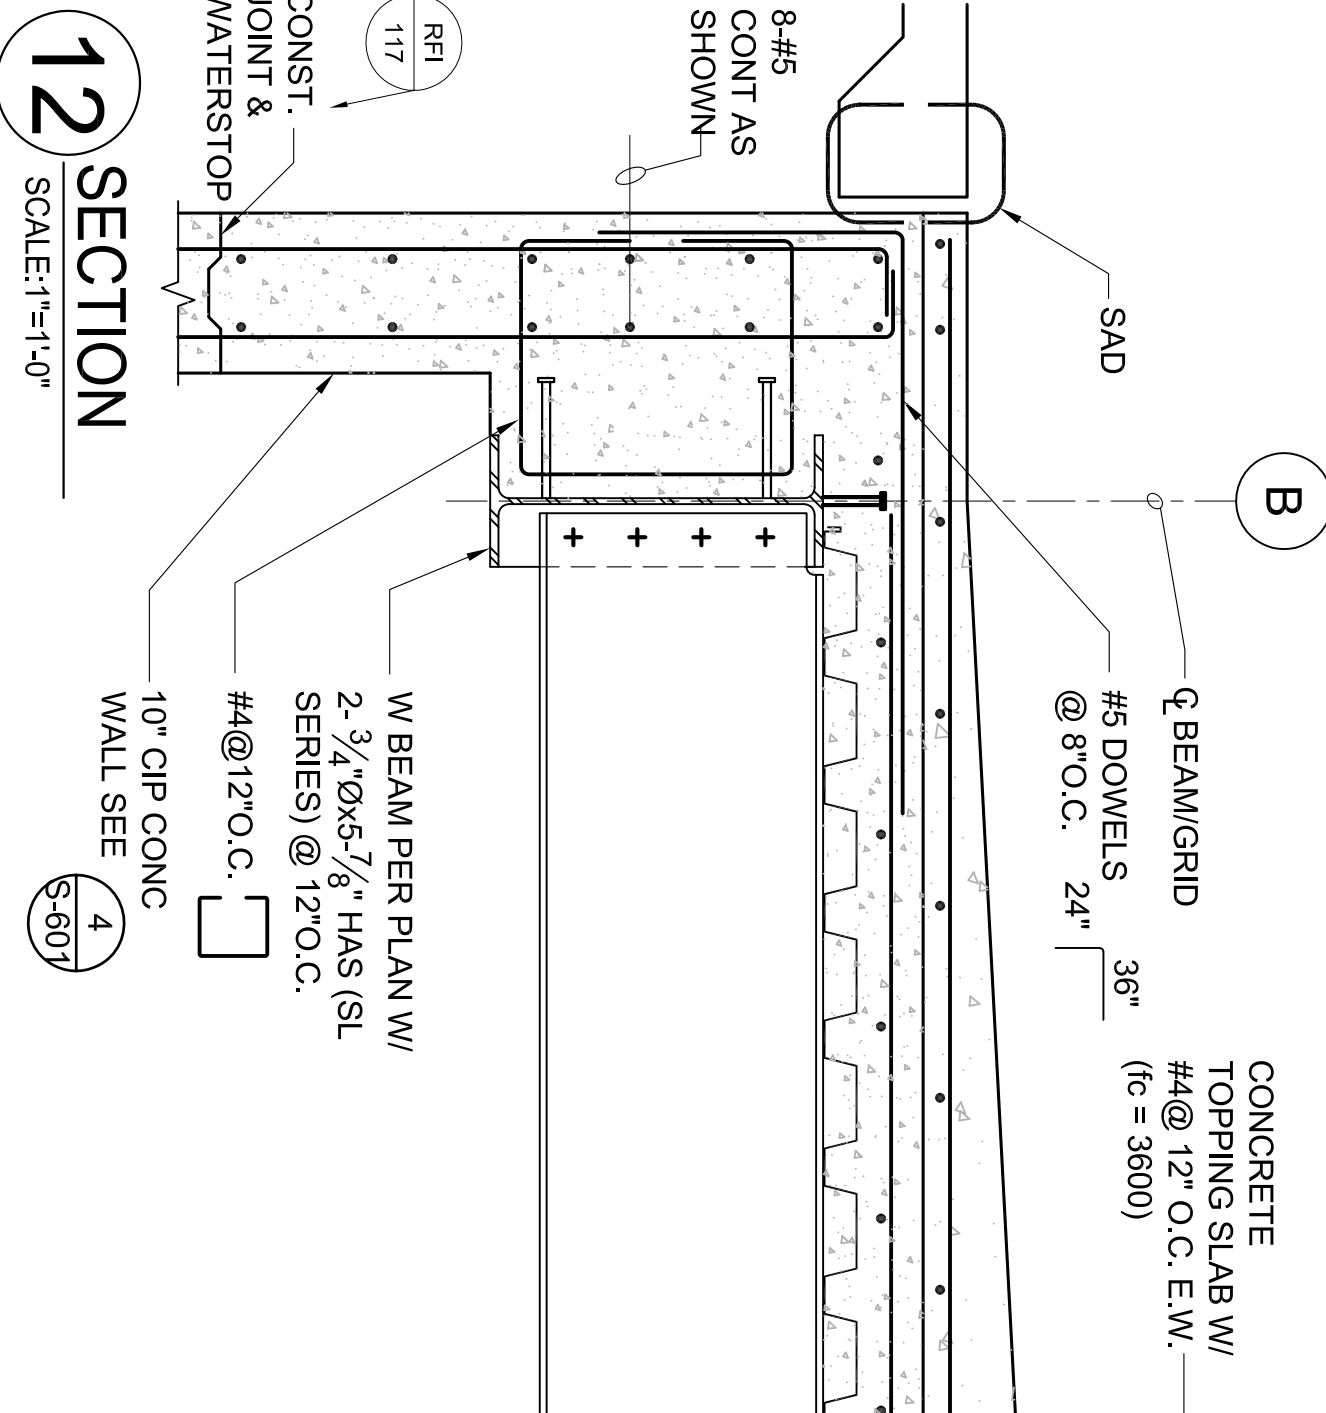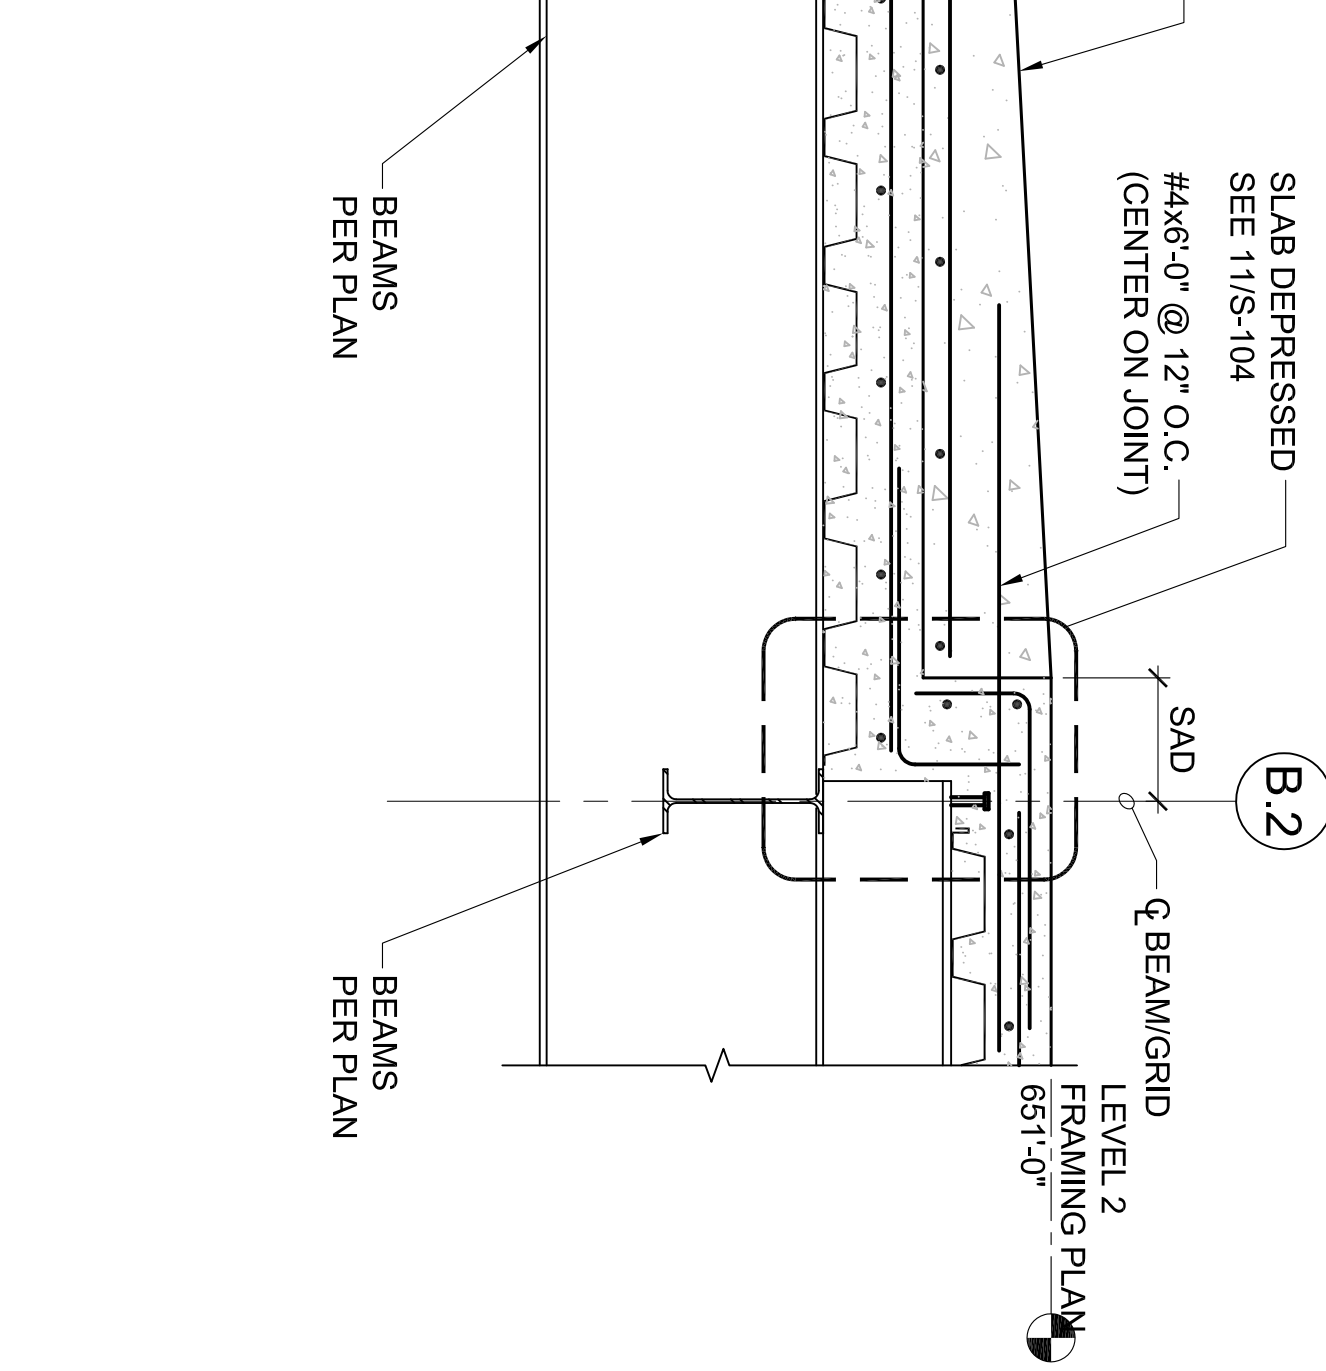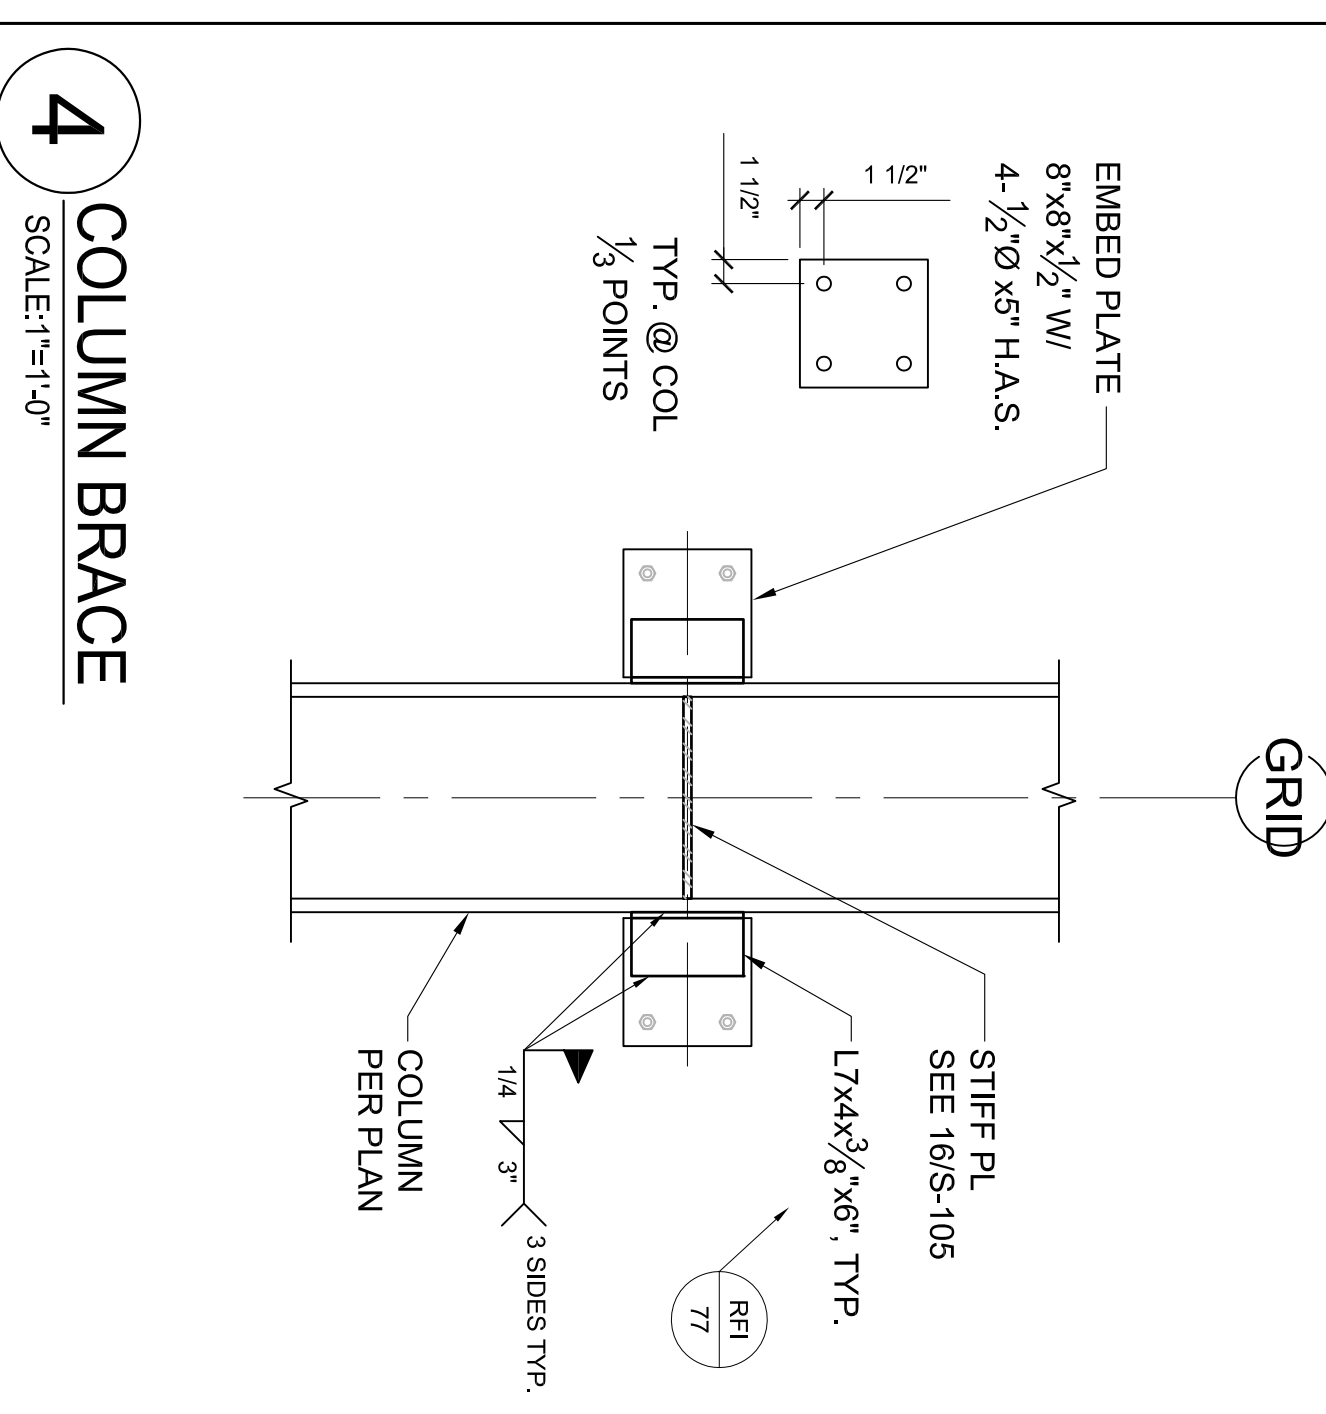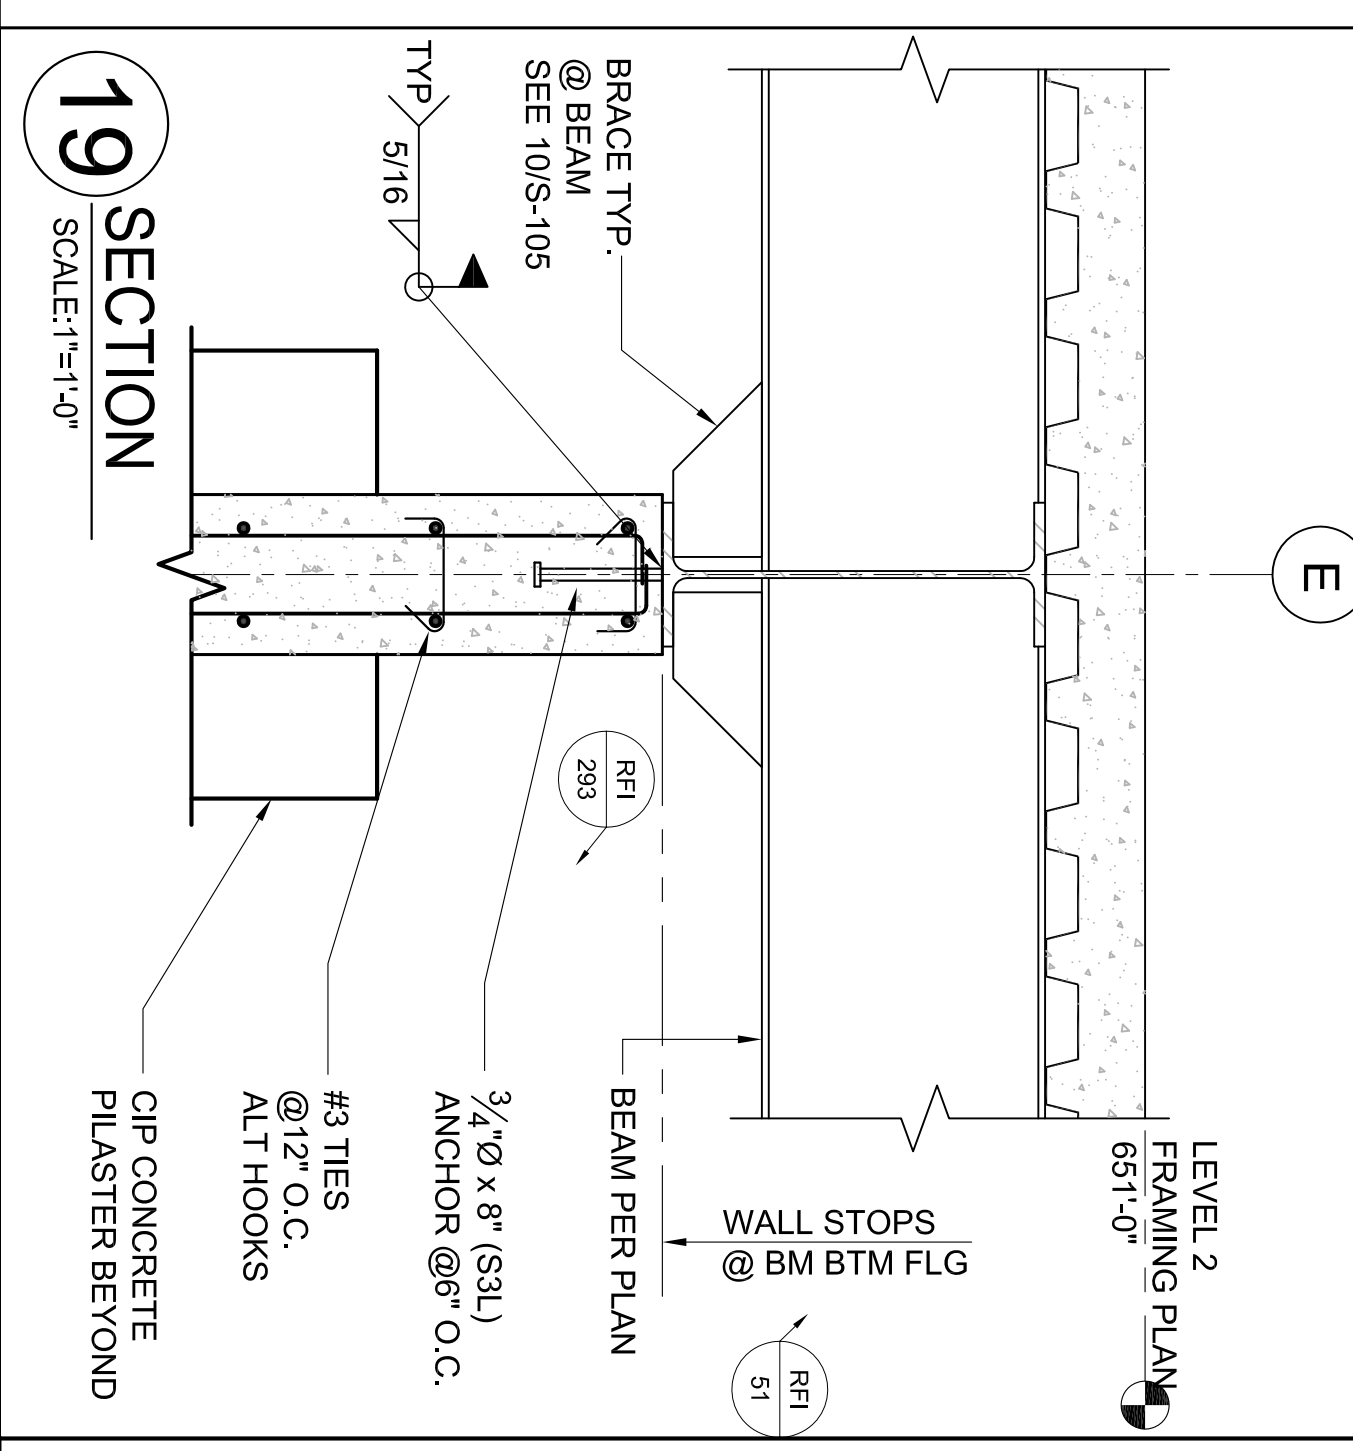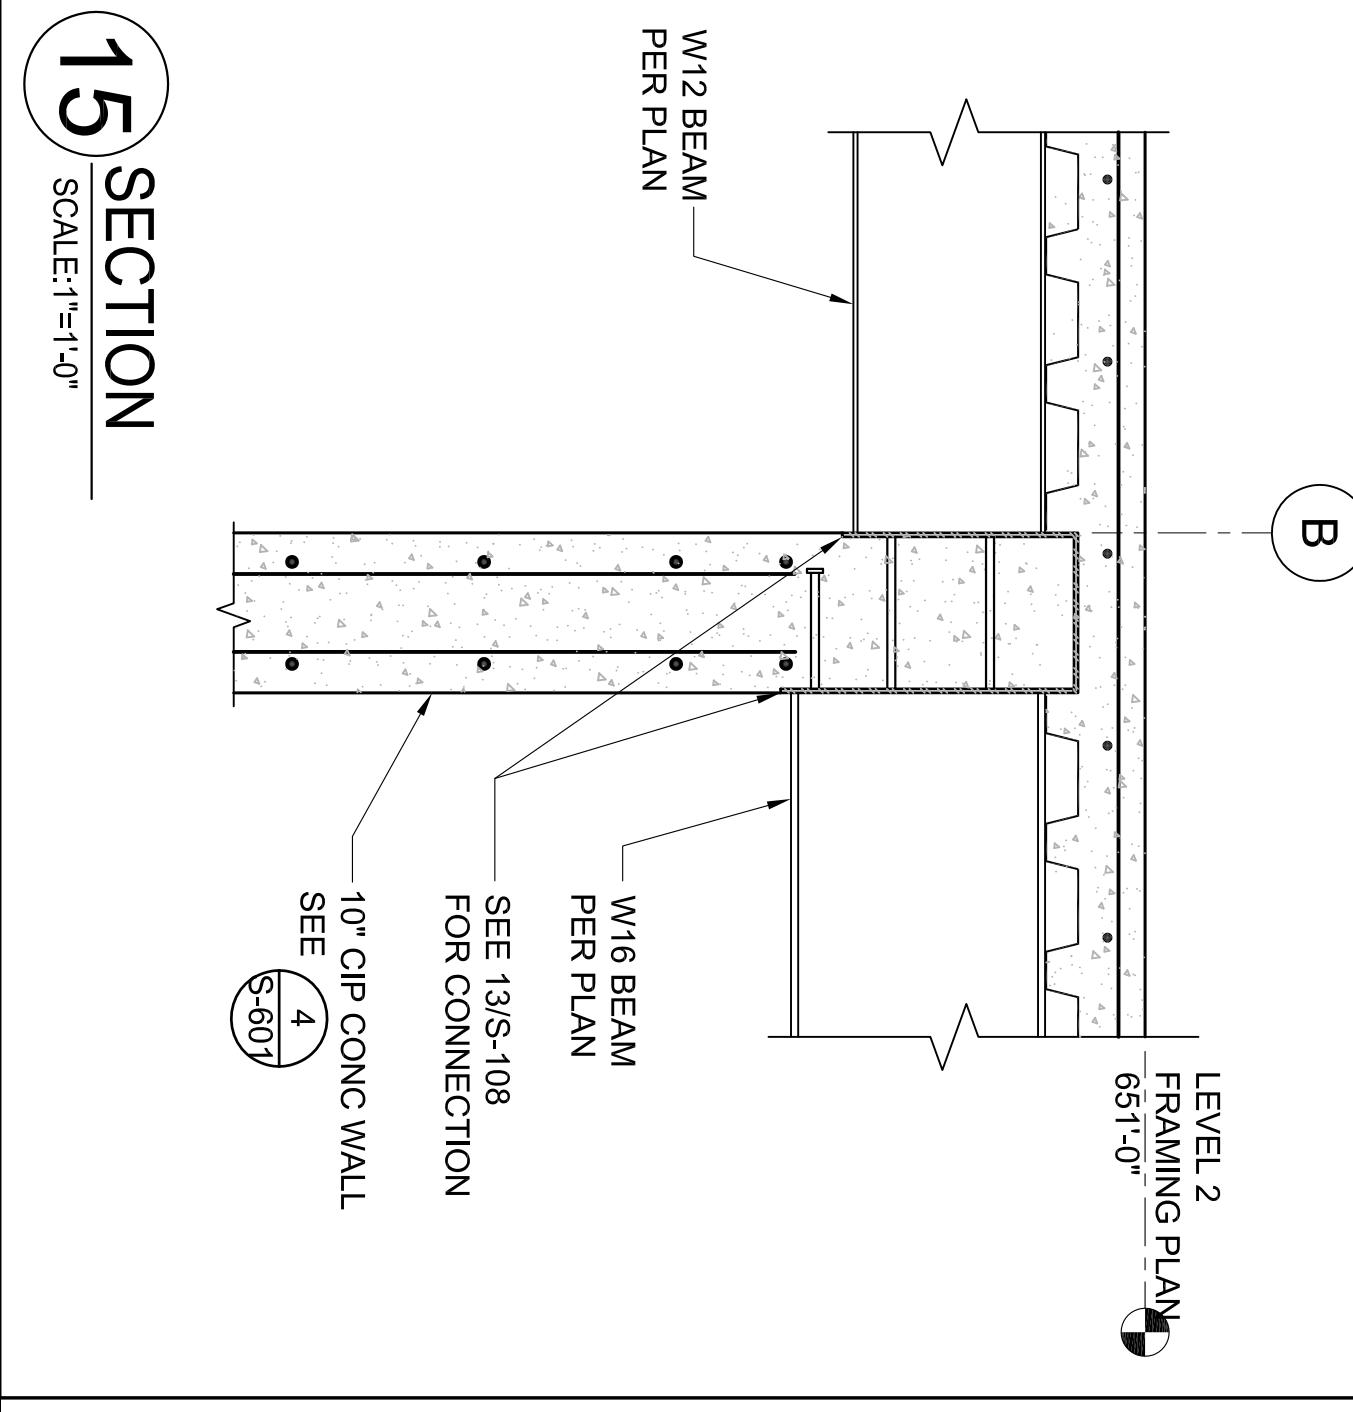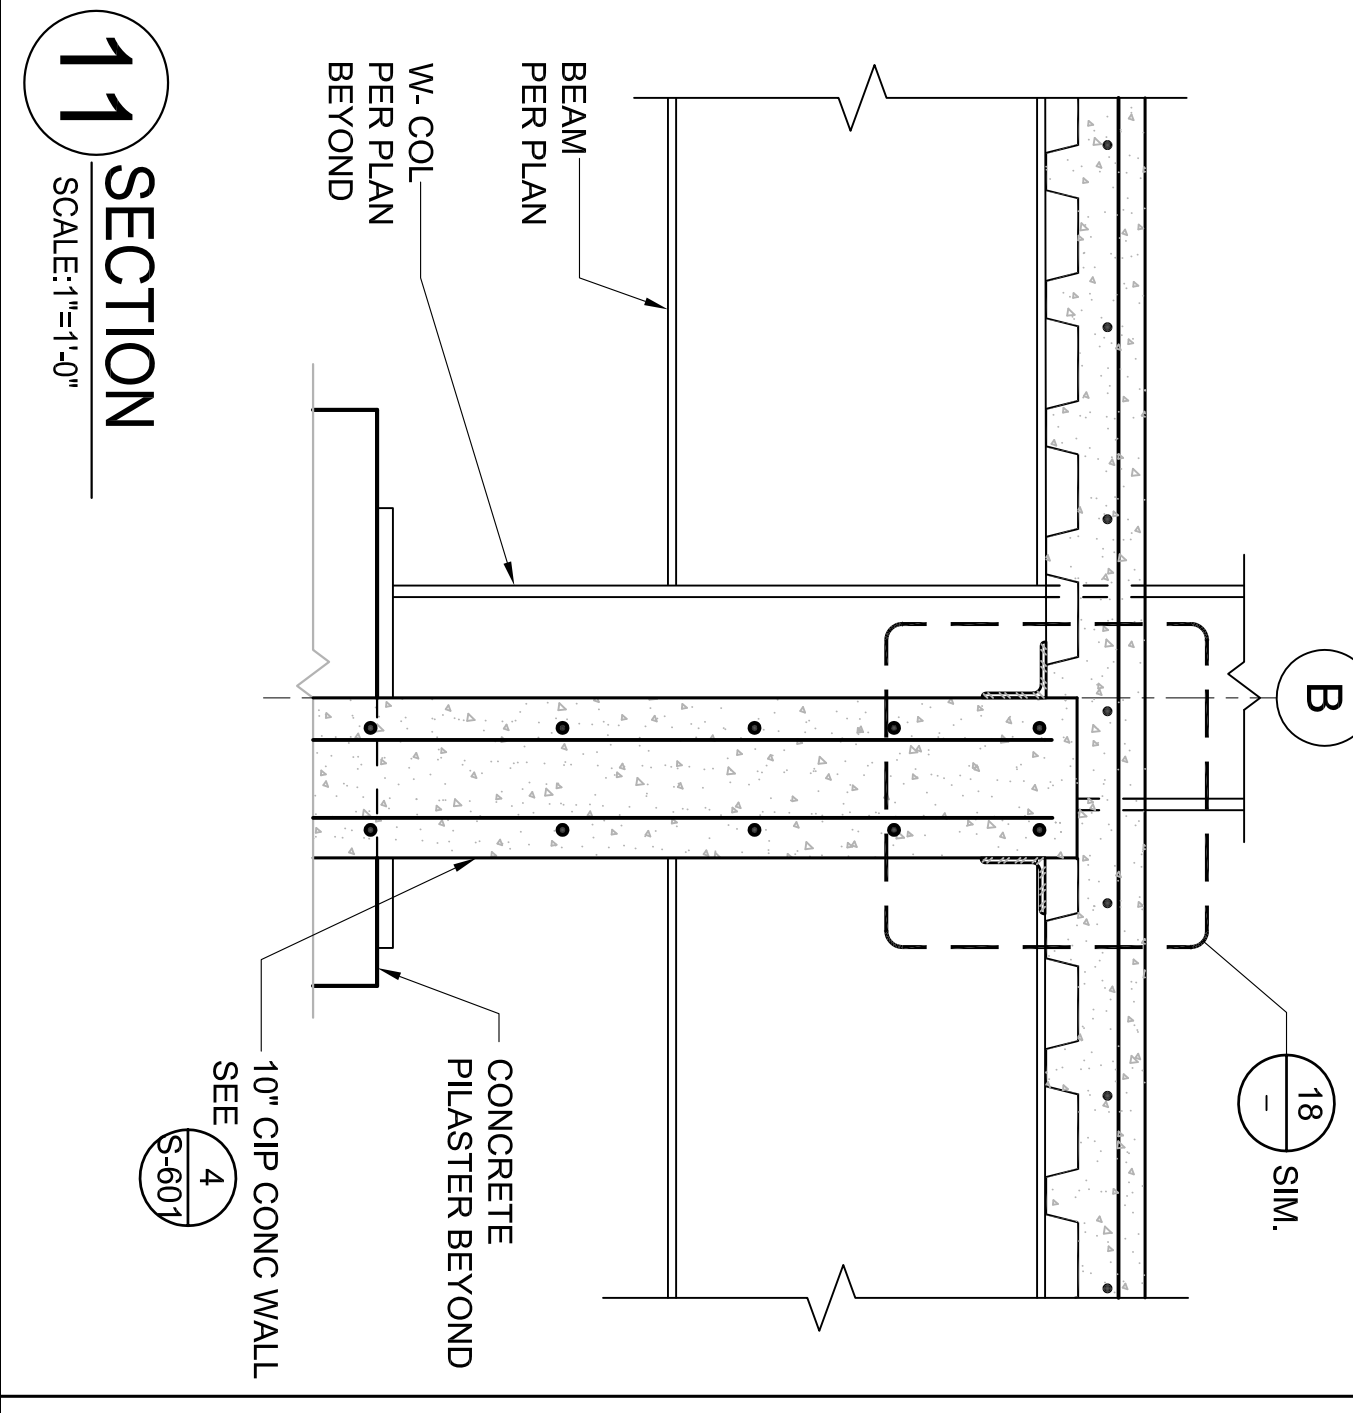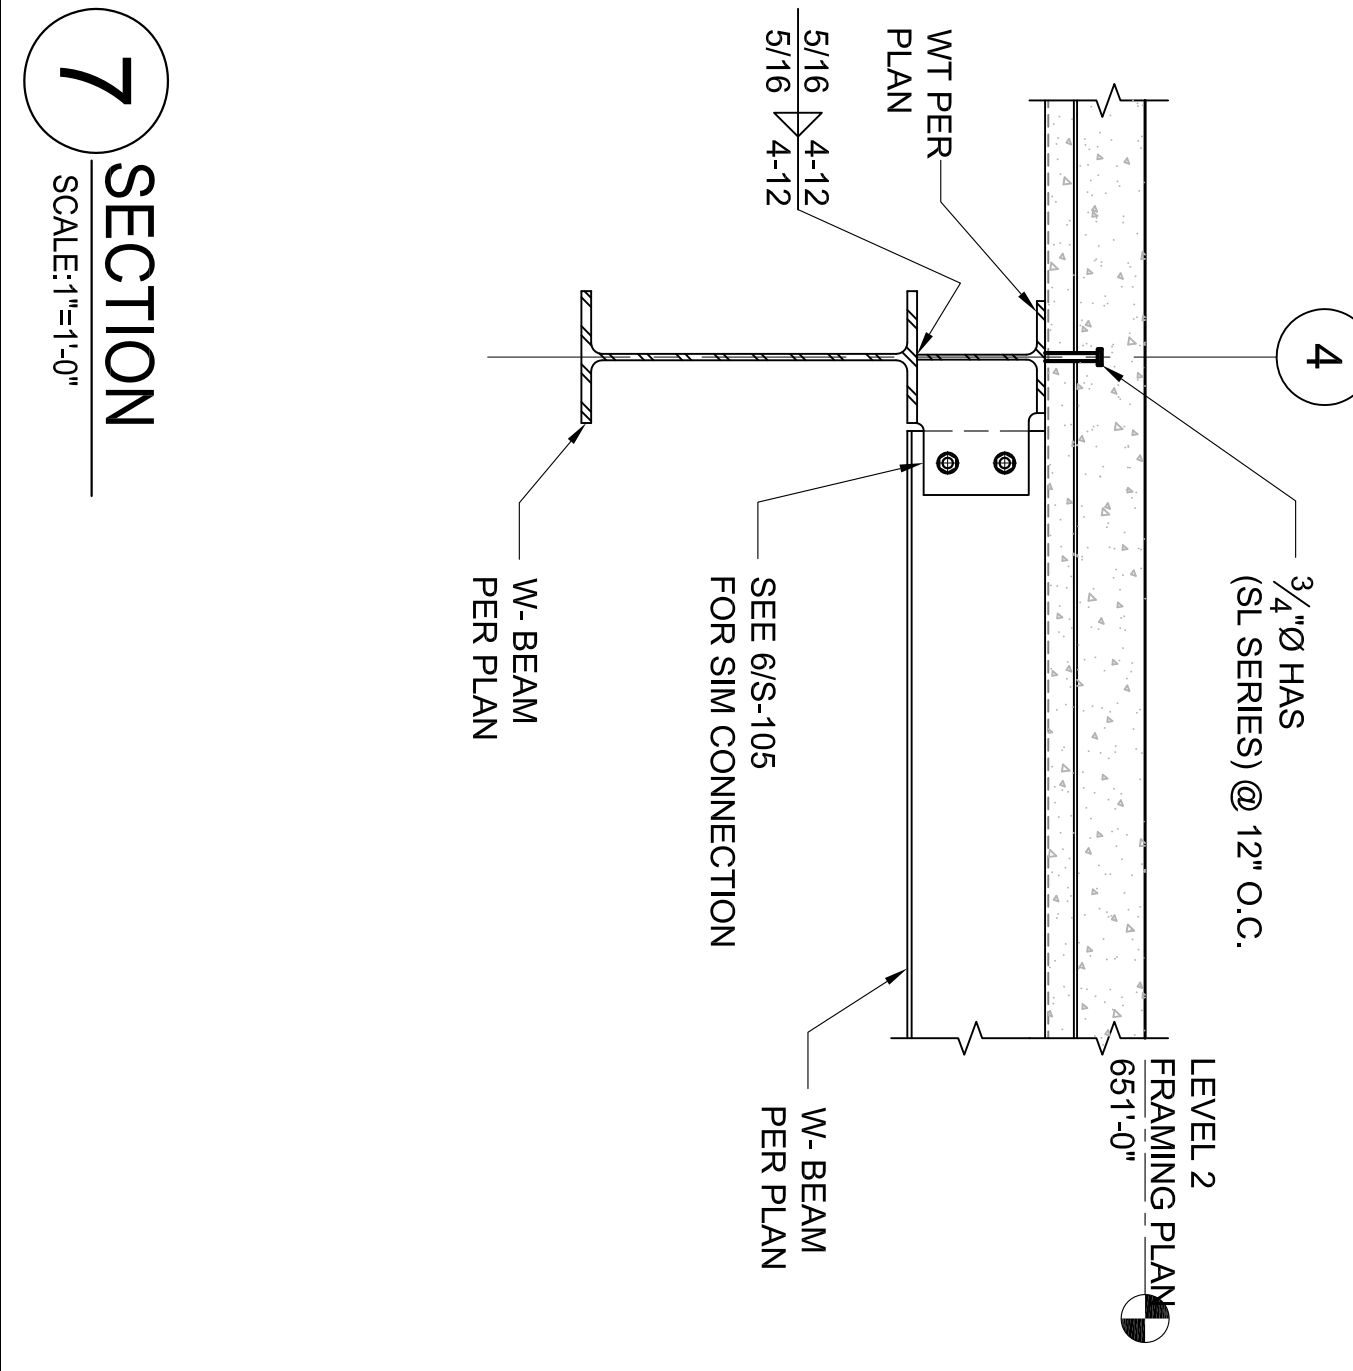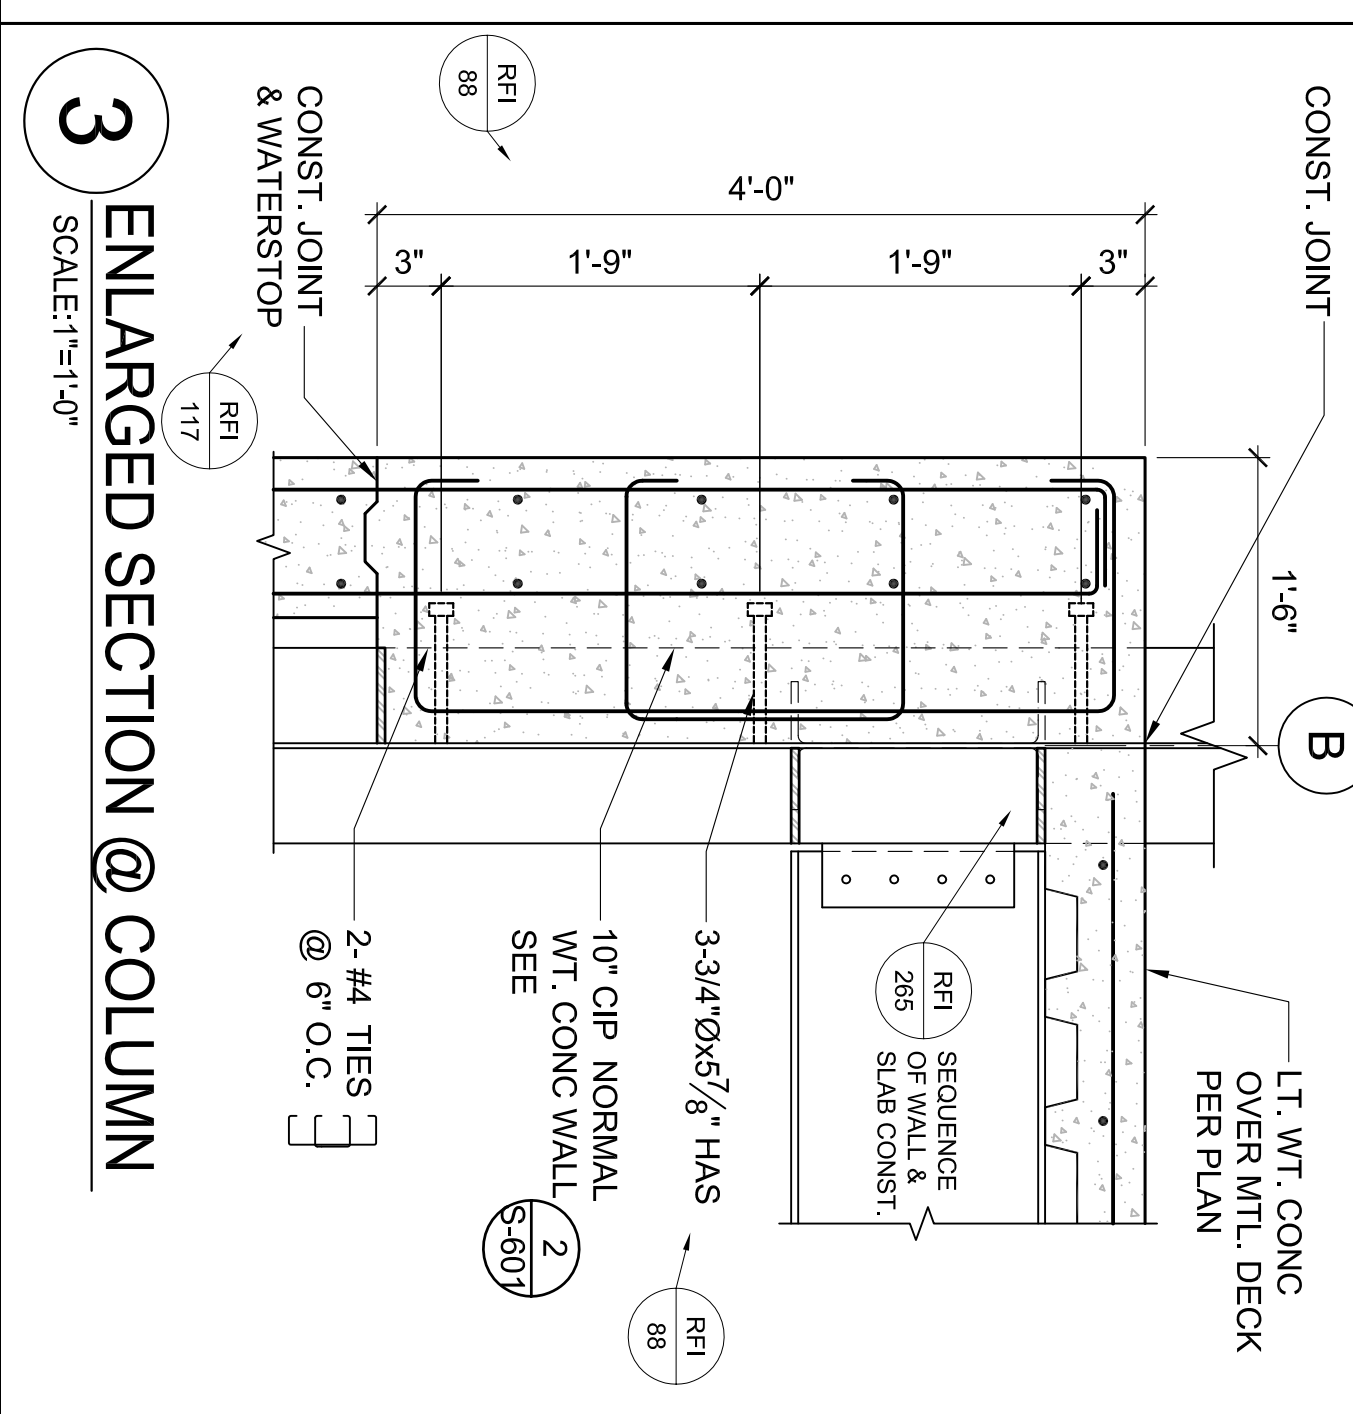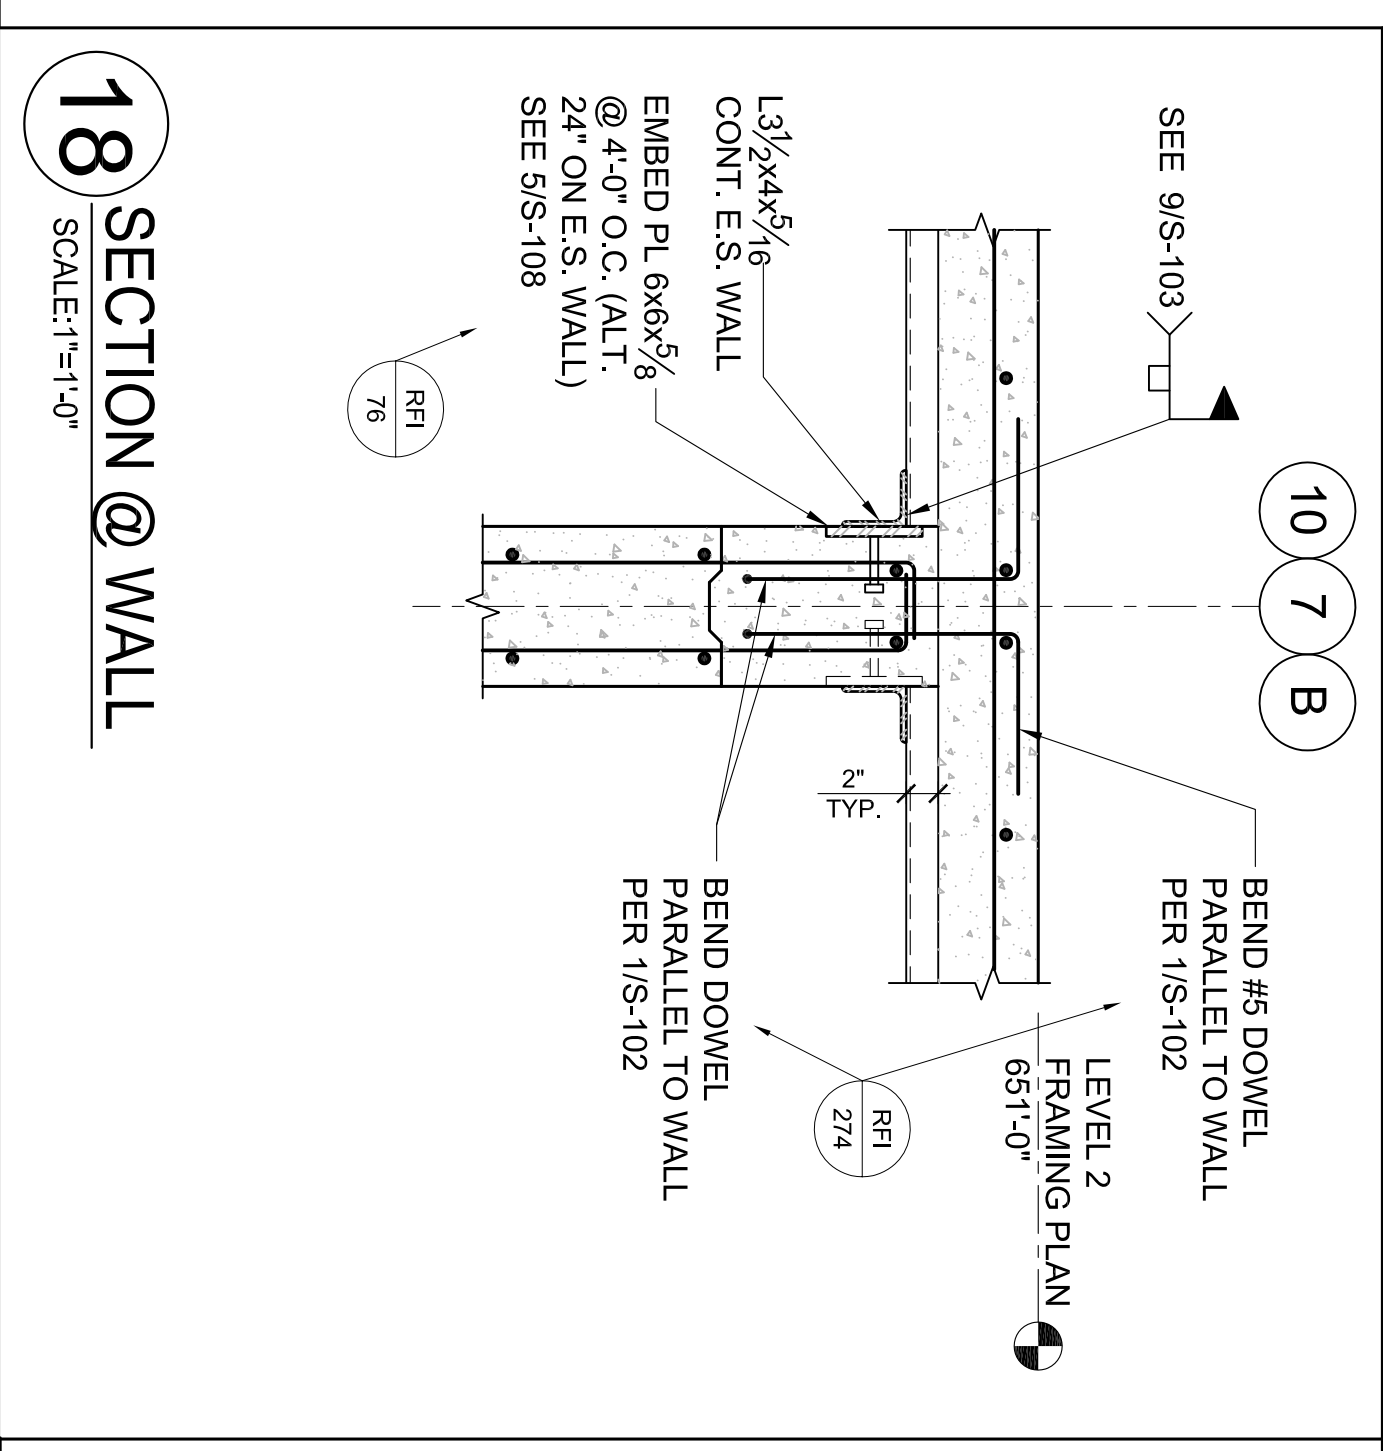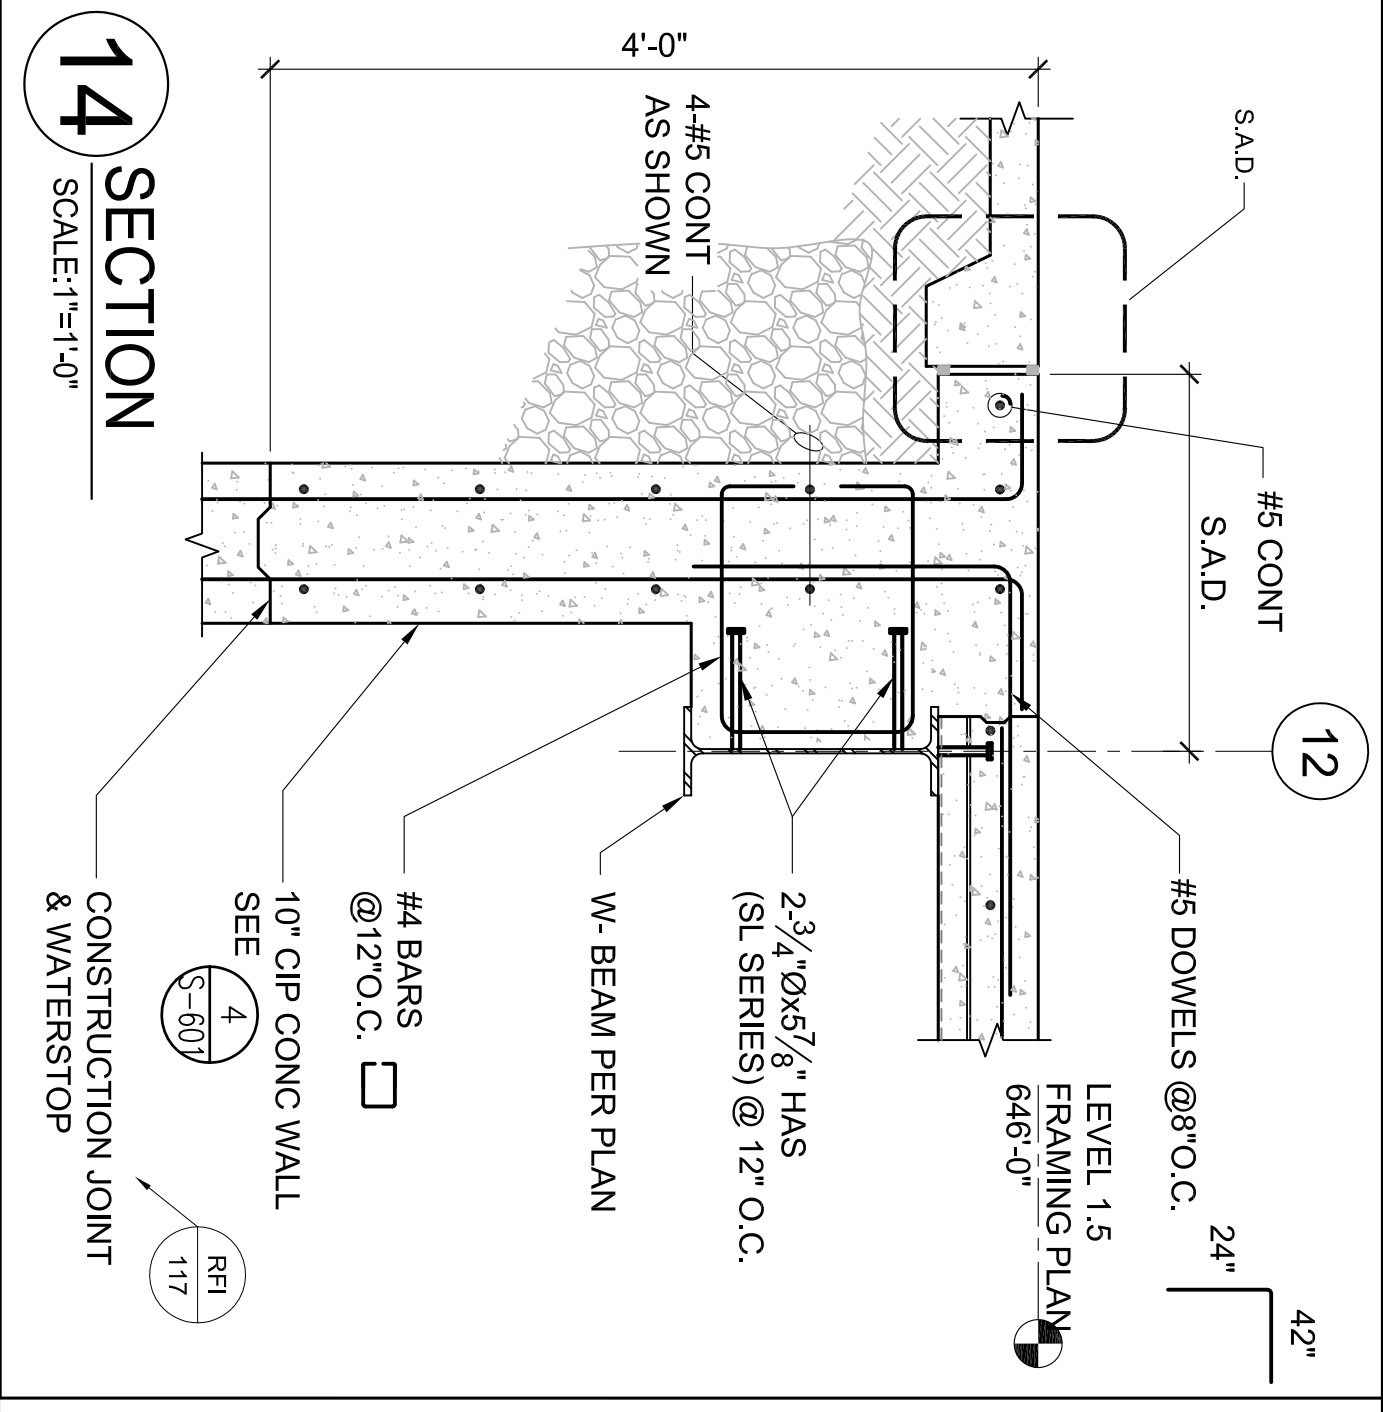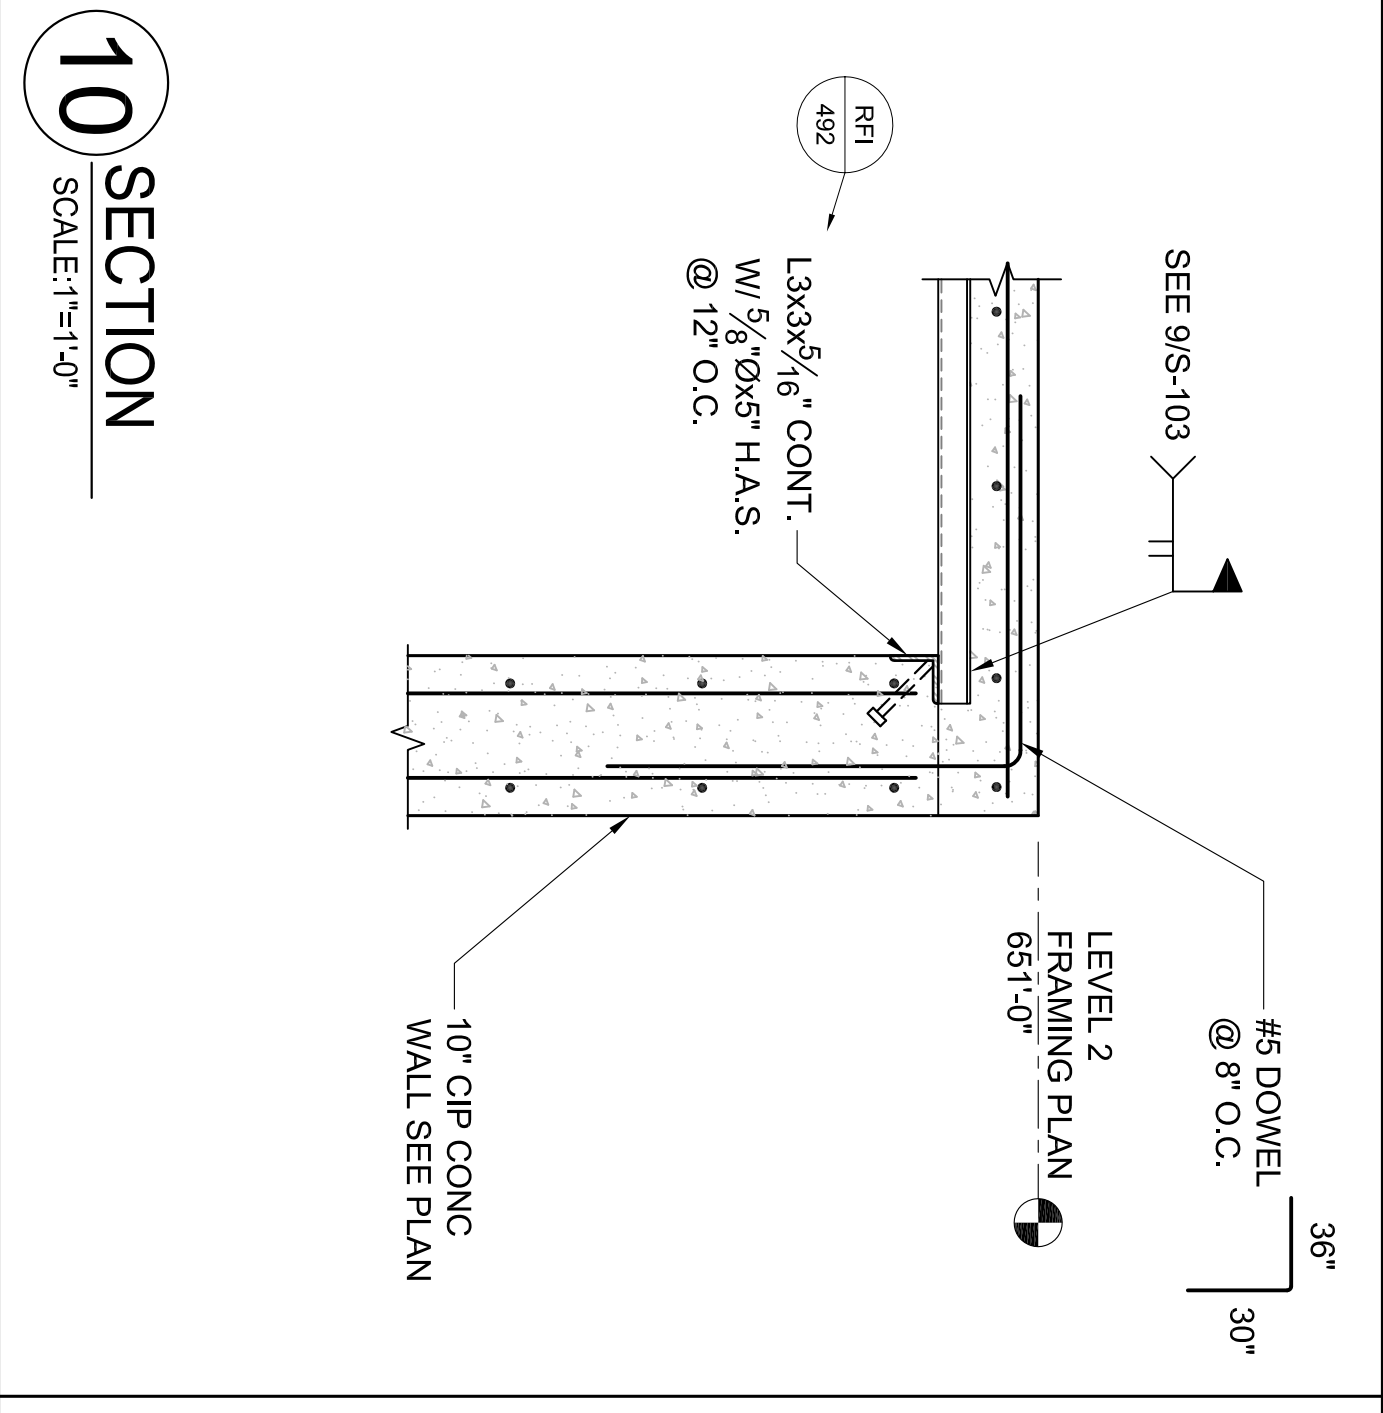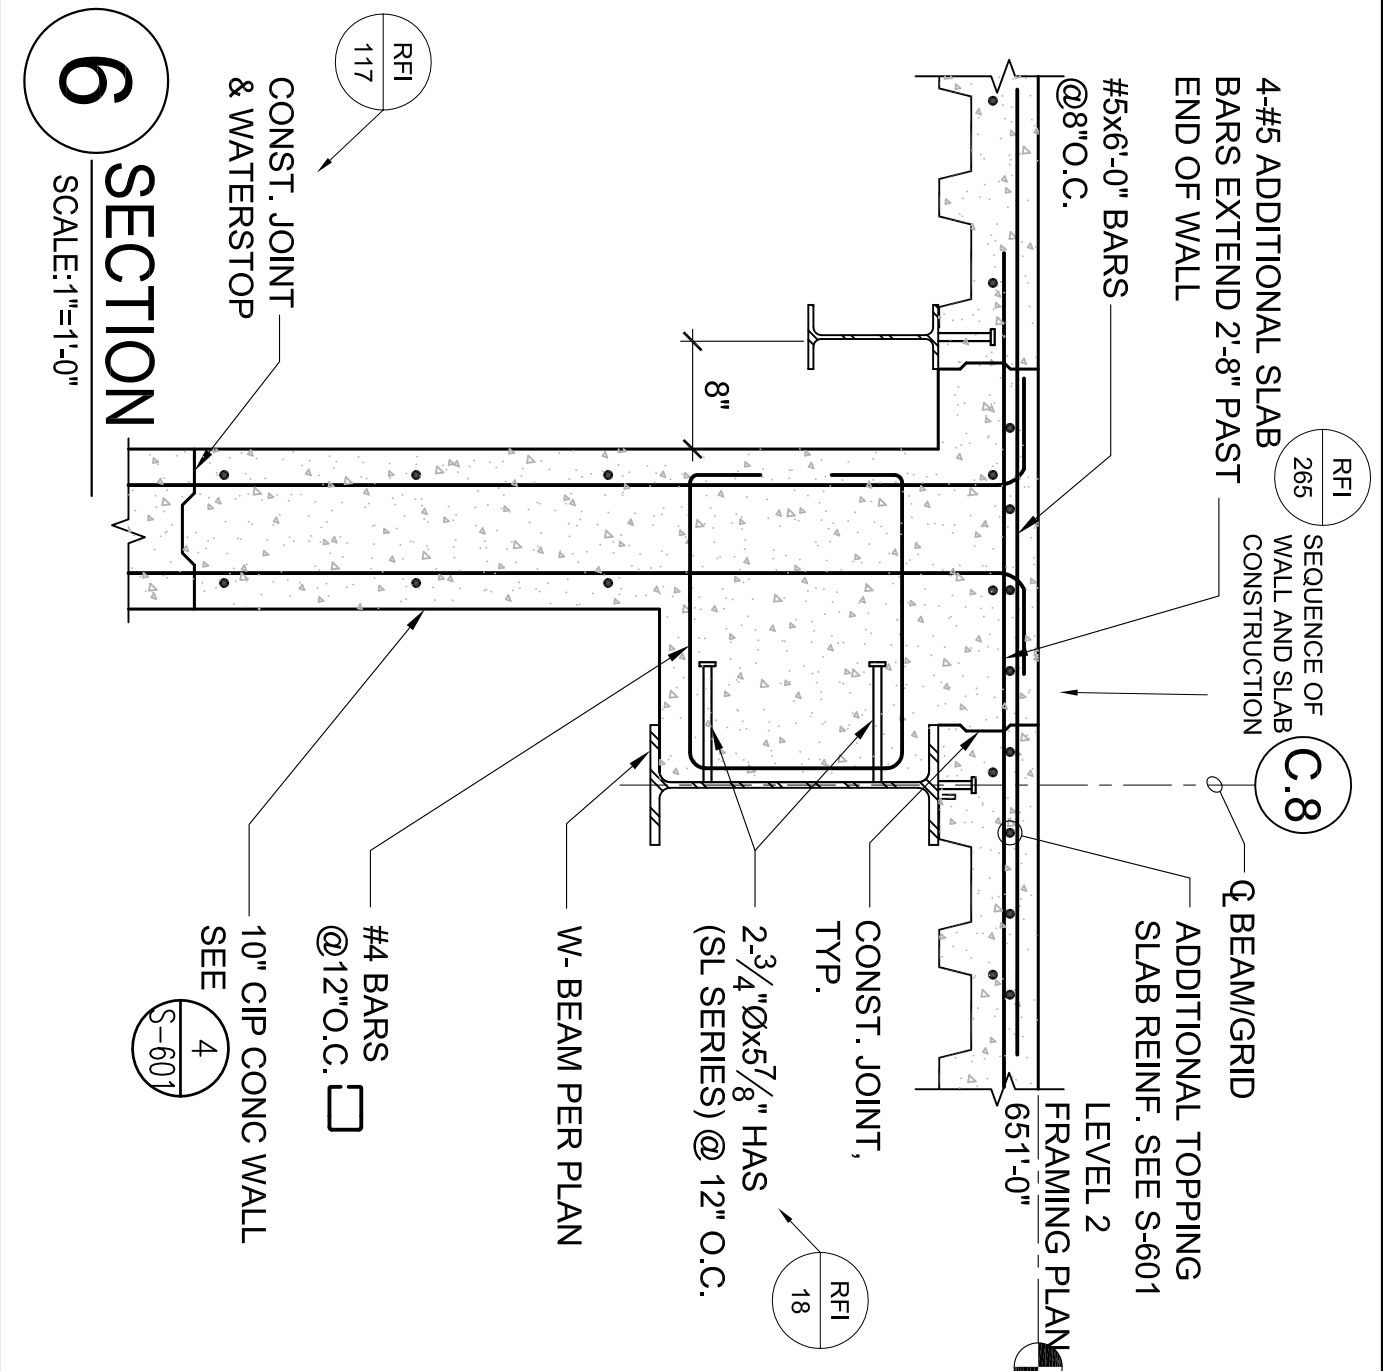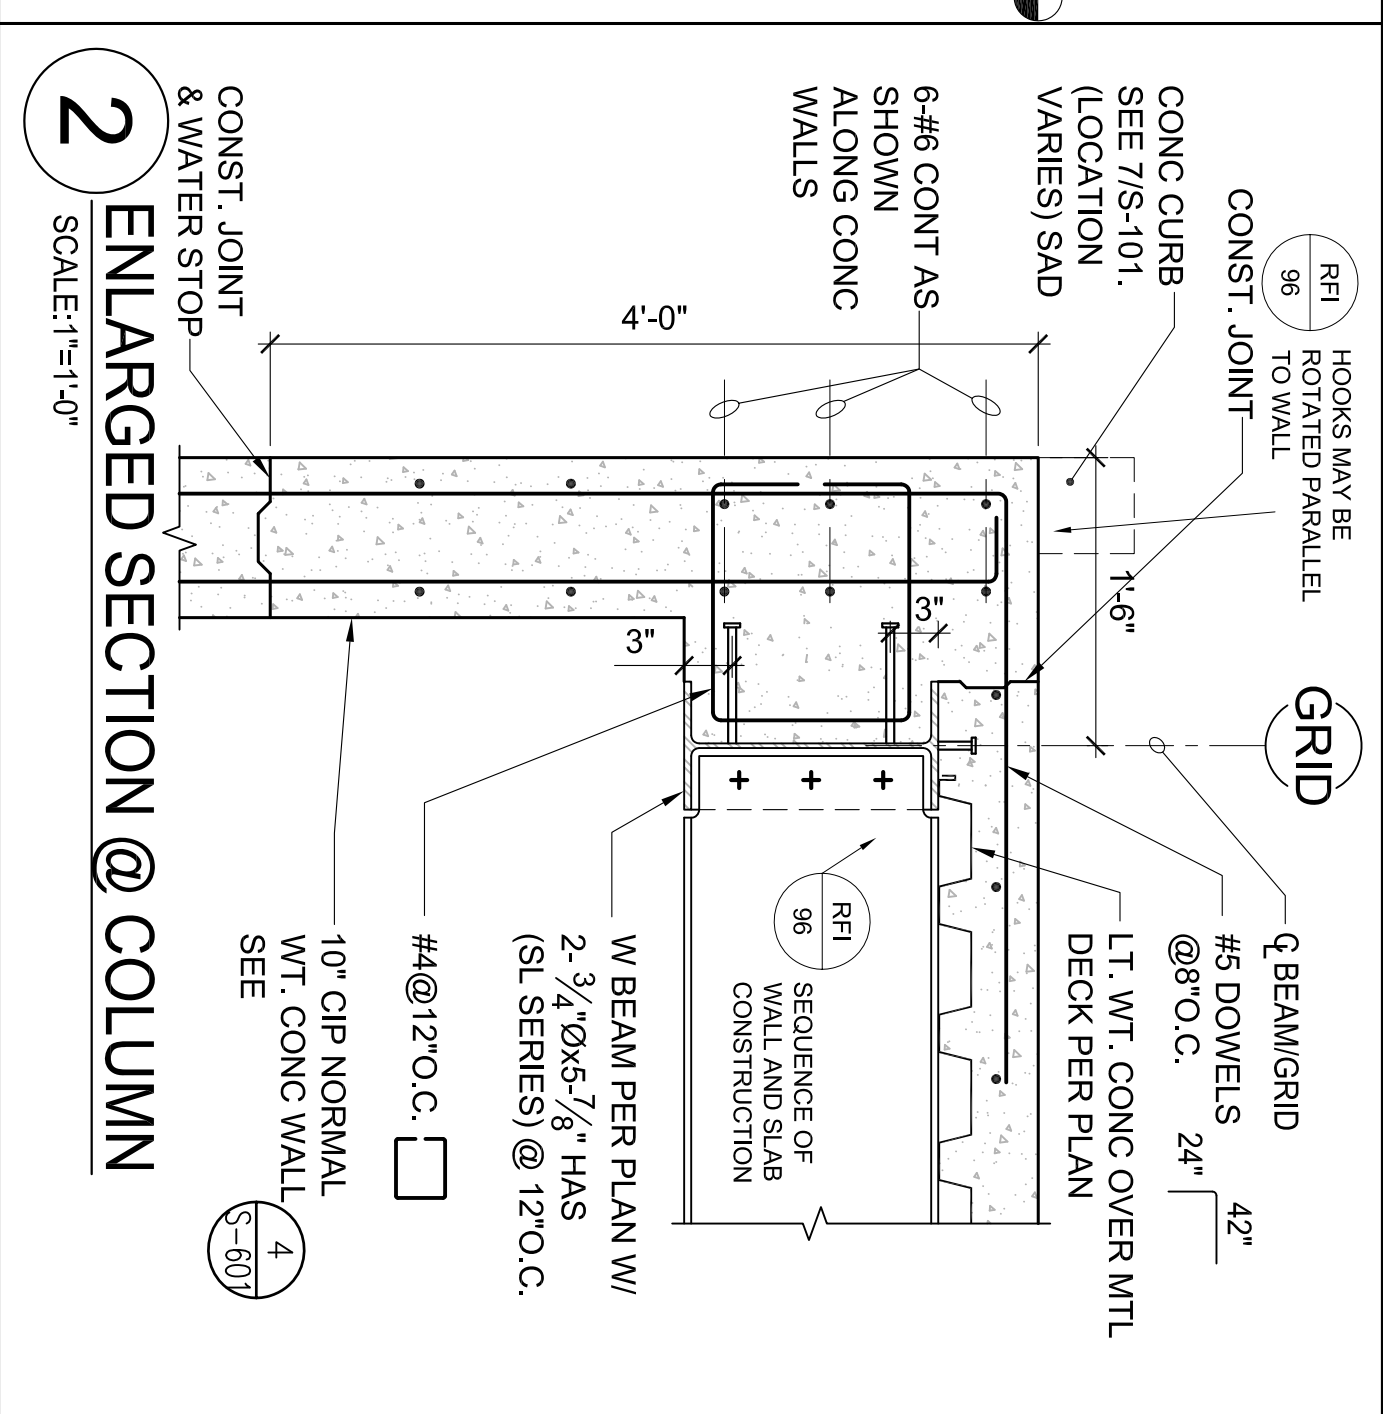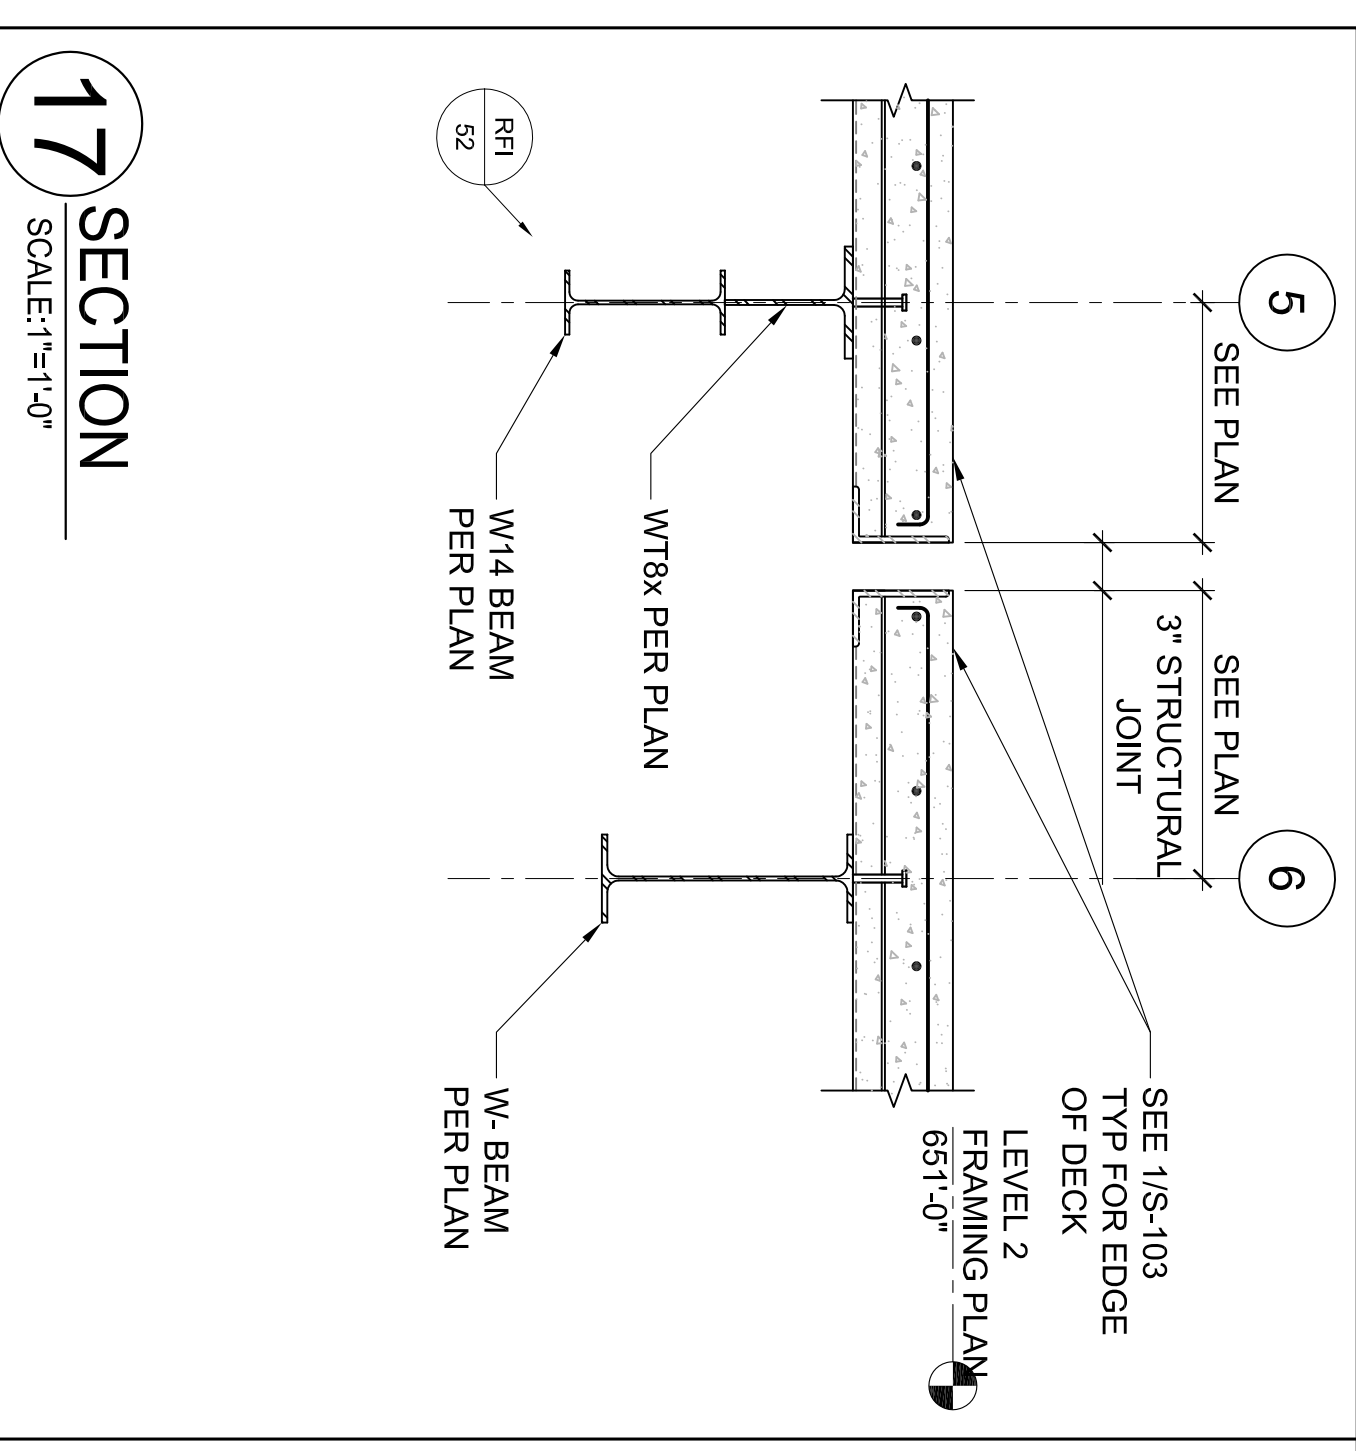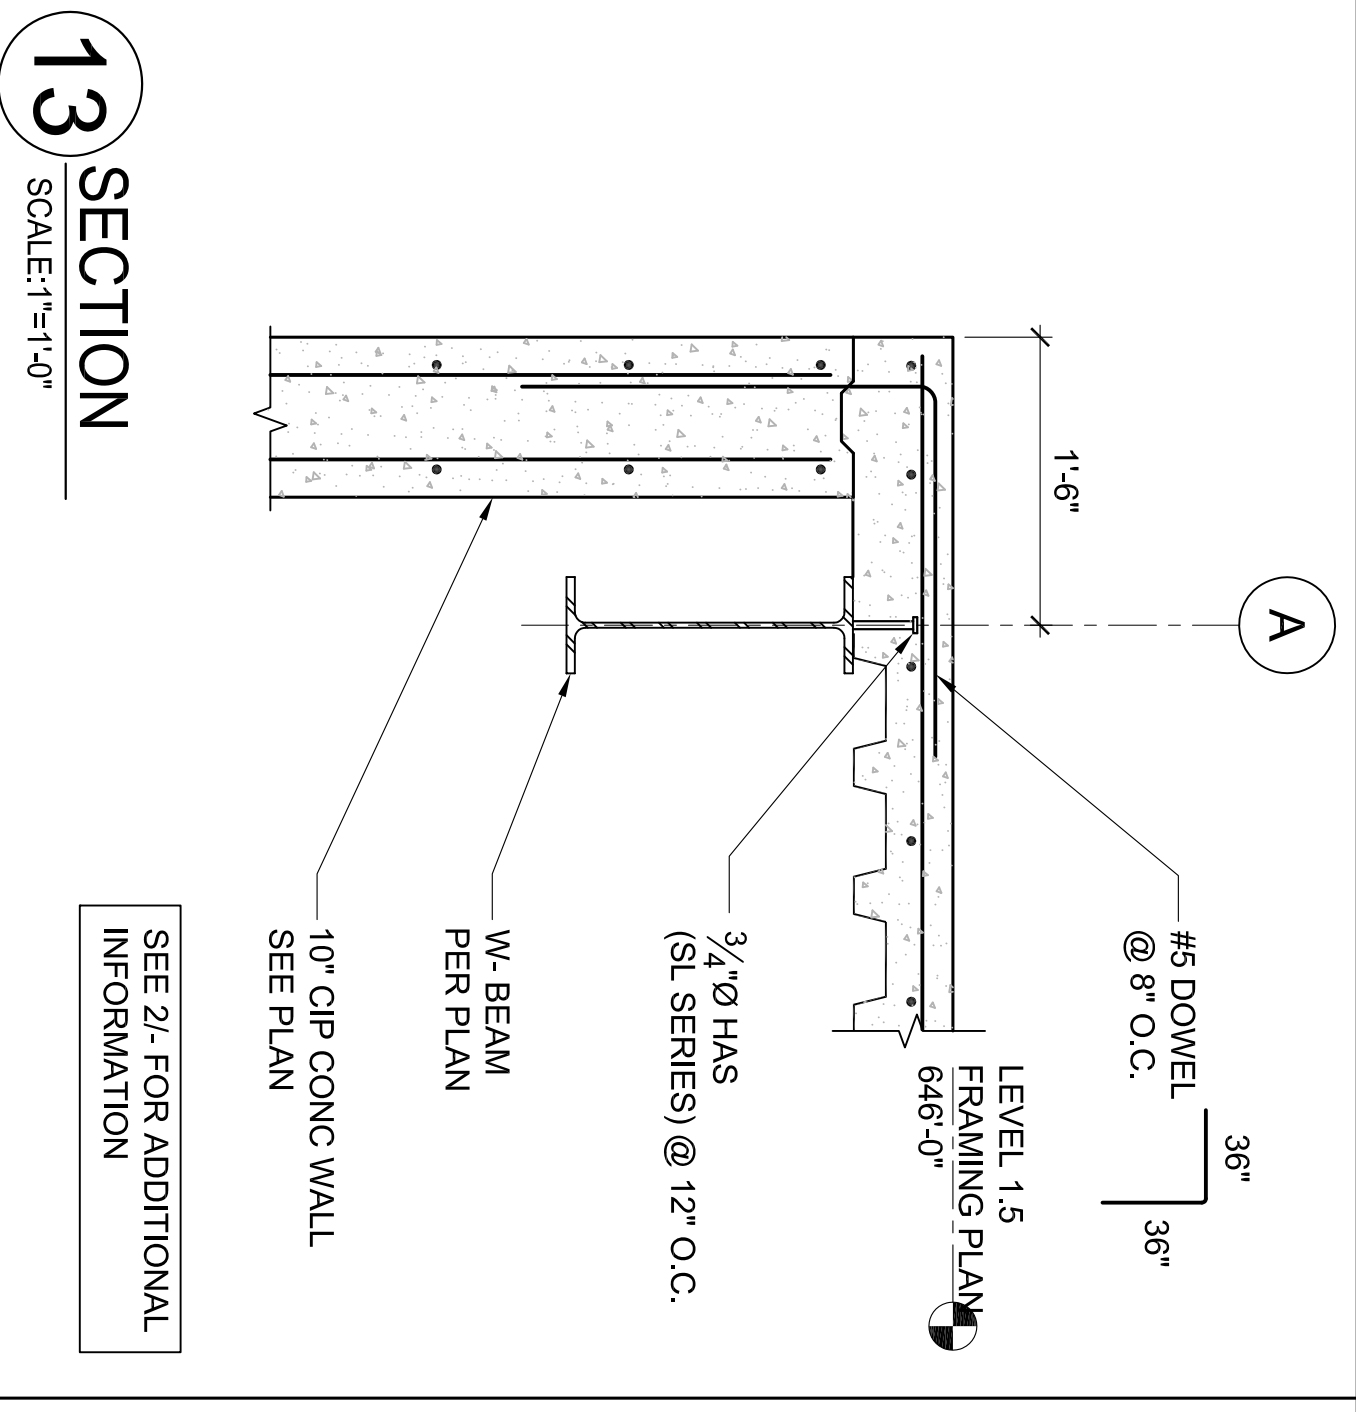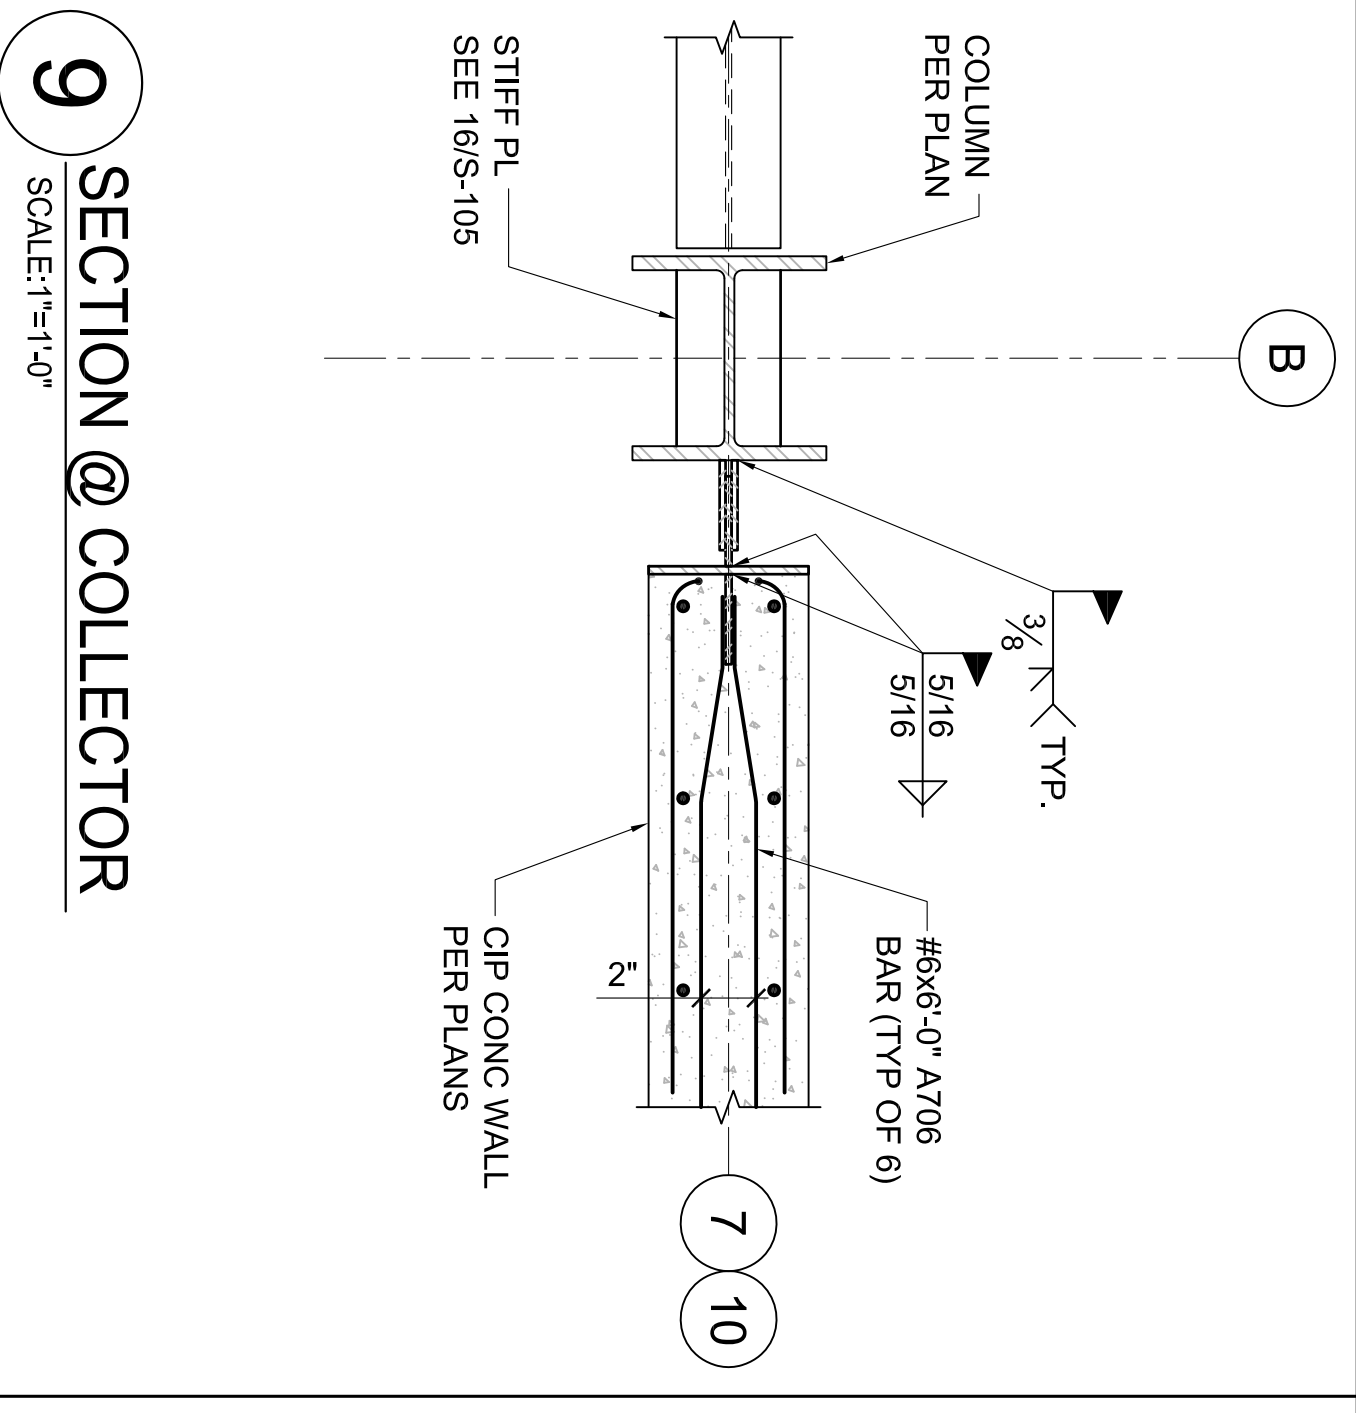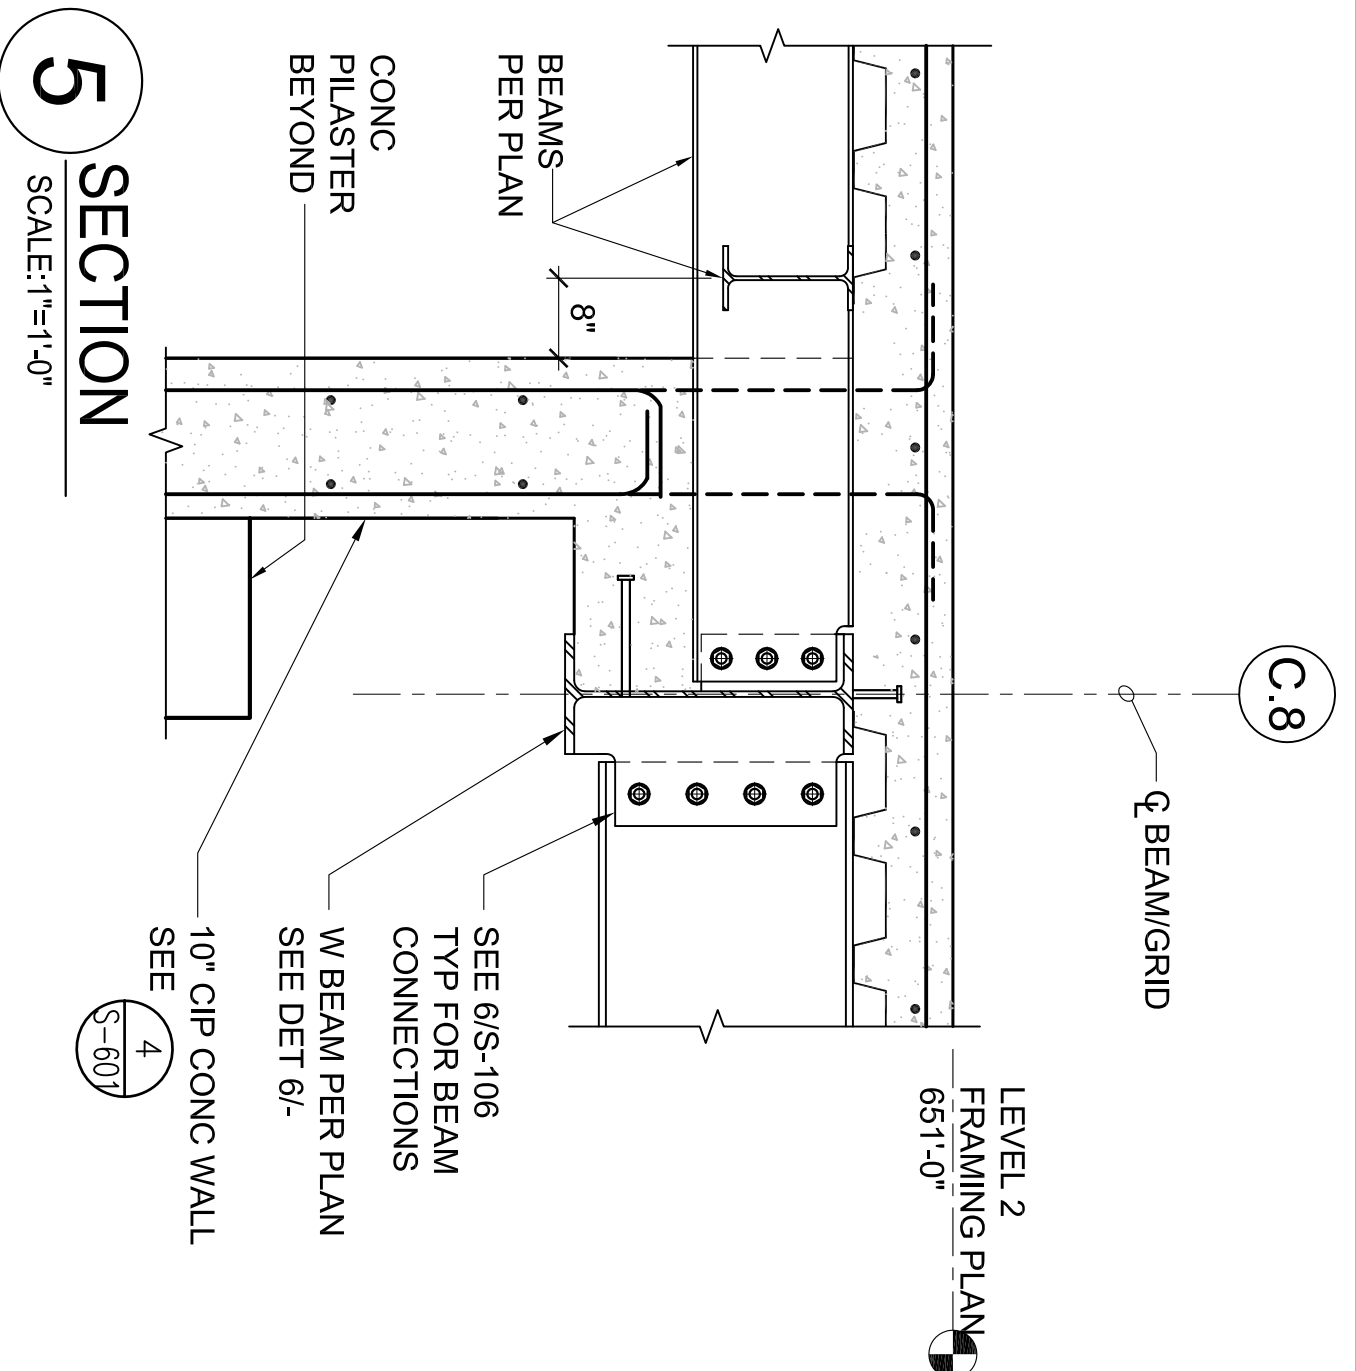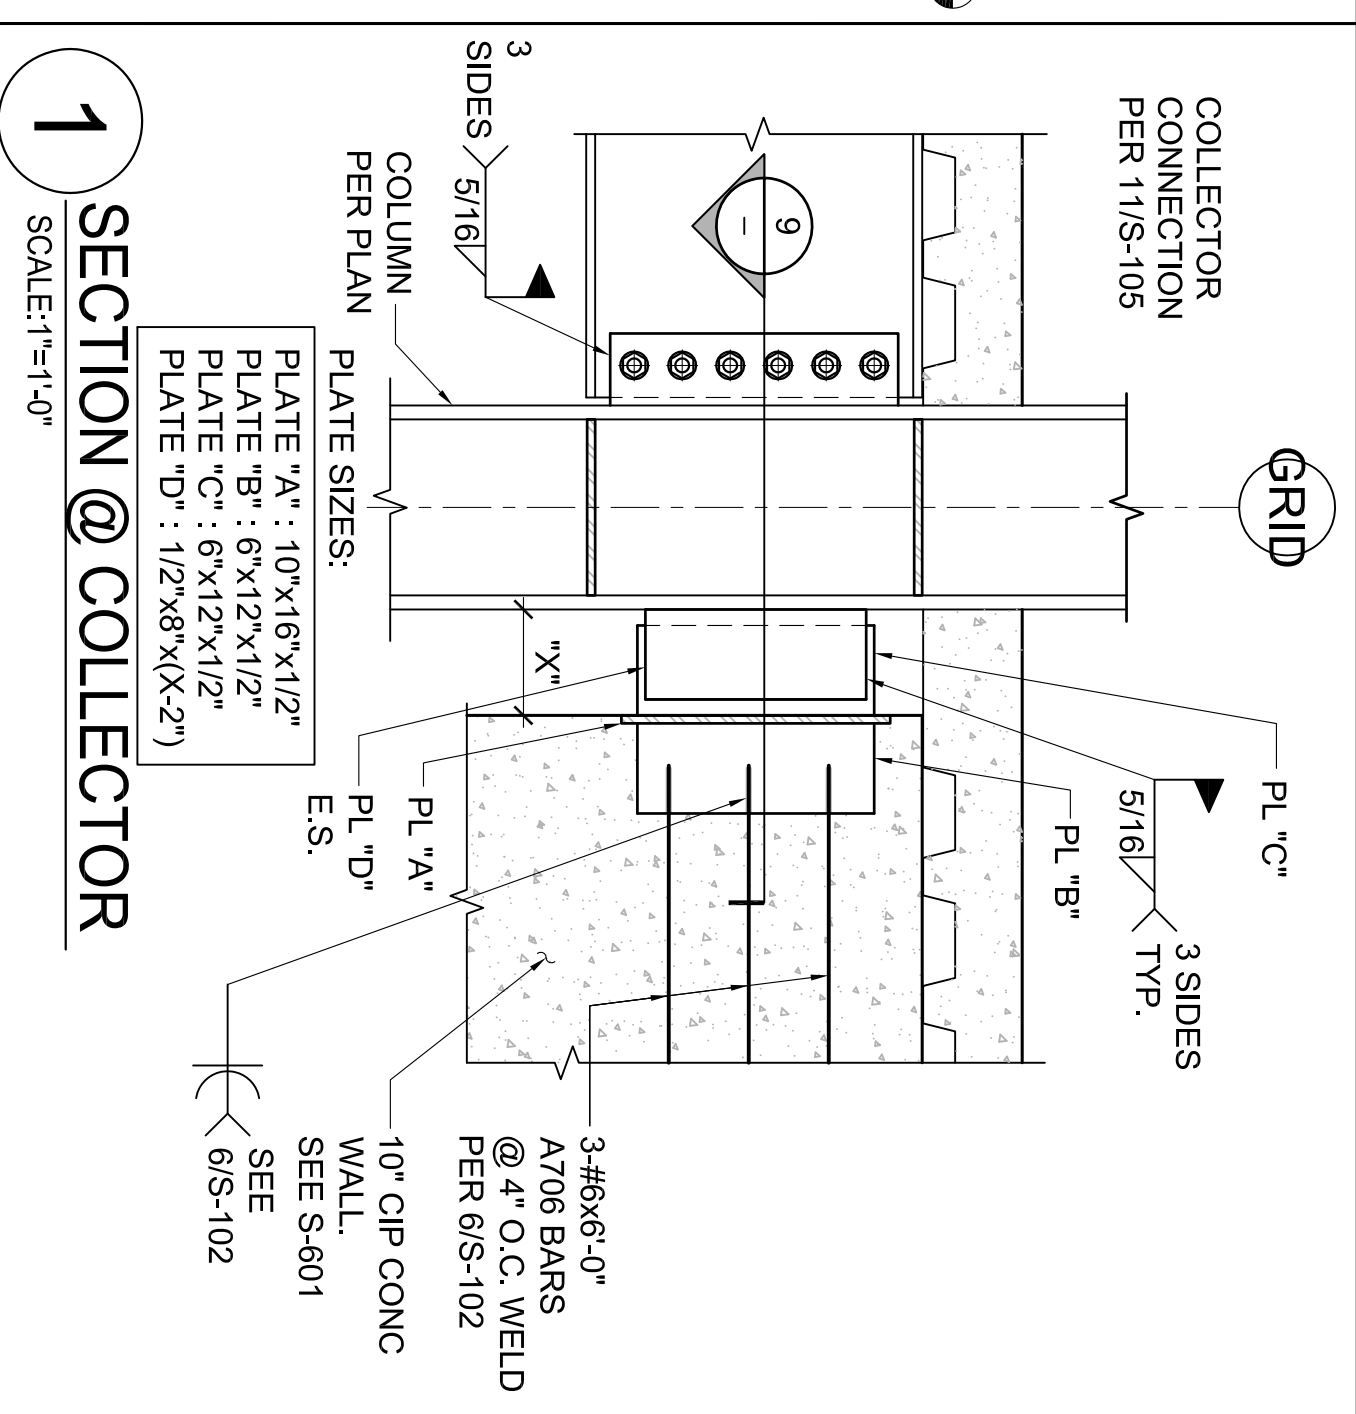

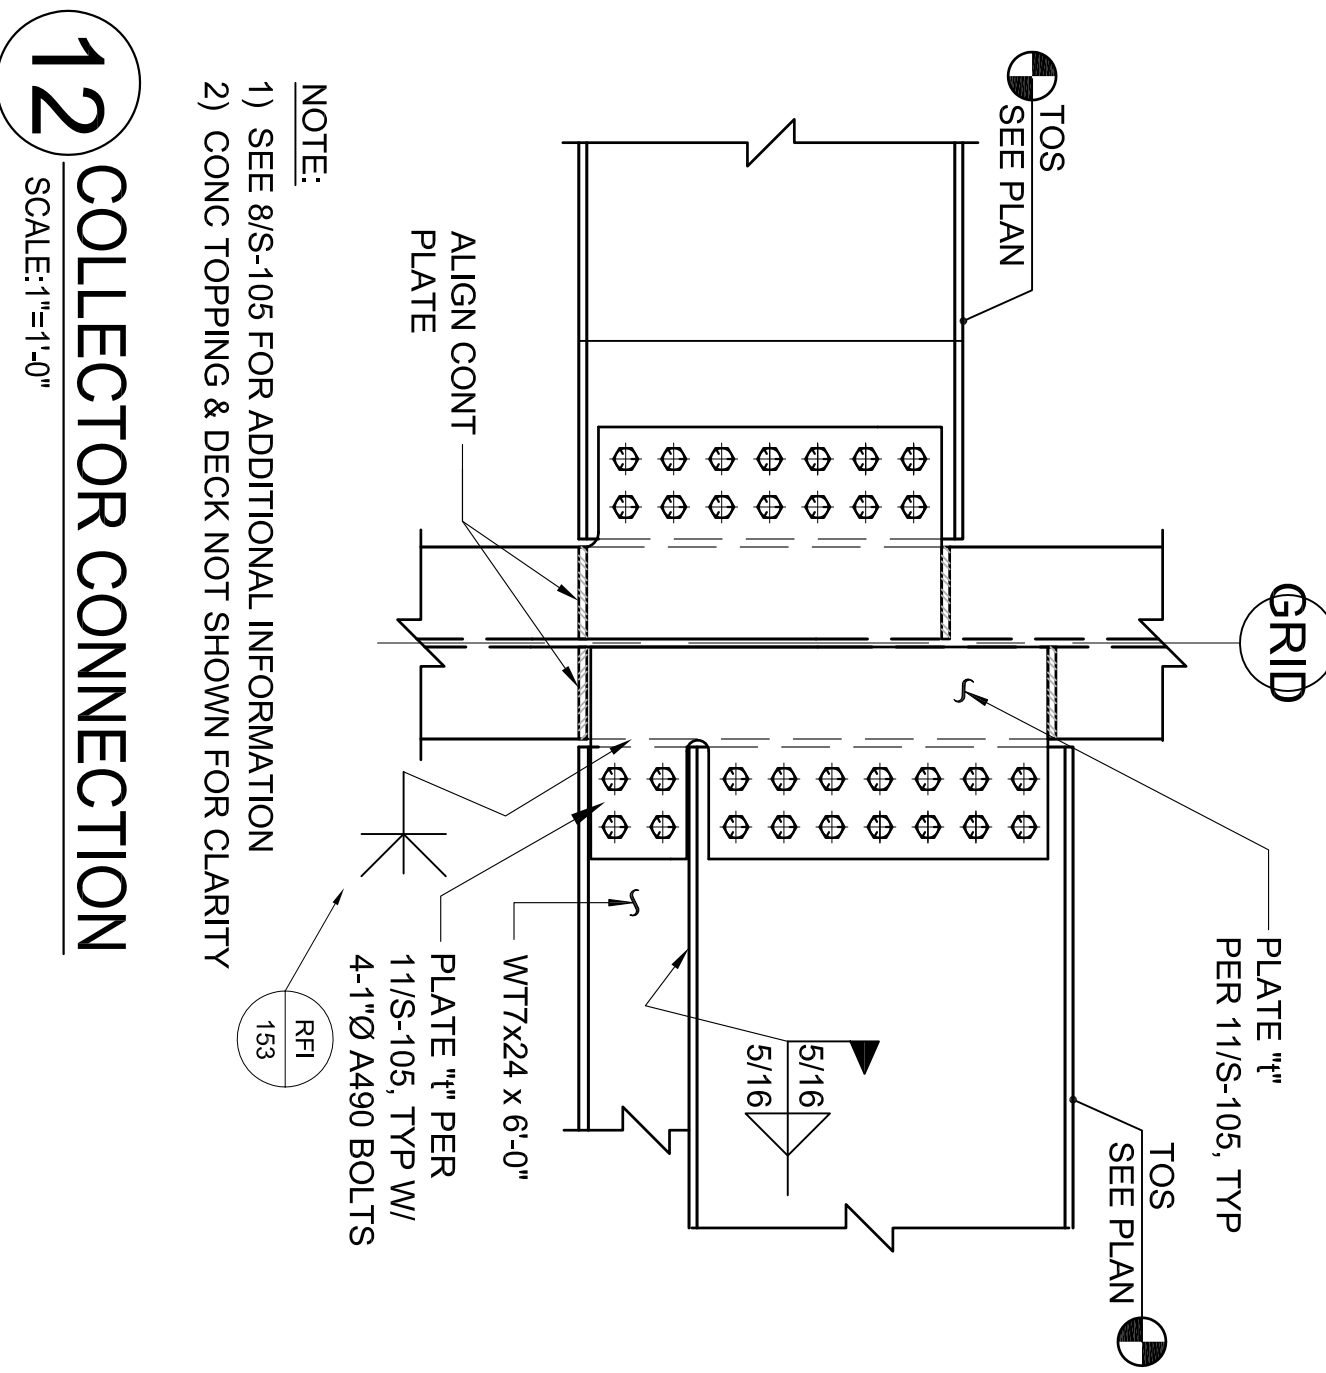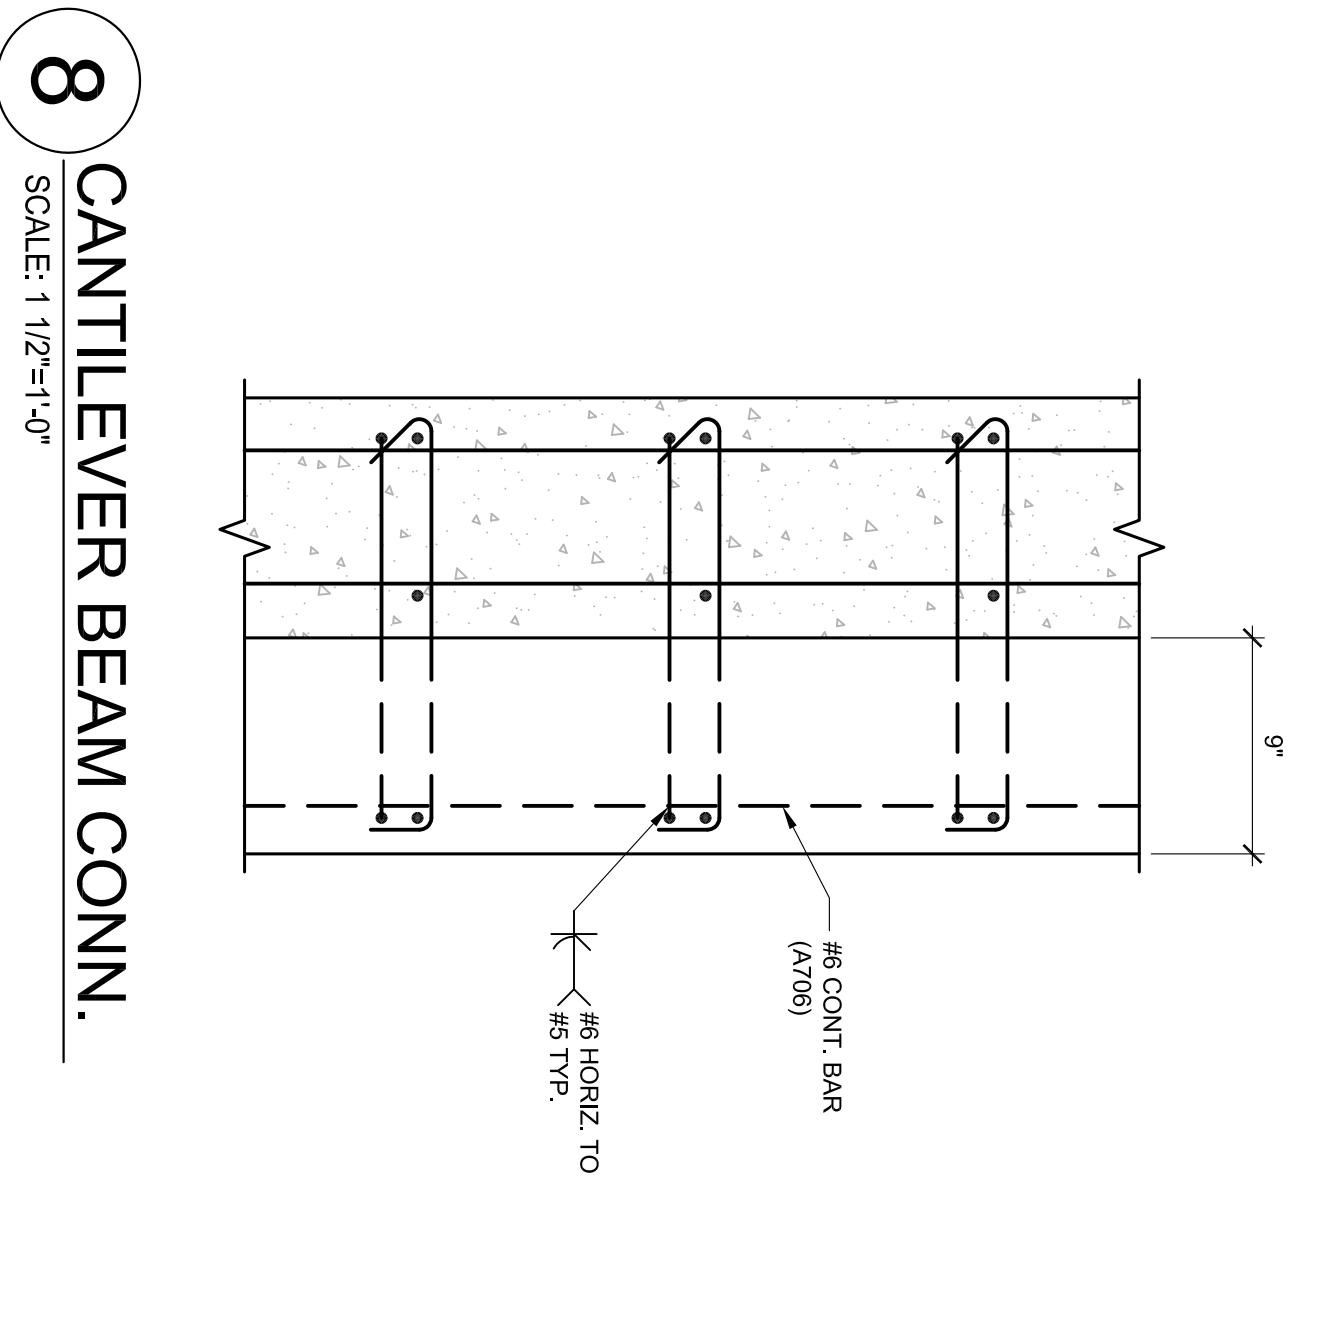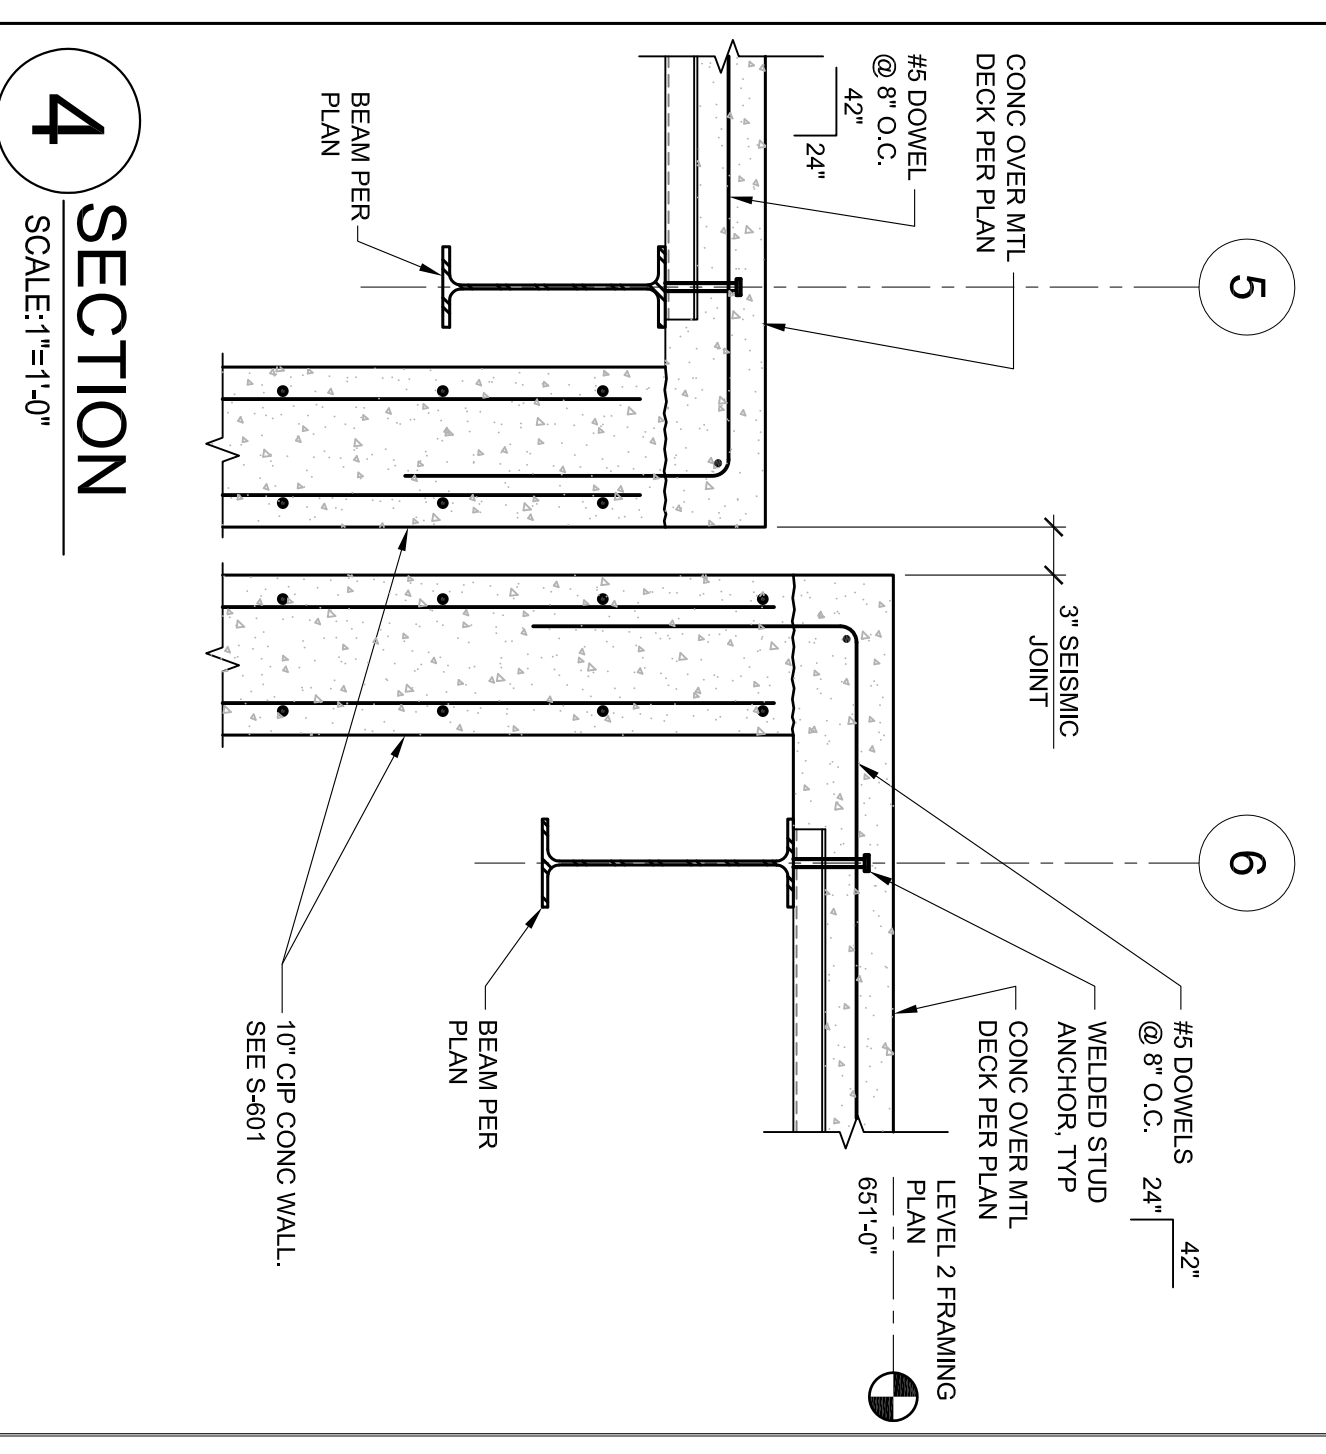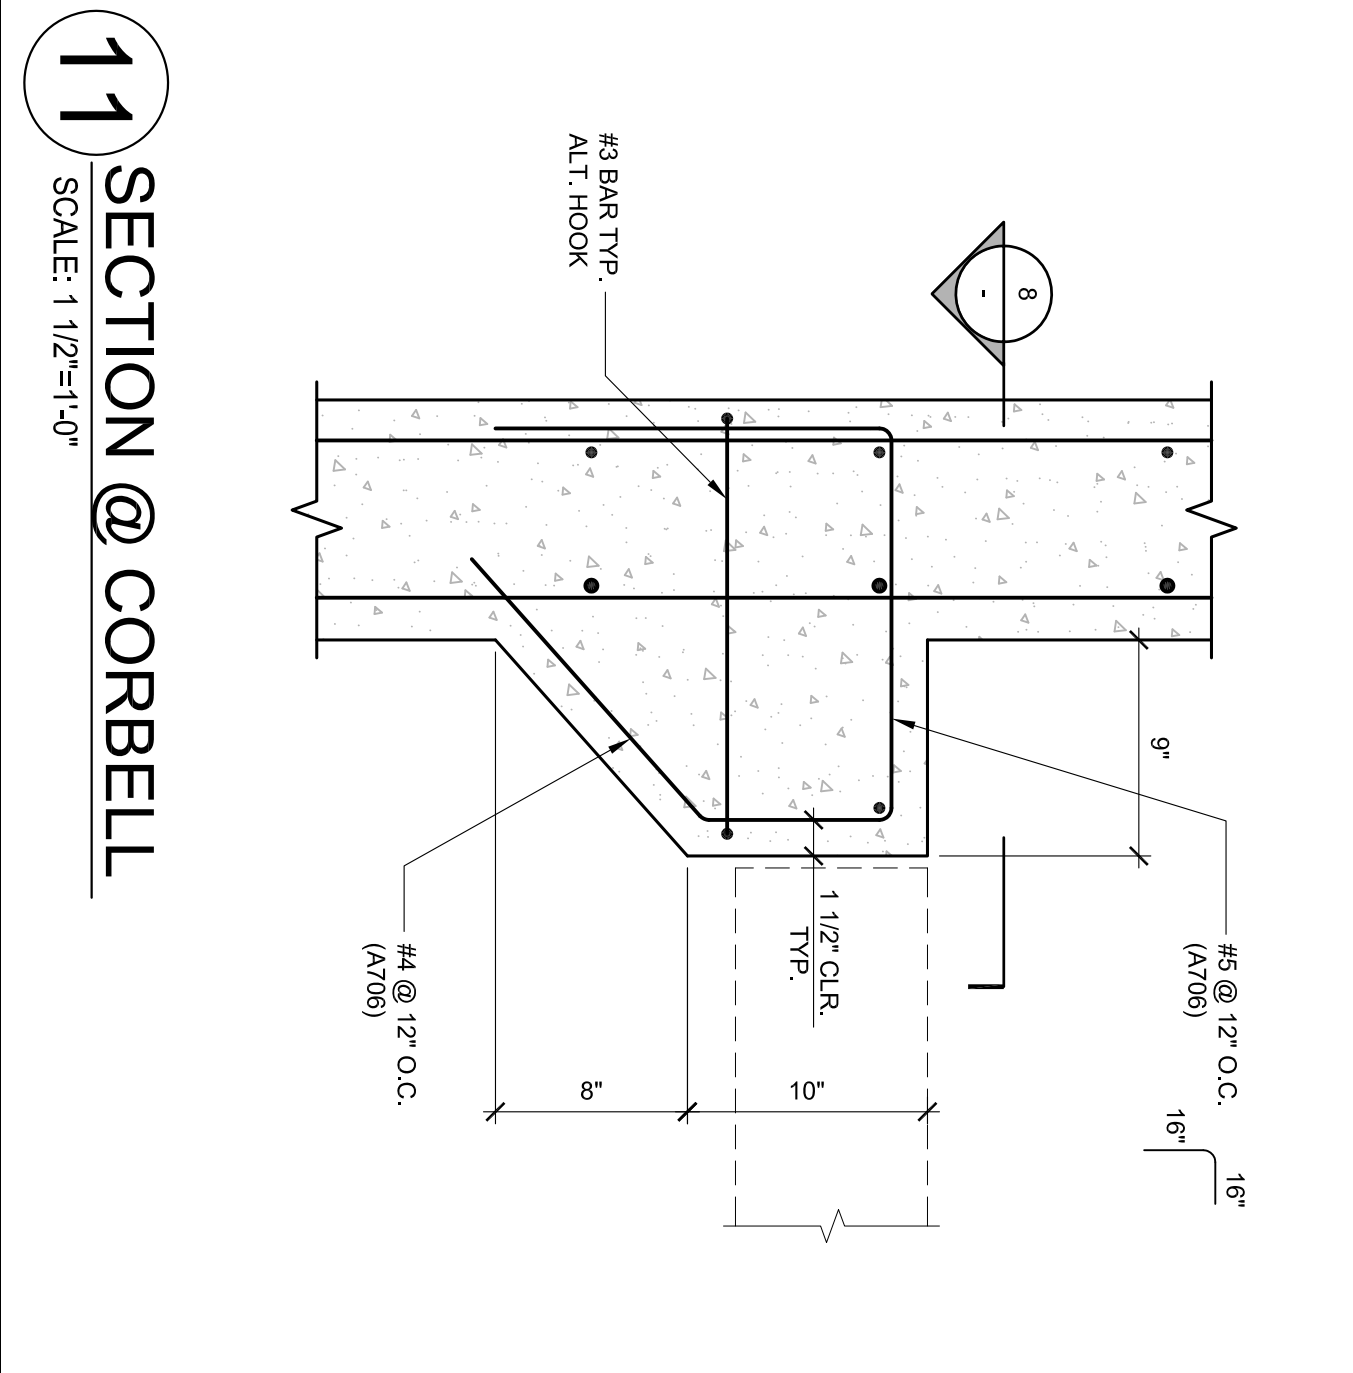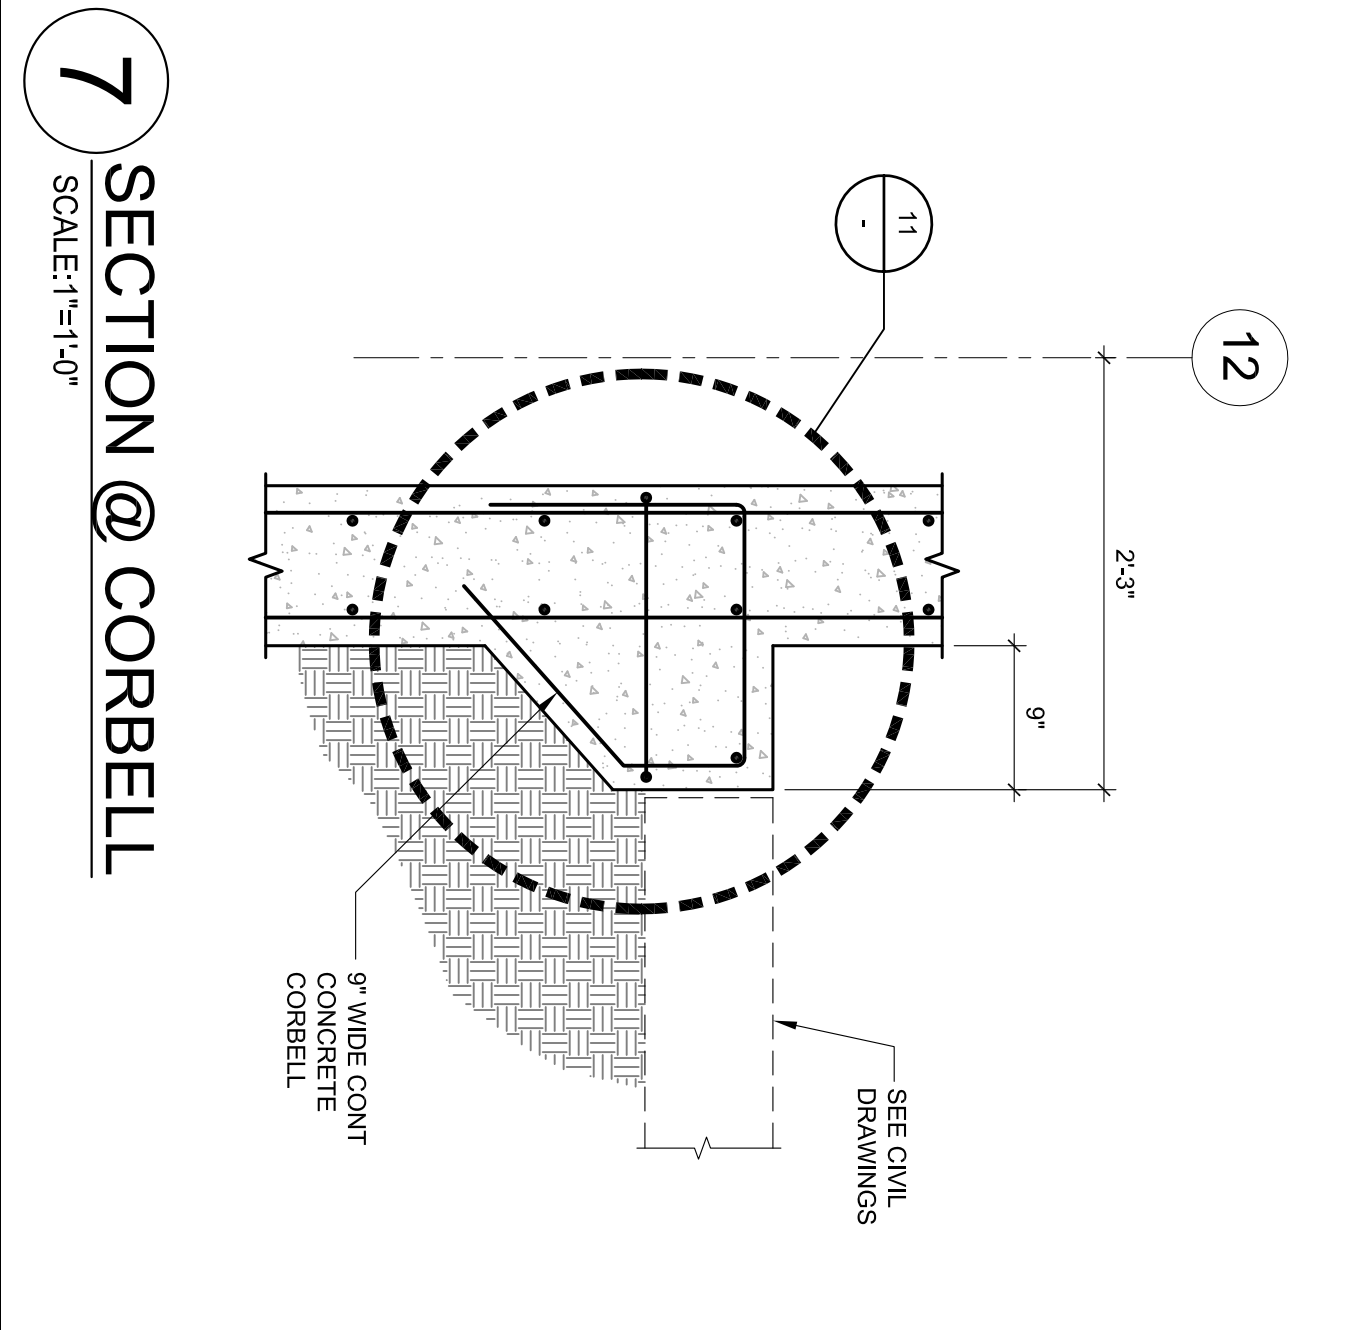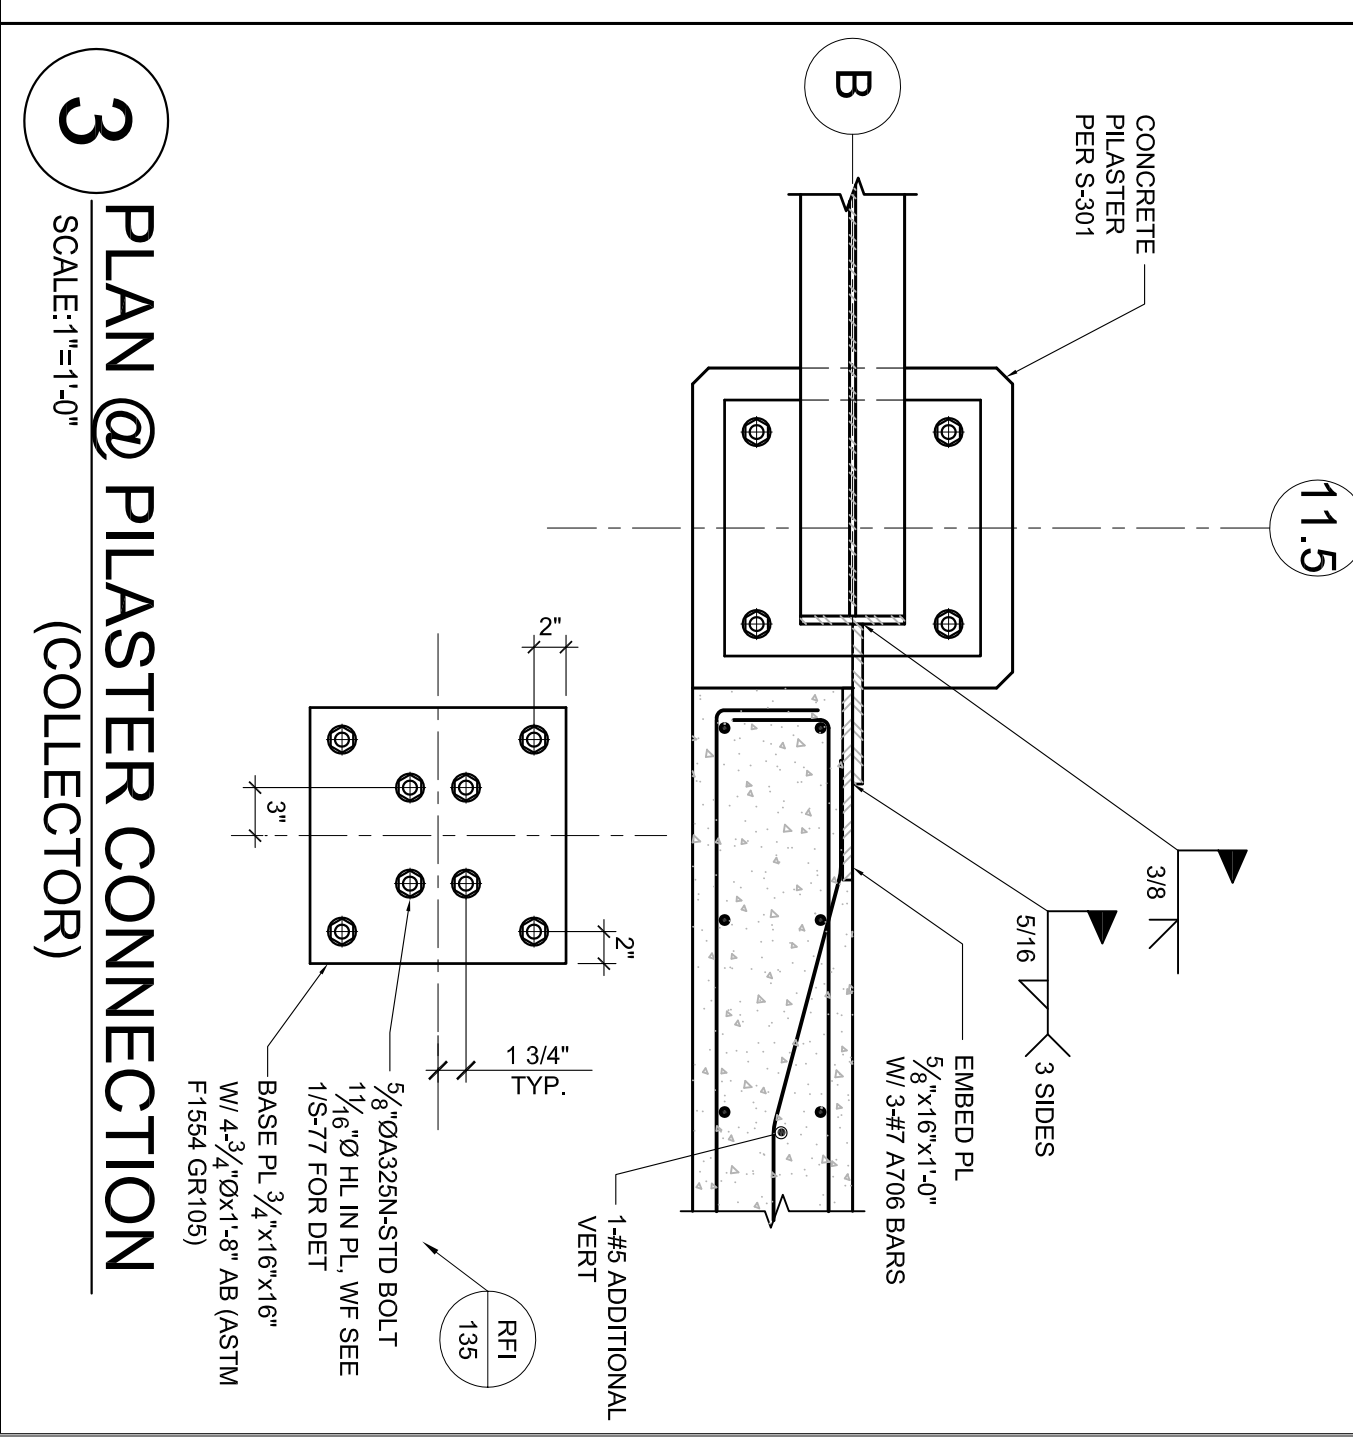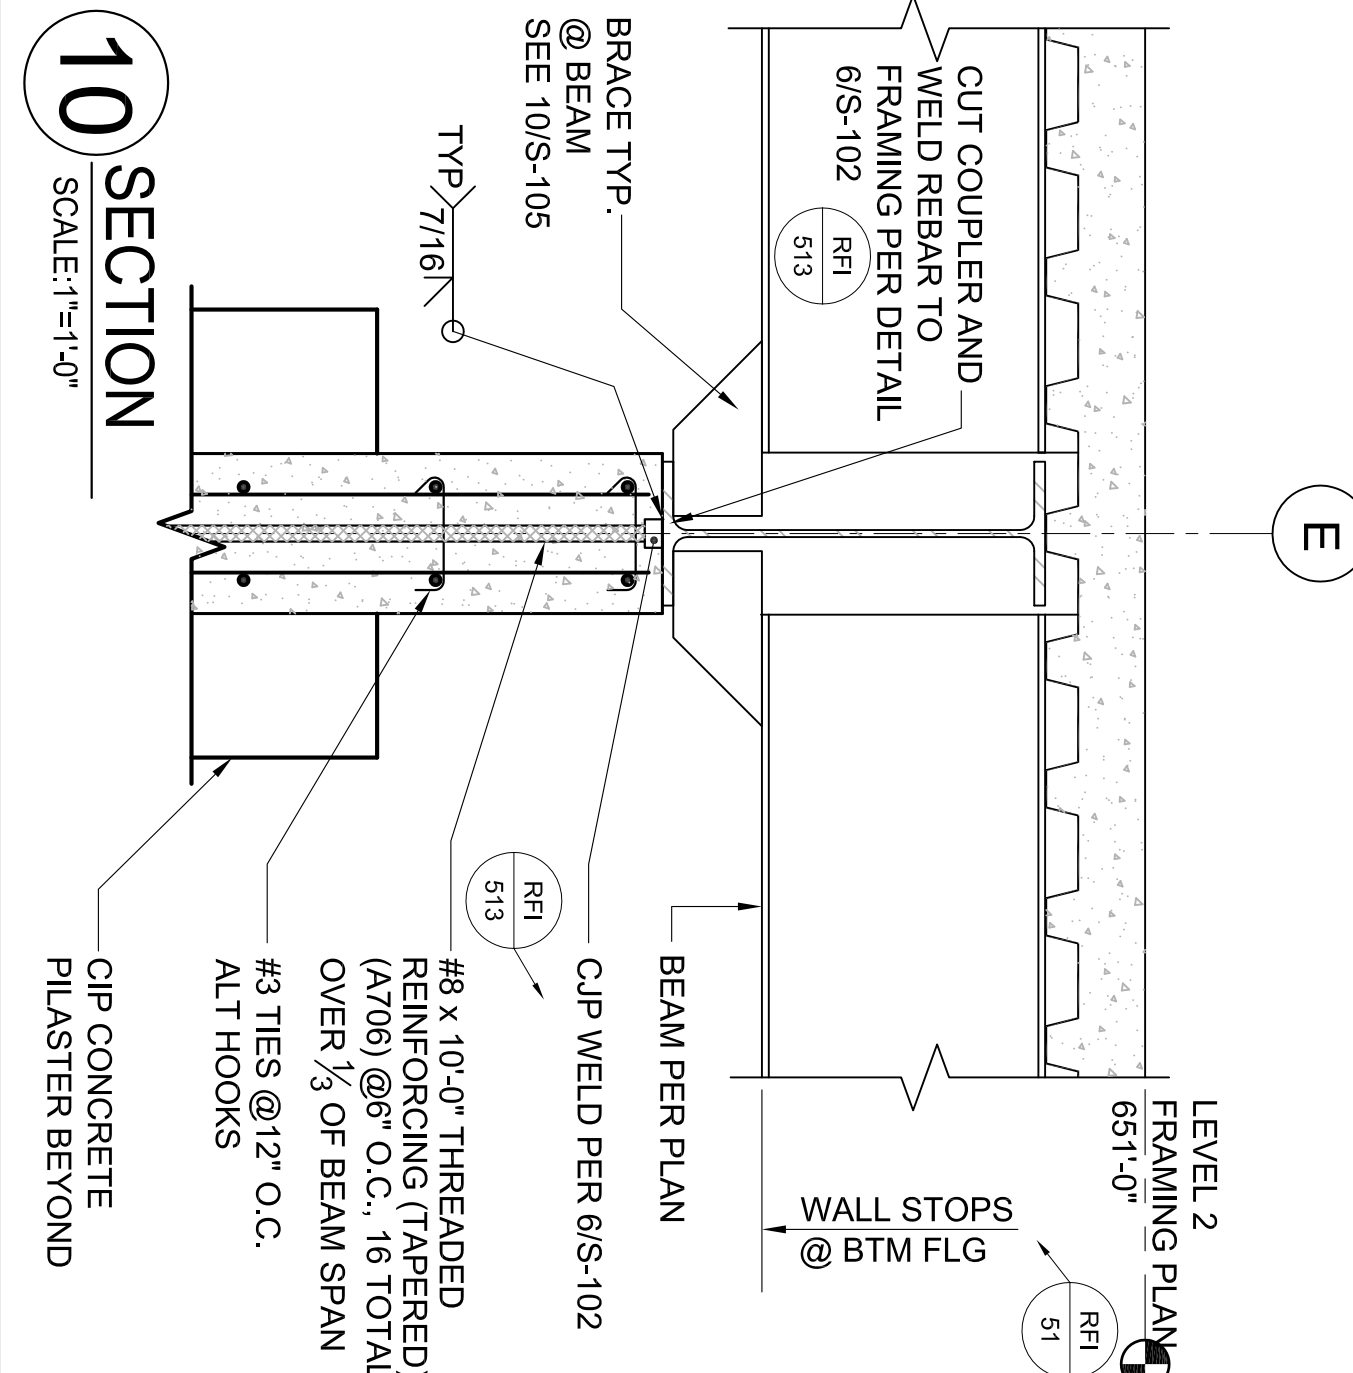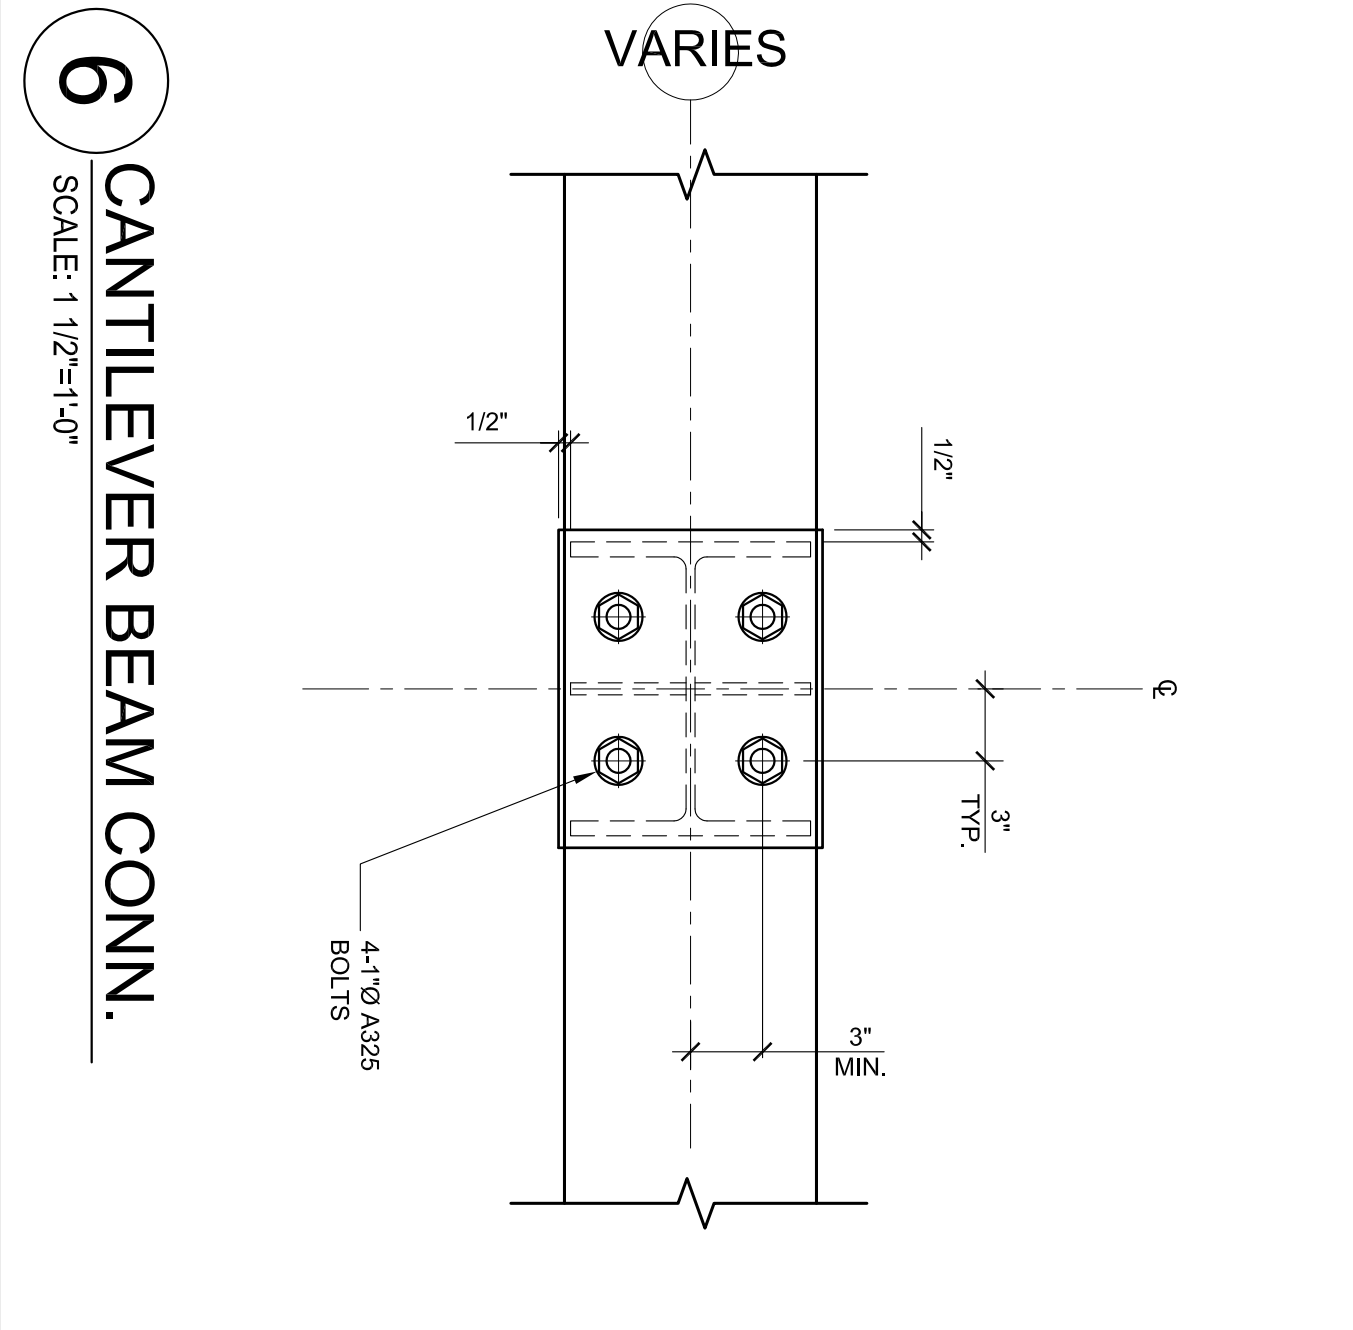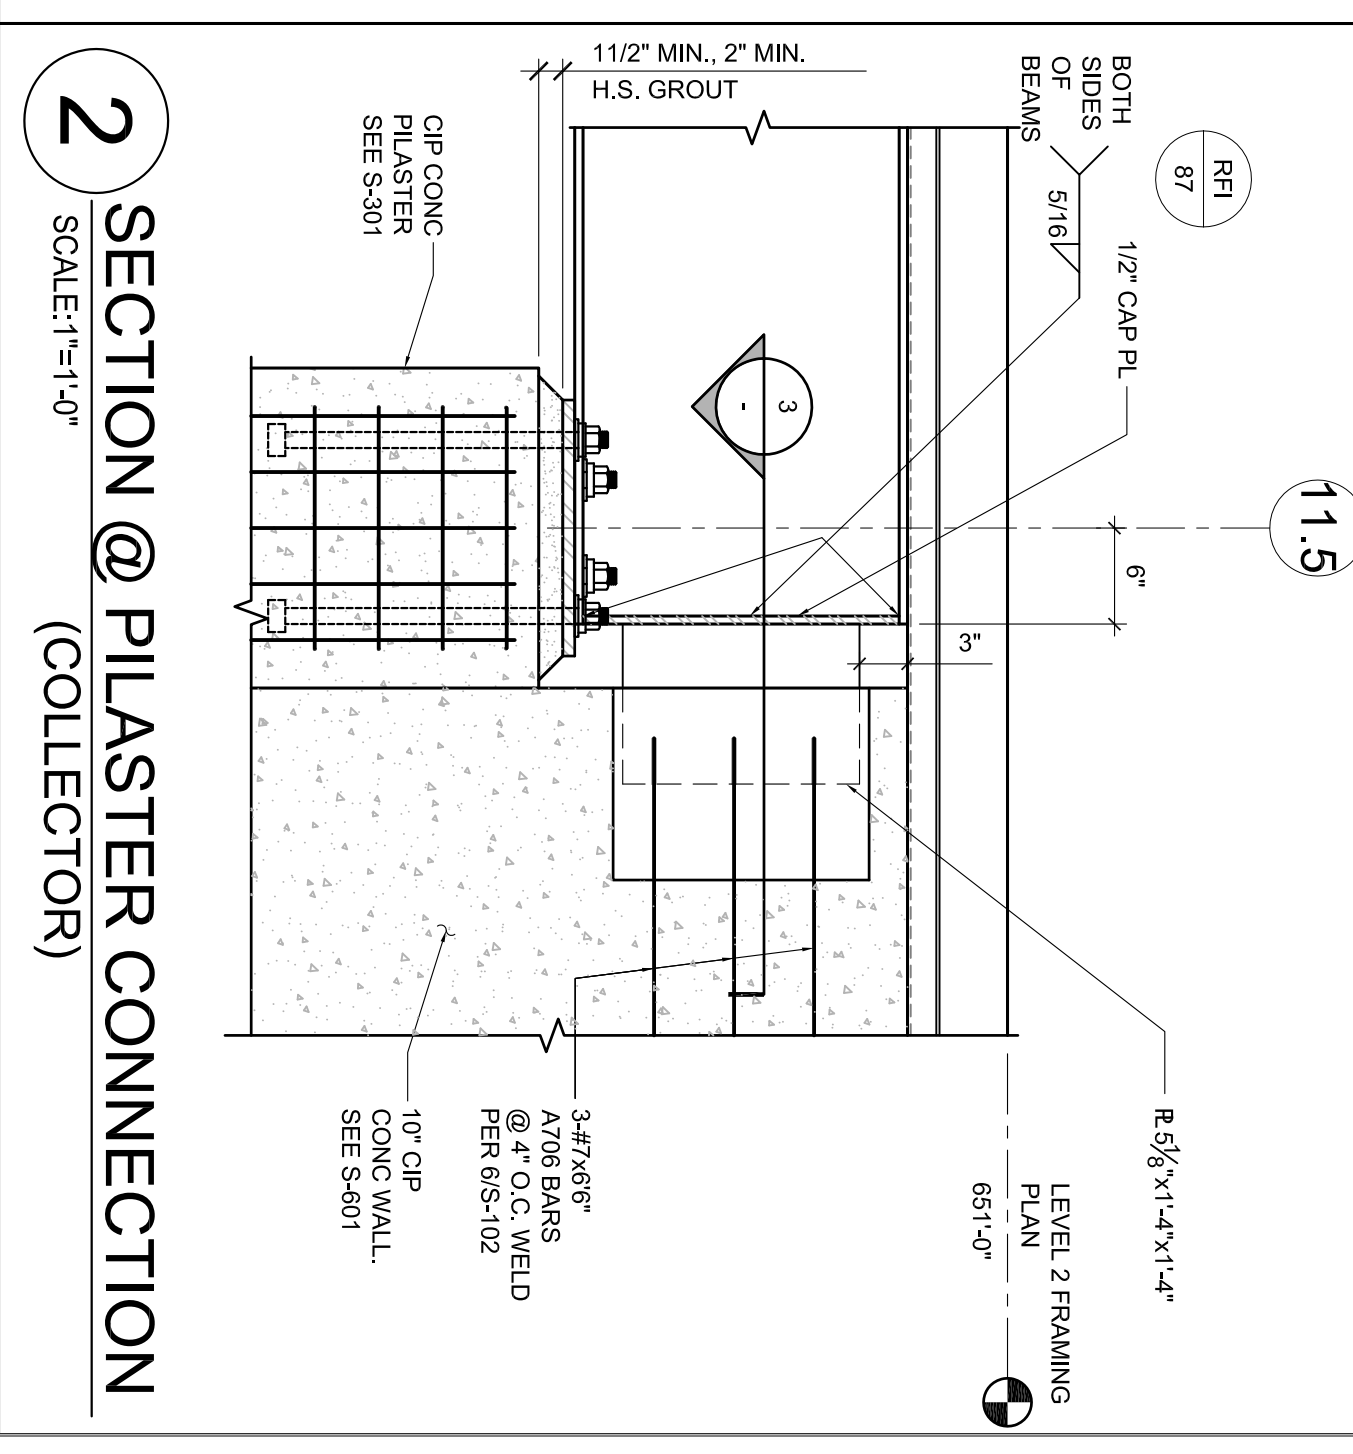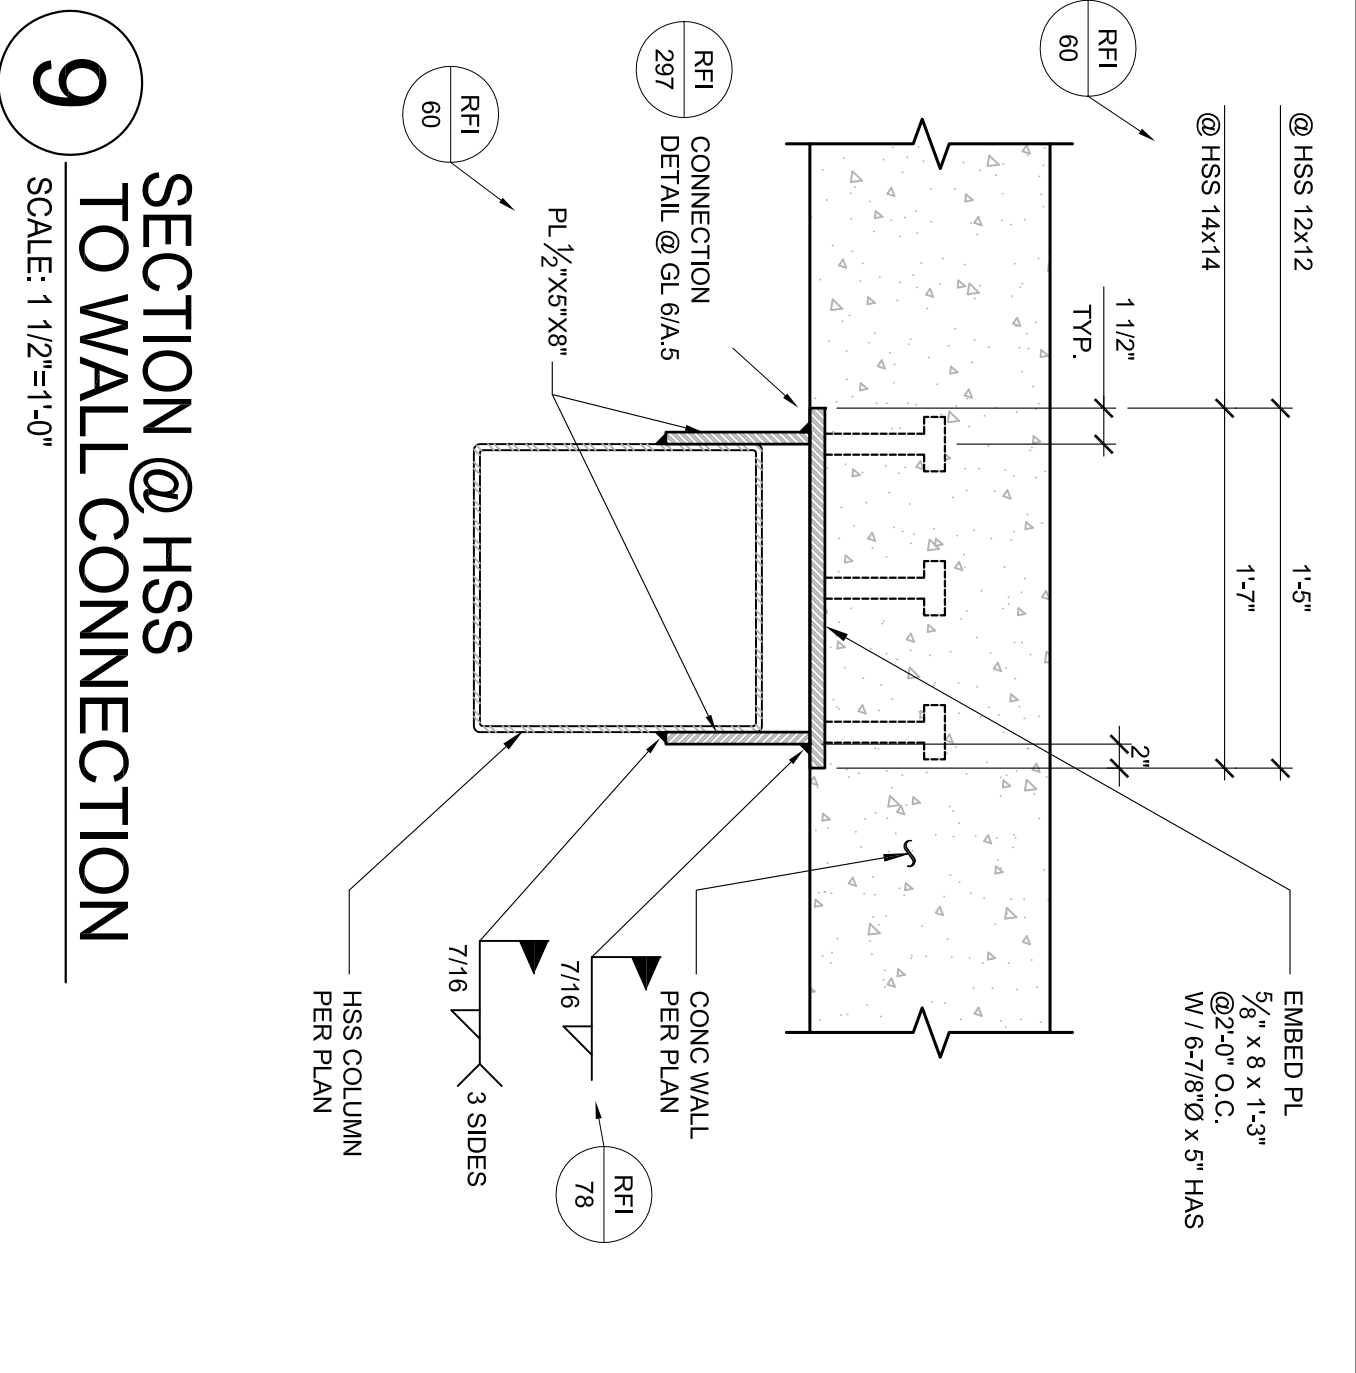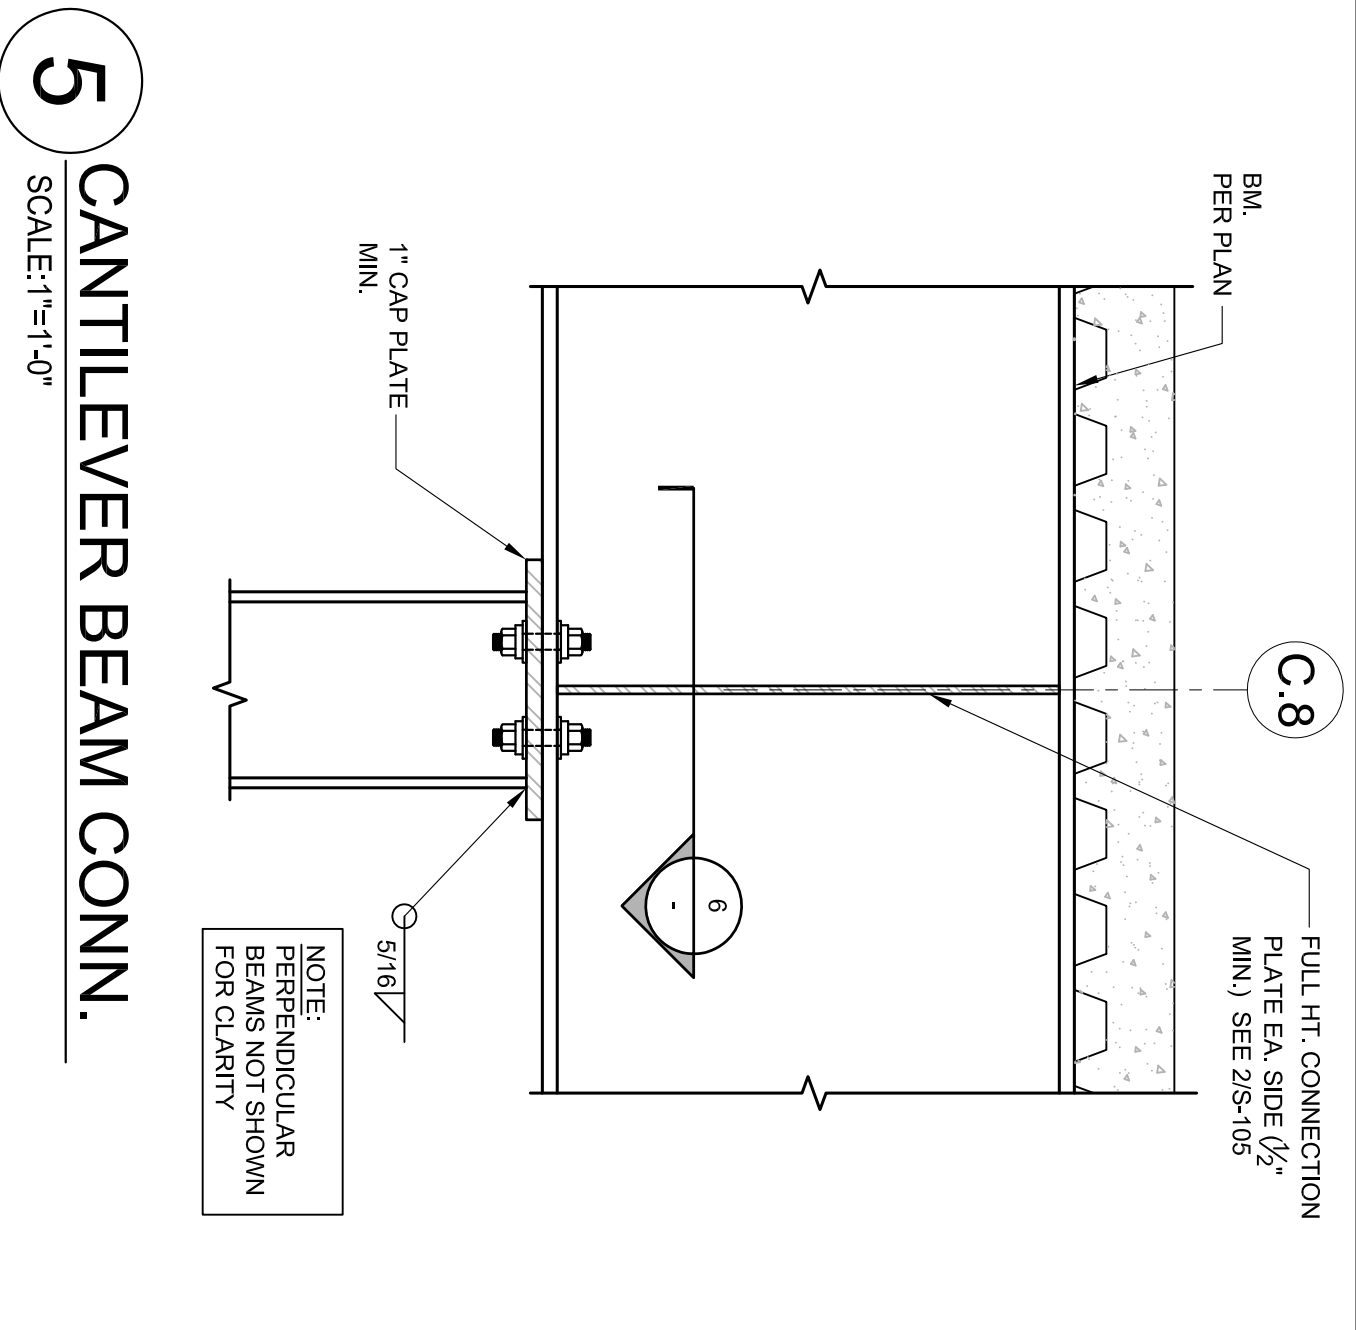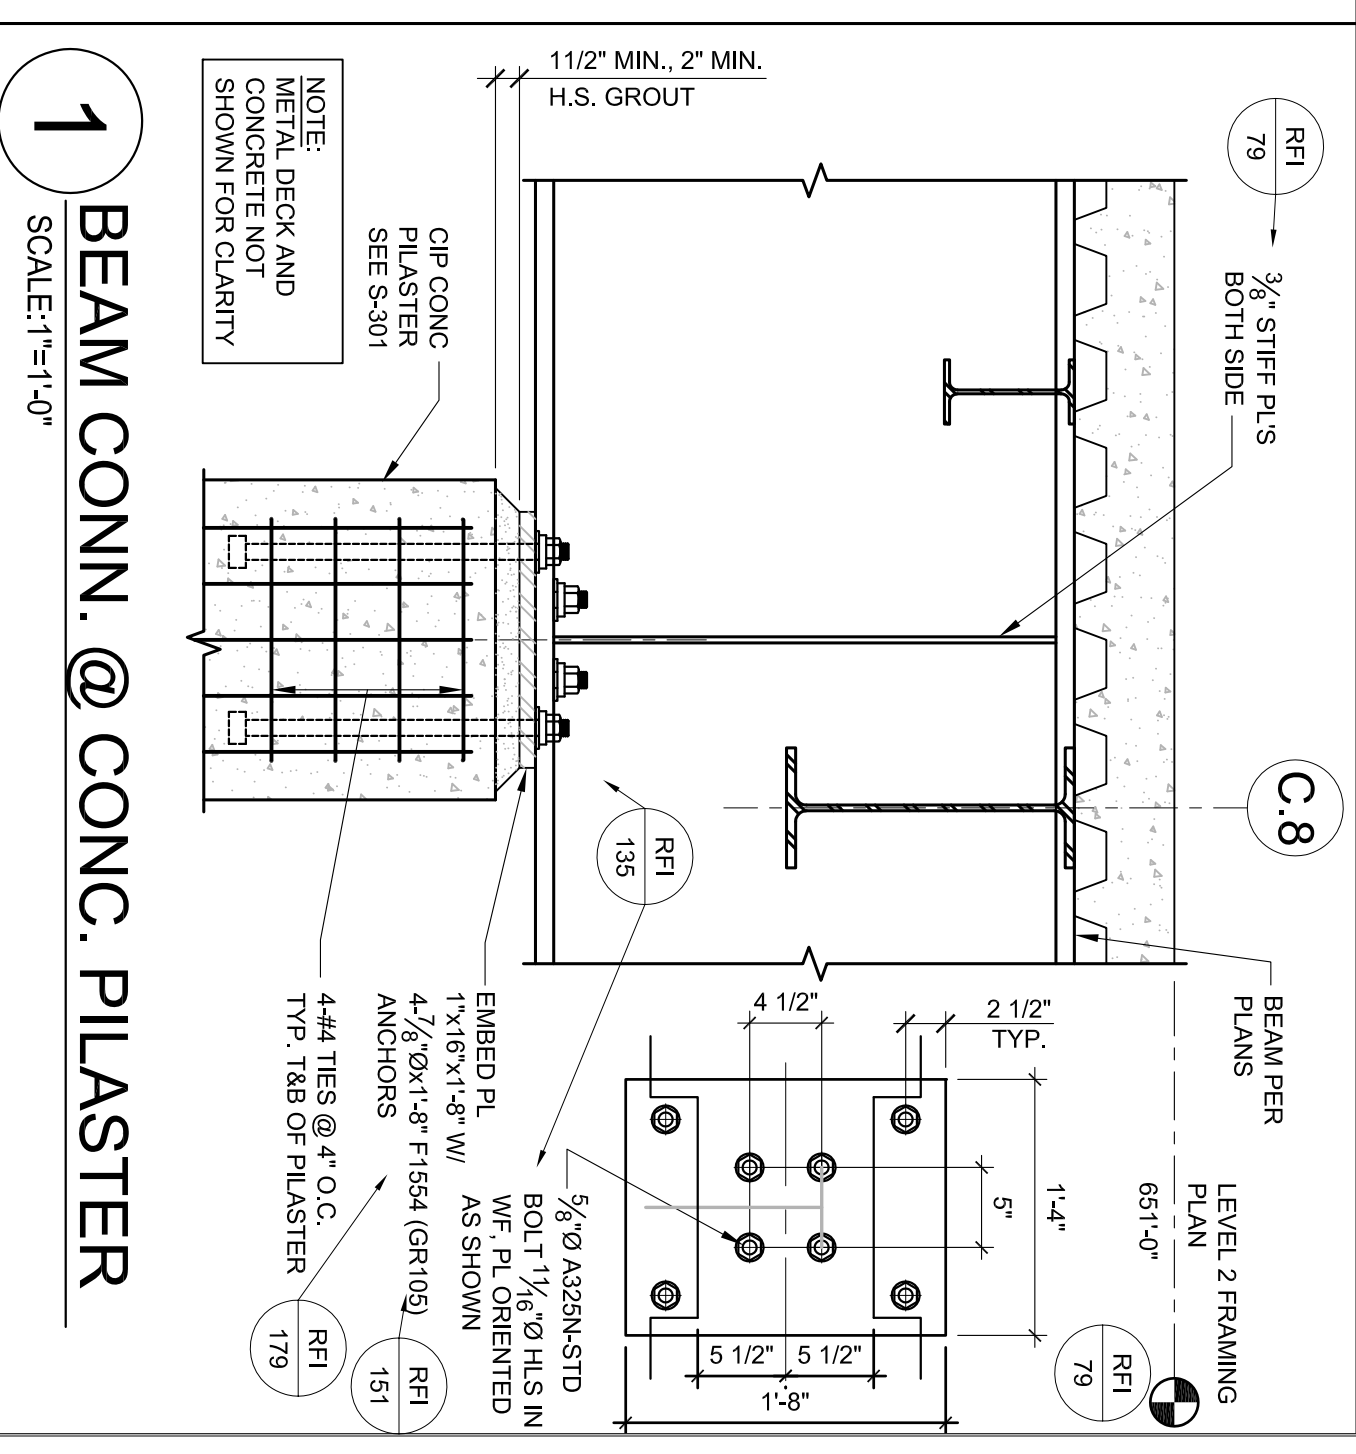






















SKYLINE COLLEGE  
SAN MATEO COUNTY  
COMMUNITY COLLEGE  
DISTRICT







CIP2 DESIGN-BUILD  
PROJECT  
BUILDING 4

PROJECT NO.: 0071240  
DATE: 03/08/09  
SCALE:  
SHEET TITLE:  
LEVEL 2  
DETAILS

DRAWN BY: AV  
CHECKED BY: CB

 
SHEET NO.: S-722

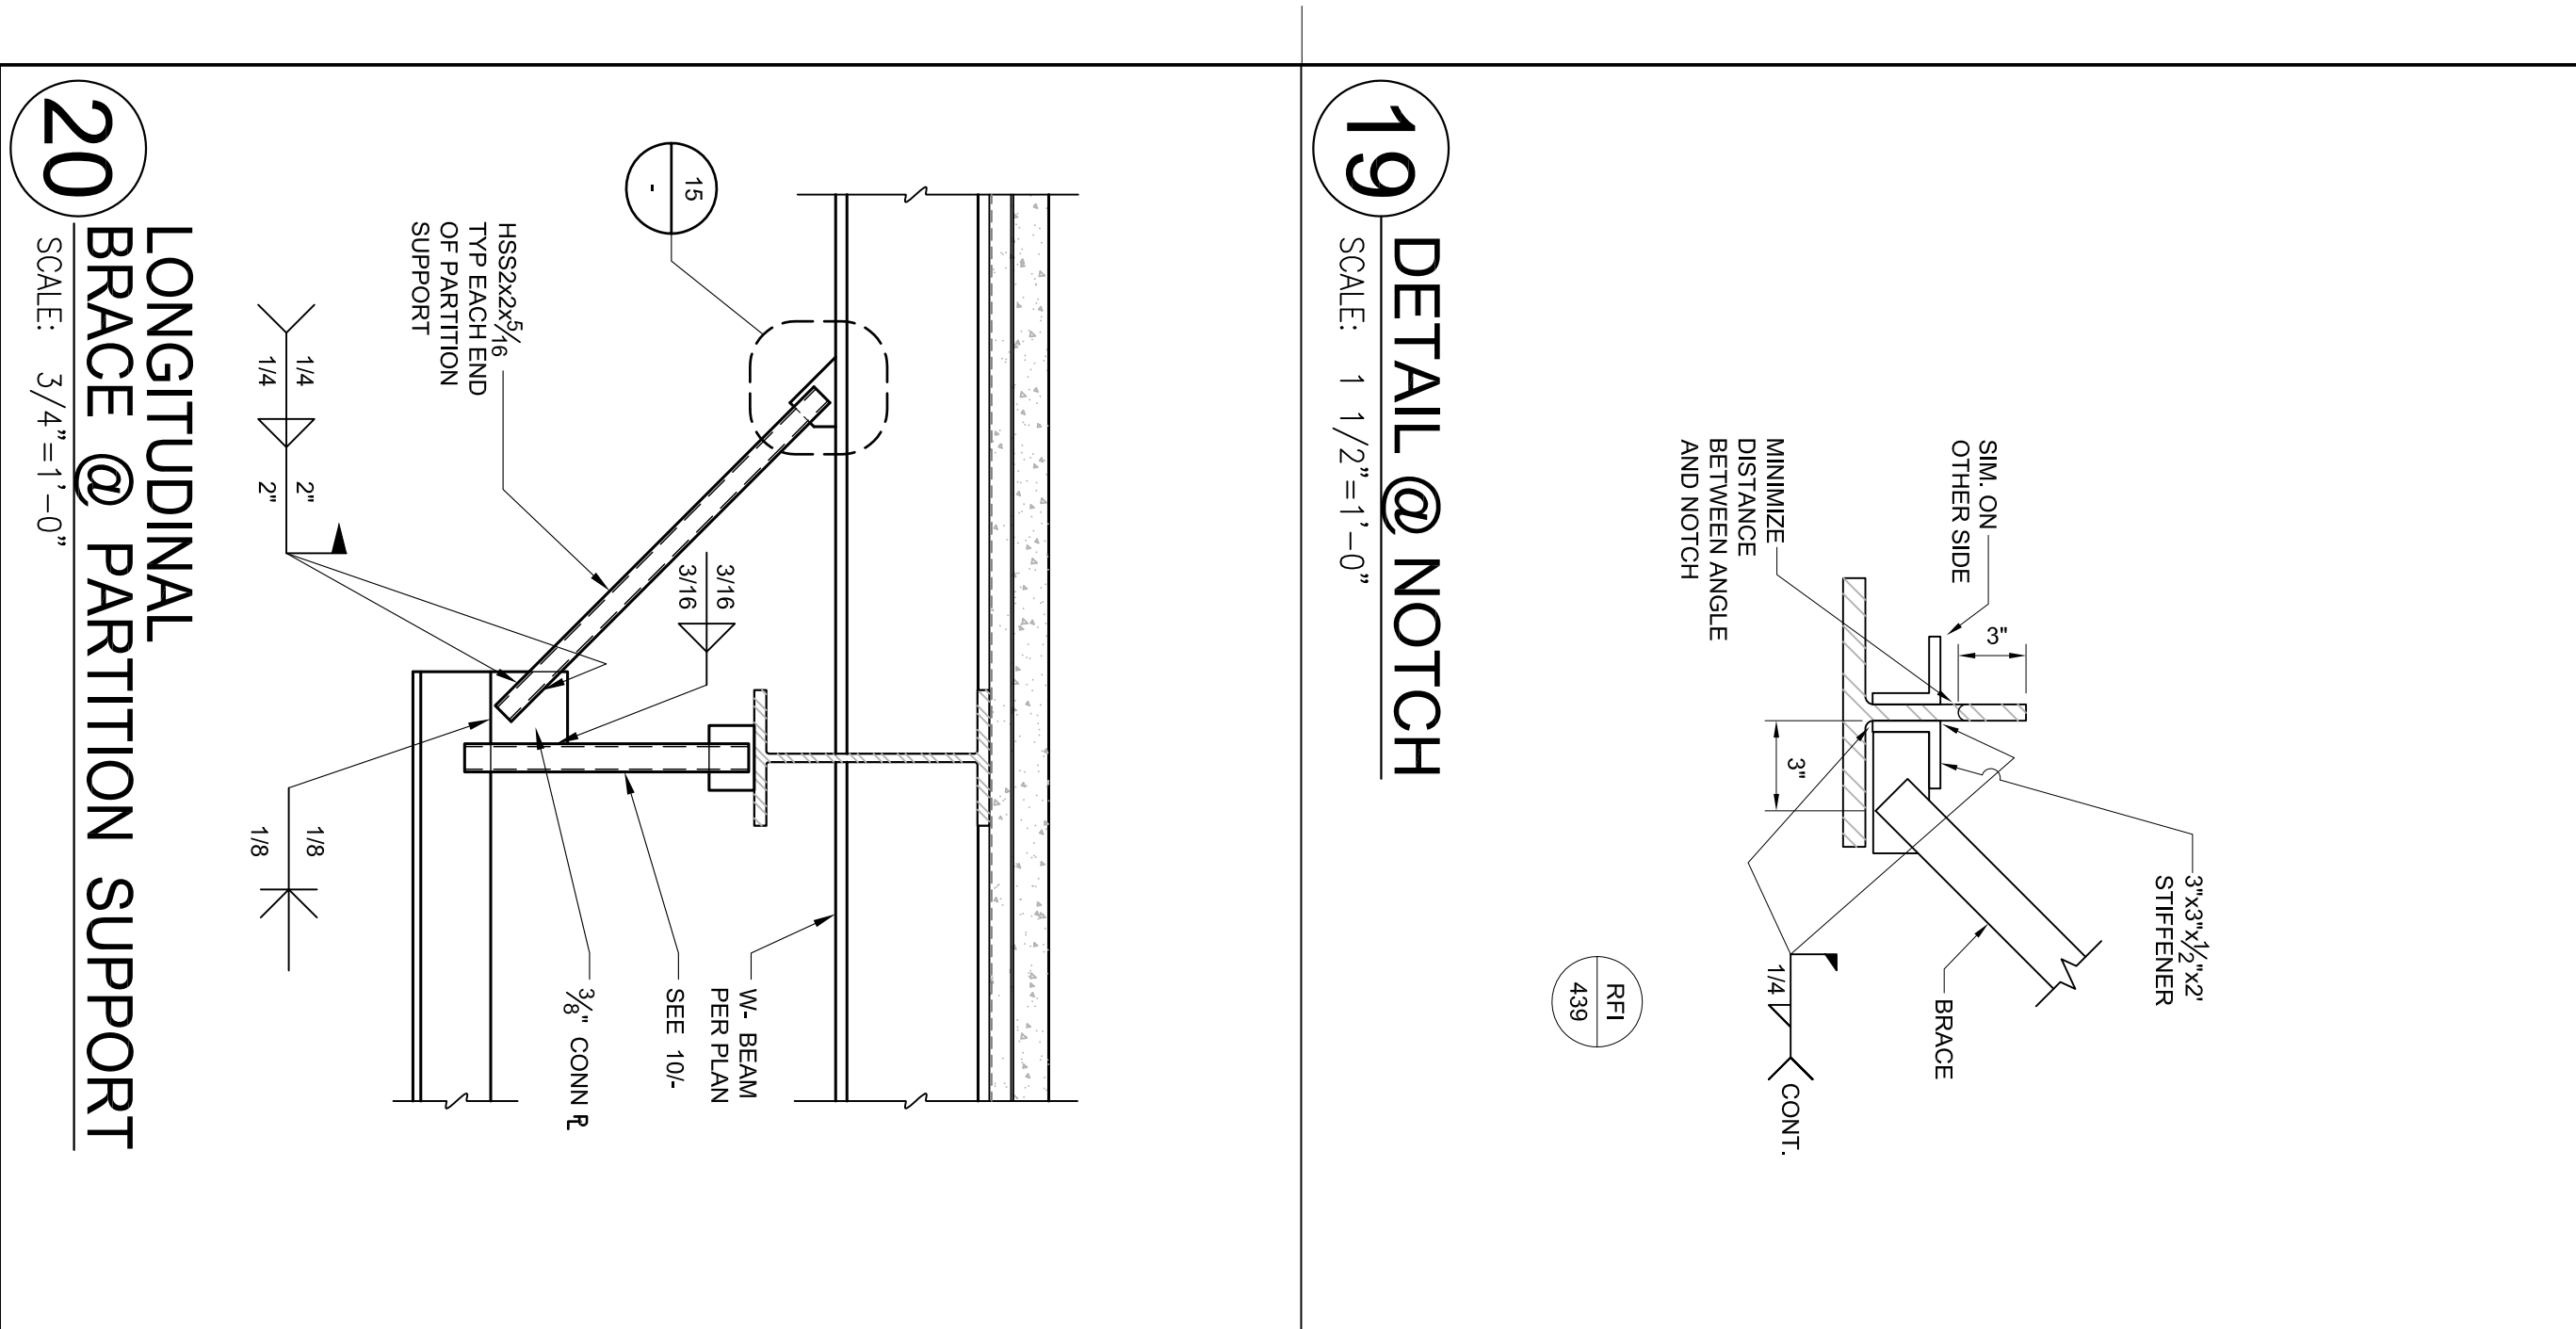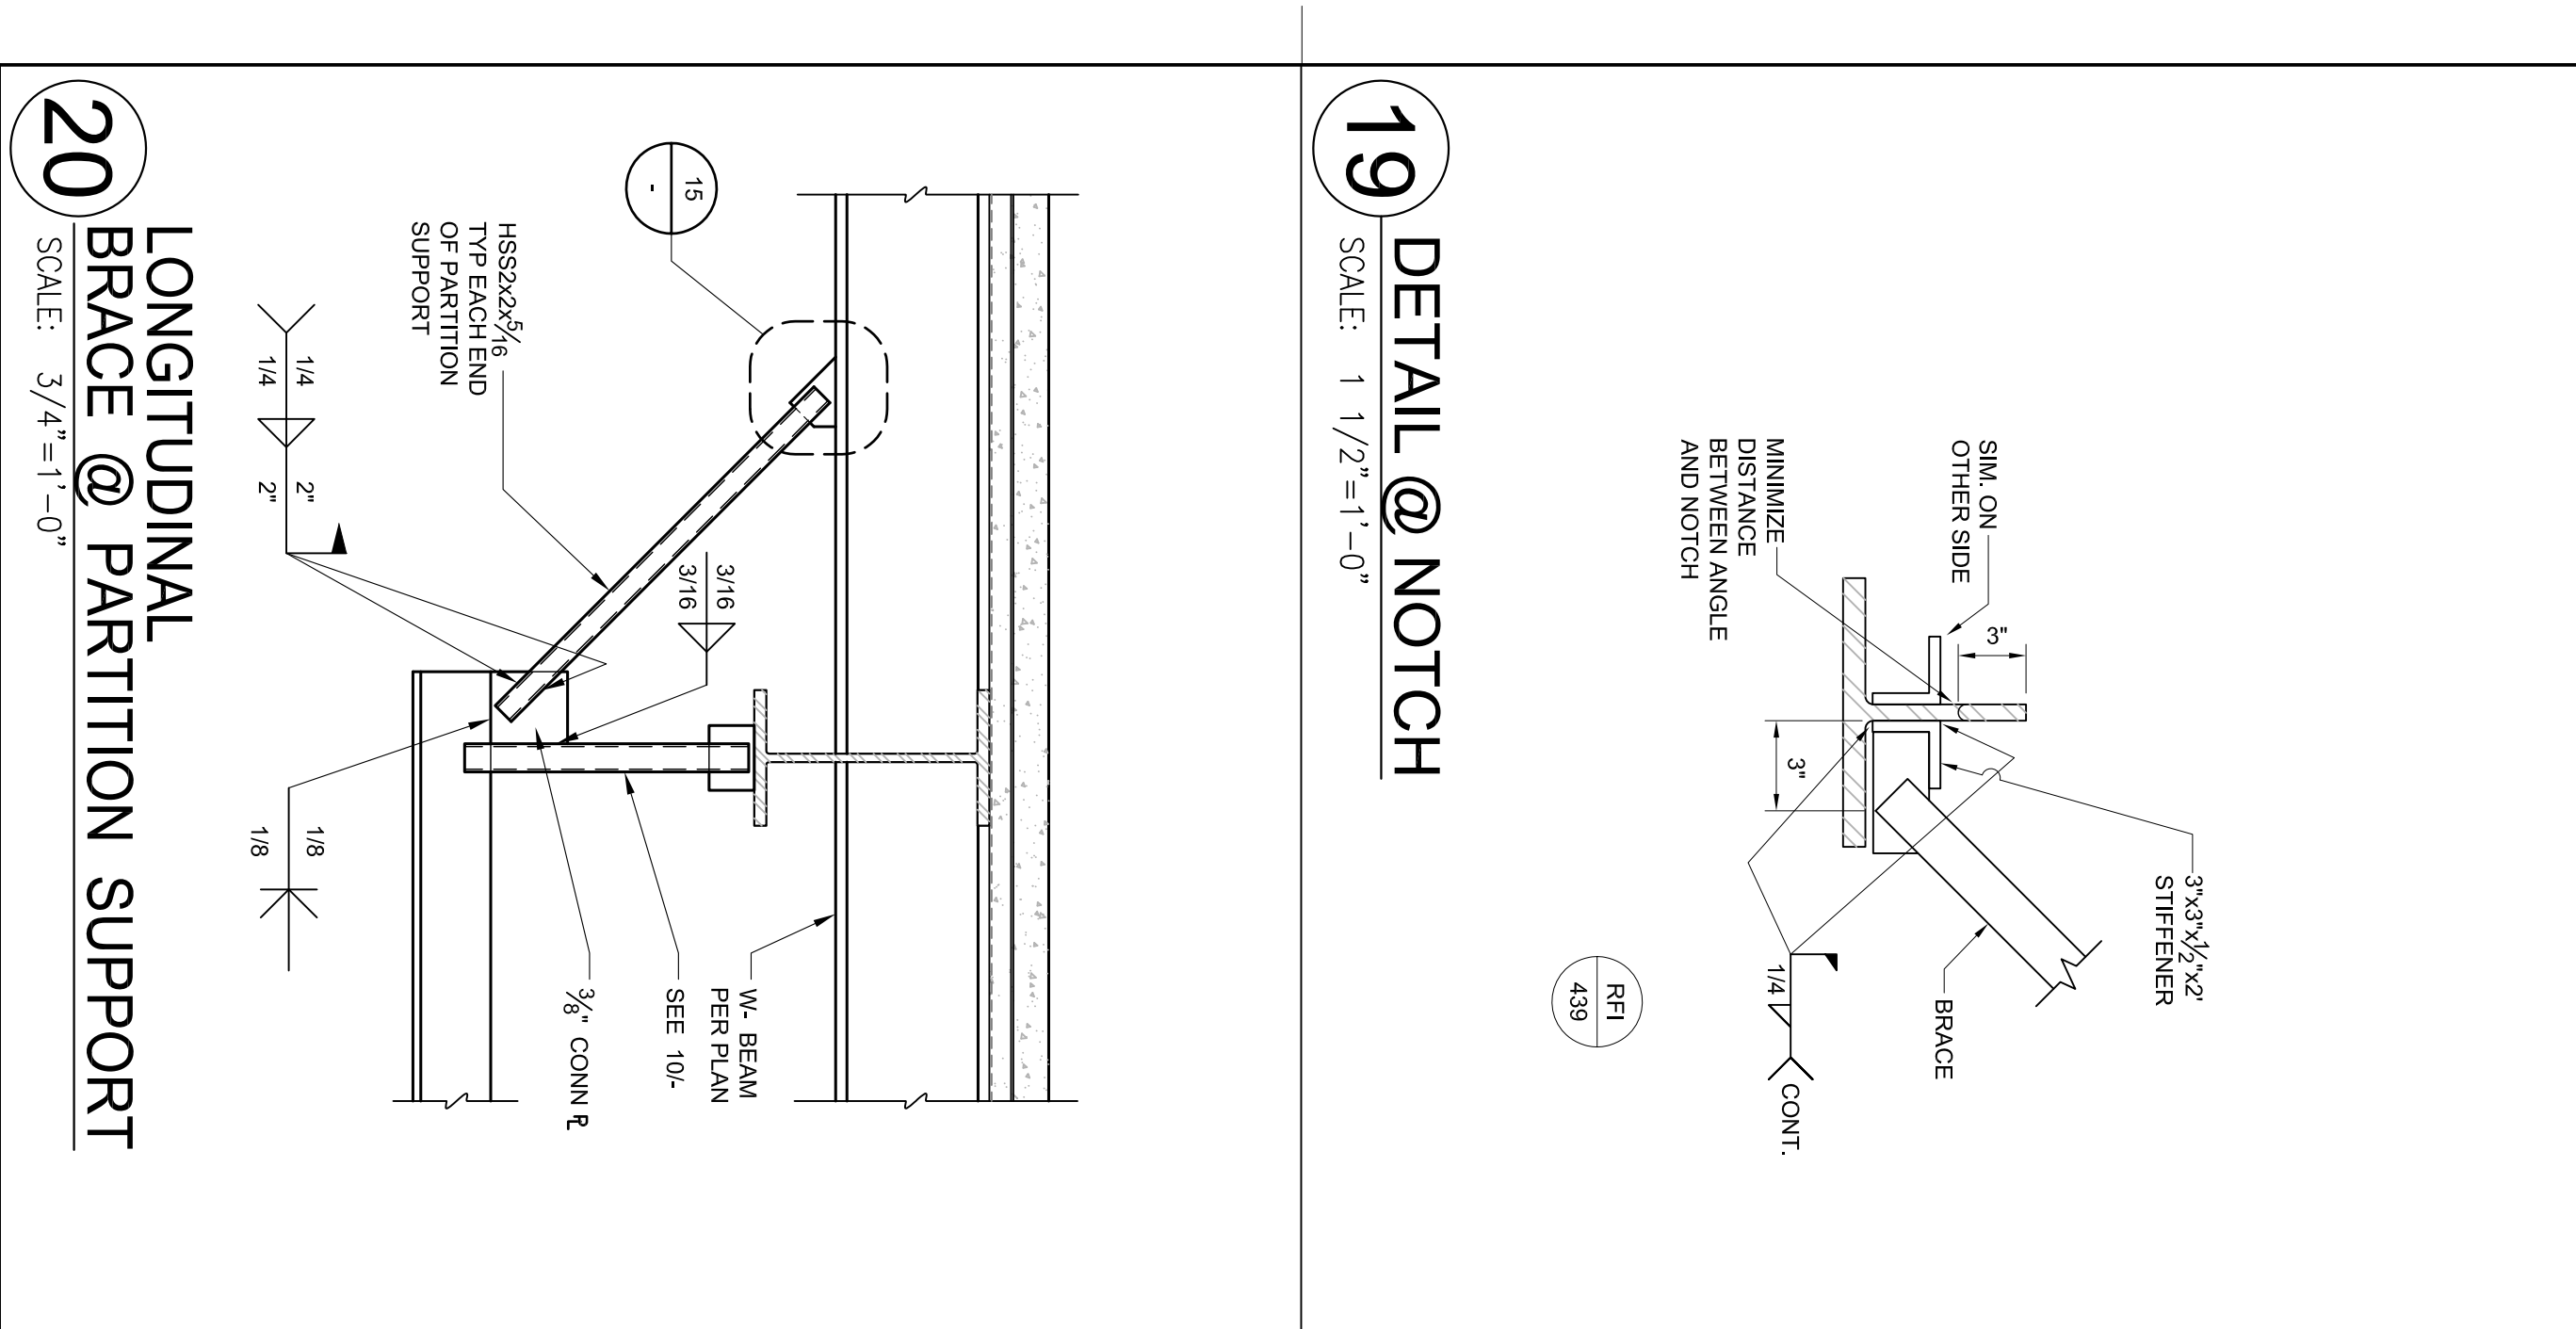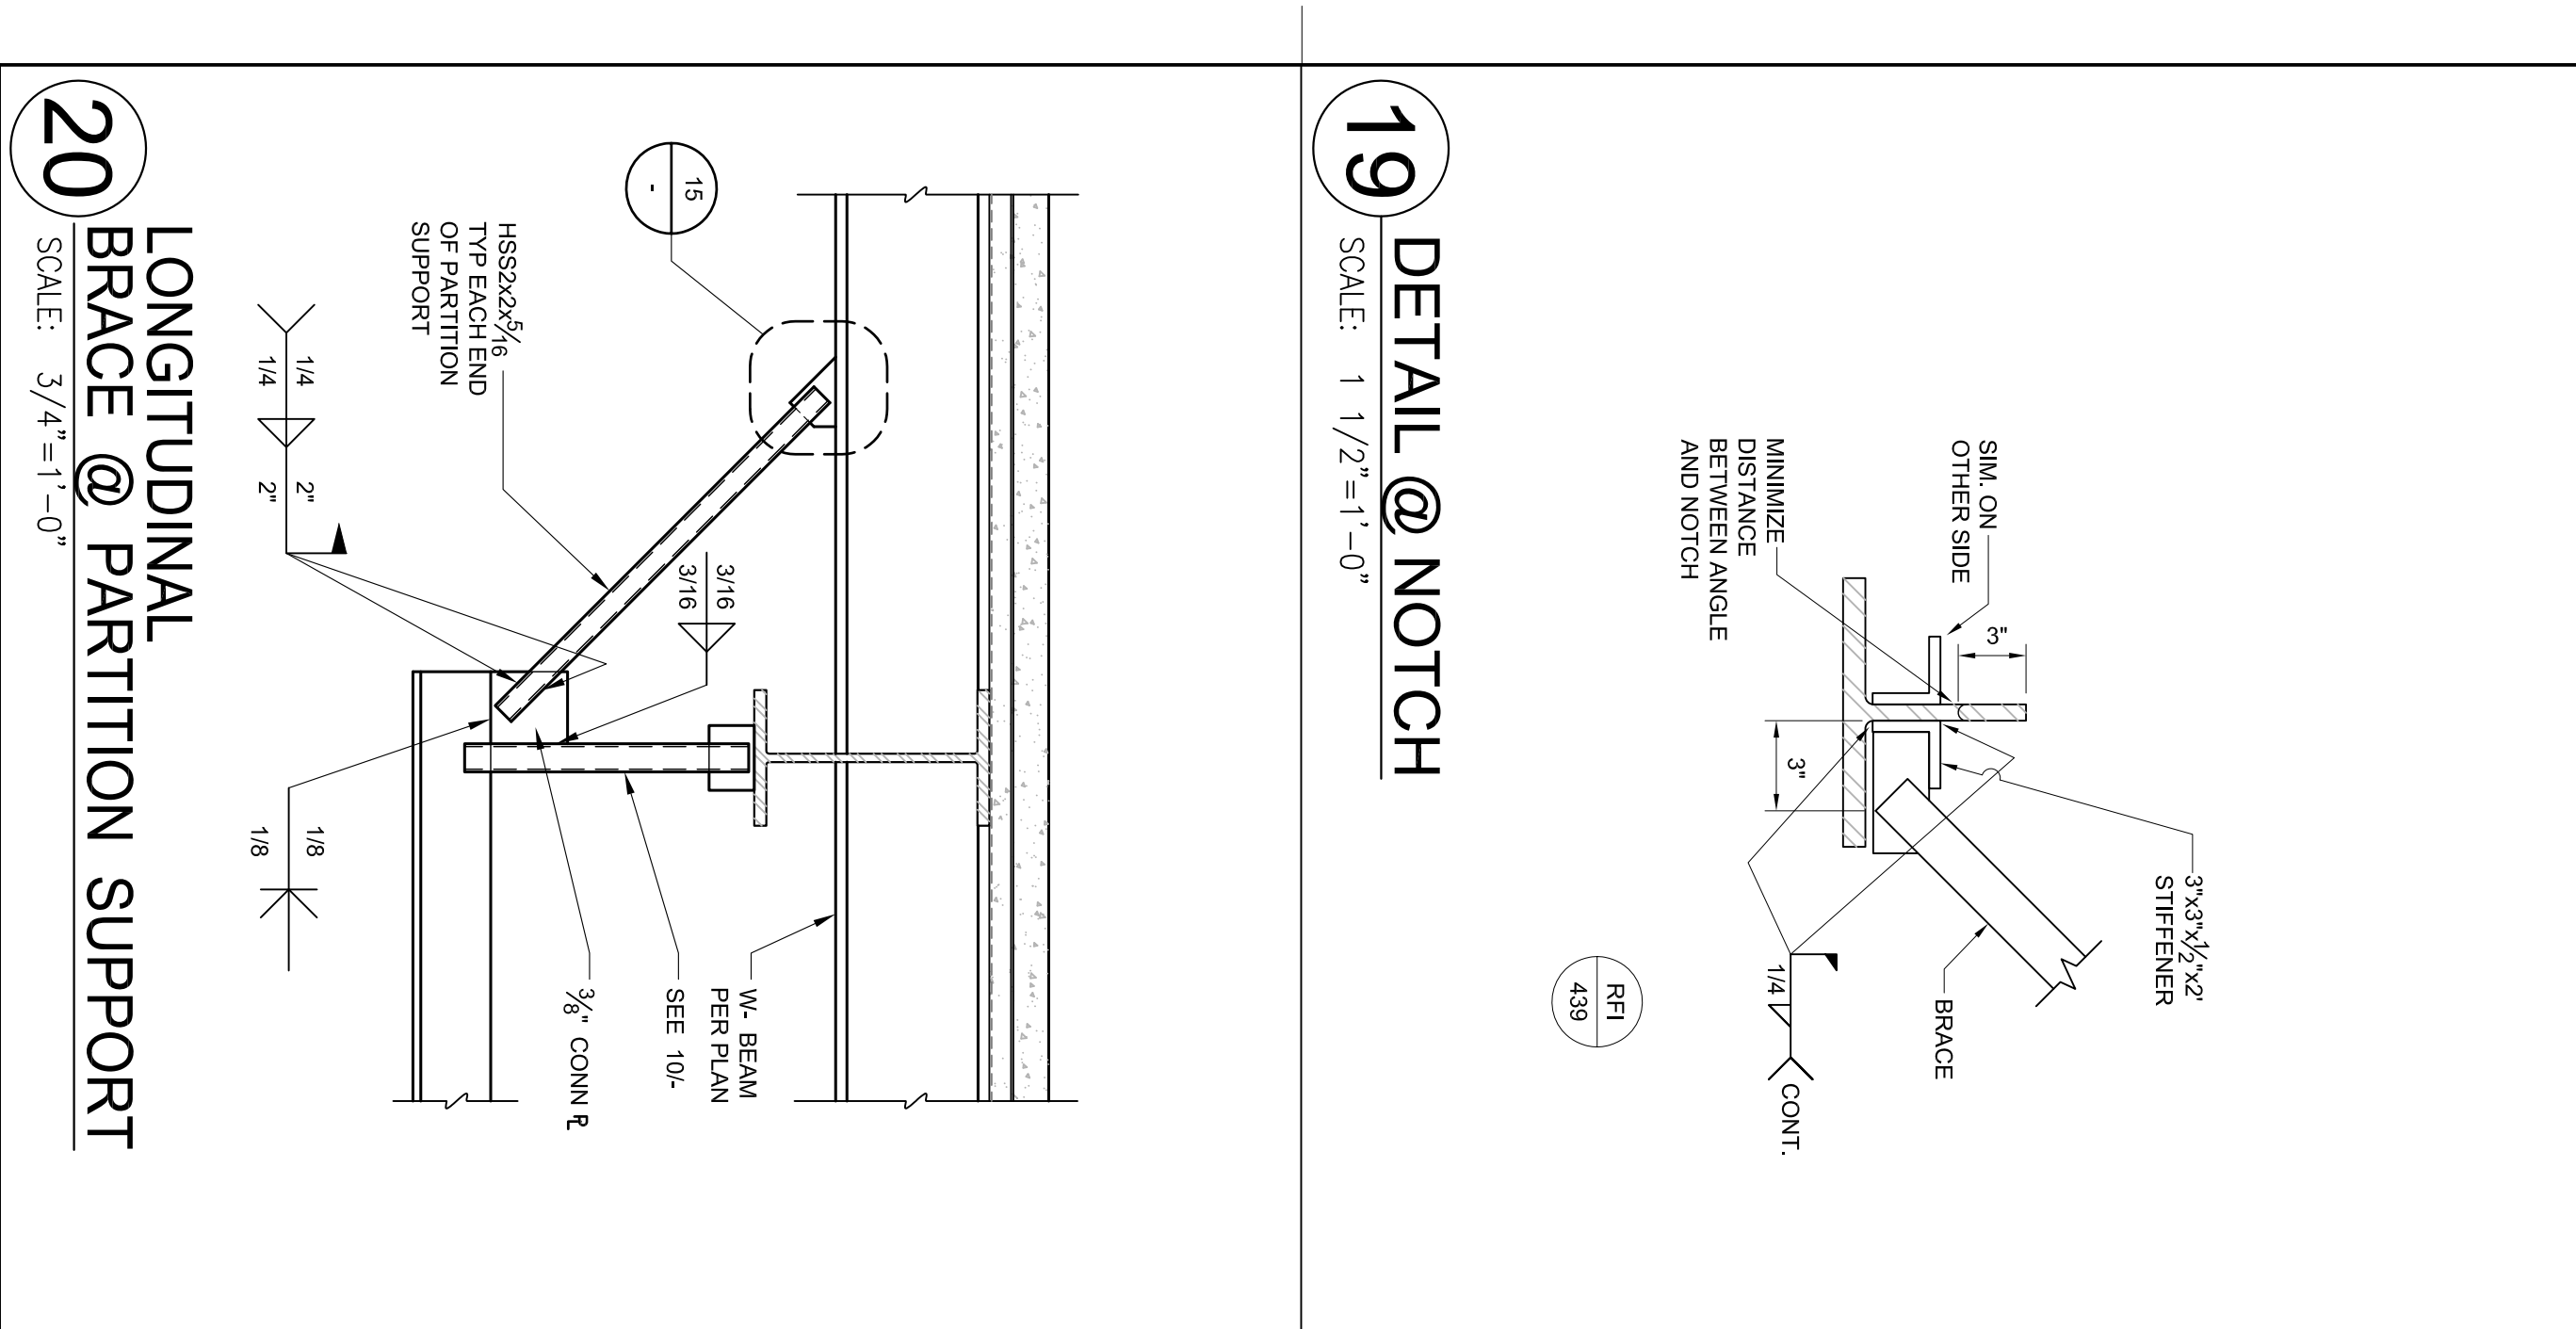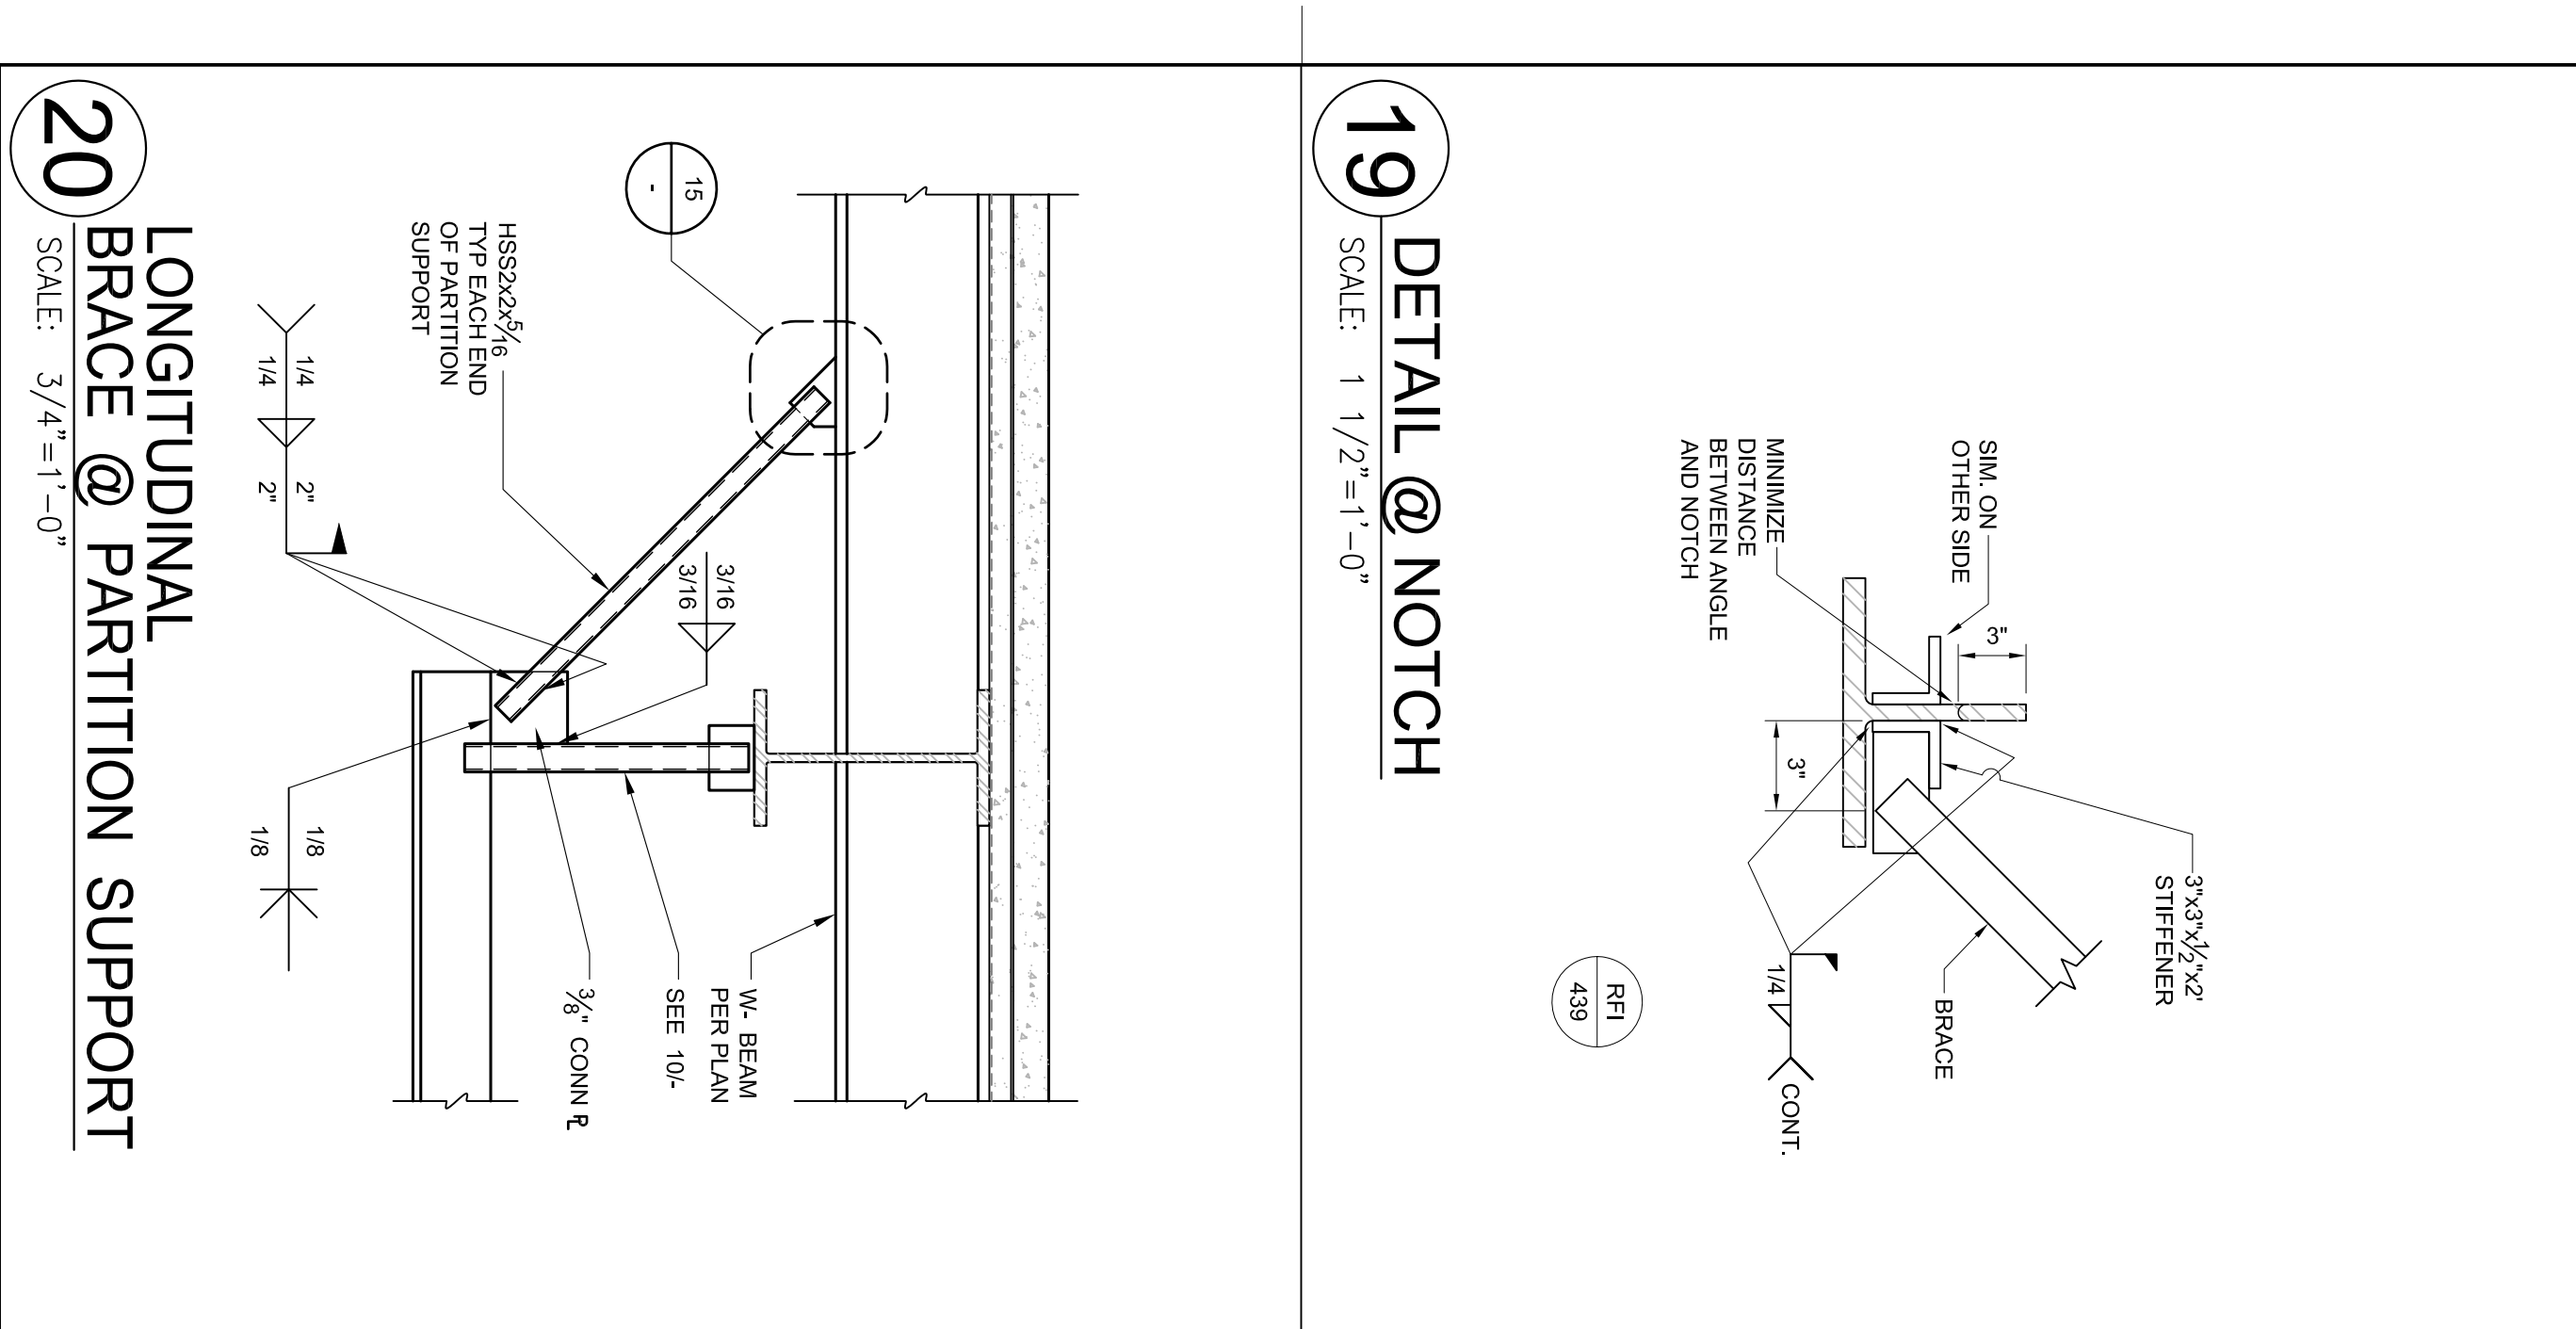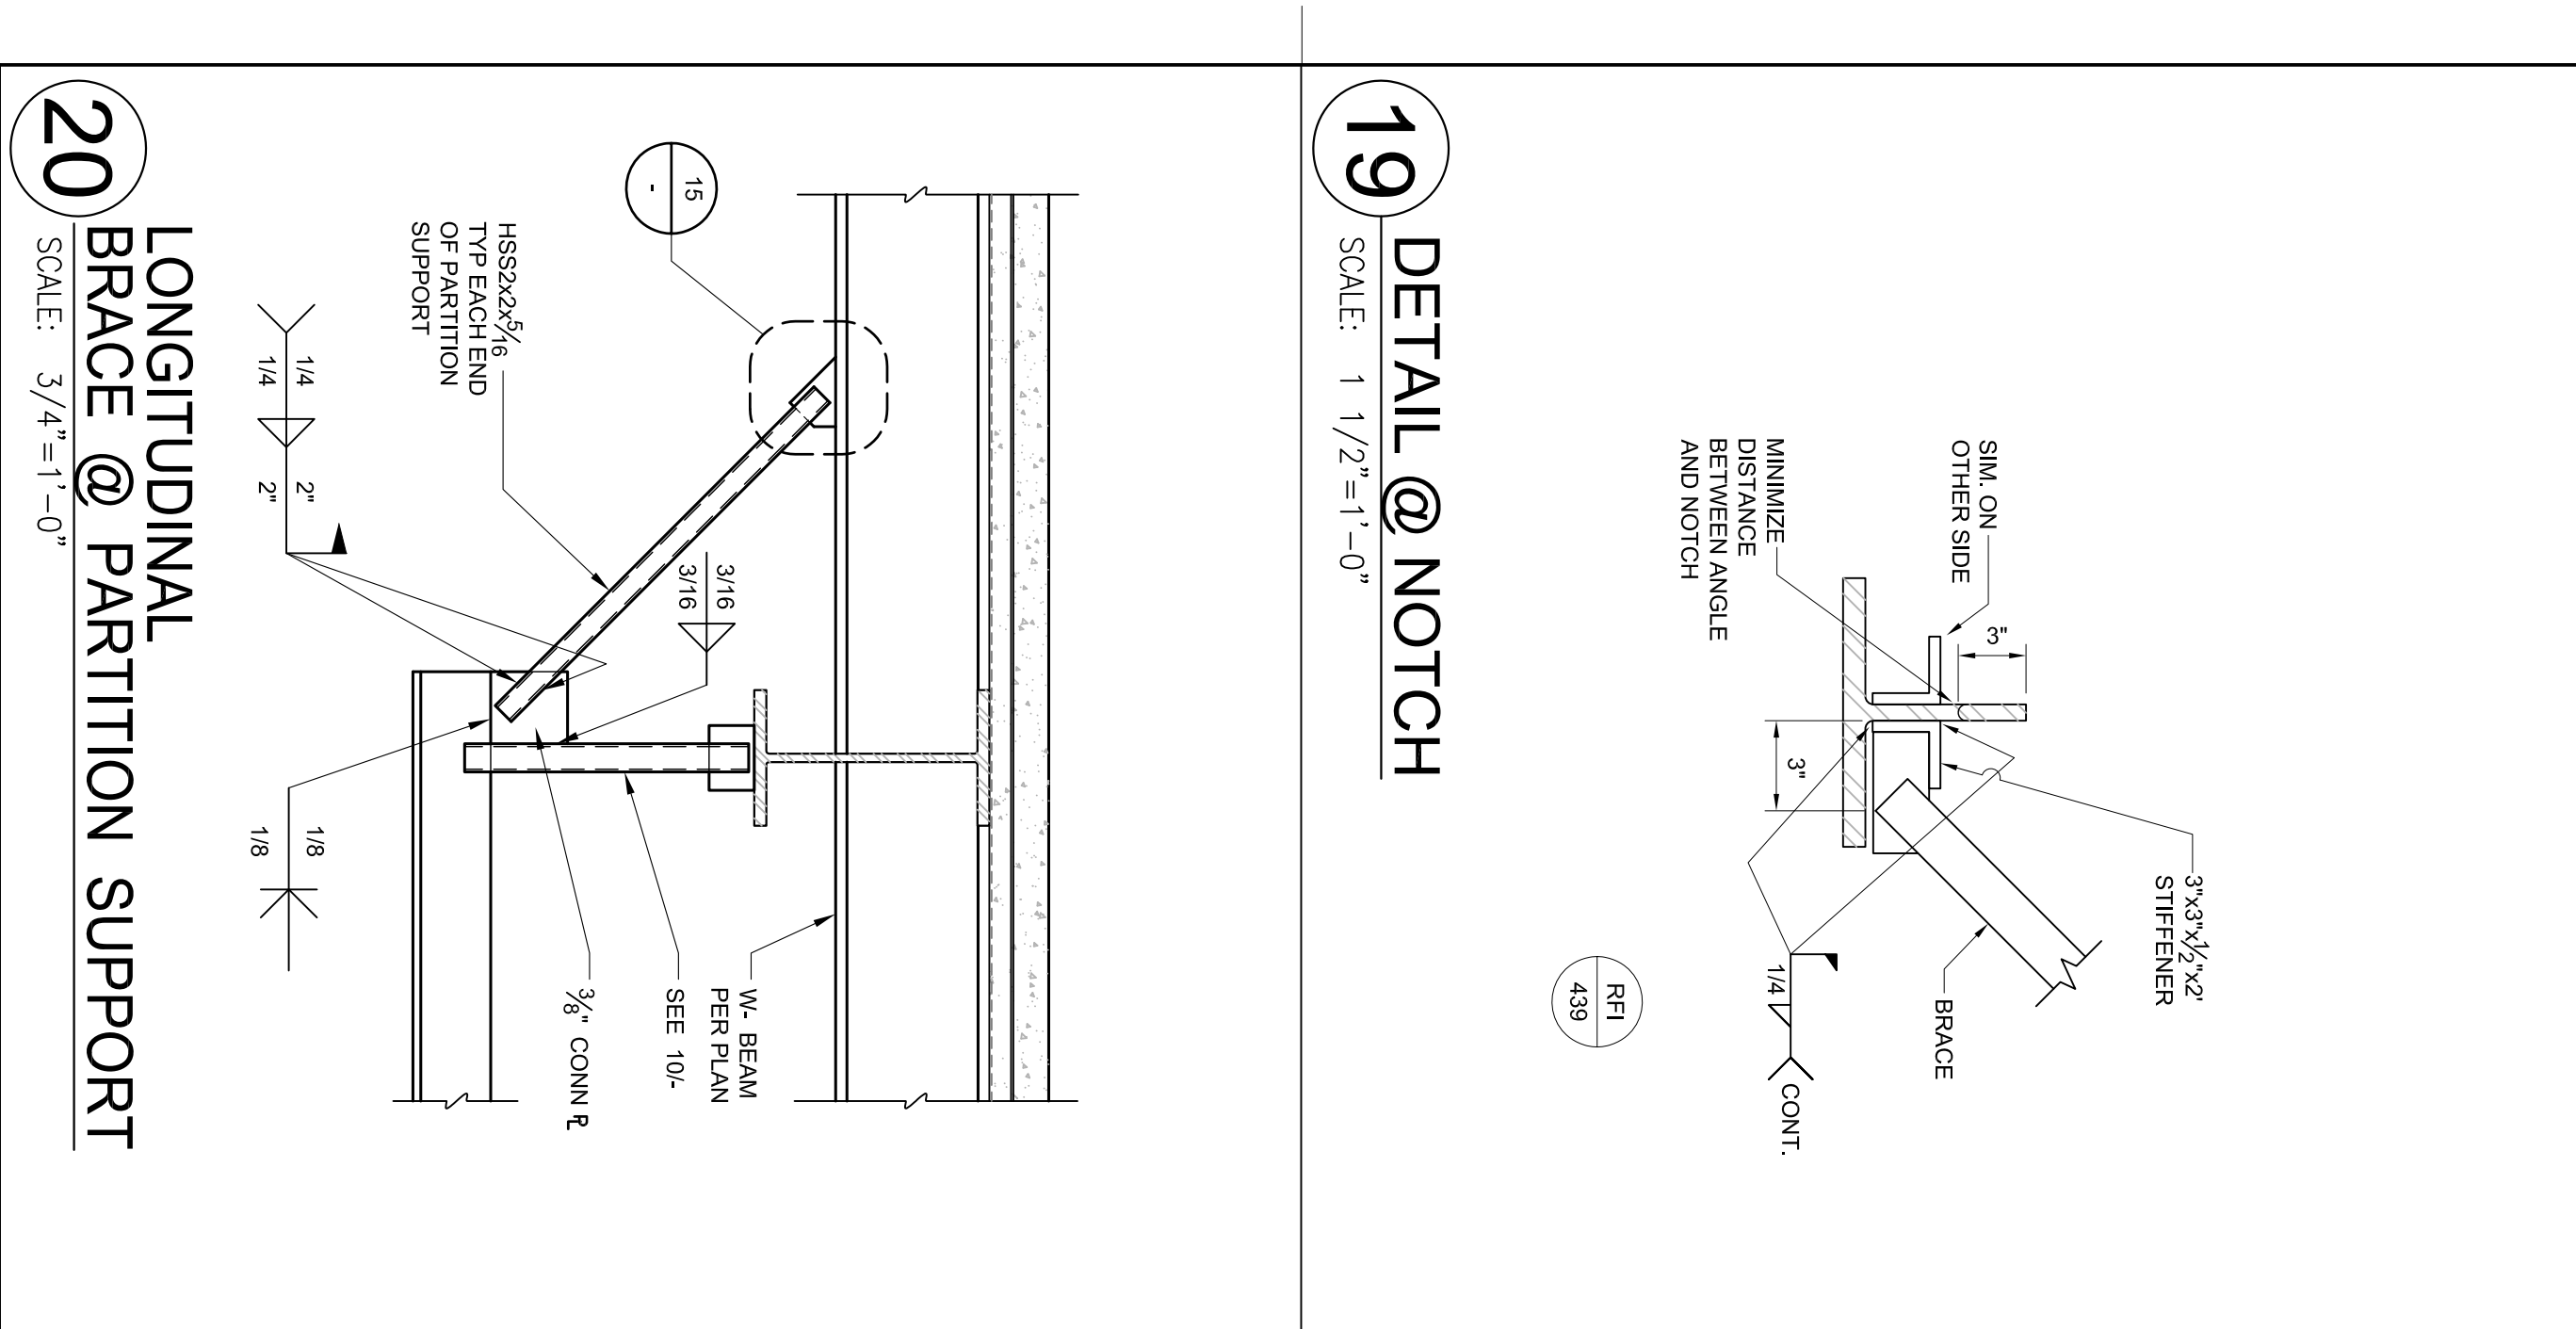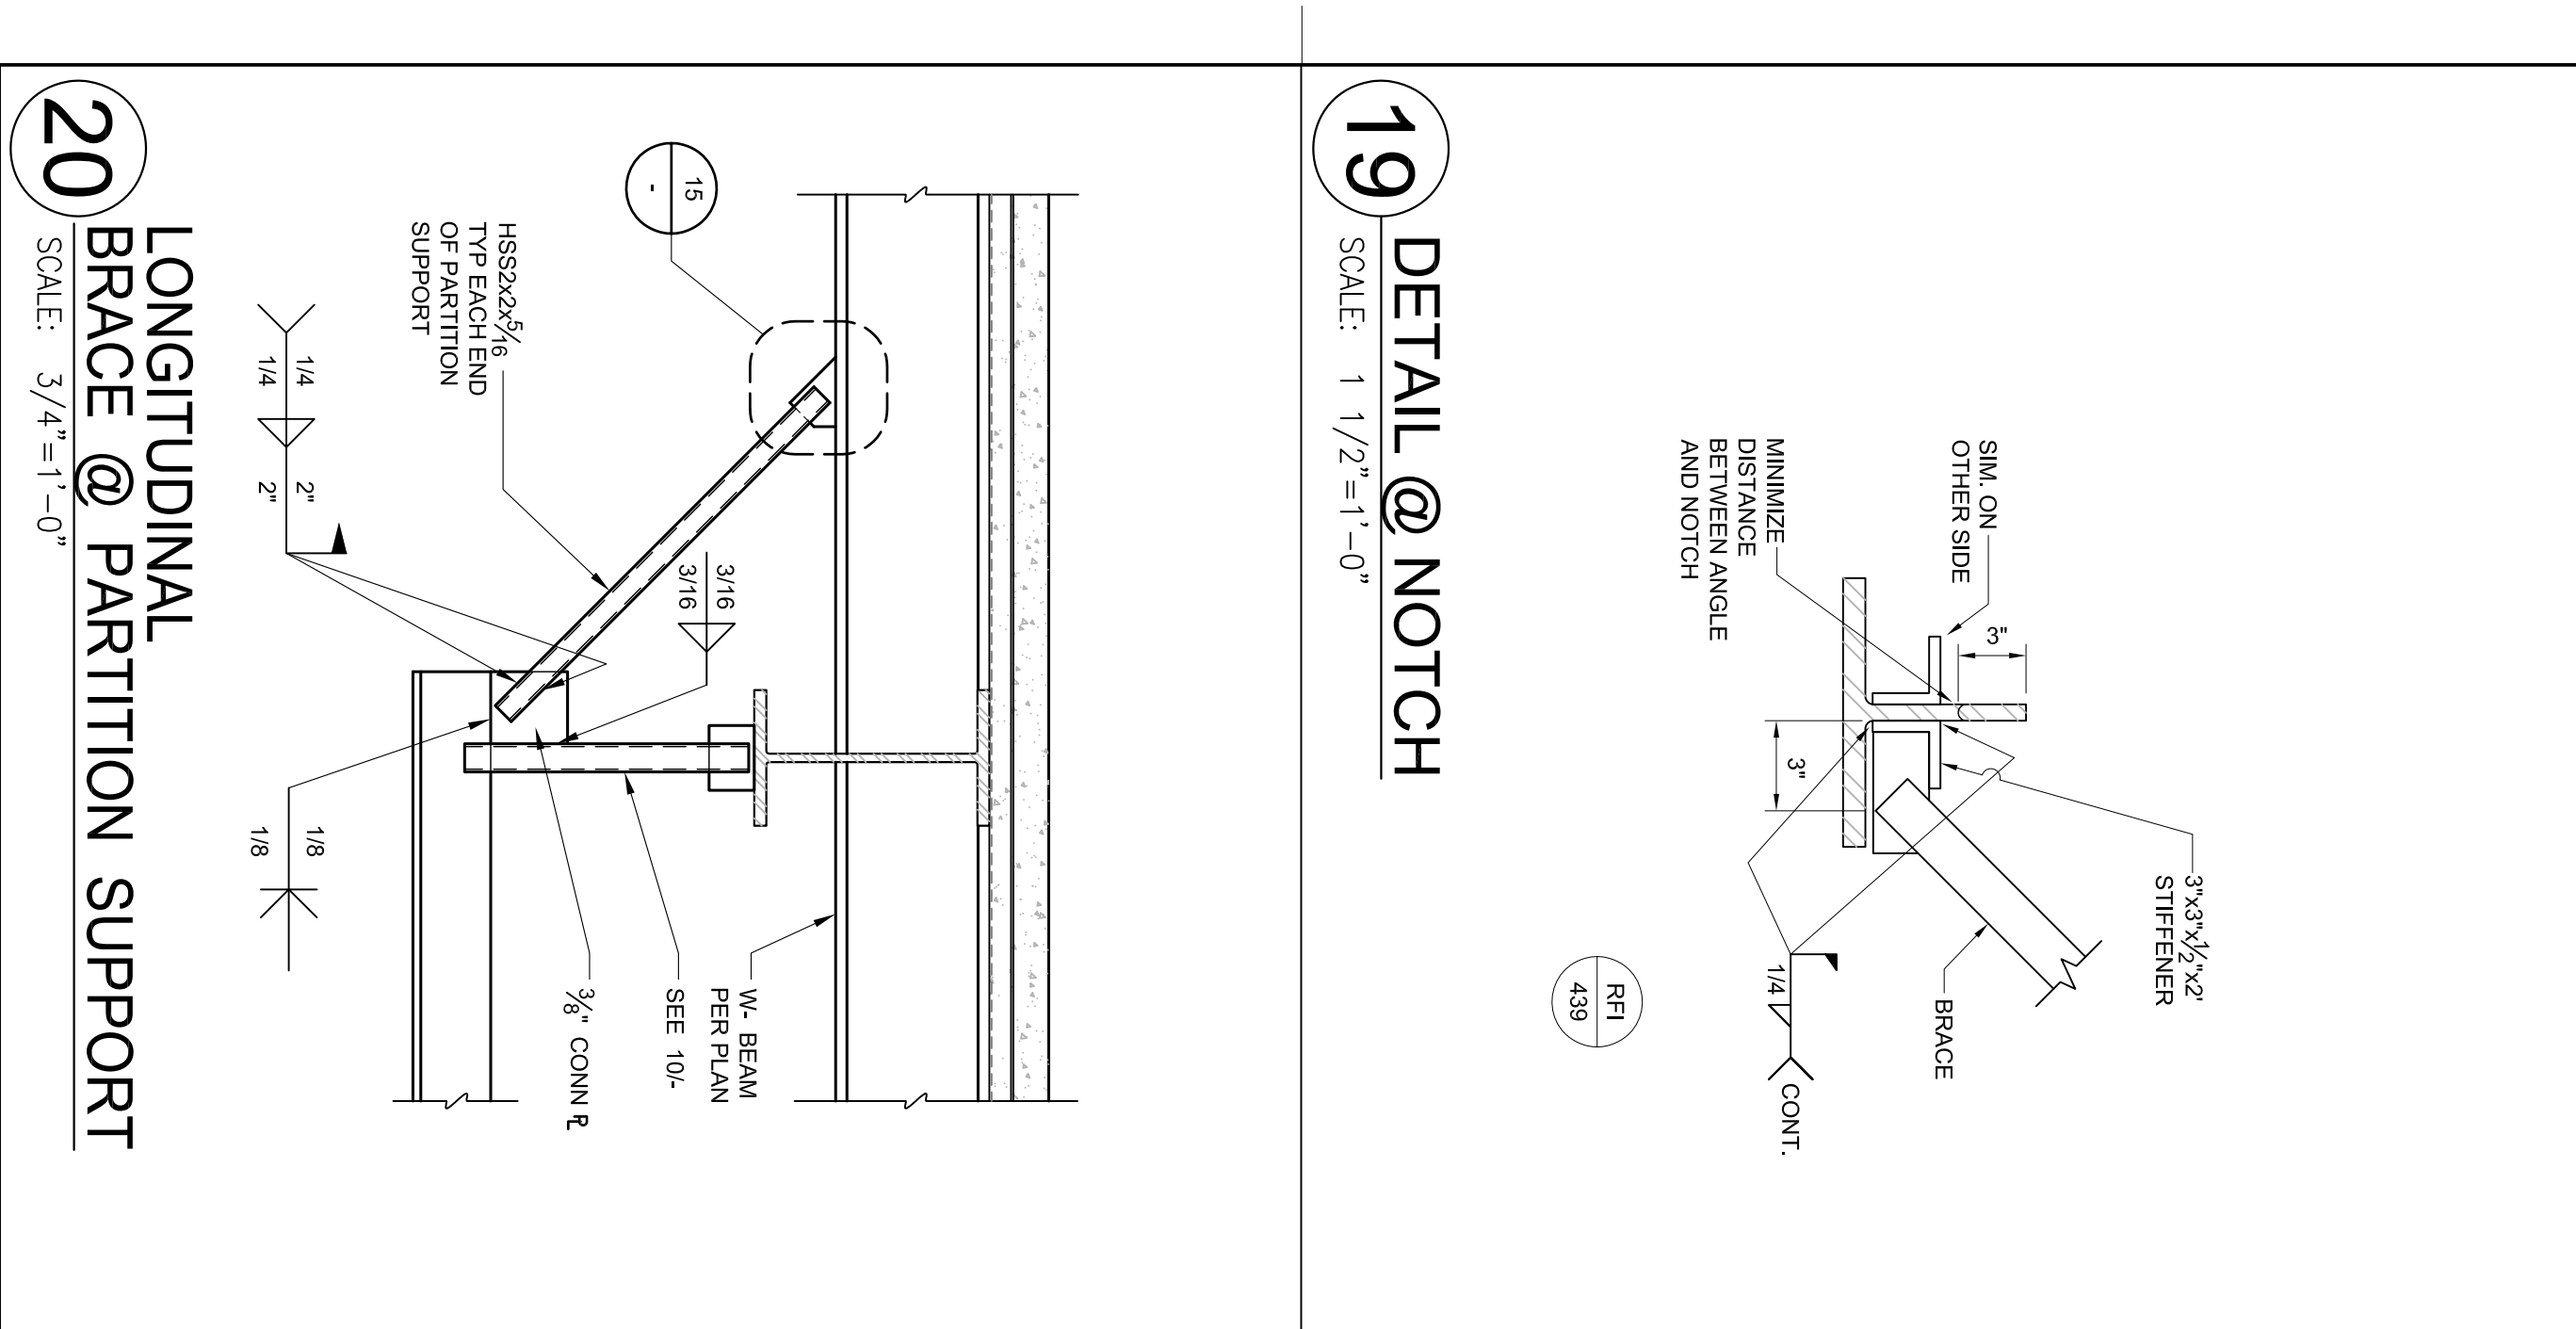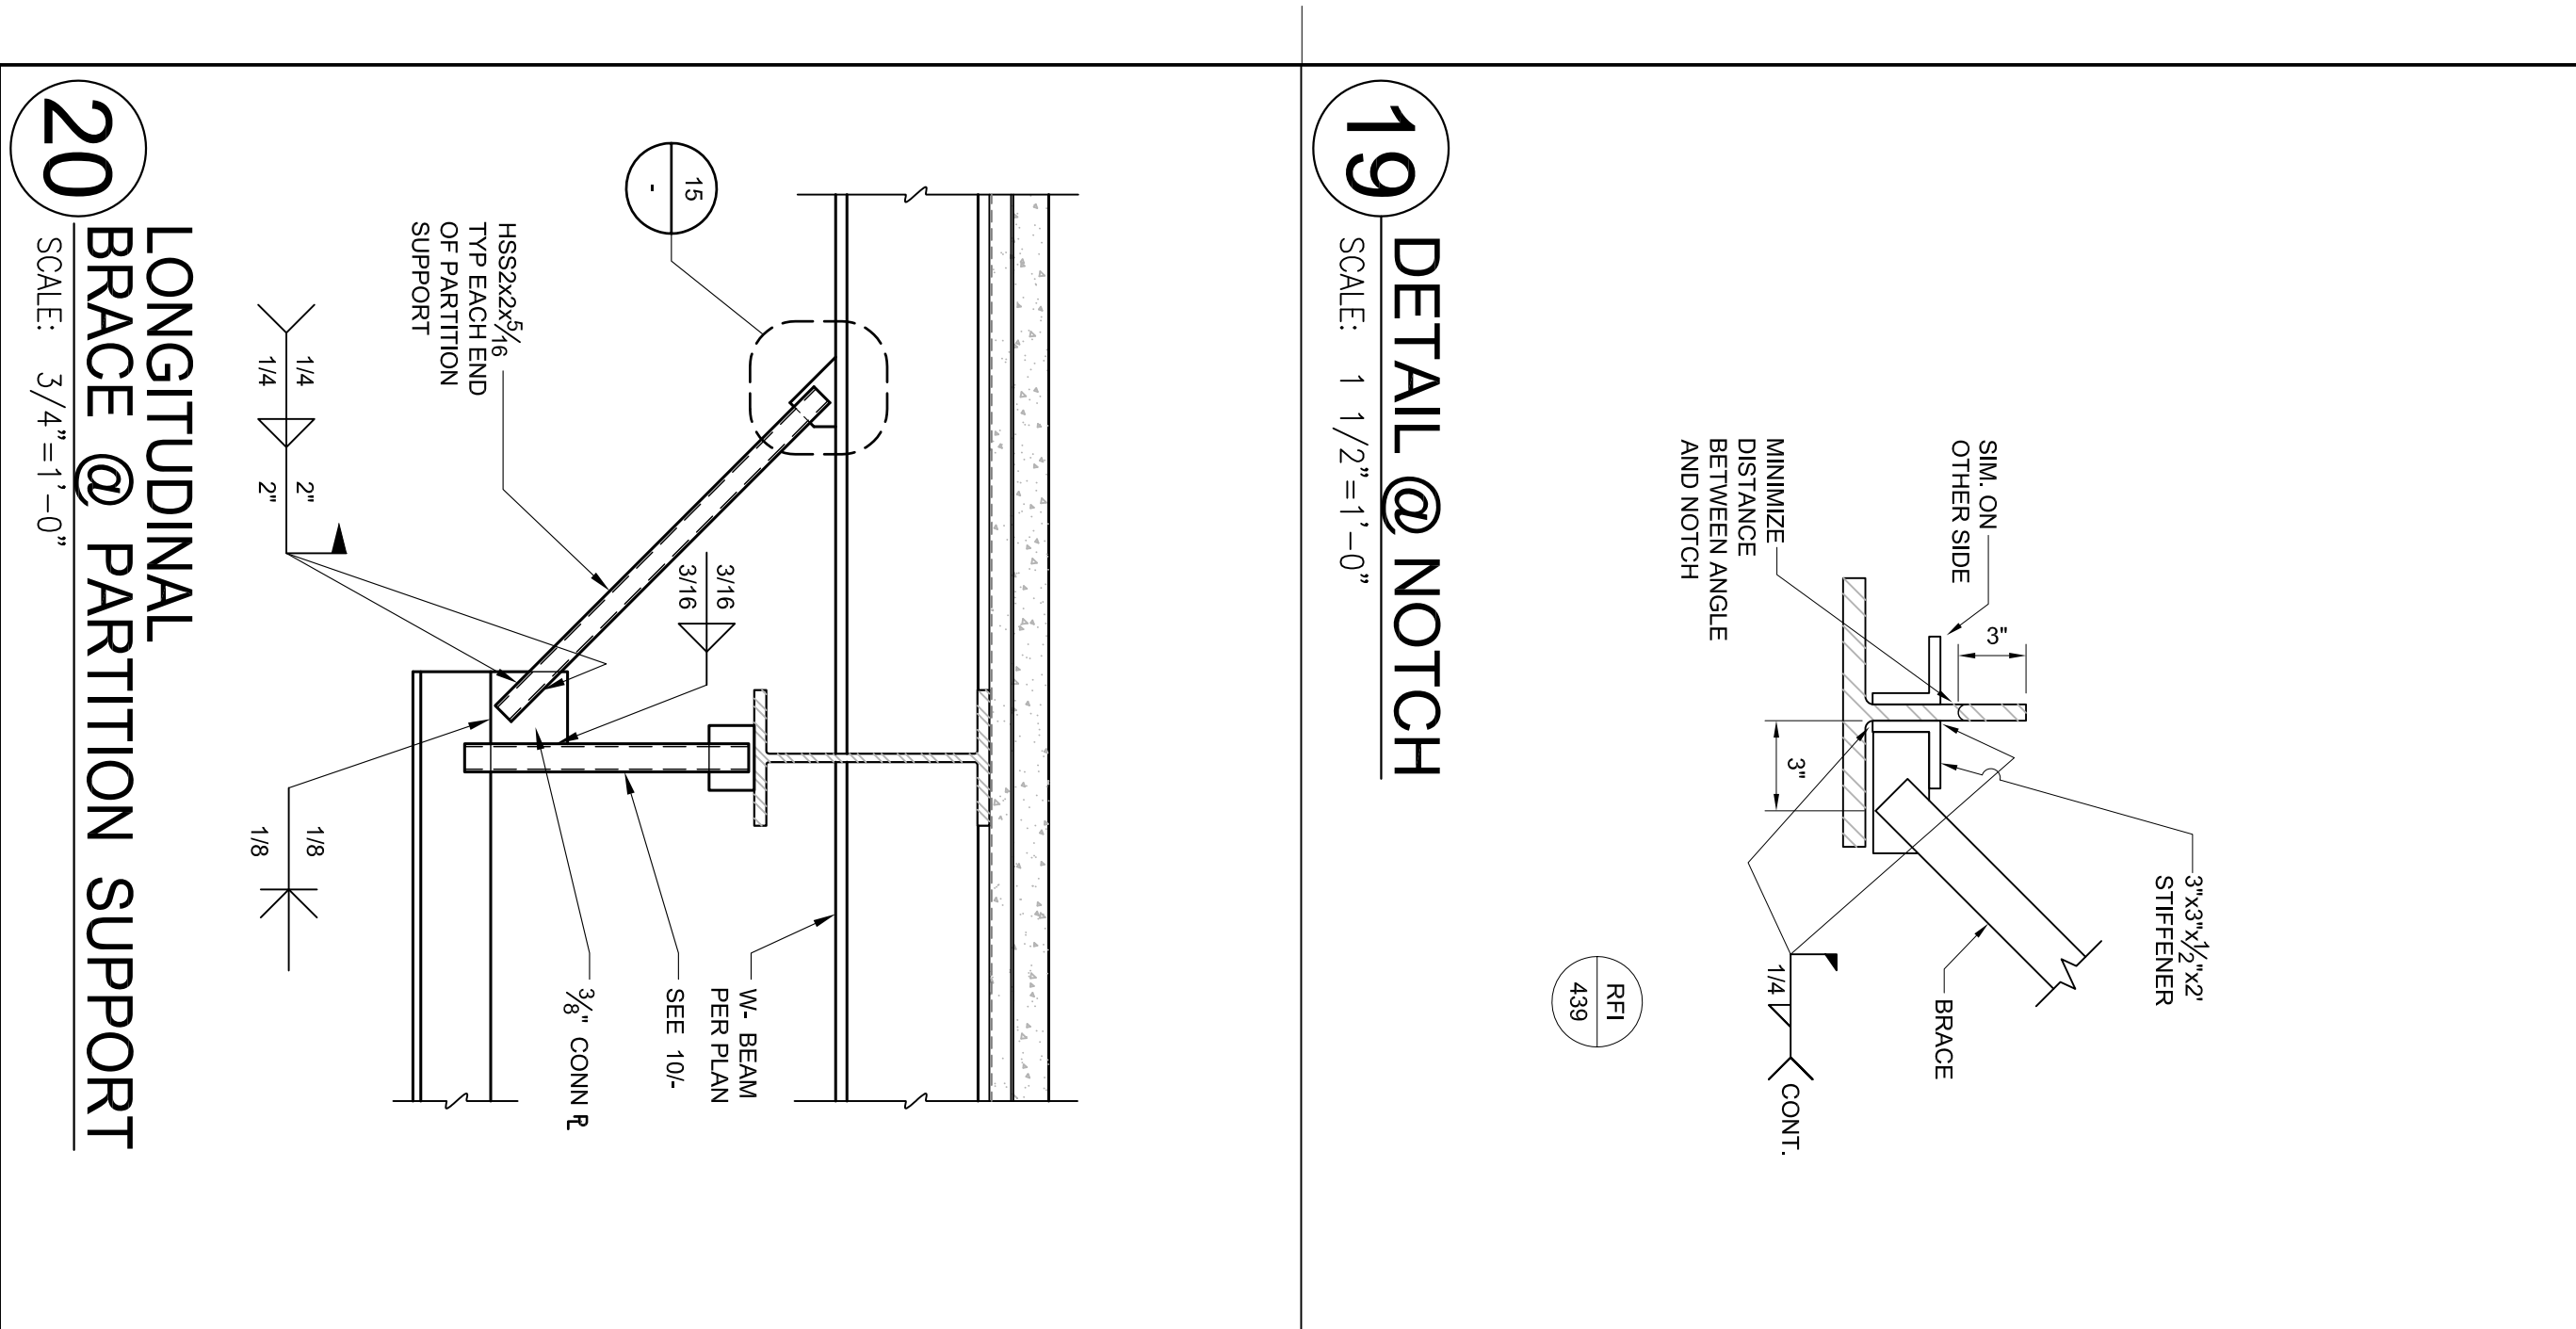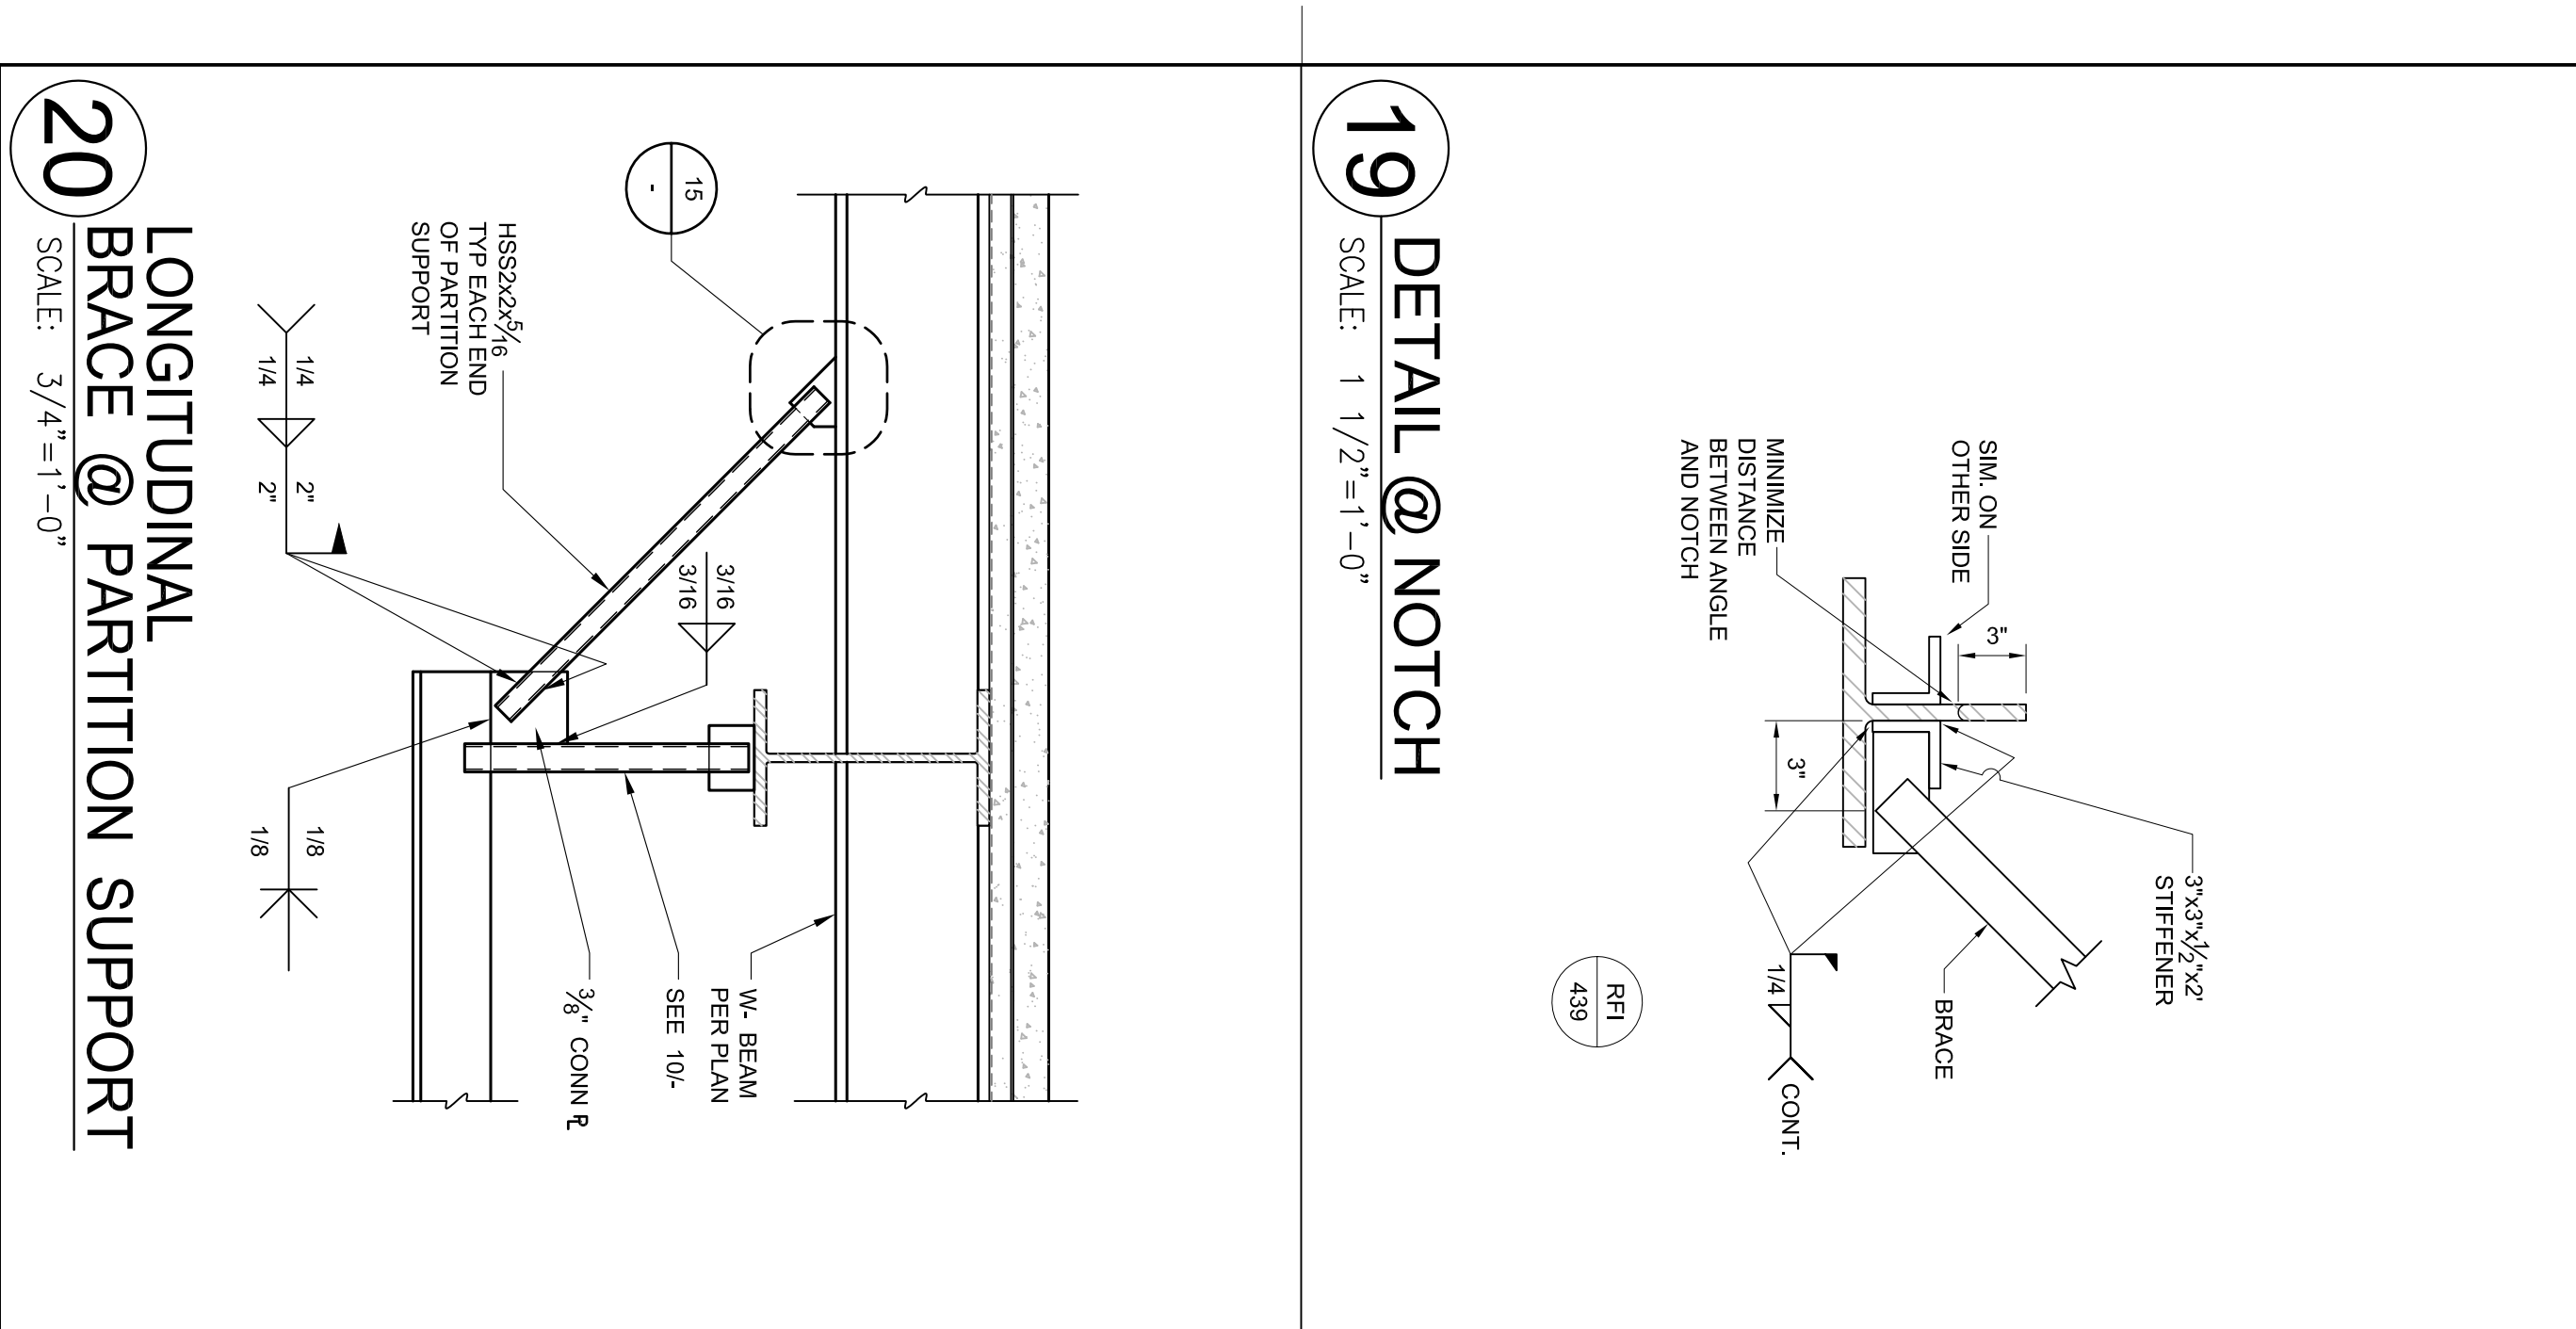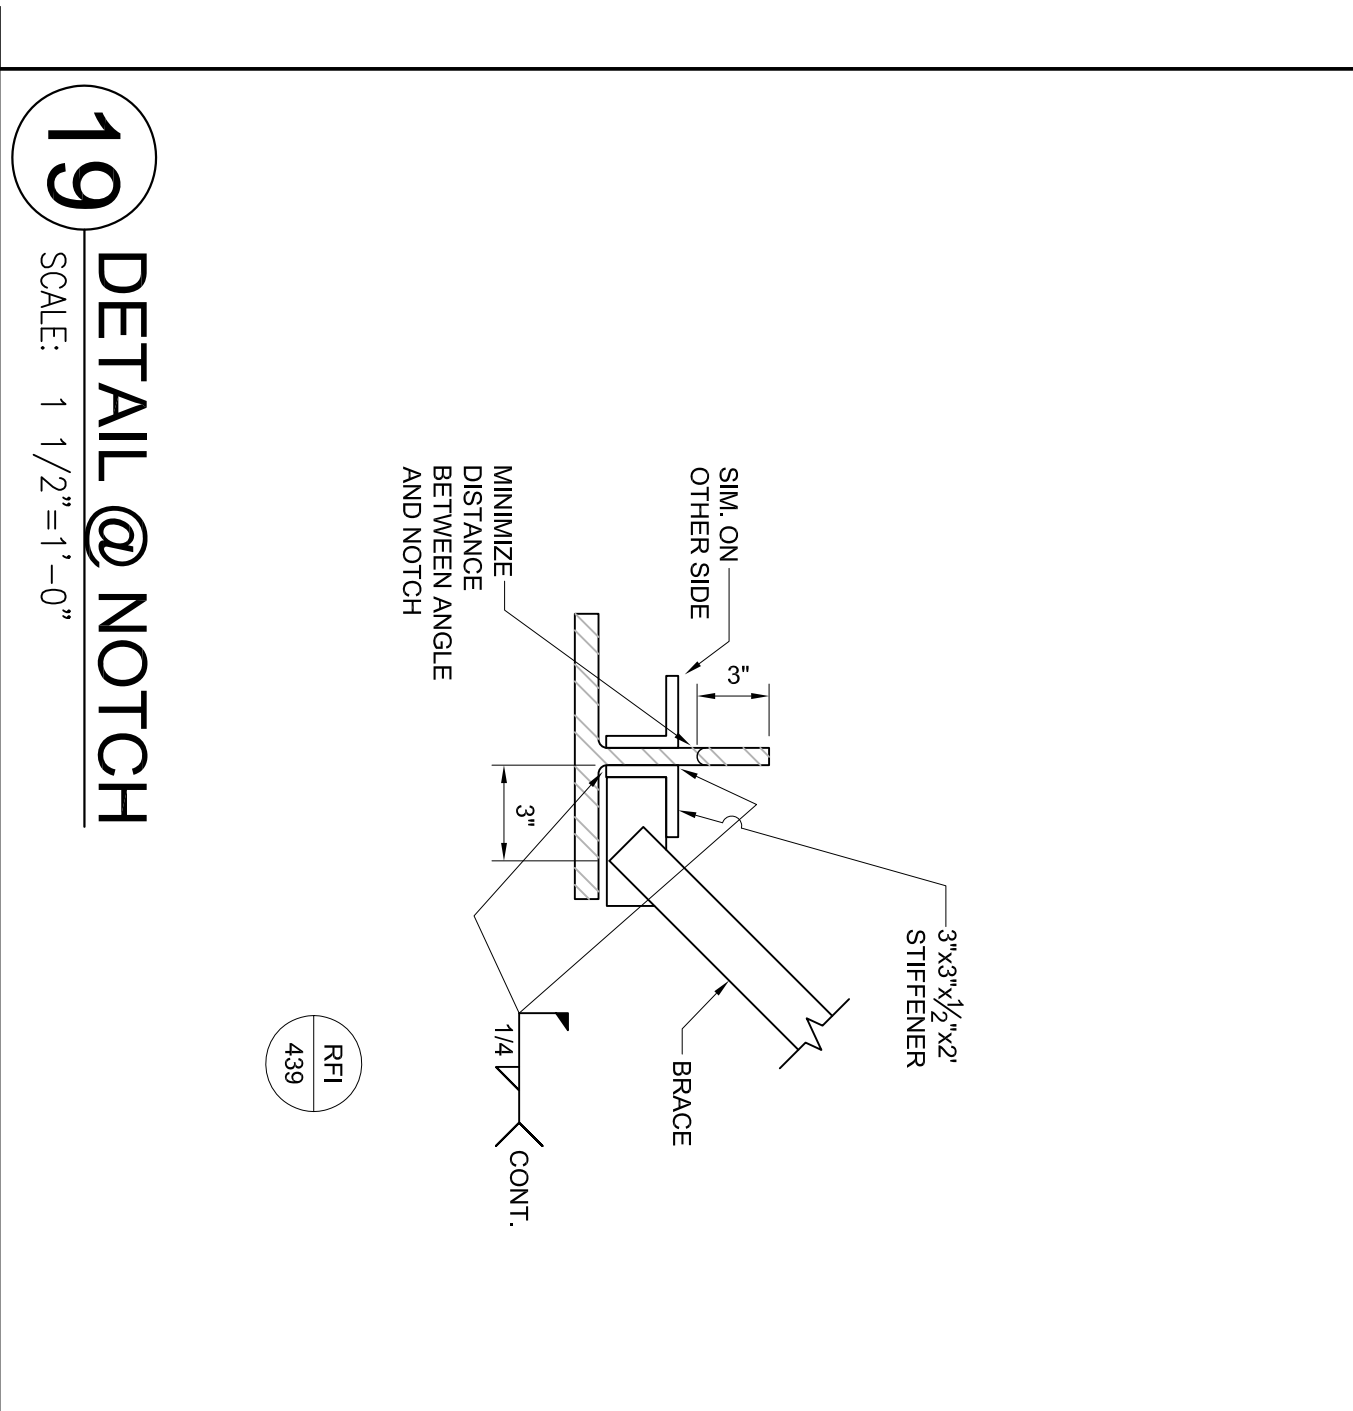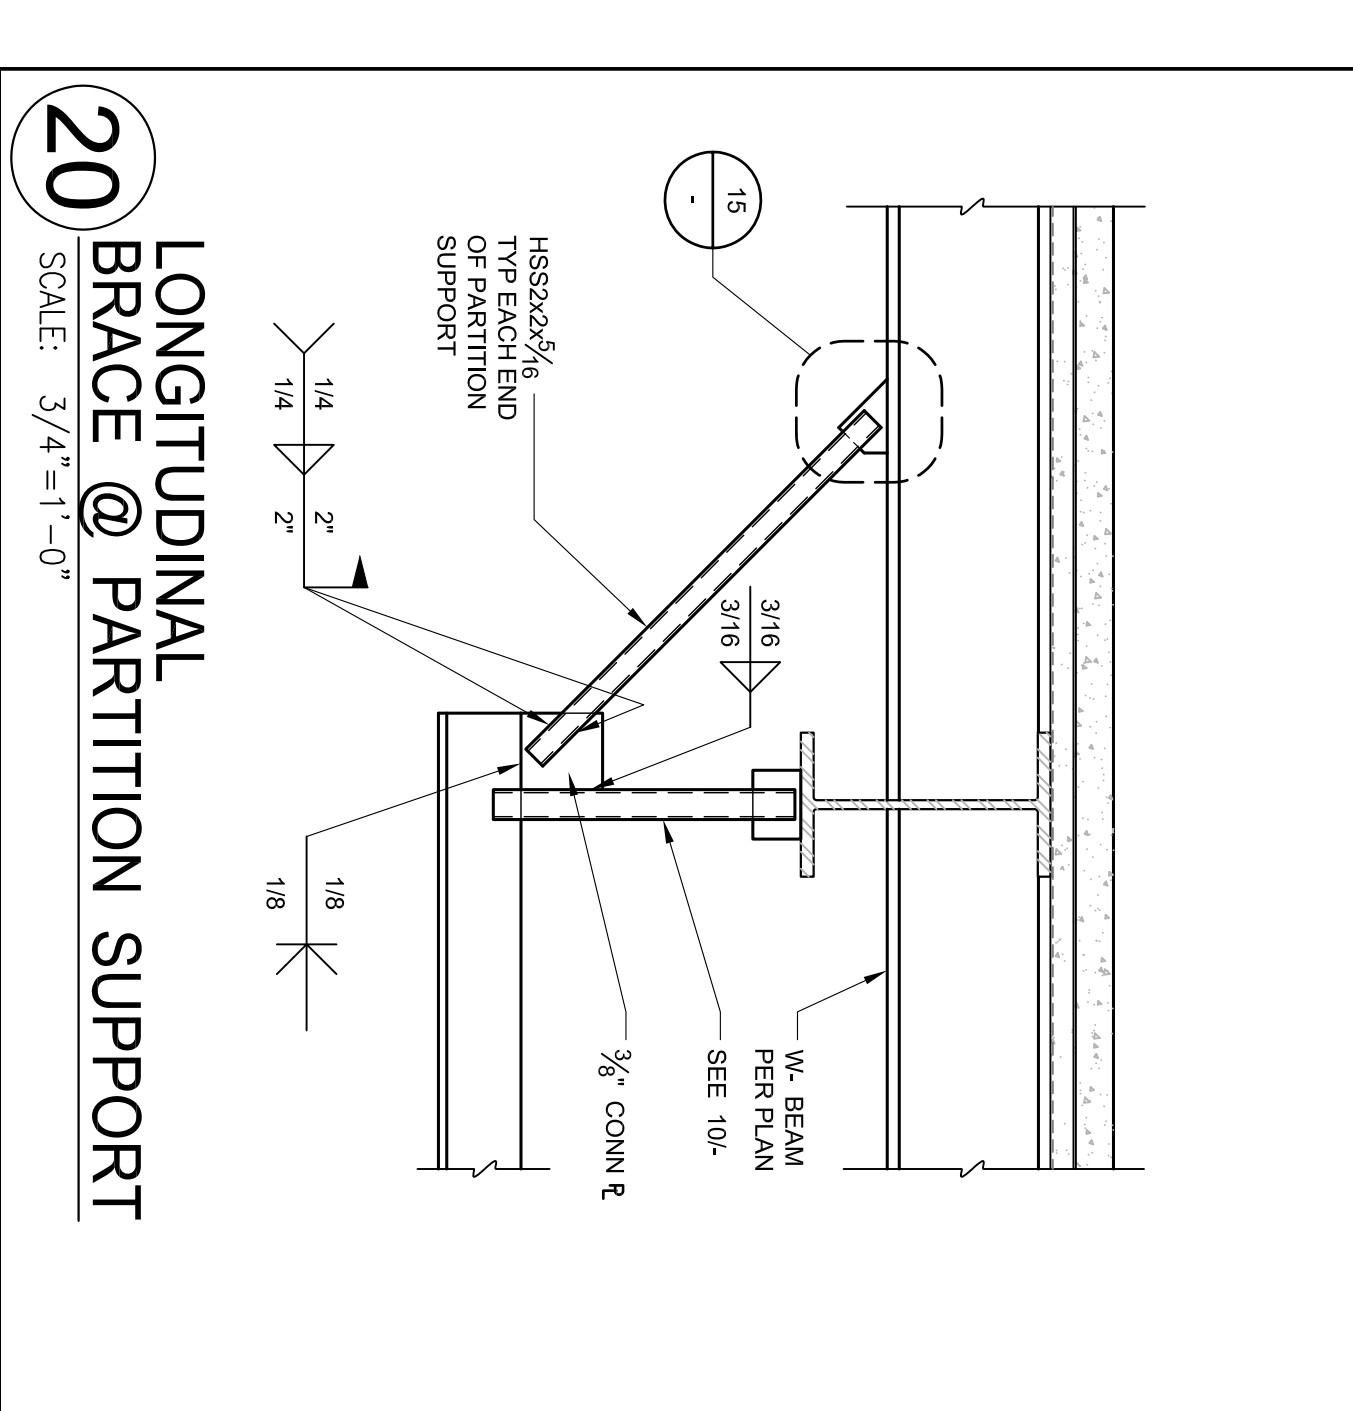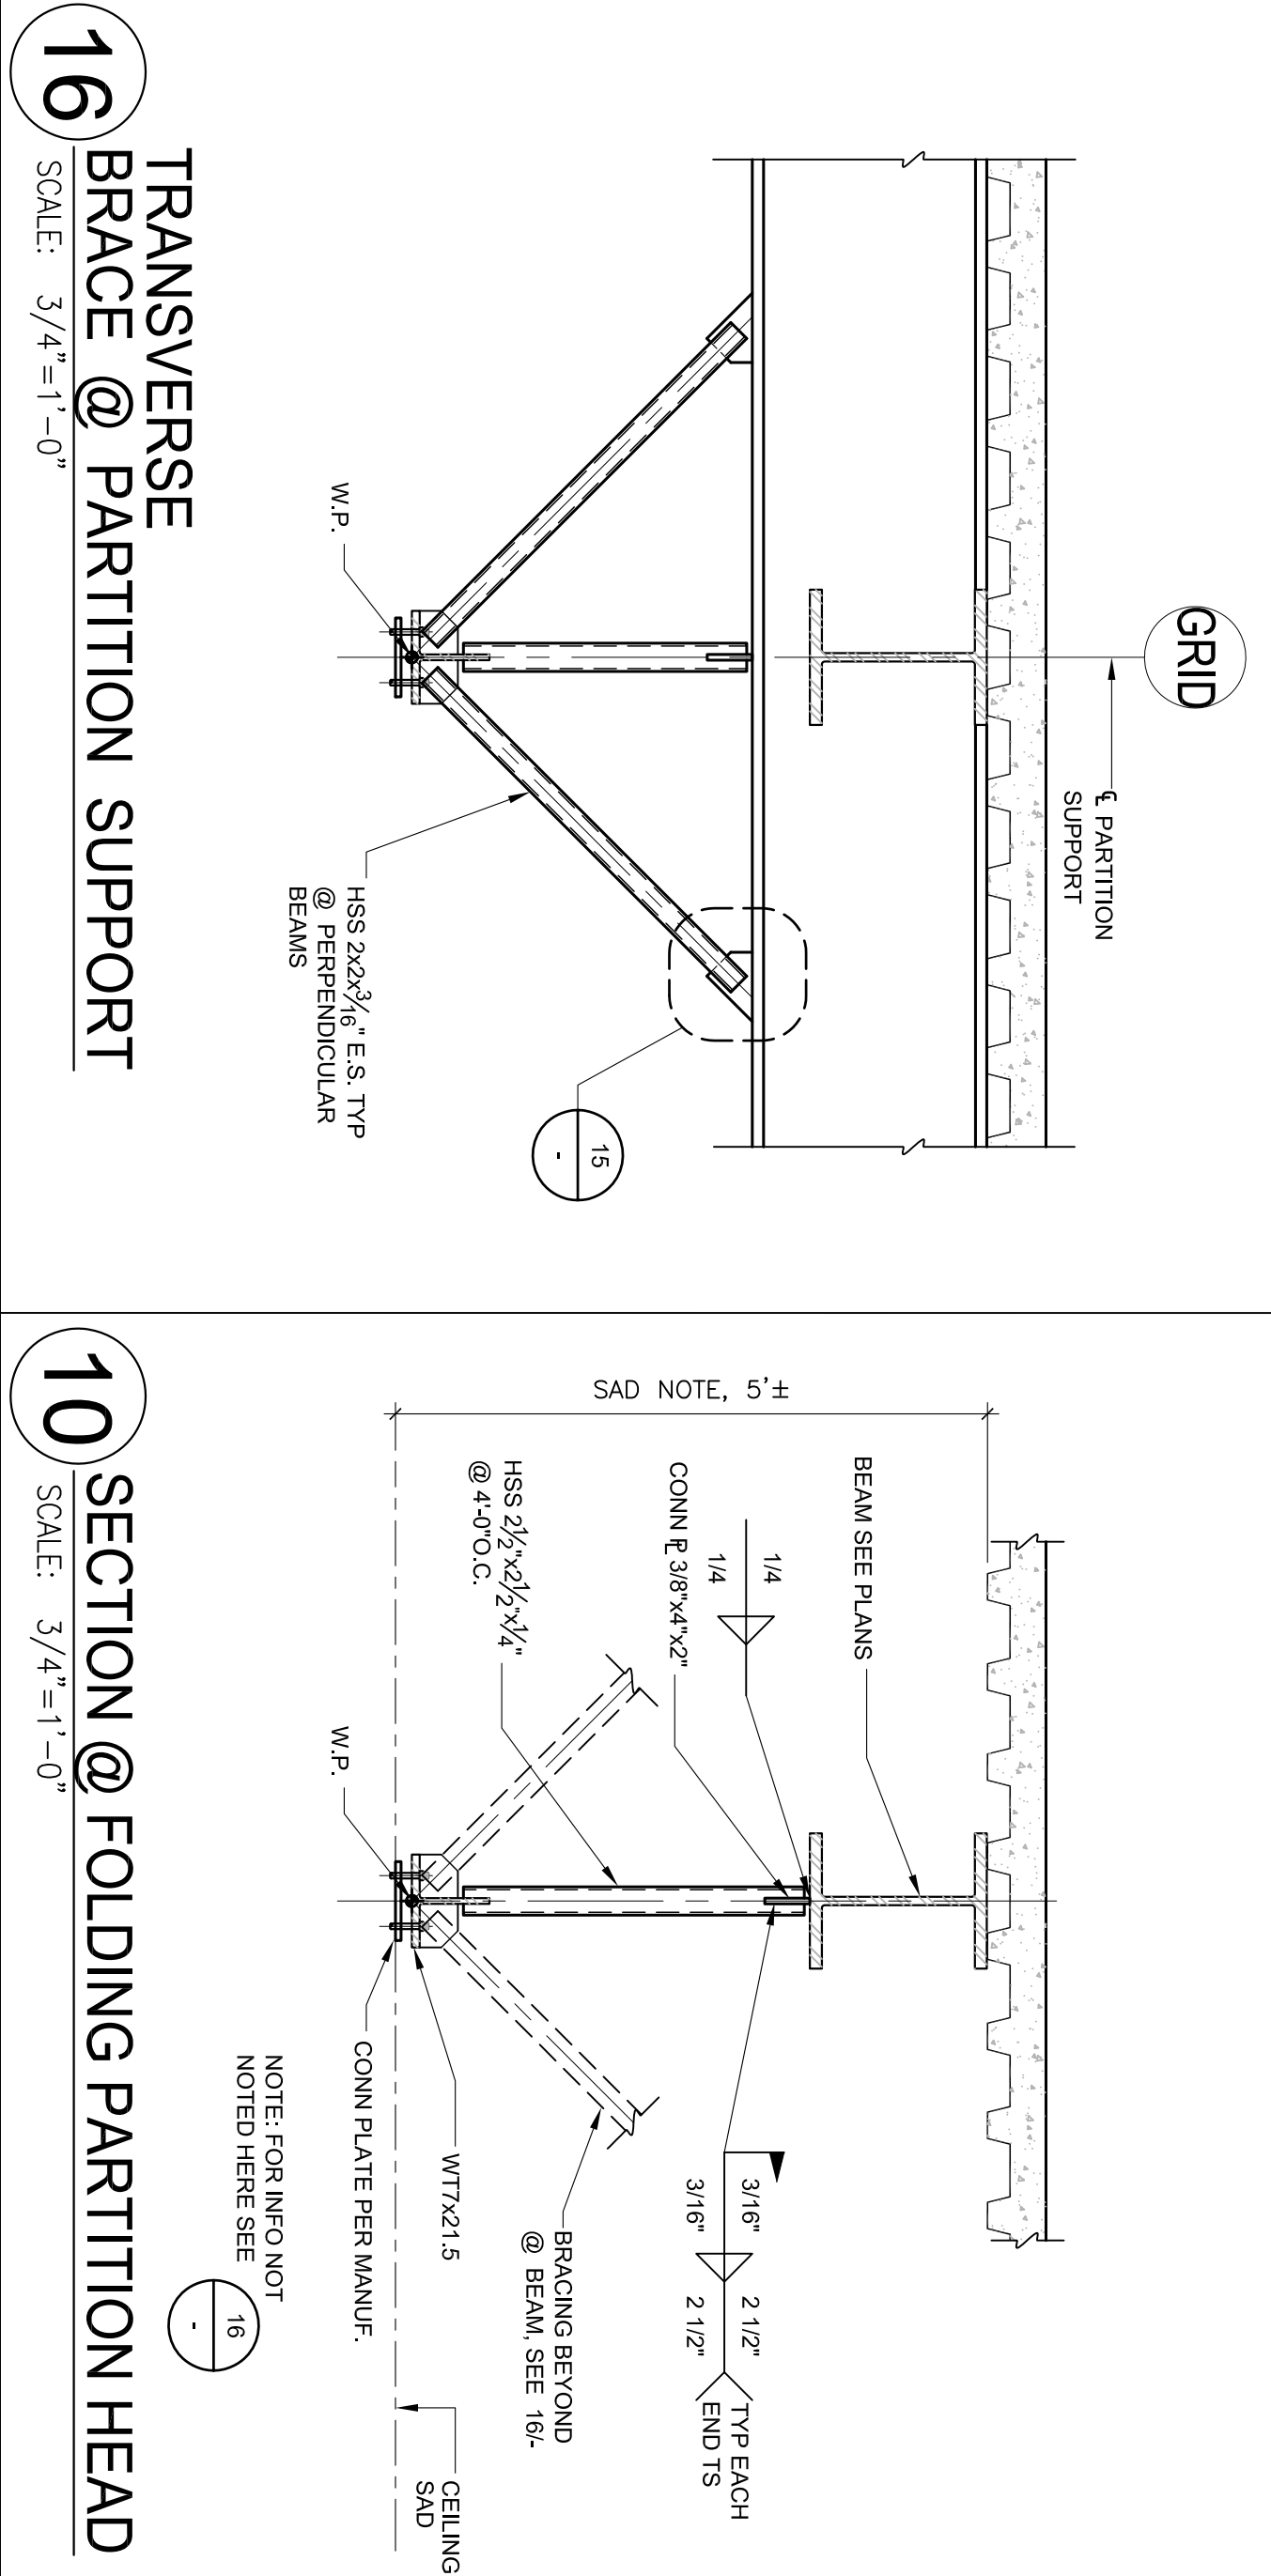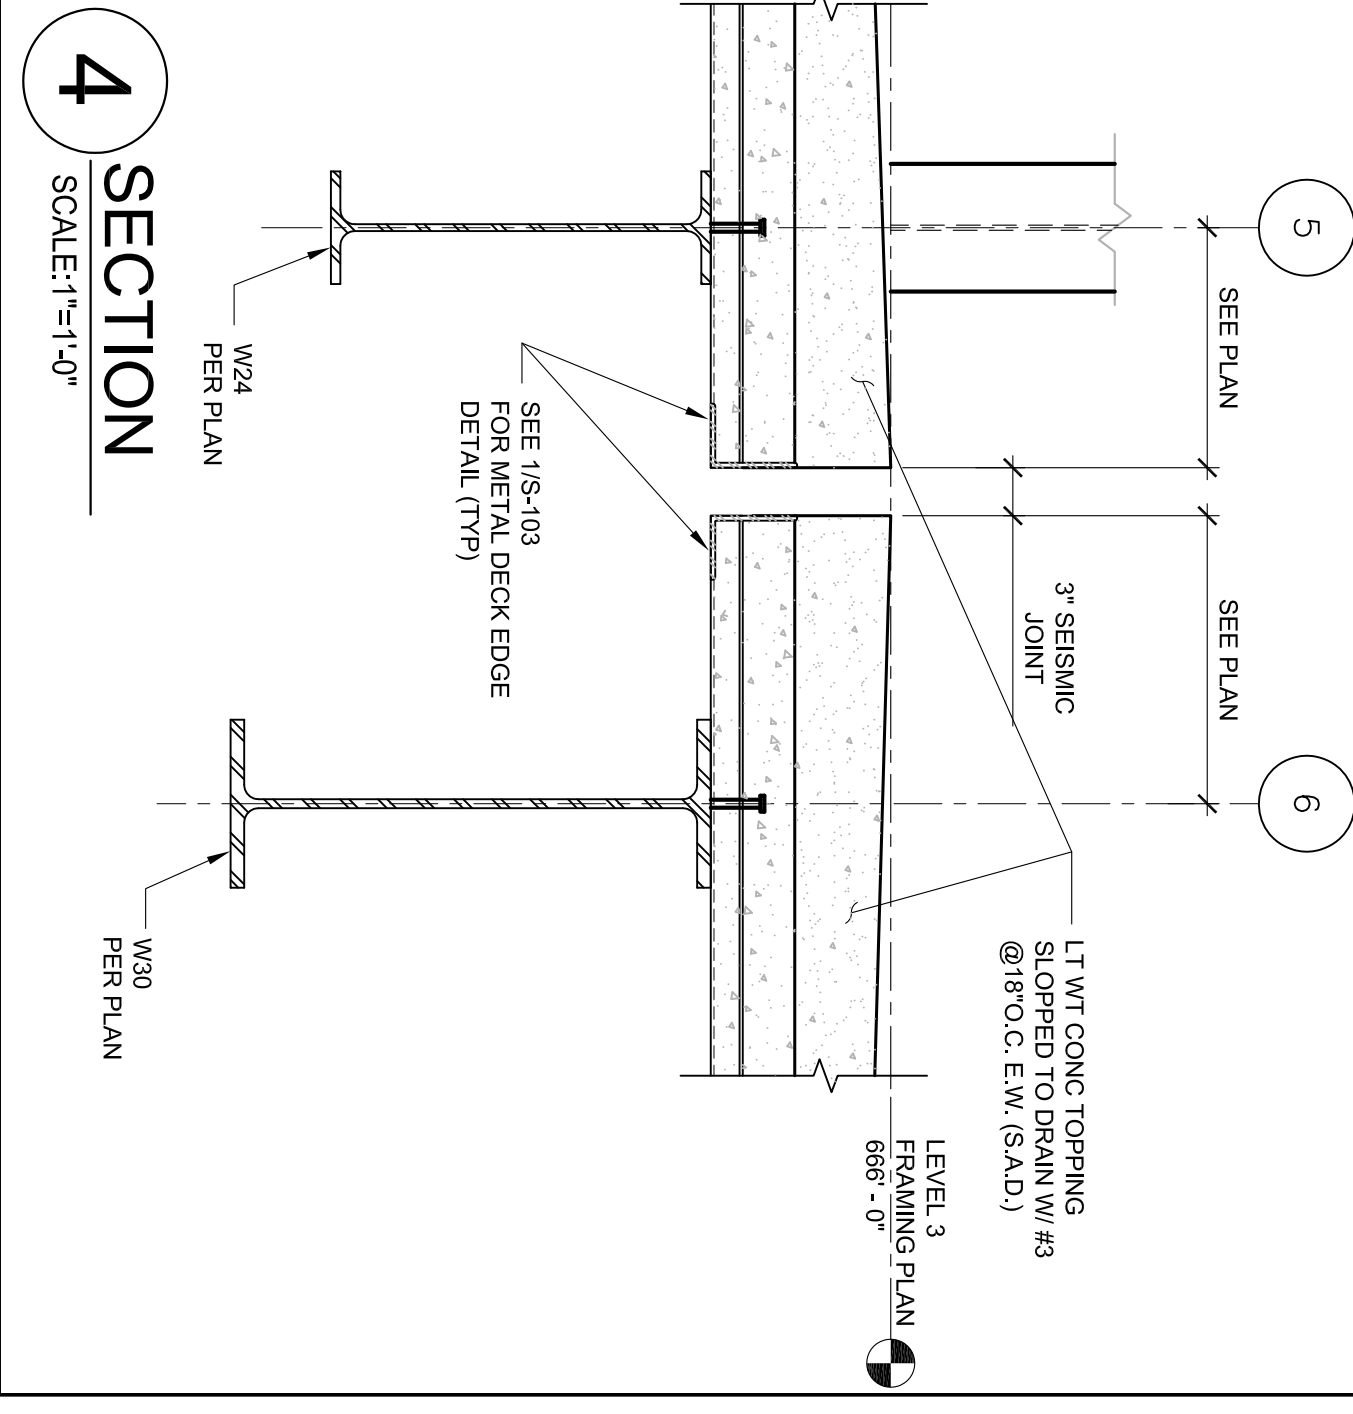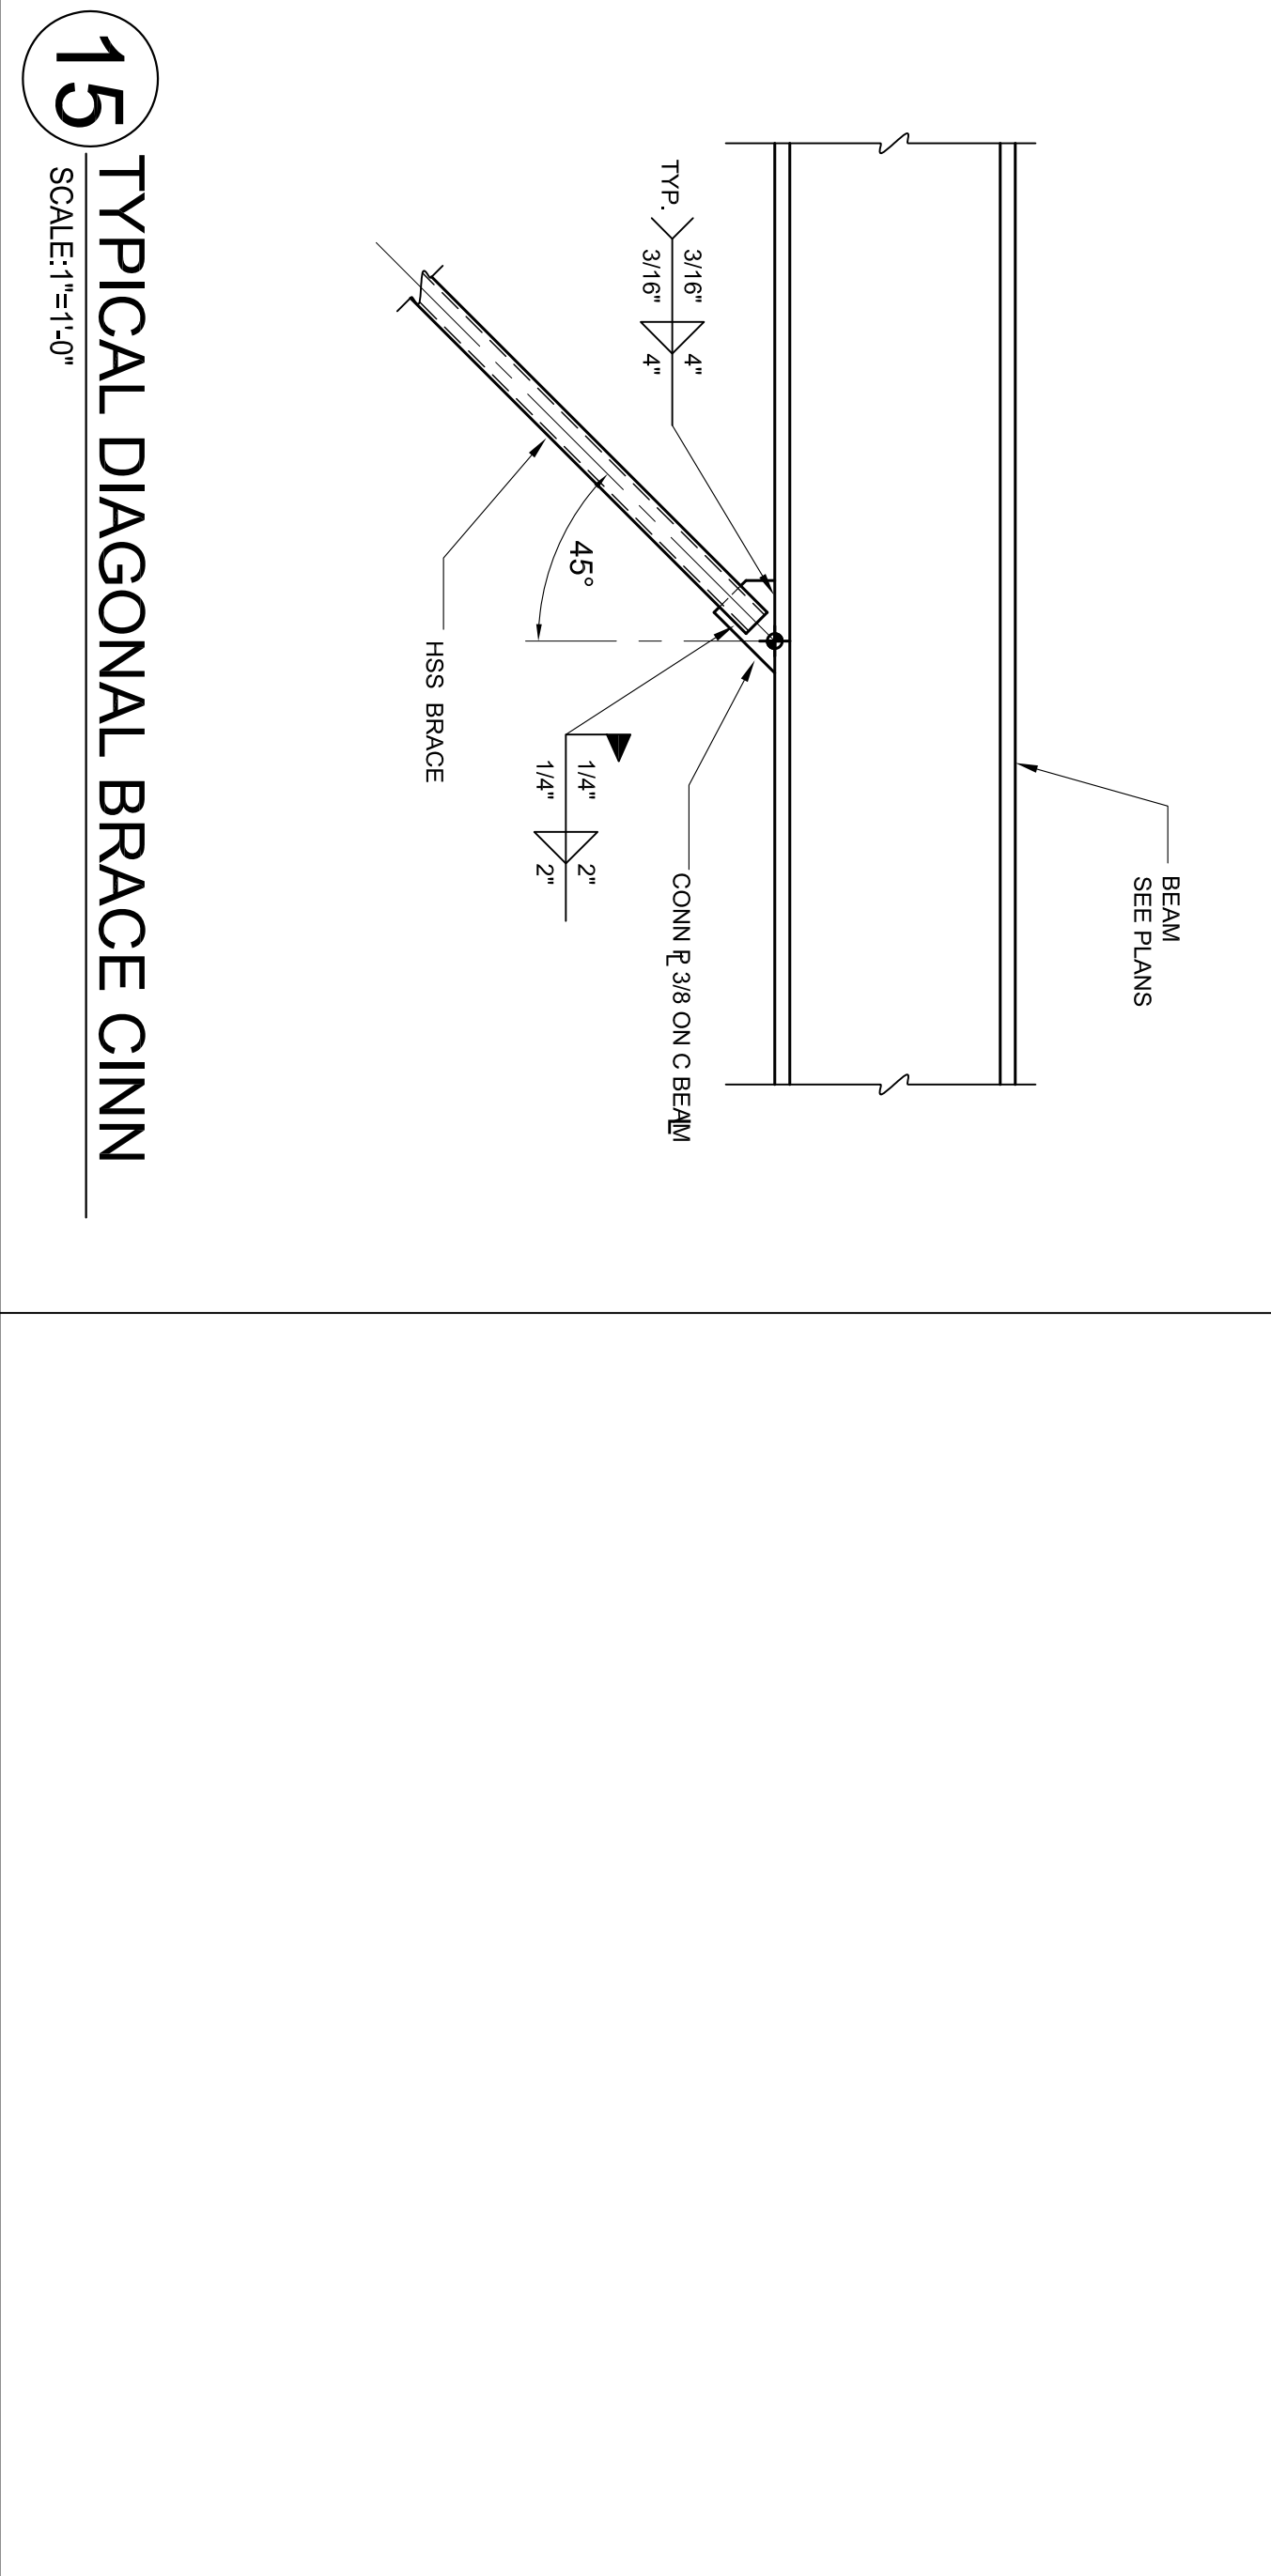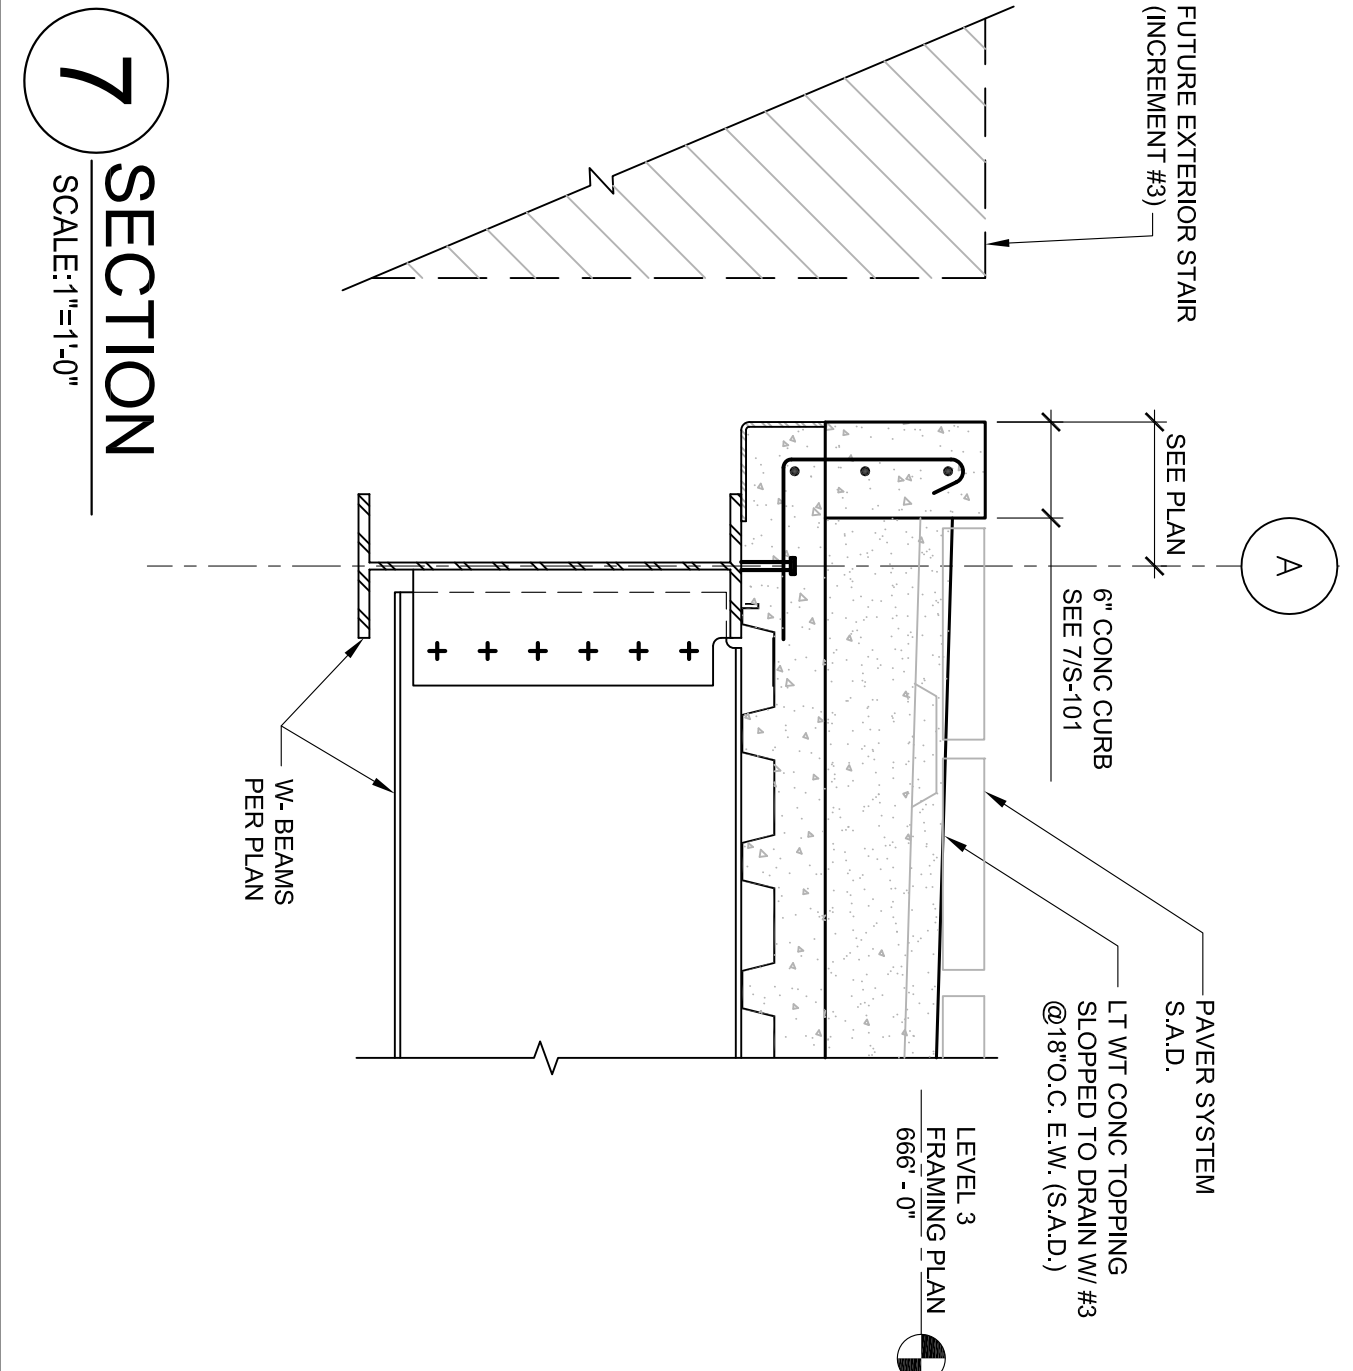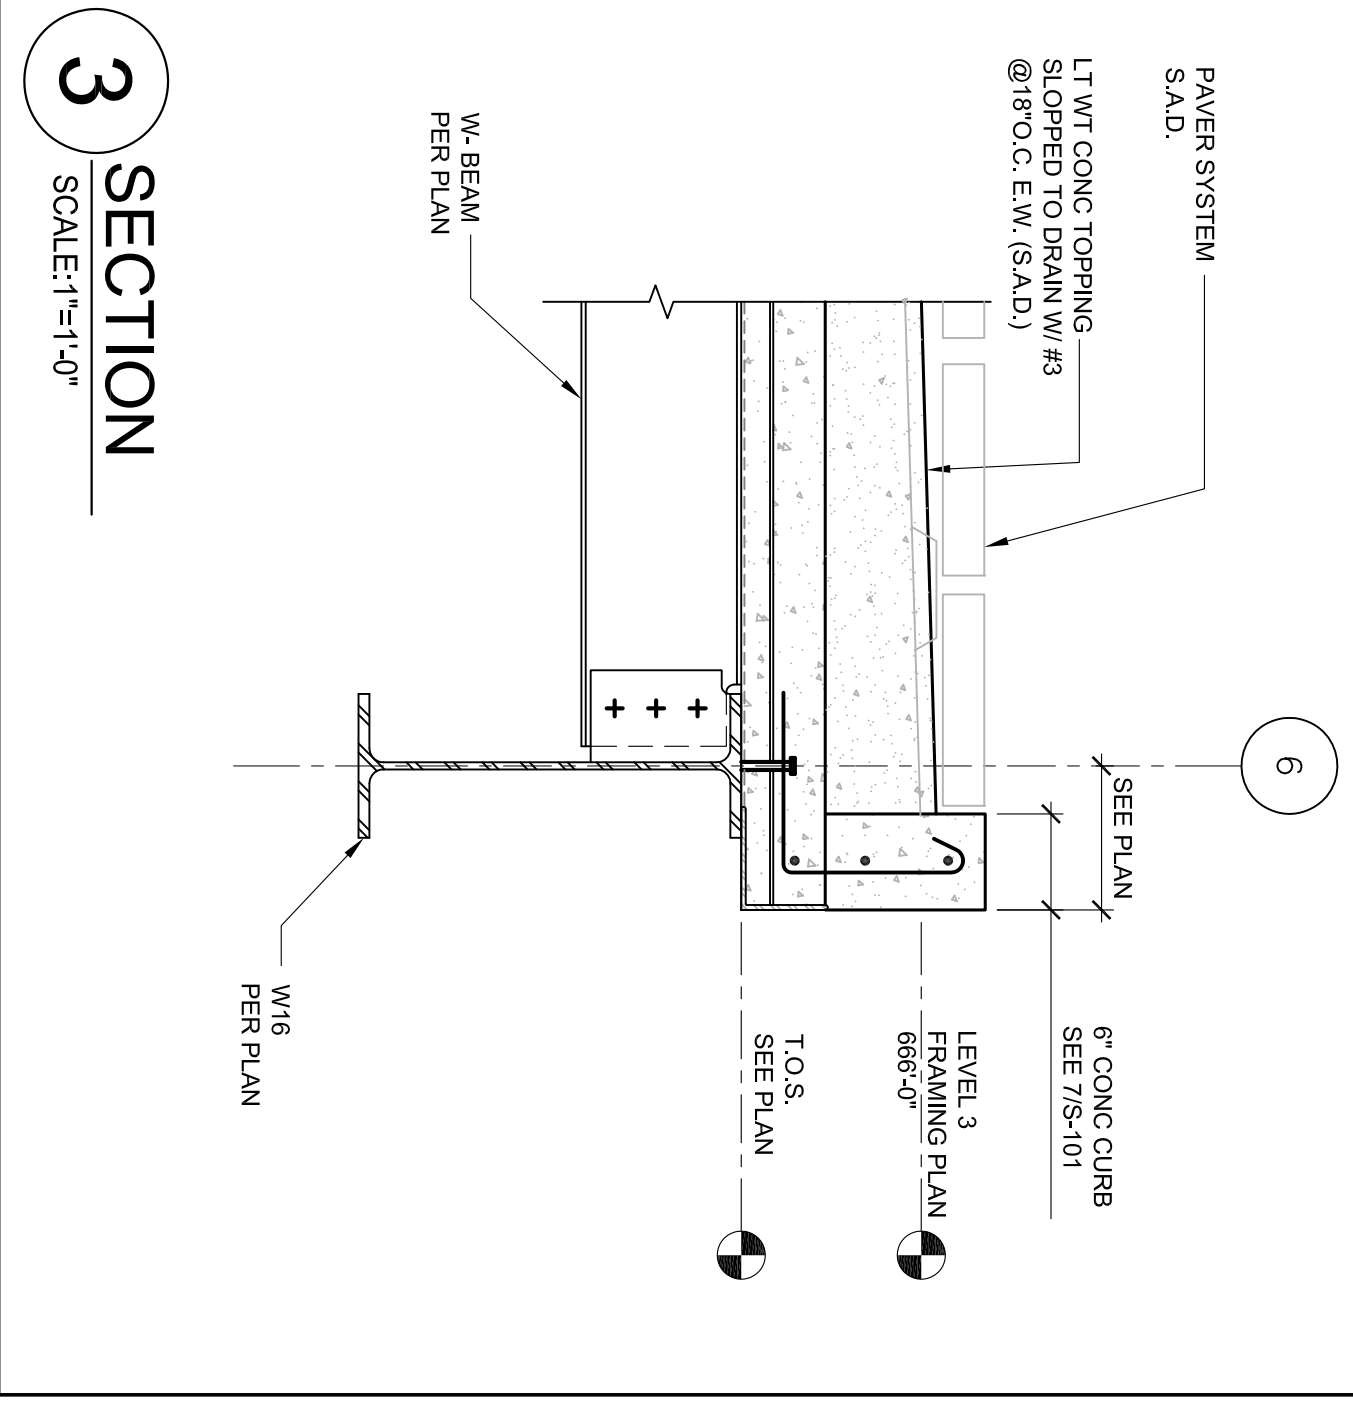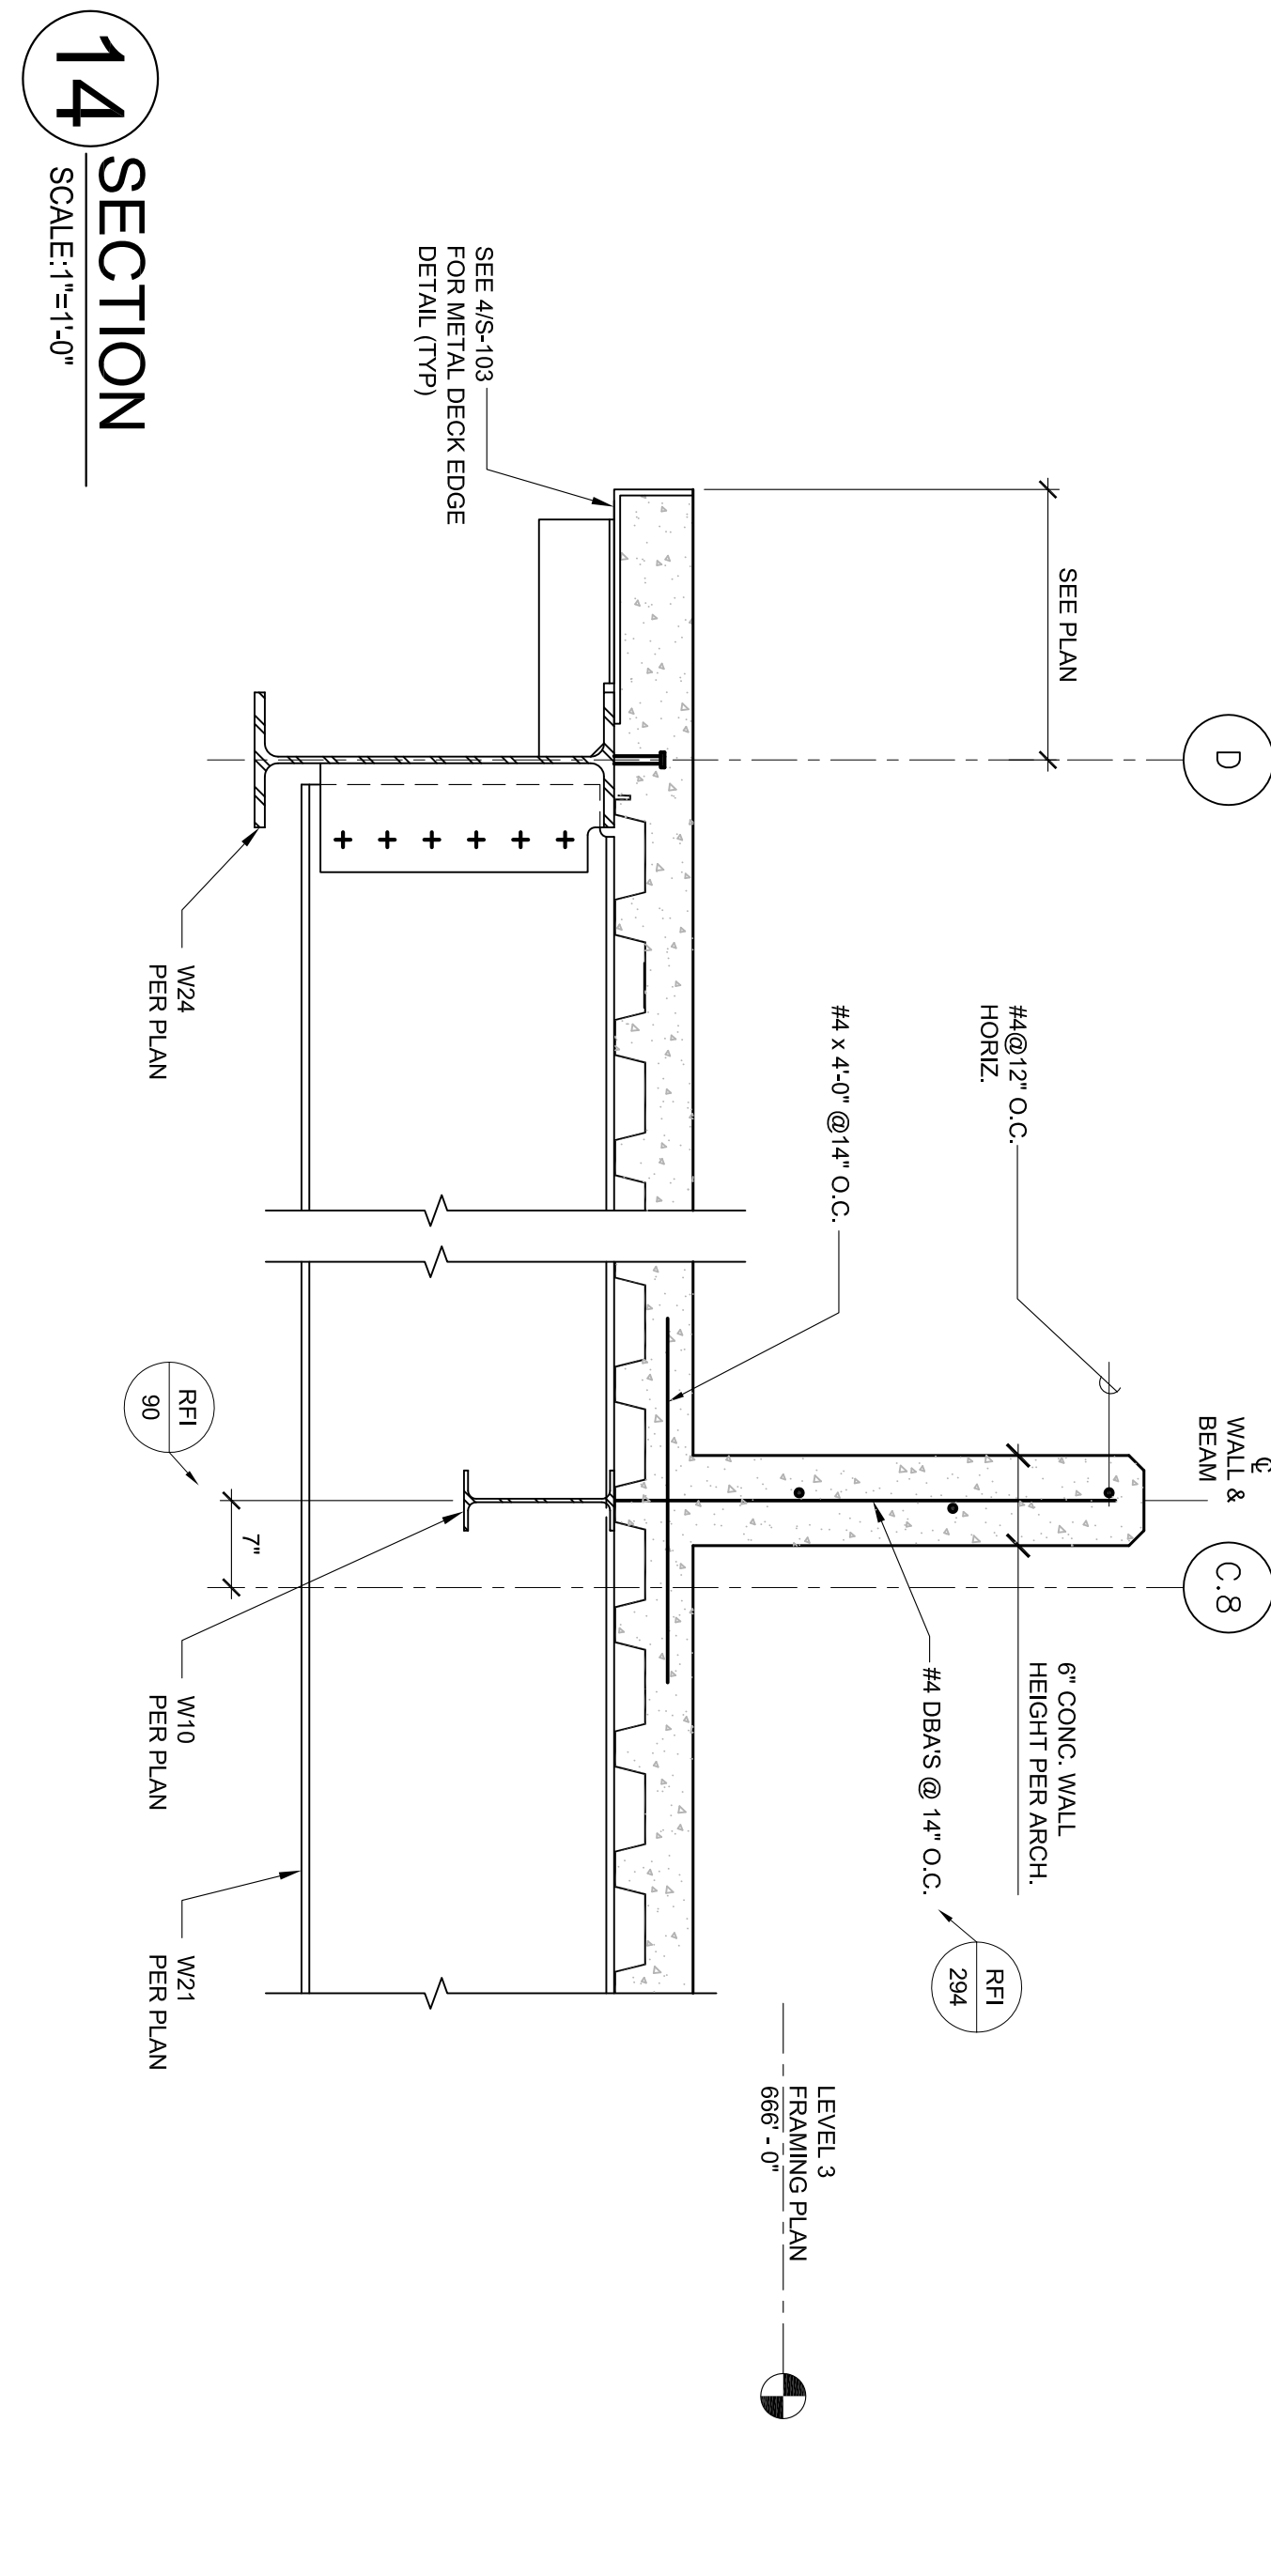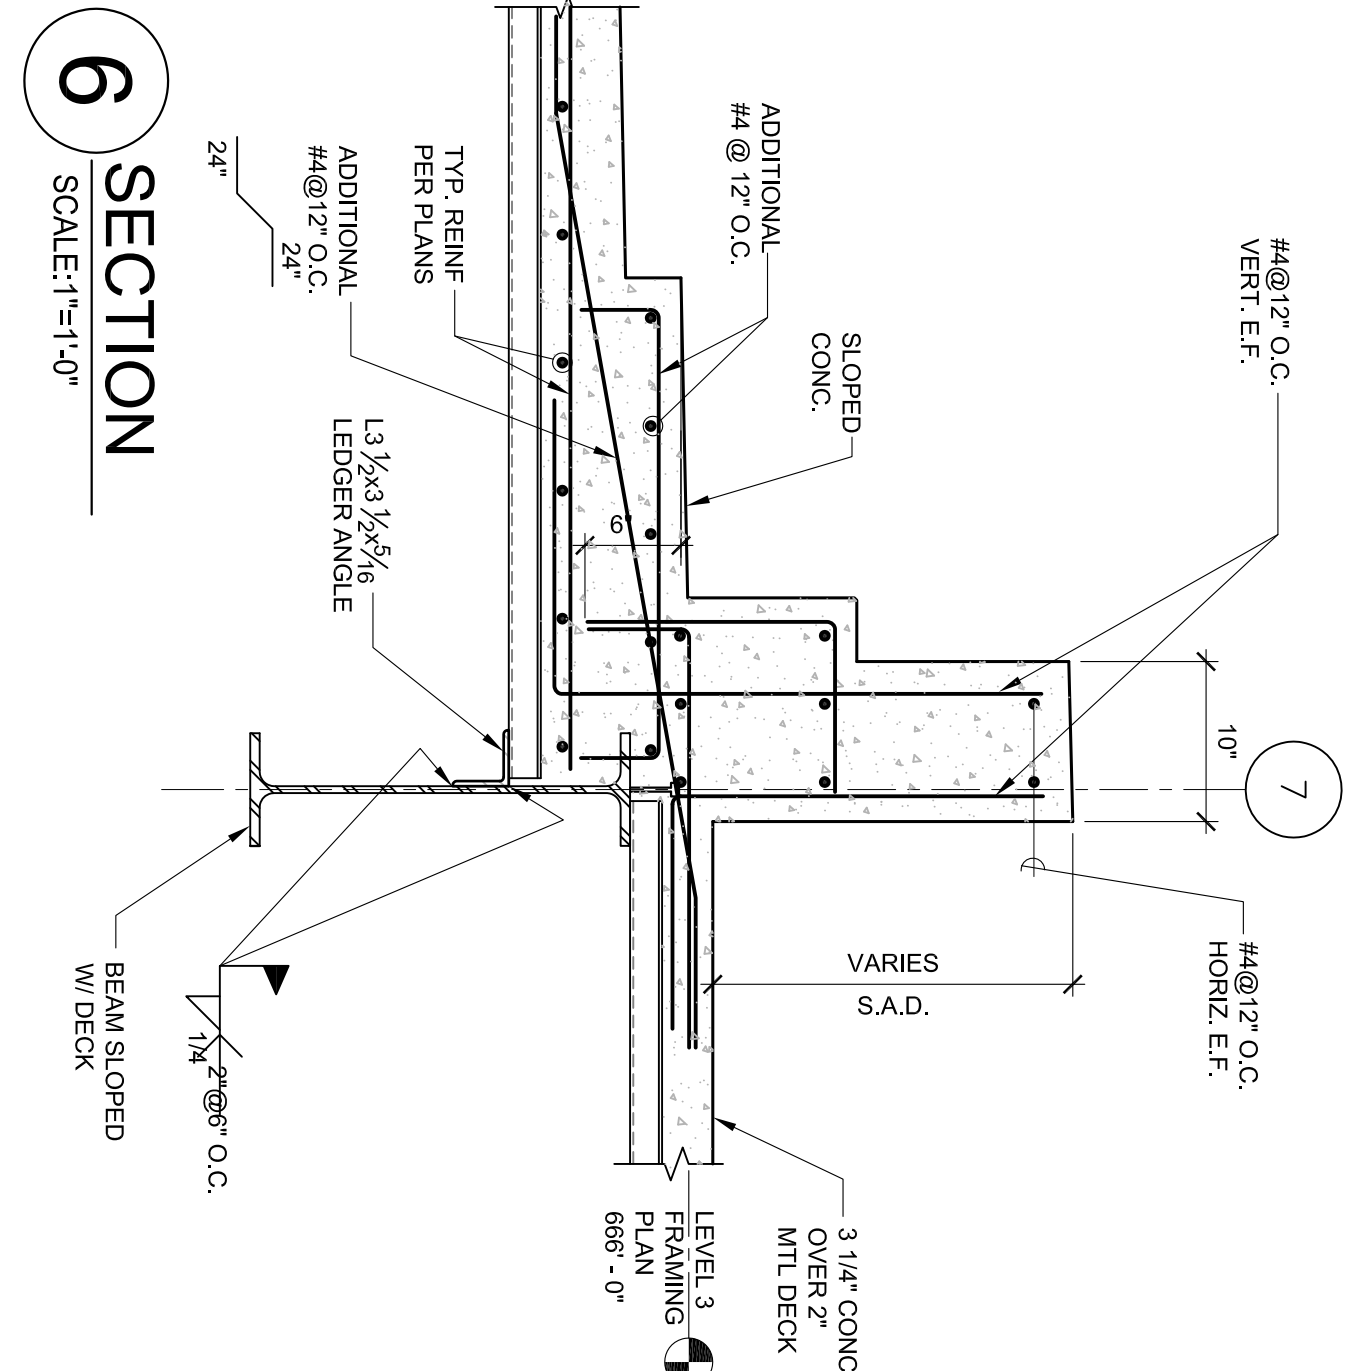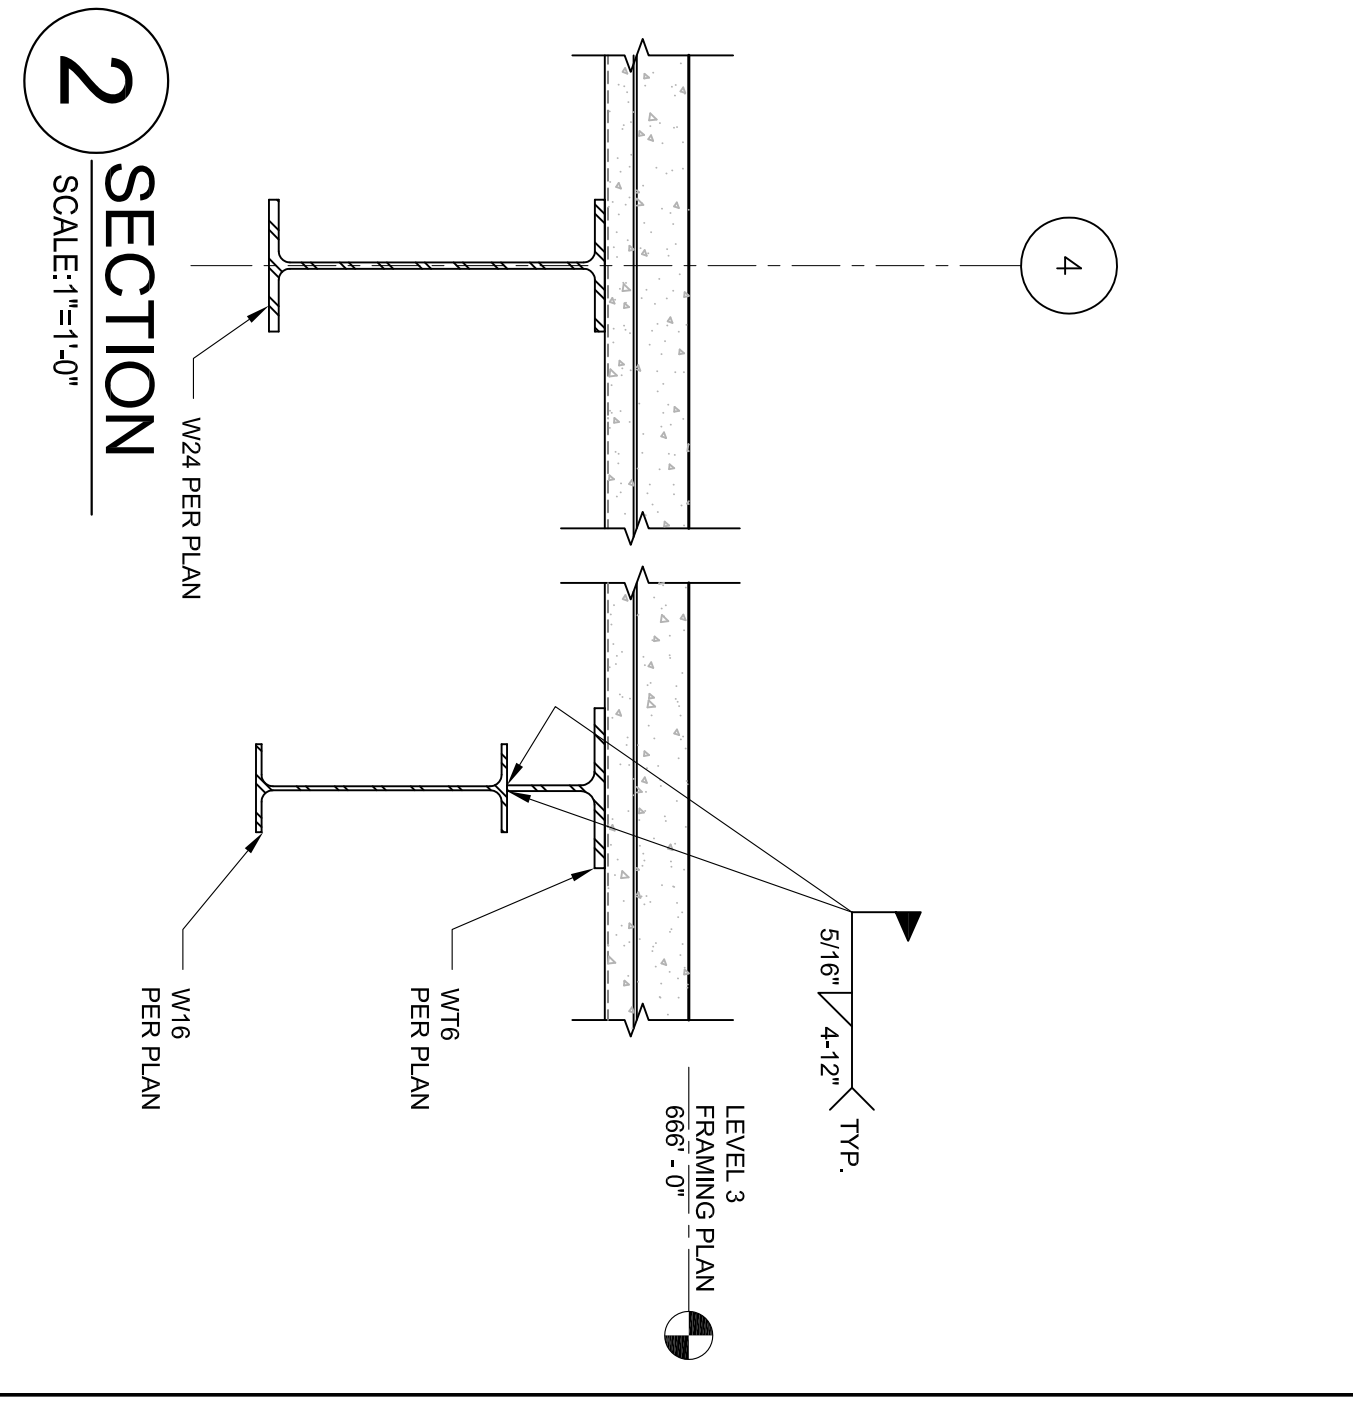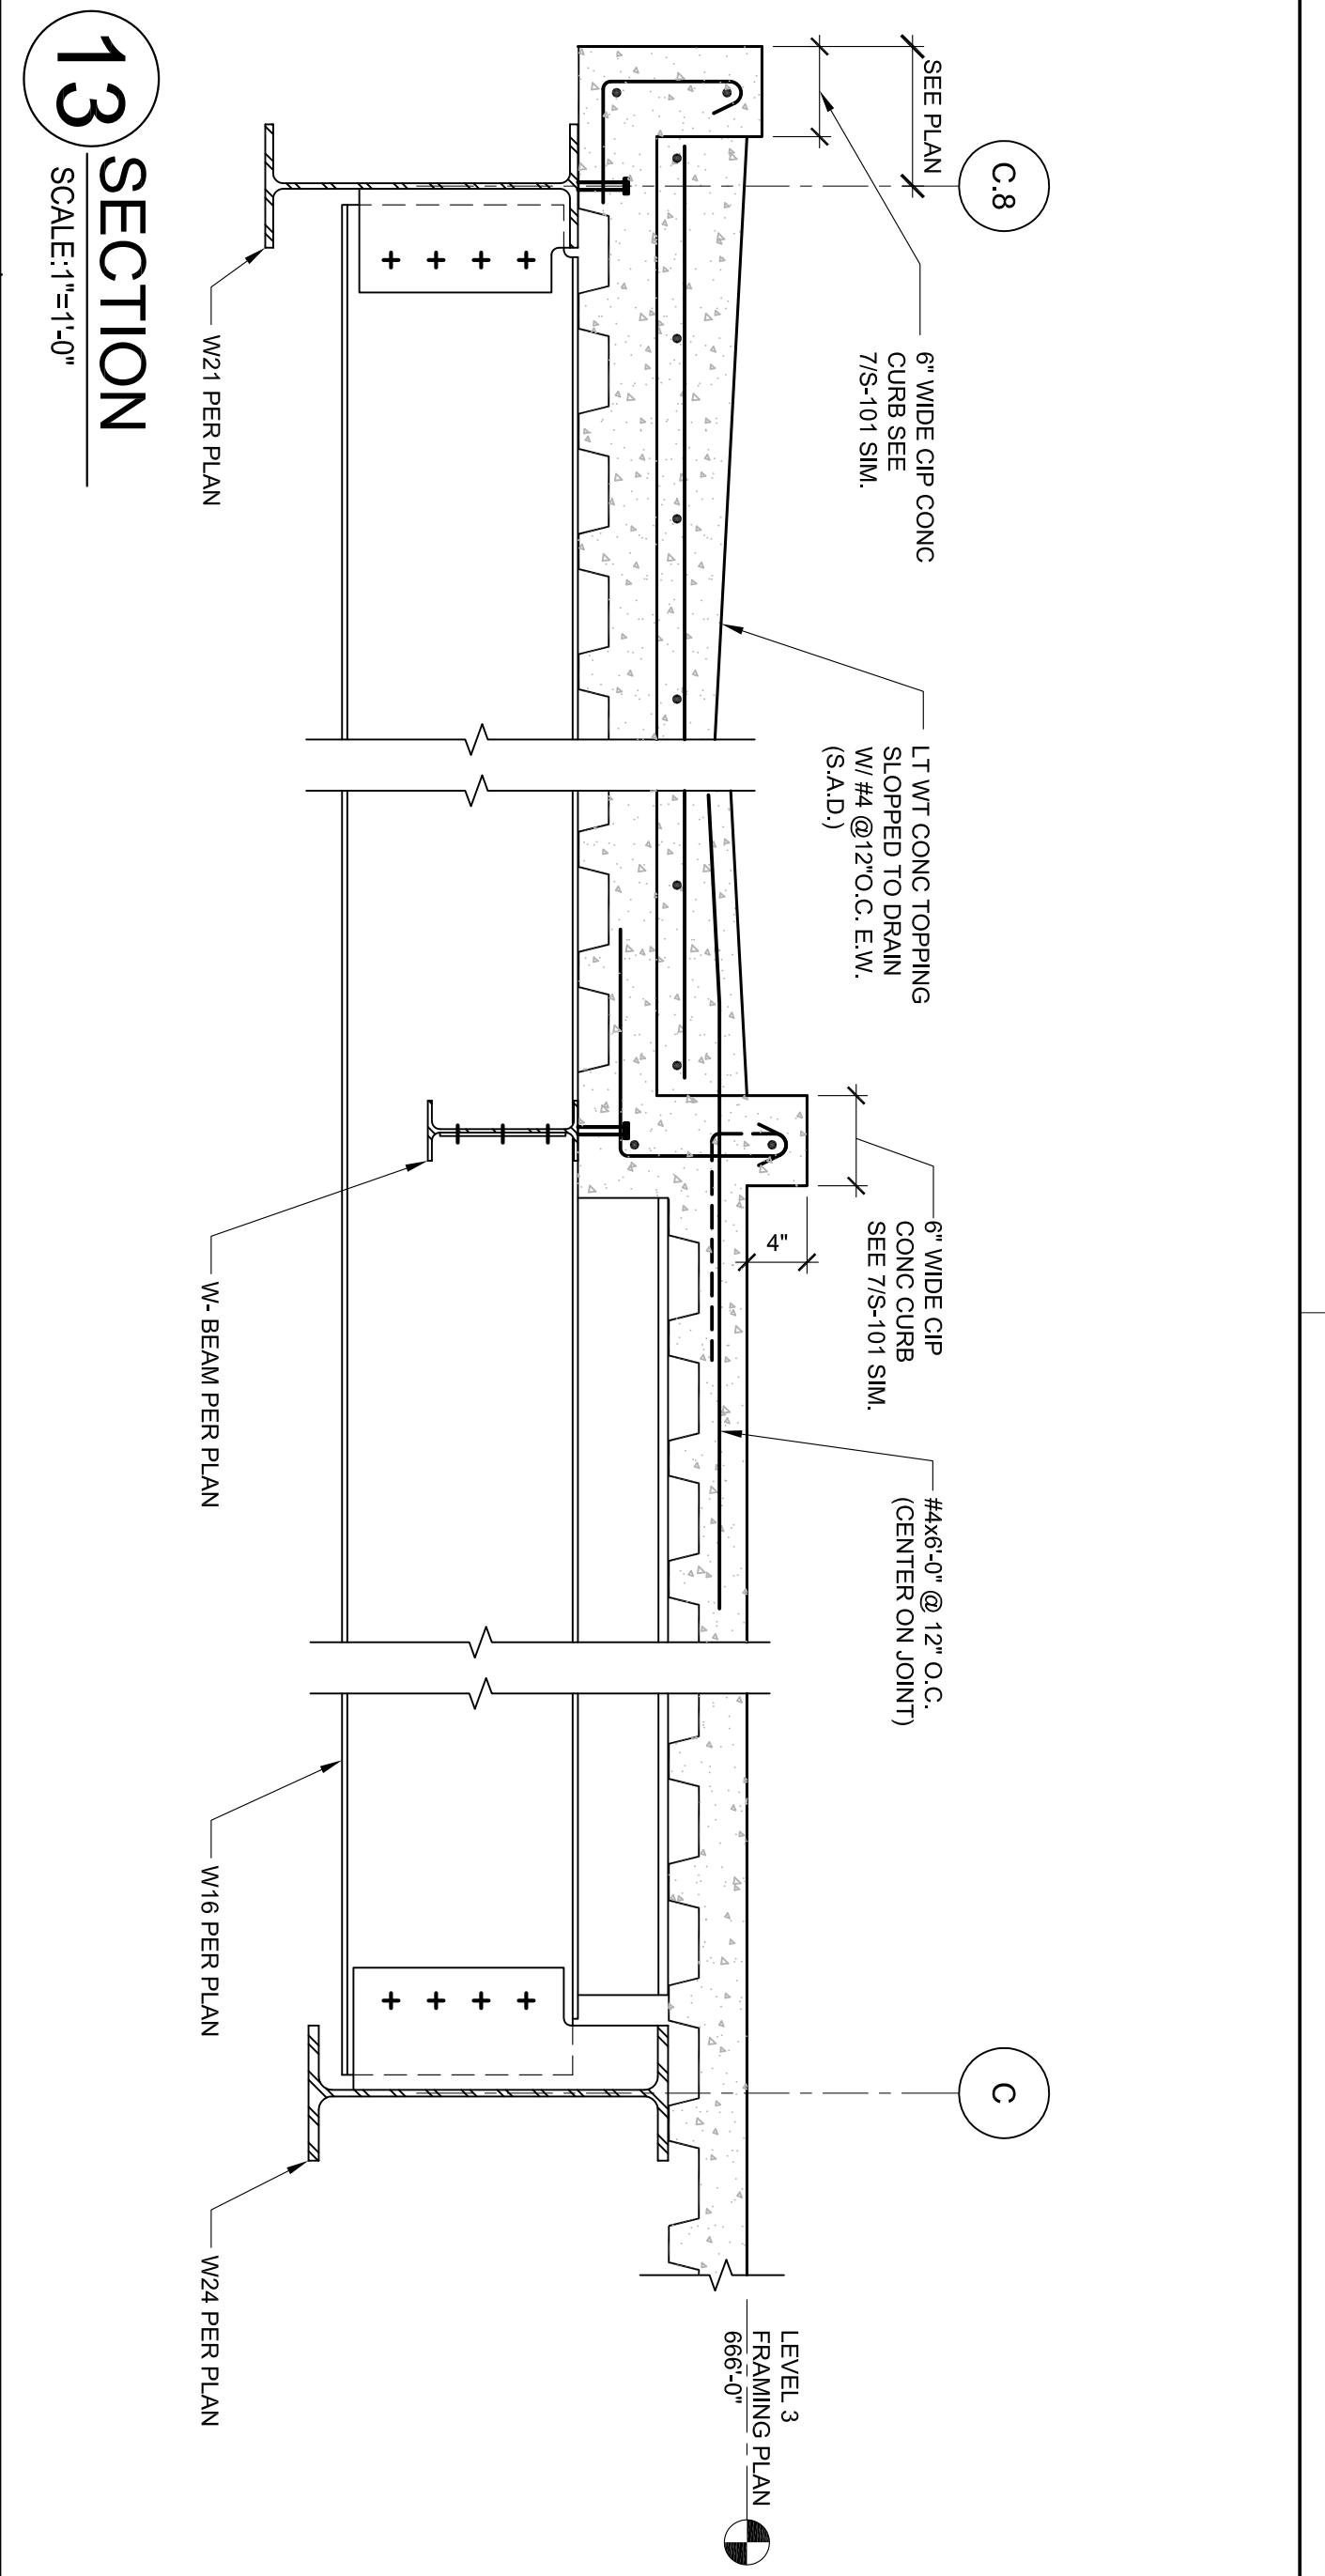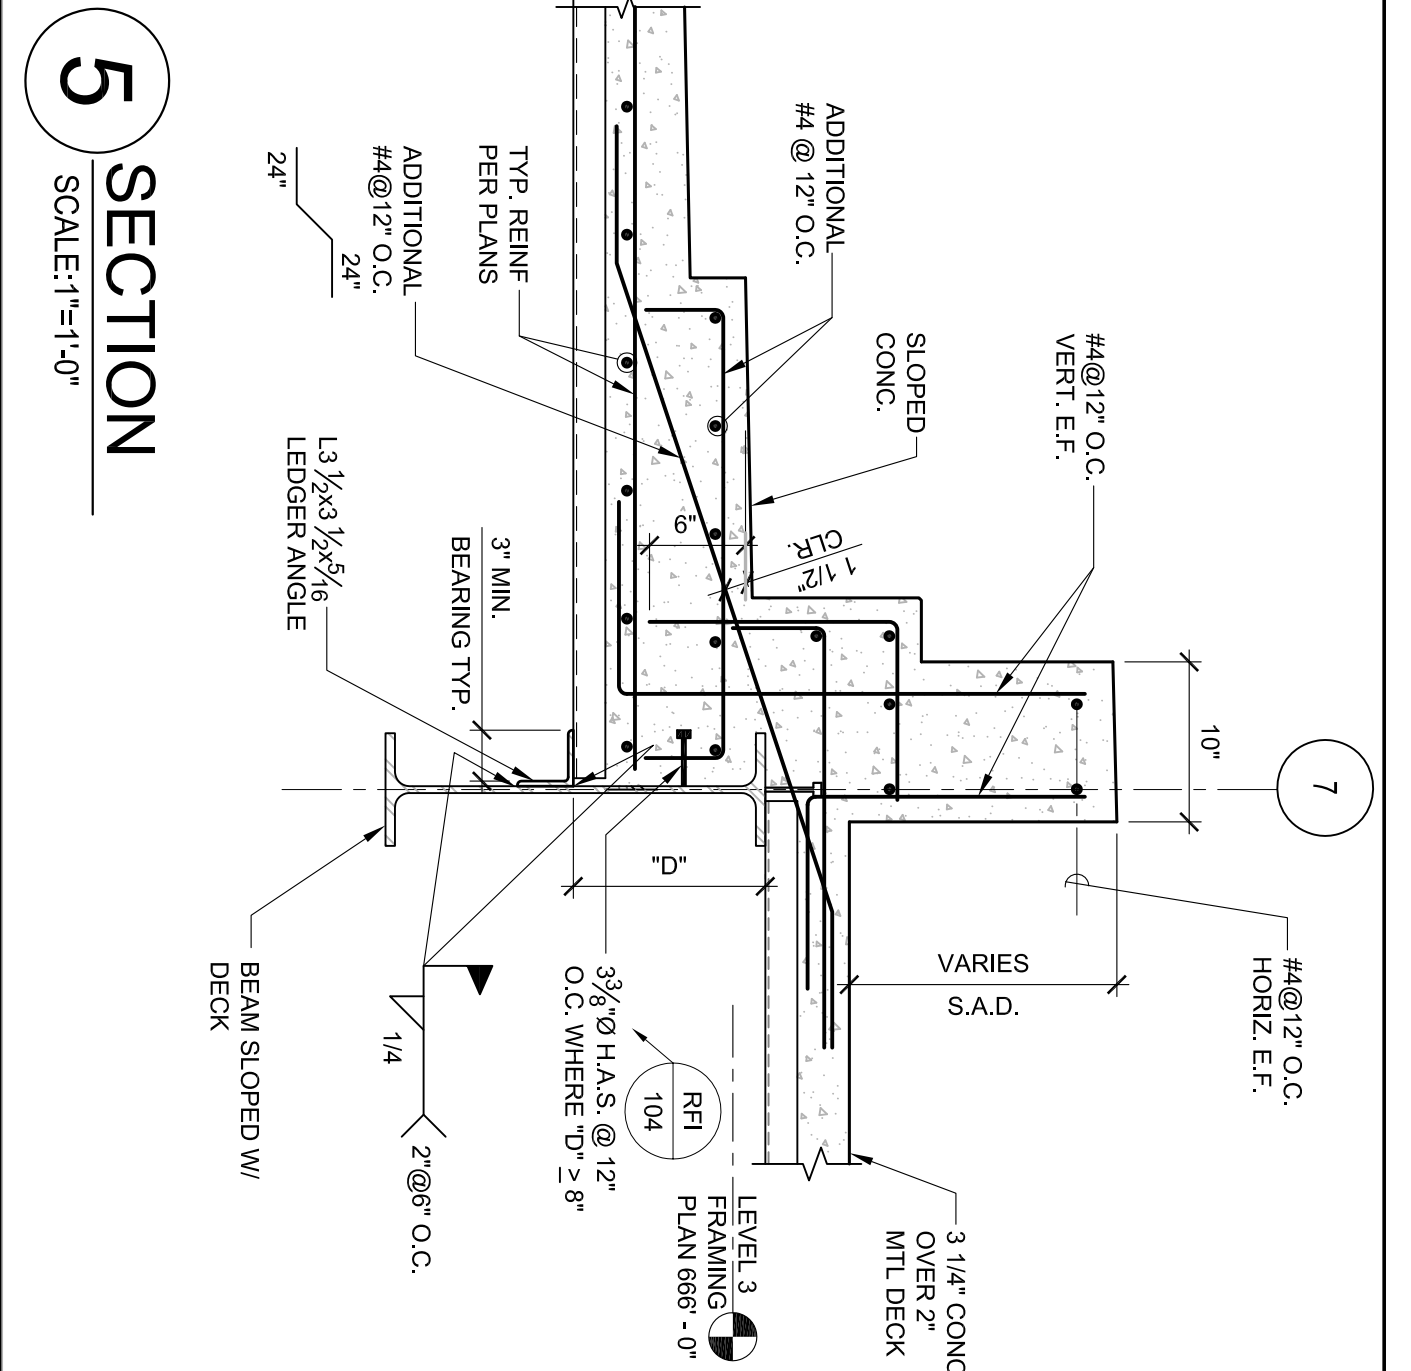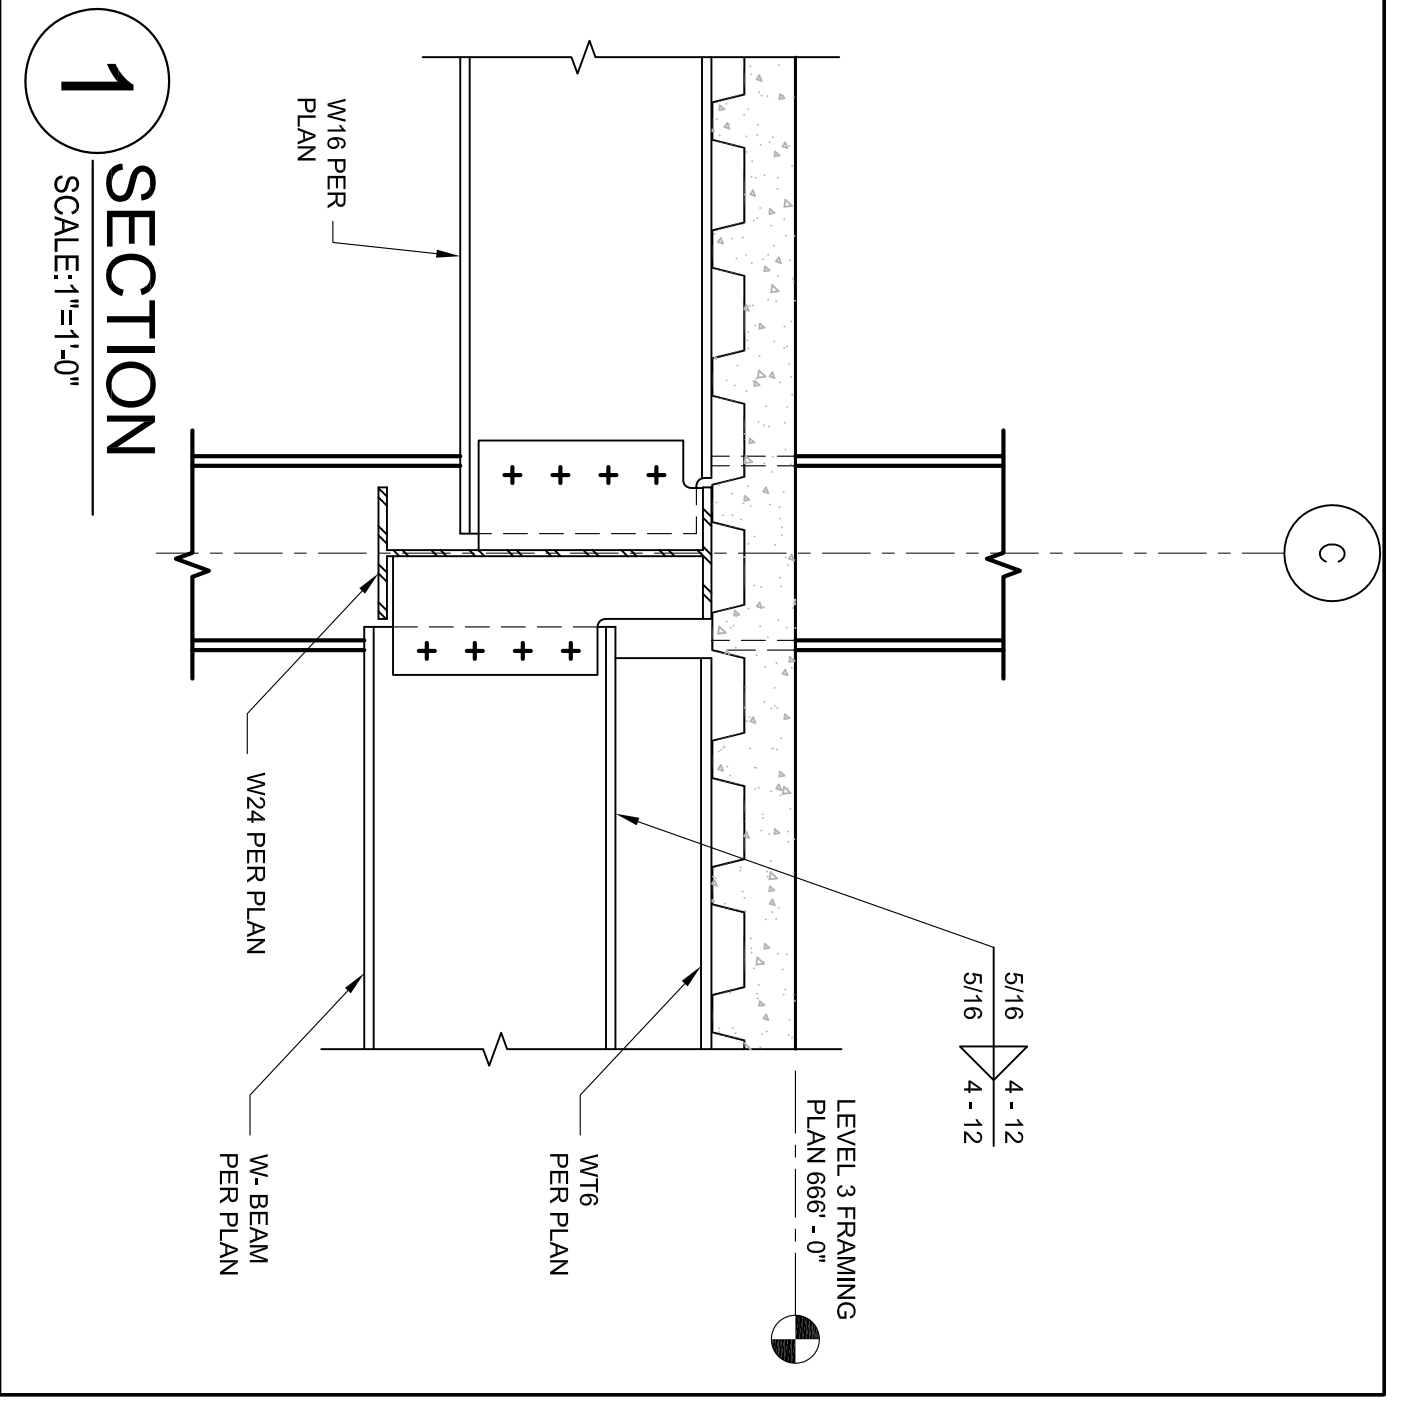

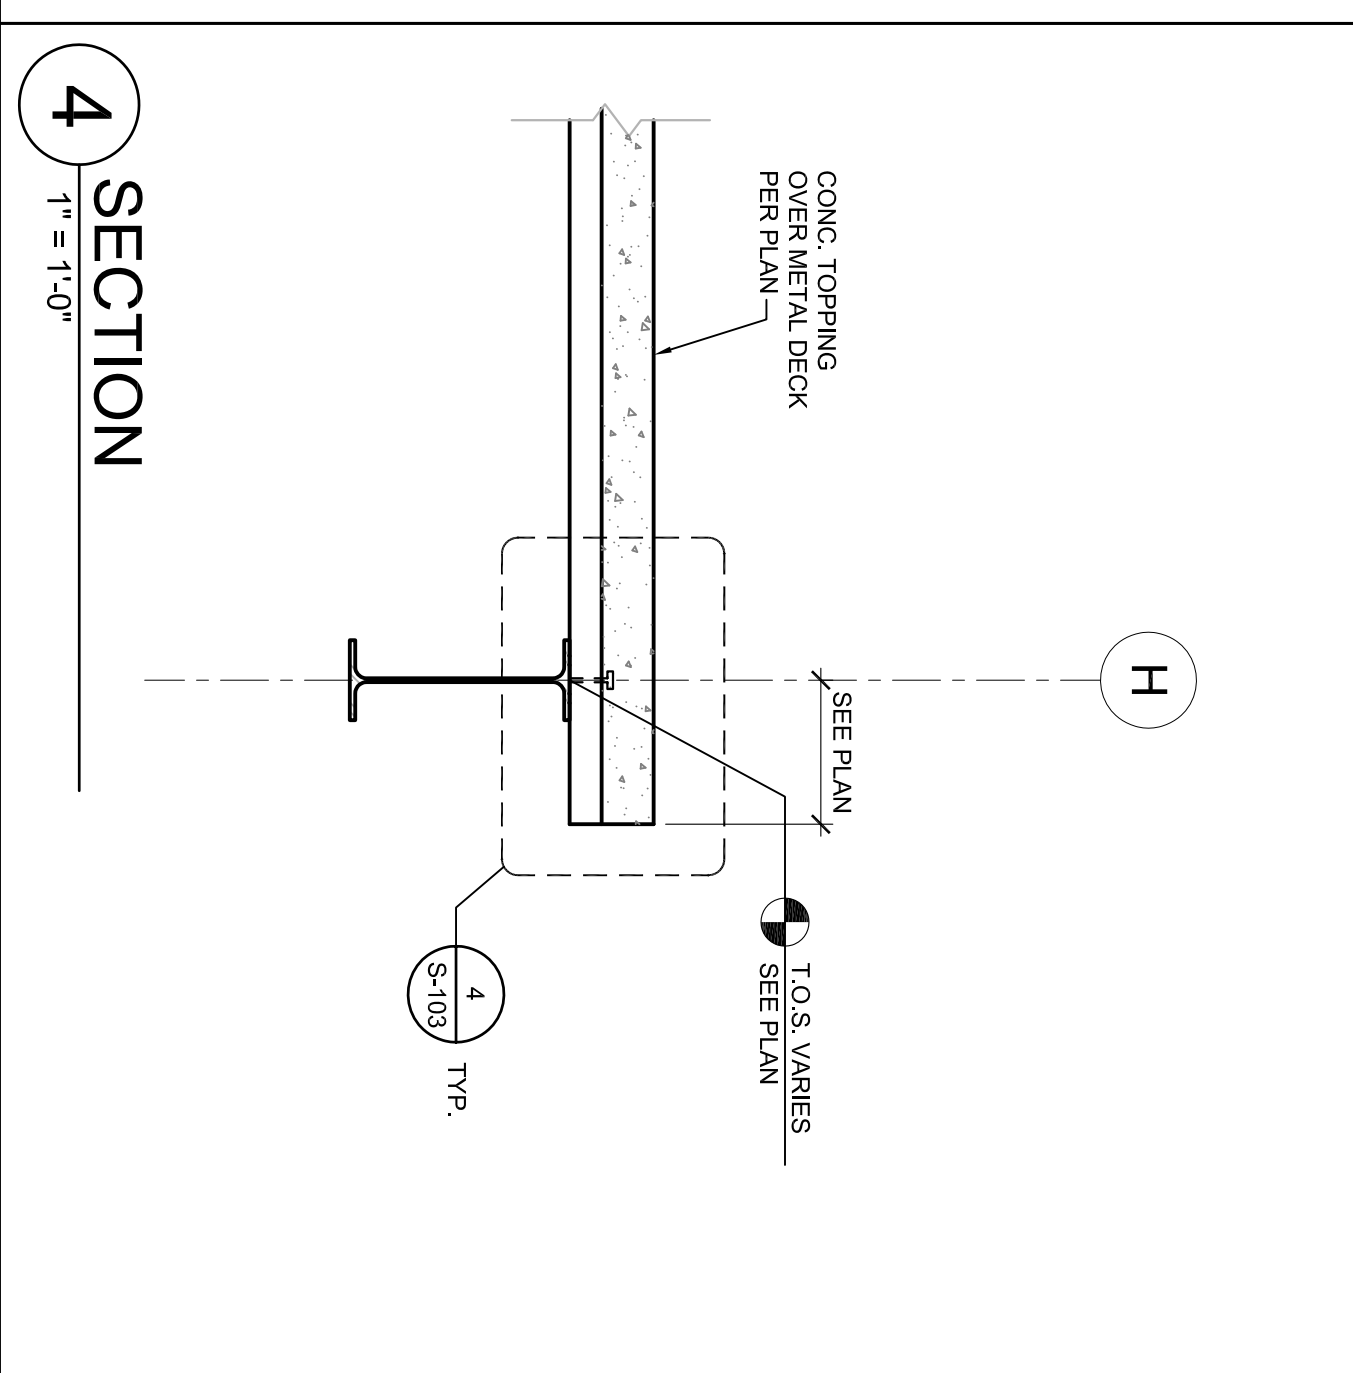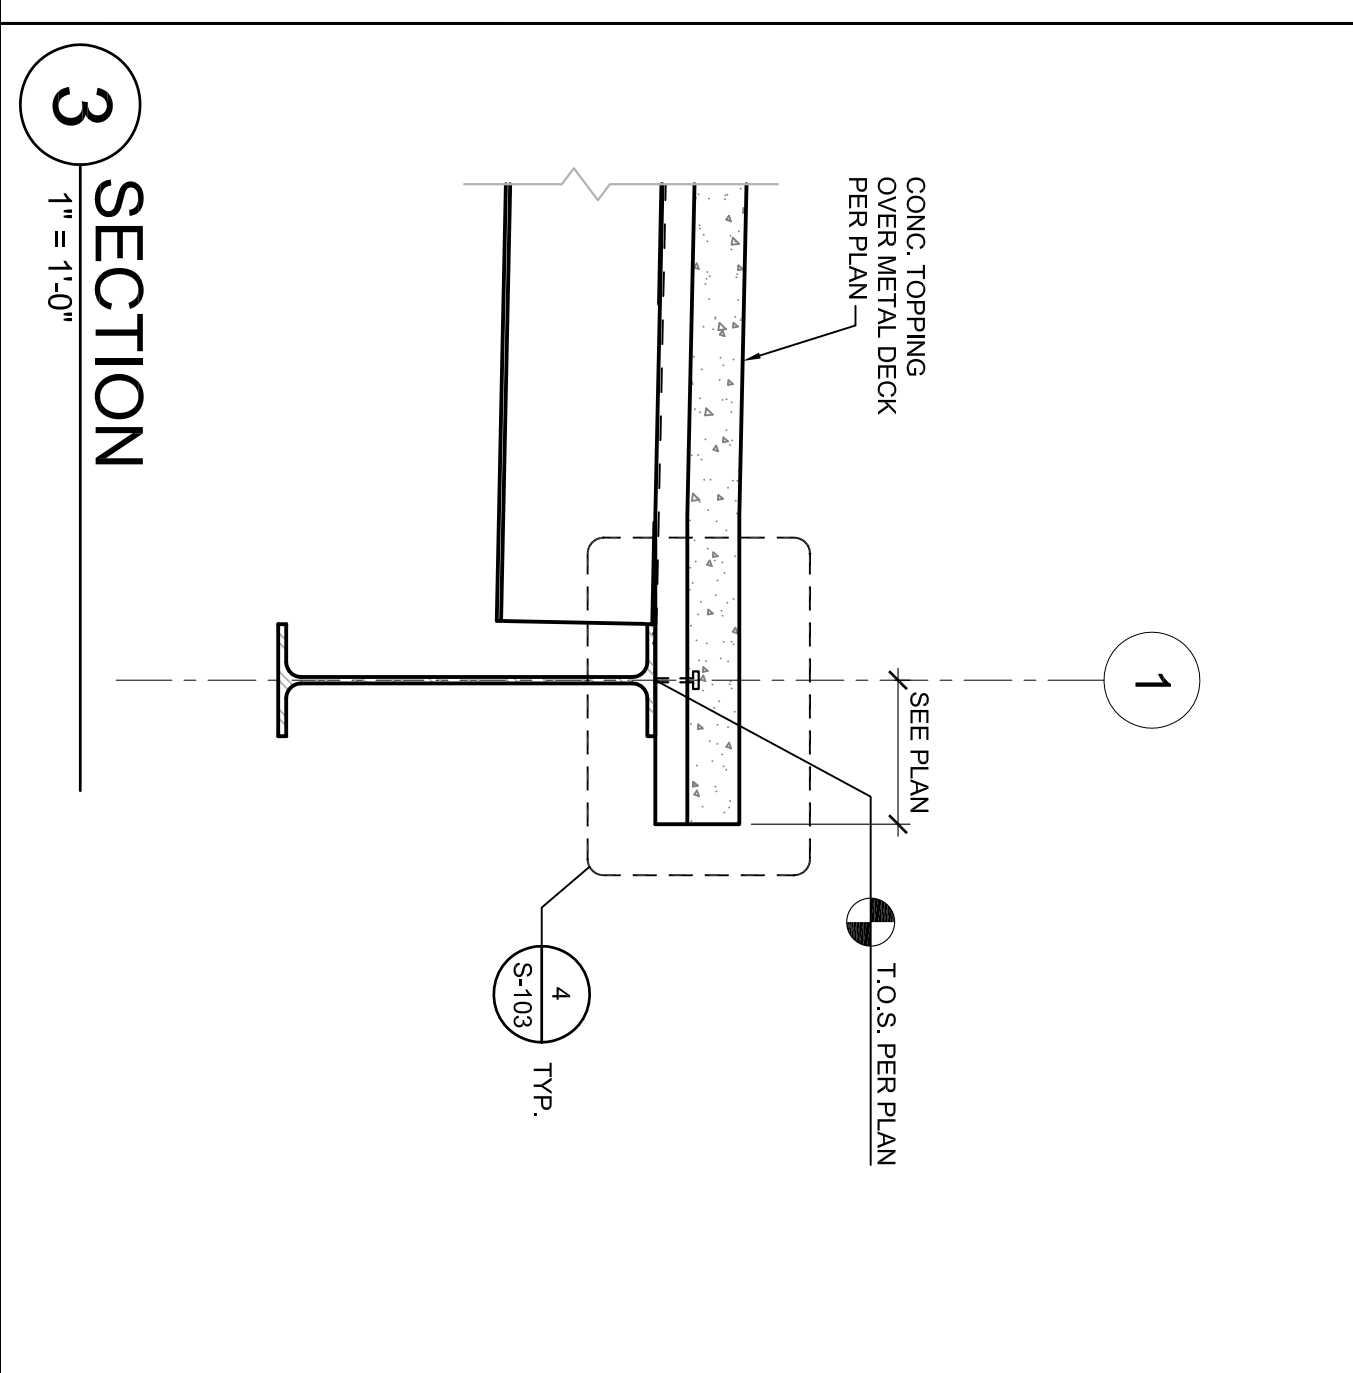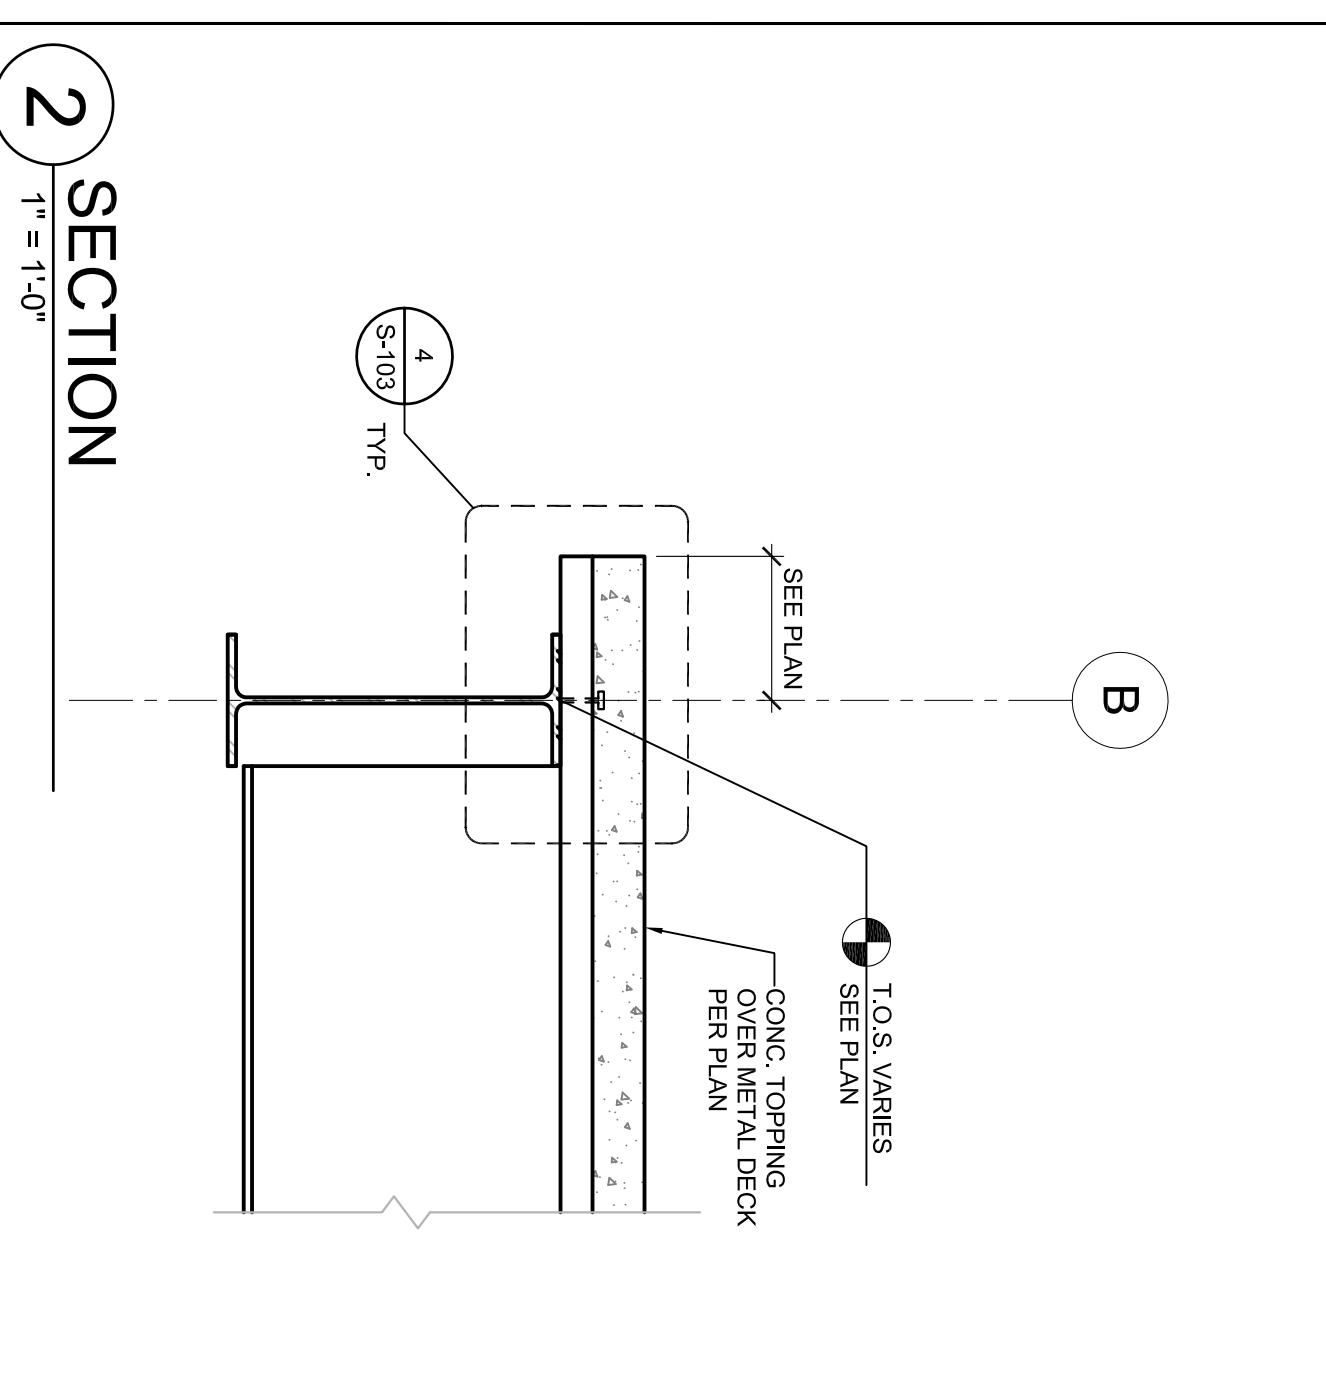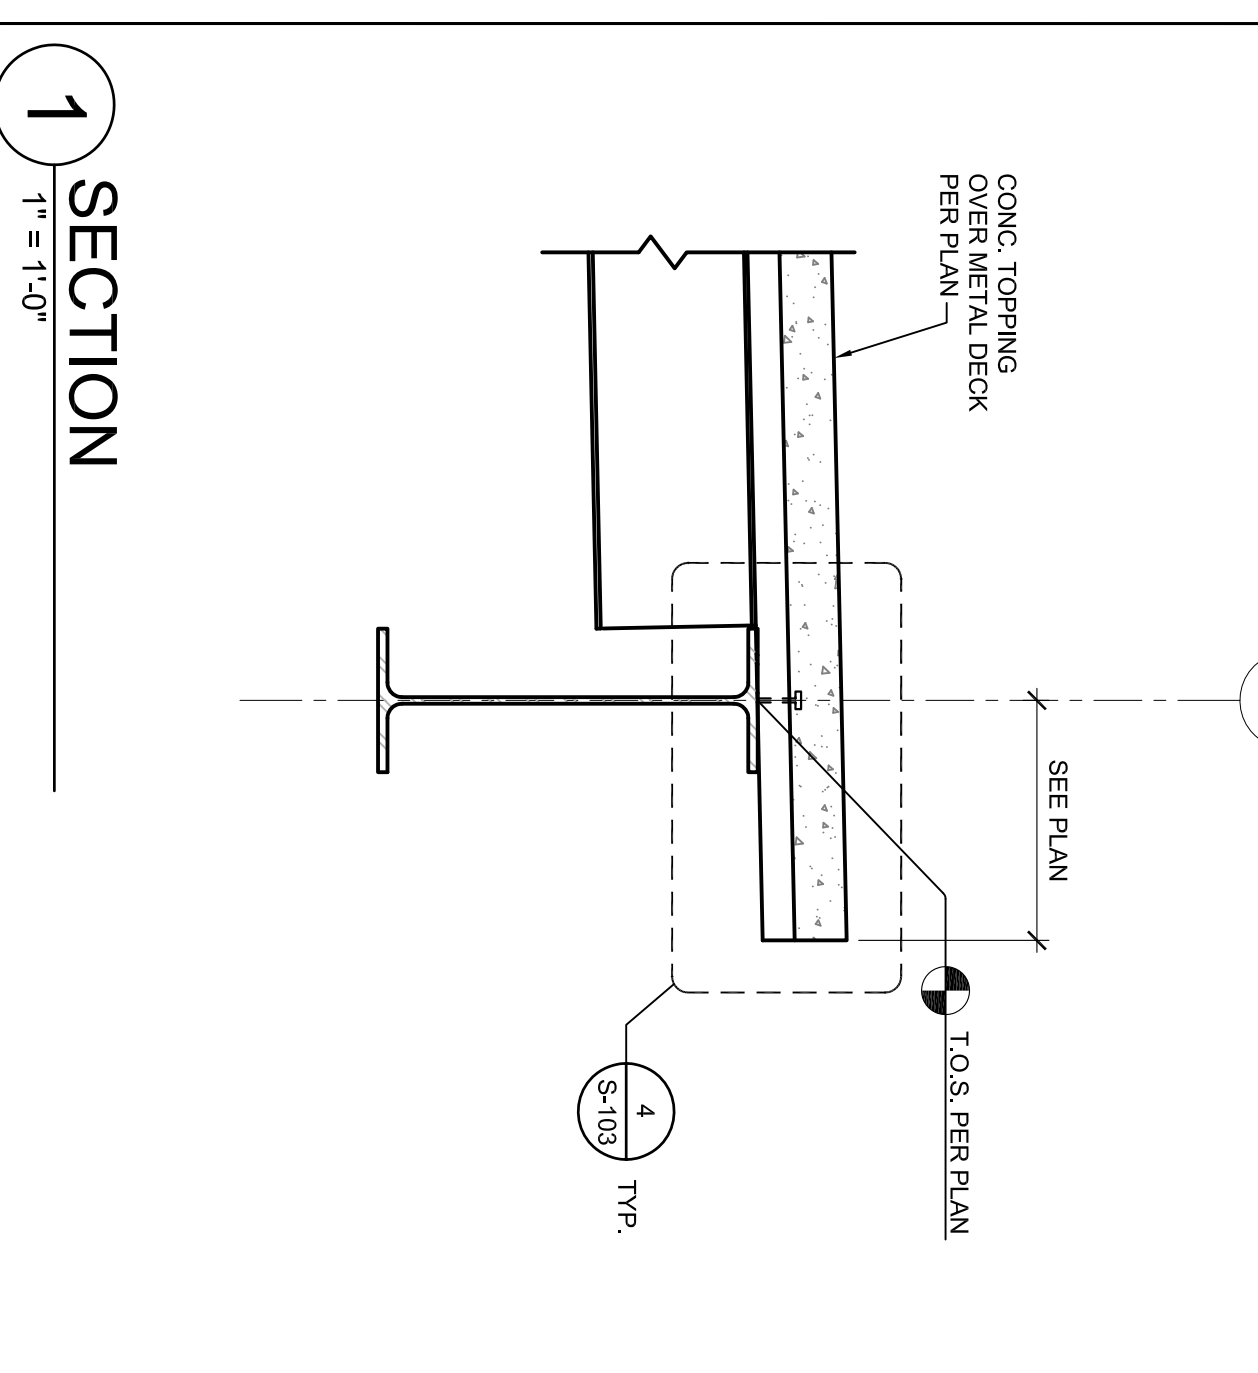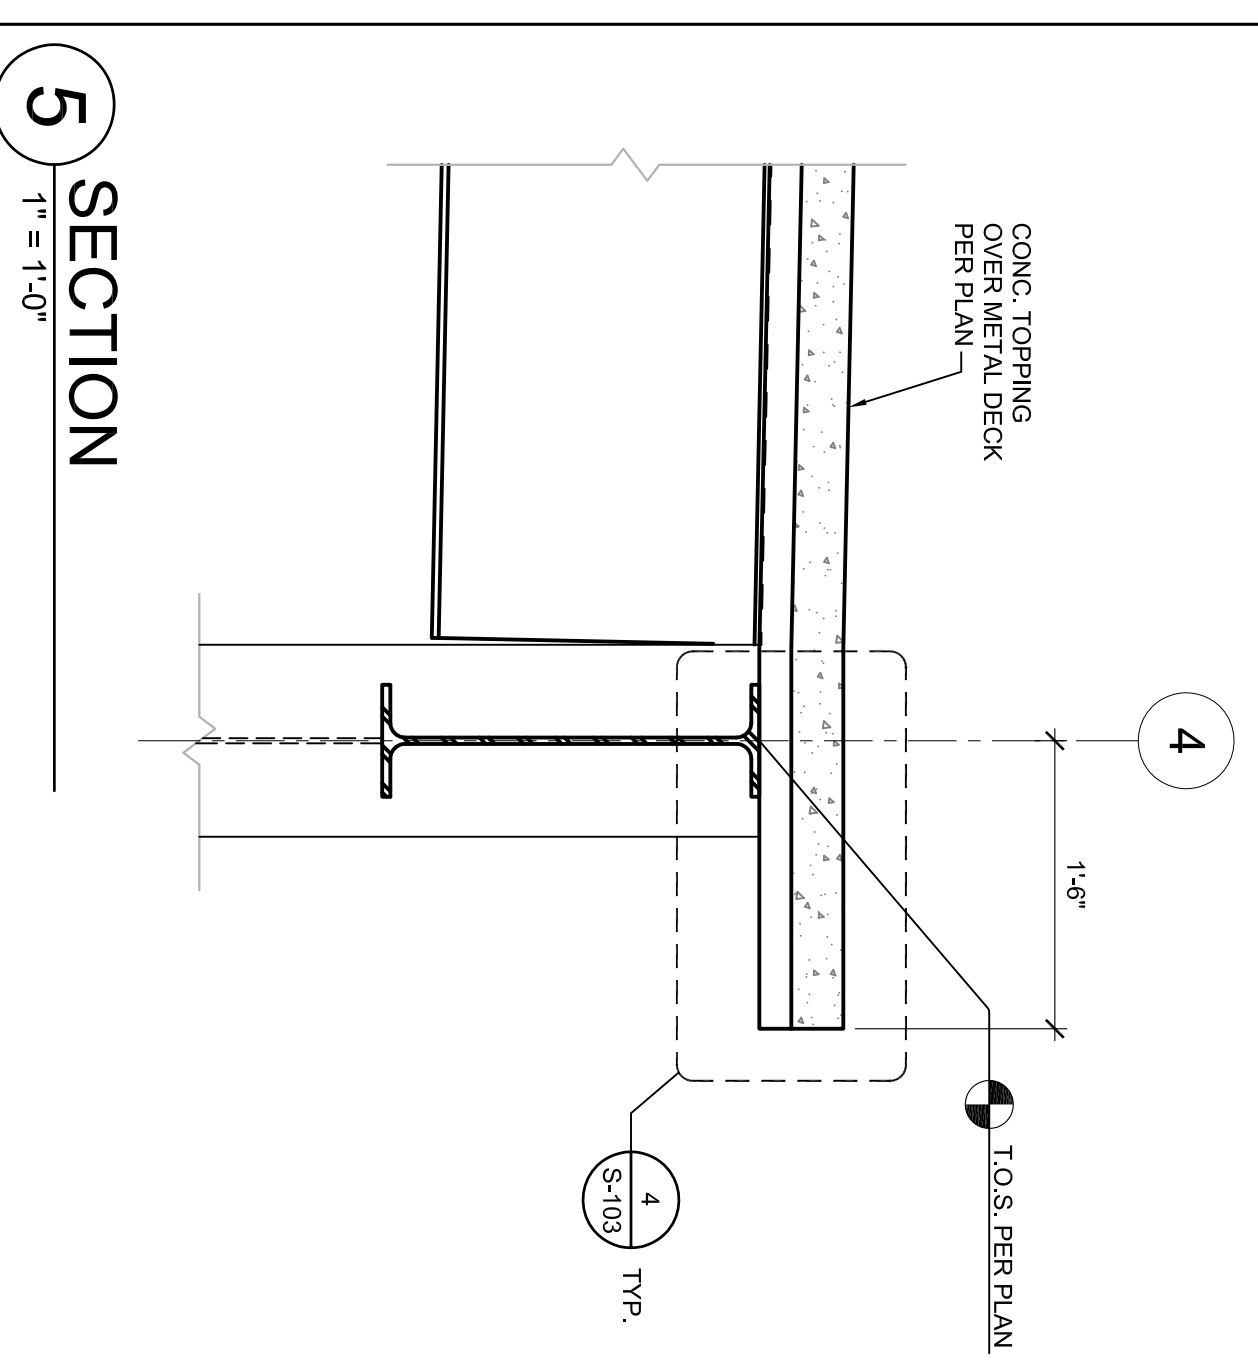


All drawings and other related materials herein constitute original and intellectual work of the Architect/Engineer and may not be reproduced, used or modified without consent of Architect/Engineer.


This drawing is at 1/8"=1'-0" and the details have been reduced from its original size. Notes scales must be adjusted. This line should be equal to one inch.

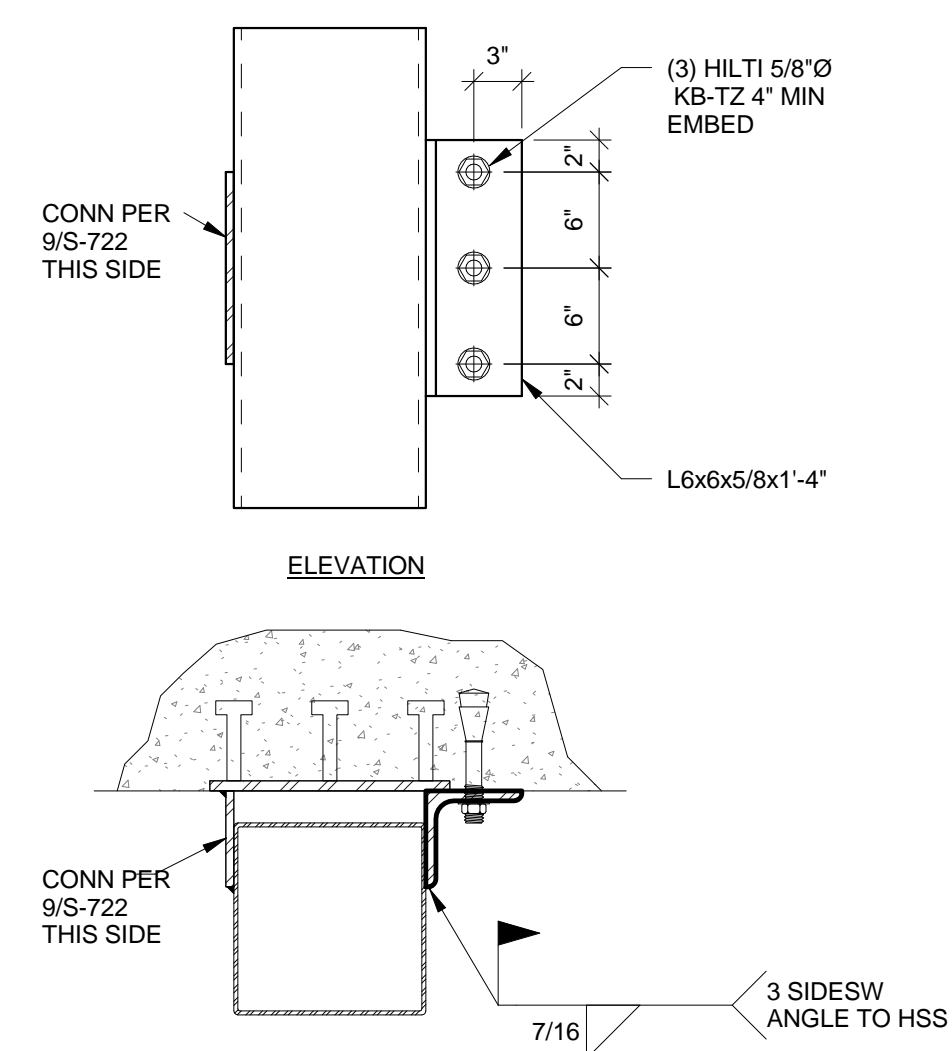


17 HSS CONN @ WALL  
SCALE: 1" = 1'-0"

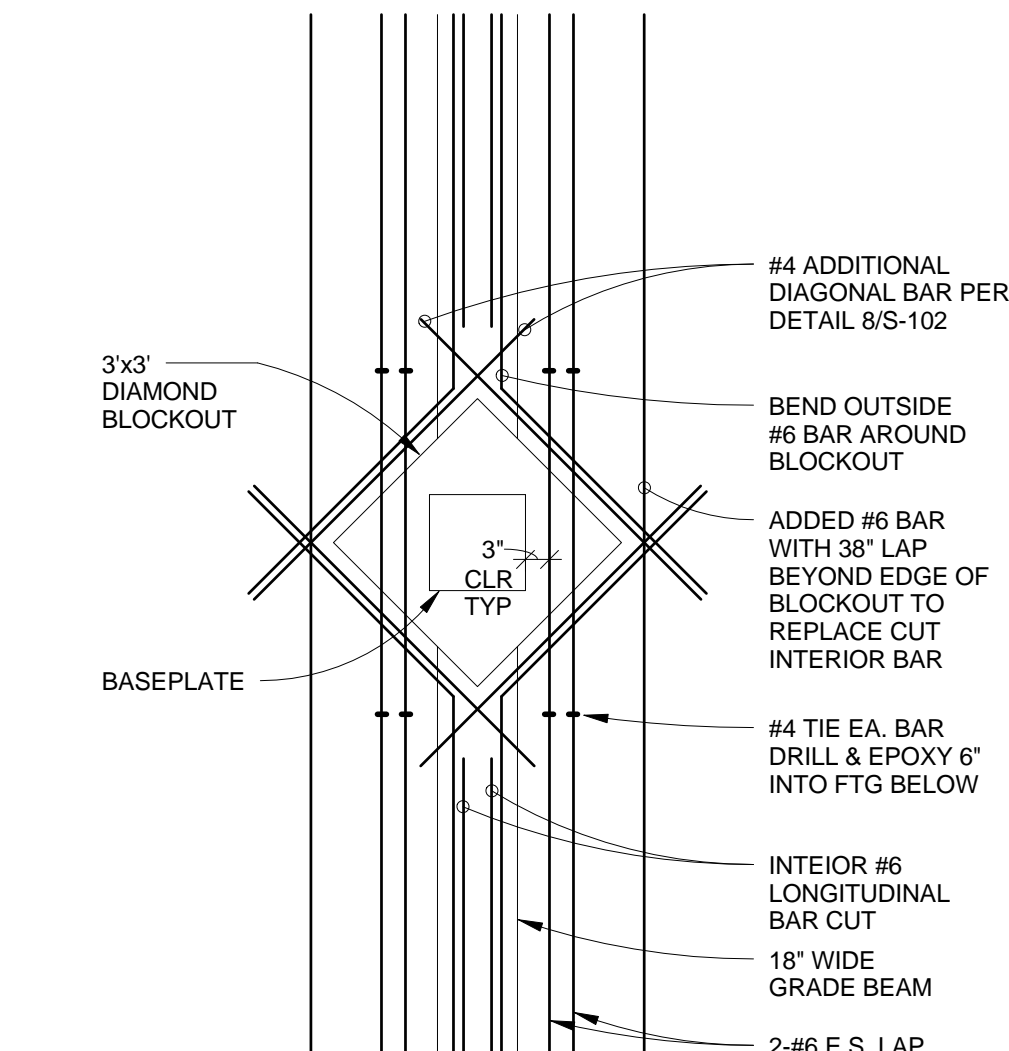


13 REINF. DETAIL @ BLOCKOUT  
INT. COL.  
SCALE: 1/2" = 1'-0"

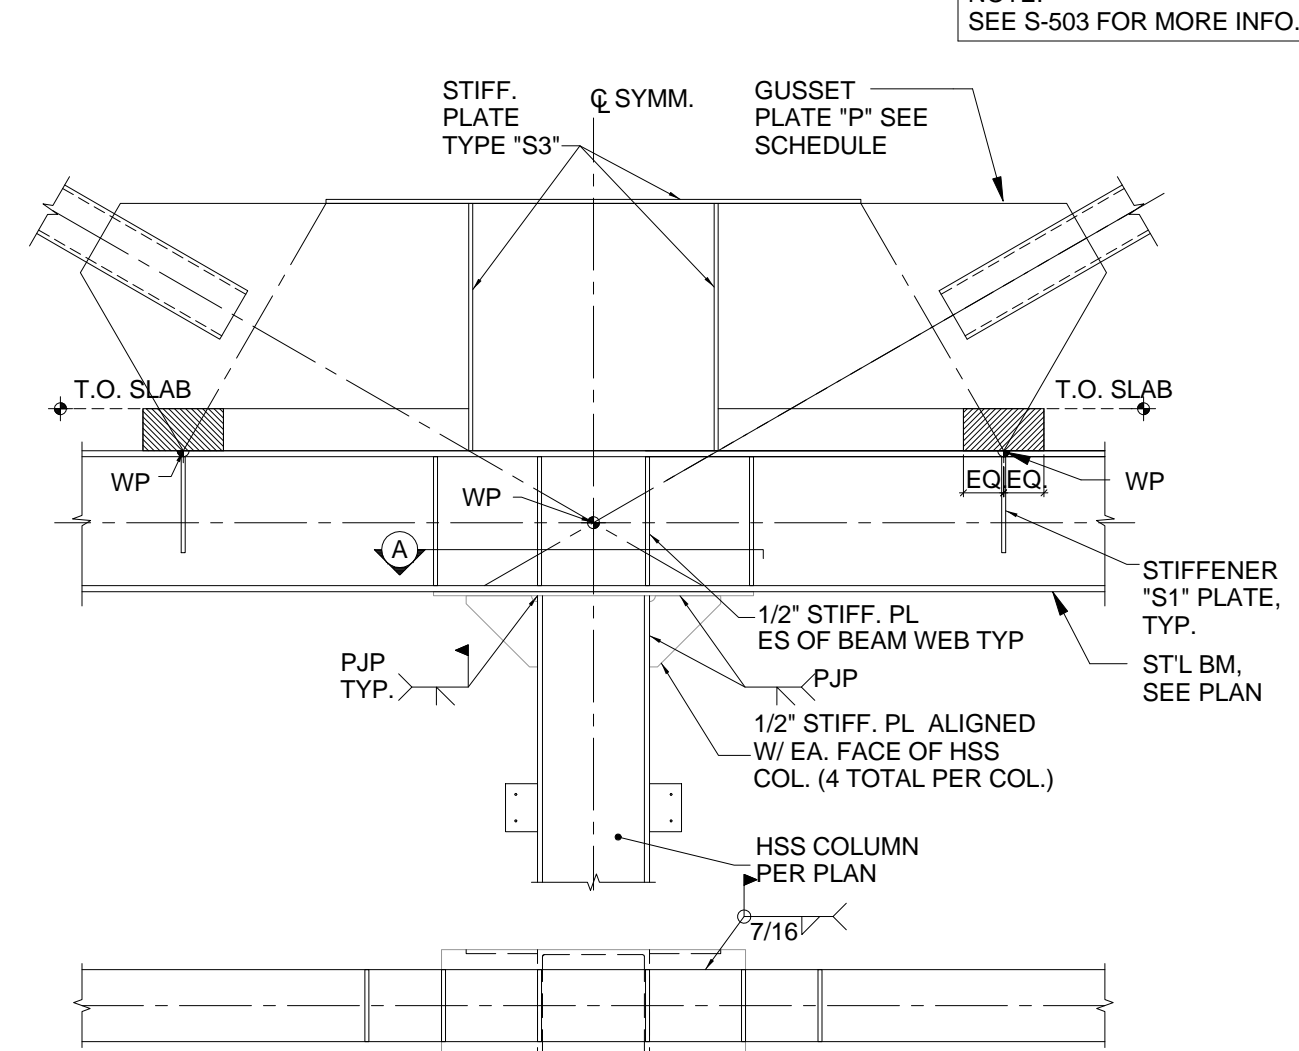



9 CONNECTION DETAIL  
SCALE: 1/2" = 1'-0"

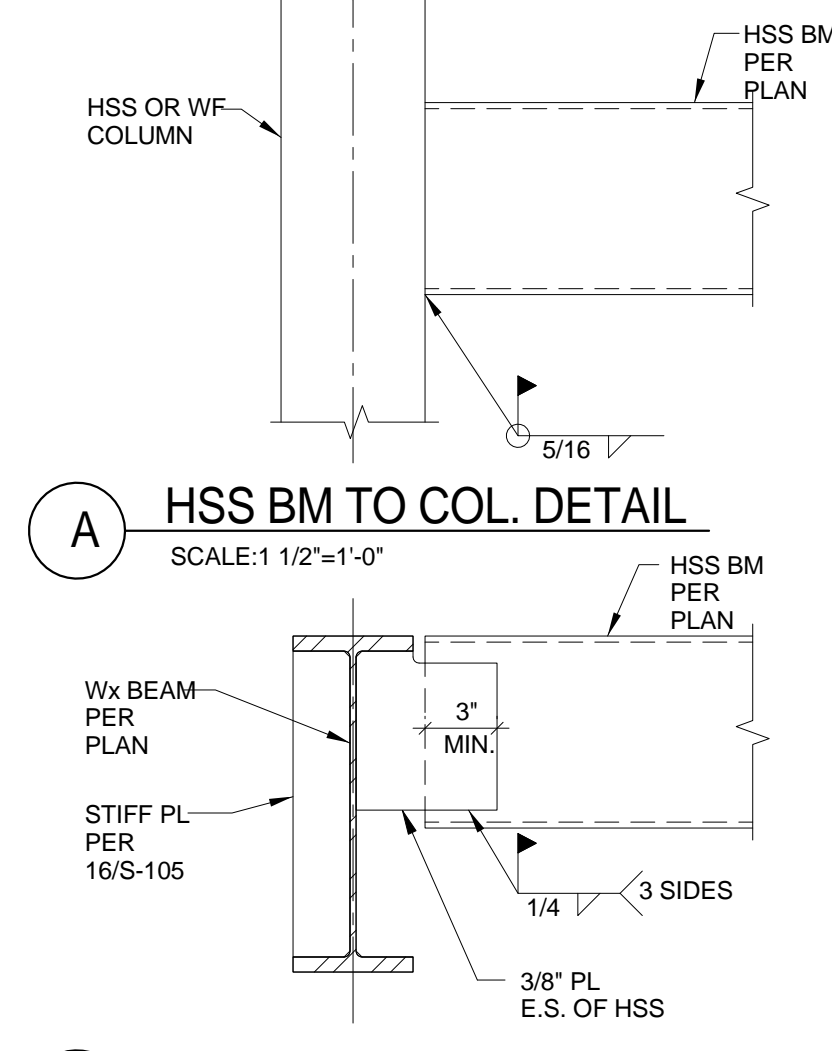


5 SECTIONS  
SCALE: 1 1/2" = 1'-0"

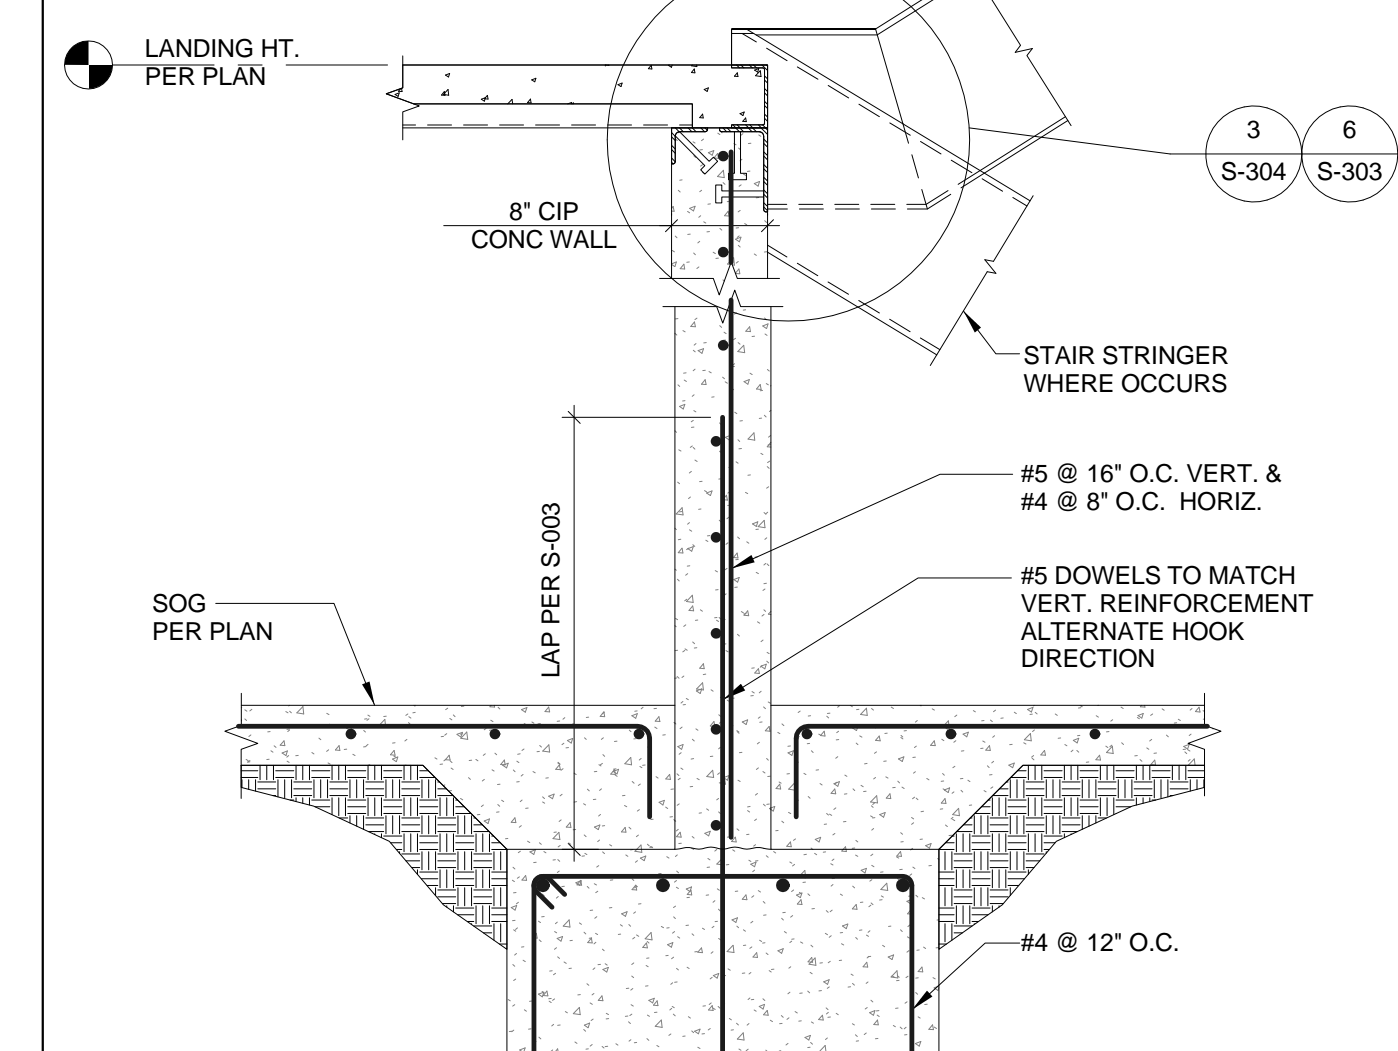


1 SECTION @ STAIR LANDING  
SCALE: 3/4" = 1'-0"

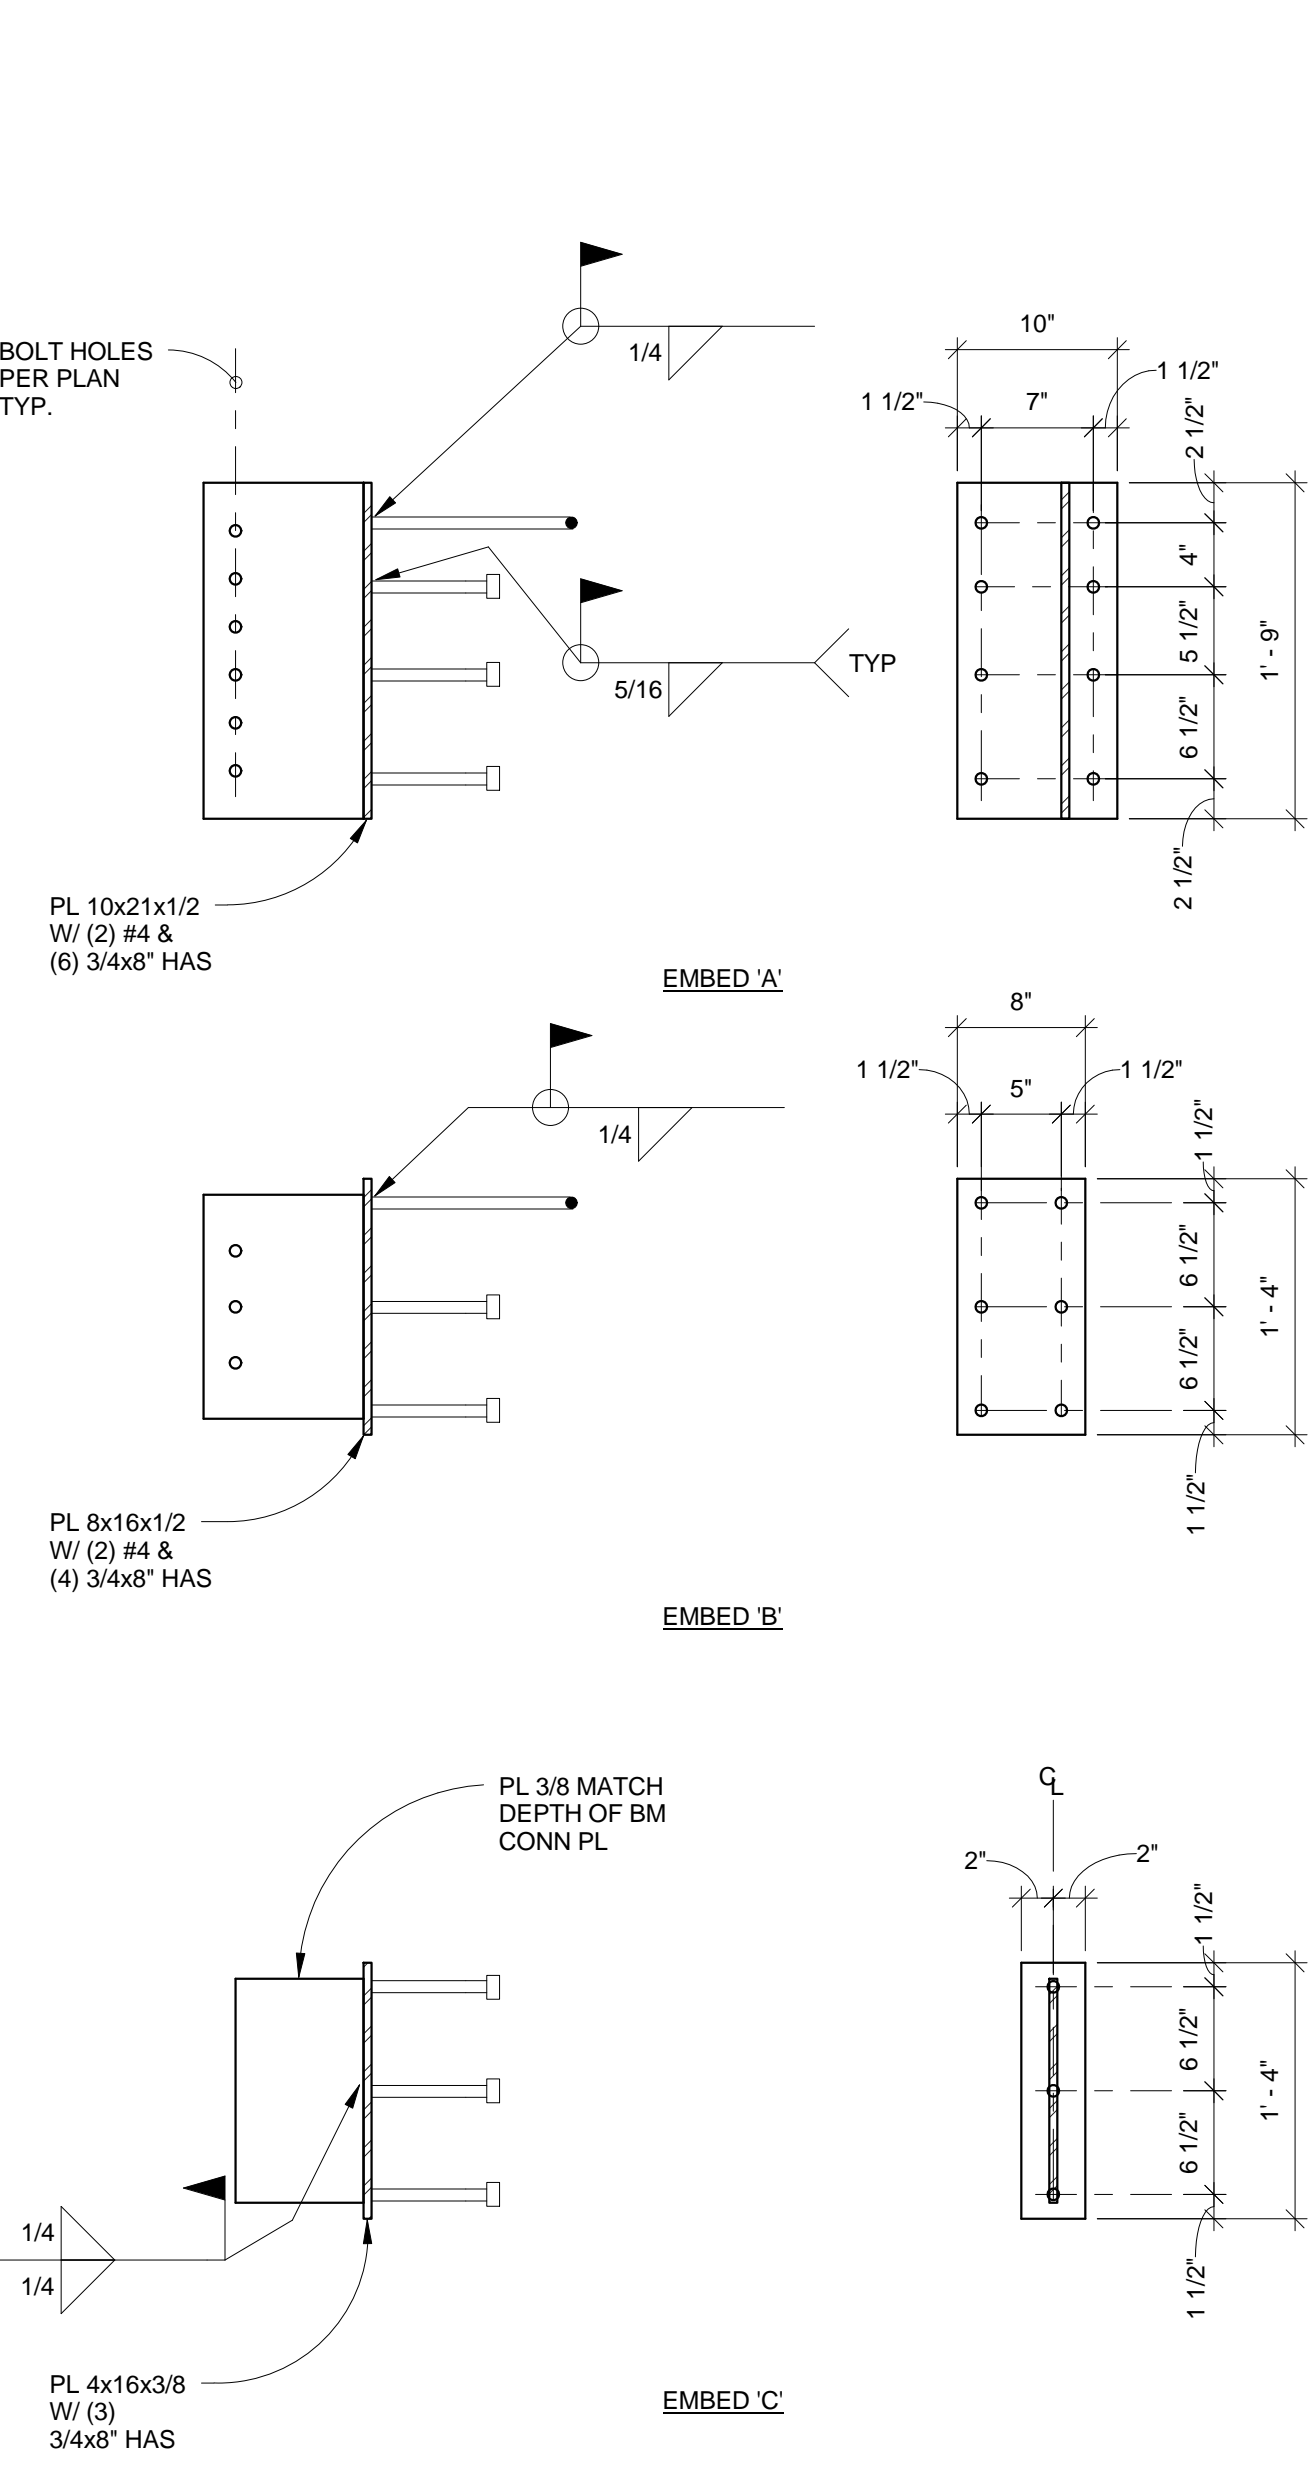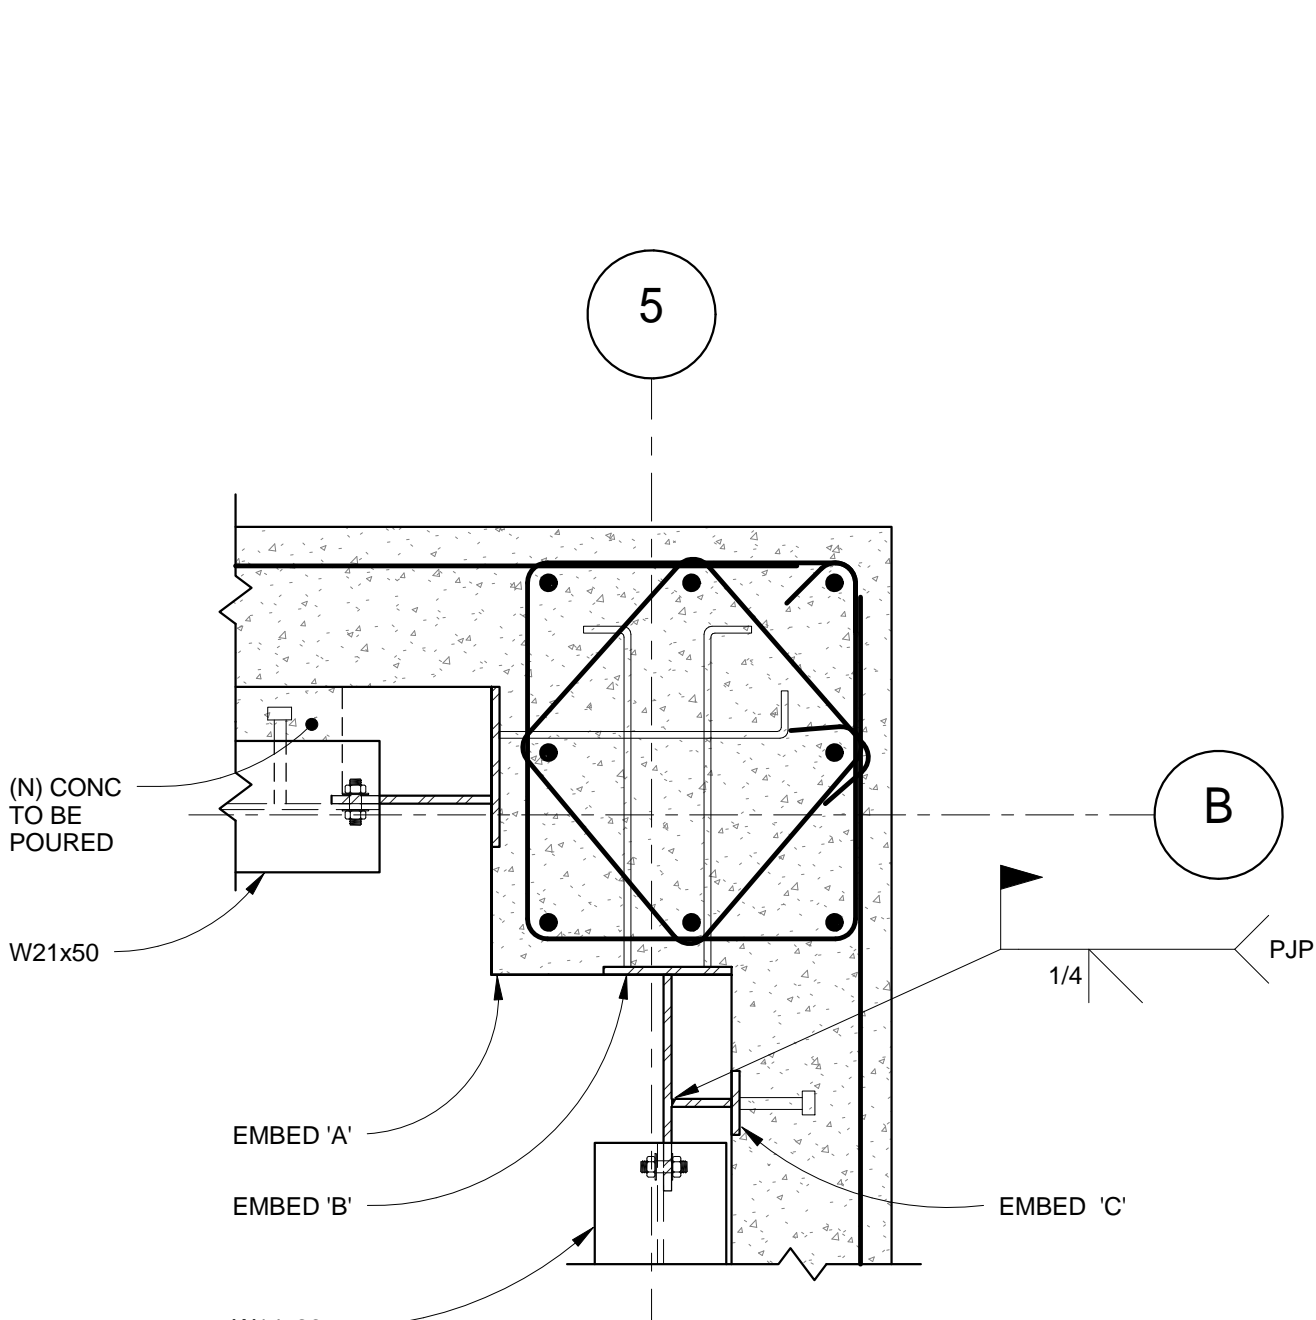


20 CONN @ B/5 PILASTER  
SCALE: 1" = 1'-0"

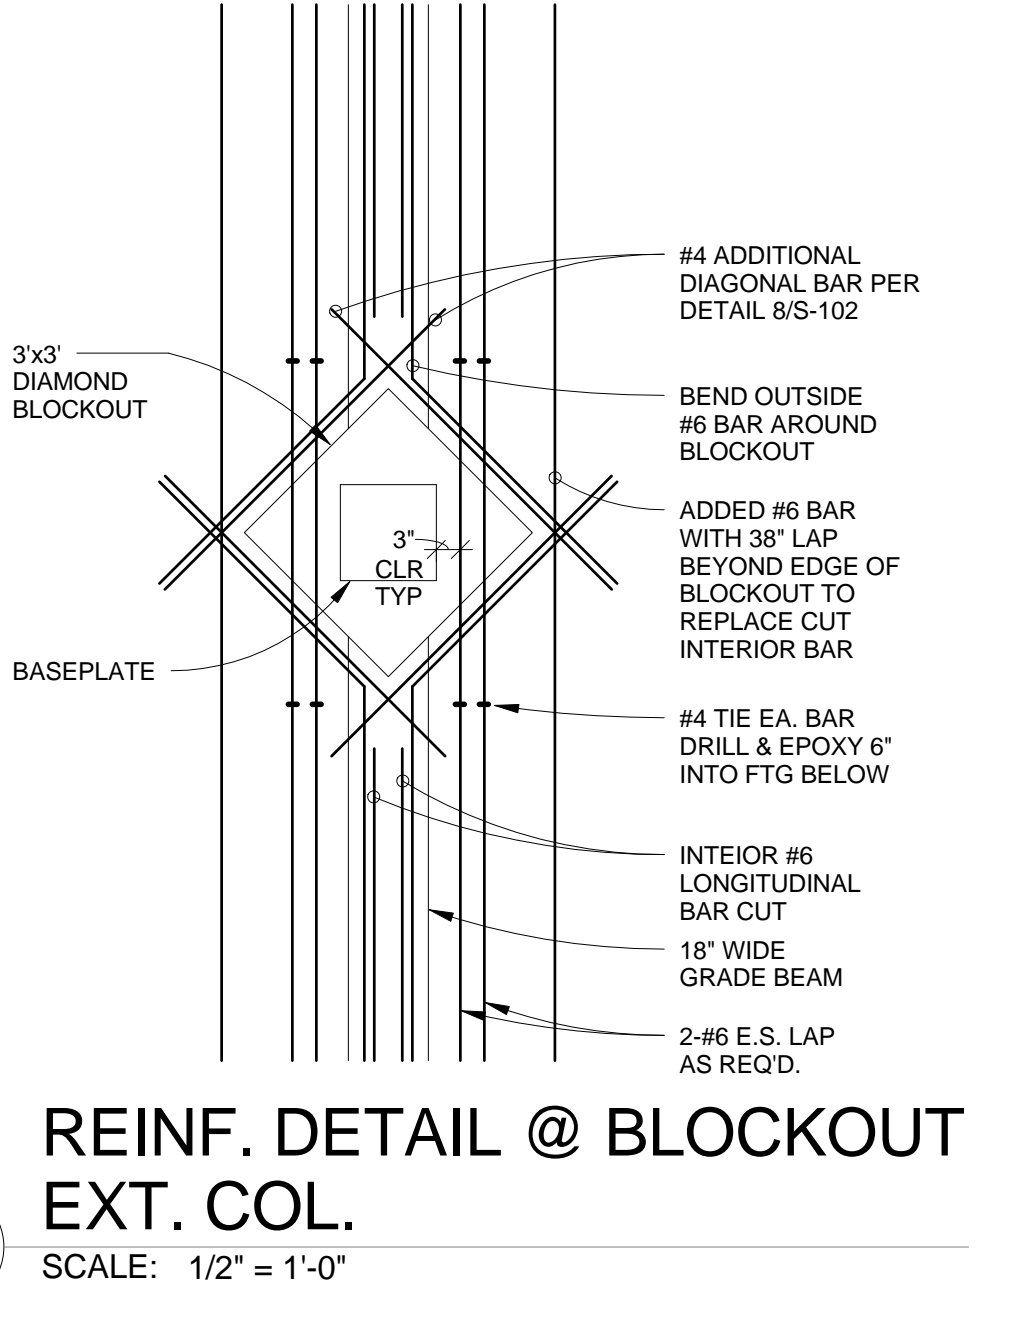


14 REINF. DETAIL @ BLOCKOUT  
EXT. COL.  
SCALE: 1/2" = 1'-0"

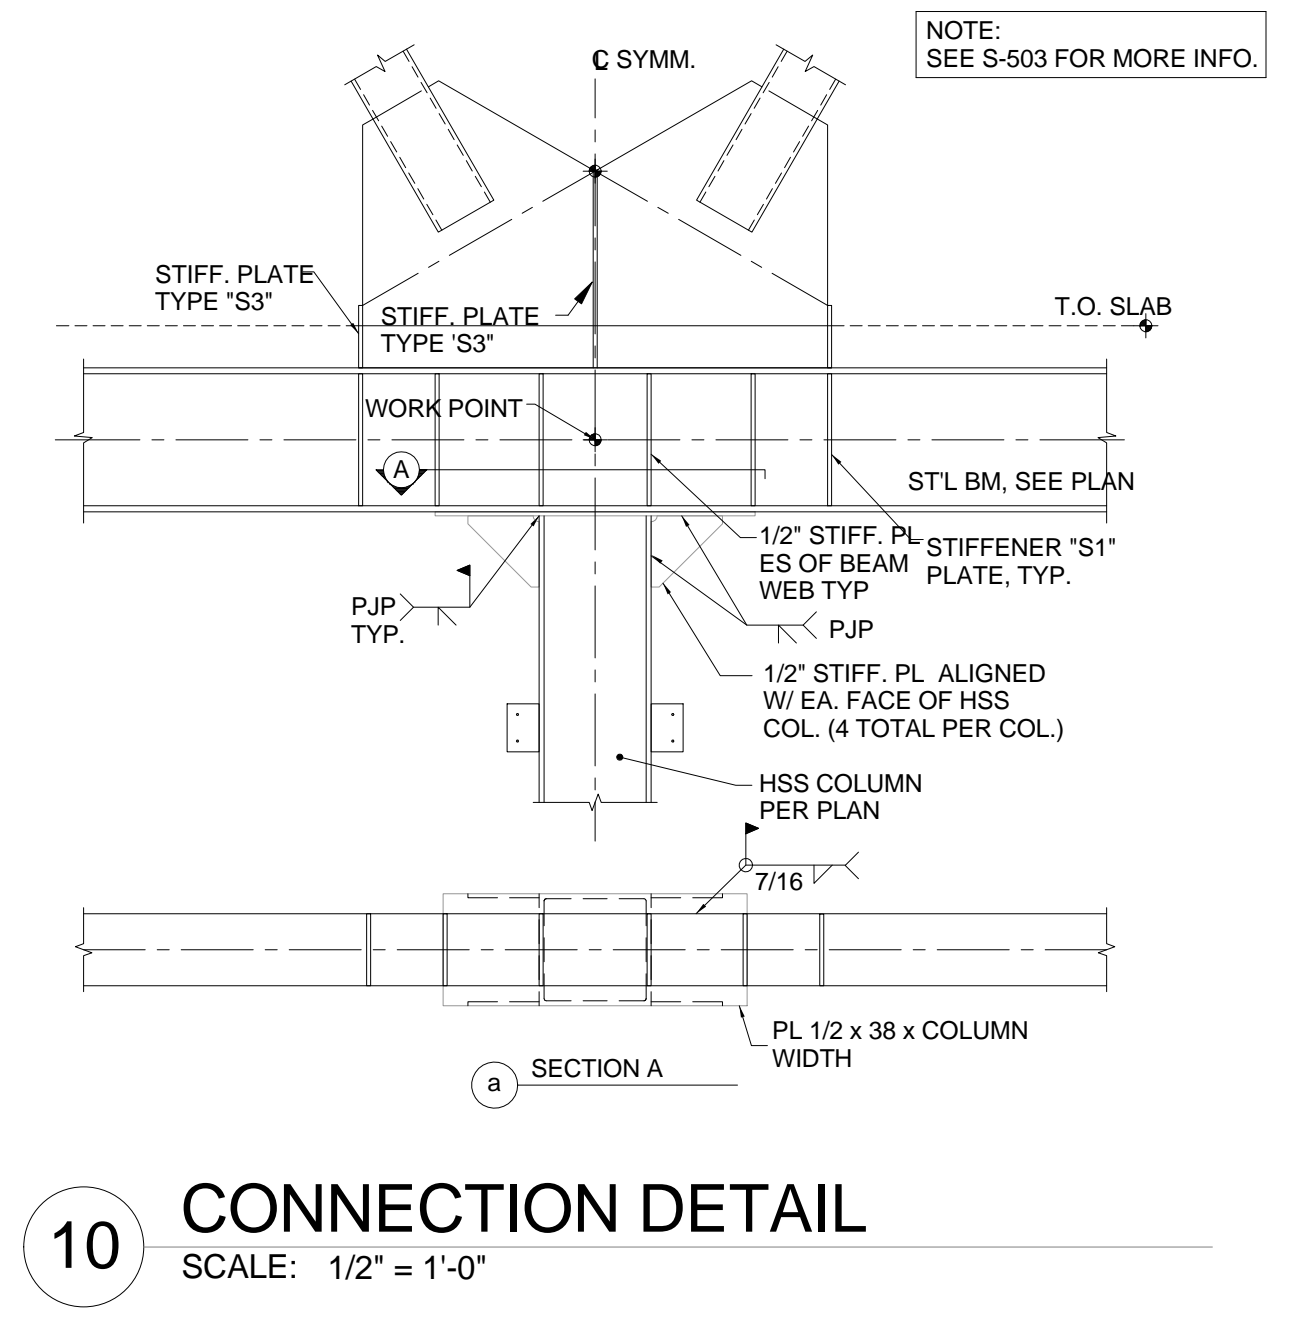


10 CONNECTION DETAIL  
SCALE: 1/2" = 1'-0"

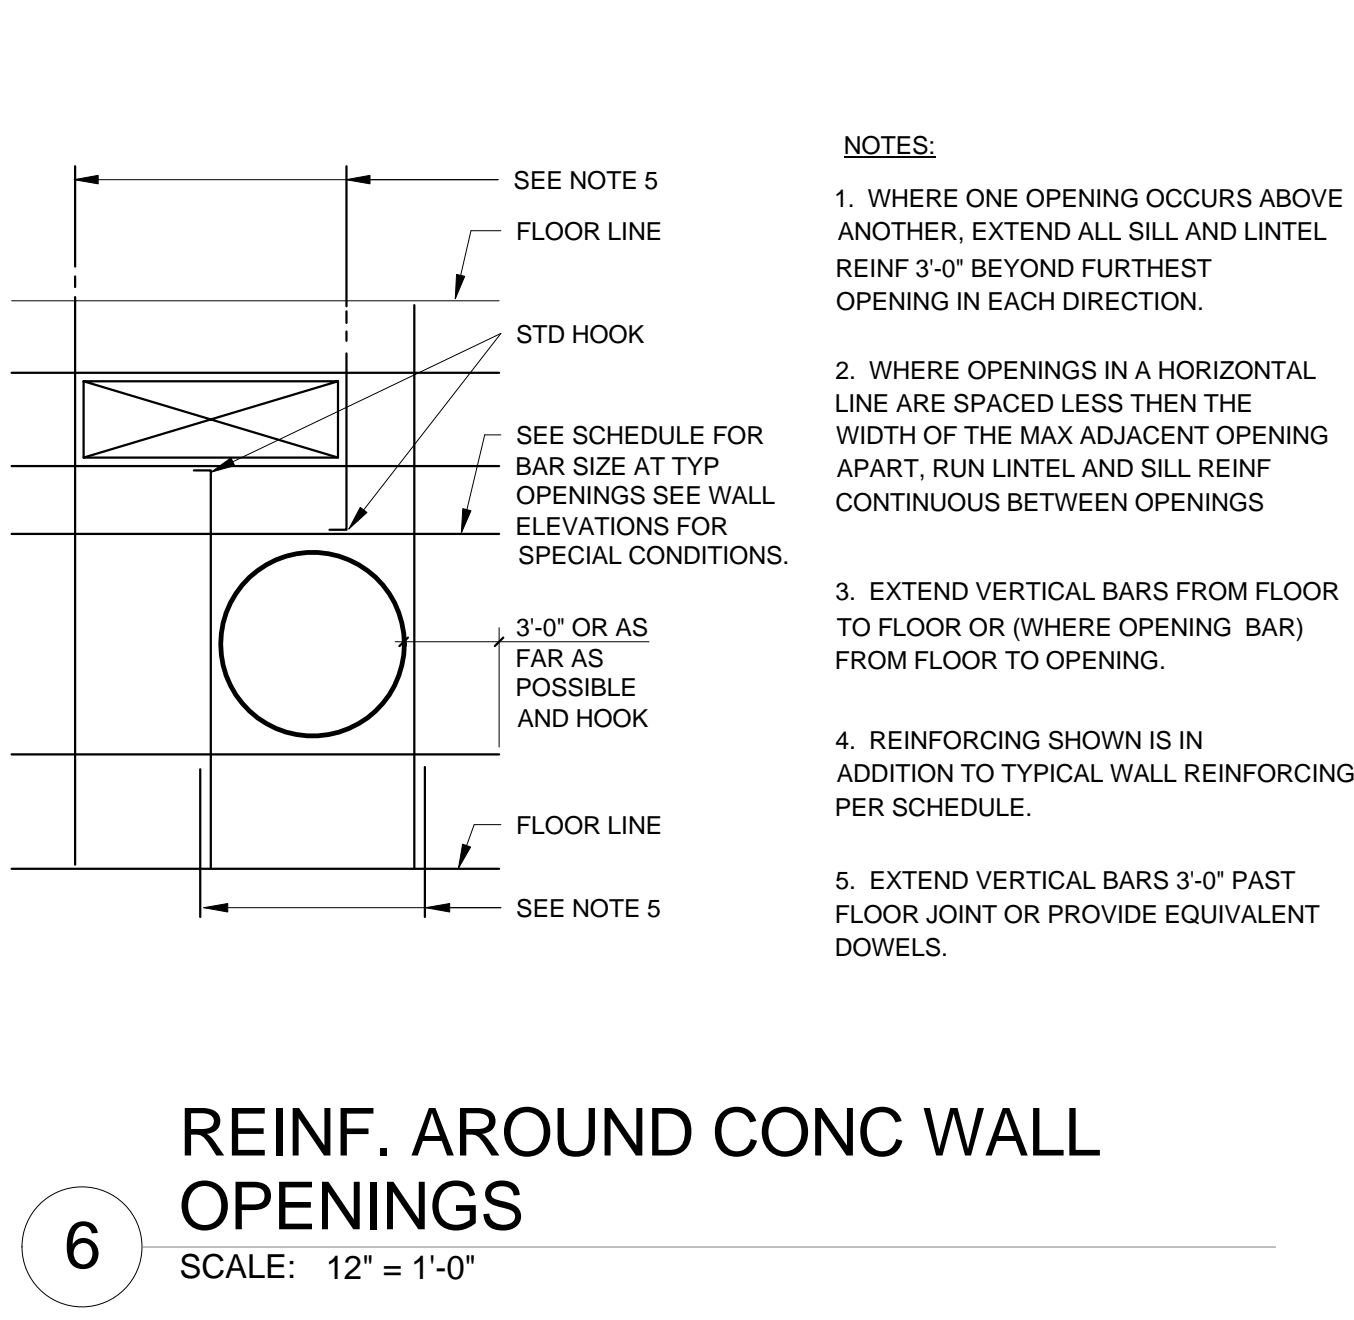


6 REINF. AROUND CONC WALL  
OPENINGS  
SCALE: 12" = 1'-0"

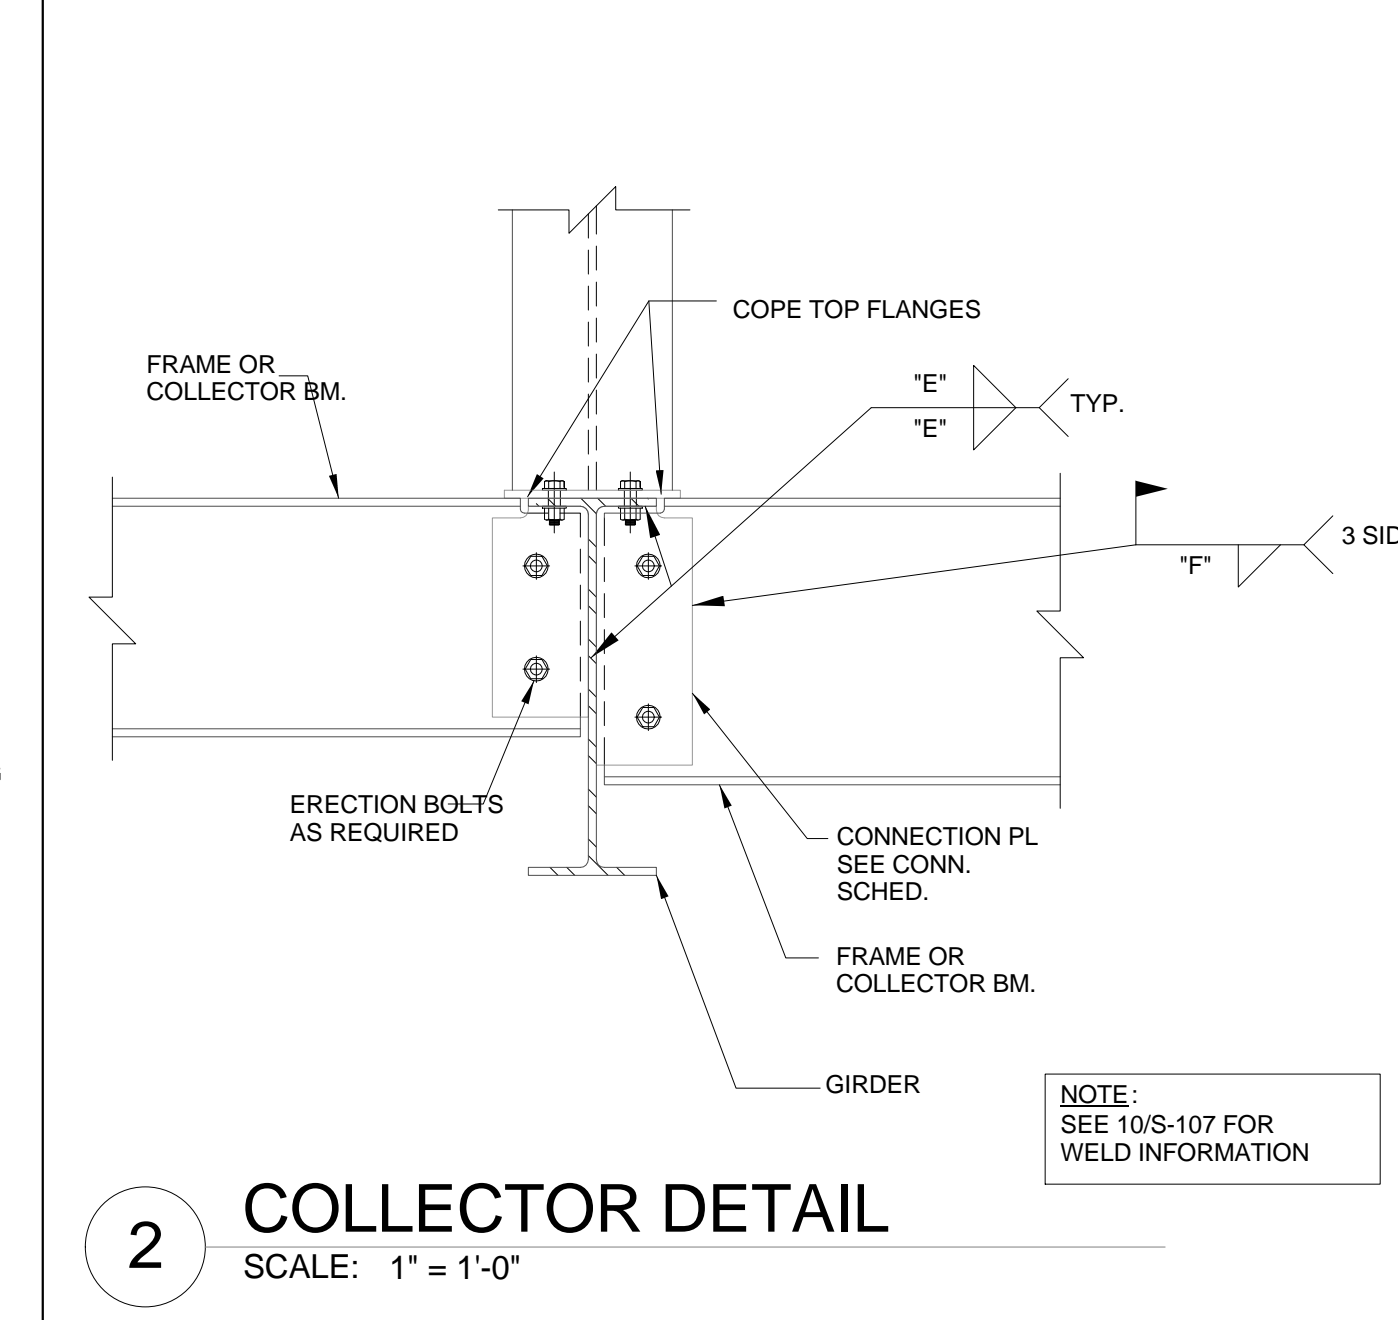


2 COLLECTOR DETAIL  
SCALE: 1" = 1'-0"

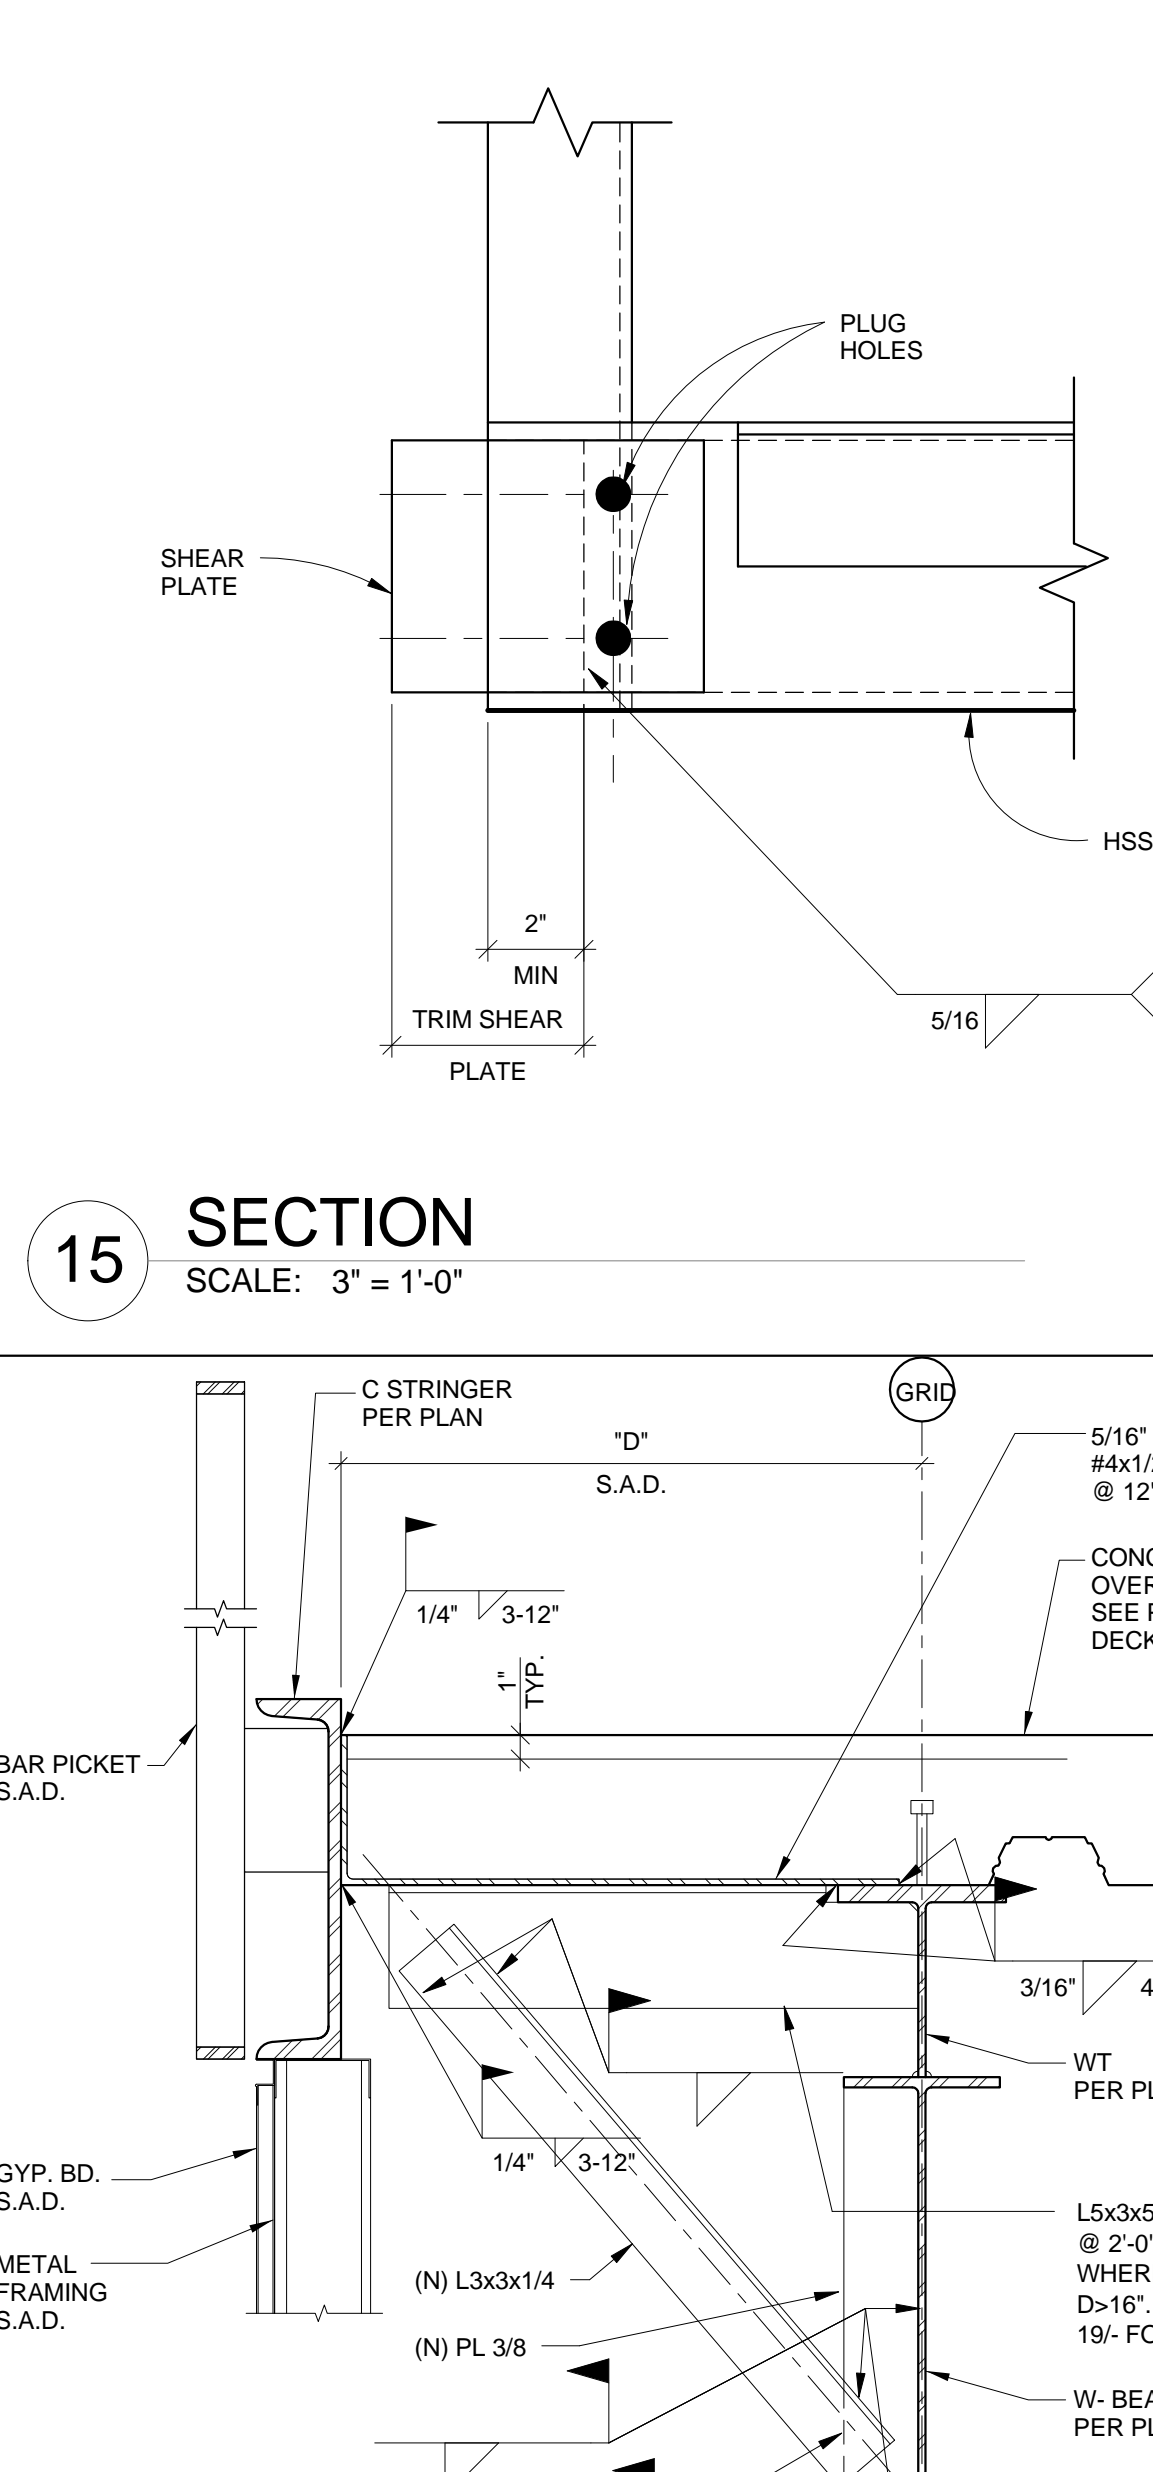


15 SECTION  
SCALE: 3" = 1'-0"

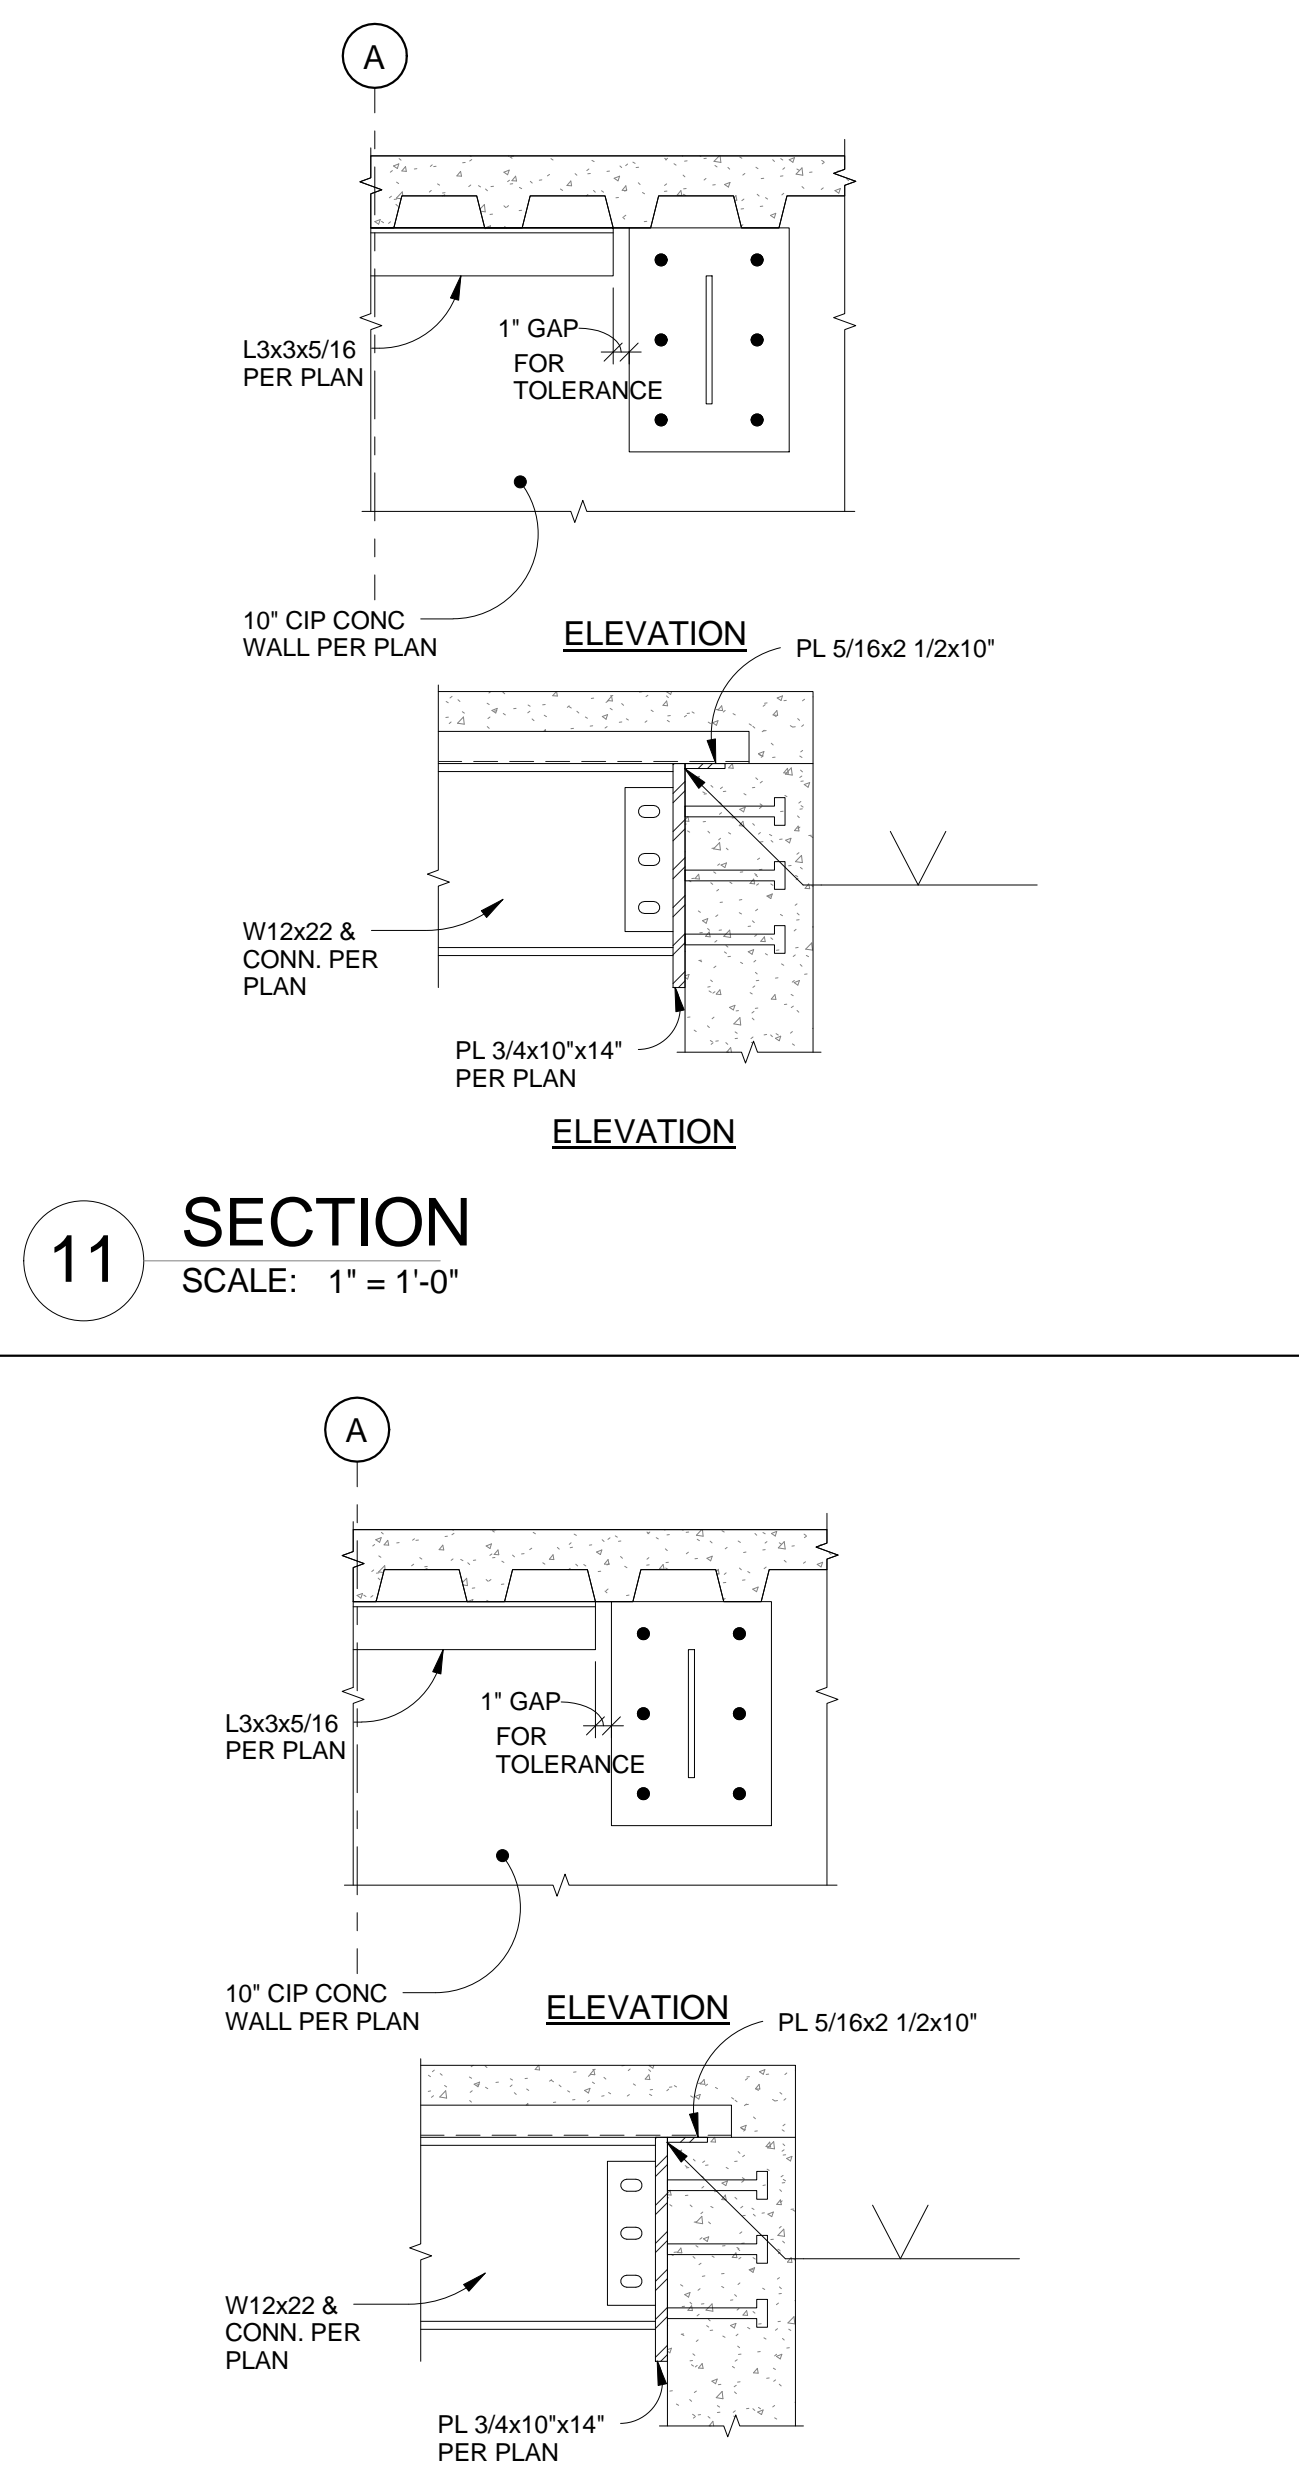

11 SECTION  
SCALE: 1" = 1'-0"

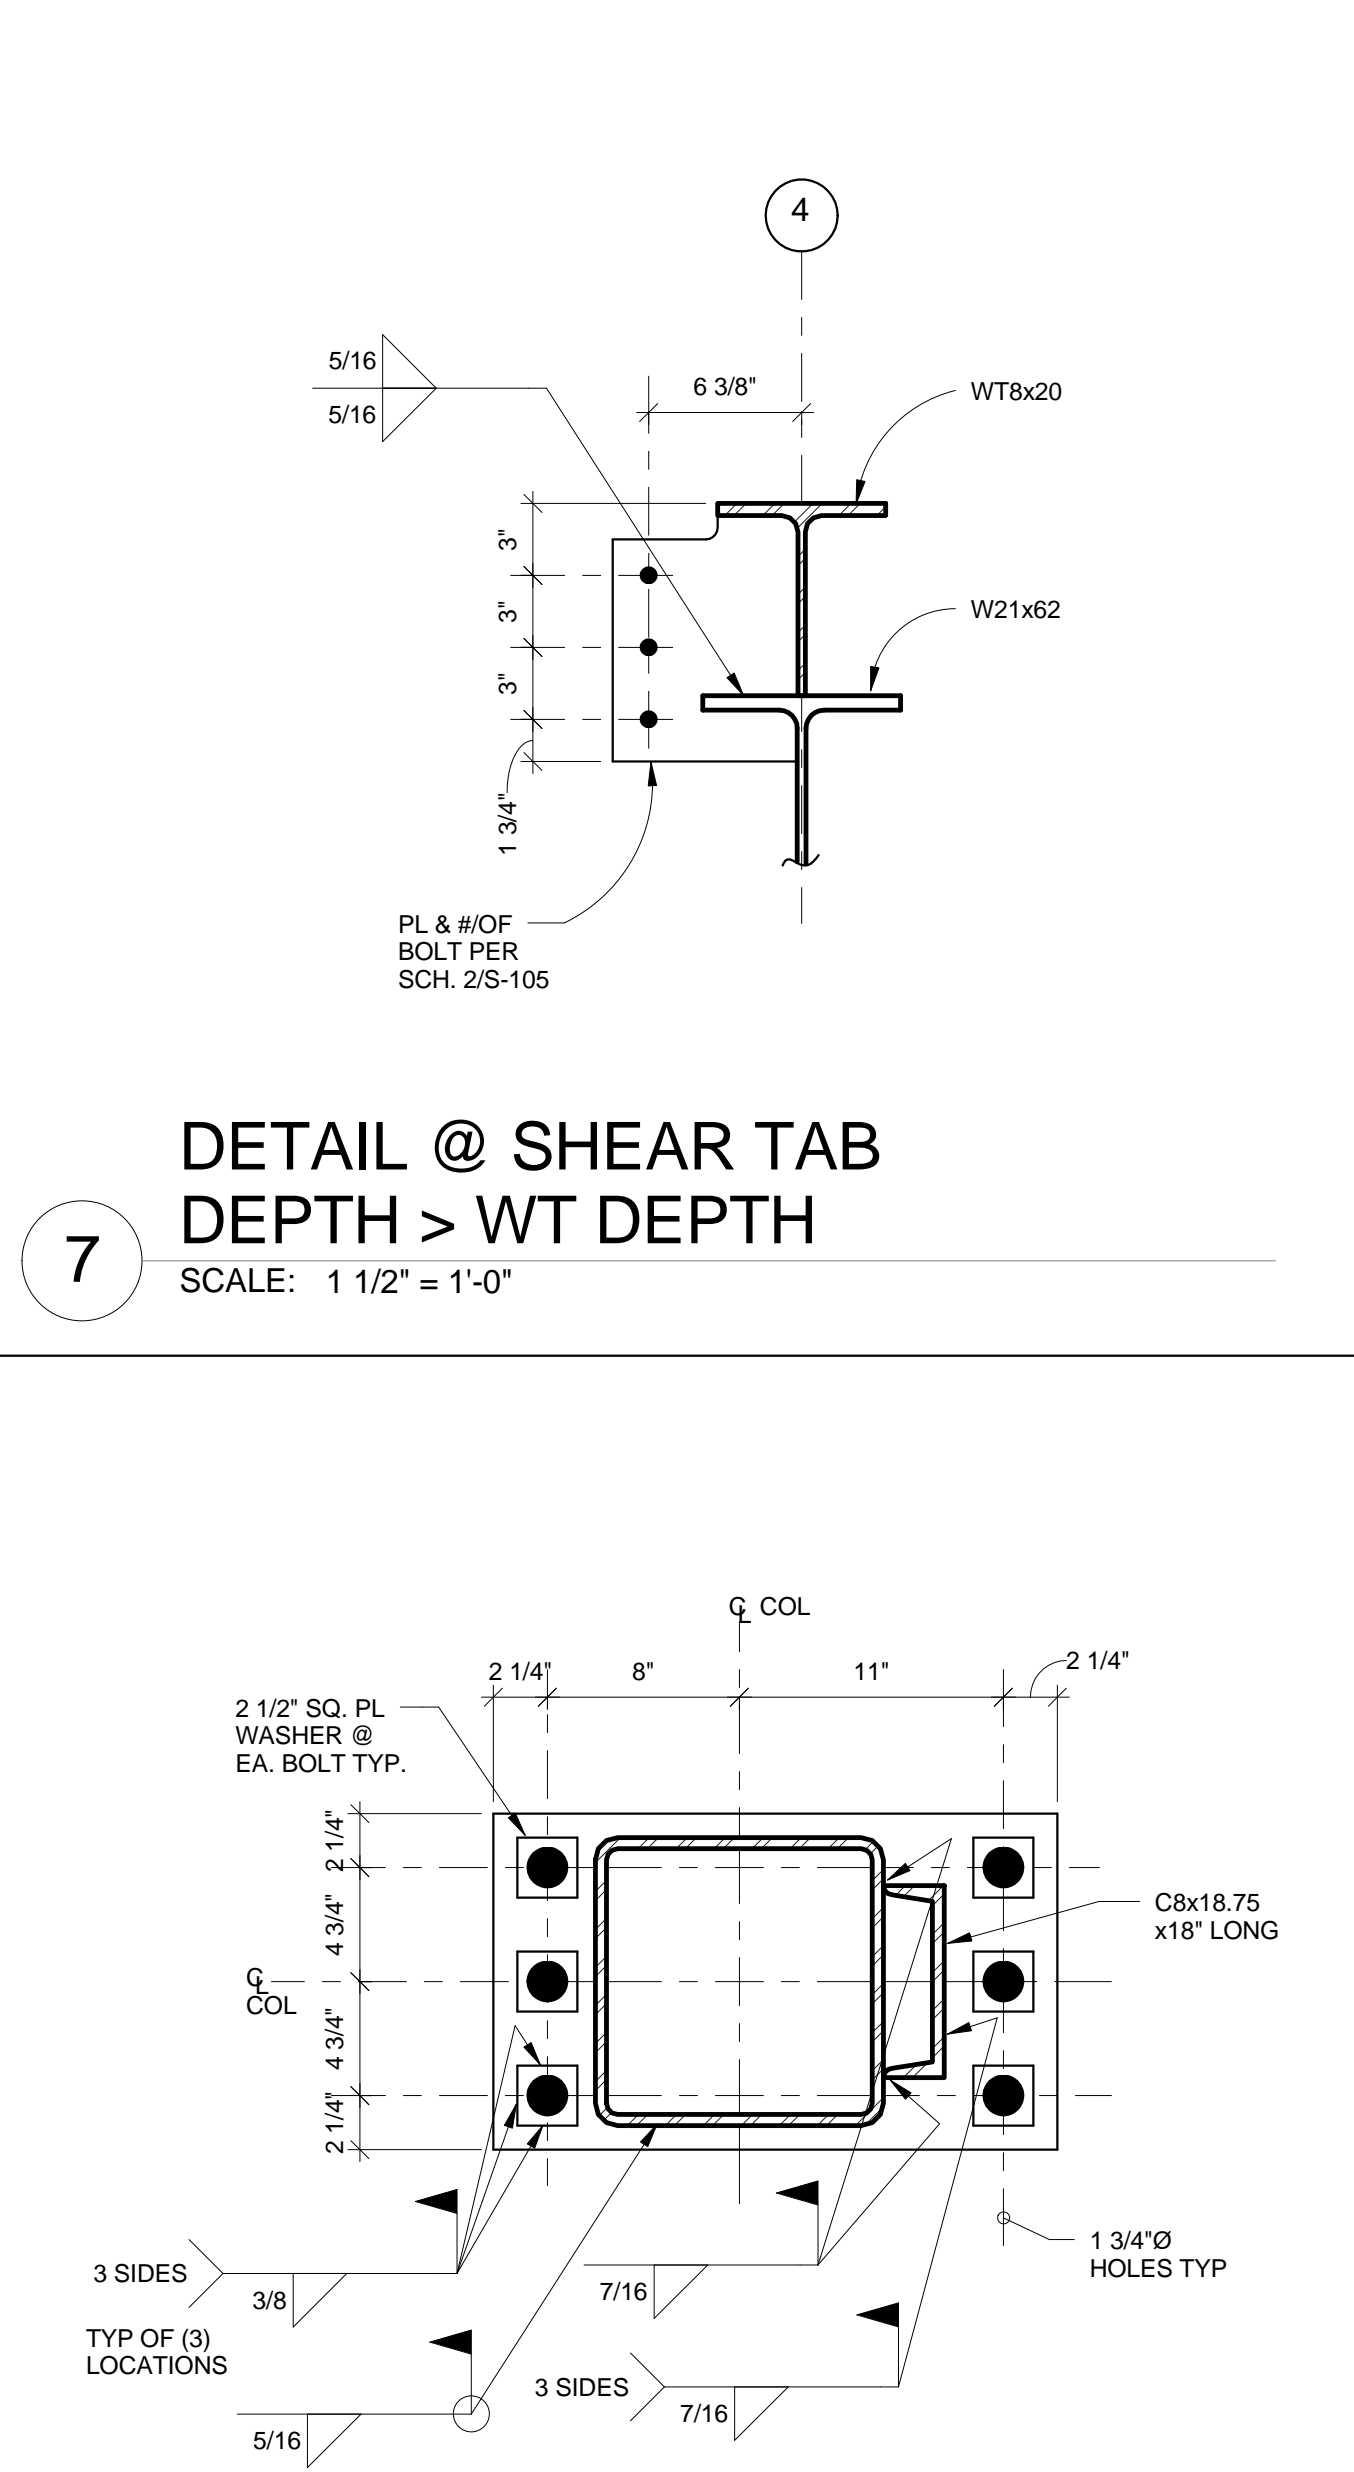

7 DETAIL @ SHEAR TAB  
DEPTH > WT DEPTH  
SCALE: 1 1/2" = 1'-0"

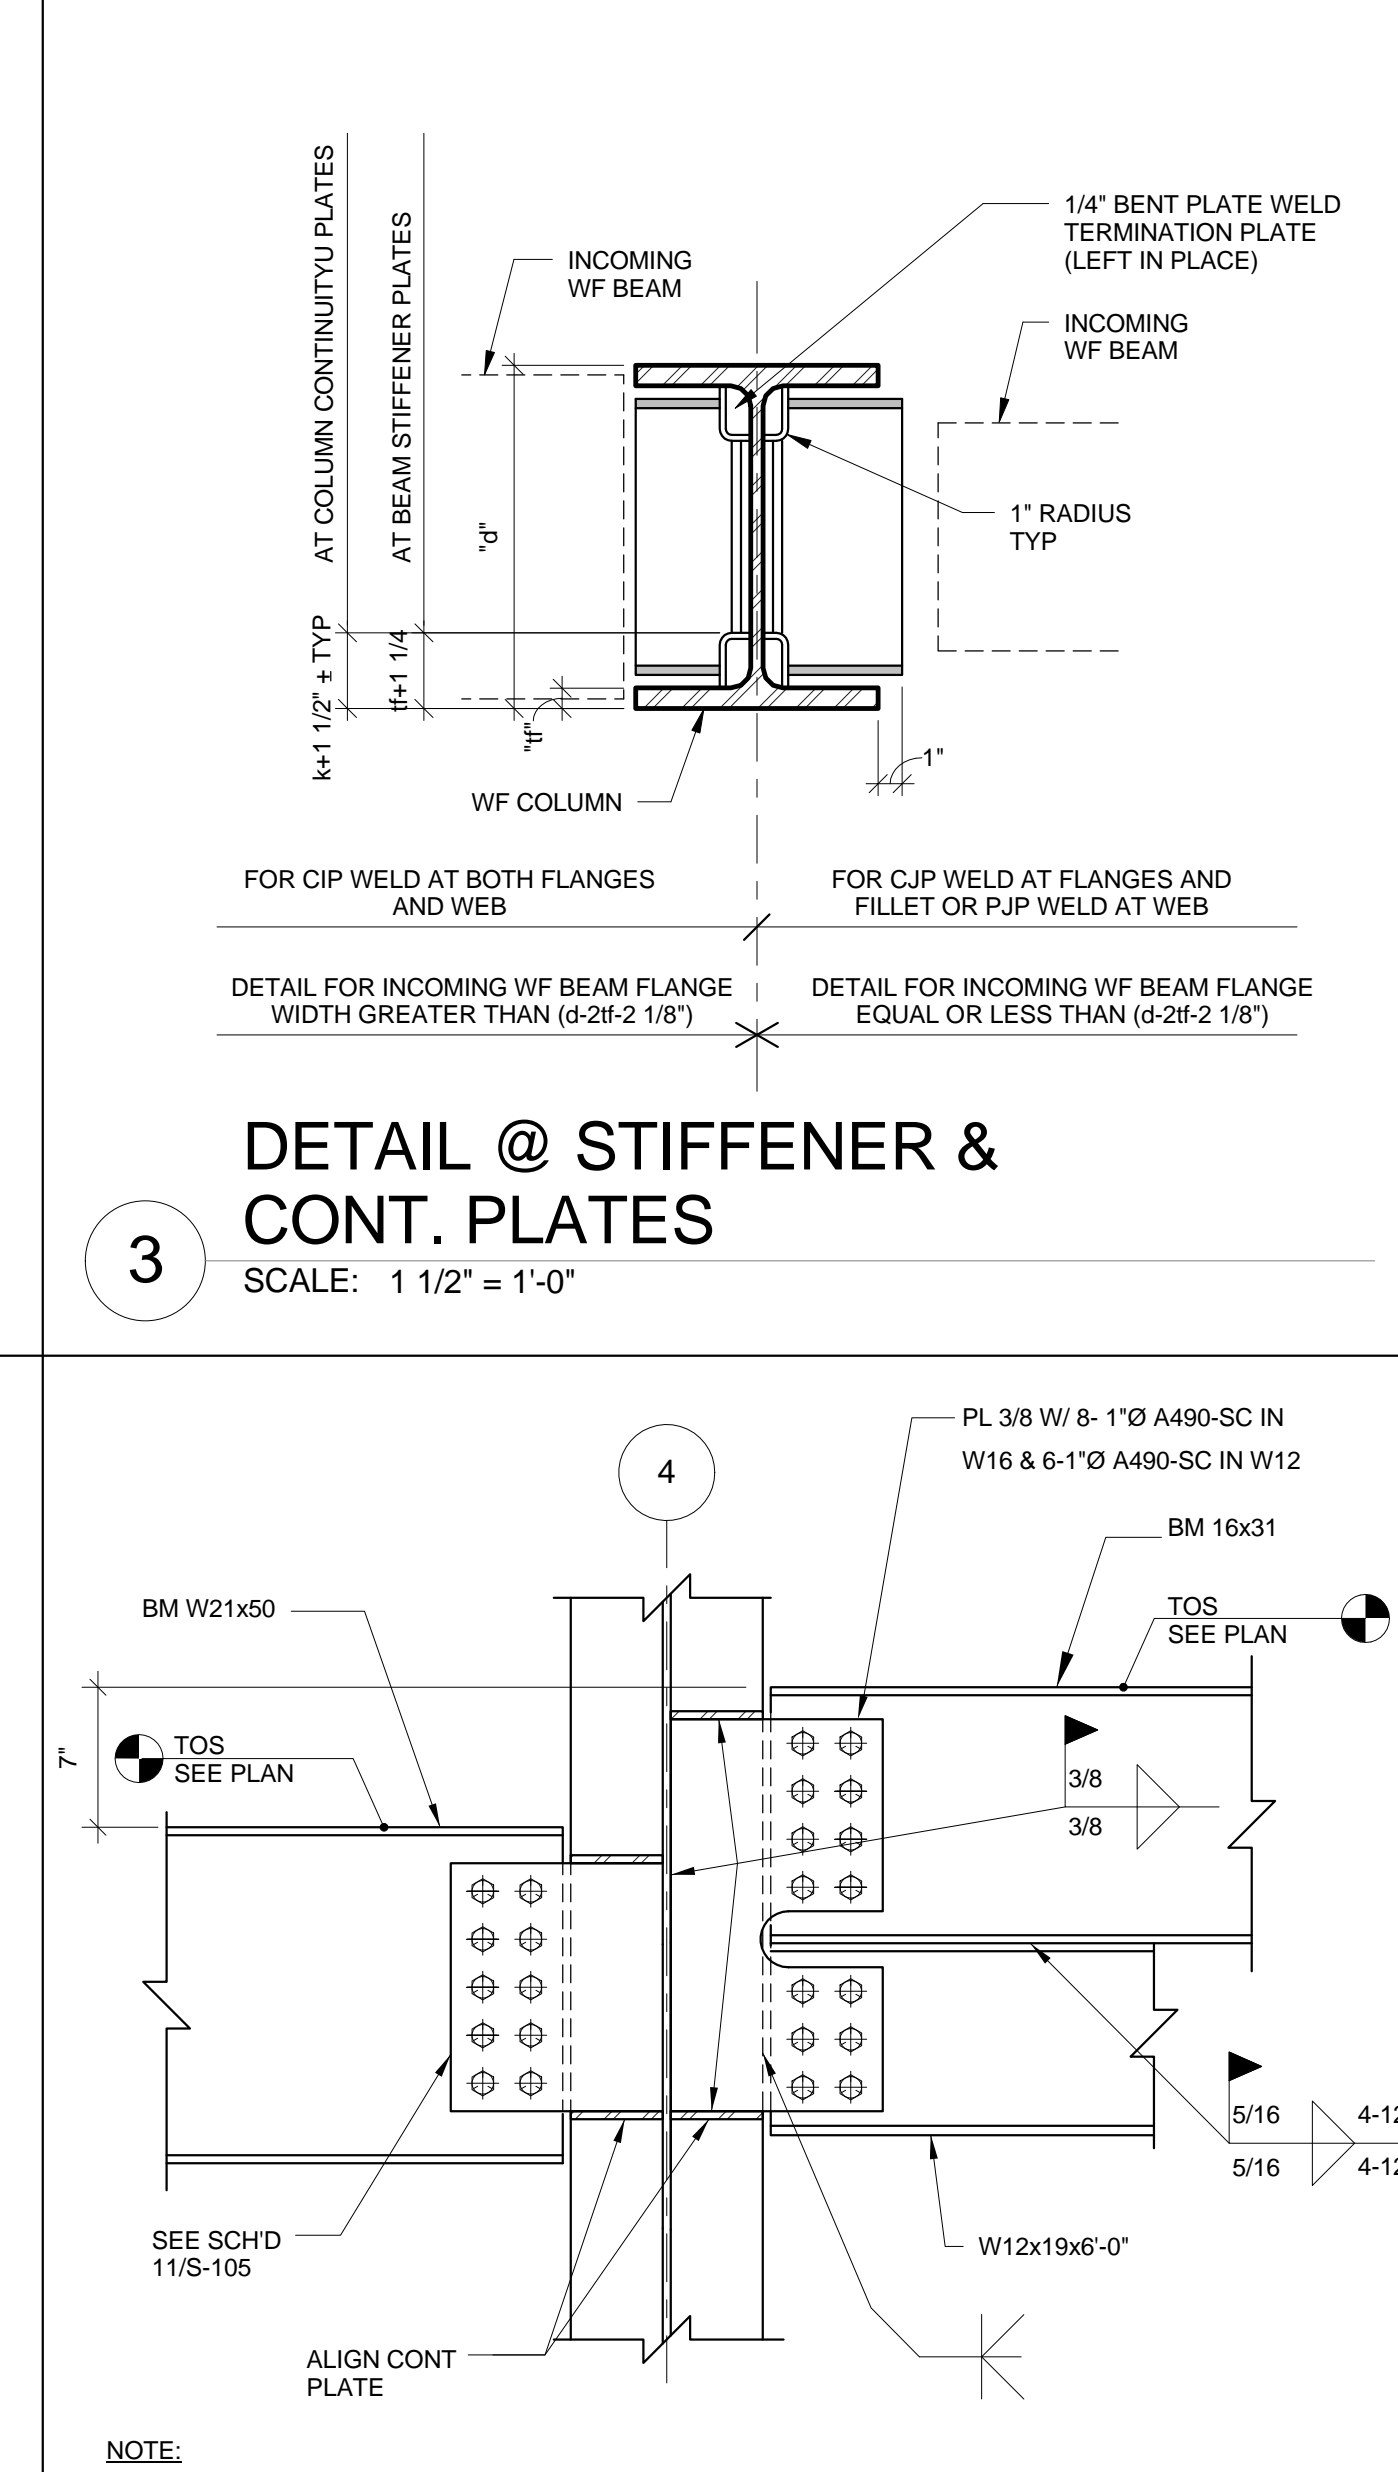


3 DETAIL @ STIFFENER &  
CONT. PLATES  
SCALE: 1 1/2" = 1'-0"

12 SECTION  
SCALE: 1" = 1'-0"


8 COLUMN BASE @ GRID A/6.5  
SCALE: 1 1/2" = 1'-0"

4 COLLECTOR CONN.  
SCALE: 1" = 1'-0"




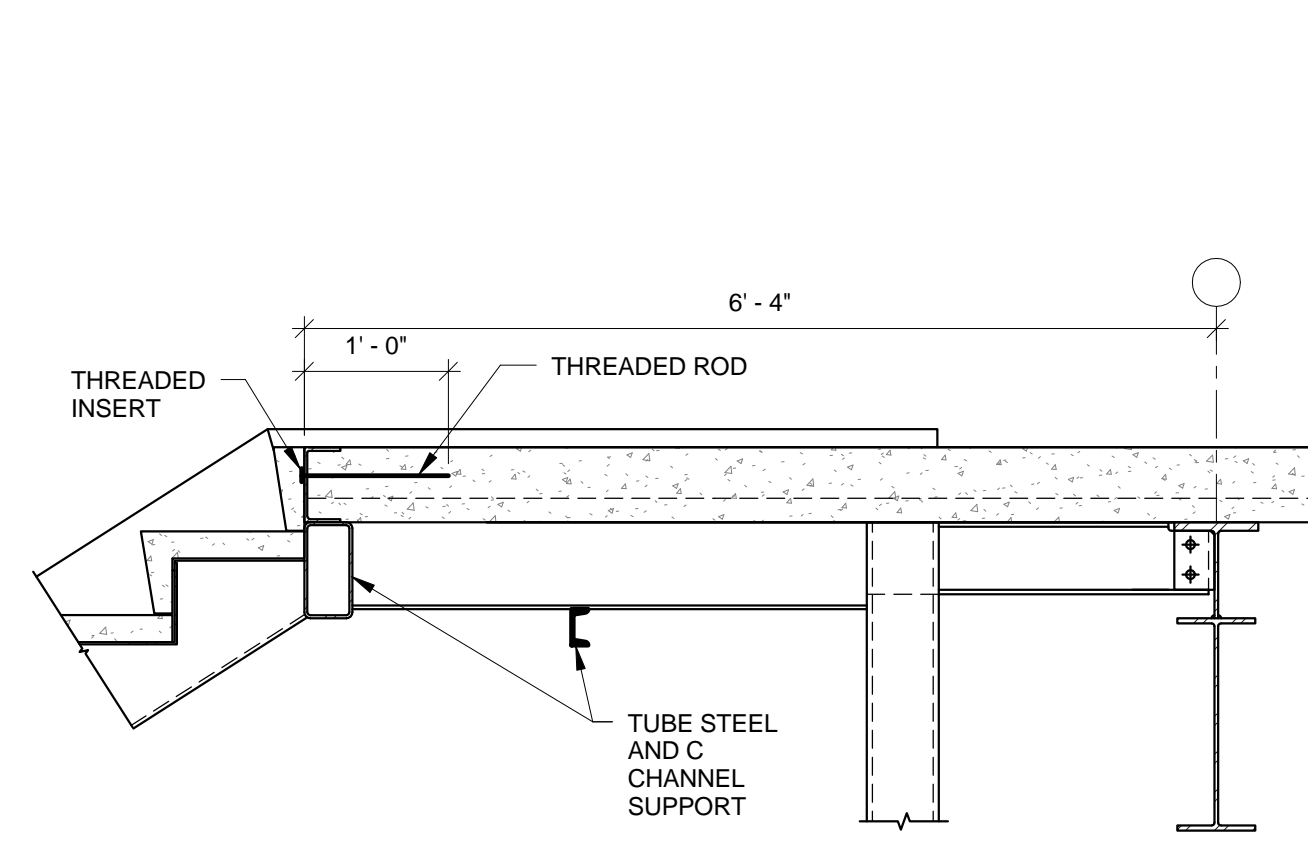


9 SECTION  
SCALE: 3/4" = 1'-0"

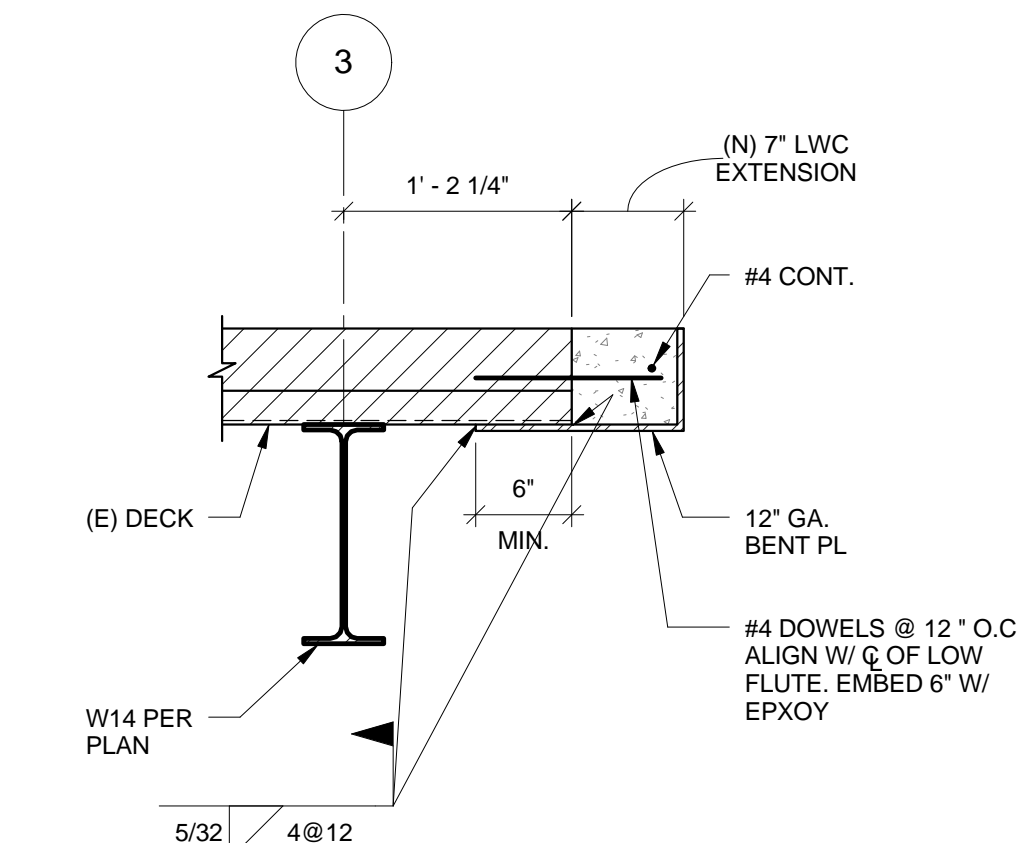


5 SECTION  
SCALE: 1" = 1'-0"

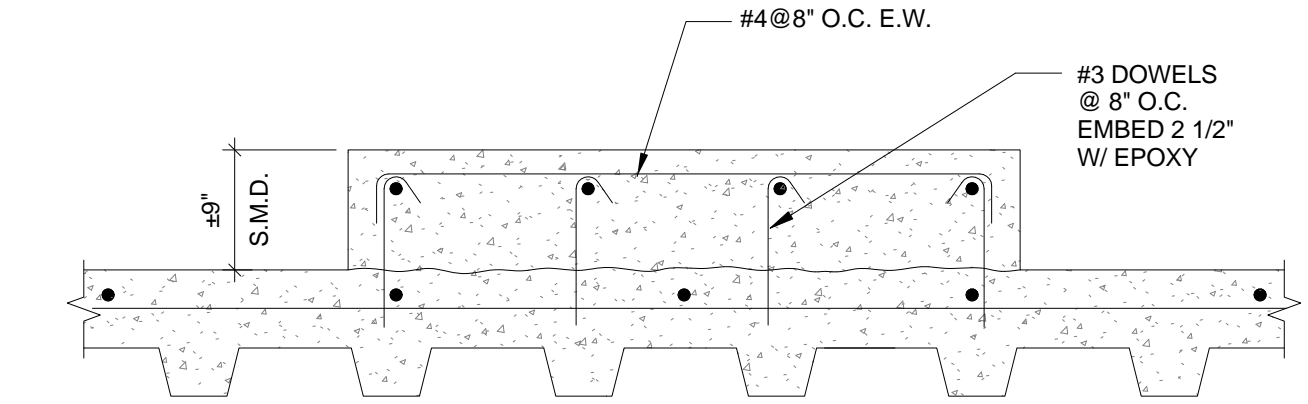


1 DETAIL @ RAISED EQUIP. PAD  
SCALE: 1 1/2" = 1'-0"

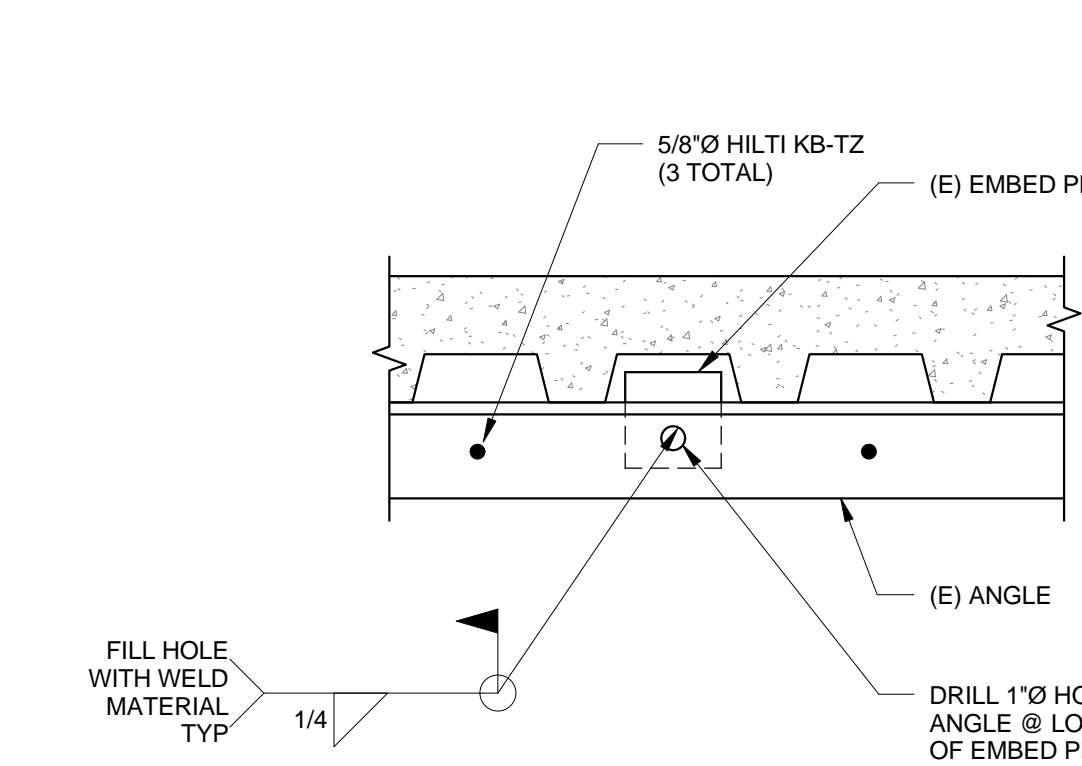


10 DETAIL @ SLAB SUPPORT - LEVEL 1.5  
SCALE: 1 1/2" = 1'-0"

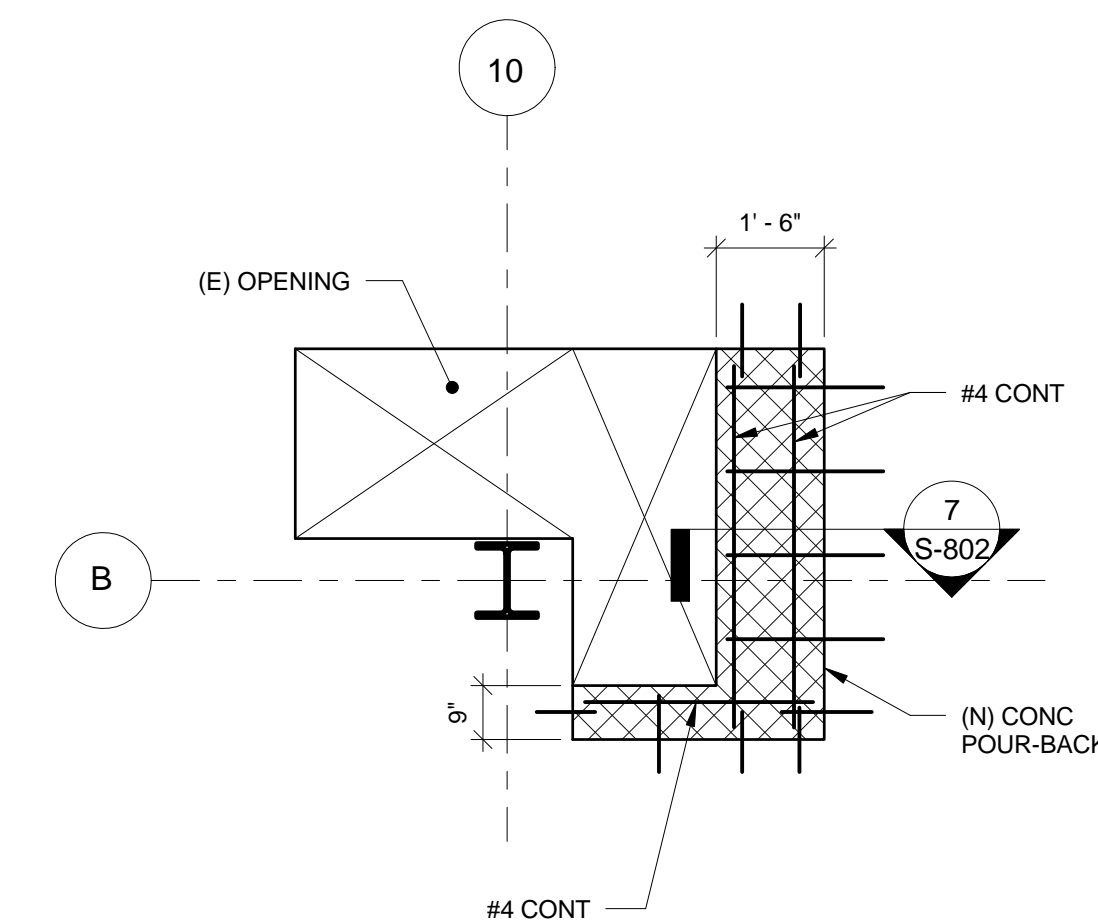


6 PARTIAL PLAN @ B/10  
SCALE: 3/8" = 1'-0"

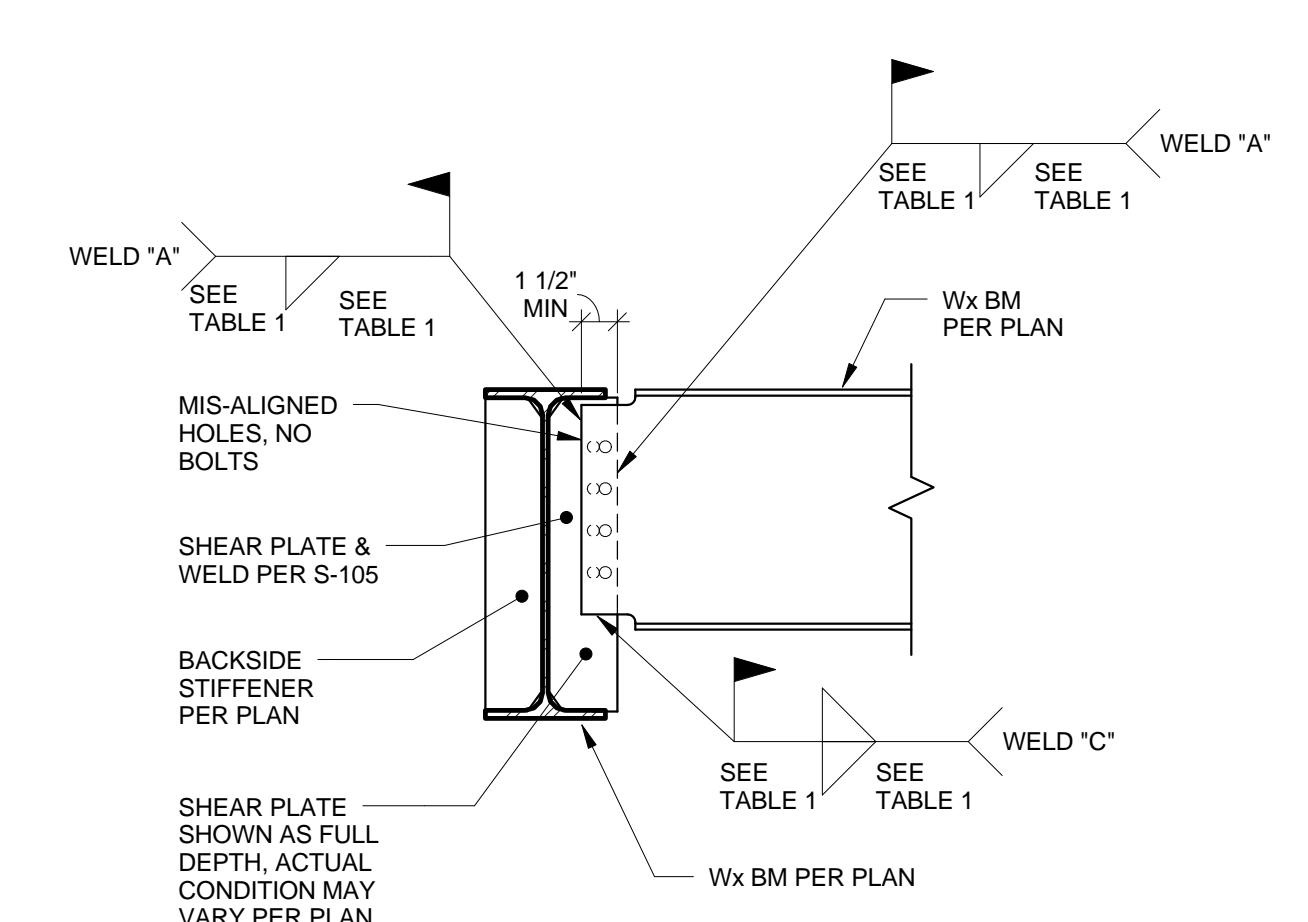


3 WELDED BM. CONN.  
SCALE: 1 1/2" = 1'-0"

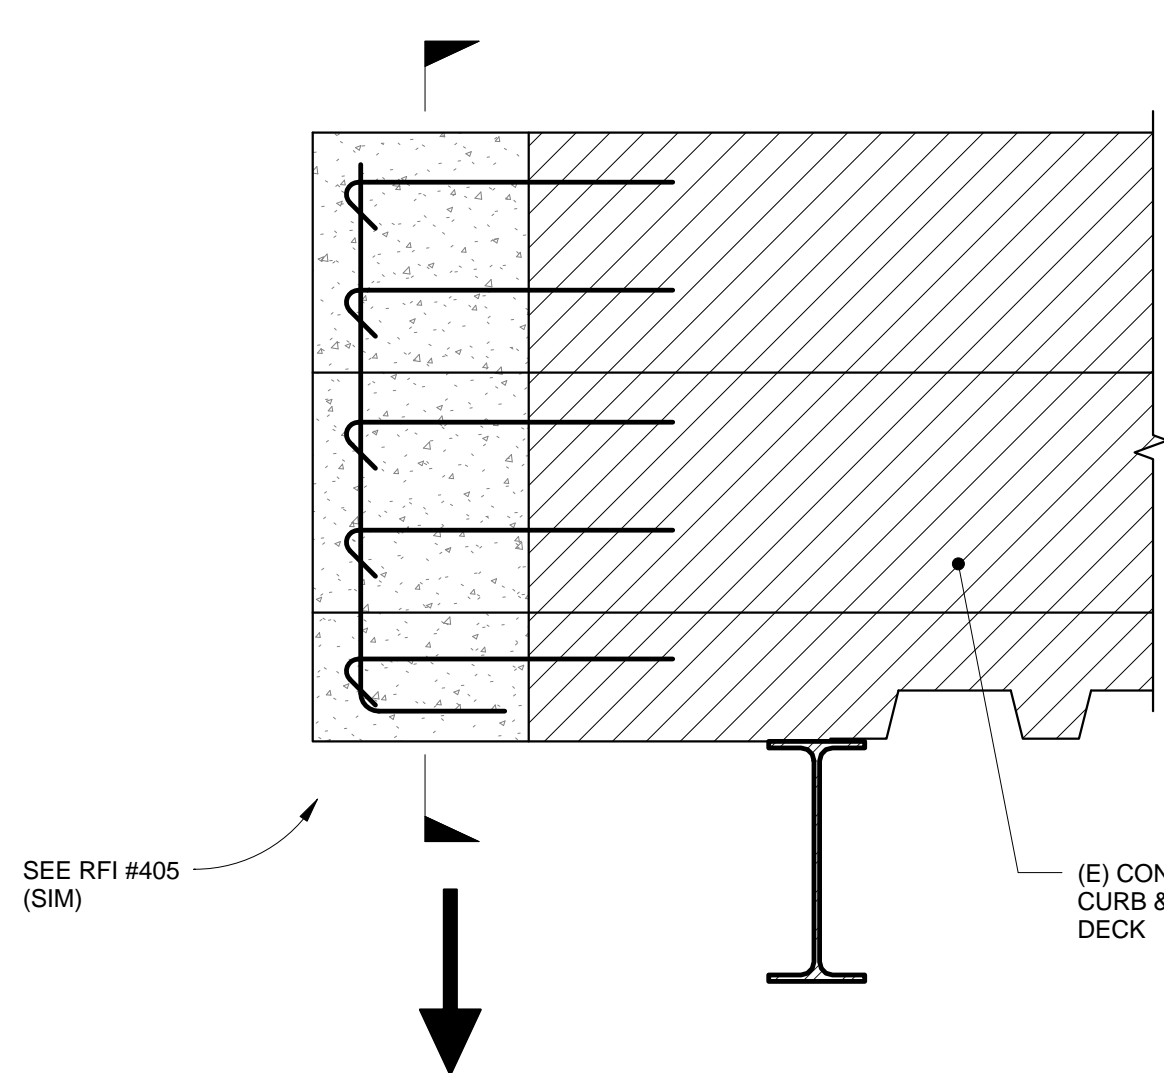


12 SECTION  
SCALE: 1 1/2" = 1'-0"

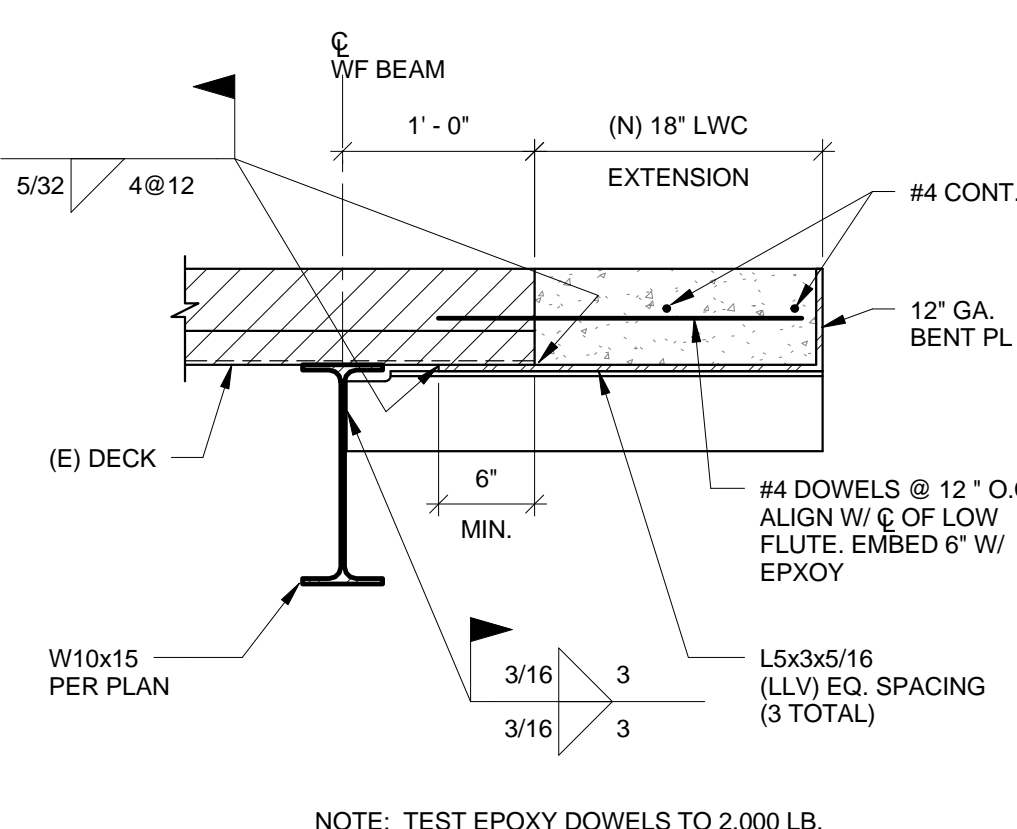


7 SECTION  
SCALE: 1" = 1'-0"

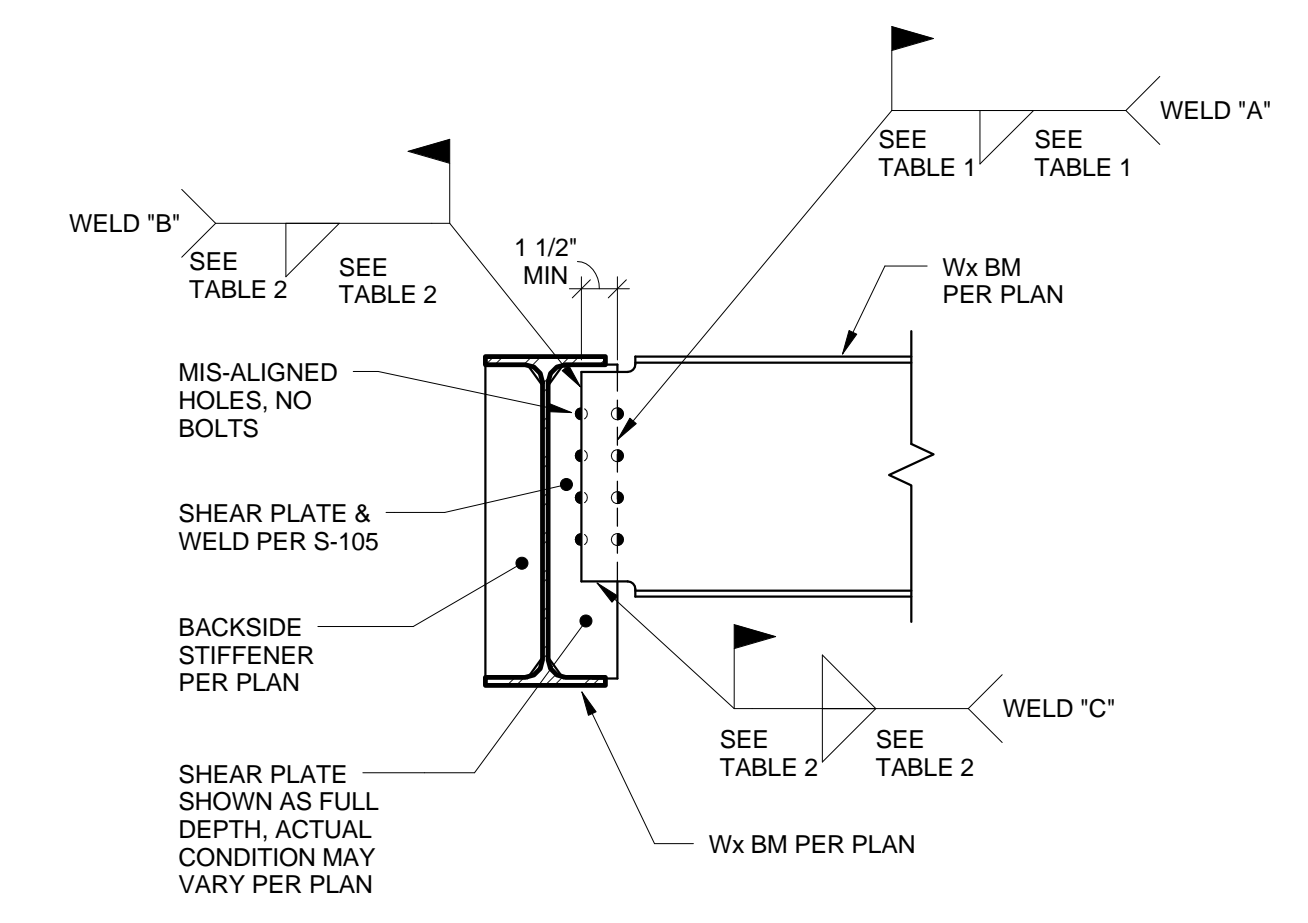

4 PARTIAL PLAN @ E/3  
SCALE: 3/8" = 1'-0"

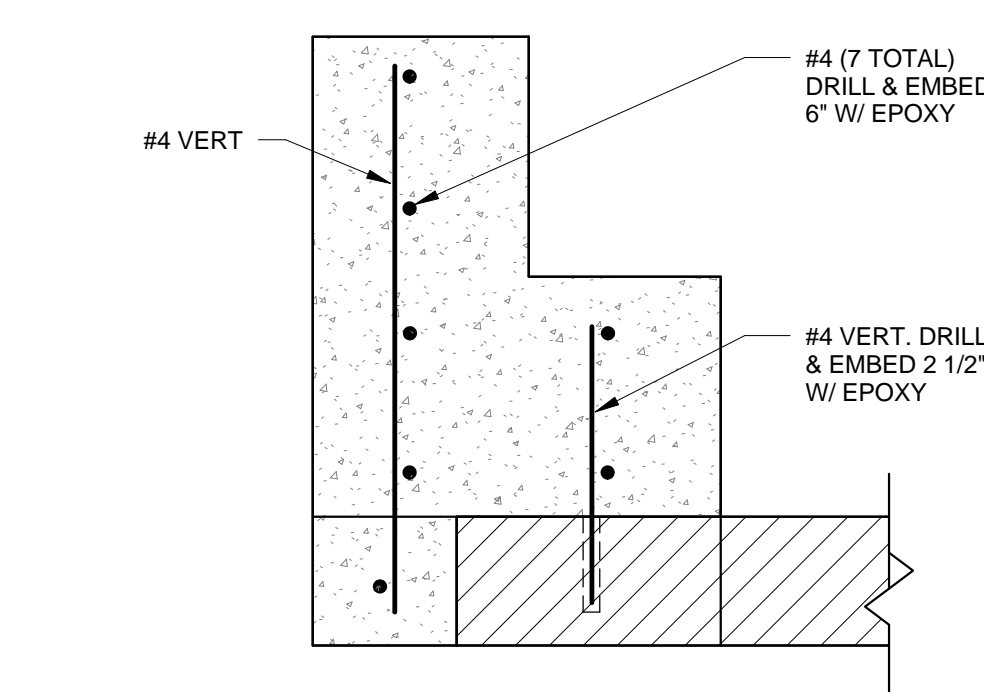

8 SECTION  
SCALE: 1" = 1'-0"

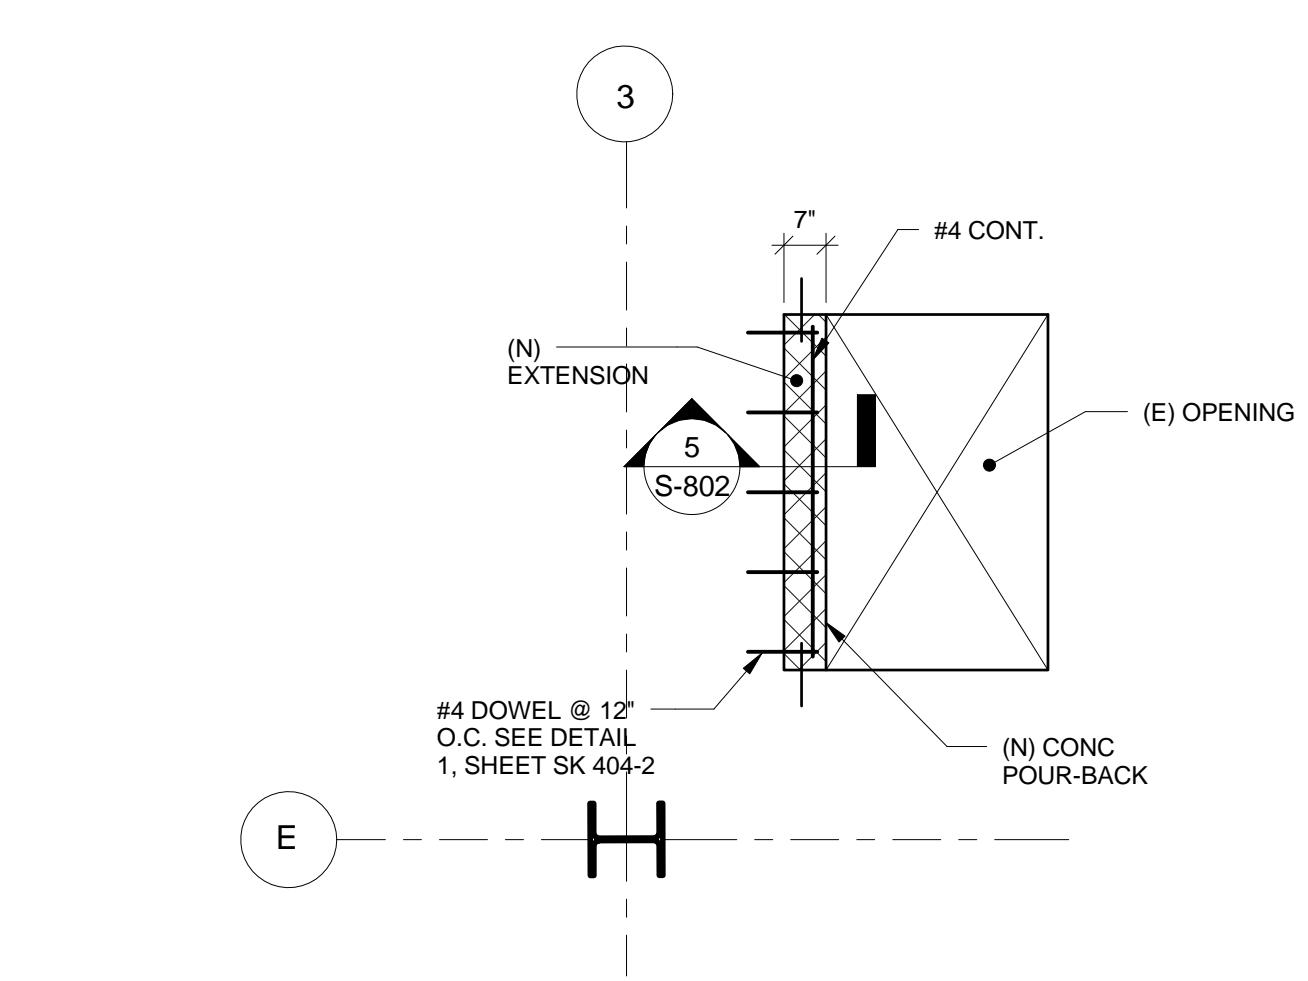

6 PARTIAL PLAN @ B/10  
SCALE: 3/8" = 1'-0"