

NO.	DESCRIPTION
1	10% SCHEMATIC DESIGN SUBMITTAL
2	30% DESIGN DEVELOPMENT SUBMITTAL
3	100% DESIGN DEVELOPMENT SUBMITTAL
4	DESA INCORPORATE FEEDBACK
5	DESA INCORPORATE FEEDBACK
6	DESA INCORPORATE FEEDBACK
7	DESA INCORPORATE FEEDBACK
8	DESA INCORPORATE FEEDBACK
9	DESA INCORPORATE FEEDBACK
10	DESA INCORPORATE FEEDBACK
11	DESA INCORPORATE FEEDBACK
12	DESA INCORPORATE FEEDBACK
13	DESA INCORPORATE FEEDBACK
14	DESA INCORPORATE FEEDBACK


PROJECT RECORD SET

**SKYLINE COLLEGE
 CIP2 DESIGN-BUILD
 BUILDING 4N**

REVISION

PROJECT NO: 0701200
 DATE: 01/31/11
 SCALE: NONE

**TELECOM
 SINGLE LINE
 RISER**

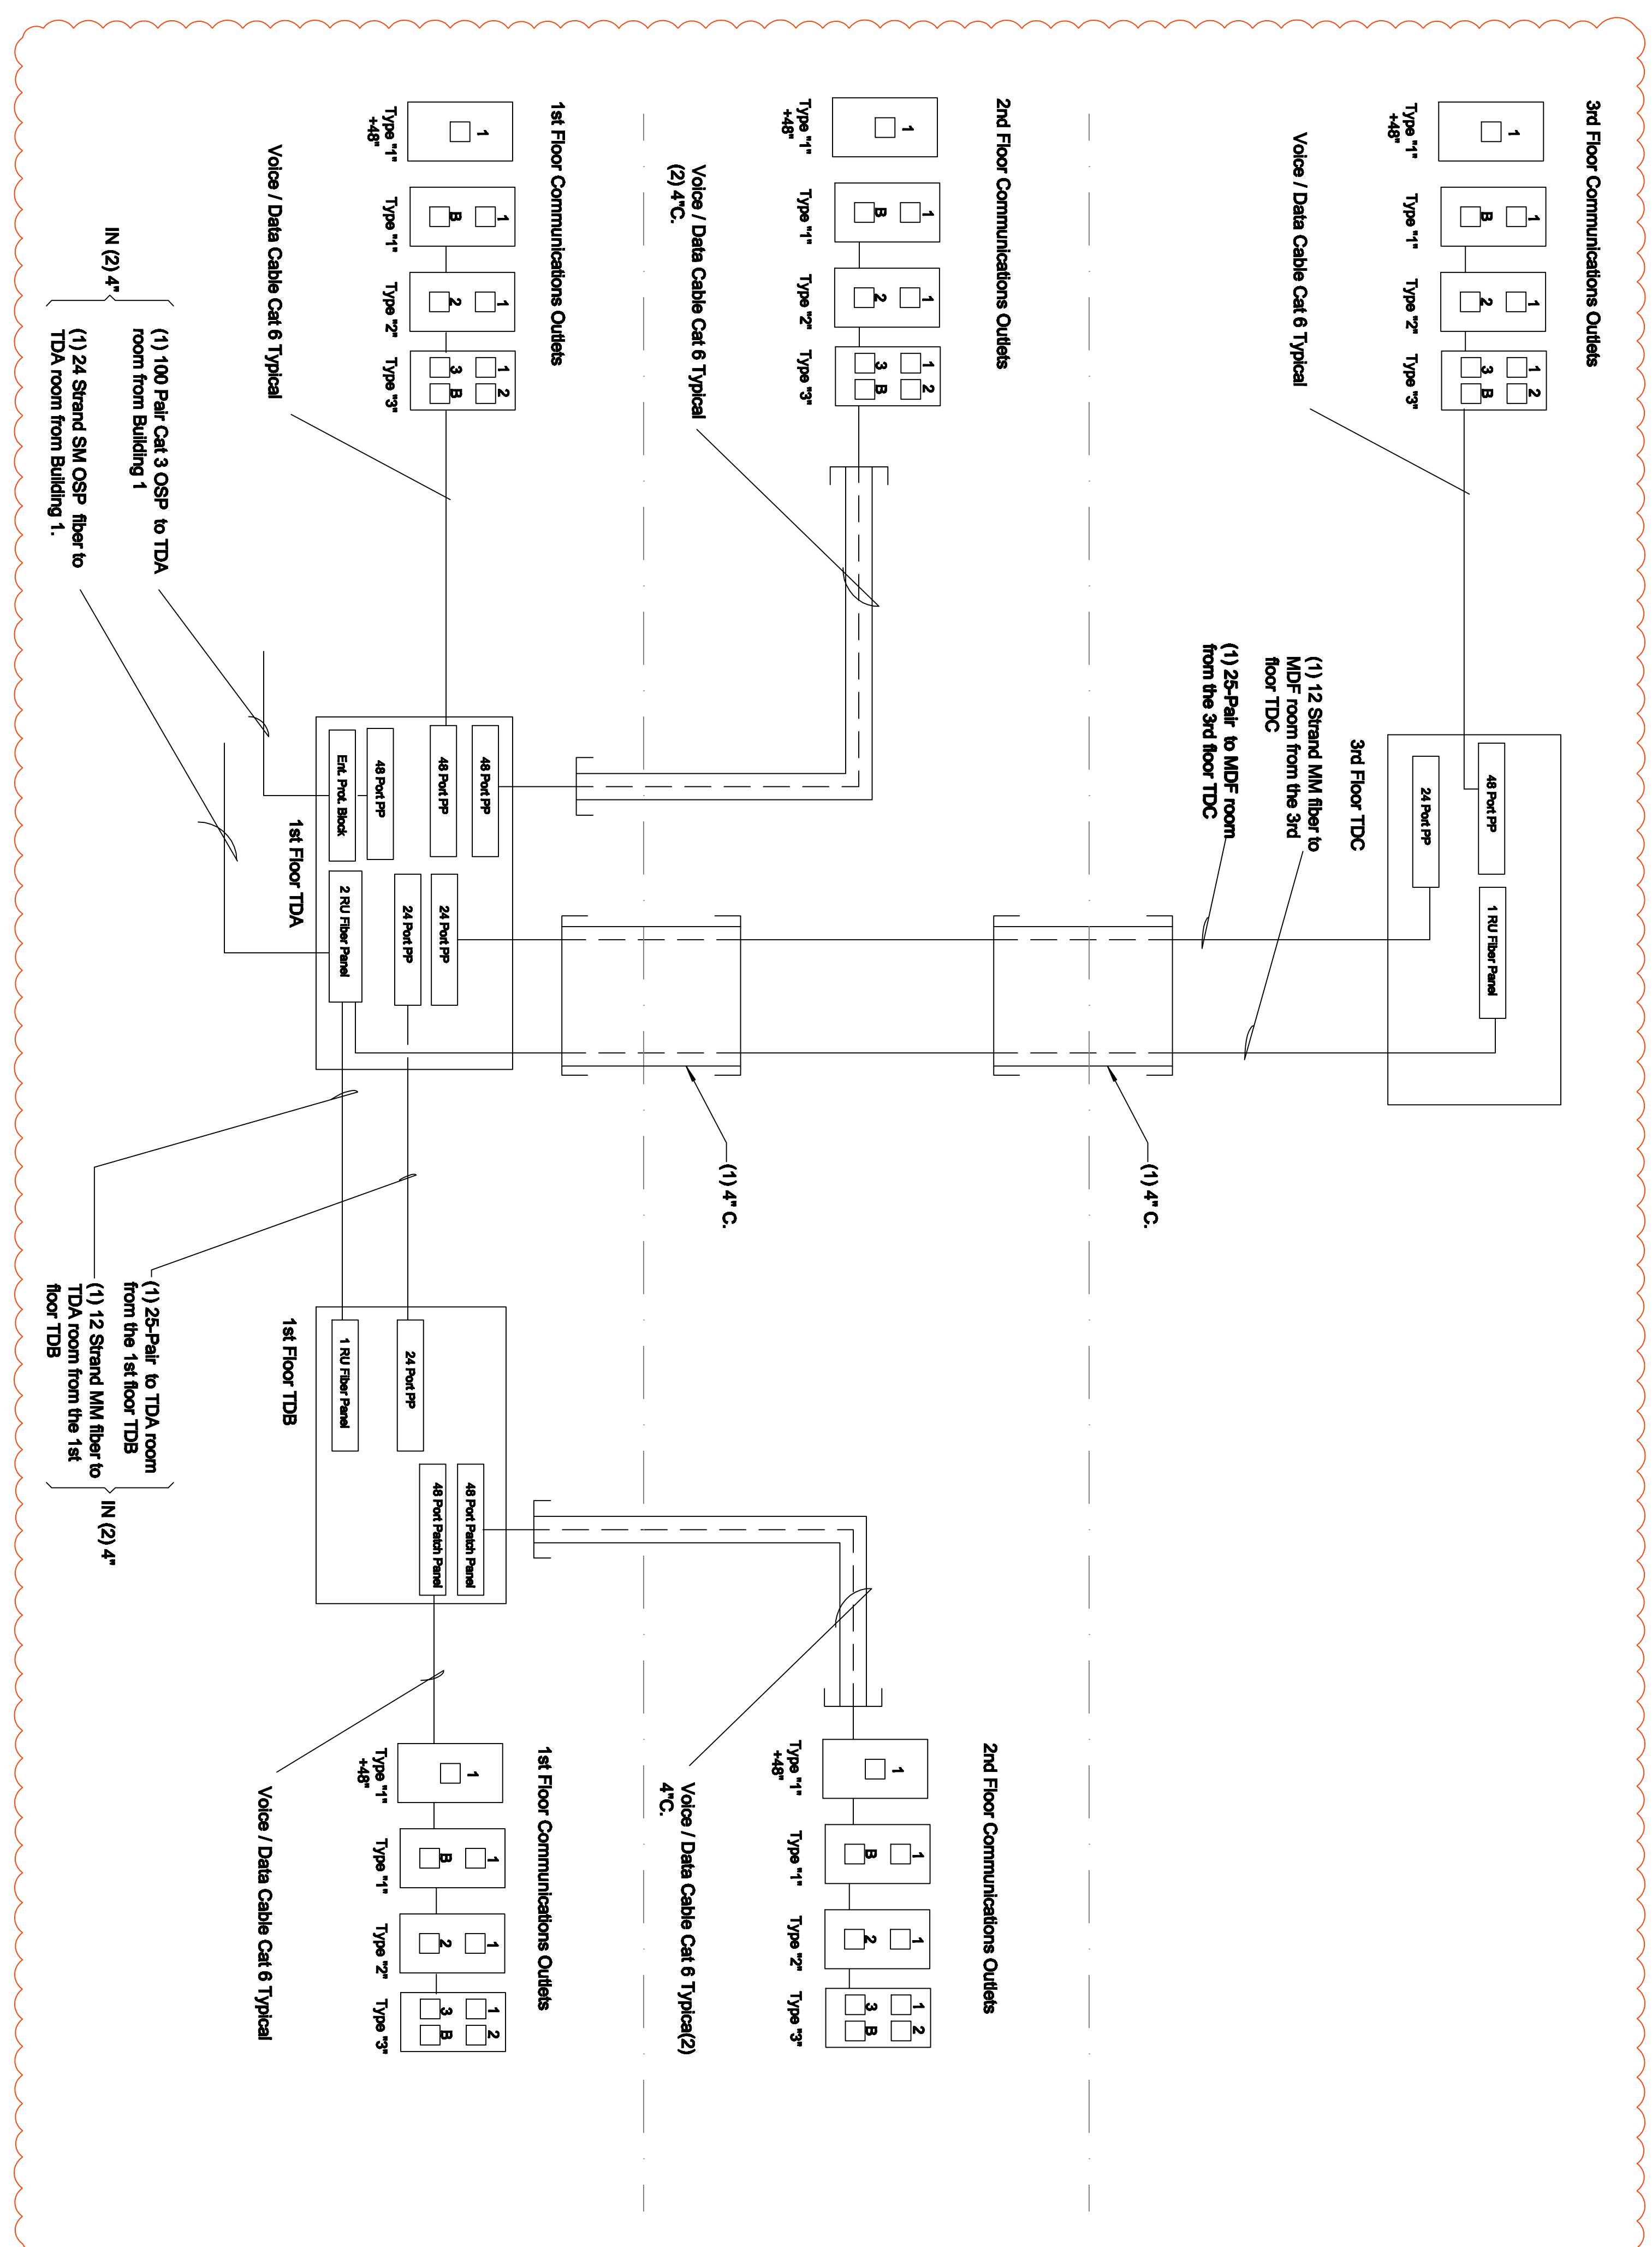

TELECOM SINGLE LINE RISER

SCALE: NONE

All drawings and written material remain the property of the Architect/Engineer and shall not be reproduced, used or displayed without the written consent of the Architect/Engineer. This drawing is not to be used for any other project without the written consent of the Architect/Engineer.