


NO.	DESCRIPTION
1	10% SCHEMATIC DESIGN SUBMITTAL
2	10% DESIGN DEVELOPMENT SUBMITTAL
3	10% DESIGN DEVELOPMENT SUBMITTAL
4	DATA INCORPORATE REVISIONS
5	30% DESIGN DEVELOPMENT SUBMITTAL
6	30% DESIGN DEVELOPMENT SUBMITTAL
7	30% DESIGN DEVELOPMENT SUBMITTAL
8	30% DESIGN DEVELOPMENT SUBMITTAL
9	30% DESIGN DEVELOPMENT SUBMITTAL
10	30% DESIGN DEVELOPMENT SUBMITTAL
11	30% DESIGN DEVELOPMENT SUBMITTAL
12	30% DESIGN DEVELOPMENT SUBMITTAL
13	30% DESIGN DEVELOPMENT SUBMITTAL
14	30% DESIGN DEVELOPMENT SUBMITTAL

PROJECT RECORD SET


**SKYLINE COLLEGE
 CIP2 DESIGN-BUILD
 BUILDING 4N**

PROJECT NO: 0701200
 DATE: 01/31/11
 SCALE: NONE

**TELECOM
 DETAILS**

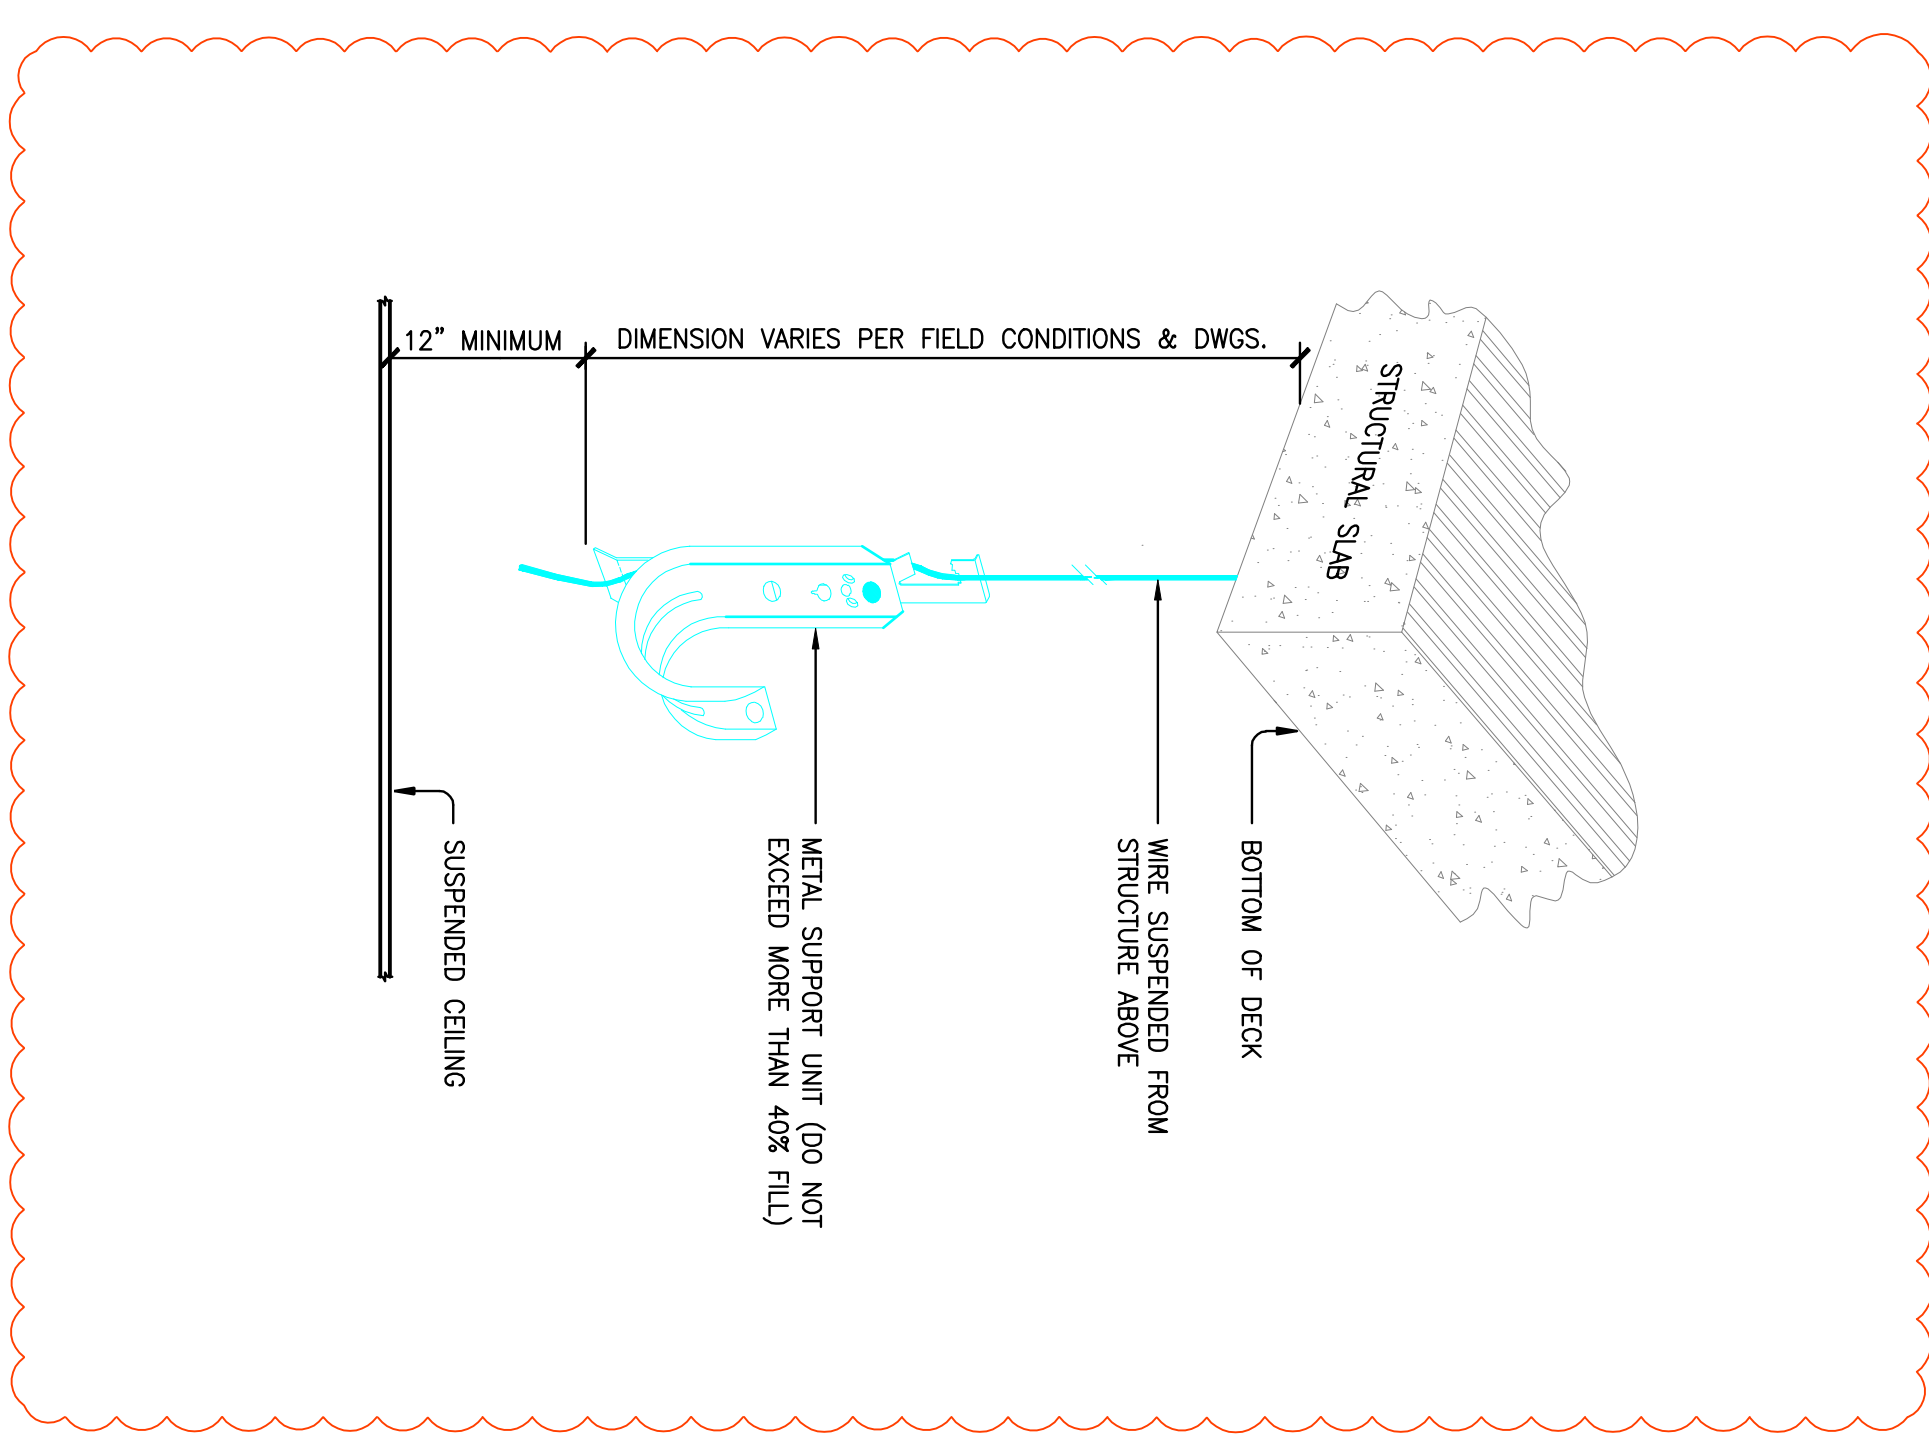

J-HANGER DETAIL
 SCALE: NONE

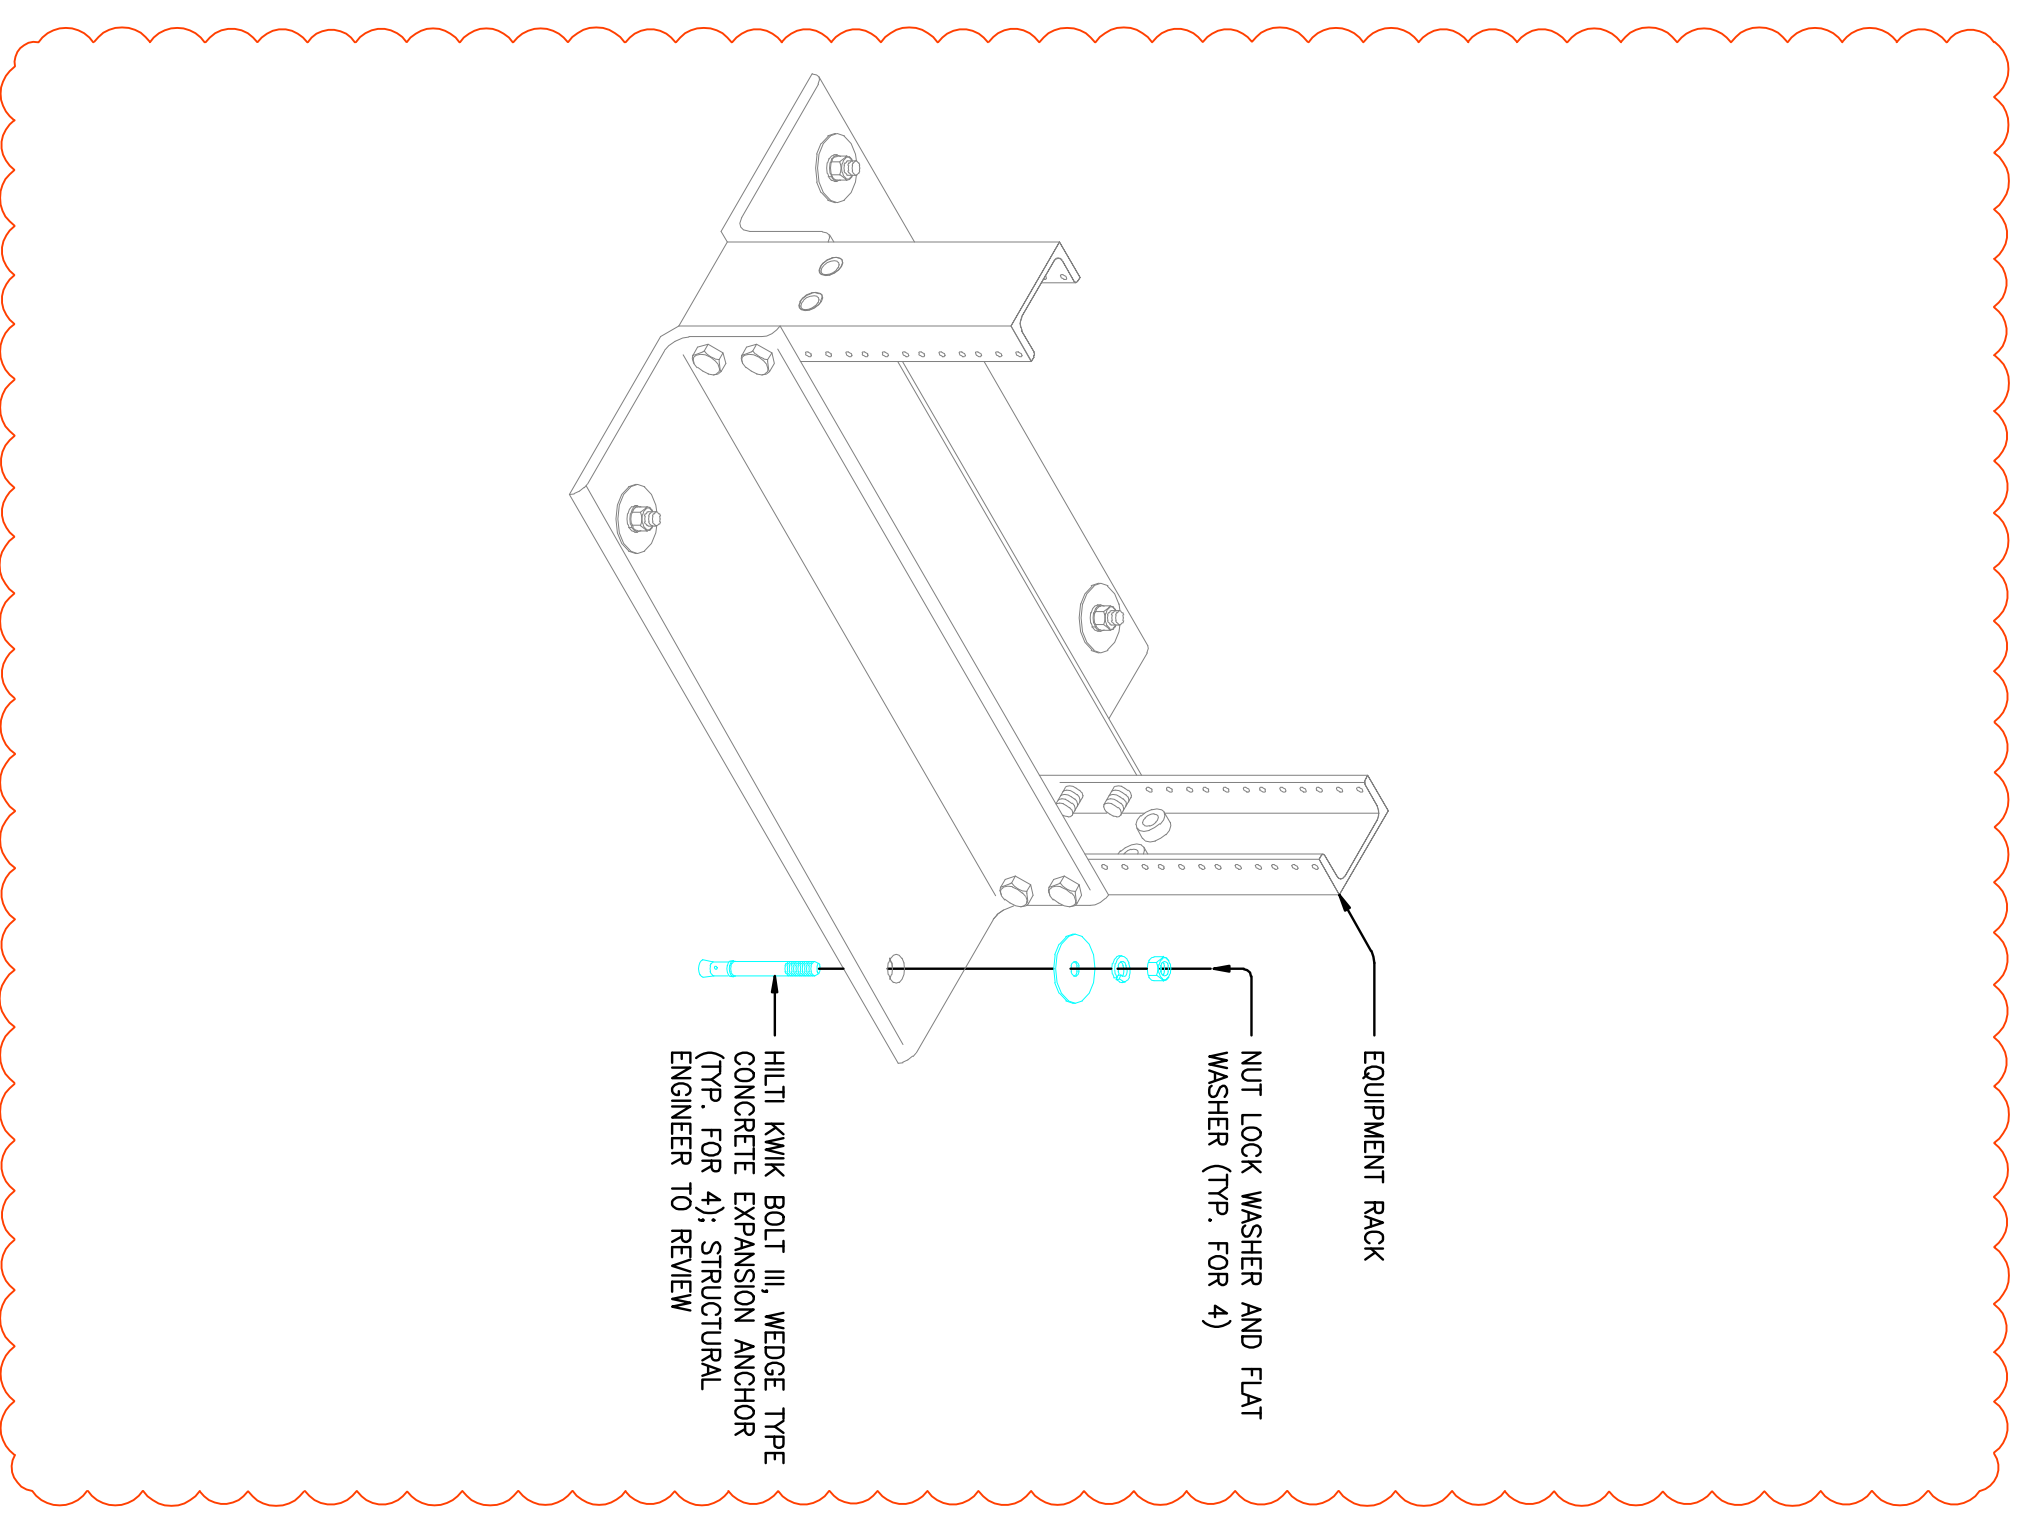

2-POST RACK ANCHOR DETAIL
 SCALE: NONE

All drawings and details are the property of Hensel Phelps Construction Company and its subsidiaries. No part of this document may be reproduced, stored in a retrieval system, or transmitted in any form or by any means, electronic, mechanical, photocopying, recording, or by any information storage and retrieval system, without the prior written permission of Hensel Phelps Construction Company.