




NOTES:
 1. MARKS F3, ETC. DENOTE FOOTING TYPE. SEE SCHEDULE ON SHEET S5.2.
 2. MARKS C2, ETC. DENOTE COLUMN TYPE. SEE SCHEDULE ON SHEET S7.1.

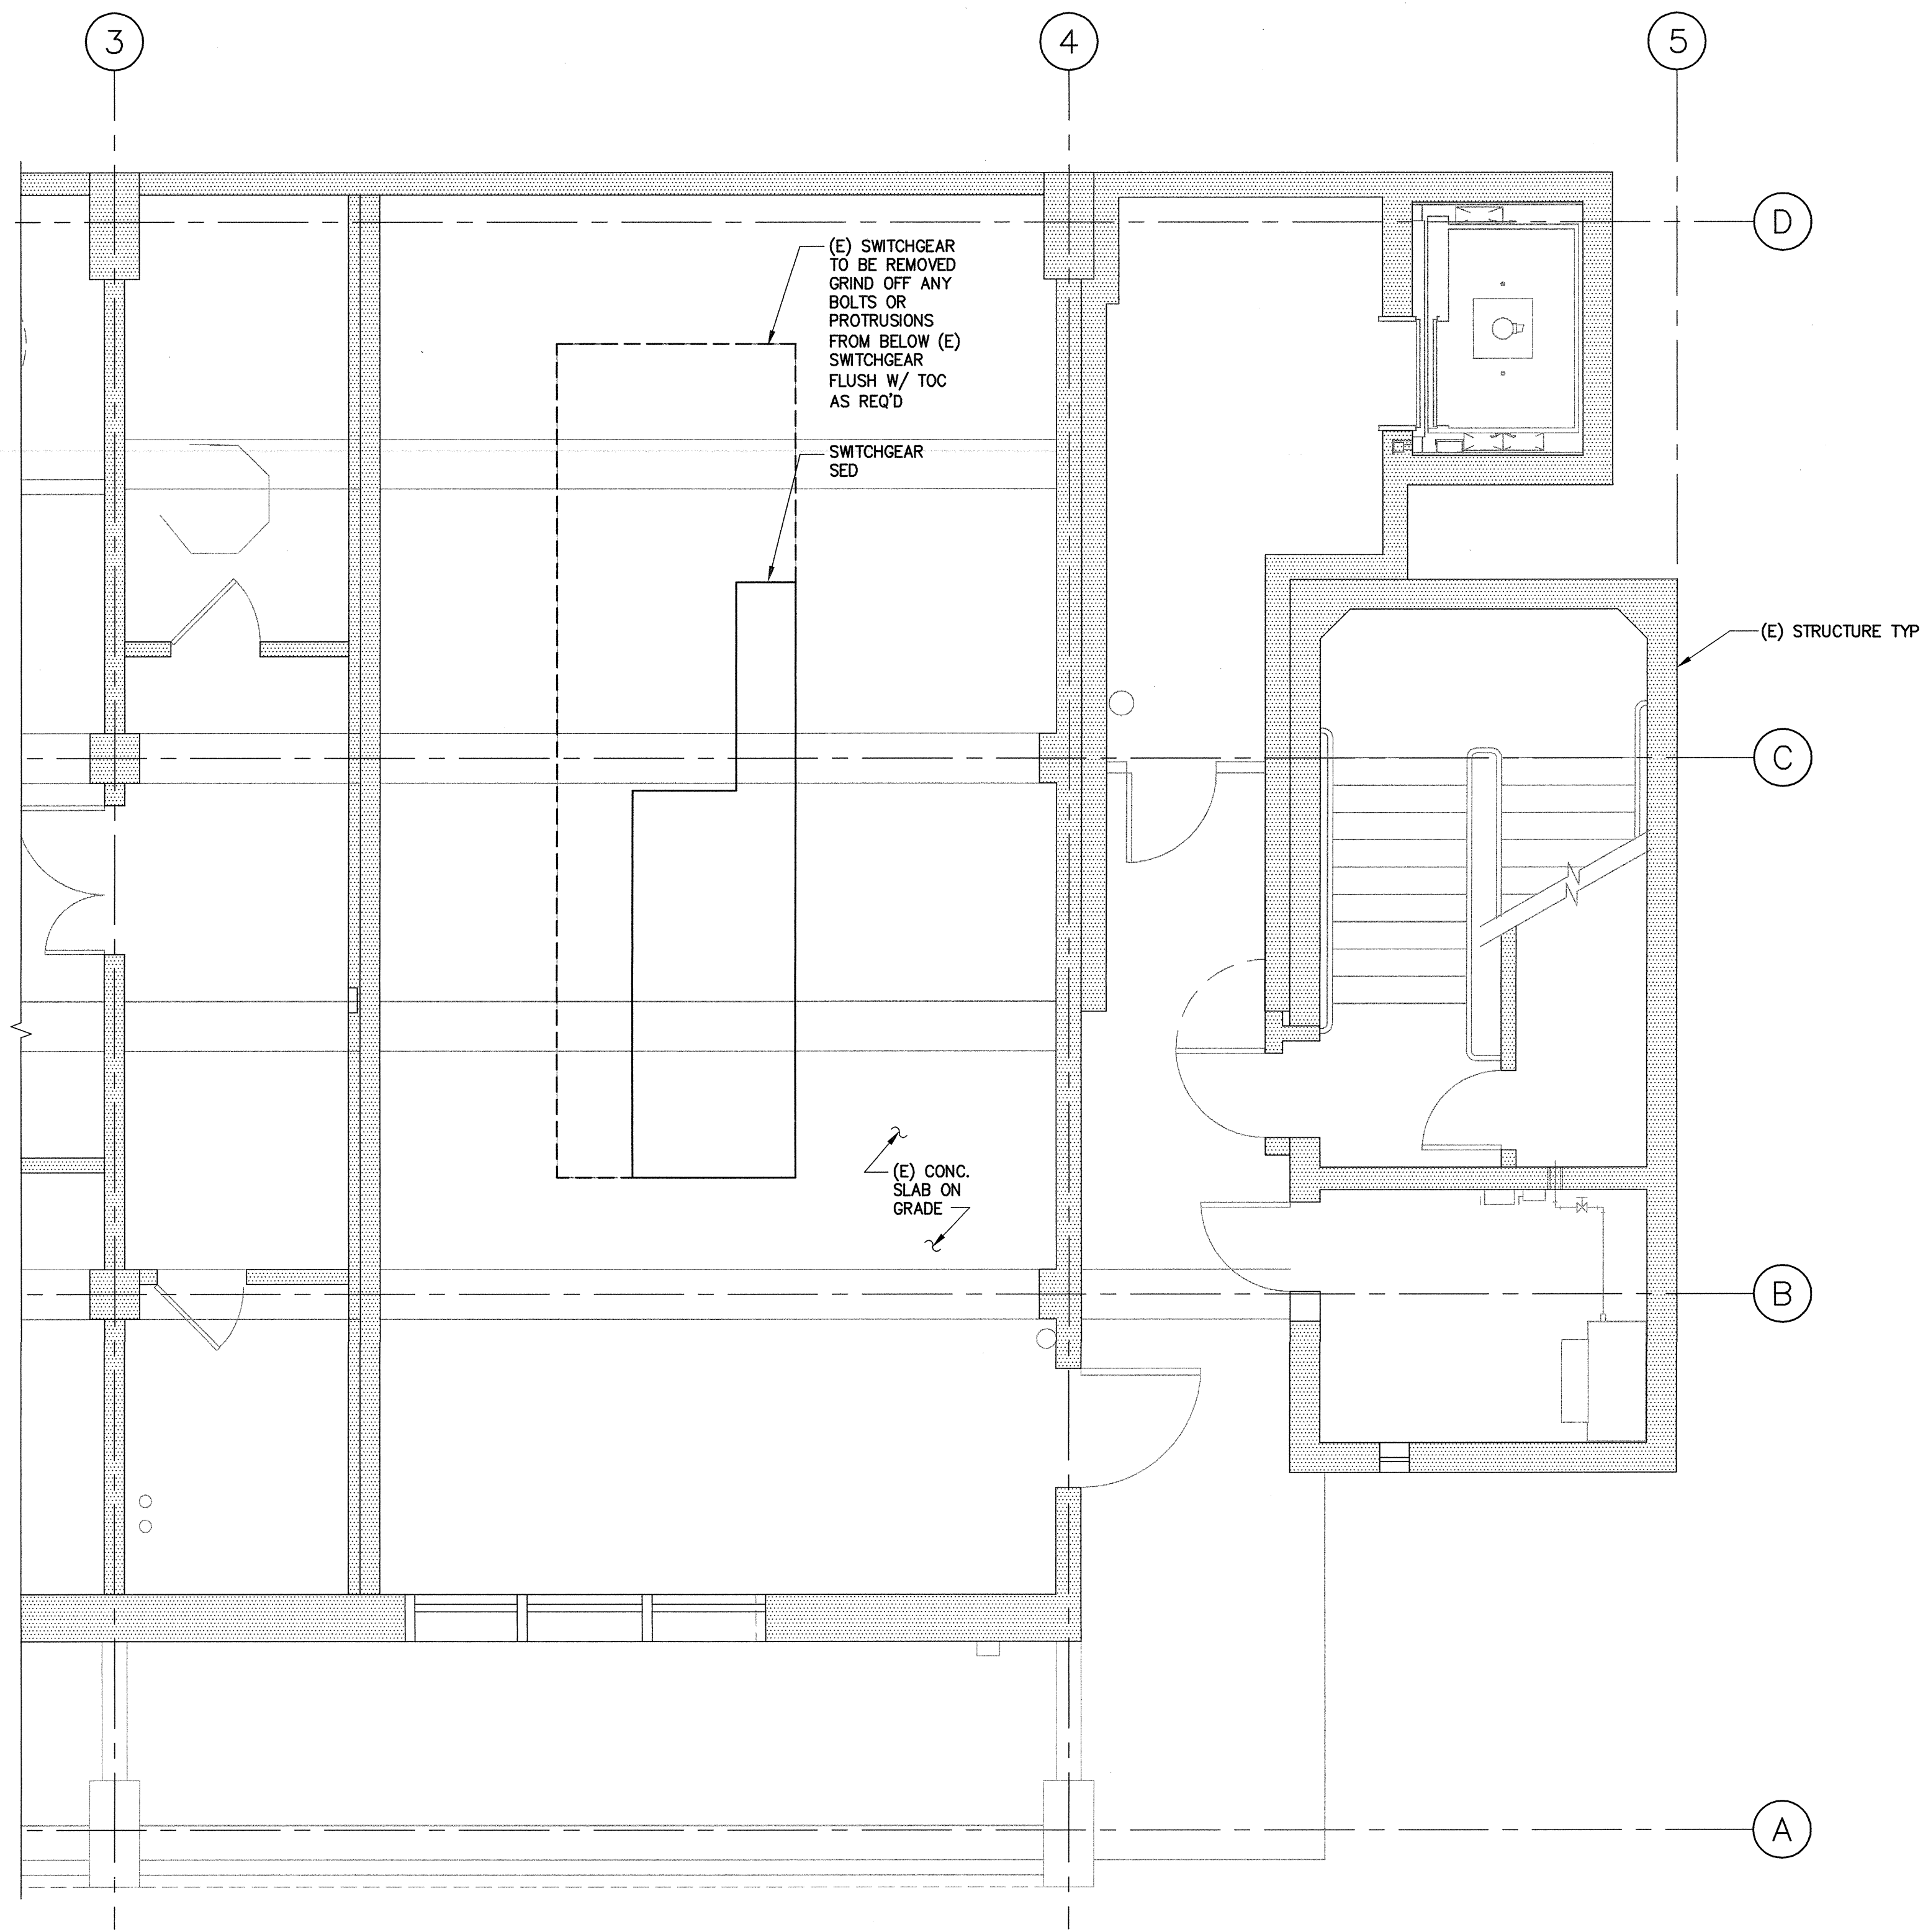

NOTES:
 1. PATCH AND REPAIR (E) SLAB WHERE (E) SWITCHGEAR HAS BEEN REMOVED.

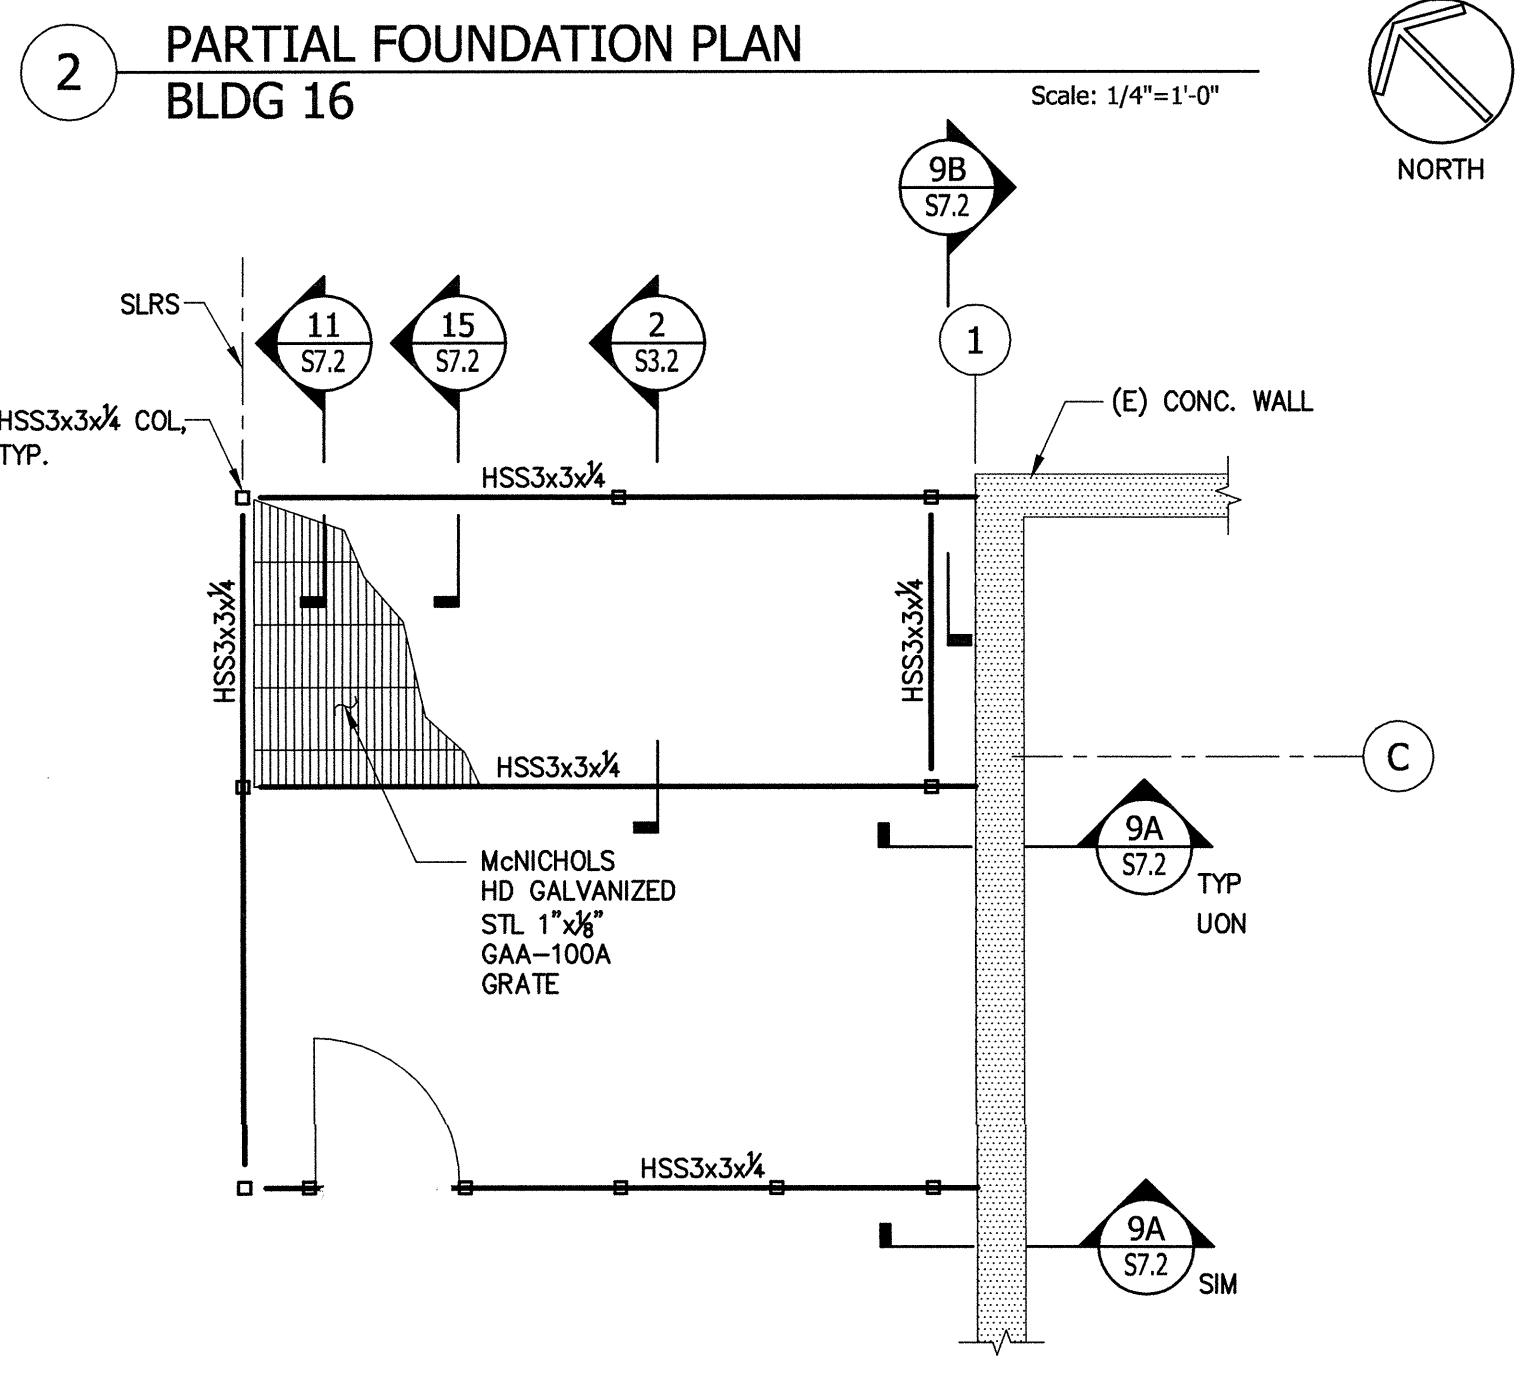

2 PARTIAL FOUNDATION PLAN
 BLDG 16
 Scale: 1/4"=1'-0"

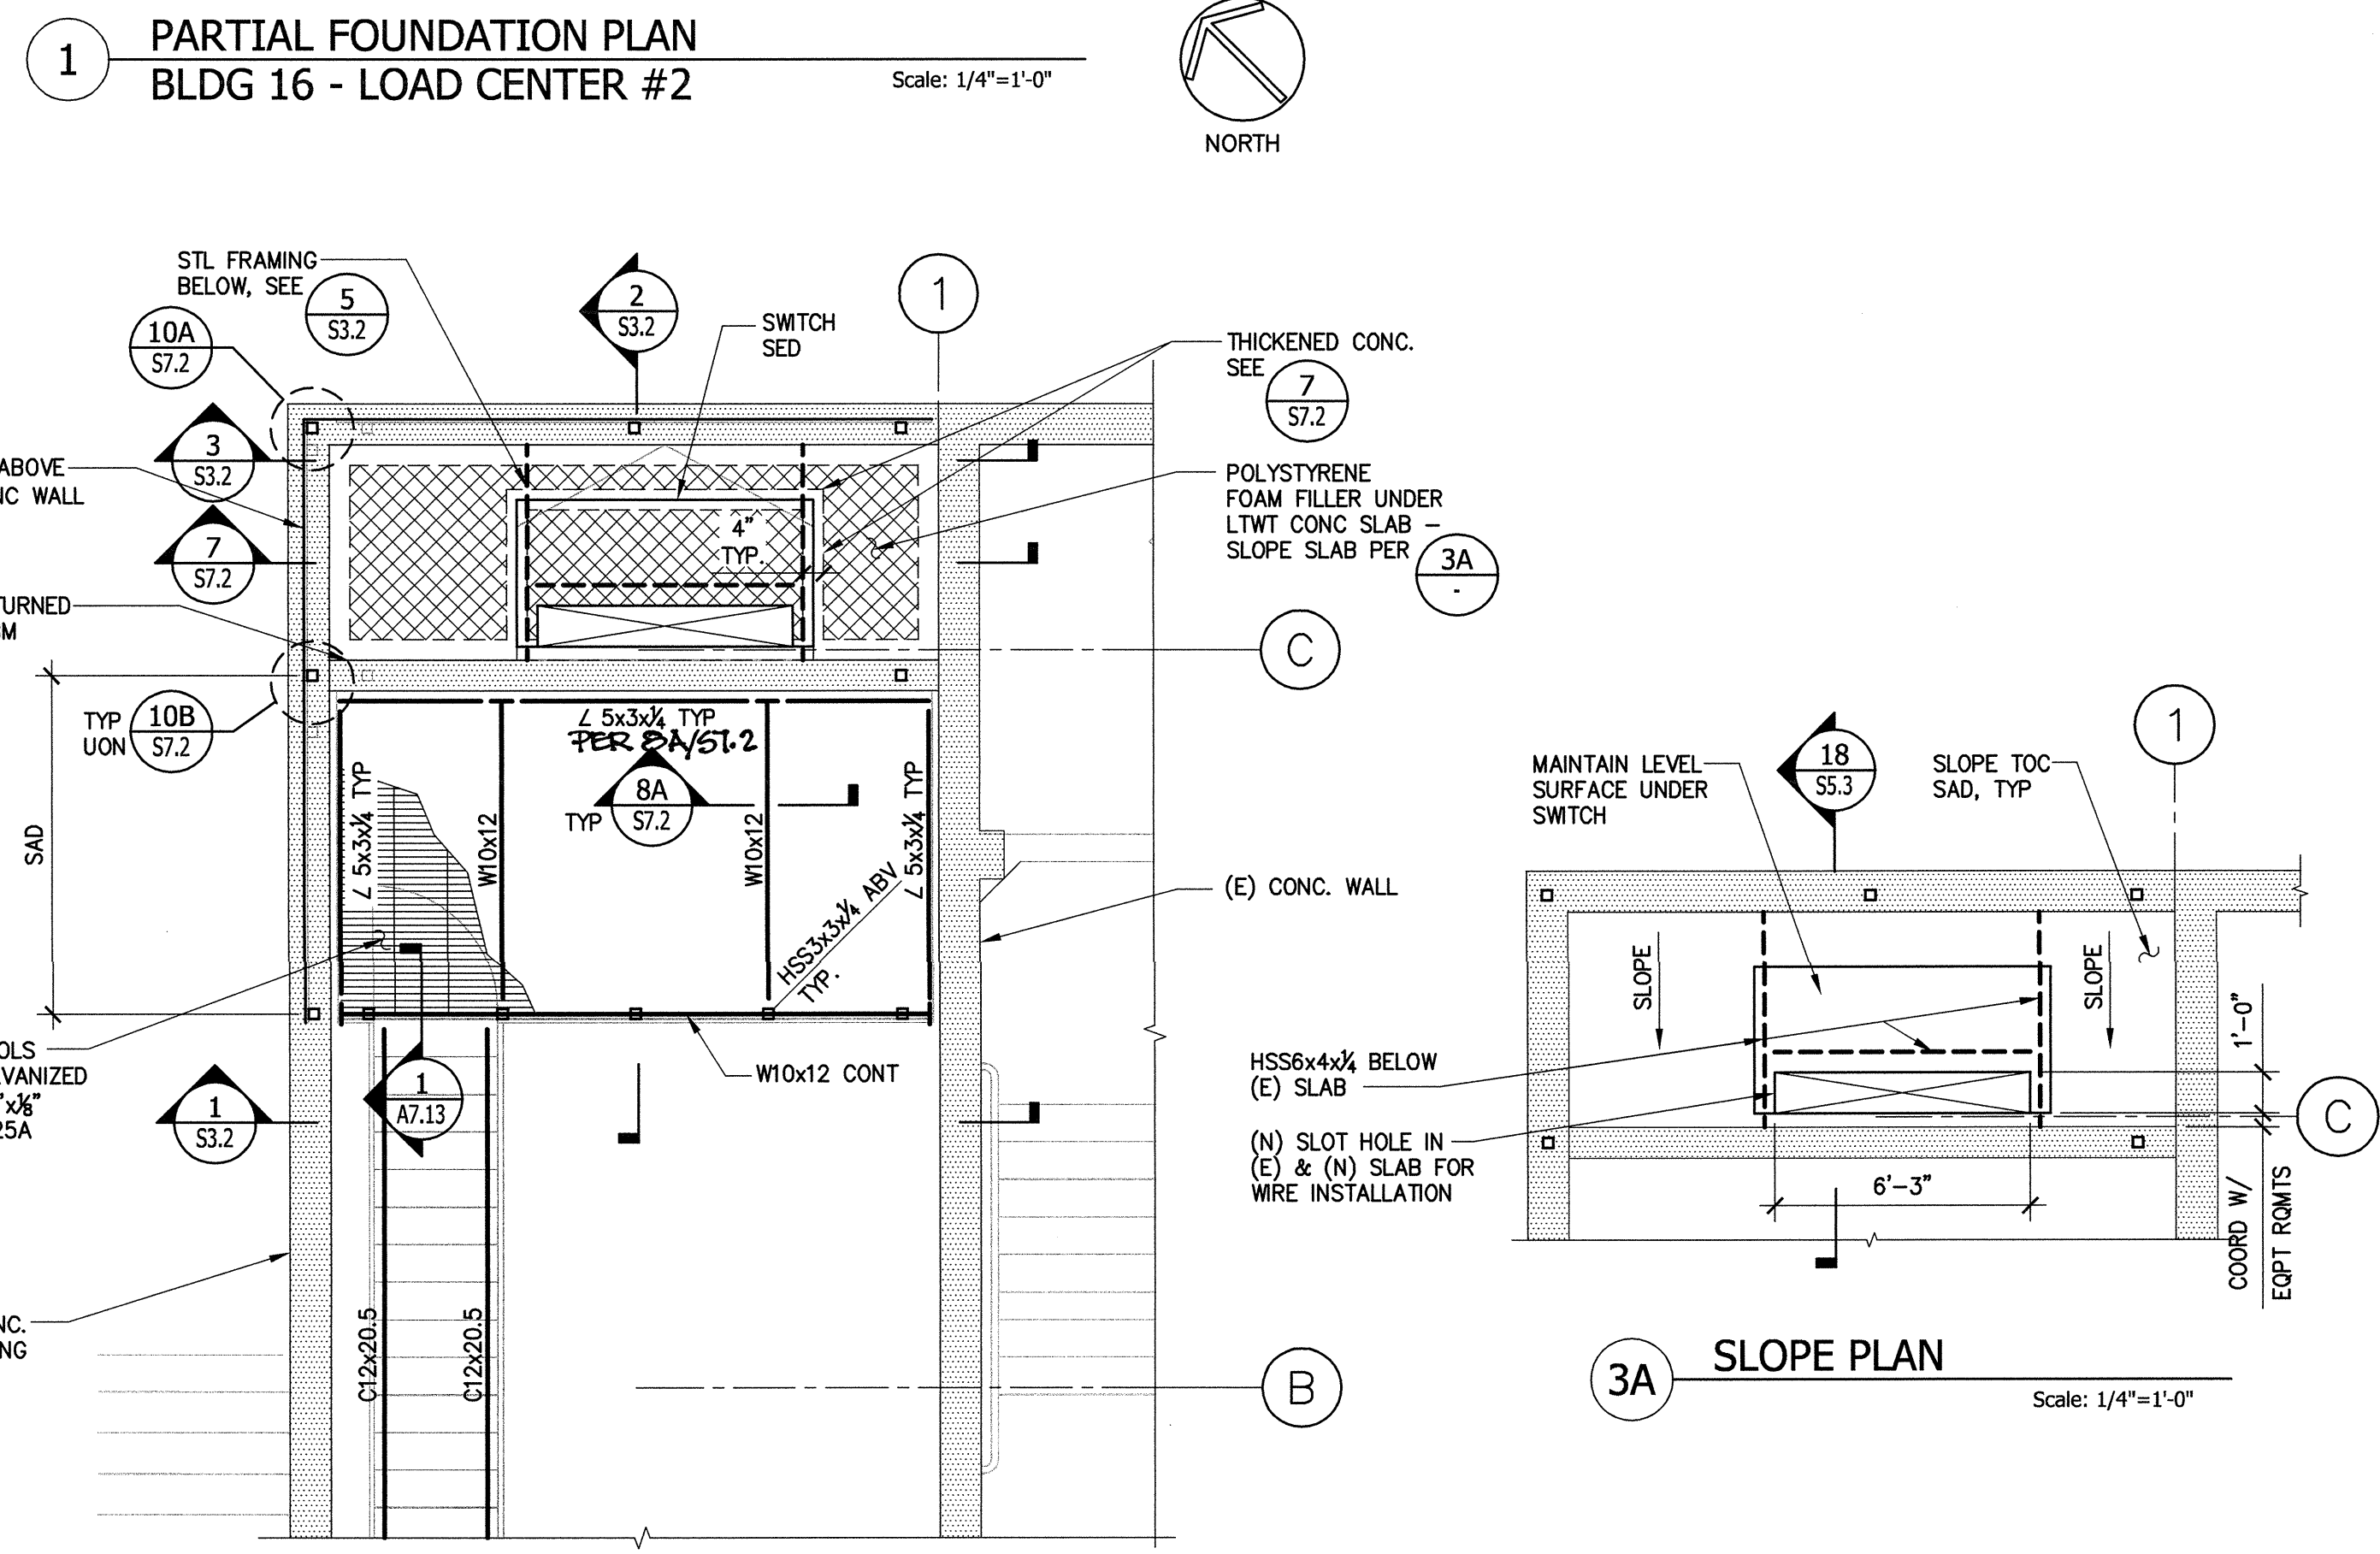

1 PARTIAL FOUNDATION PLAN
 BLDG 16 - LOAD CENTER #2
 Scale: 1/4"=1'-0"

3A SLOPE PLAN
 Scale: 1/4"=1'-0"

4 TRELLIS FRAMING PLAN
 BLDG 16
 Scale: 1/4"=1'-0"

3 PARTIAL FIRST FLOOR FRAMING PLAN
 BLDG 16
 Scale: 1/4"=1'-0"