



McCarthy Building Companies, Inc.
 343 Sansome Street, 14th Floor
 San Francisco, California 94104
 P 415 364-1339
 F 415 397-5999

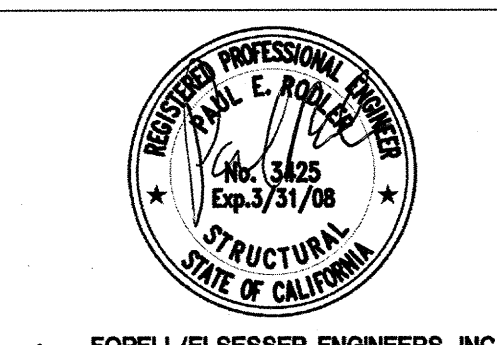

FORELL/ELLESER ENGINEERS, INC.
 Structural Engineers
 645 Howe Street - San Francisco, CA 94111
 Phone: (415) 837-0200 Fax: (415) 837-0200
 www.forell.com job_no: 07-020-004

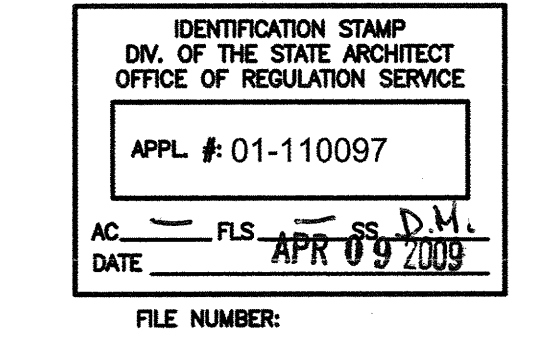

FILE NUMBER: _____

This set of other project documents and all notes, schedules and design responsibilities remain the property of MBE, INC. and shall not be used in whole or in part for any project other than that for which they were prepared. The contractor shall verify the accuracy of all dimensions and conditions shown on these drawings and shall be responsible for any discrepancies between the drawings and the actual conditions. The contractor shall be responsible for any discrepancies between the drawings and the actual conditions. 

© Copyright 2008

College of San Mateo
 Site Package
 San Mateo, CA

Developed for
 San Mateo County Community College District


Revision	Description	Date

Revision	Description	Date





Job No.	Date
27082.30	09 APRIL 2009
Drawn by	MC
Checked by	PR
Scale	AS NOTED

POOL EQUIPMENT BUILDING PLANS, DETAILS AND ELEVATIONS










S1.0

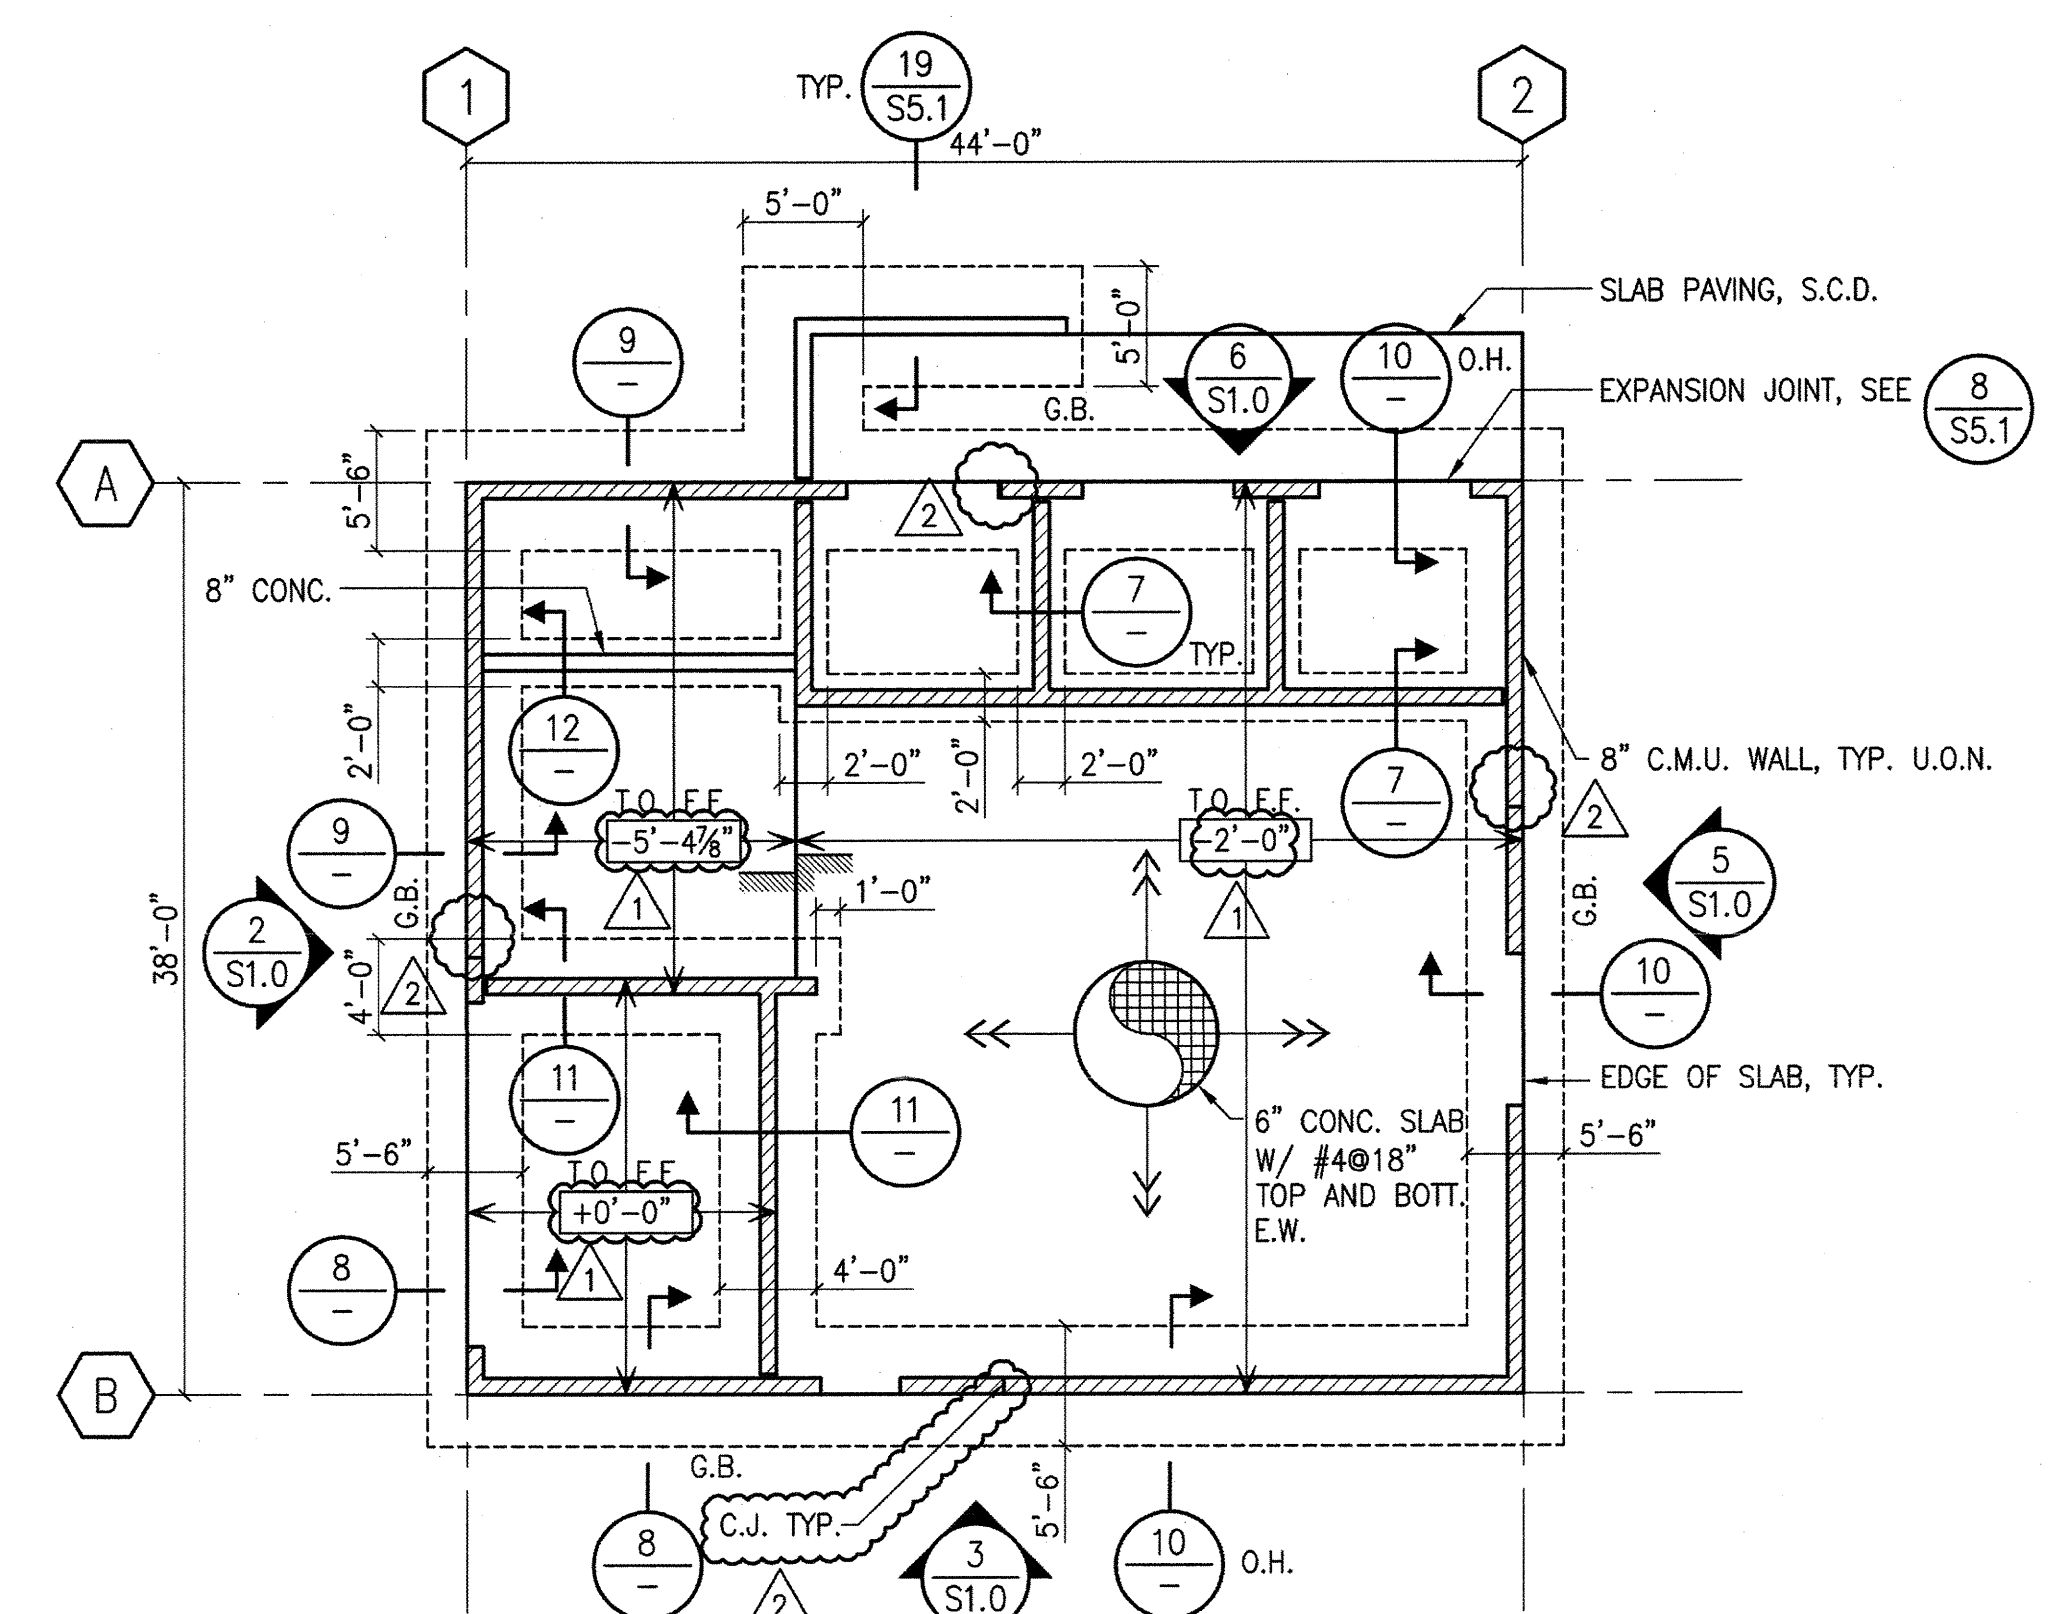

- NOTES:**
- TOP OF FINISHED FLOOR INDICATED ON PLAN
 - CONCRETE: FOR TYPICAL DETAILS, SEE SHEET S5.1 FOOTINGS, EDGE BEAMS AND WALLS AS NOTED ON PLAN.
 - C.M.U.: FOR WALL TYPES, AND TYPICAL DETAILS, SEE SHEET S4.1
 - SLAB EDGE: S.L.D. FOR EDGE OF SLAB DIMENSION. CONTRACTOR SHALL COMPARE STRUCTURAL DRAWINGS WITH ALL OTHER DISCIPLINES AND NOTIFY THE ARCHITECT OF ANY DISCREPANCIES PRIOR TO FABRICATION.
 - DEPRESSIONS, CURBS & FINISHES: SEE ARCHITECTURAL DRAWINGS FOR LOCATION OF FLOOR DEPRESSIONS, CURBS AND FINISHES.
 - TOP OF SLAB: TYPICAL TOP OF STRUCTURAL SLAB (T.O.C.) SHALL BE AS INDICATED ON THE ARCHITECTURAL PLANS WITH RESPECT TO TOP OF FINISHED FLOOR (T.O.F.F.)
 - SPECIAL CONDITIONS:
 PRIOR TO REQUESTING A FOUNDATION INSPECTION (AT LEAST 48 HOURS) THE CONTRACTOR SHALL CONTACT THE GEOTECHNICAL ENGINEER. THE GEOTECHNICAL ENGINEER SHALL VERIFY IN WRITING TO THE BUILDING OFFICIAL THAT THE BUILDING FOUNDATION FOOTING EXCAVATIONS AND BUILDING PAD WERE PREPARED IN ACCORDANCE WITH THE SOIL REPORT RECOMMENDATIONS. THE FOUNDATION FORMING AND GRADING WERE PERFORMED IN CONFORMANCE WITH THE SOIL REPORT RECOMMENDATION AND APPROVED PLANS.
 - S.L.D. FOR DIMENSIONS OF WALLS & OPENINGS.

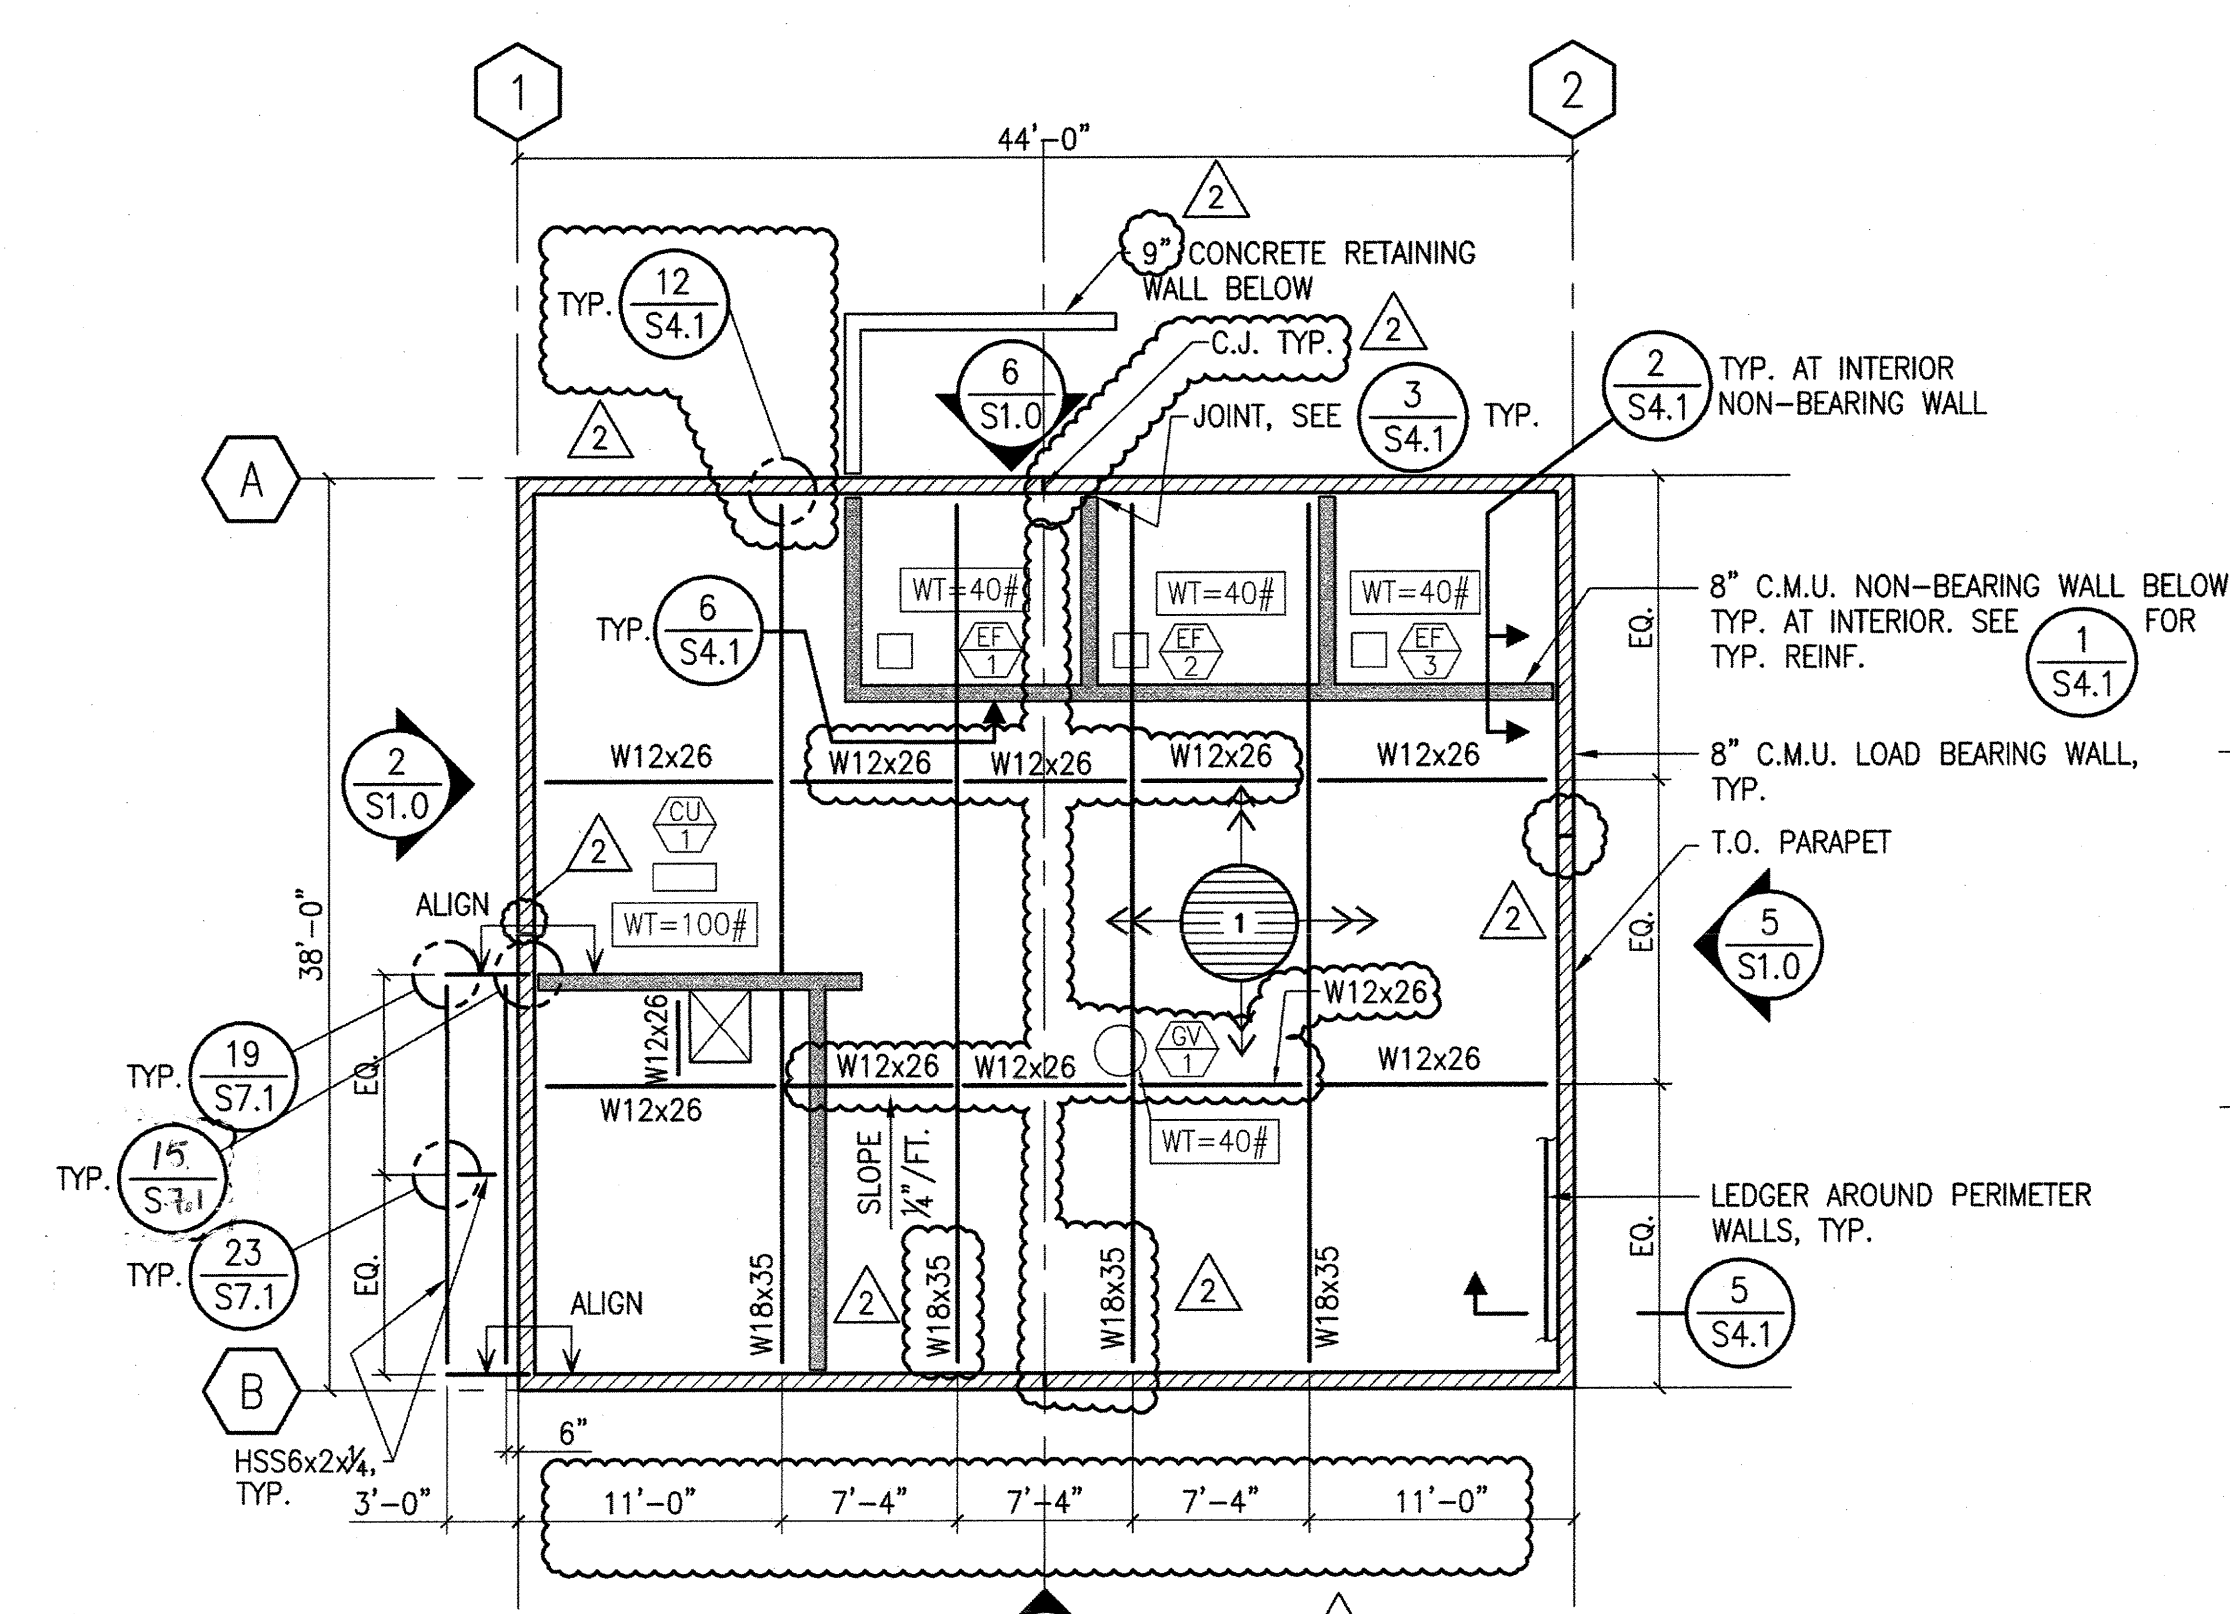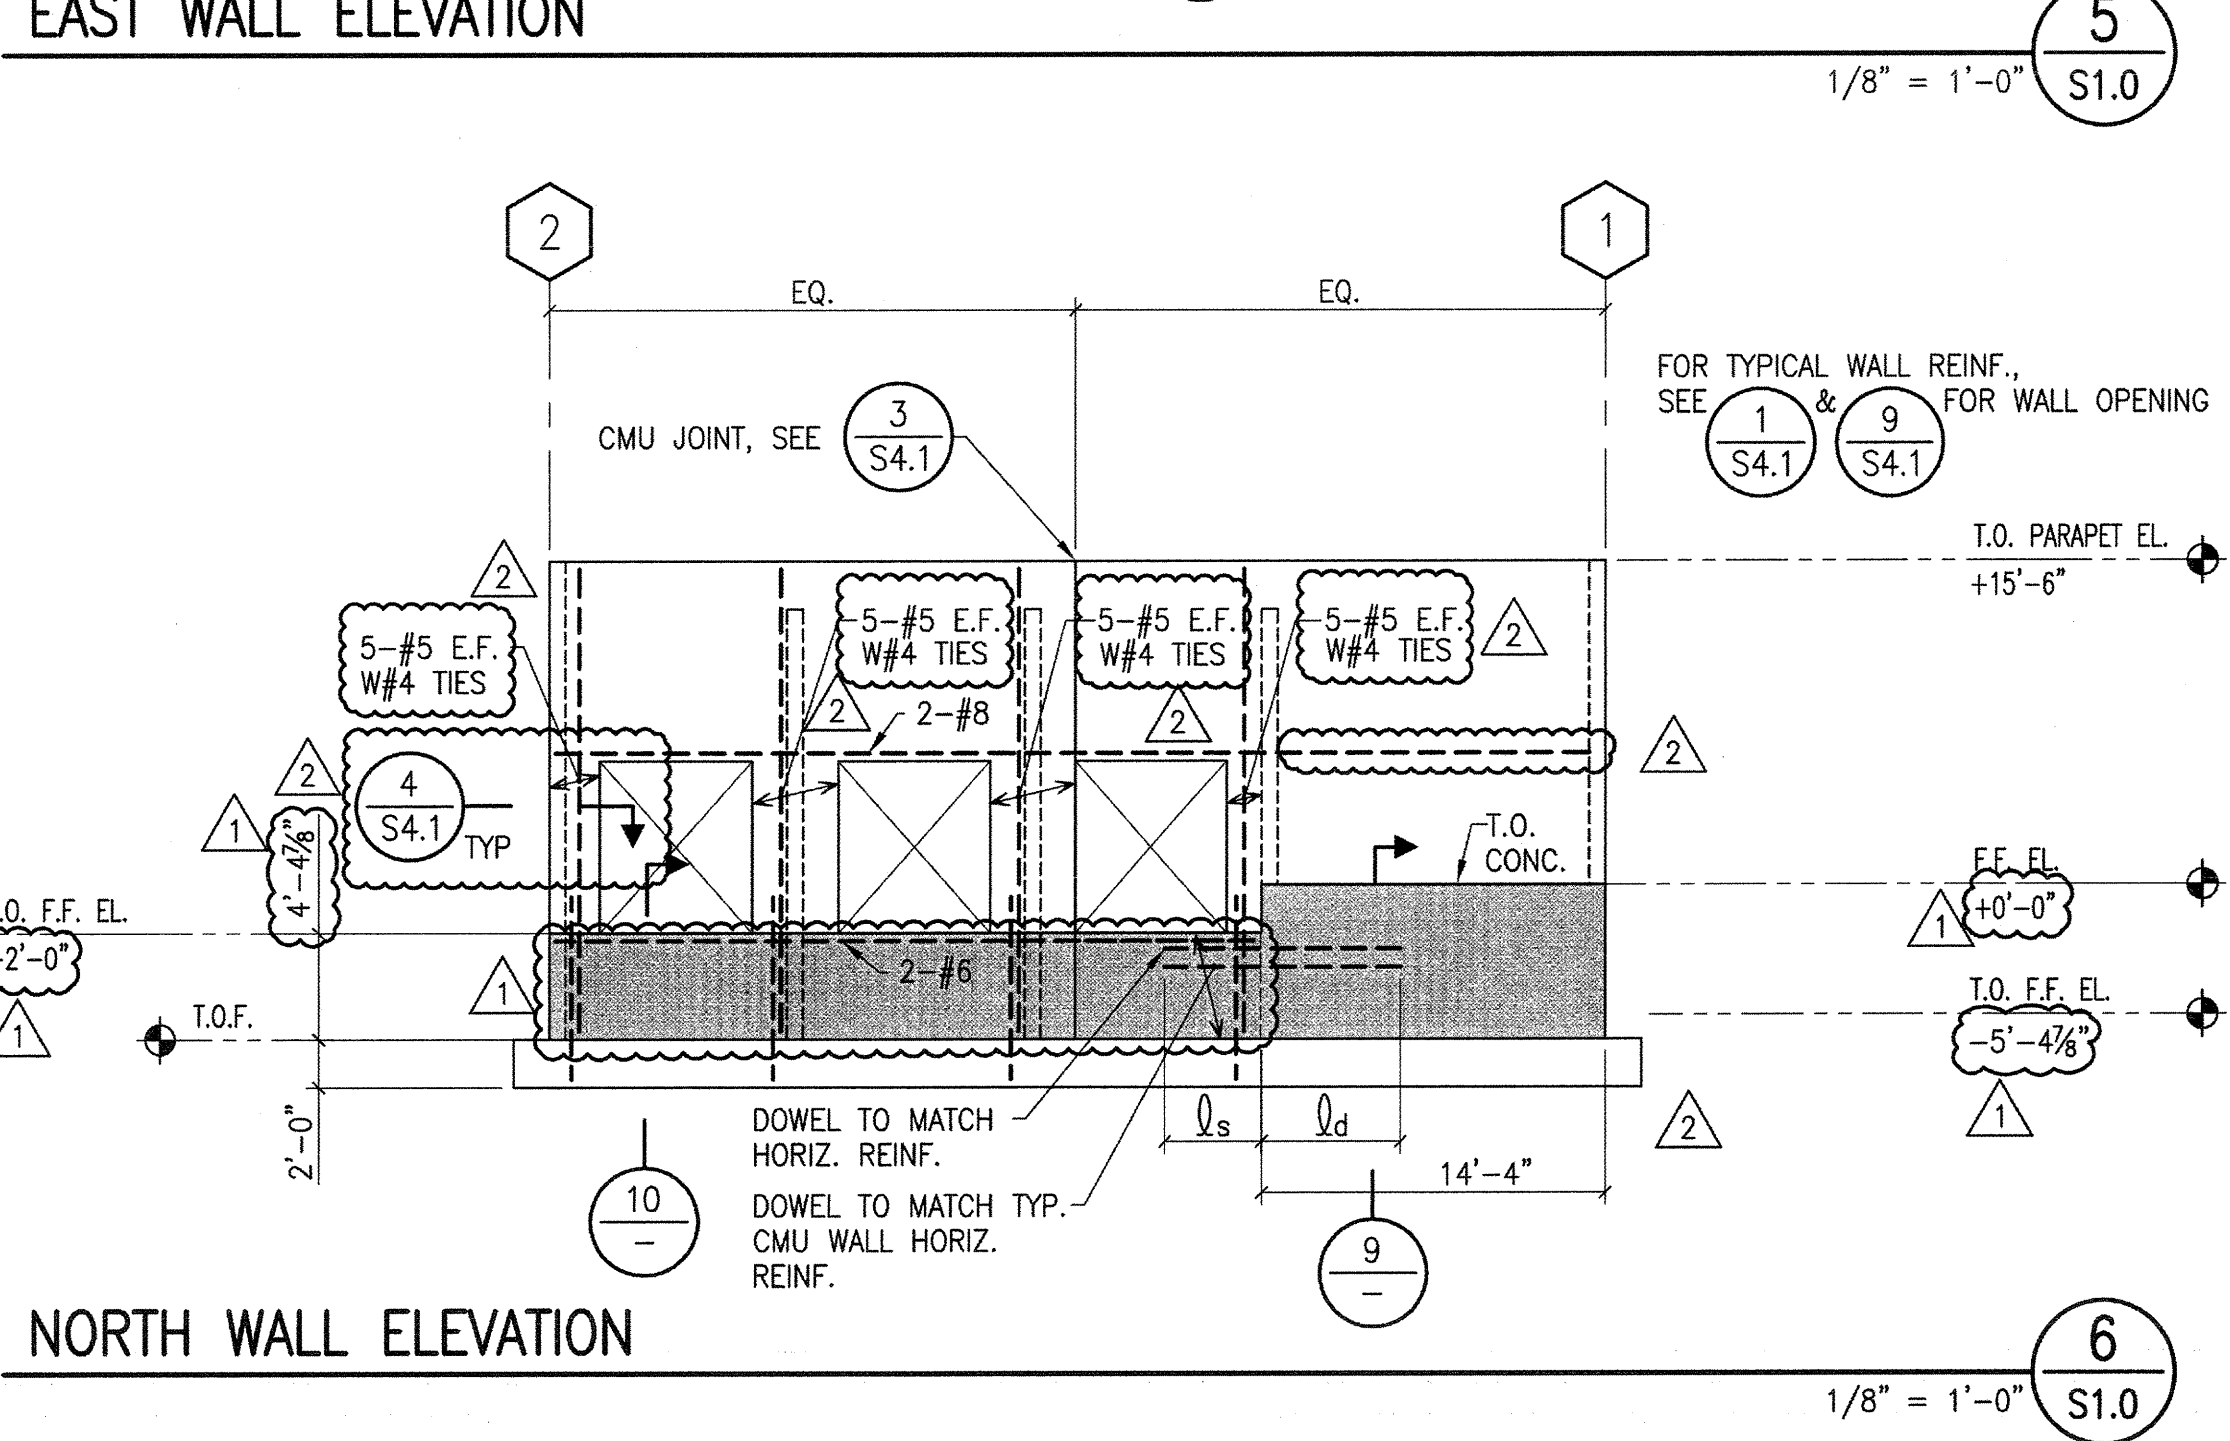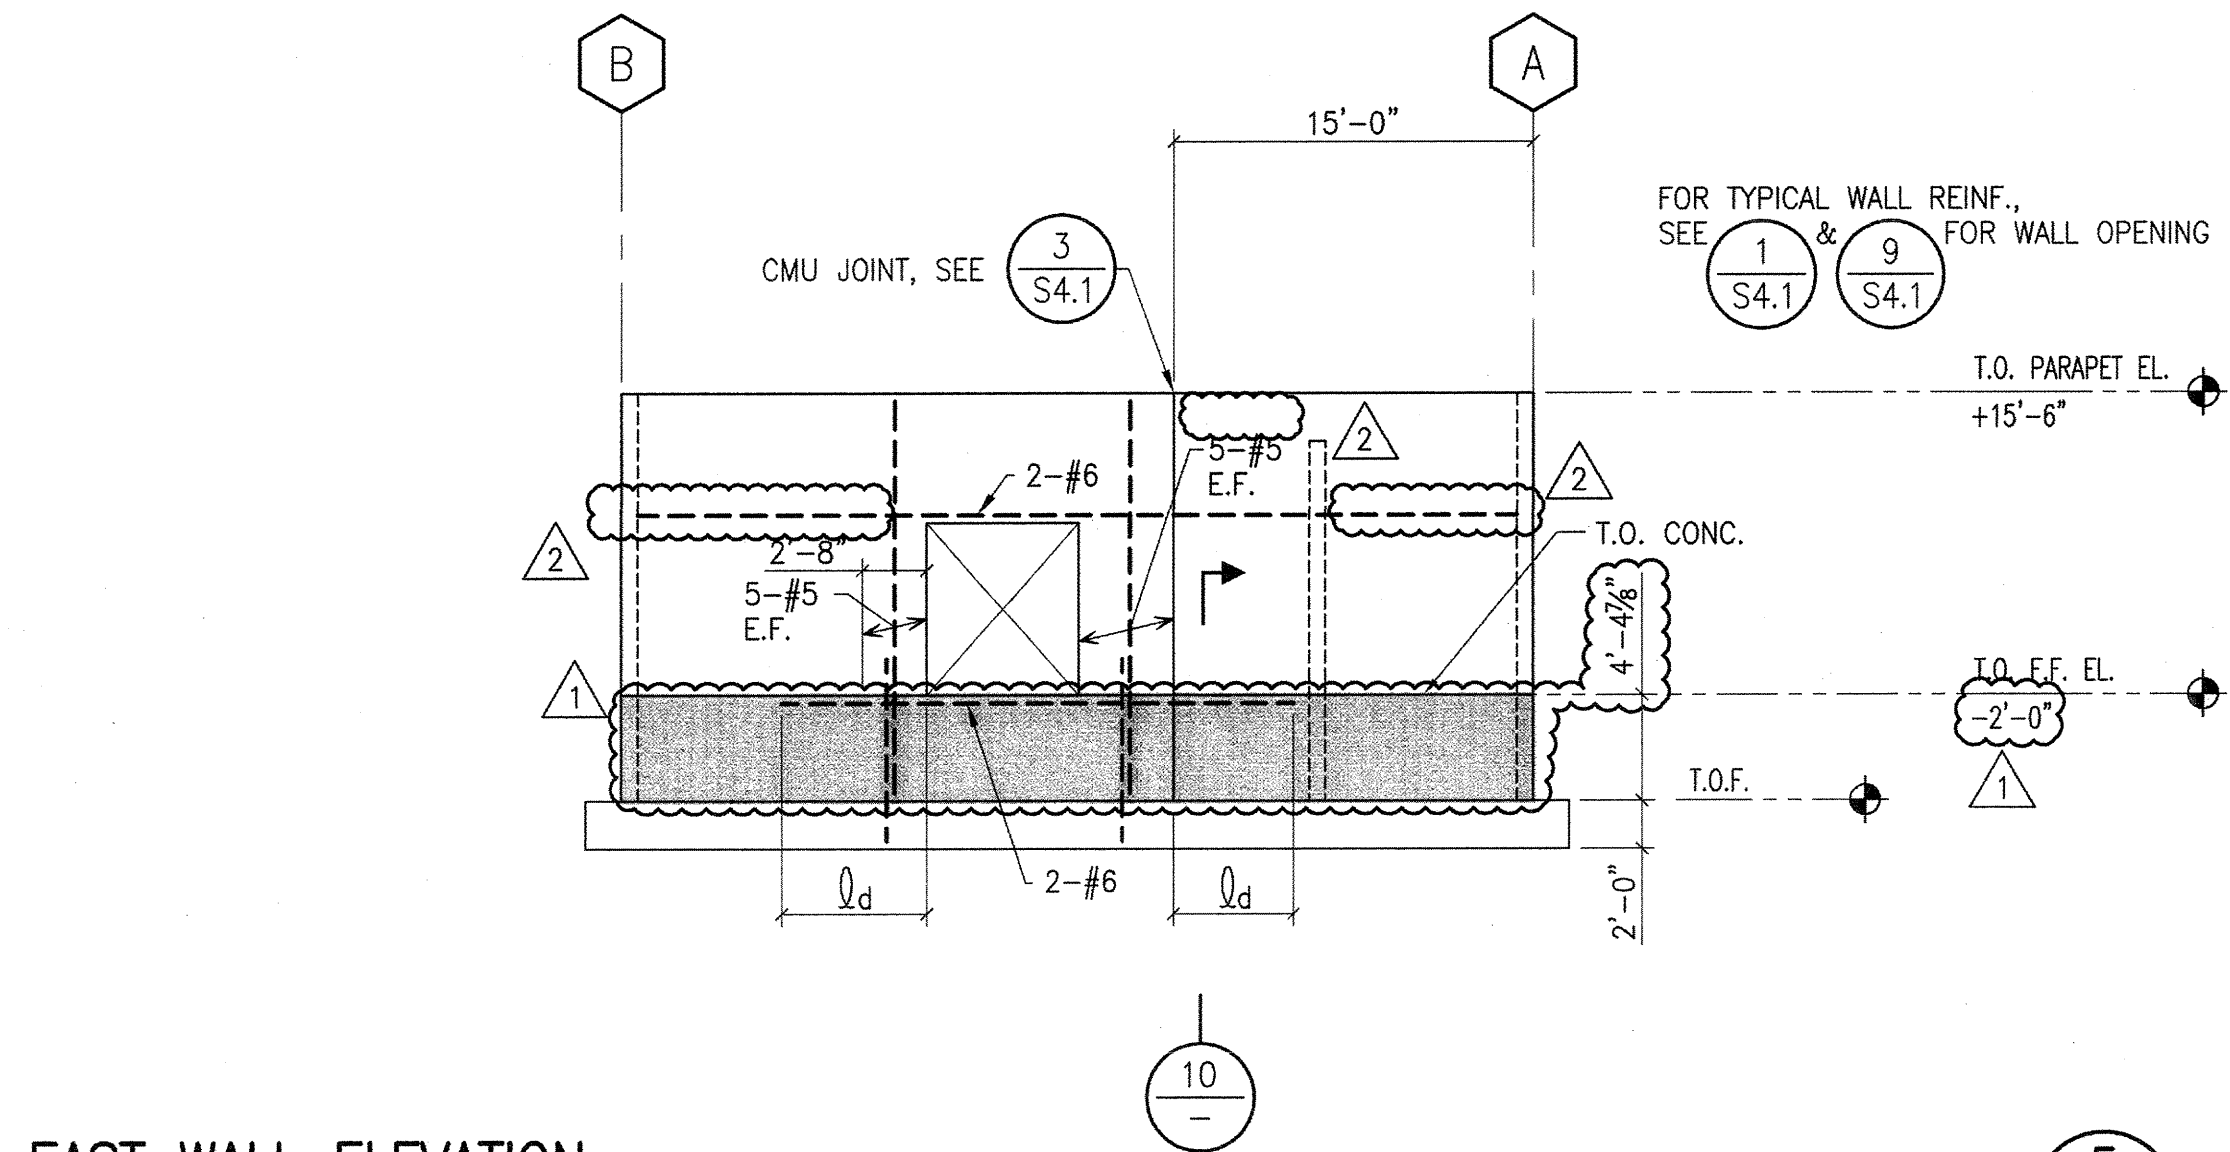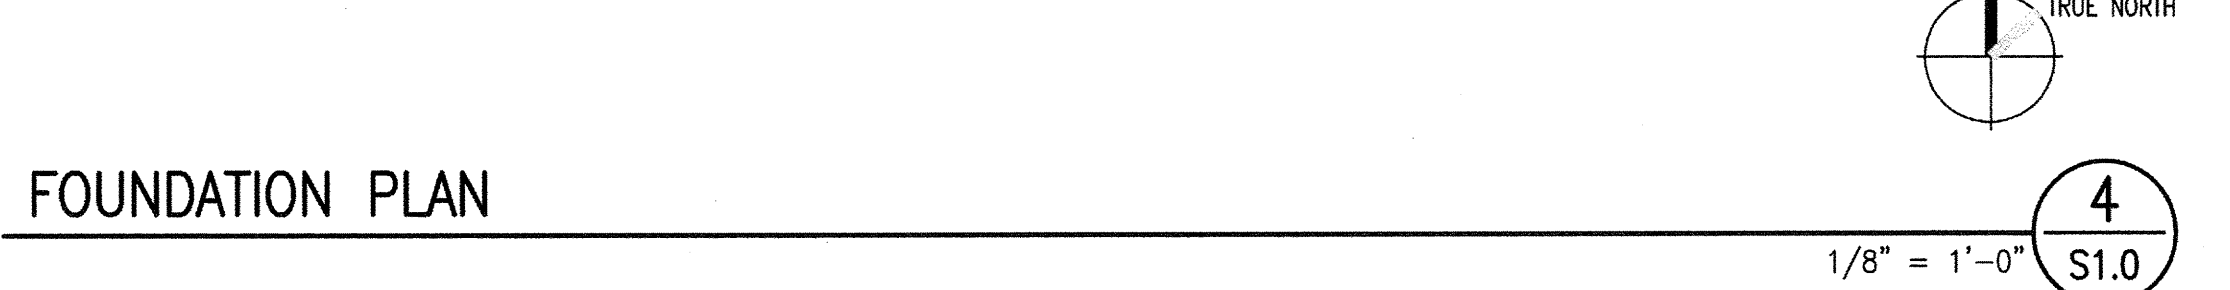

- NOTES:**
- STEEL: FOR TYPICAL DETAILS, SEE SHEET S7.1
 - METAL DECK: FOR TYPICAL DETAILS SEE SHEET S7.1
 - DECK EDGE: ALL BEAMS AT INTERIOR DECK OPENINGS ARE CENTERED 6" FROM EDGE UNLESS OTHERWISE NOTED. CONTRACTOR SHALL COMPARE STRUCTURAL DRAWINGS WITH ALL OTHER DISCIPLINES AND NOTIFY THE ARCHITECT OF ANY DISCREPANCIES PRIOR TO FABRICATION.
 - TOP OF DECK: TYPICAL TOP OF DECK SHALL BE AS INDICATED ON LANDSCAPE ARCHITECTURAL DWG.
 - OPENINGS: NOT ALL OPENINGS ARE SHOWN. ONLY LARGE OPENINGS ARE SHOWN HERE. S.L.D. FOR SIZE AND LOCATION OF OPENINGS. SEE SHEET S7.1 FOR TYPICAL SECONDARY FRAMING AND REINFORCEMENT CRITERIA.
 - CMU WALL
 CMU WALL BLW., U.O.N.
 - S.A.D. FOR DIMENSIONS

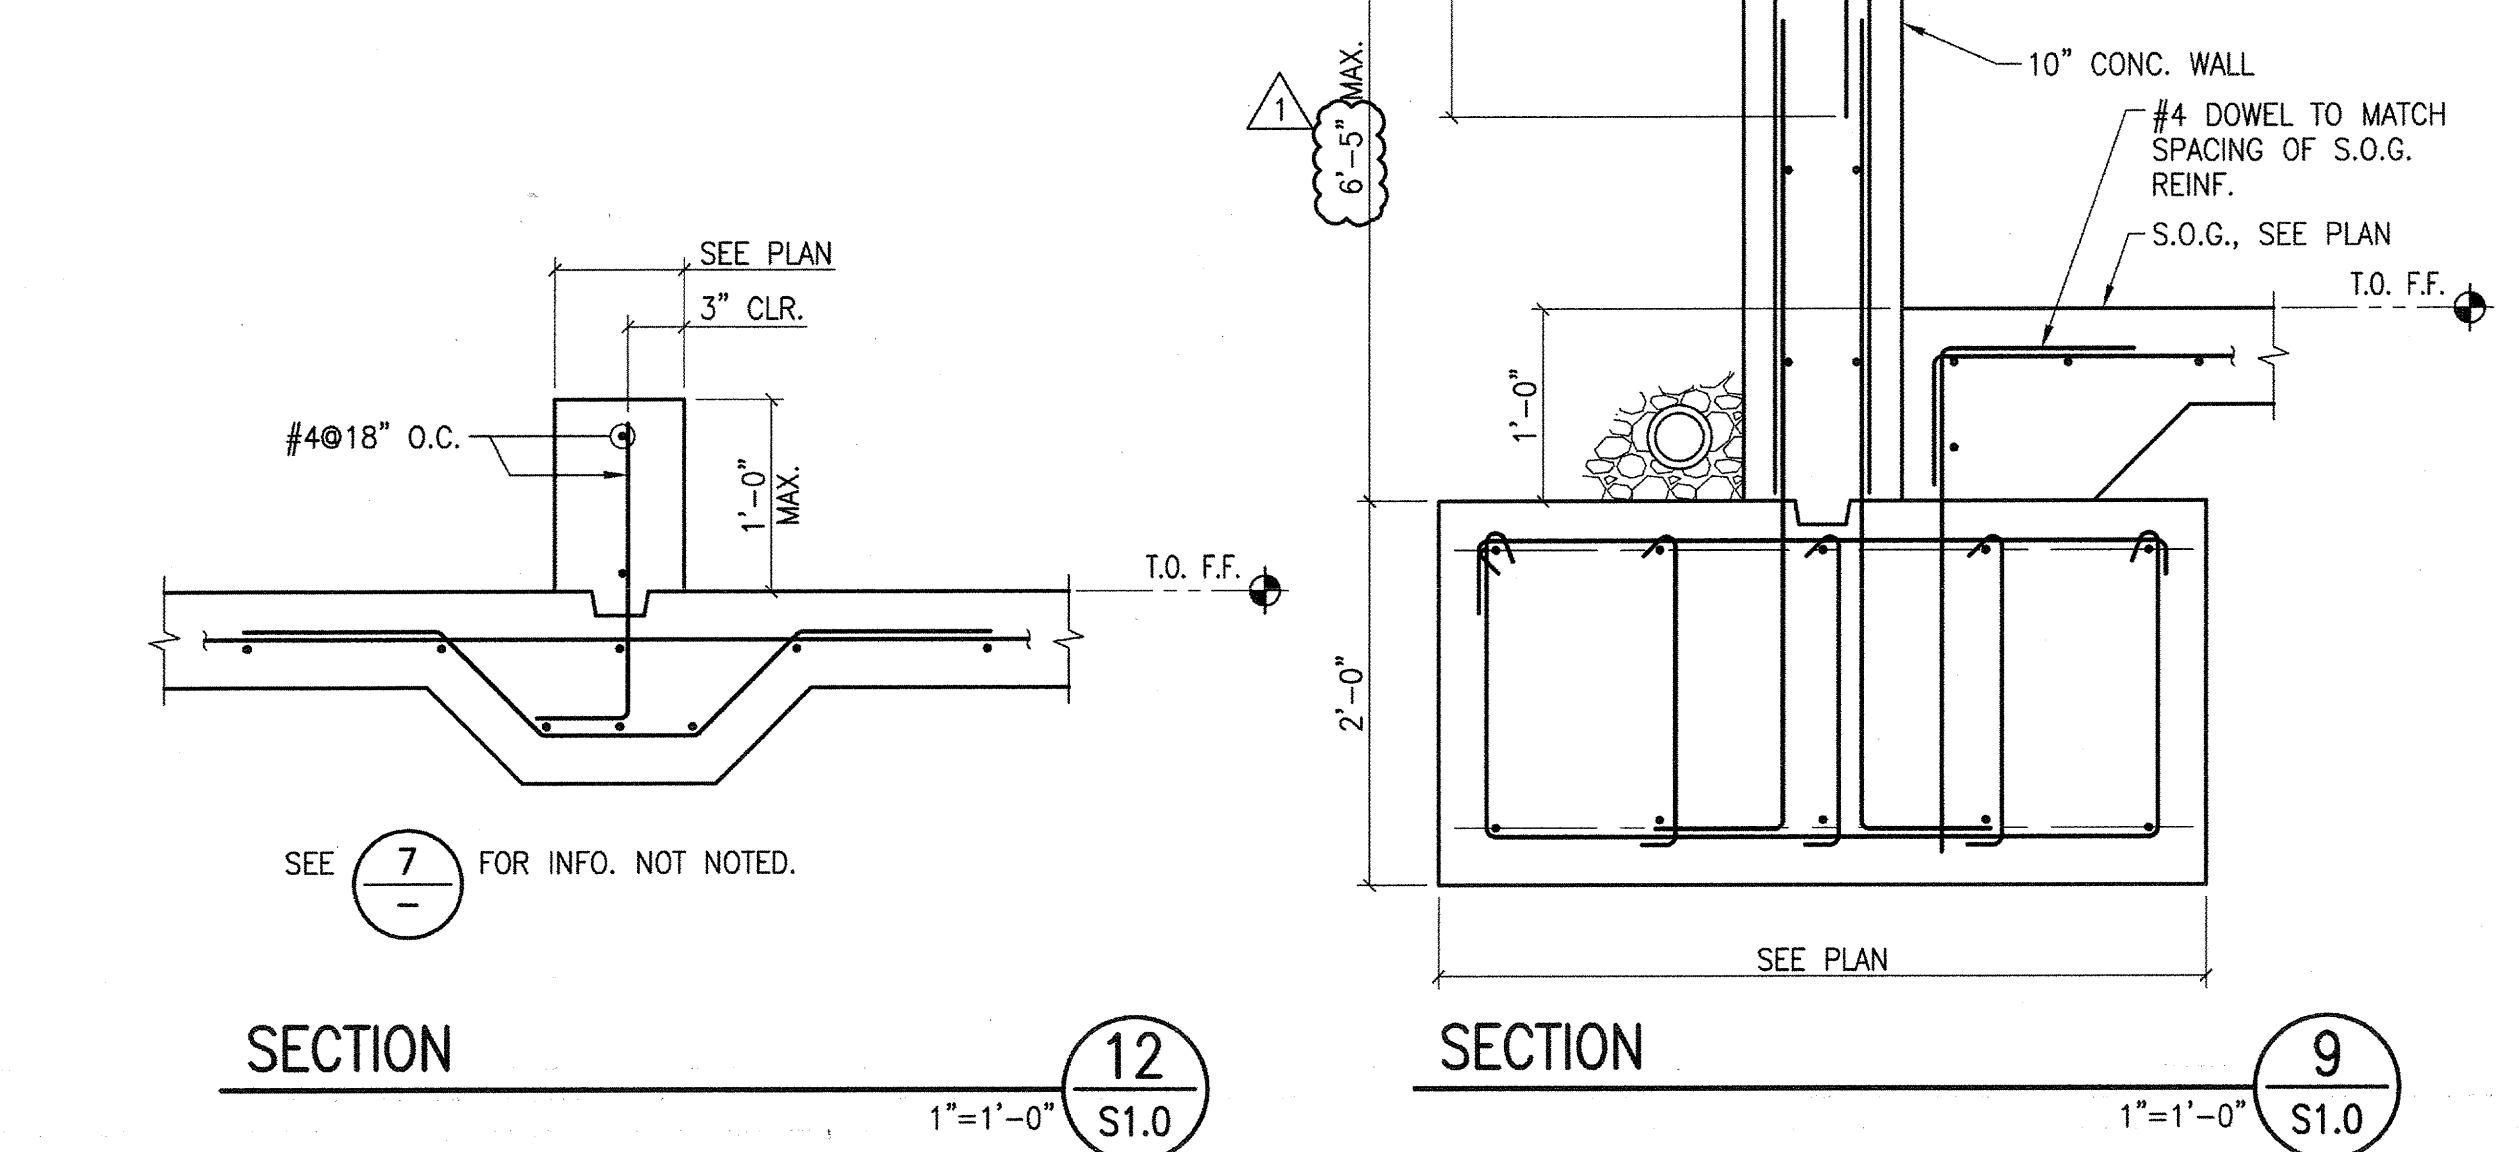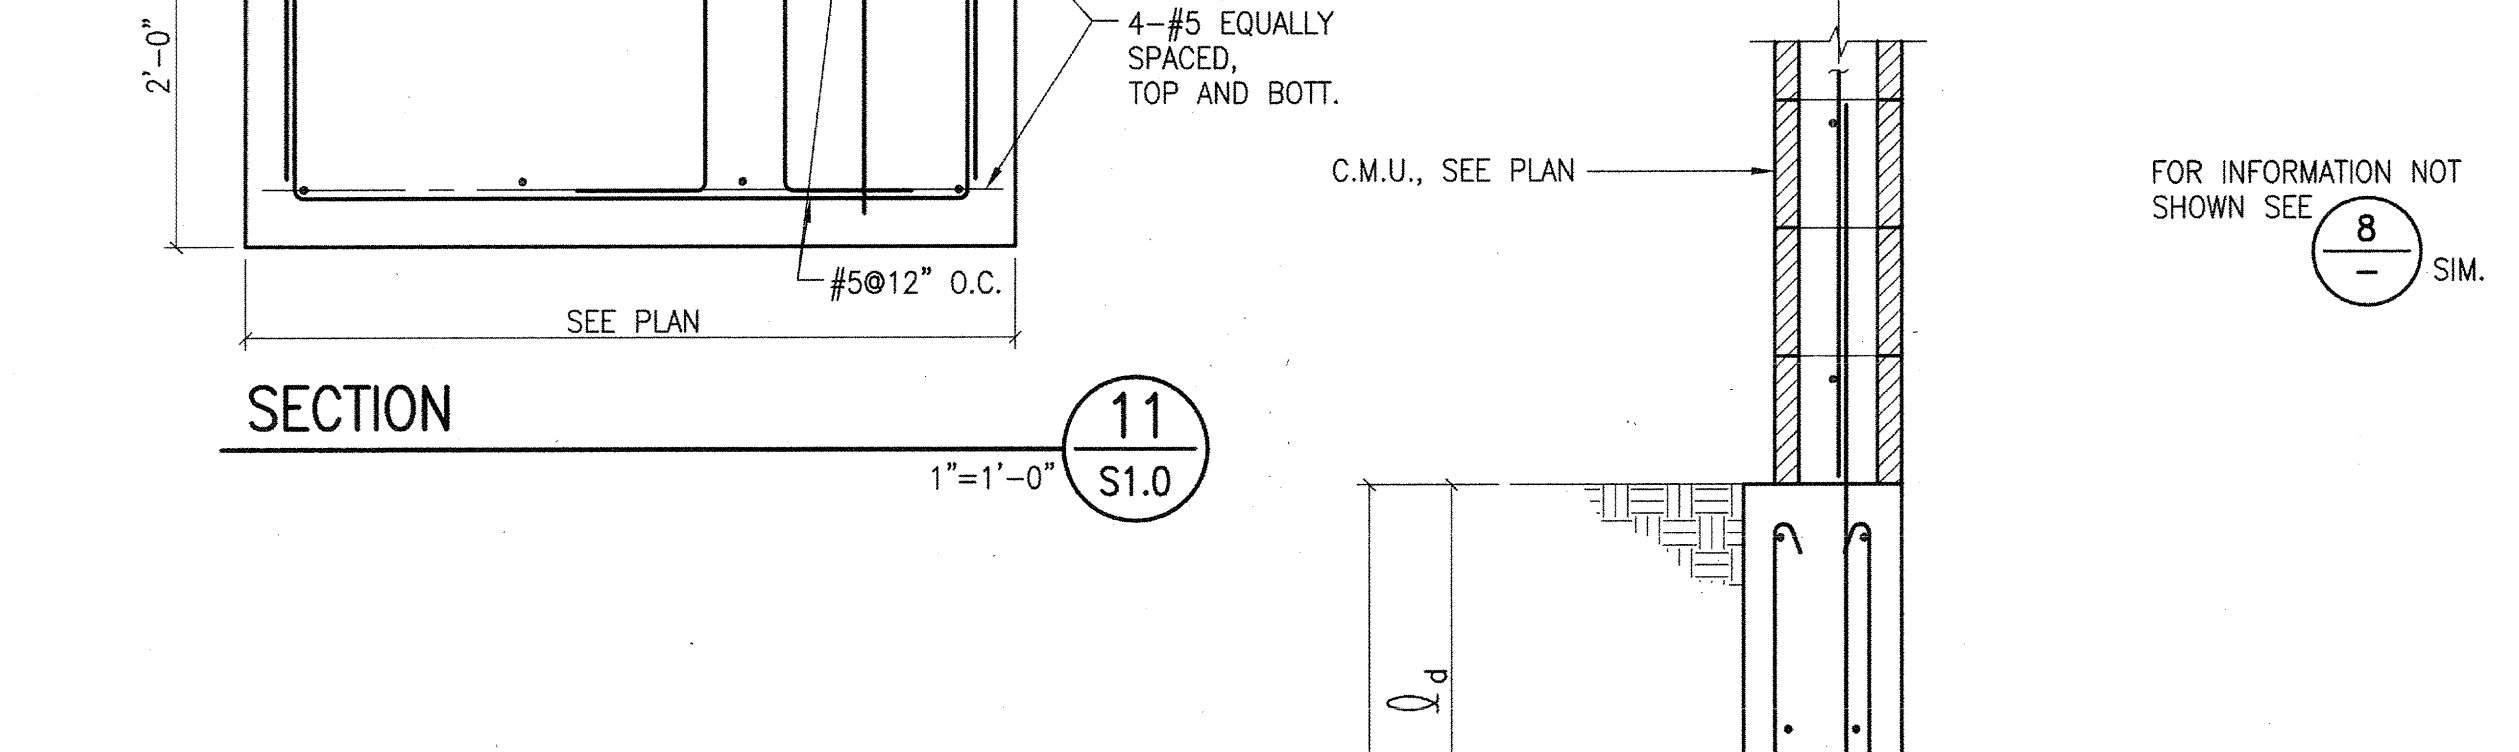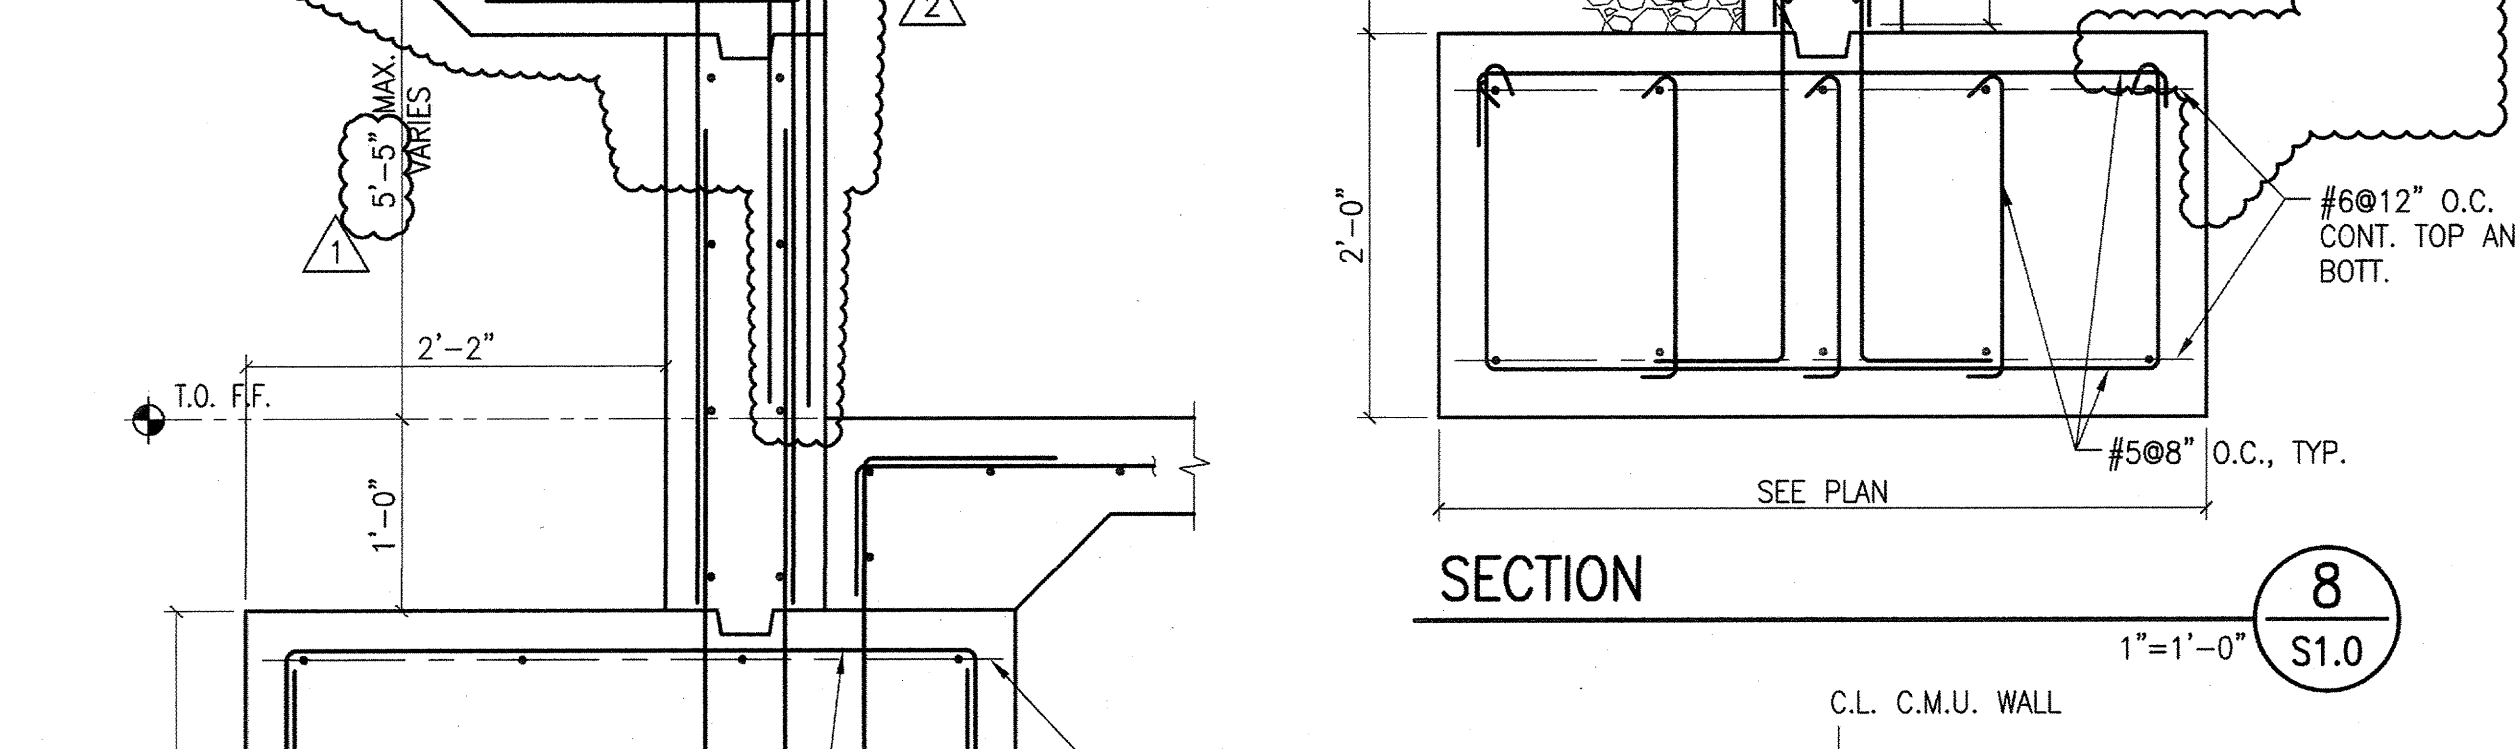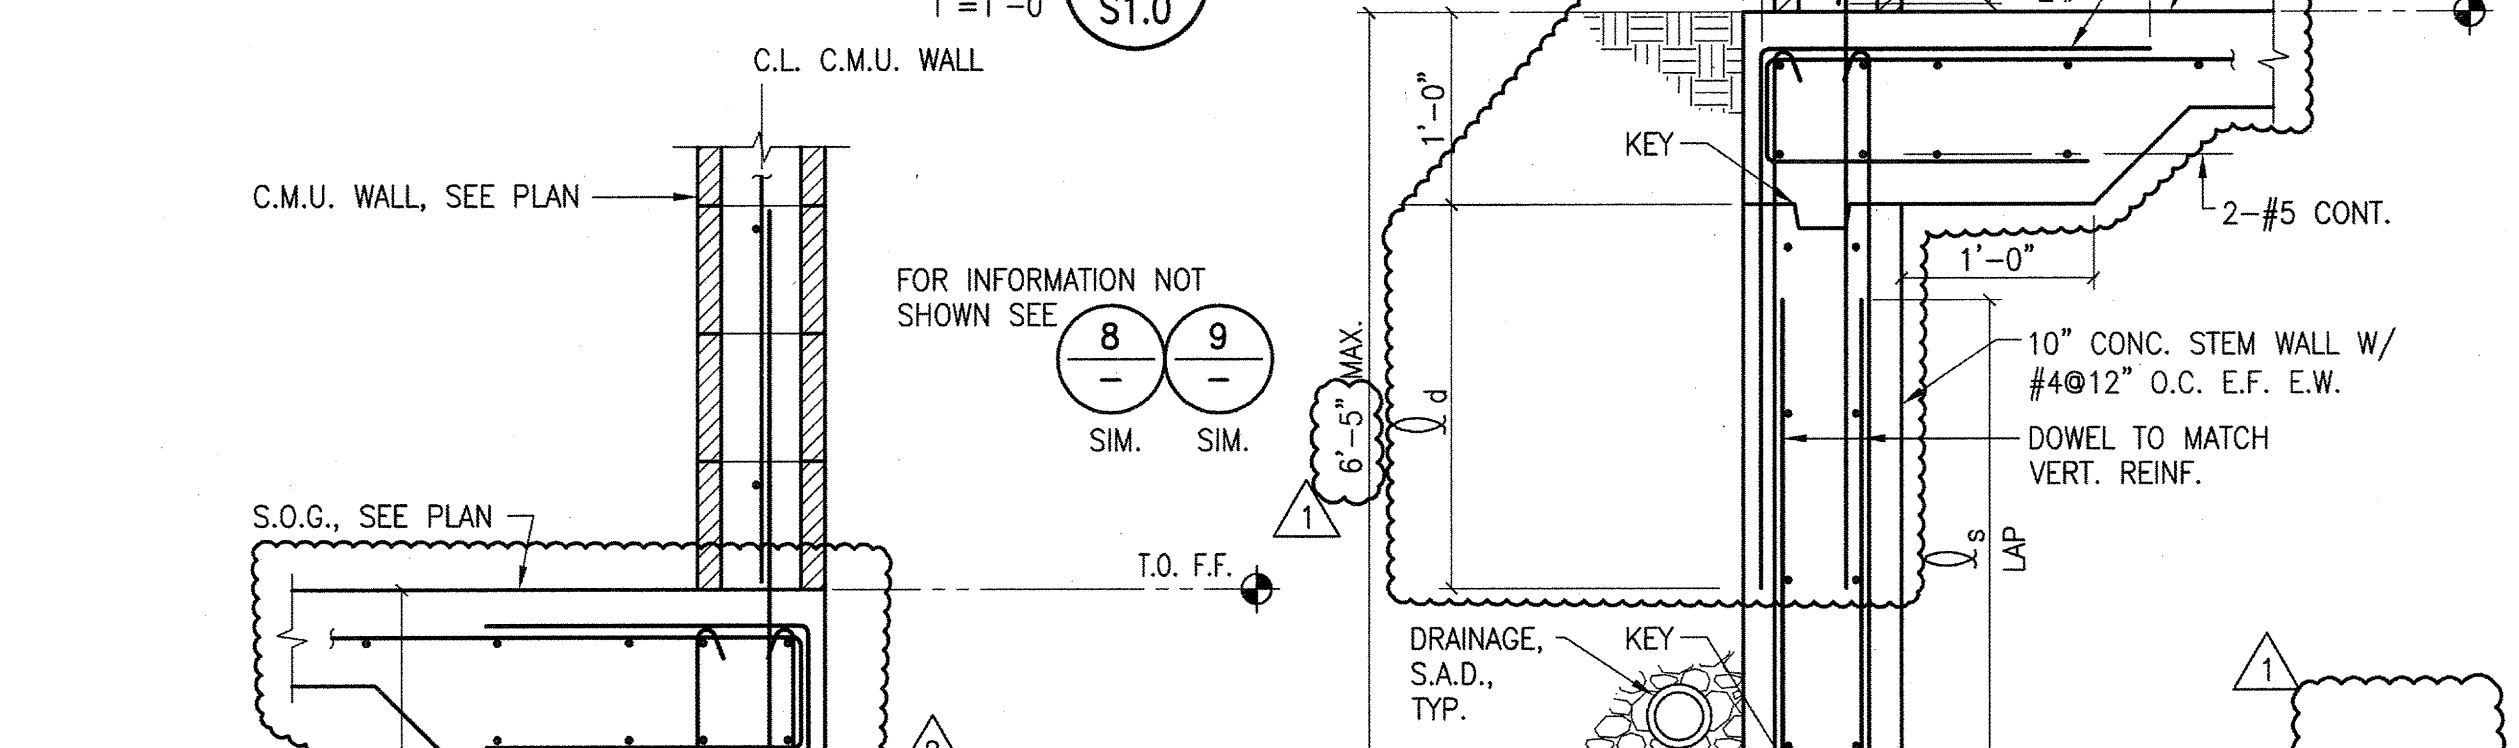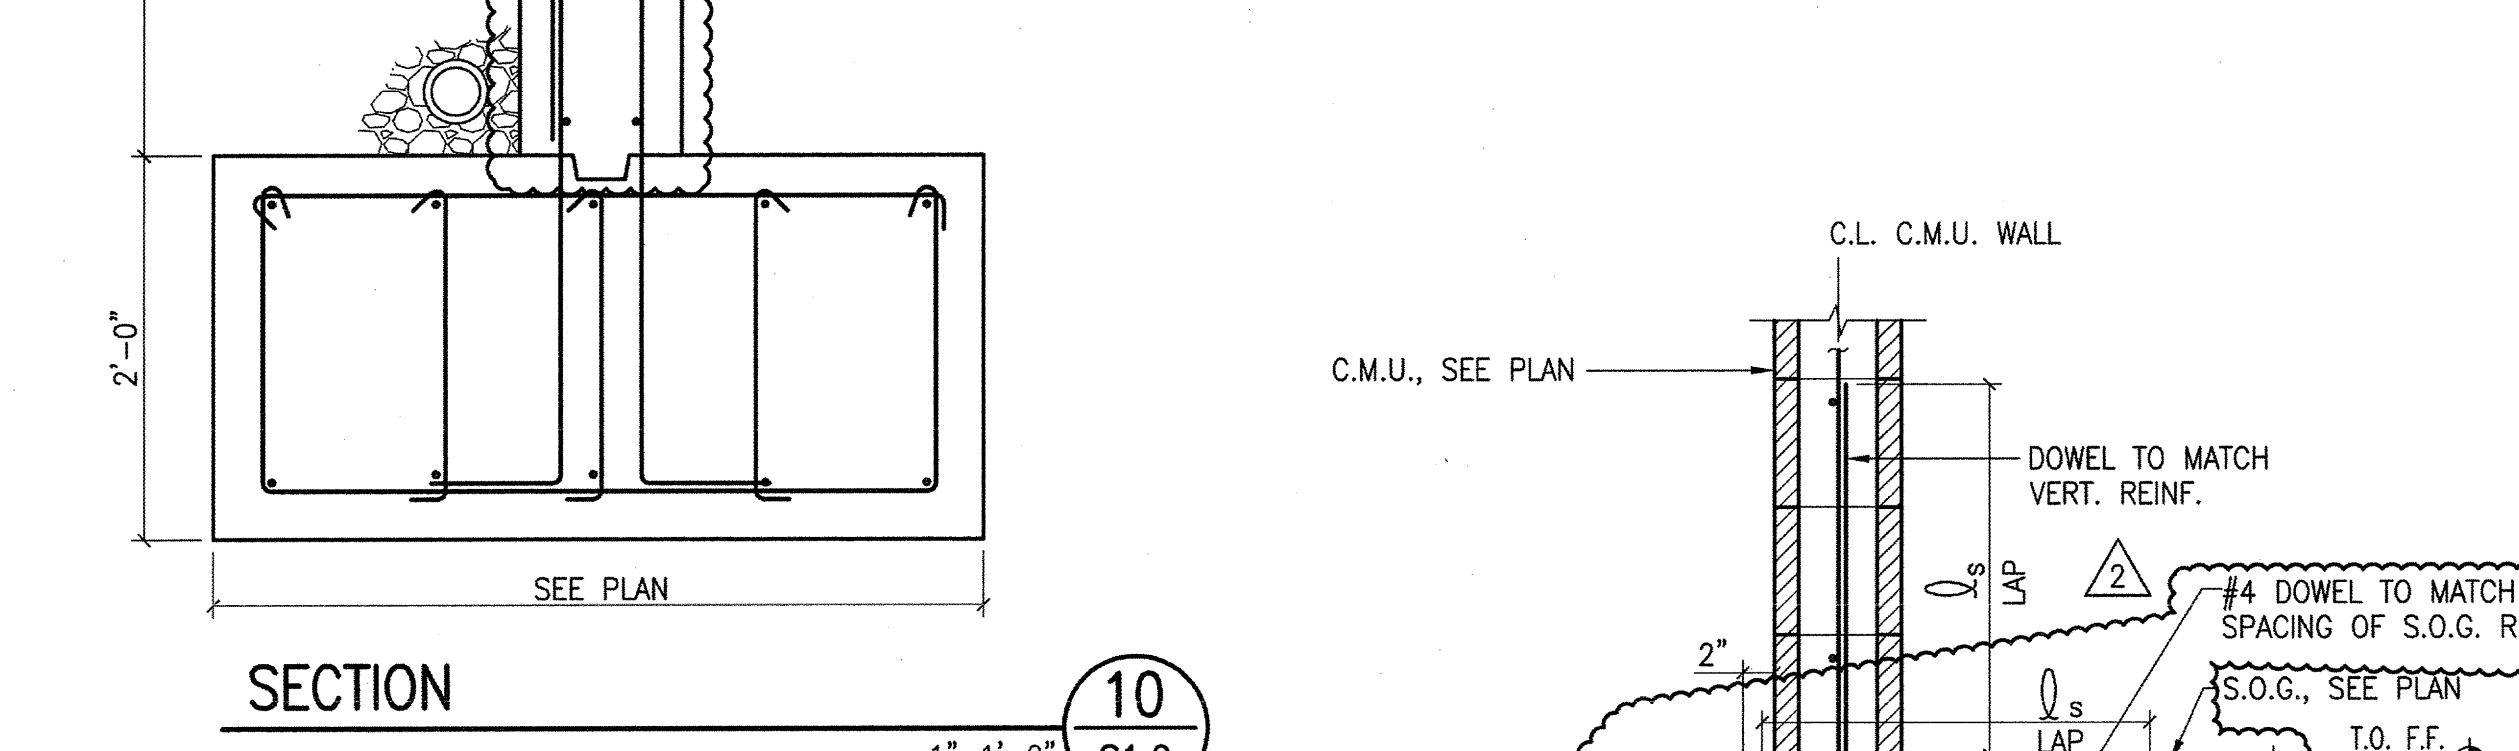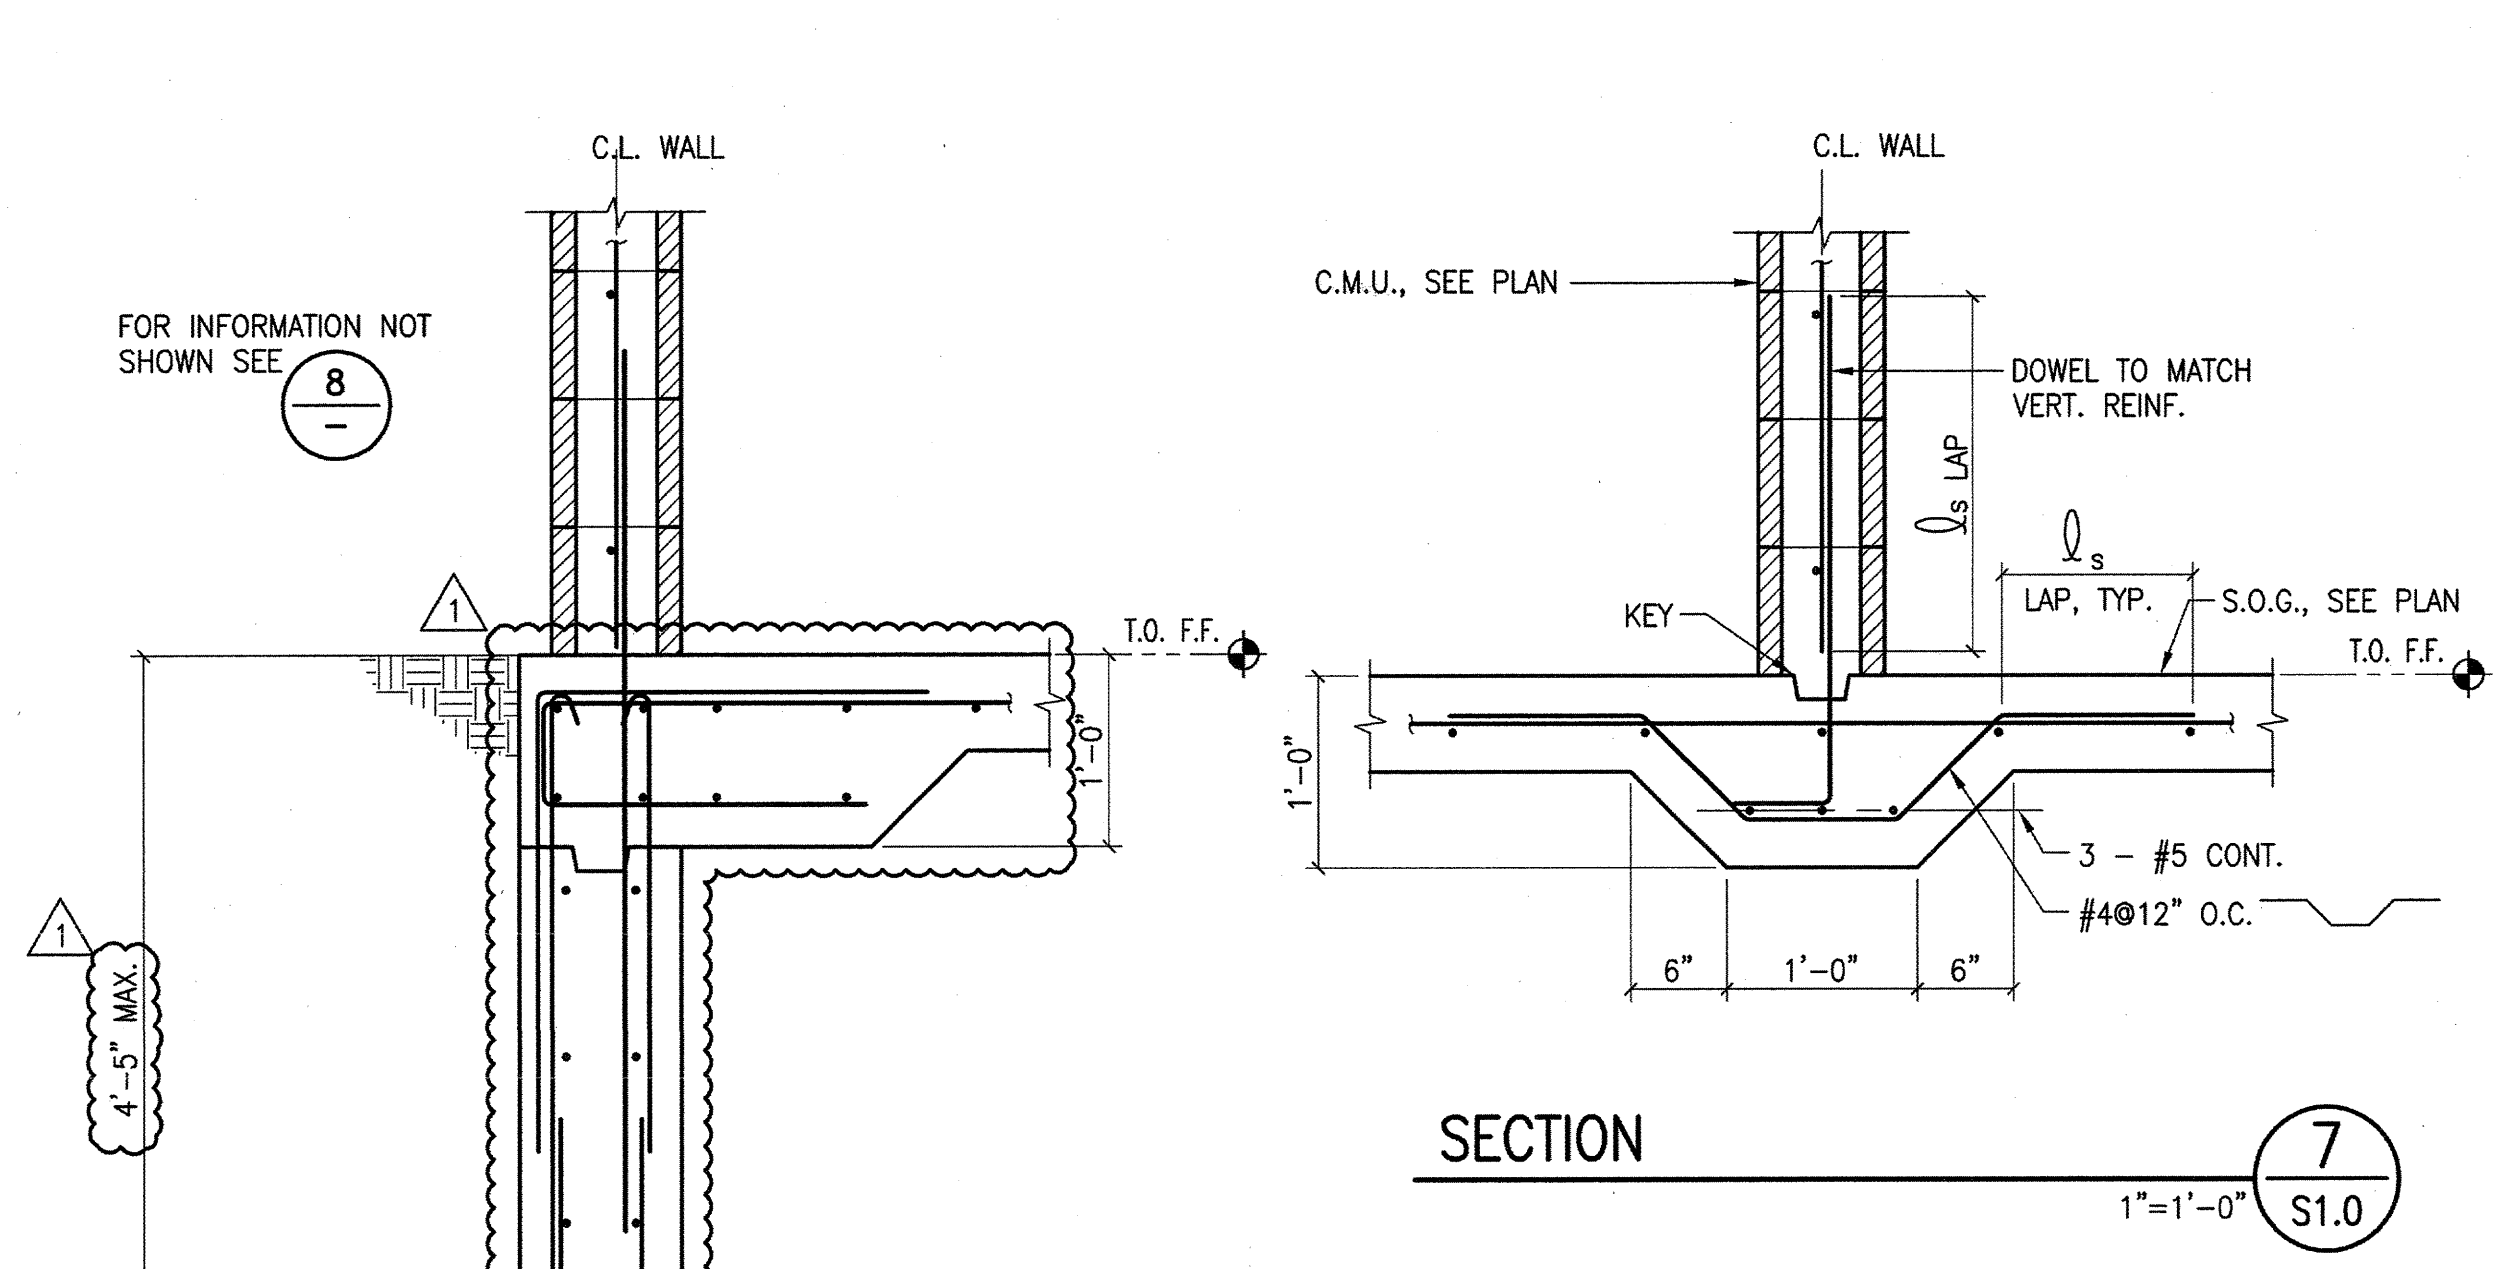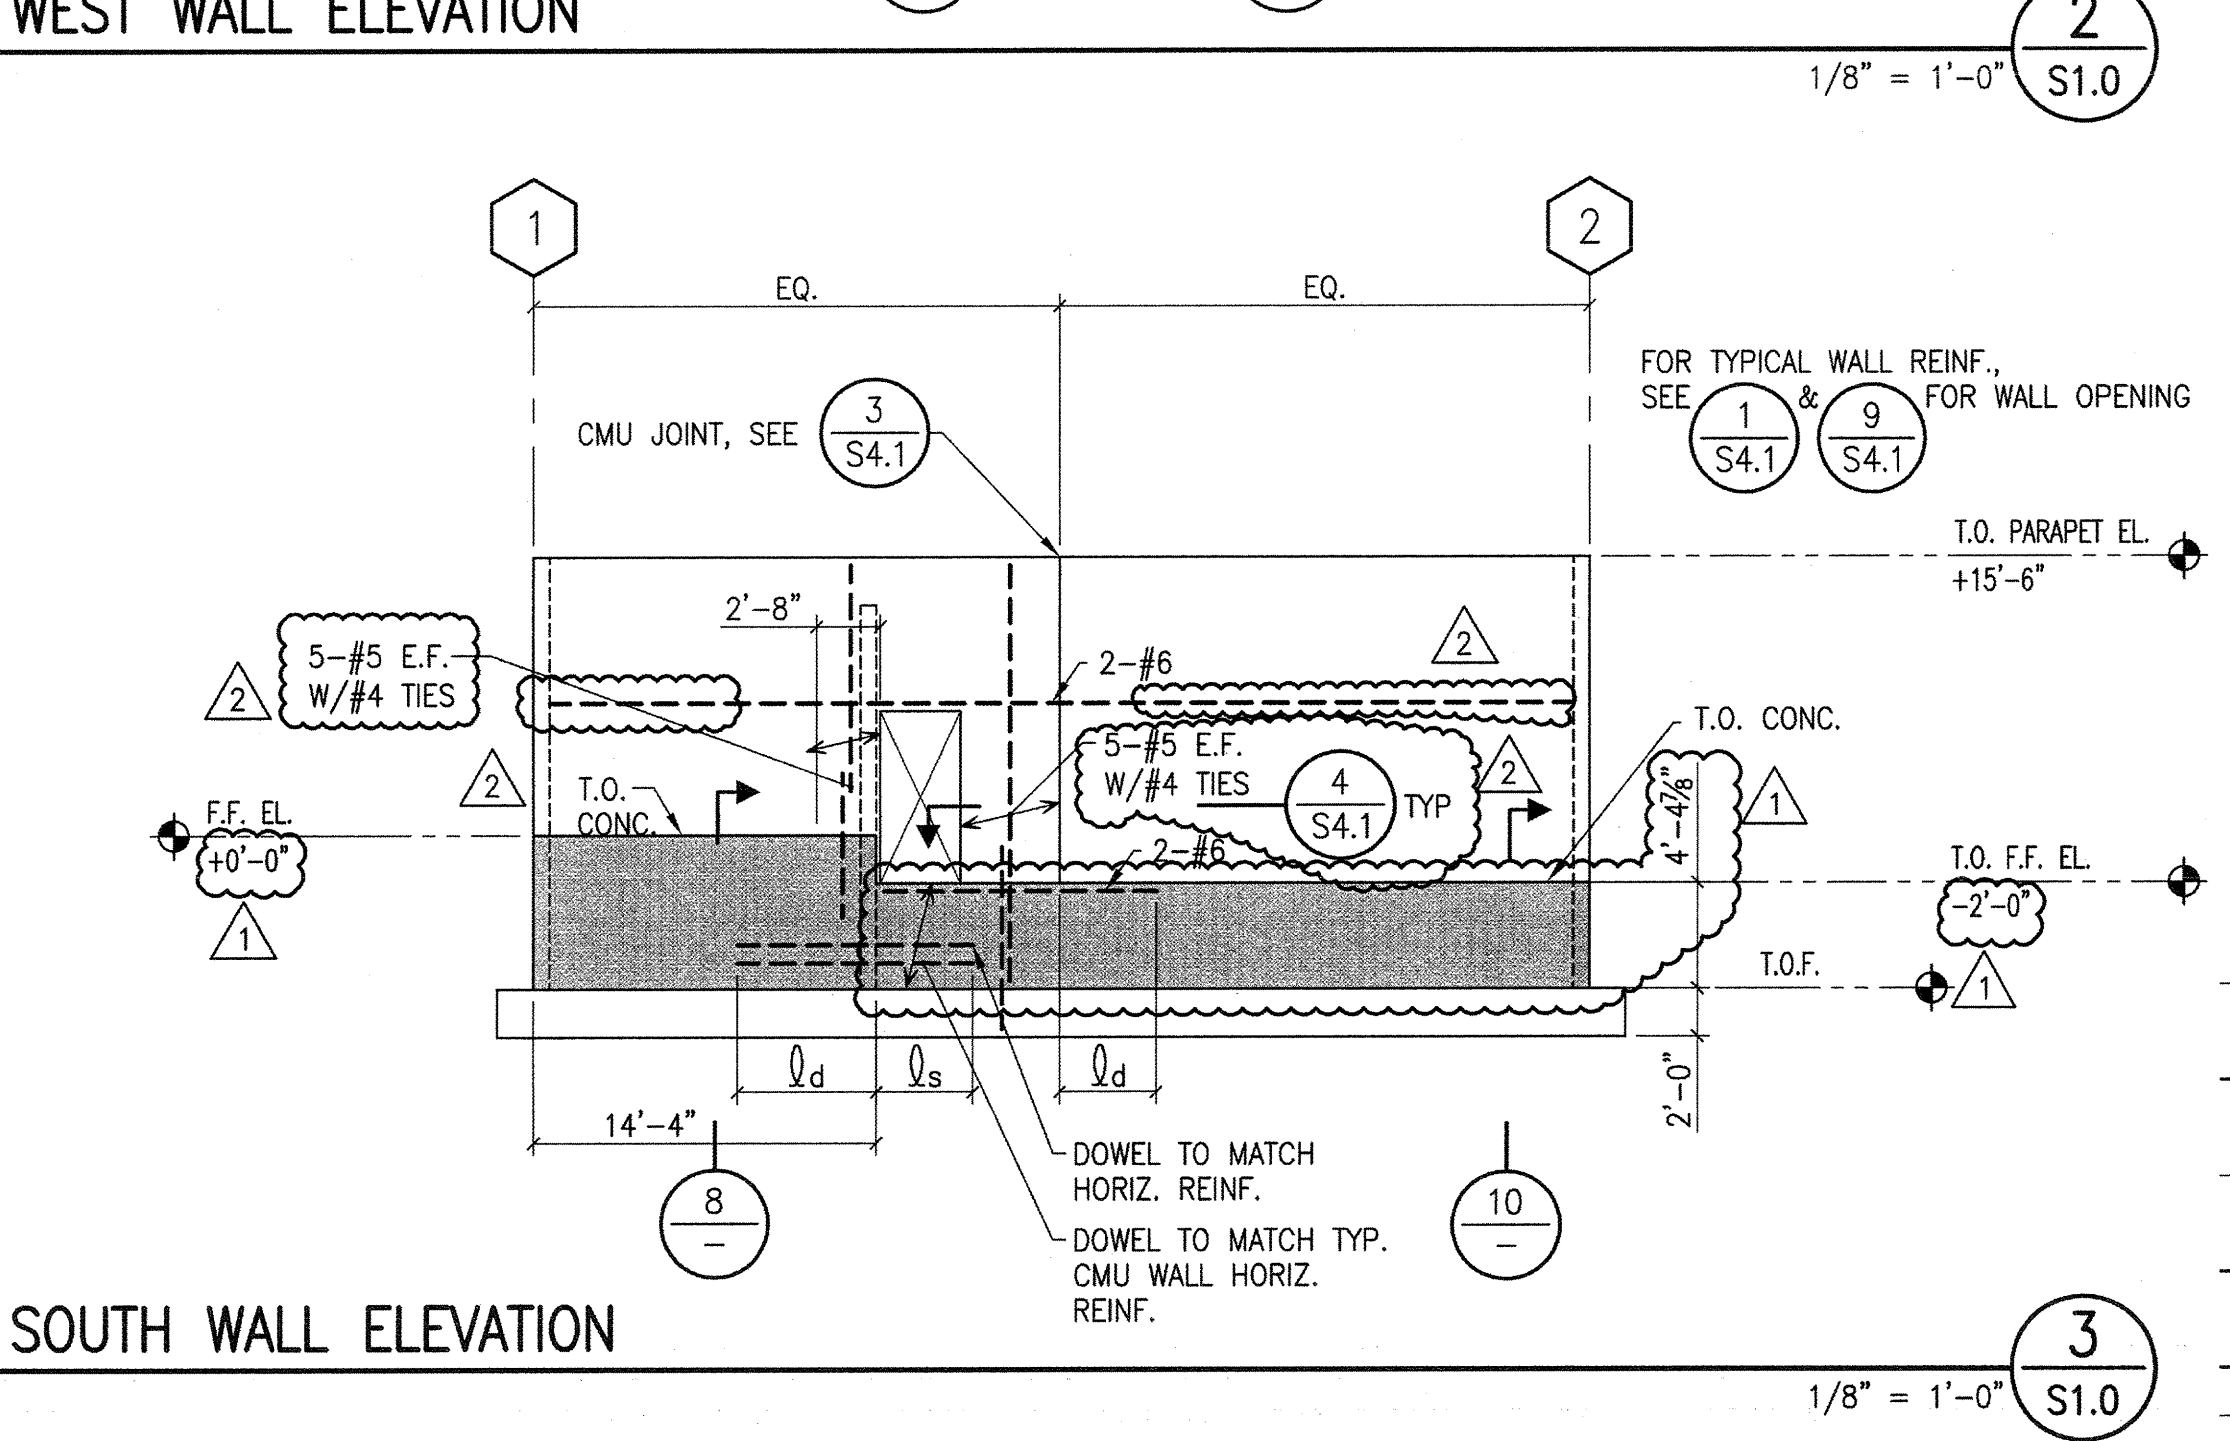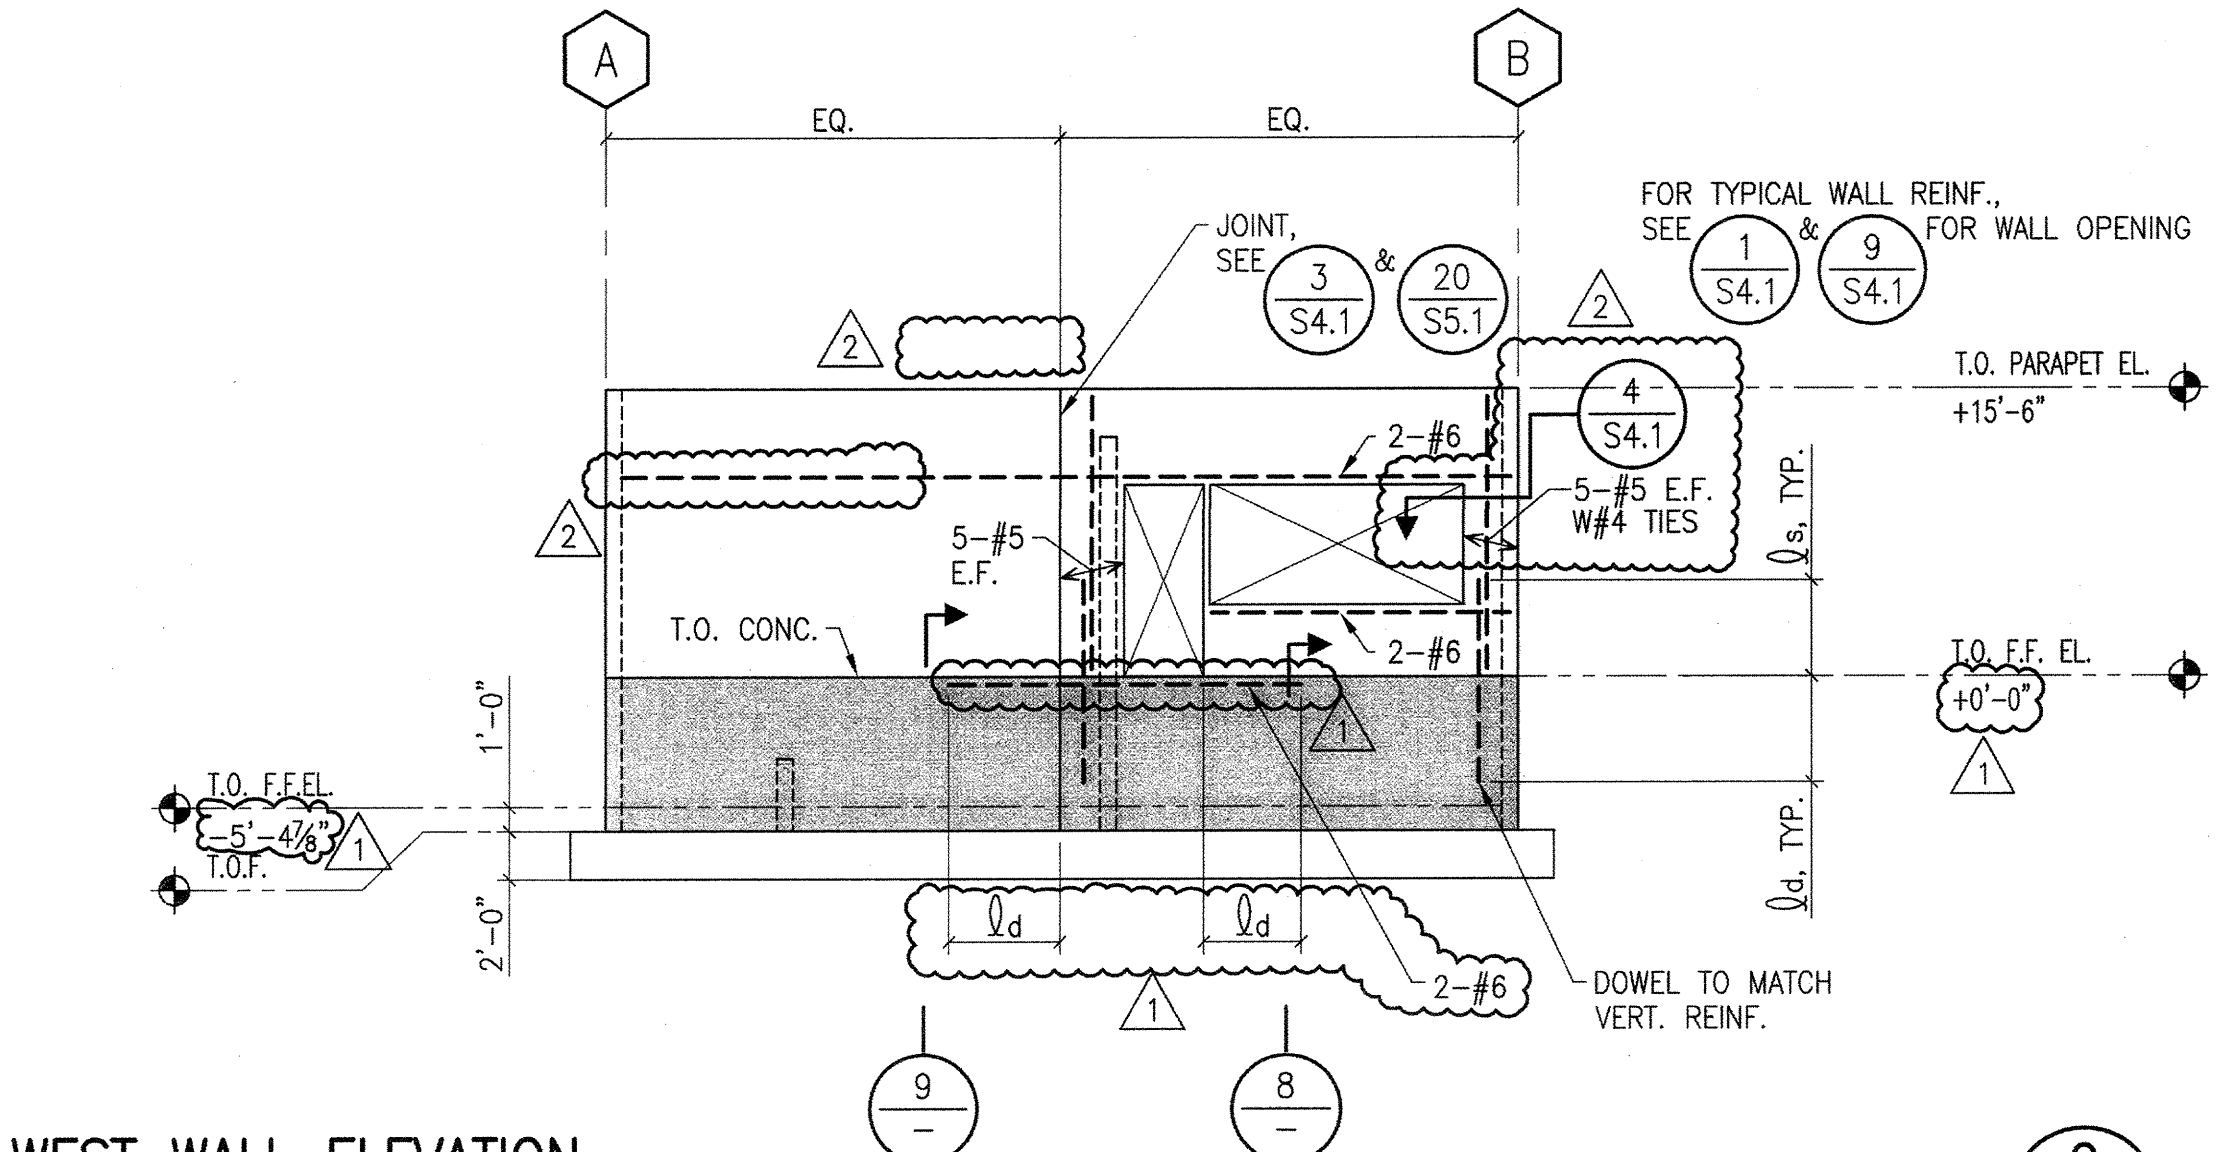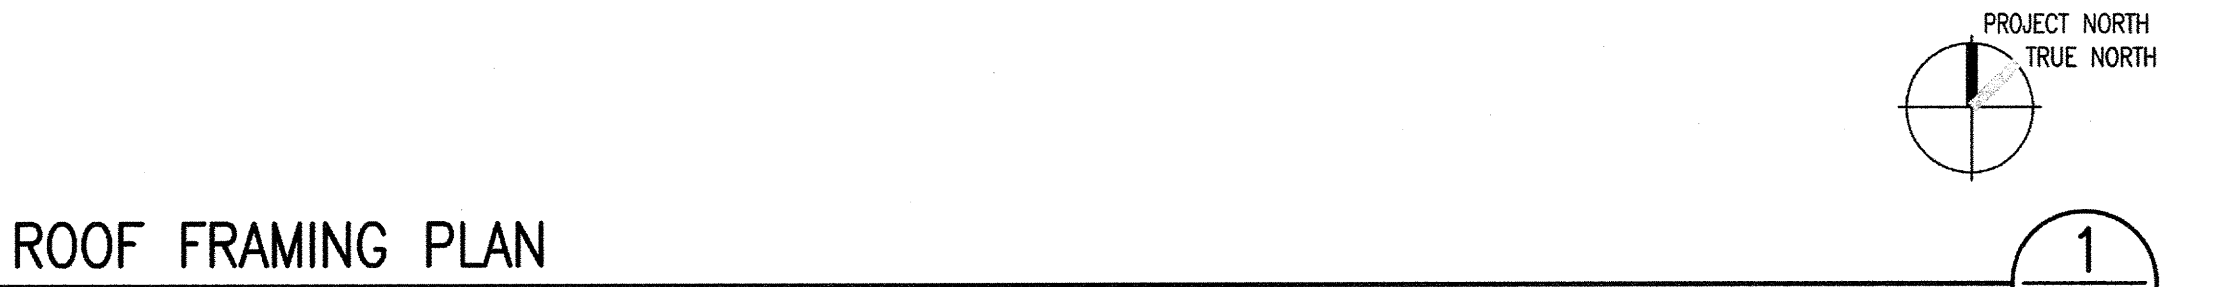

J:\Projects\2009\0313 San Mateo County Community College District\Pool Equipment Building\Drawings\Structural\Sheet S1.0.dwg
 Date: 04/09/09 12:53:37 PM
 User: JACOB
 Plot: S1.0.dwg
 Title: POOL EQUIPMENT BUILDING PLANS, DETAILS AND ELEVATIONS