GENERAL NOTES

A. ALL 277V, NORMAL LIGHTING DEVICES SHALL BE CIRCUITED TO PANEL "1HL1", U.O.N.

B. ALL 277V, EMERGENCY LIGHTING DEVICES SHALL BE CIRCUITED THRU EMERGENCY LIGHTING INVERTER TO PANEL "1EHL", U.O.N.

C. ALL 120V, NORMAL LIGHTING DEVICES SHALL BE CIRCUITED TO PANEL "1LN11/1LN12", U.O.N.

SHEET NOTES

1. EXTERIOR LIGHTS SHALL BE CONTROLLED VIA LCP AND BY PHOTOCELLS LOCATED ON BUILDING ROOF FACING NORTH. CONTROLS SHALL BE INTERFACED WITH THE BMS.
2. NORMAL POWER FEED END.

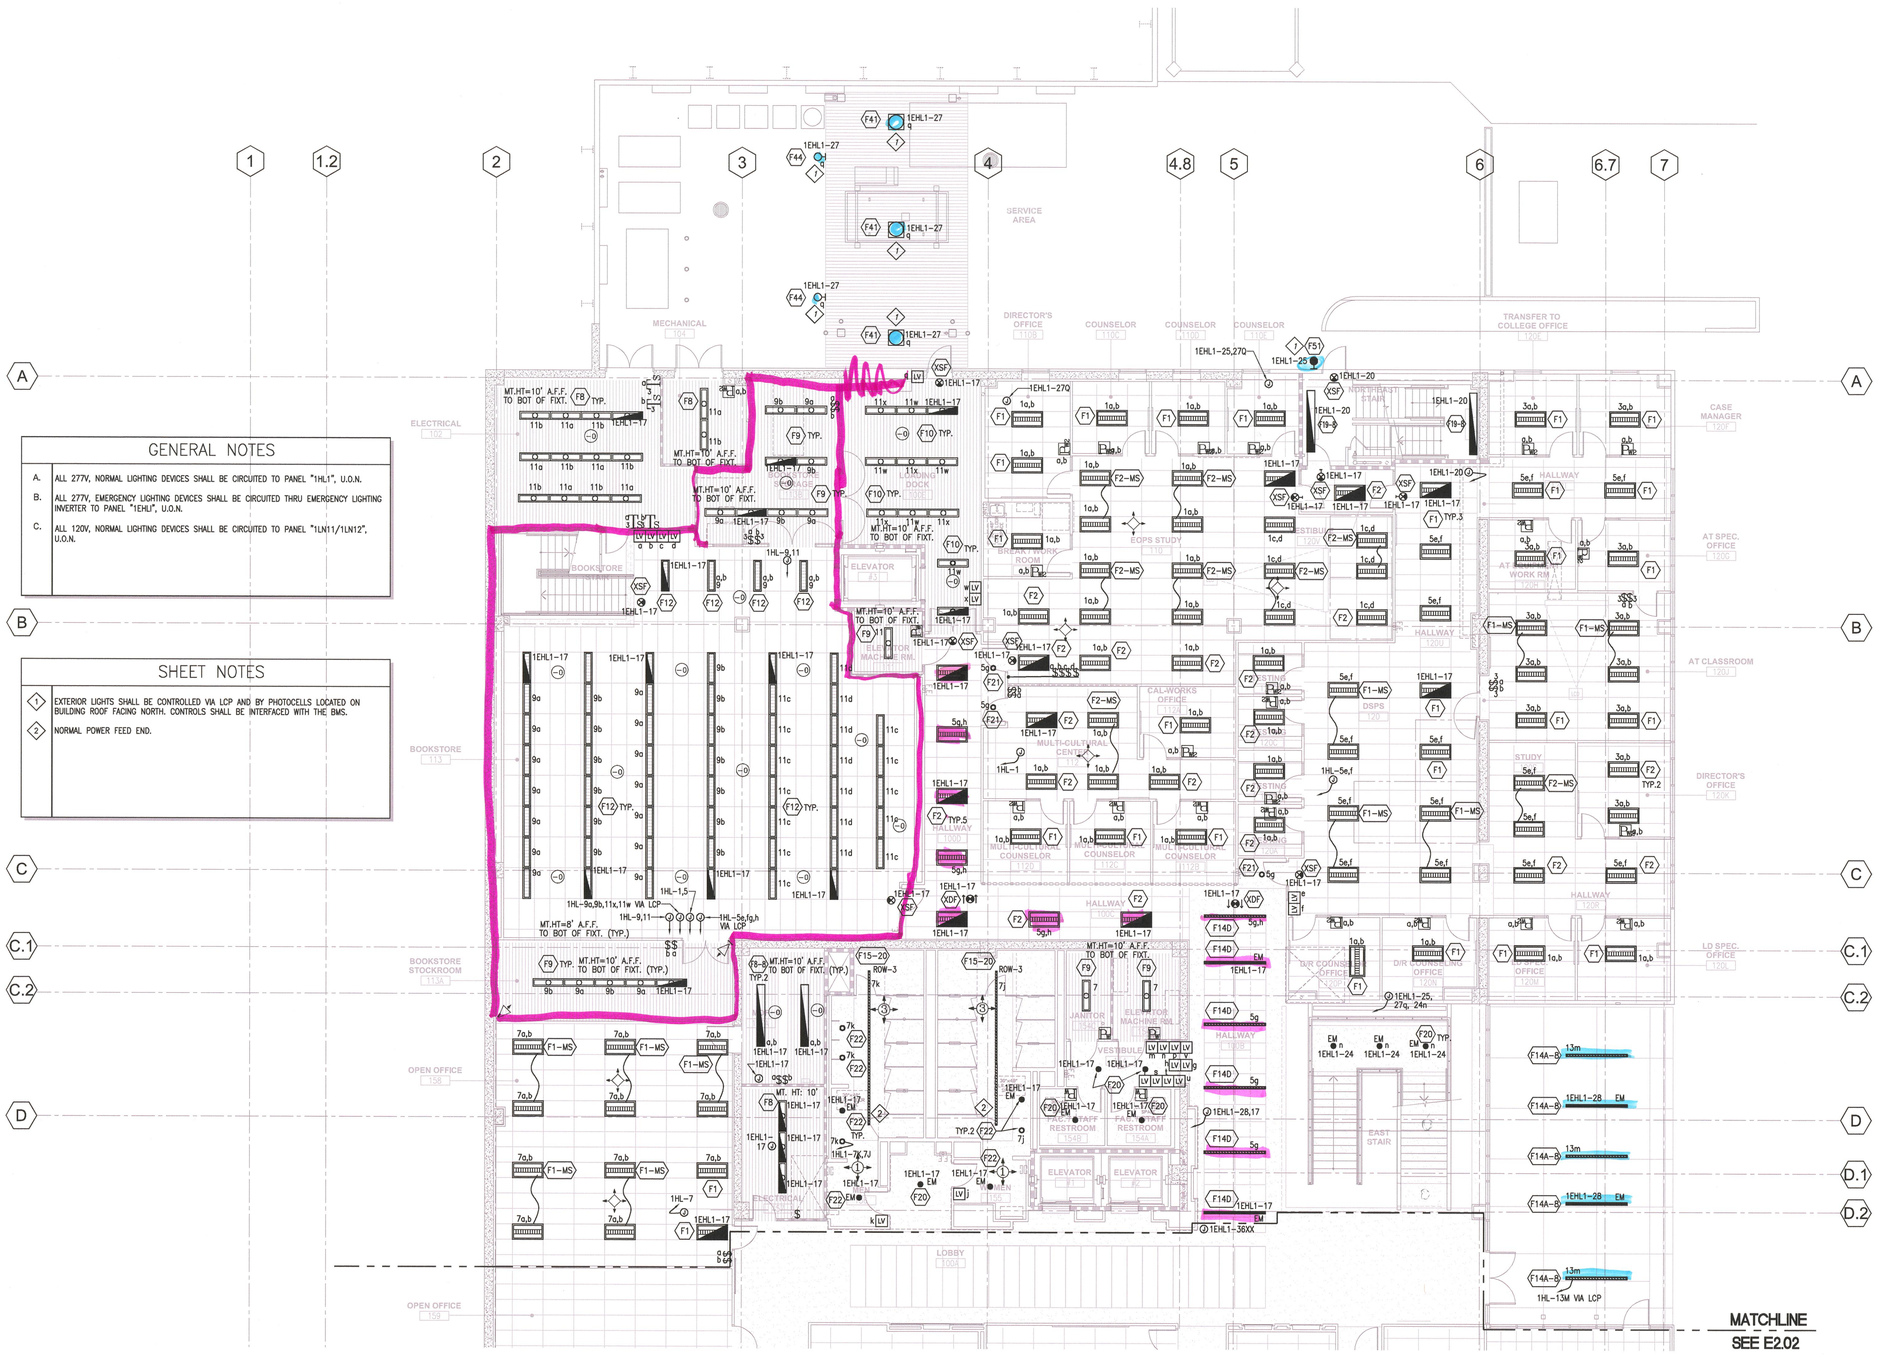

1 E2.01 Lighting Plan - Level 1 - North
SCALE:1/8"=1'-0"

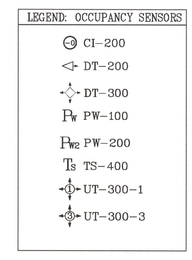

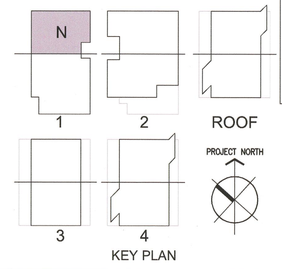

NIGHT LIGHT (BOLLARDS, ENTRIES/ CANOPY EDGE)

SITE LIGHT (IN WALL, SCONCES)

Bookstore Floors 1 + 2

Floors 1 + 2 circulation

Dining Room

Learning Center

Floors 3 + 4 circulation

Floor 3 A+R

\\REISJENG\S2ENG2\Eng_2\Current Projects\College of San Mateo-Bldg 10N_300085\Electrical Design-DOR_01-07-2011\300085_10N_E2.01.dwg - Feb 14, 2011 Monday - 10:54am - 30x42-Plt - fferaren

McCarthy Building Companies, Inc.
343 Sansome Street, 14th Floor
San Francisco, California 94104
P 415 | 397-5151
F 415 | 397-5999

IDENTIFICATION STAMP
DIVISION OF THE STATE ARCHITECT
OFFICE OF REGULATION SERVICE
APPL. #: 01-110095
AC _____ FLS _____ SS _____
DATE _____
FILE NUMBER: 41-C1

REGISTERED PROFESSIONAL ENGINEER
ERNESTO ANTONIO HERNANDEZ
E015390
EXP.6/30/11
ELECTRICAL
STATE OF CALIFORNIA

BUILDING QUALITY BUILDING VALUE BUILDING PEOPLE
ROSENDIN ELECTRIC
www.rosendin.com
CORPORATE HEADQUARTERS
880 Mabury Road
San Jose, CA 95133
(408) 286-2800
Arizona California Nevada New Mexico Oregon

This and all other project documents and all ideas, conflicts and designs incorporated therein are instruments of service. All project documents are the registered property of LPA, INC. (LPA) and cannot be lawfully used in whole or in part for any project or purpose except as described in the contractual agreement between McCarthy and the District. LPA hereby reserves all rights in the event of any unauthorized use, reproduction or modification (whether) in not only patently but carbonically blade alt parties involved with release to fully indemnify and defend LPA and LPA's Consultants to the maximum legal extent applied all losses, demands, claims or liabilities arising directly or indirectly from project document release. Project documents describe design intent of work and are not a representation of as-built or existing conditions. LPA and LPA's Consultants make no representations concerning the accuracy of documents and are not responsible for any discrepancies between project documents and the existing conditions.

© Copyright 2007

College of San Mateo
Building 10N

San Mateo, CA

Developed for
San Mateo County Community College District

Rev&dsn	Description	Date
FCO #1	EXIT SIGN COORDINATION	07/27/10
- FCO 041	PROVIDE ON AIR SIGN	12/14/09
- FCO 023	ELECTRICAL COORDINATION FOR CONFERENCE ROOM 1 AT FLR 2	03/24/10
- FCO 038	DSA CO-01 Conformed Set	03/24/10
- FCO 039	3RD FLR FINANCIAL AID CHANGES	03/24/10
- FCO 040	7TH FLR V.P. SUITES CHANGES	03/24/10
- FCO 041	7TH FLR CONFERENCE ROOM 481 & 431 RECEIVED	03/24/10
- FCO 106	ELECTRICAL - DRAWING OF RECORD	01/21/11

Rev&dsn	Description	Date
	100% Design Development	06/06/08
	50% Construction Documents	07/25/08
	DSA Submittal	09/18/08
	95% Construction Documents	12/08/08
	DSA Final	03/11/09
	ELEC RM CHANGES PER ARCH'T	07/28/09
FCO 014		08/05/09
FCO 016		09/10/09
	4TH FLR OFFICES REVISION PER OWNER - FCO 026	11/20/09

DRAWING OF RECORD
ROSENDIN ELECTRIC, INC.
DATE: 01-21-2011

Job. No.
Date March 2009
Drawn by
Checked by
Scale

LIGHTING PLAN
LEVEL 1 - NORTH

E2.01