




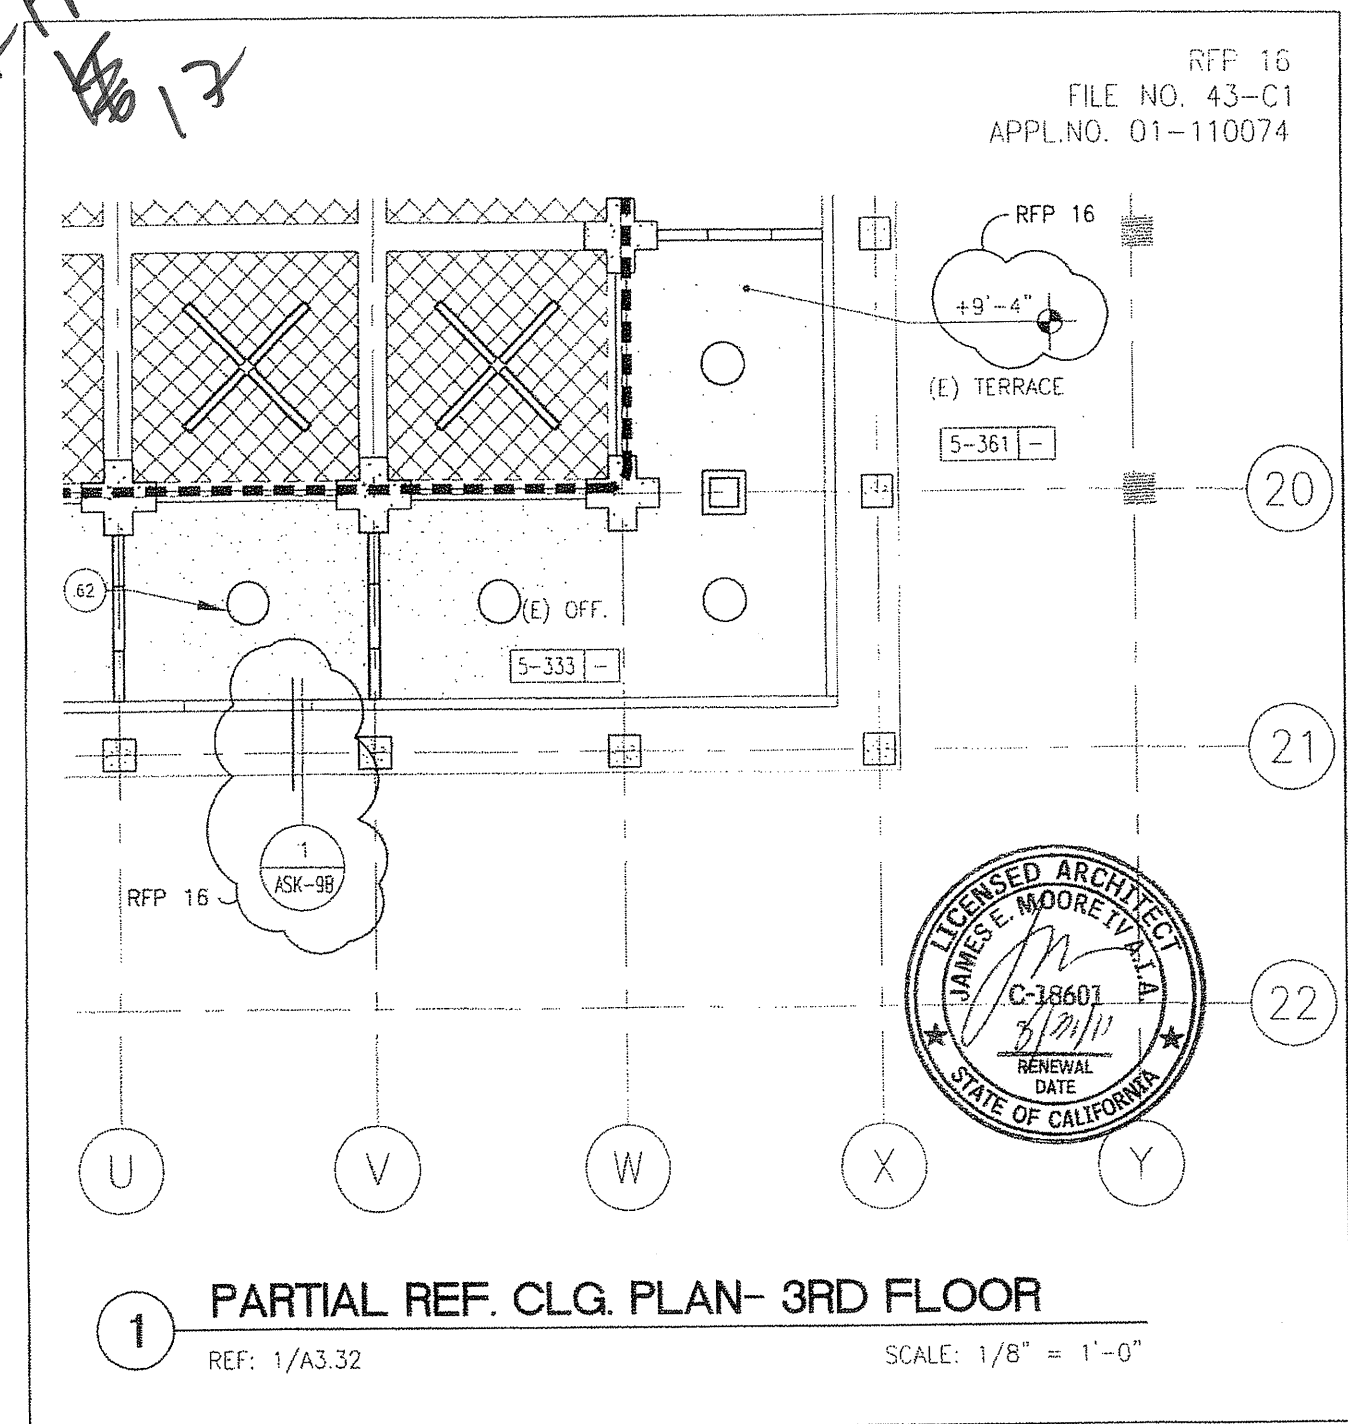

BCIA ARCHITECTURE
PLANNING
INTERIORS

PROJECT: SOFFIT AT 3RD FLR. EXTERIOR STOREFRONTS
SHEET: RFI 23/ FCD 20
DATE: 07/19/16
DRAWN BY: ASK-9A
CHECKED BY: [Signature]

RFP #12

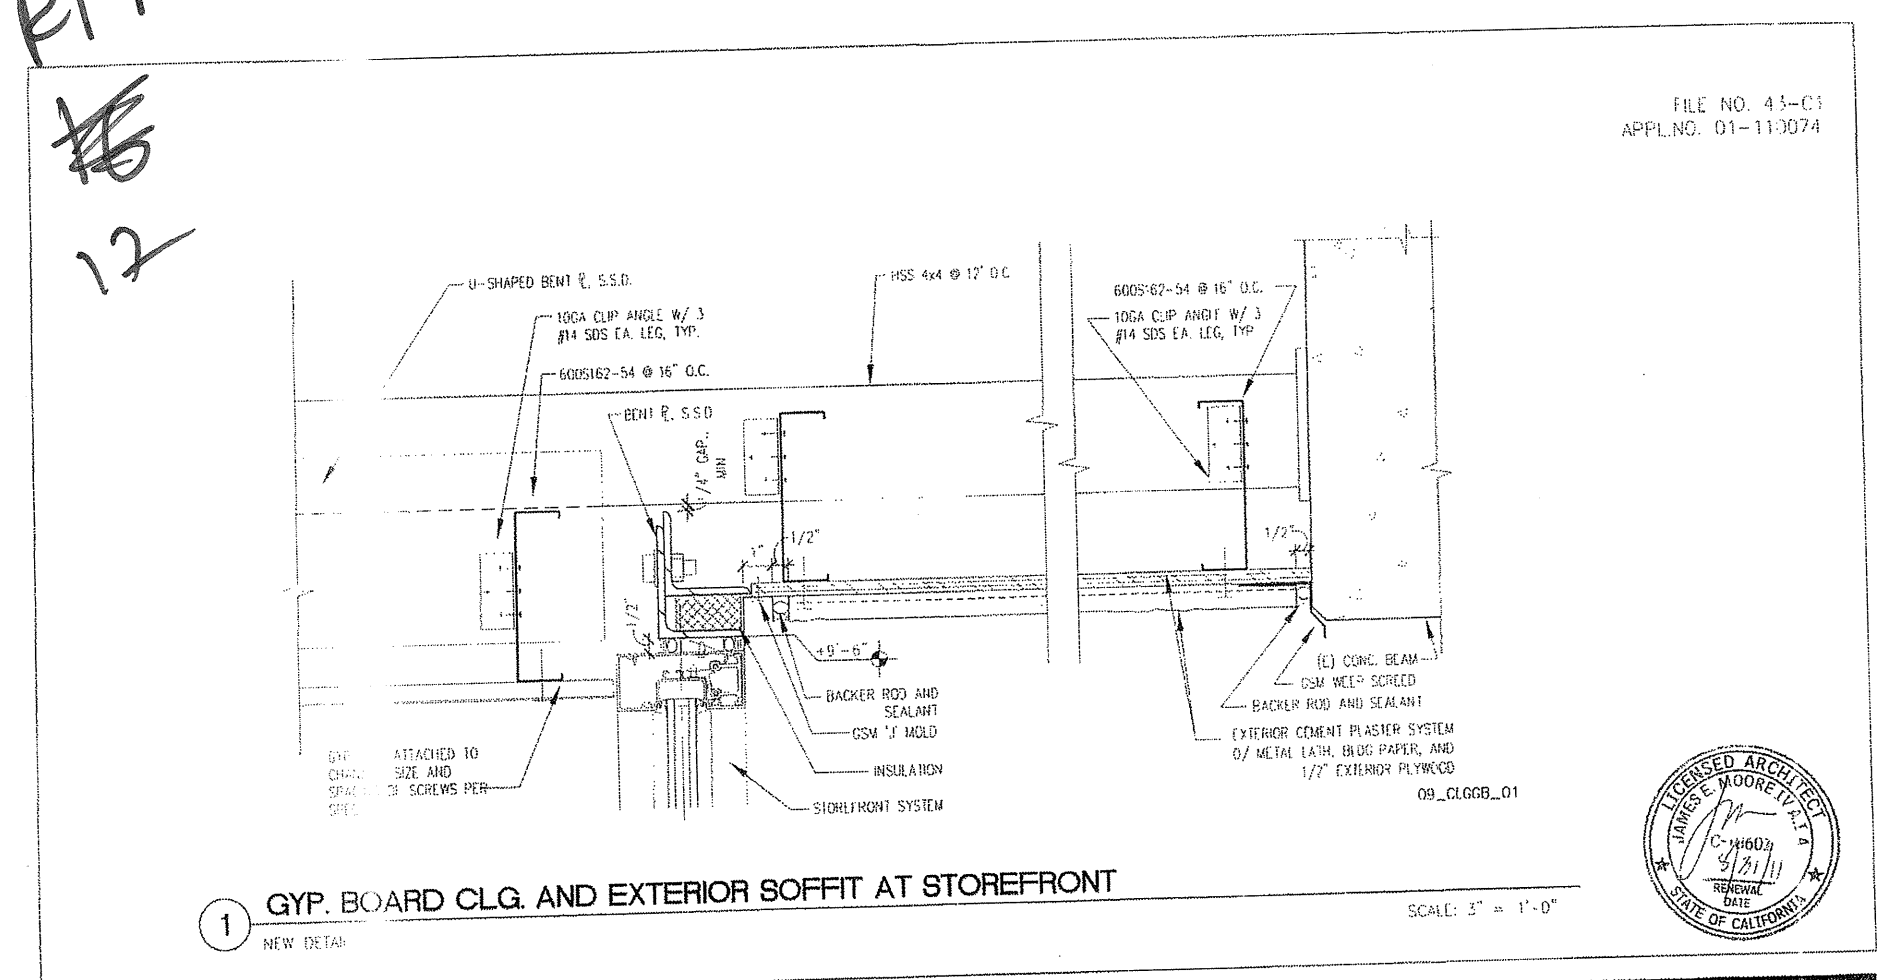

BCIA ARCHITECTURE
PLANNING
INTERIORS

PROJECT: SOFFIT AT 3RD FLR. EXTERIOR STOREFRONTS
SHEET: RFI 23/ FCD 20
DATE: 07/19/16
DRAWN BY: ASK-9A
CHECKED BY: [Signature]