


RFP-39

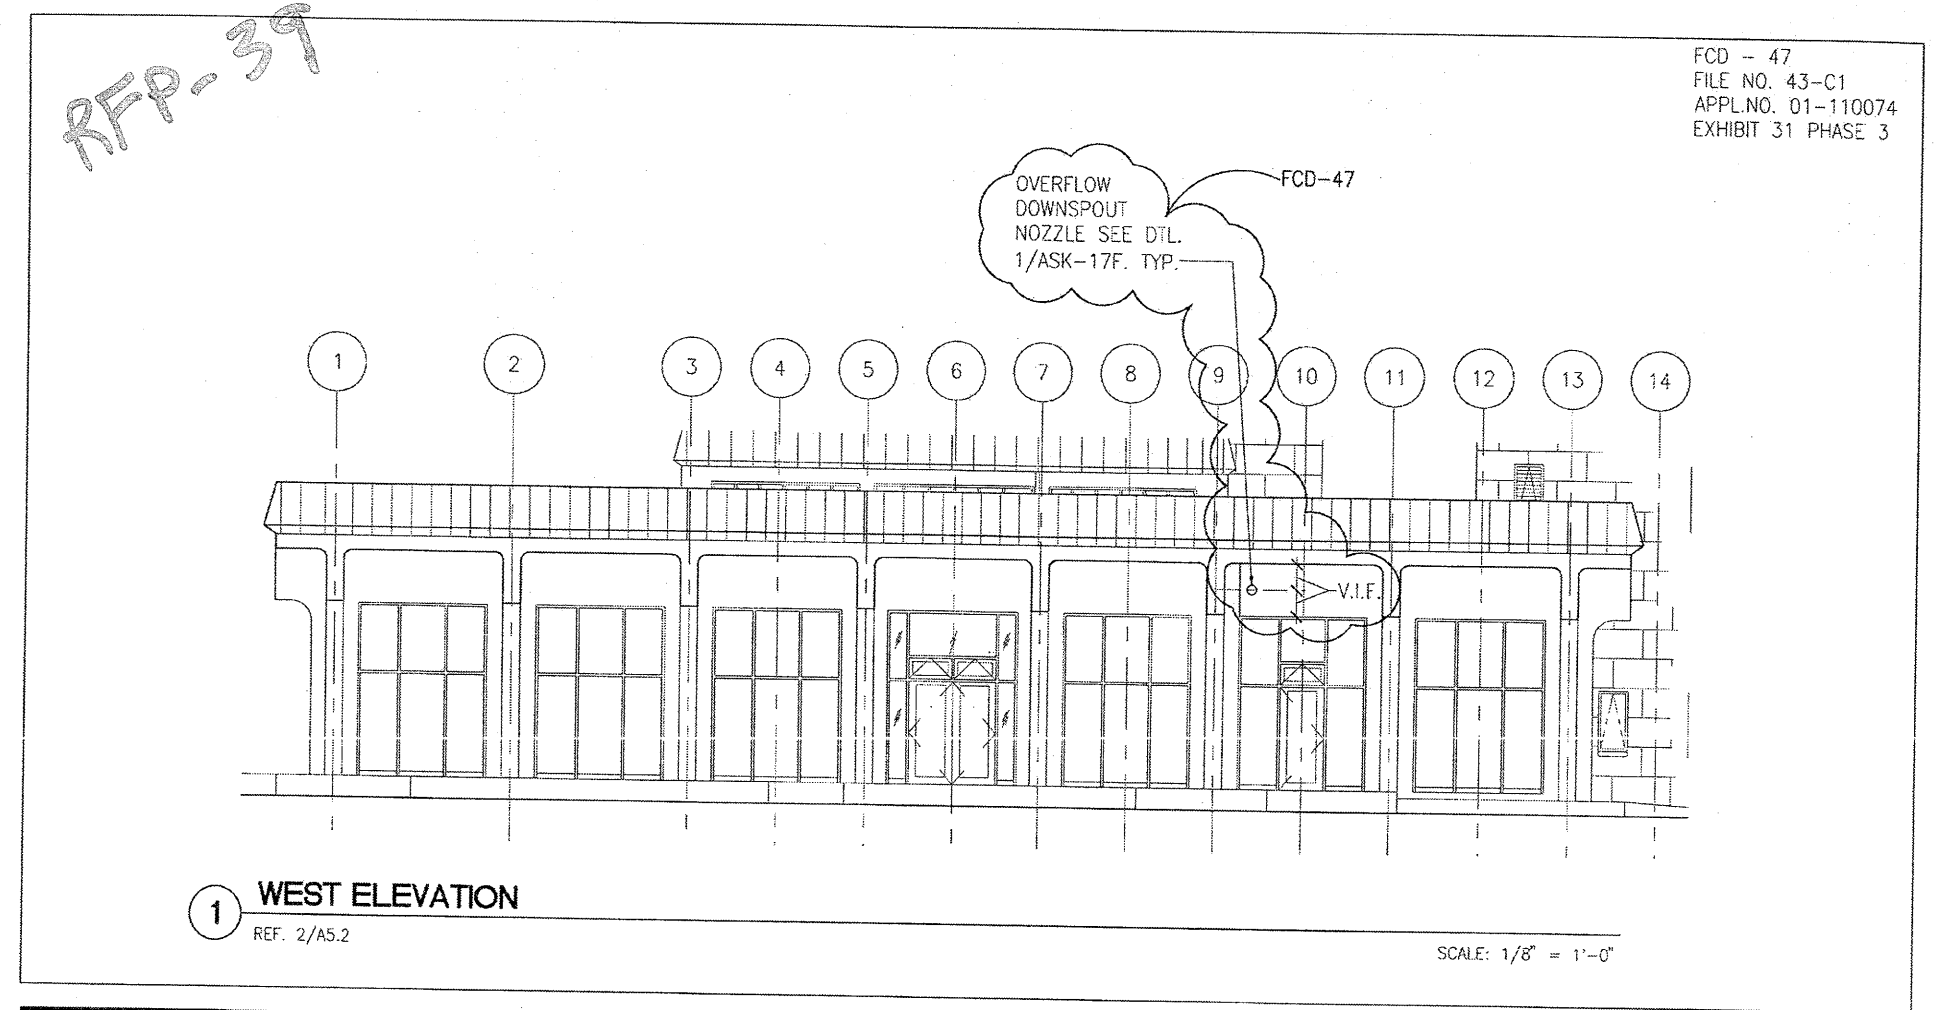

FGD - 47
FILE NO. 43-C1
APPL. NO. 01-110074
EXHIBIT 31 PHASE 3

BCA
NEW OVERFLOW DRAIN
ARCHITECT
CONRAD COLLEGE - BUILDINGS & RENOVATIONS
SAN MATEO COUNTY COMMUNITY COLLEGE DISTRICT
FILE NO. 43-C1 APPL. 01-110074
SHERIDAN, P.C. SAN FRANCISCO



47
ASK-17D