



ASI-16

ASI 16
FILE NO. 43-C1
APPLNO. 01-110074

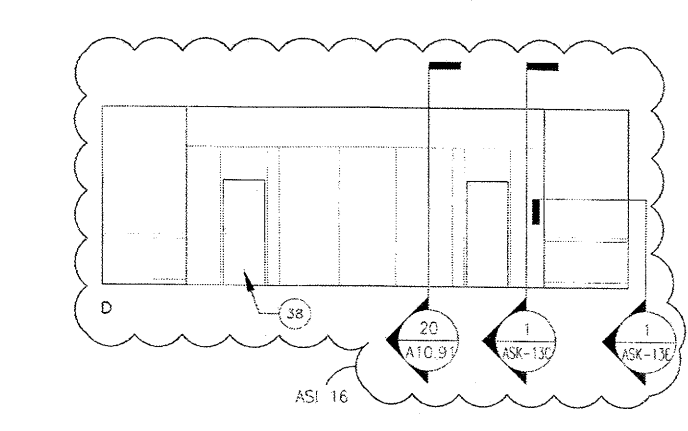

1 LOBBY RM. 6-101 - INTERIOR ELEVATION
REF. 30/AR.1 SCALE: 1/8" = 1'-0"

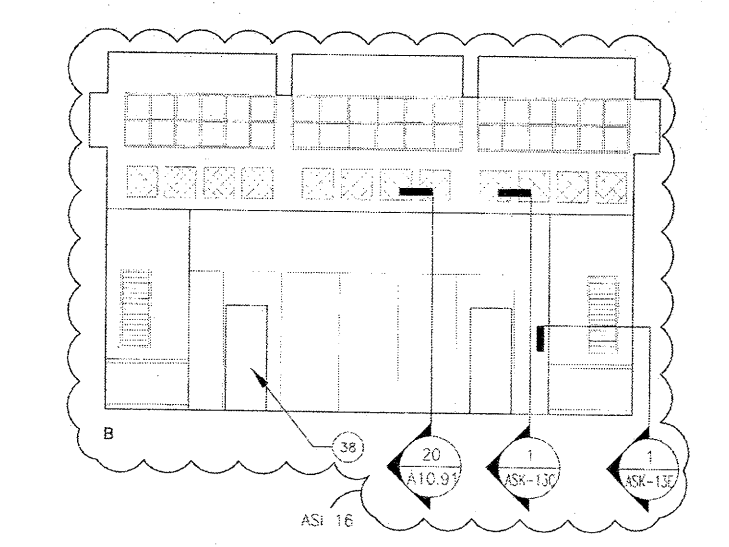

2 MULTI-PURPOSE RM. 6-102
REF. 30/AR.1 SCALE: 1/8" = 1'-0"