




RFP #75

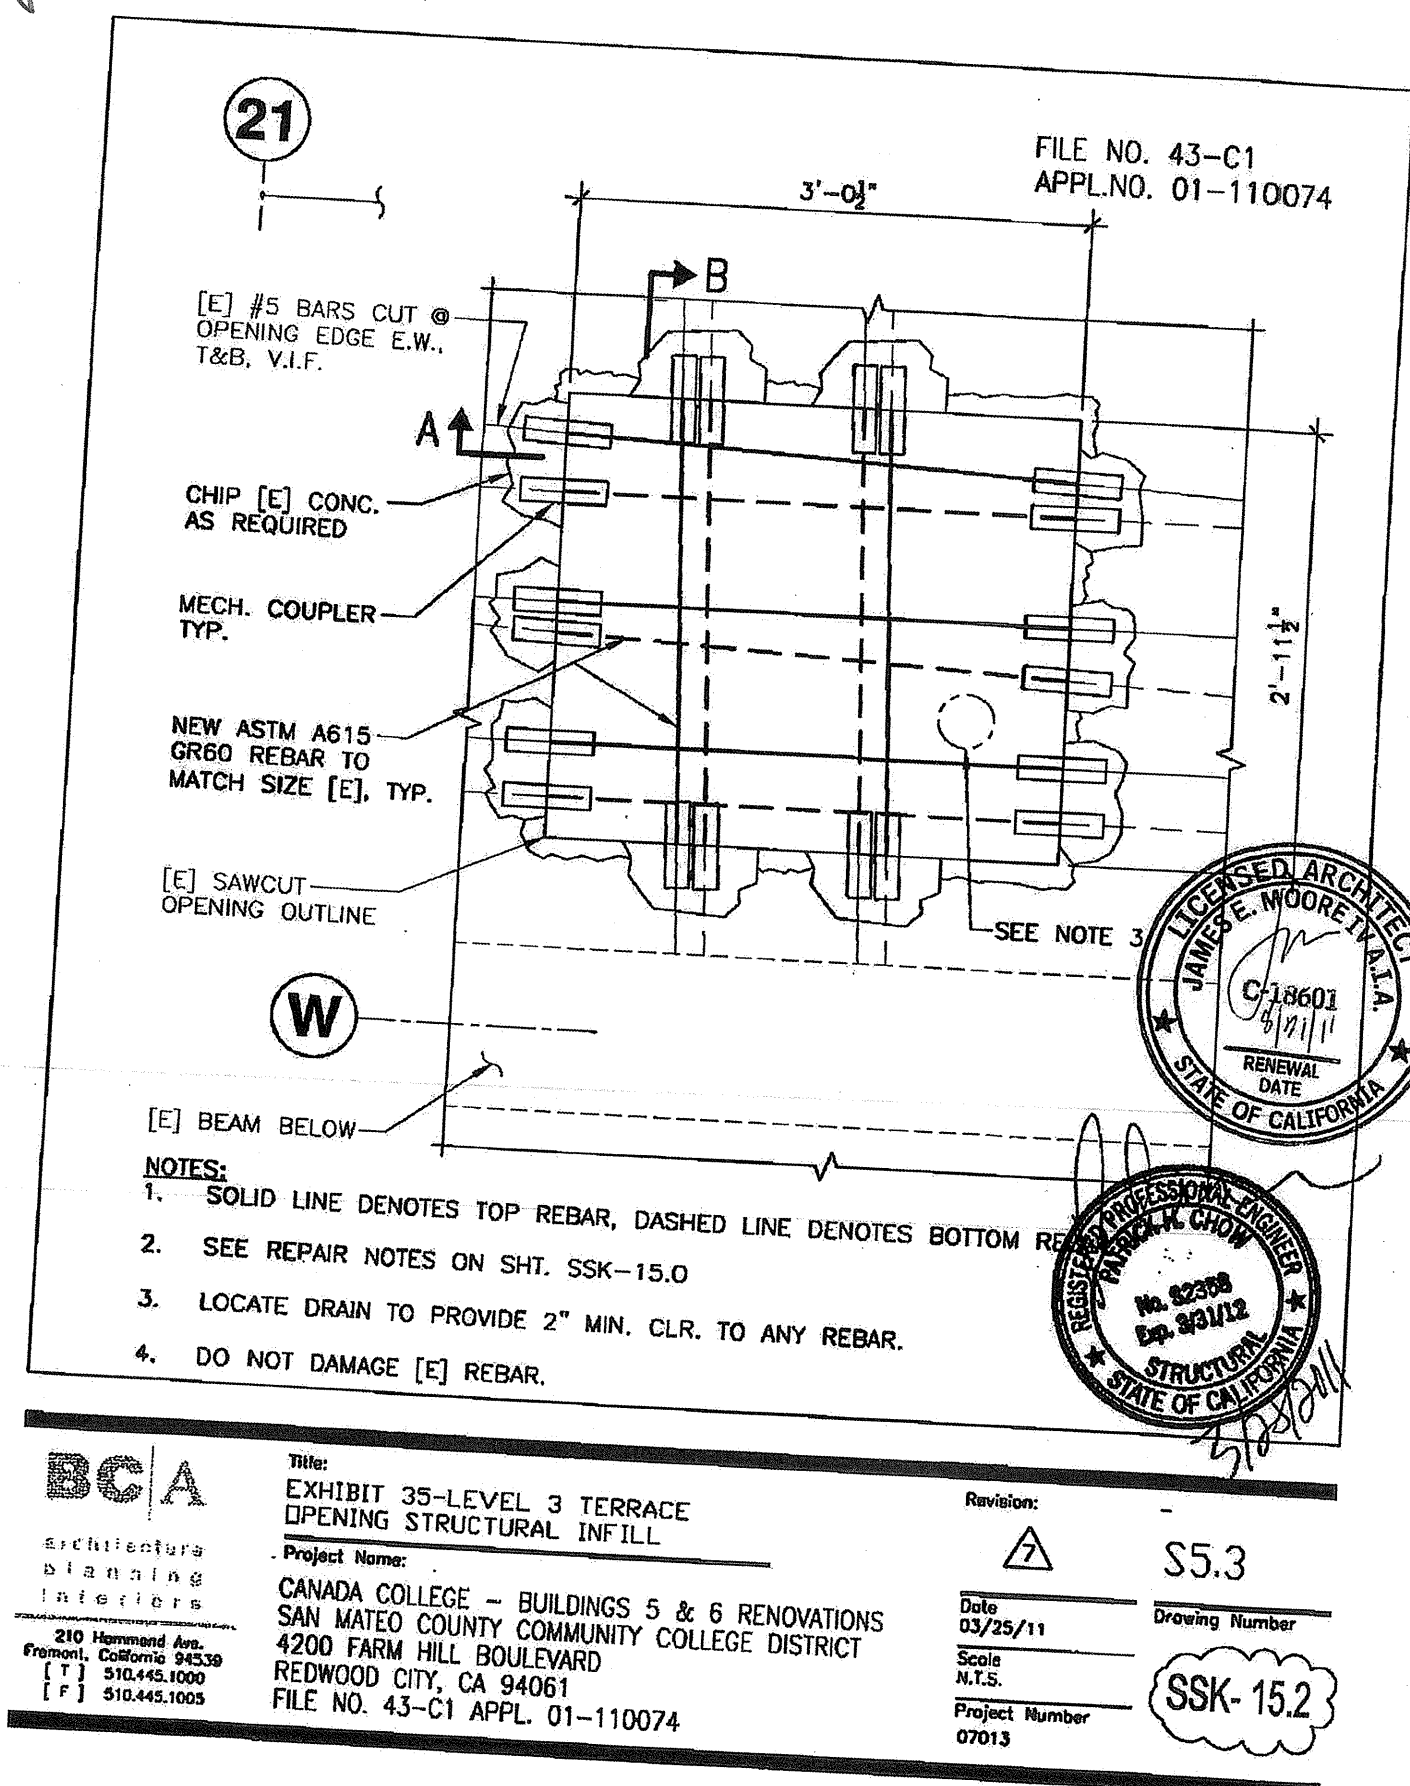


RFP #75

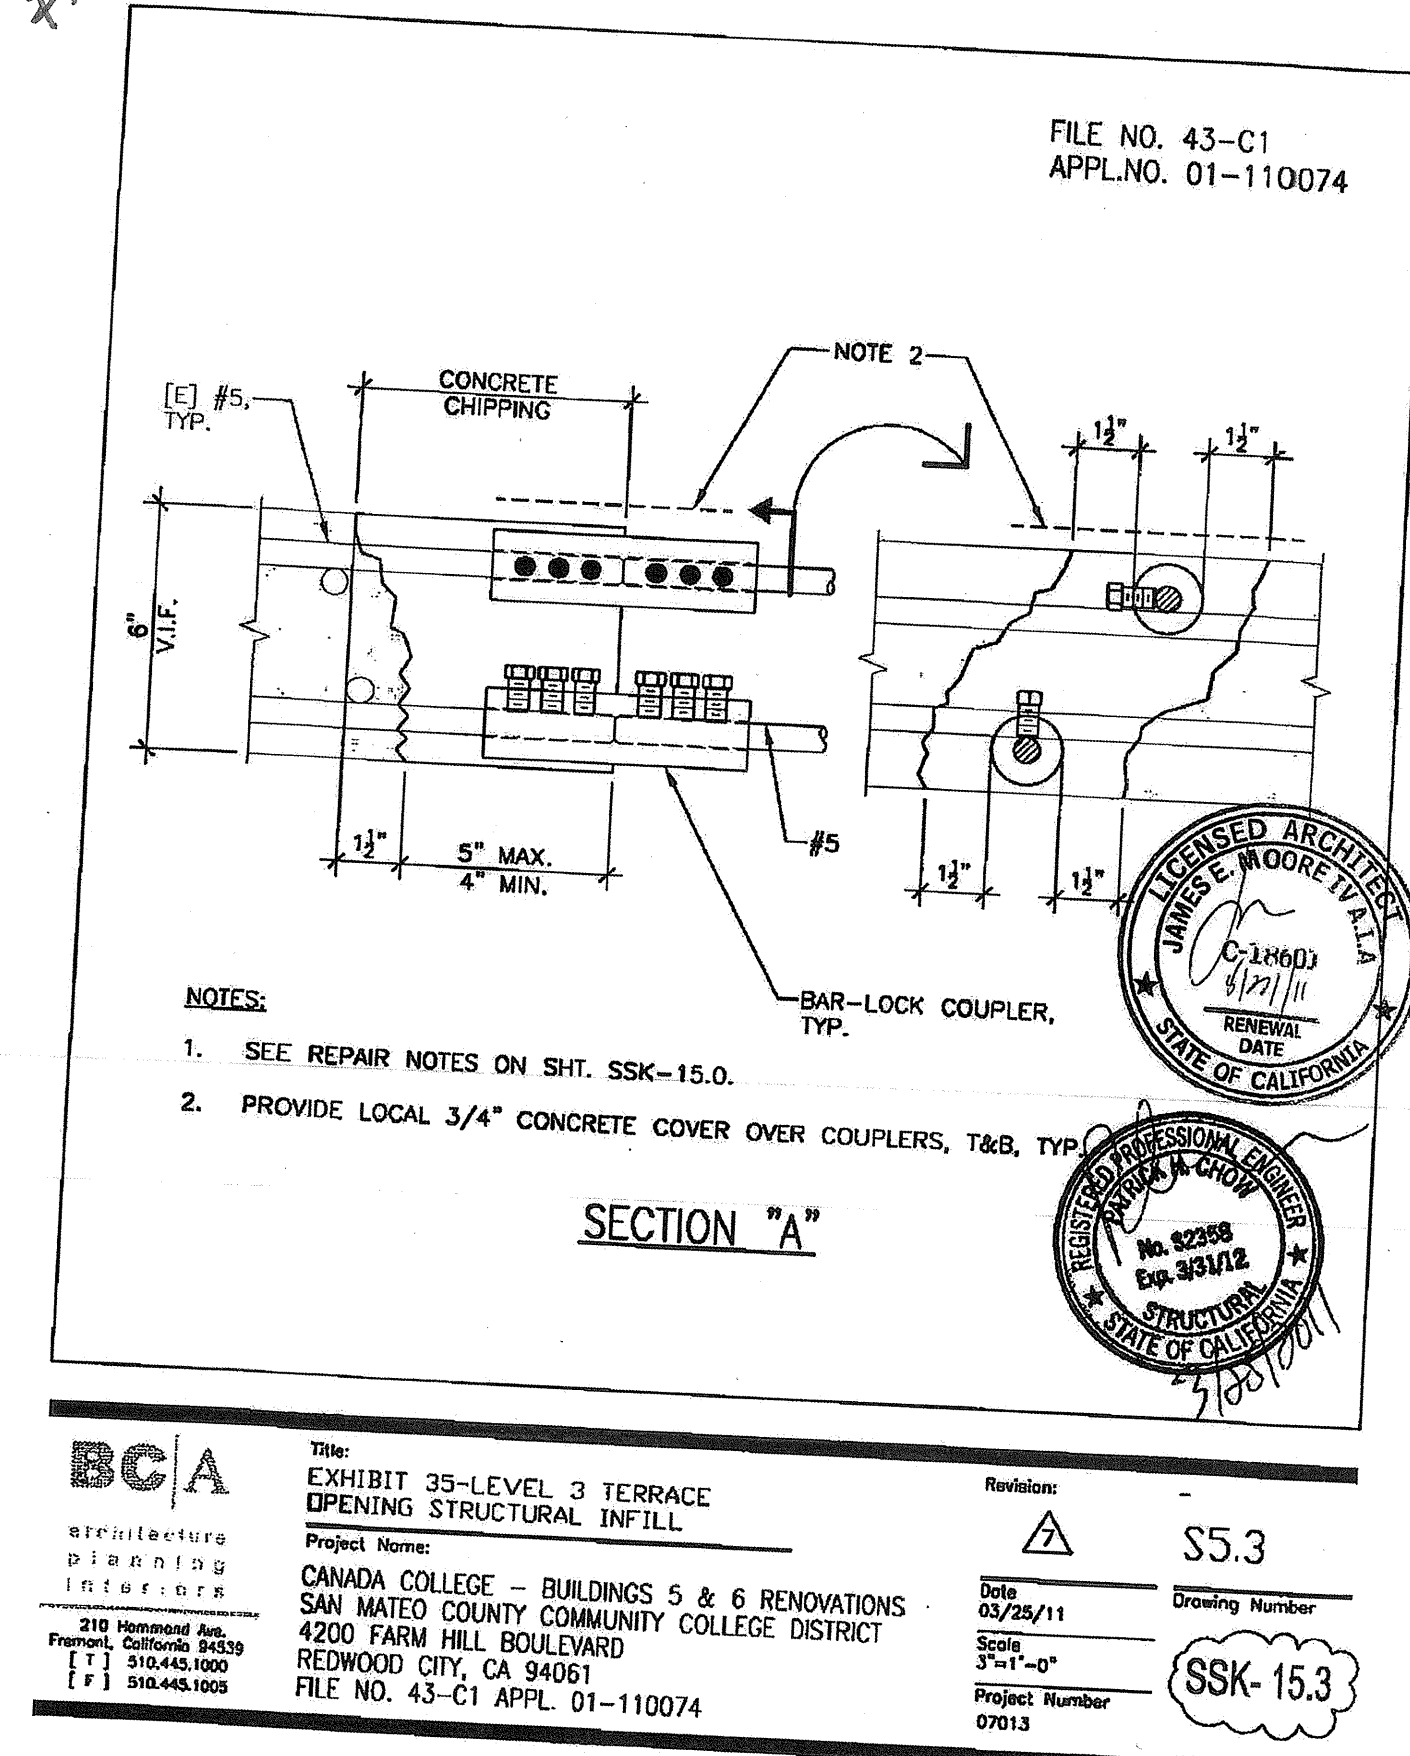


RFP #75

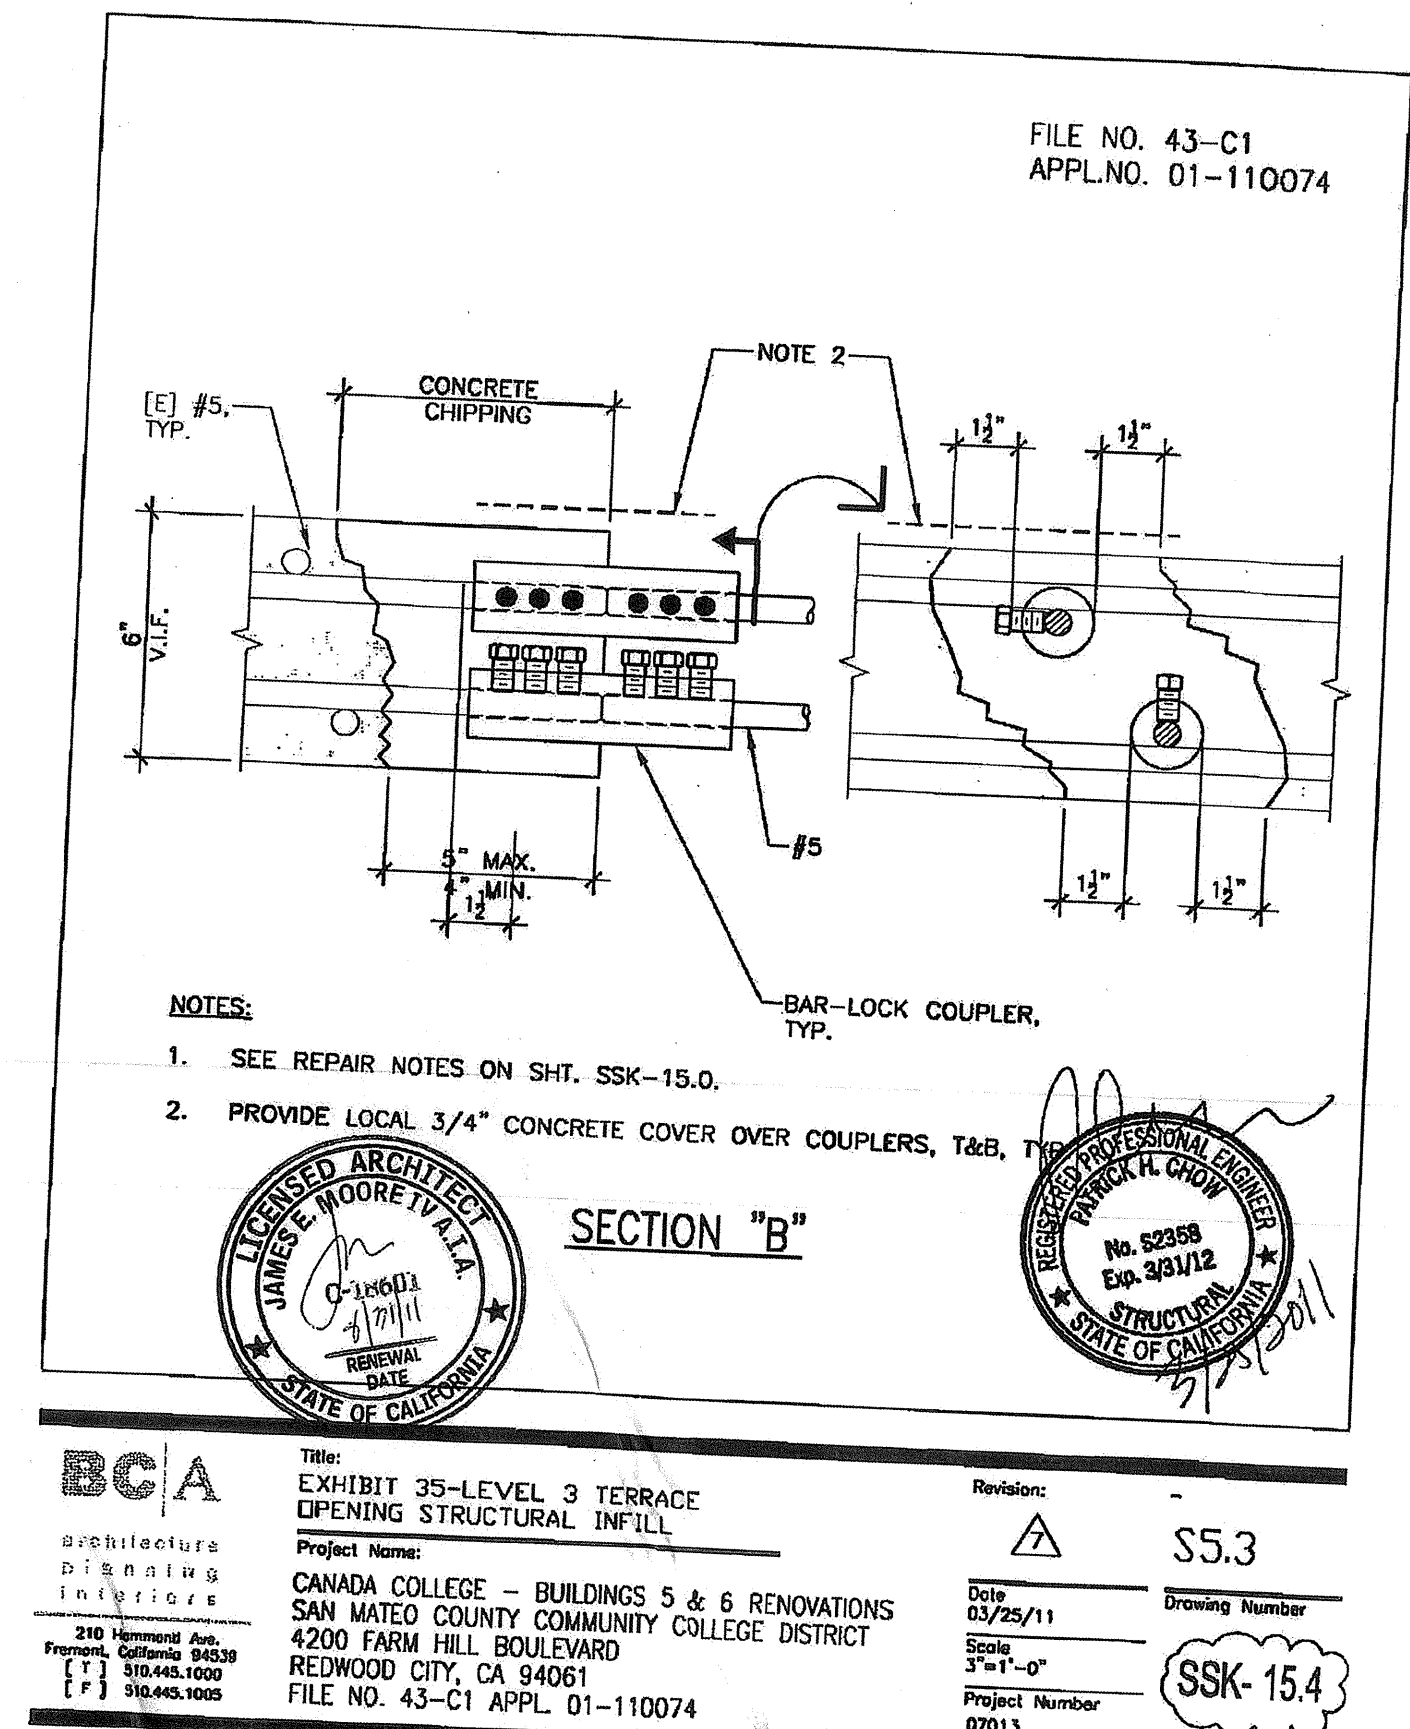

RFP #25

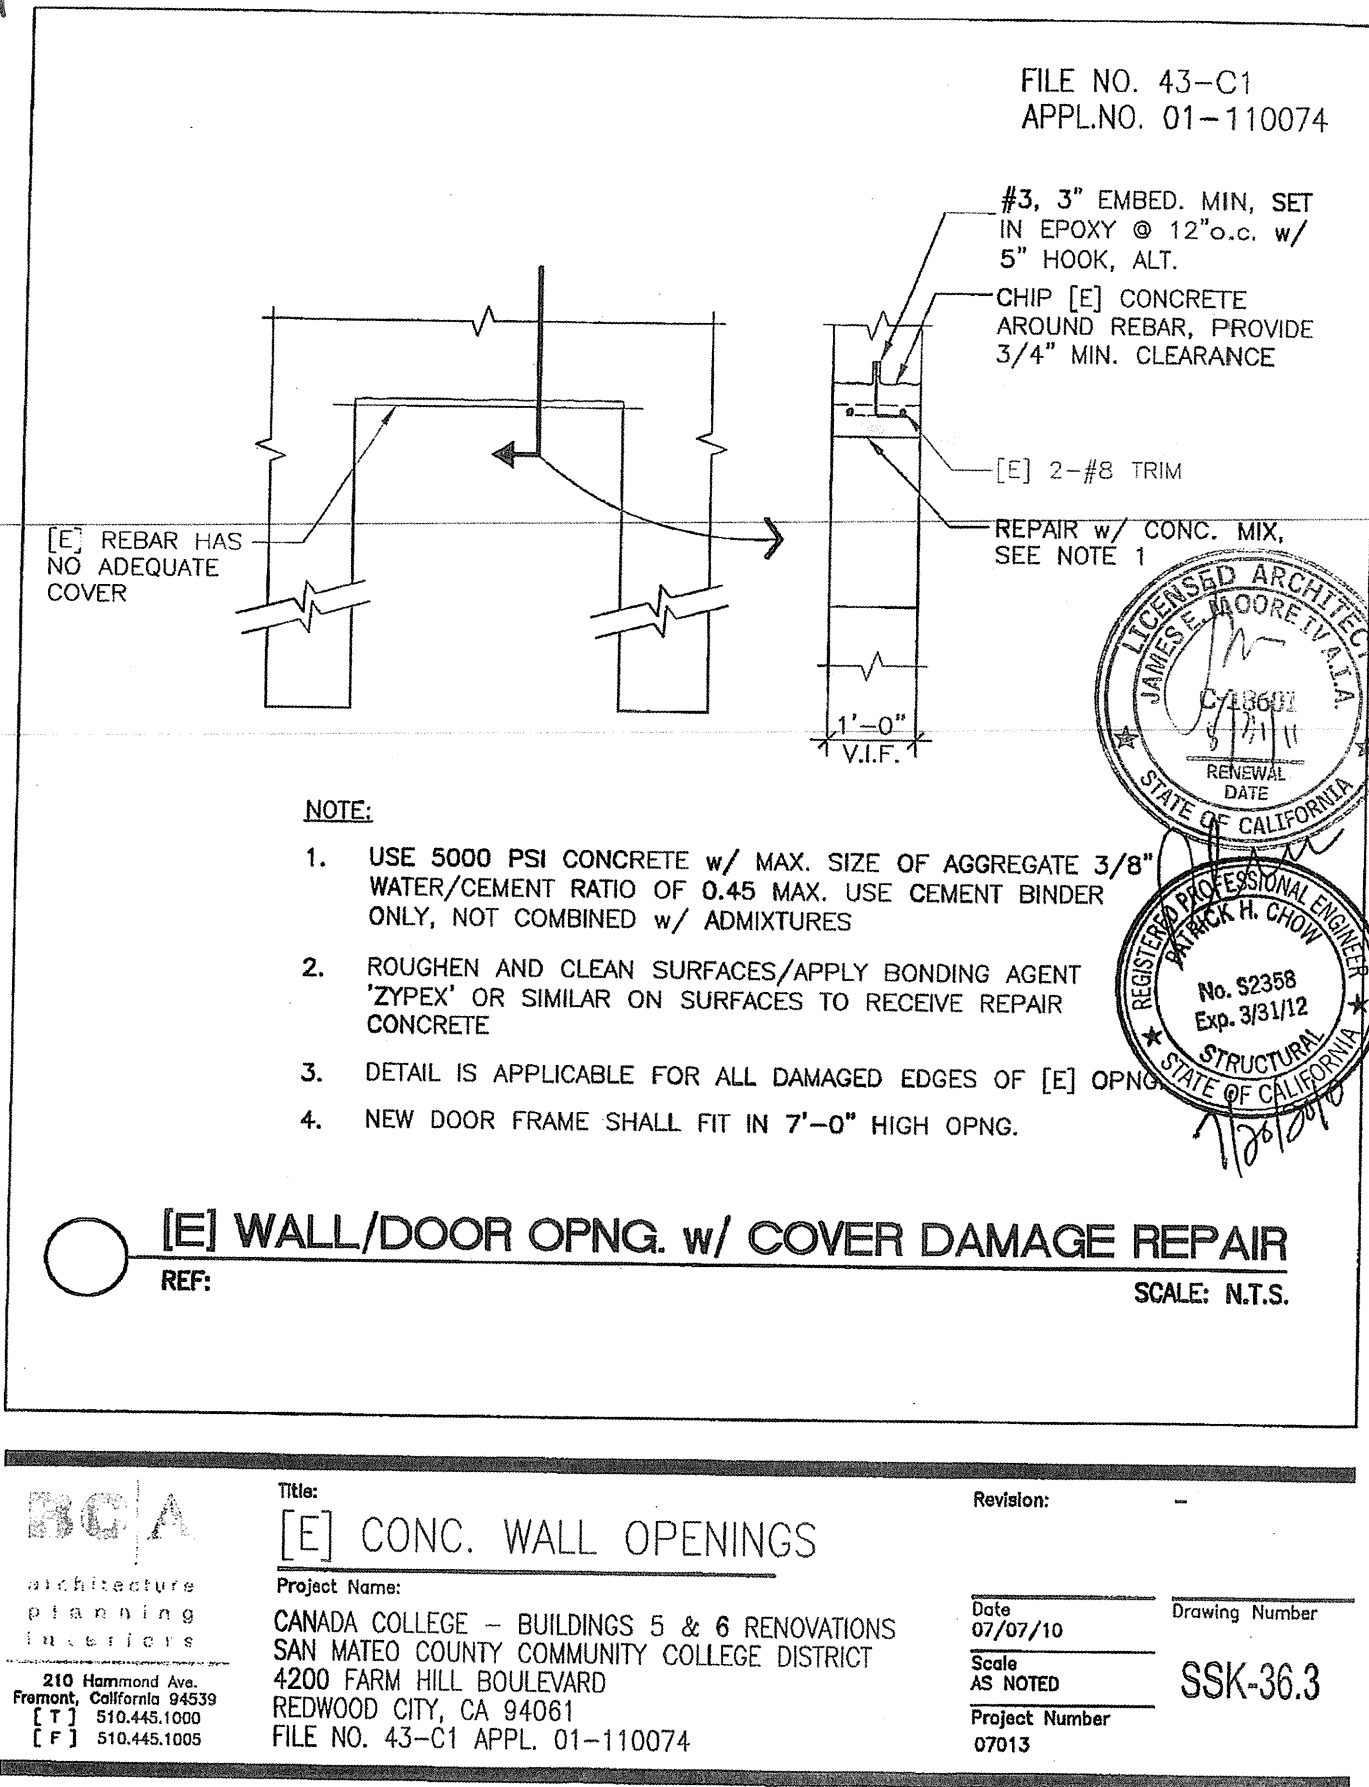

RFP #25

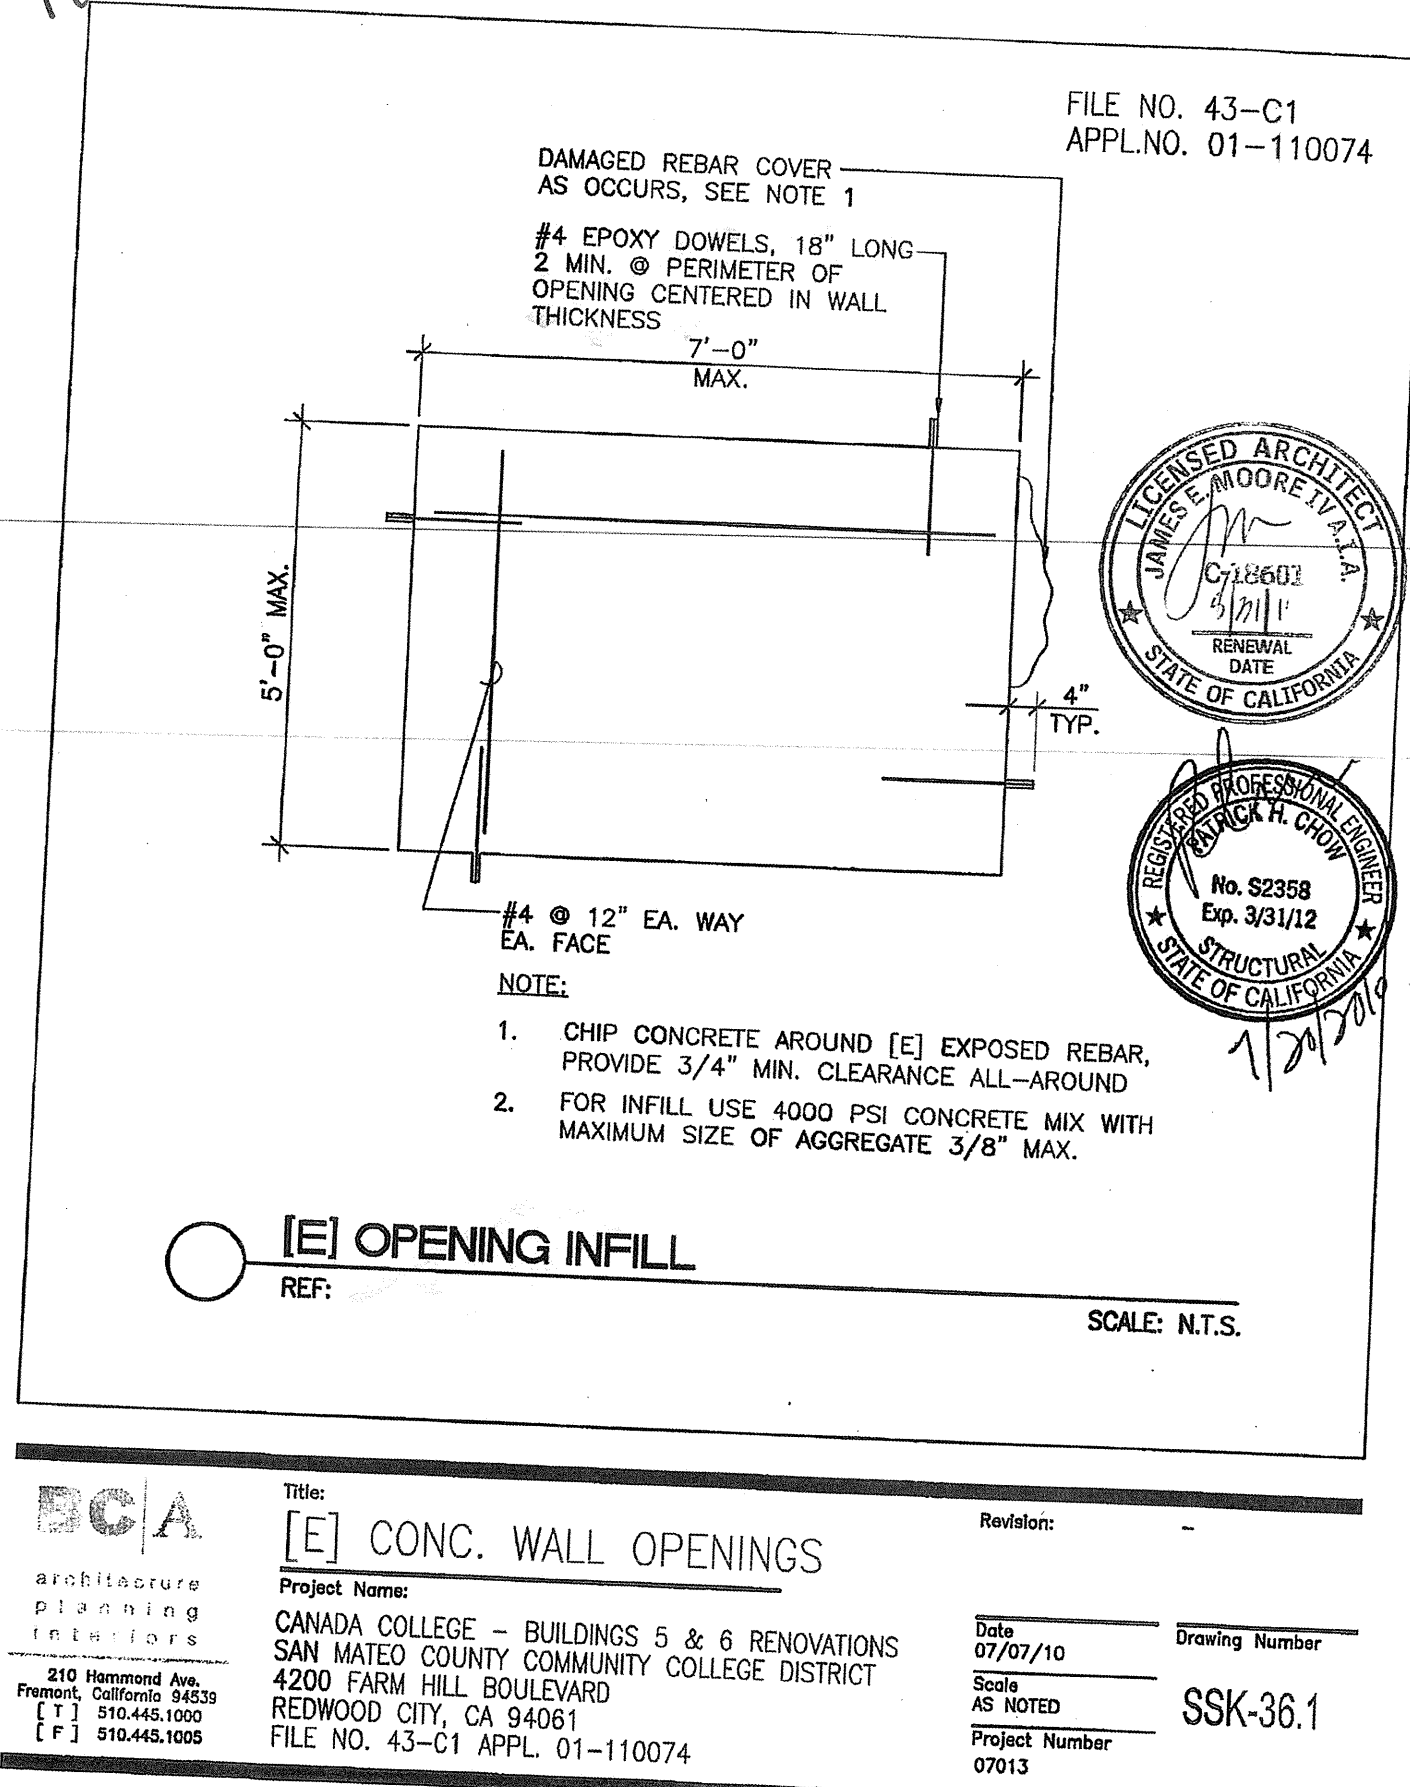

RFP #25

