


FILE NO. 43-C1
APPL. NO. 01-110074

LUMINAIRE SCHEDULE

TYPE: A2	DESCRIPTION:	5W6 AS TYPE 'A1', EXCEPT RECESSED IN GYP CEILING
BALLAST:	ELECTRONIC	
LAMP:	TWO T27V	
INPUT WATTS:	83	
NOTE:	FINISH: 'V' TRIM AND FLANGE KIT OPTION (FK24)	


TYPE: N	DESCRIPTION:	4.5" SQUARE LED DOWNLIGHT
HOUSING:	ALUMINUM	
REFLECTOR:	CLEAR OPTIC	
MOUNTING:	RECESSED	
FINISH:	WHITE	
DRIVER:	INTERNAL	
VOLTAGE:	277V	
LAMP:	23W LED/3500K	
INPUT WATTS:	23W	
MANUFACTURER:	FUGAL POINT OR APPROX. FL44-13L3-23-277-30-T-BH-L44-SD-0N-CD-WH	



BCIA The
LUMINAIRE SCHEDULE & TITLE 24 CALCULATIONS

Project Name:
CANADA COLLEGE - BUILDINGS 5 & 6 RENOVATIONS

4200 FARM HILL BOULEVARD
REDWOOD CITY, CA 94061
FILE NO. 43-C1 APPL. 01-110074

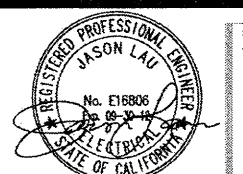

Revision: 01 of 02
Sheet reference: 02

DATE: 12/23/10


DATE: 12/23/10

DATE: 12/23/10


RFI 1080
FILE NO. 43-C1
APPL. NO. 01-110074

LUMINAIRE SCHEDULE

TYPE: O	DESCRIPTION:	EXTERIOR HID DOWNLIGHT
HOUSING:	7" DIAMETER DIE CAST ALUMINUM HOUSING	
LOUVER:	BLACK LOWER BAFFLE	
REFLECTOR:	CLEAR UPPER REFLECTOR	
FINISH:	VERY TRIM FINISH WITH ARCHITECT	
BALLAST:	CW, HIGH POWER FACTOR BALLAST, 277V	
LAMP:	70W MH	
INPUT WATTS:	80	
MANUFACTURER:	COOPER LIGHTING, PORTFOLIO M07-738-7780-00-1G	

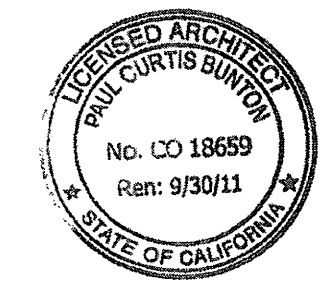

No. CO 18659
Ren: 9/30/11

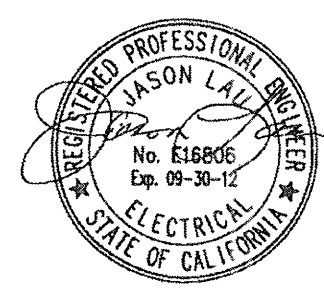


Exp. 09-30-12

Date Signed: 12/23/10

BCIA The
LUMINAIRE SCHEDULE

Project Name:
CANADA COLLEGE - BUILDINGS 5 & 6 RENOVATIONS
SAN MATEO COUNTRY COMMUNITY COLLEGE DISTRICT

4200 FARM HILL BOULEVARD
REDWOOD CITY, CA 94061
FILE NO. 43-C1 APPL. 01-110074

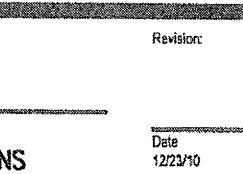

Revision: 01 of 02
Sheet reference: 02

DATE: 12/23/10

DATE: 12/23/10

DATE: 12/23/10