




RFP-6

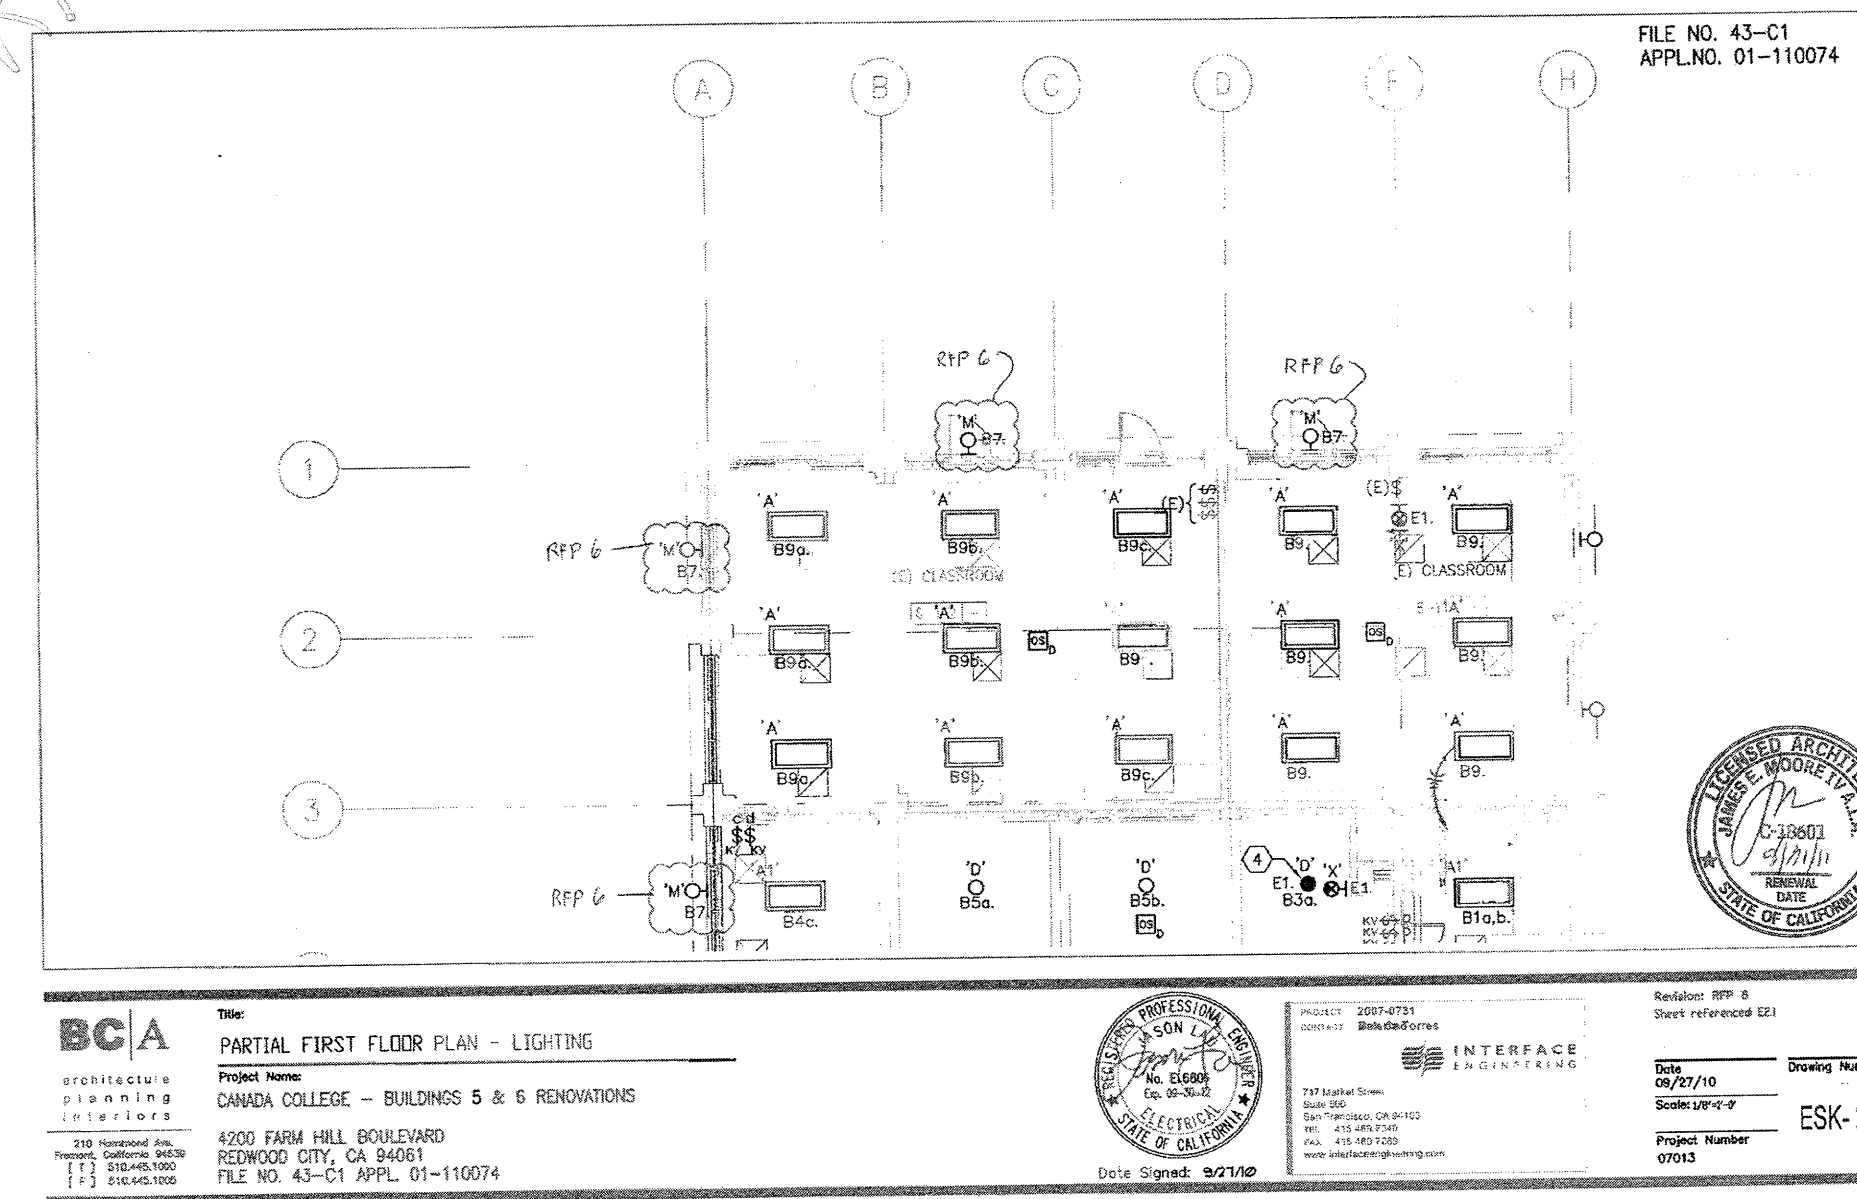

RFP-69

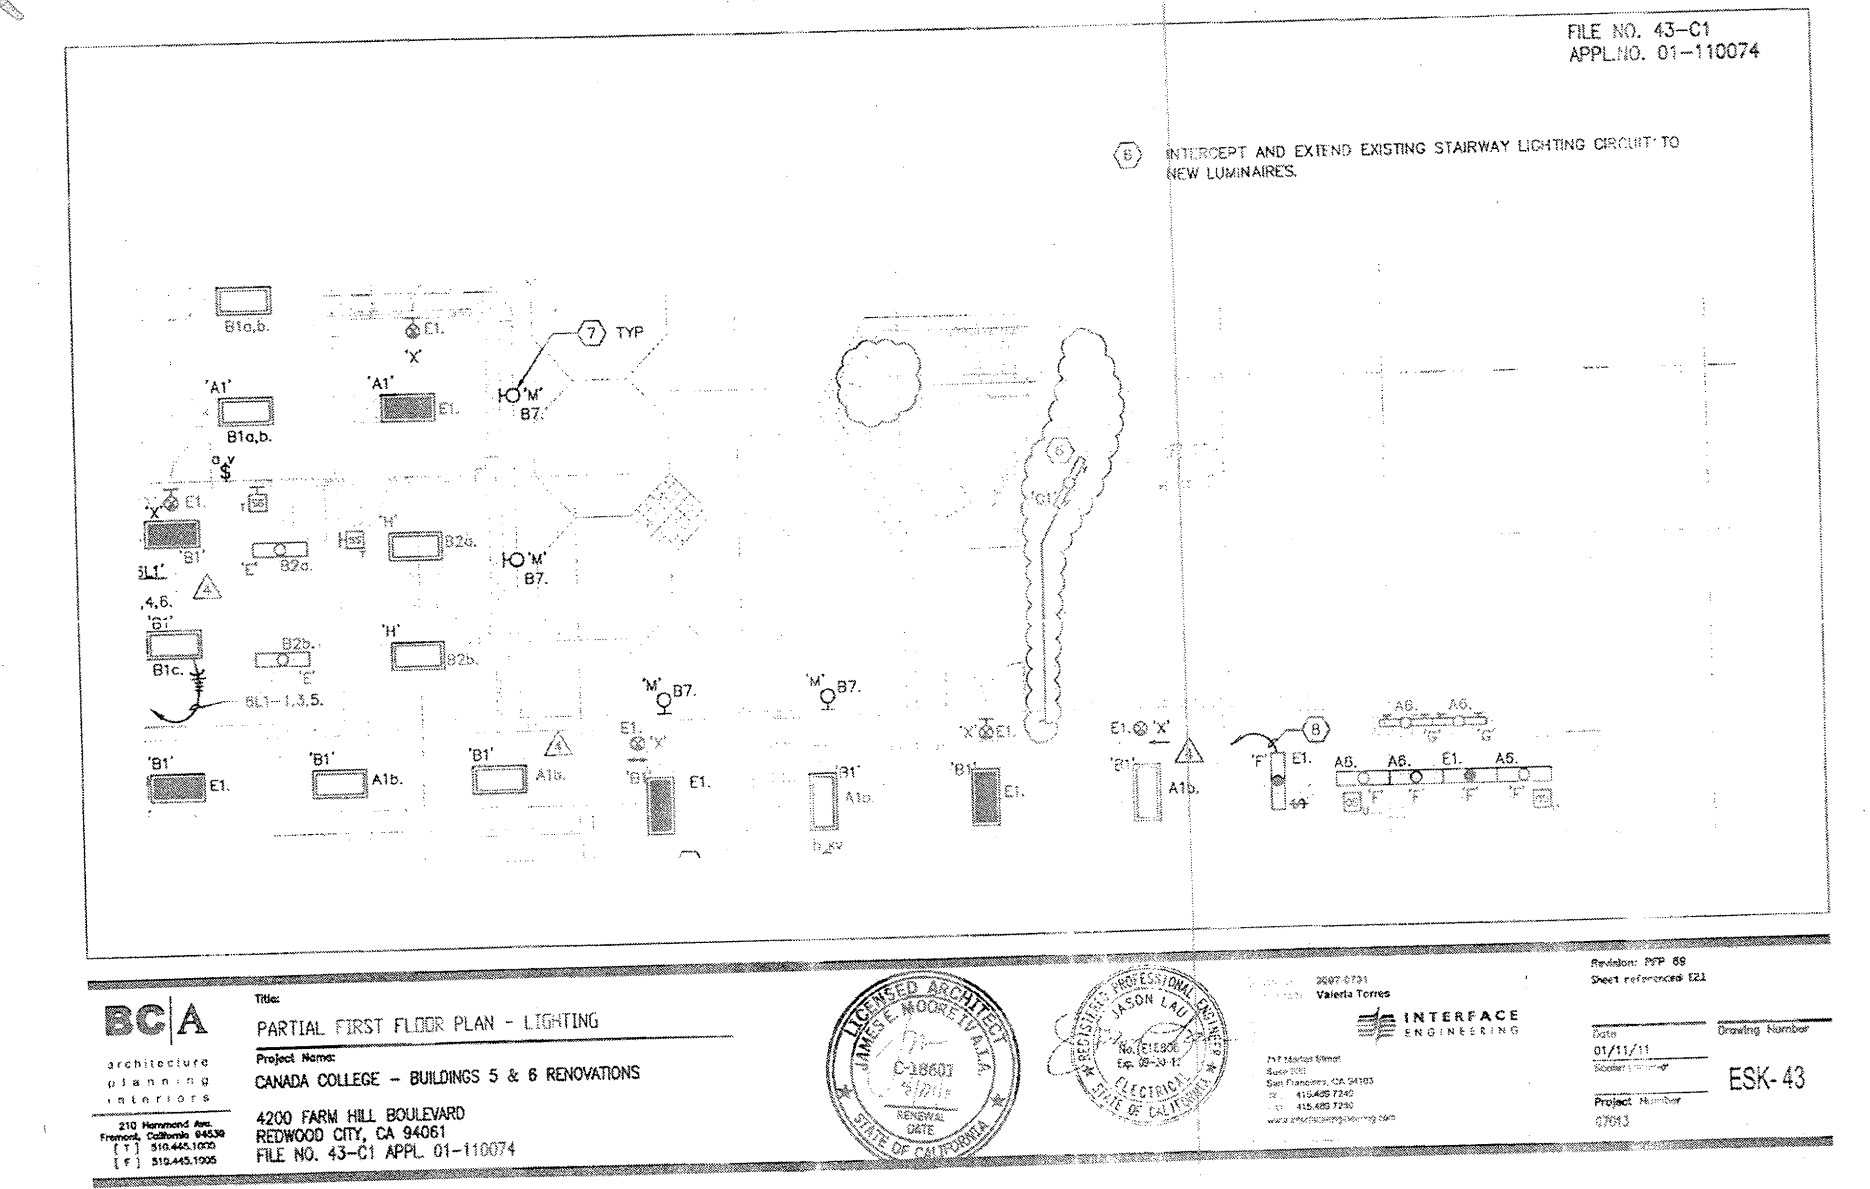

RFP-6

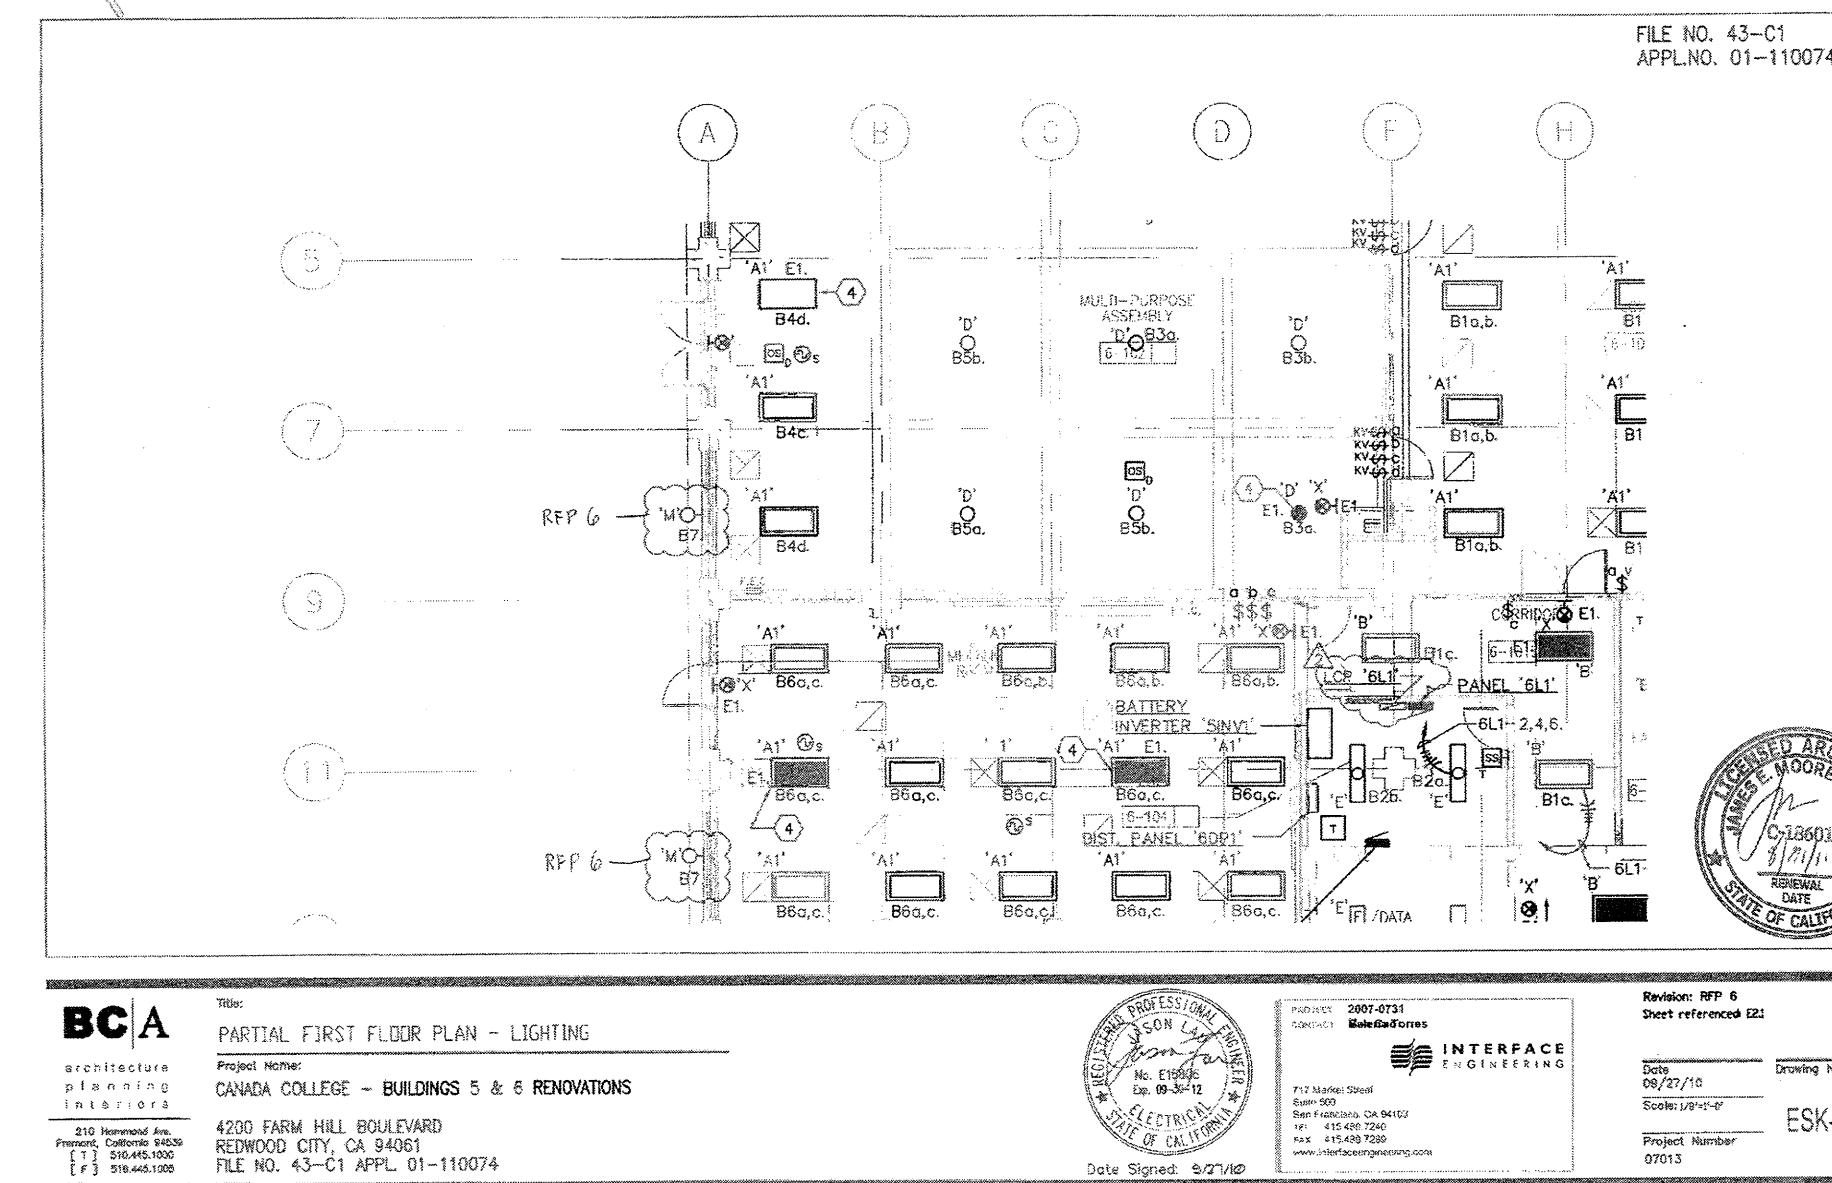

RFP-36

