


RFP-50

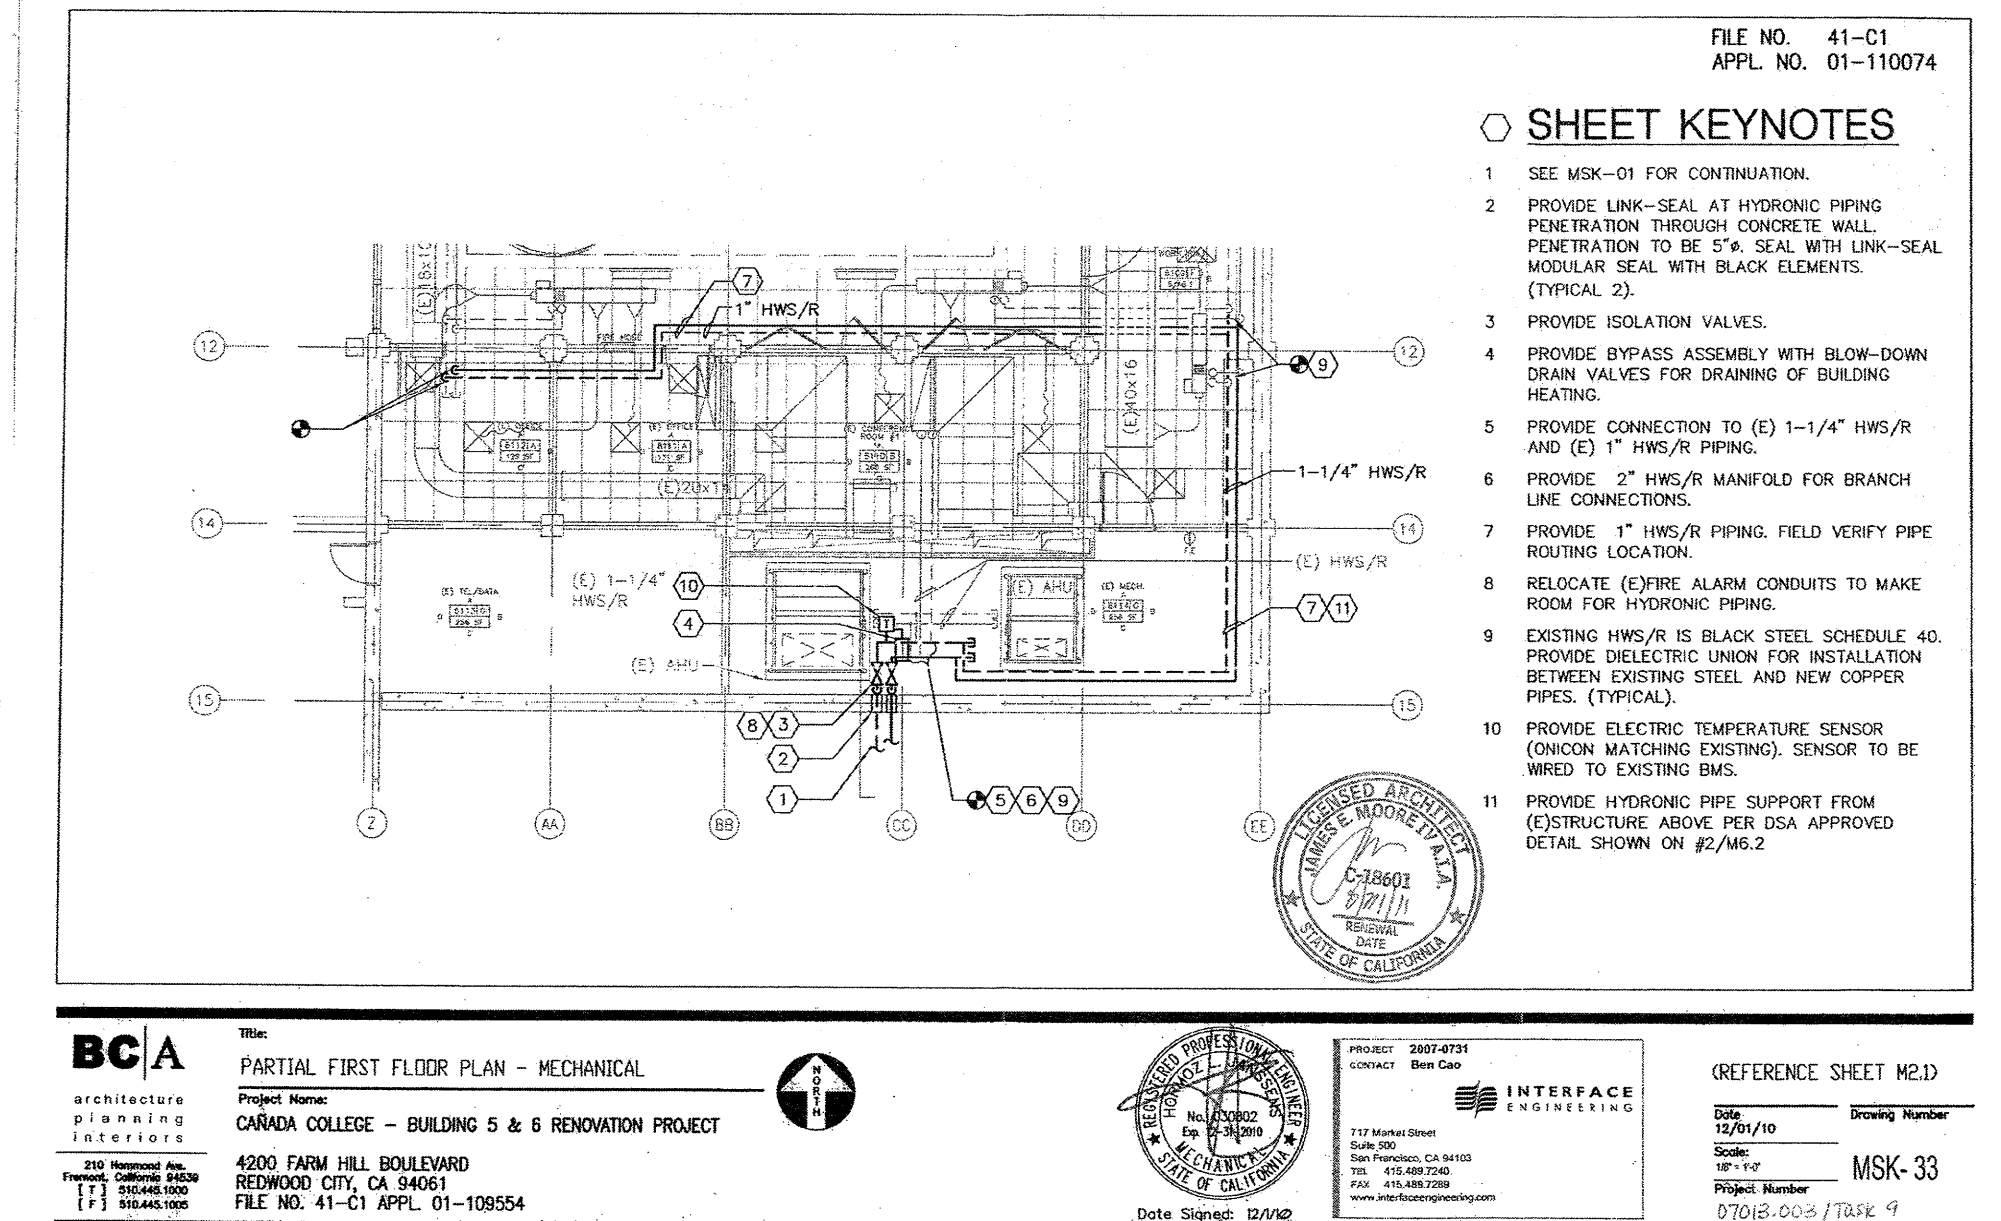

RFP-50

