


ASI 014R  
 FILE NO. 41-C1  
 APPL. NO. 01-108959

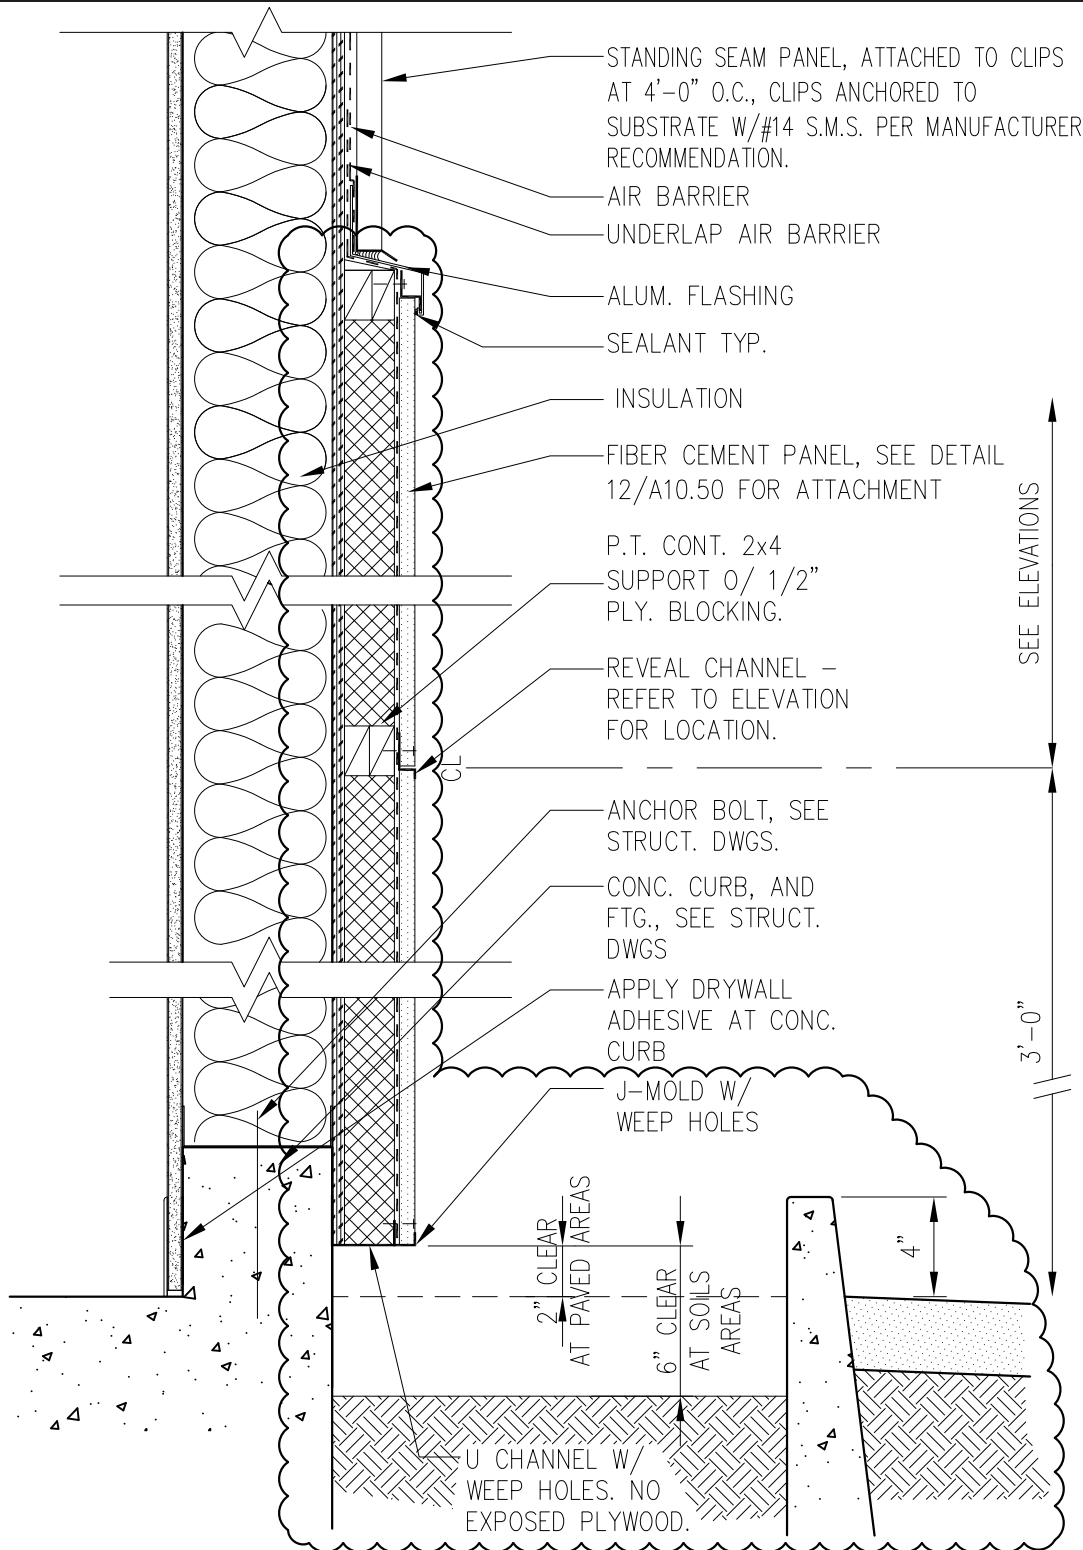

SEE ELEVATIONS

3'-0"

1

**TYP. EXTERIOR WALL**

REF. 2/A10.50

1-1/2"



architecture  
 planning  
 interiors

210 Hammond Ave.  
 Fremont, California 94539  
 [T] 510.445.1000  
 [F] 510.445.1005

Title:  
**EXTERIOR WALL SECTION**

Project Name:  
 CANADA COLLEGE - FACILITIES MAINTENANCE CENTER  
 4200 Farm Hill Boulevard  
 Redwood City, CA 94061  
 FILE NO. 41-C1 APPL. 01-108959

Revision: ASI No.: 014R

Date  
 09/30/08

Scale  
 AS NOTED

Project Number  
 06018

Drawing Number

**ASK-010R**