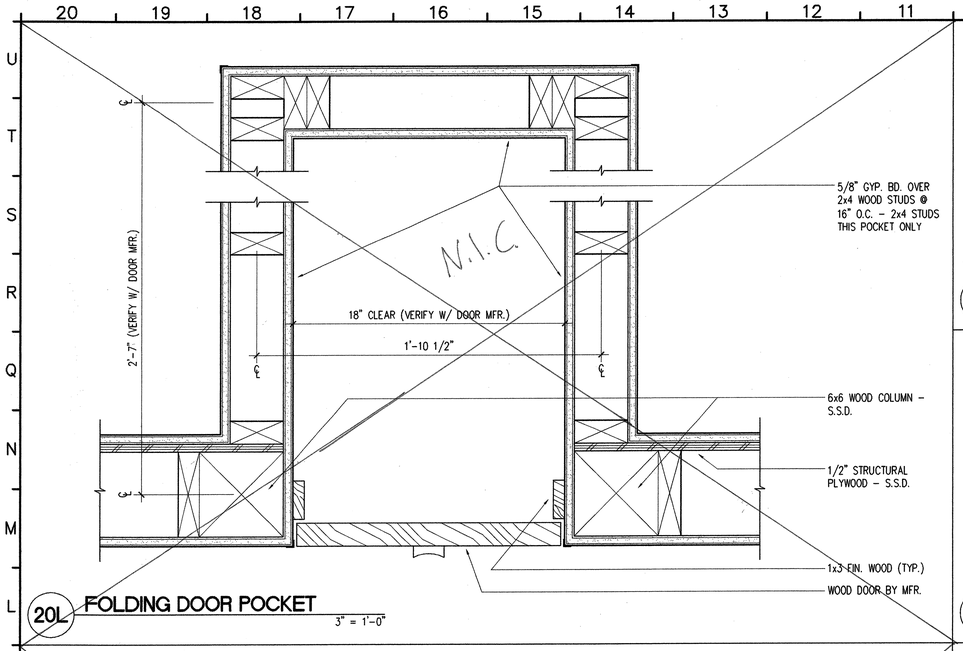

20L FOLDING DOOR POCKET
3" = 1'-0"

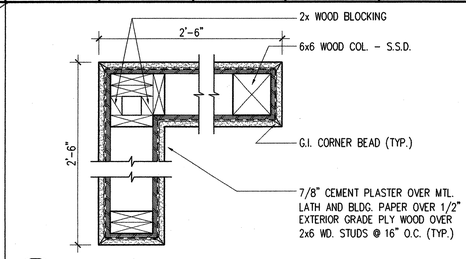

10R ENTRY PEIR
1 1/2" = 1'-0"

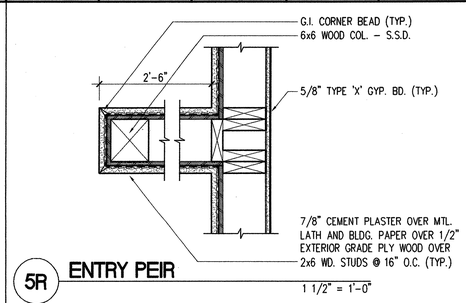

5R ENTRY PEIR
1 1/2" = 1'-0"

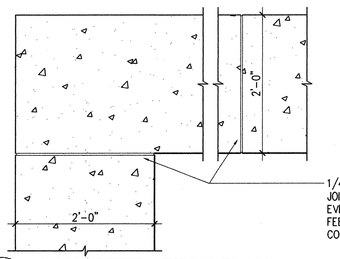

10L CONCRETE APRON PLAN
1 1/2" = 1'-0"

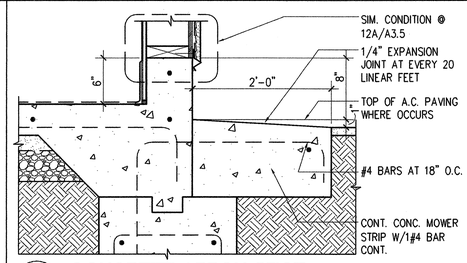

5L CONCRETE APRON SECT.
1 1/2" = 1'-0"

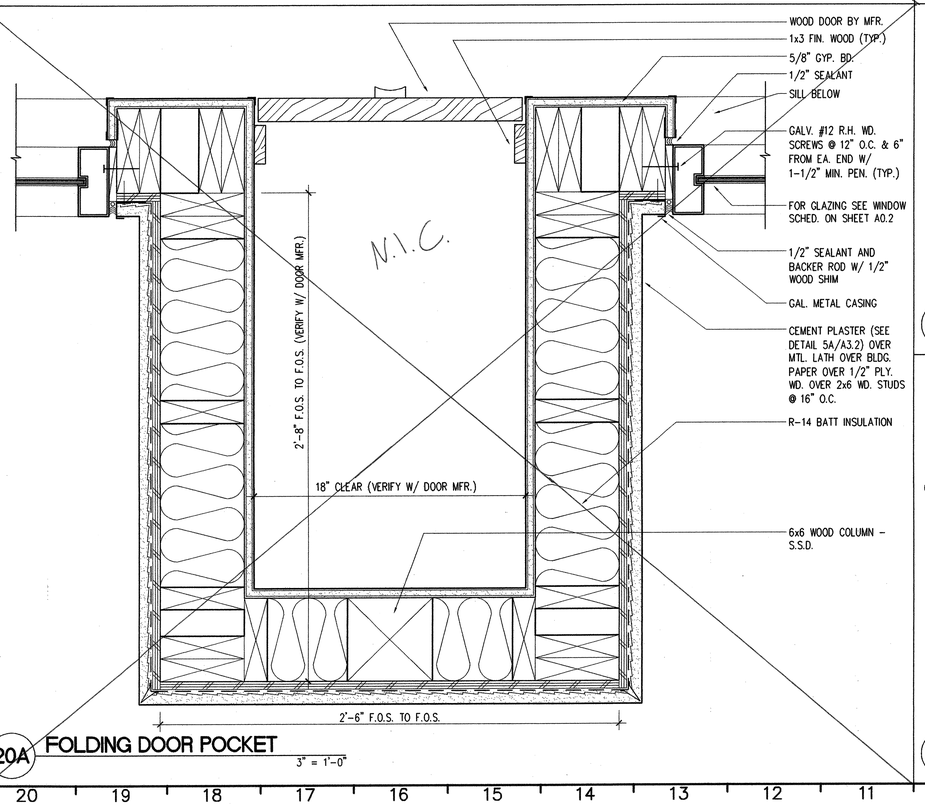

20A FOLDING DOOR POCKET
3" = 1'-0"

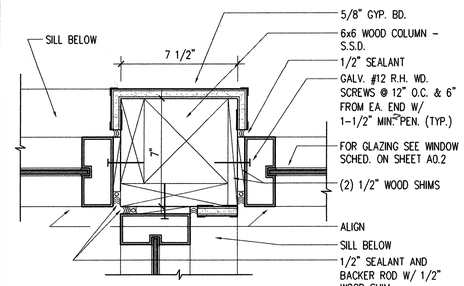

10F JAMB DETAIL
3" = 1'-0"

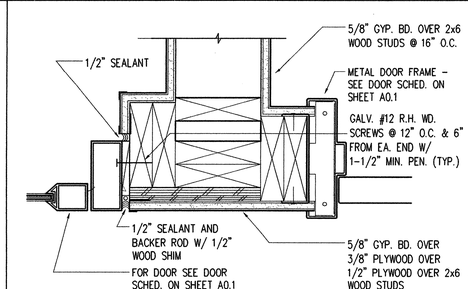

5F JAMB DETAIL
3" = 1'-0"

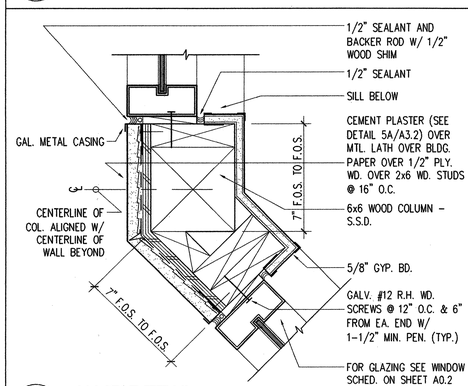

10A JAMB DETAIL
3" = 1'-0"

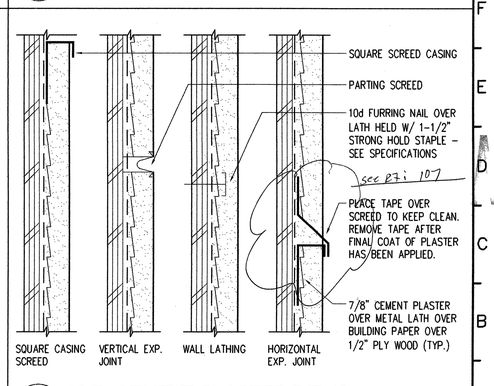

5A TYP. CEMENT PLASTER DTL.'S
N.T.S.

REVISIONS: (△ INDICATES REVISIONS MADE TO THIS SHEET)

NO.:	DATE	REASON	BY

ISSUE FOR PROGRESS REVIEW	01/15/01
ISSUE FOR PLAN CHECK	01/25/01
ISSUE FOR FINAL REVIEW	05/09/01
ISSUE FOR BID	
ISSUE FOR CONSTRUCTION	

SEAL:

LICENSED ARCHITECT — JOHN D. CIANFICHI — No. C-13412 — EXP. 10-31-01 — STATE OF CALIFORNIA

ARCHITECT:

CONSULTANT:

CONSULTANT:

ARCHITECT:
C I A N F I C H I
ARCHITECTURE • PLANNING
30 ANNE COURT
WALNUT CREEK, CA. 94598
TEL.: (925) 256-8638
FAX.: (925) 256-8652

PROJECT:

CHILD DEVELOPMENT CENTER CAÑADA COLLEGE

4200 FARM HILL BLVD. REDWOOD CITY, CA 94061

SAN MATEO COUNTY COMMUNITY COLLEGE DISTRICT

STAMP: IDENTIFICATION STAMP
DIVISION OF THE STATE ARCHITECT
APPL.01 1035 29
AC WW FLS
DATE 5/9/01 Redate 7/11/01
APPL. NUMBER:

KEY PLAN:

AS BUILTS

SHEET TITLE:

ENVELOPE DETAILS

DRAWN BY: GL	PROJECT NO.: 304.99
CHECKED BY: BA	DATE: 01-25-2001
APPL NO.:	SHEET: A3.2
DATA NO.:	NO.: OF: