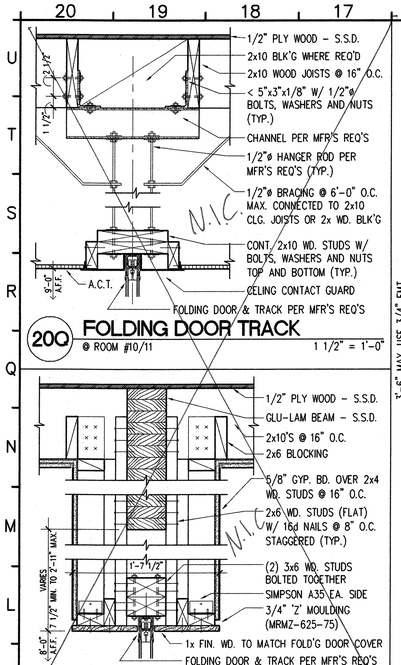

20Q FOLDING DOOR TRACK

@ ROOM #10/11 — 1 1/2" = 1'-0"

20K FOLDING DOOR TRACK

@ ROOM #40/41 — 1 1/2" = 1'-0"

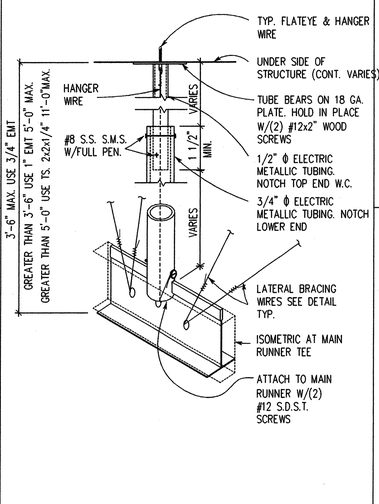

16K THRUST STRUT DETAIL

@ T-BAR GRID — N.T.S.

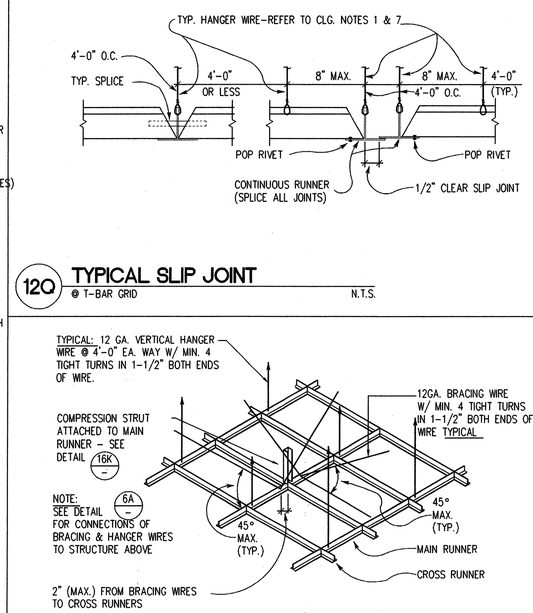

12Q TYPICAL SLIP JOINT

@ T-BAR GRID — N.T.S.

12K TYPICAL SUPPORT DETAIL

@ T-BAR GRID — N.T.S.

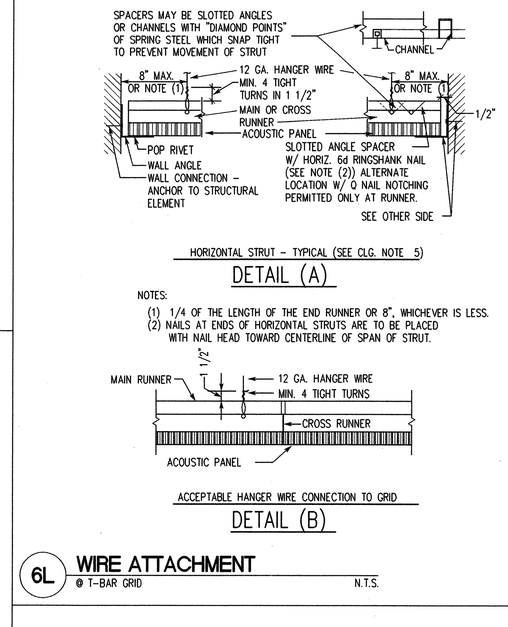

HORIZONTAL STRUT – TYPICAL (SEE CLG. NOTE 5)

DETAIL (A)

NOTES:
(1) 1/4 OF THE LENGTH OF THE END RUNNER OR 8", WHICHEVER IS LESS.
(2) NAILS AT ENDS OF HORIZONTAL STRUTS ARE TO BE PLACED WITH NAIL HEAD TOWARD CENTERLINE OF SPAN OF STRUT.

ACCEPTABLE HANGER WIRE CONNECTION TO GRID

DETAIL (B)

6L WIRE ATTACHMENT

@ T-BAR GRID — N.T.S.

20E FOLDING DOOR TRACK

@ ROOM 19/22 — 1 1/2" = 1'-0"

12E CEILING GRID DETAIL

N.T.S.

6A TYP. CEILING WIRE ANCHORAGE

@ WOOD FRAMING — N.T.S.

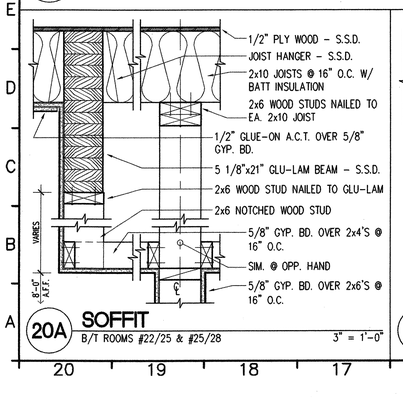

20A SOFFIT

B/T ROOMS #22/25 & #25/28 — 3" = 1'-0"

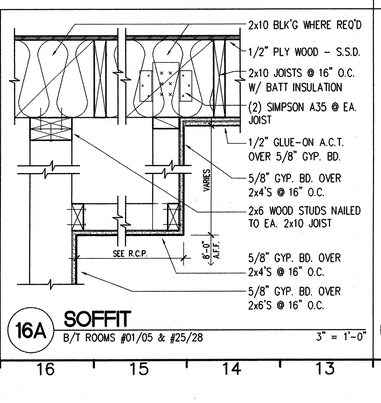

16A SOFFIT

B/T ROOMS #01/05 & #25/28 — 3" = 1'-0"

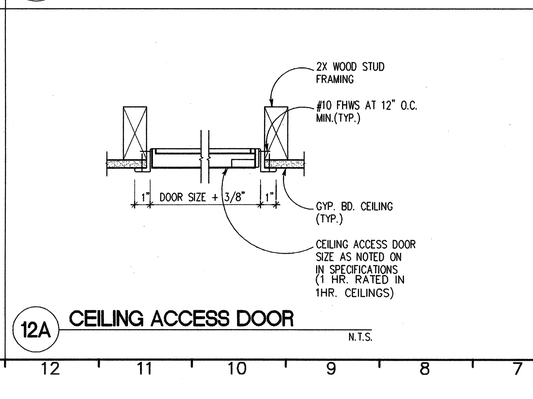

12A CEILING ACCESS DOOR

N.T.S.

REVISIONS: (△ INDICATES REVISIONS MADE TO THIS SHEET)

NO.:	DATE	REASON	BY

ISSUE FOR PROGRESS REVIEW	01/15/01
ISSUE FOR PLAN CHECK	01/25/01
ISSUE FOR FINAL REVIEW	05/09/01
ISSUE FOR BID	
ISSUE FOR CONSTRUCTION	

SEAL:

LICENSED ARCHITECT — BRUCE A. CIANFICHI — No. C-5310 — REN. 10-31-01 — STATE OF CALIFORNIA

ARCHITECT: CONSULTANT:

CONSULTANT:

ARCHITECT:

CIANFICHI
ARCHITECTURE • PLANNING

30 ANNE COURT
WALNUT CREEK, CA. 94598
TEL: (925) 256-8638
FAX: (925) 256-8652

PROJECT:

CHILD DEVELOPMENT CENTER
CAÑADA COLLEGE

4200 FARM HILL BLVD.
REDWOOD CITY, CA 94061

SAN MATEO COUNTY COMMUNITY COLLEGE DISTRICT

STAMP: IDENTIFICATION STAMP — DIVISION OF THE STATE ARCHITECT
APPL 01 1035 29 — AC WP FLS SS — DATE 5/14/01 — Rebate w/ Shell

APPL. NUMBER:

KEY PLAN:

AS-BUILTS

SHEET TITLE:

CEILING DETAILS

DRAWN BY: GL	PROJECT NO.: 304.99
CHECKED BY: BA	DATE: 01-25-2001
APPL NO.:	SHEET NO.: A5.1
DATA NO.:	OF:

35