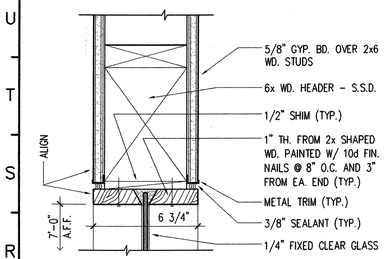

20Q HEAD DETAIL

3" = 1'-0"

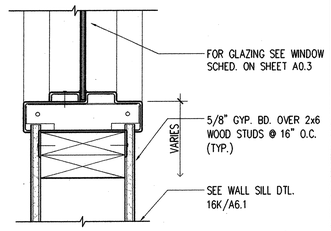

16Q INT. WINDOW SILL

SIM. @ HEAD & JAMB

3" = 1'-0"

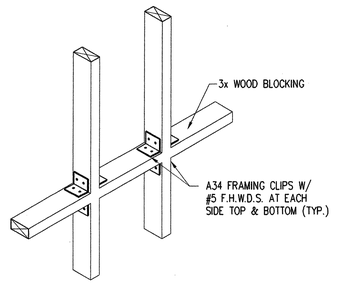

12Q WOOD BLOCKING DETAIL

N.T.S.

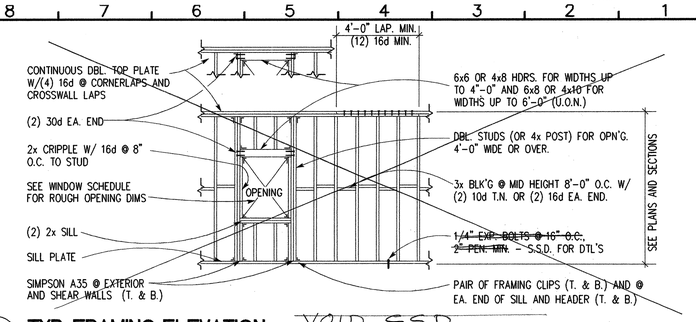

VOID SSD

8Q TYP. FRAMING ELEVATION

@ DOORS AND WINDOWS

1/8" = 1'-0"

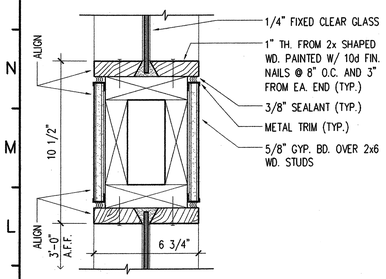

20K FRAME DETAIL

3" = 1'-0"

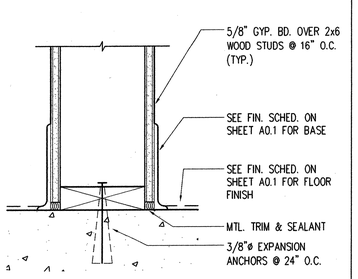

16K TYPICAL WALL SILL

3" = 1'-0"

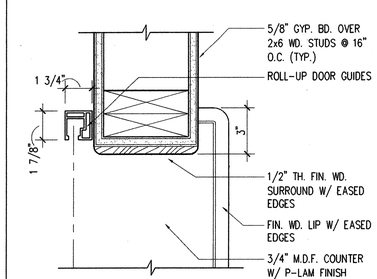

12K ROLL-UP DOOR JAMB

@ KITCHEN PASS-THRU

3" = 1'-0"

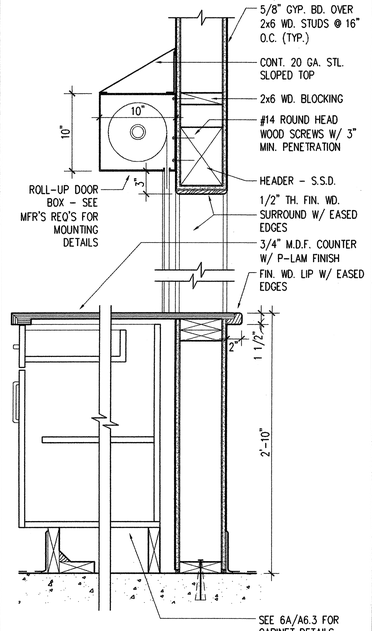

6E ROLL-UP DOOR HEAD/SILL

@ KITCHEN PASS-THRU

1 1/2" = 1'-0"

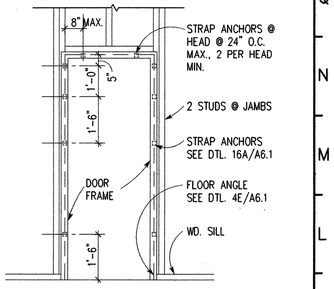

4K DOOR FRAMING

N.T.S.

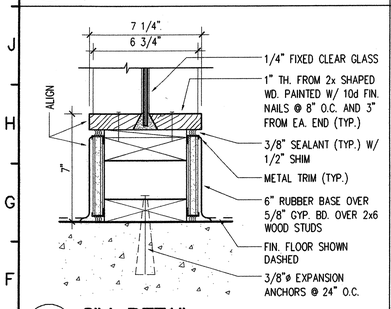

20E SILL DETAIL

3" = 1'-0"

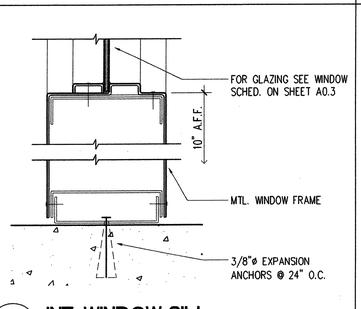

16E INT. WINDOW SILL

@ SIDELITE

3" = 1'-0"

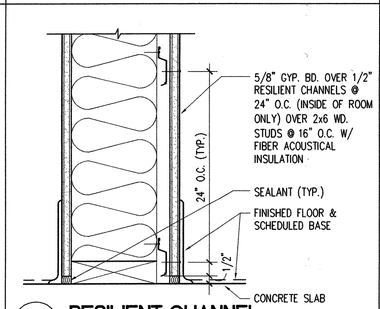

12E RESILIENT CHANNEL

@ ISOLATION ROOM #10/11

3" = 1'-0"

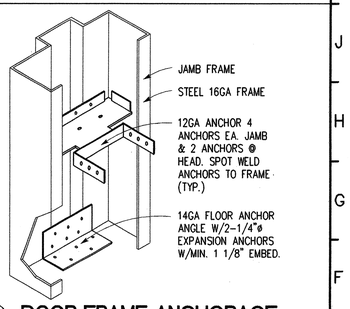

4E DOOR FRAME ANCHORAGE

N.T.S.

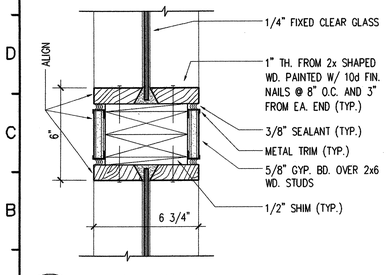

20A JAMB DETAIL

PLAN VIEW

3" = 1'-0"

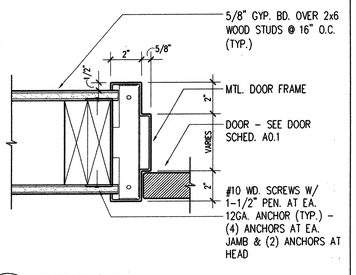

16A INT. DOOR JAMB

PLAN (SIM. @ HEAD)

3" = 1'-0"

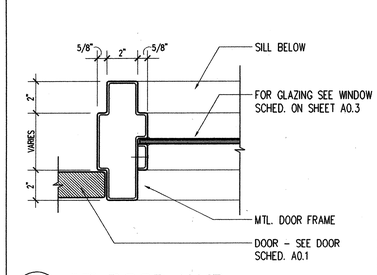

12A INT. DOOR JAMB

PLAN @ SIDELITE

3" = 1'-0"

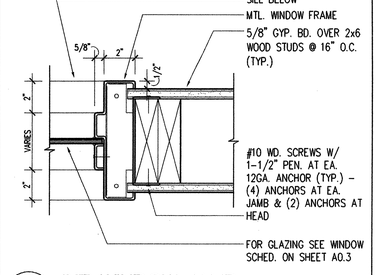

8A INT. WINDOW JAMB

PLAN

3" = 1'-0"

4A NOT USED

N.T.S.

REVISIONS: (△ INDICATES REVISIONS MADE TO THIS SHEET)			
NO.:	DATE	REASON	BY
ISSUE FOR PROGRESS REVIEW			01/15/01
ISSUE FOR PLAN CHECK			01/25/01
ISSUE FOR FINAL REVIEW			05/09/01
ISSUE FOR BID			
ISSUE FOR CONSTRUCTION			

SEAL:

LICENSED ARCHITECT — REG. C-24598 — EXP. 10-31-01 — STATE OF CALIFORNIA

ARCHITECT: CONSULTANT:

CONSULTANT:

ARCHITECT:

CIANFICHI
ARCHITECTURE • PLANNING

30 ANNE COURT
WALNUT CREEK, CA. 94598
TEL.: (925) 256-8638
FAX.: (925) 256-8652

PROJECT:

CHILD DEVELOPMENT CENTER CAÑADA COLLEGE

4200 FARM HILL BLVD. REDWOOD CITY, CA 94061

SAN MATEO COUNTY COMMUNITY COLLEGE DISTRICT

STAMP: IDENTIFICATION STAMP DIVISION OF THE STATE ARCHITECT
APPL.01 10 25 29
AS NOTED BY FLS
DATE 4/5/01
Redate by 4/24/01
APPL. NUMBER:
KEY PLAN:

AS BUILTS

SHEET TITLE:

INTERIOR DETAILS

DRAWN BY:	PROJECT NO.:
GL	304.99
CHECKED BY:	DATE:
BA	01-25-2001
APPL NO.:	SHEET:
DATA NO.:	A6.1
	NO.: OF:

96