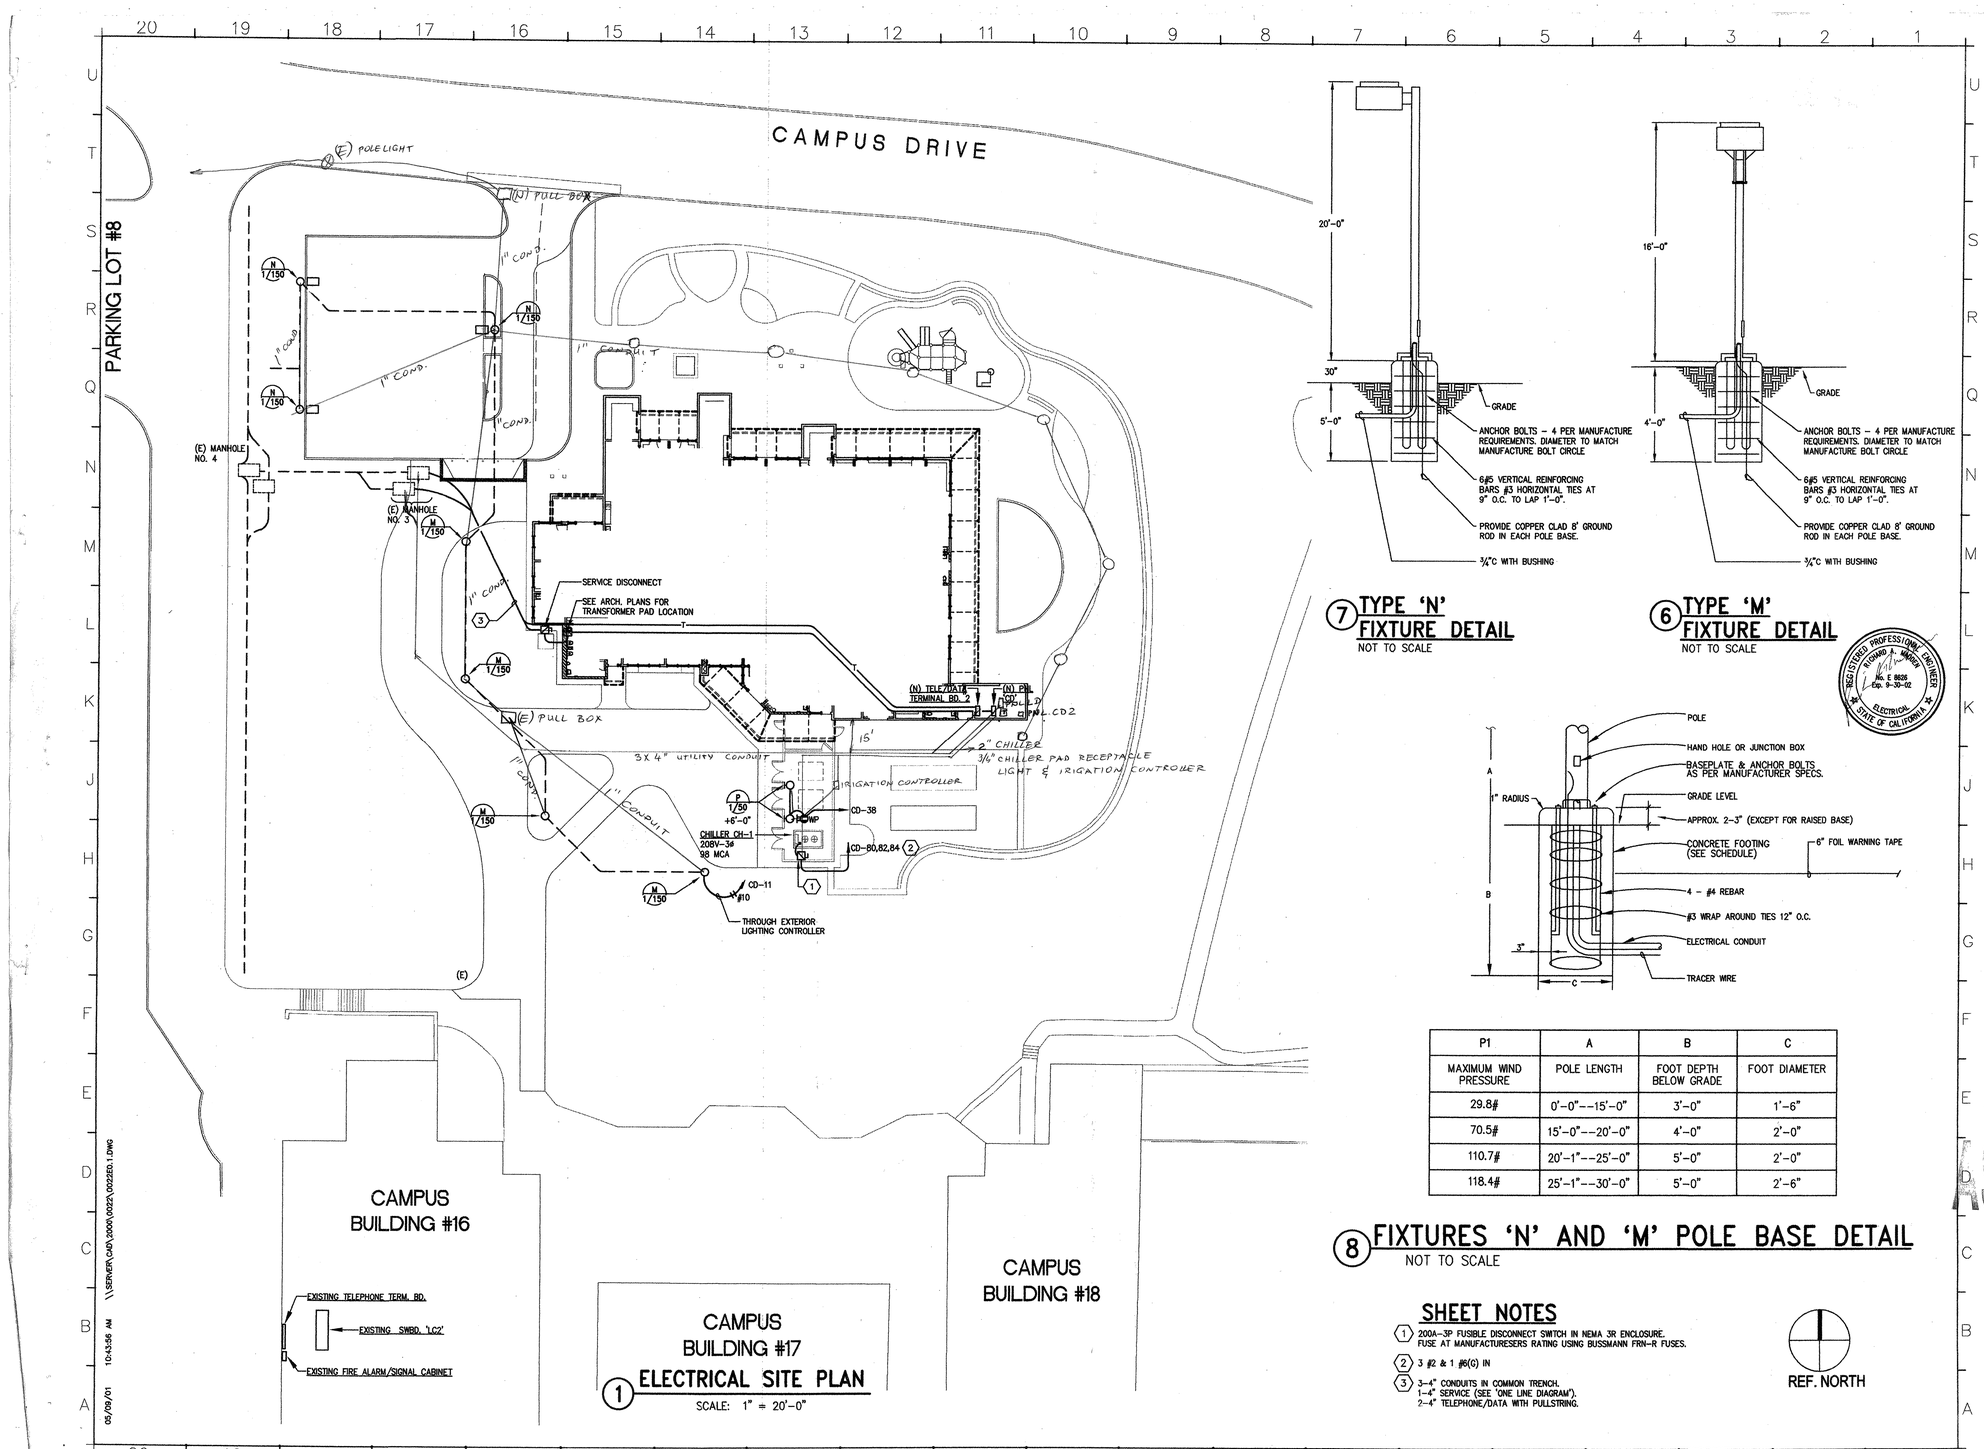

1 ELECTRICAL SITE PLAN
SCALE: 1" = 20'-0"

7 TYPE 'N' FIXTURE DETAIL
NOT TO SCALE

6 TYPE 'M' FIXTURE DETAIL
NOT TO SCALE

P1	A	B	C
MAXIMUM WIND PRESSURE	POLE LENGTH	FOOT DEPTH BELOW GRADE	FOOT DIAMETER
29.8#	0'–0"–-15'–0"	3'–0"	1'–6"
70.5#	15'–0"–-20'–0"	4'–0"	2'–0"
110.7#	20'–1"–-25'–0"	5'–0"	2'–0"
118.4#	25'–1"–-30'–0"	5'–0"	2'–6"

8 FIXTURES 'N' AND 'M' POLE BASE DETAIL
NOT TO SCALE

SHEET NOTES
1. 200A–3P FUSIBLE DISCONNECT SWITCH IN NEMA 3R ENCLOSURE. FUSE AT MANUFACTURESERS RATING USING BUSSMANN FRN–R FUSES.
2. 3 #2 & 1 #6(G) IN
3. 3–4" CONDUITS IN COMMON TRENCH. 1–4" SERVICE (SEE 'ONE LINE DIAGRAM'). 2–4" TELEPHONE/DATA WITH PULLSTRING.

05/09/01 10:43:56 AM \\SERVER\CAD\2000\0022\0022E0.1.DWG

REVISIONS: (△ INDICATES REVISIONS MADE TO THIS SHEET)

NO.:	DATE	REASON	BY

ISSUE FOR PROGRESS REVIEW	1/15/01
ISSUE FOR PLAN CHECK	1/25/01
ISSUE FOR FINAL REVIEW	5/9/01
ISSUE FOR BID	
ISSUE FOR CONSTRUCTION	

SEAL:

LICENSED ARCHITECT — JOHN D. CIANFICHI — No. C-8656 — REN. 10-31-02 — STATE OF CALIFORNIA

ARCHITECT:

CONSULTANT:

CONSULTANT:
WHM INCORPORATED
Engineering Consultants
1605 School Street
Moraga, CA 94556
Tel (925)376–2902 • Fax (925)376–2904
0022

ARCHITECT:
CIANFICHI
ARCHITECTURE • PLANNING
30 ANNE COURT
WALNUT CREEK, CA. 94598
TEL.: (925) 256–8638
FAX.: (925) 256–8652

REGISTERED PROFESSIONAL ENGINEER — RICHARD A. MARCH — No. E 8626 — Exp. 9–30–02 — ELECTRICAL — STATE OF CALIFORNIA

PROJECT:

CHILD DEVELOPMENT CENTER
CANADA COLLEGE

4200 FARM HILL BLVD.
REDWOOD CITY, CA 94061

SAN MATEO COUNTY COMMUNITY COLLEGE DISTRICT

STAMP:

IDENTIFICATION STAMP
BUREAU OF THE STATE ARCHITECT
DATE 1/25/01 — 104529 — FILED — BY — Roberta
APPL. NUMBER: 5/9/01

KEY PLAN:

AS-BUILTS

SHEET TITLE:

ELECTRICAL SITE PLAN, AND DETAILS

DRAWN BY: AK	PROJECT NO.: 304.99
CHECKED BY: FR	DATE: 01–25–2001
APPL NO.:	SHEET:
DATA NO.:	NO.: E–0.1 OF: