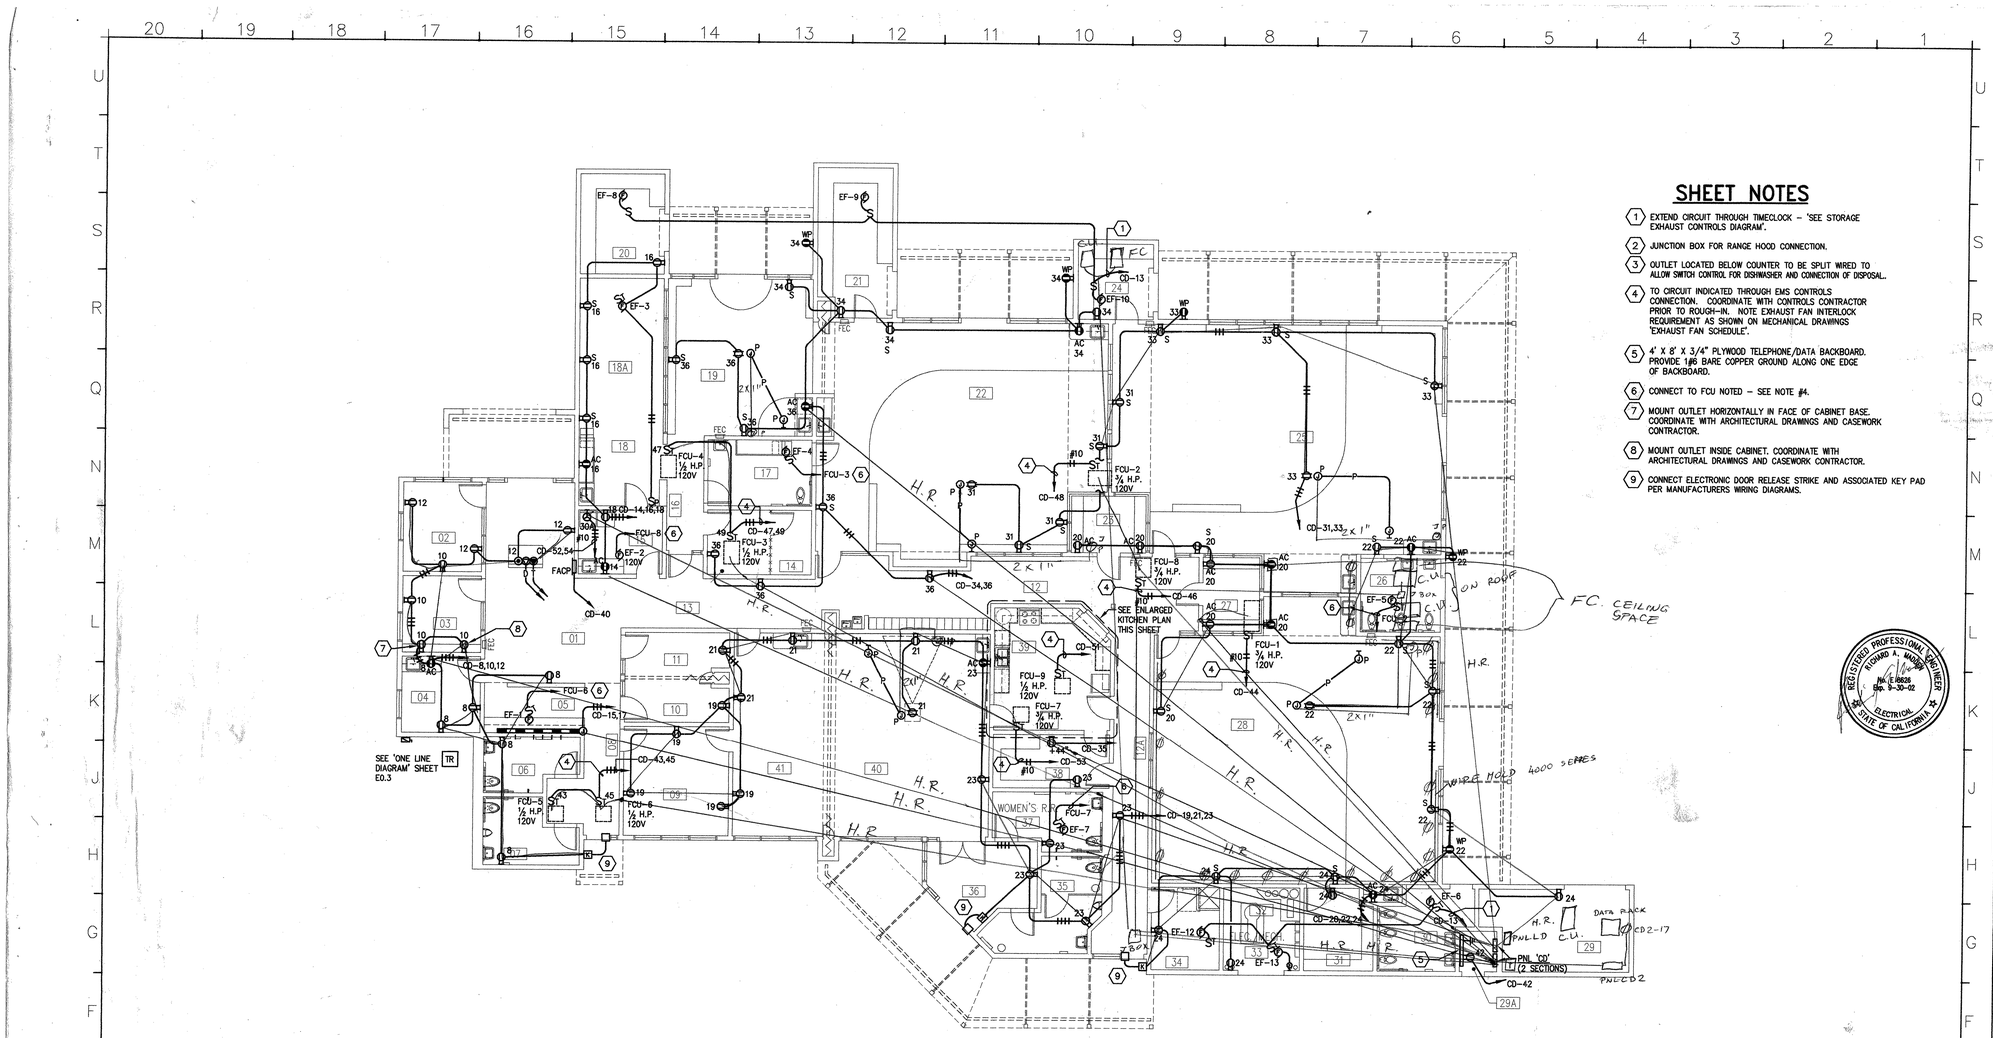

1 ELECTRICAL POWER PLAN

SCALE: 1/8" = 1' – 0"

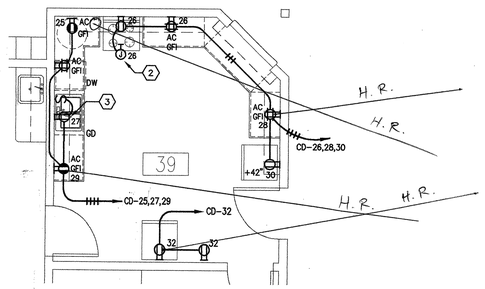

2 ENLARGED KITCHEN PLAN

SCALE: 1/4" = 1' – 0"

SHEET NOTES

1. EXTEND CIRCUIT THROUGH TIMECLOCK – 'SEE STORAGE EXHAUST CONTROLS DIAGRAM'.
2. JUNCTION BOX FOR RANGE HOOD CONNECTION.
3. OUTLET LOCATED BELOW COUNTER TO BE SPLIT WIRED TO ALLOW SWITCH CONTROL FOR DISHWASHER AND CONNECTION OF DISPOSAL..
4. TO CIRCUIT INDICATED THROUGH EMS CONTROLS CONNECTION. COORDINATE WITH CONTROLS CONTRACTOR PRIOR TO ROUGH-IN. NOTE EXHAUST FAN INTERLOCK REQUIREMENT AS SHOWN ON MECHANICAL DRAWINGS 'EXHAUST FAN SCHEDULE'.
5. 4' X 8' X 3/4" PLYWOOD TELEPHONE/DATA BACKBOARD. PROVIDE #6 BARE COPPER GROUND ALONG ONE EDGE OF BACKBOARD.
6. CONNECT TO FCU NOTED – SEE NOTE #4.
7. MOUNT OUTLET HORIZONTALLY IN FACE OF CABINET BASE. COORDINATE WITH ARCHITECTURAL DRAWINGS AND CASEWORK CONTRACTOR.
8. MOUNT OUTLET INSIDE CABINET. COORDINATE WITH ARCHITECTURAL DRAWINGS AND CASEWORK CONTRACTOR.
9. CONNECT ELECTRONIC DOOR RELEASE STRIKE AND ASSOCIATED KEY PAD PER MANUFACTURERS WIRING DIAGRAMS.

REF. NORTH

REVISIONS: (△ INDICATES REVISIONS MADE TO THIS SHEET)

NO.:	DATE	REASON	BY:

ISSUE FOR PROGRESS REVIEW	1/15/01
ISSUE FOR PLAN CHECK	1/25/01
ISSUE FOR FINAL REVIEW	5/9/01
ISSUE FOR BID	
ISSUE FOR CONSTRUCTION	

SEAL:

LICENSED ARCHITECT — EDWARD A. CIANFICHI — No. C-8316 — REN. 10-31-01 — STATE OF CALIFORNIA

REGISTERED PROFESSIONAL ENGINEER — RICHARD A. MONTEITH — No. E 9626 — Exp. 9-30-02 — ELECTRICAL — STATE OF CALIFORNIA

ARCHITECT: CONSULTANT:

CONSULTANT:

WHM INCORPORATED
Engineering Consultants
1605 School Street
Moraga, CA 94556
Tel (925)376-2902 • Fax (925)376-2904
0022

ARCHITECT:

CIANFICHI
ARCHITECTURE • PLANNING
30 ANNE COURT
WALNUT CREEK, CA. 94598
TEL: (925) 256-8638
FAX: (925) 256-8652

PROJECT:

CHILD DEVELOPMENT CENTER
CANADA COLLEGE

4200 FARM HILL BLVD.
REDWOOD CITY, CA 94061

SAN MATEO COUNTY COMMUNITY COLLEGE DISTRICT

STAMP: IDENTIFICATION STAMP
DIVISION OF THE STATE ARCHITECT
APPL.01 101529
DATE 5/11/01

APPL. NUMBER:

KEY PLAN:

AS-BUILTS

SHEET TITLE:

ELECTRICAL POWER PLAN

DRAWN BY: AK	PROJECT NO.: 304.99
CHECKED BY: FR	DATE: 01-25-2001
APPL NO.:	SHEET:
DATA NO.:	NO.: E-2.1 OF:

05/08/01 5:16:58 PM \\SERVER\CAD\2000\0022\0022E1.DWG