

ALL IDEAS, DESIGNS, ARRANGEMENTS AND PLANS INDICATED OR REPRESENTED BY THIS DRAWING ARE OWNED BY AND THE PROPERTY OF VERDE DESIGN, INC. AND WERE CREATED, ENVELOPED, AND DEVELOPED FOR USE ON AND IN CONNECTION WITH THE SPECIFIED PROJECT. NONE OF SUCH IDEAS, DESIGNS, ARRANGEMENTS OR PLANS SHALL BE USED, REPRODUCED, OR PUBLISHED BY ANY METHOD, IN WHOLE OR IN PART, OR DISCLOSED TO ANY PERSON, FIRM, OR CORPORATION FOR ANY PURPOSE WHATSOEVER WITHOUT WRITTEN PERMISSION OF VERDE DESIGN, INC.

NOT USED


NOT USED

NOT USED


NOT USED

NOT USED


NOT USED

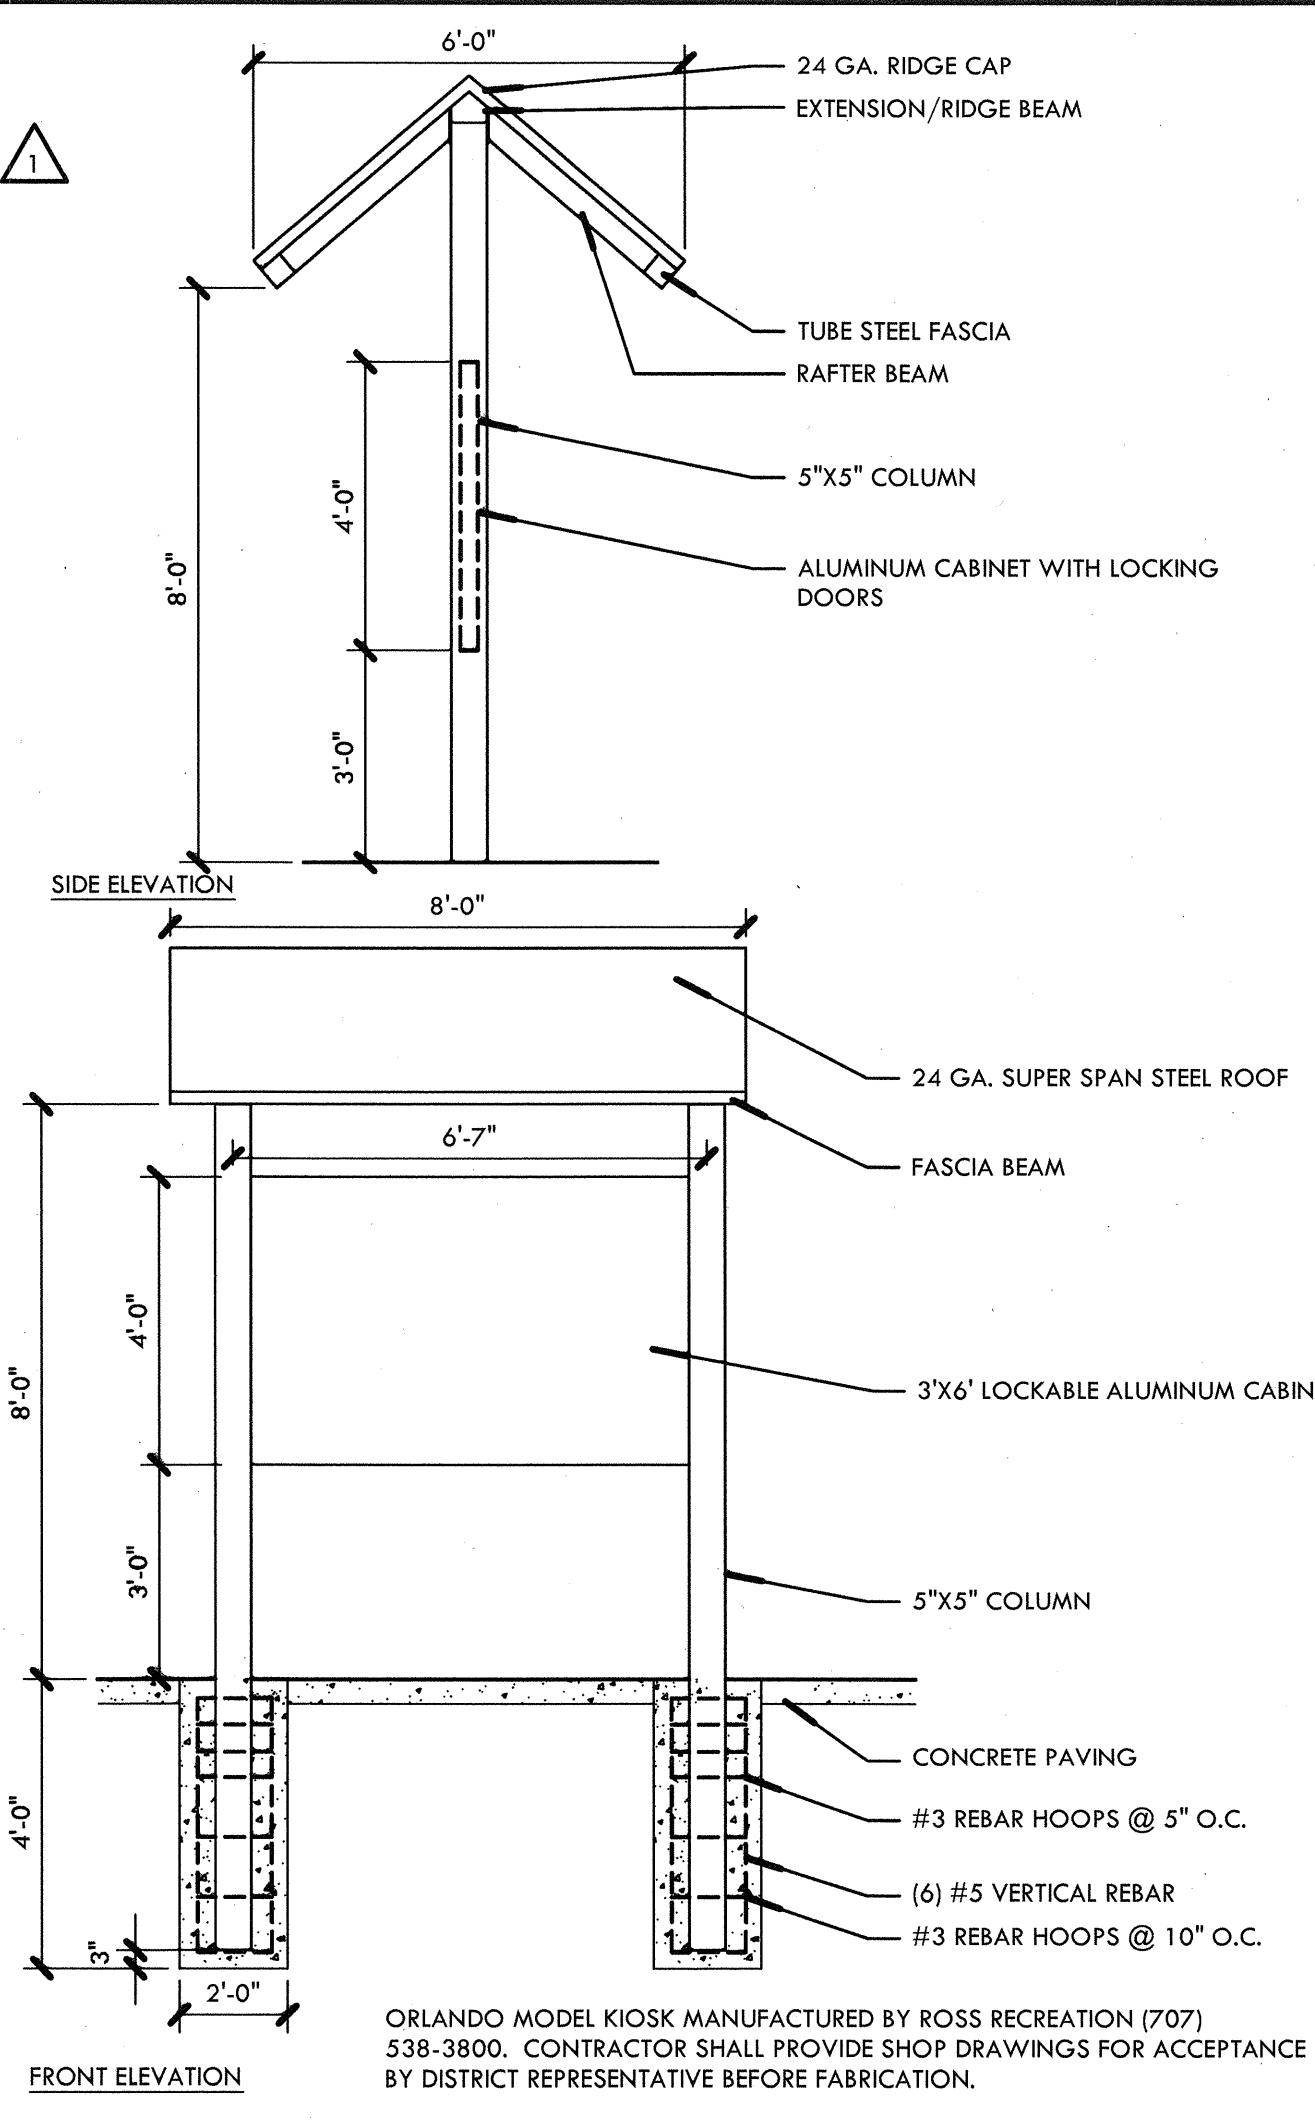


KIOSK SIGN NTS

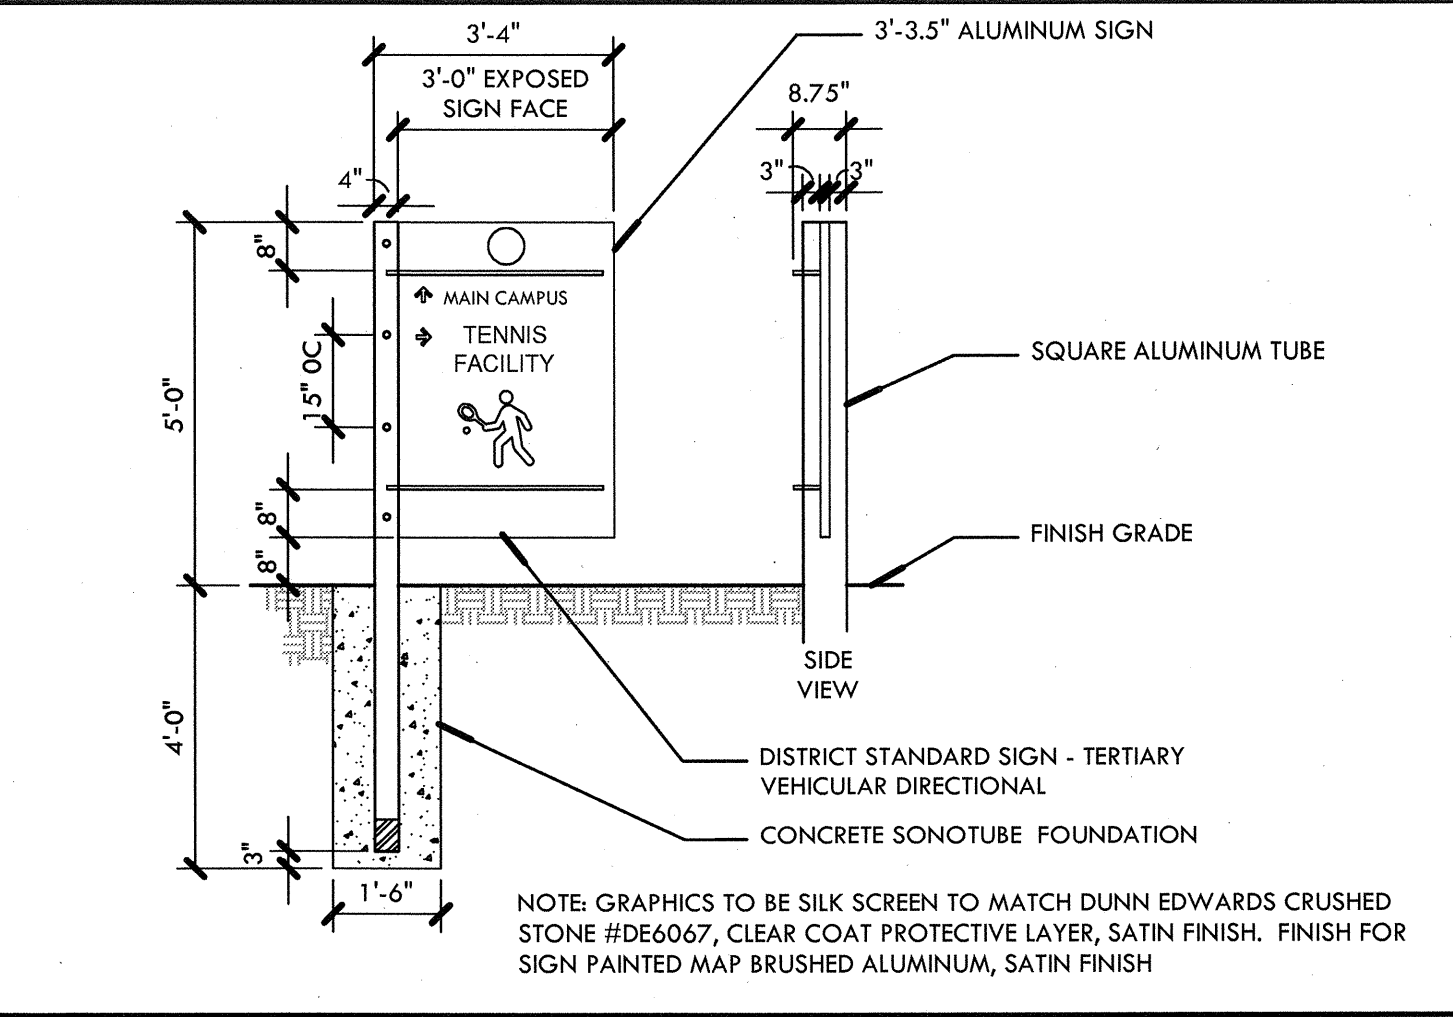


FACILITY SIGN NTS

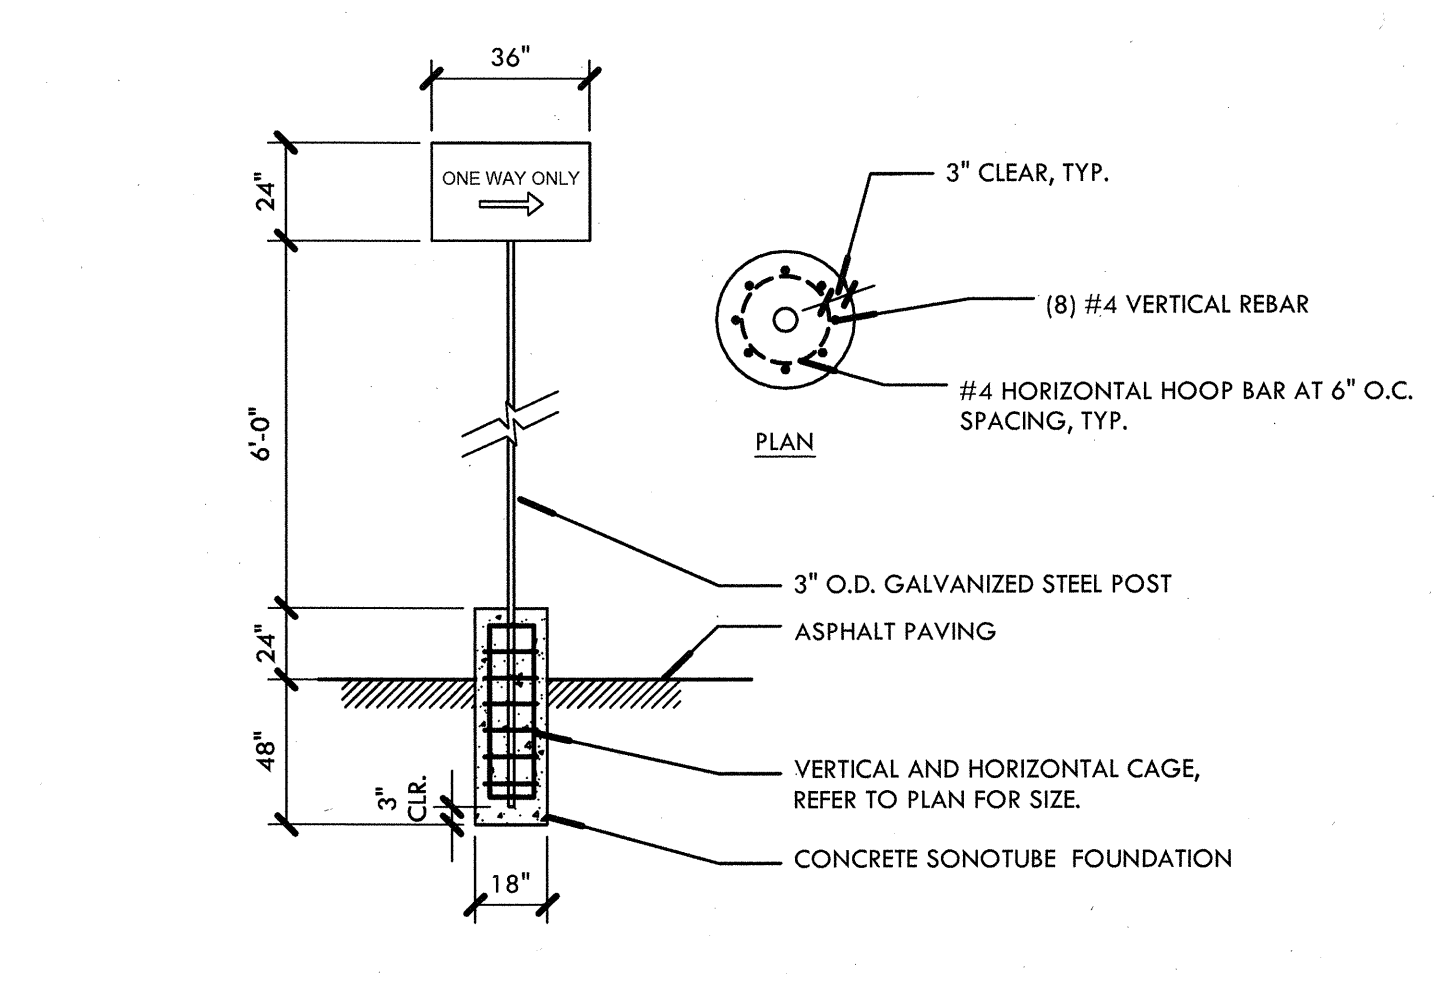


ONE WAY ONLY SIGN NTS

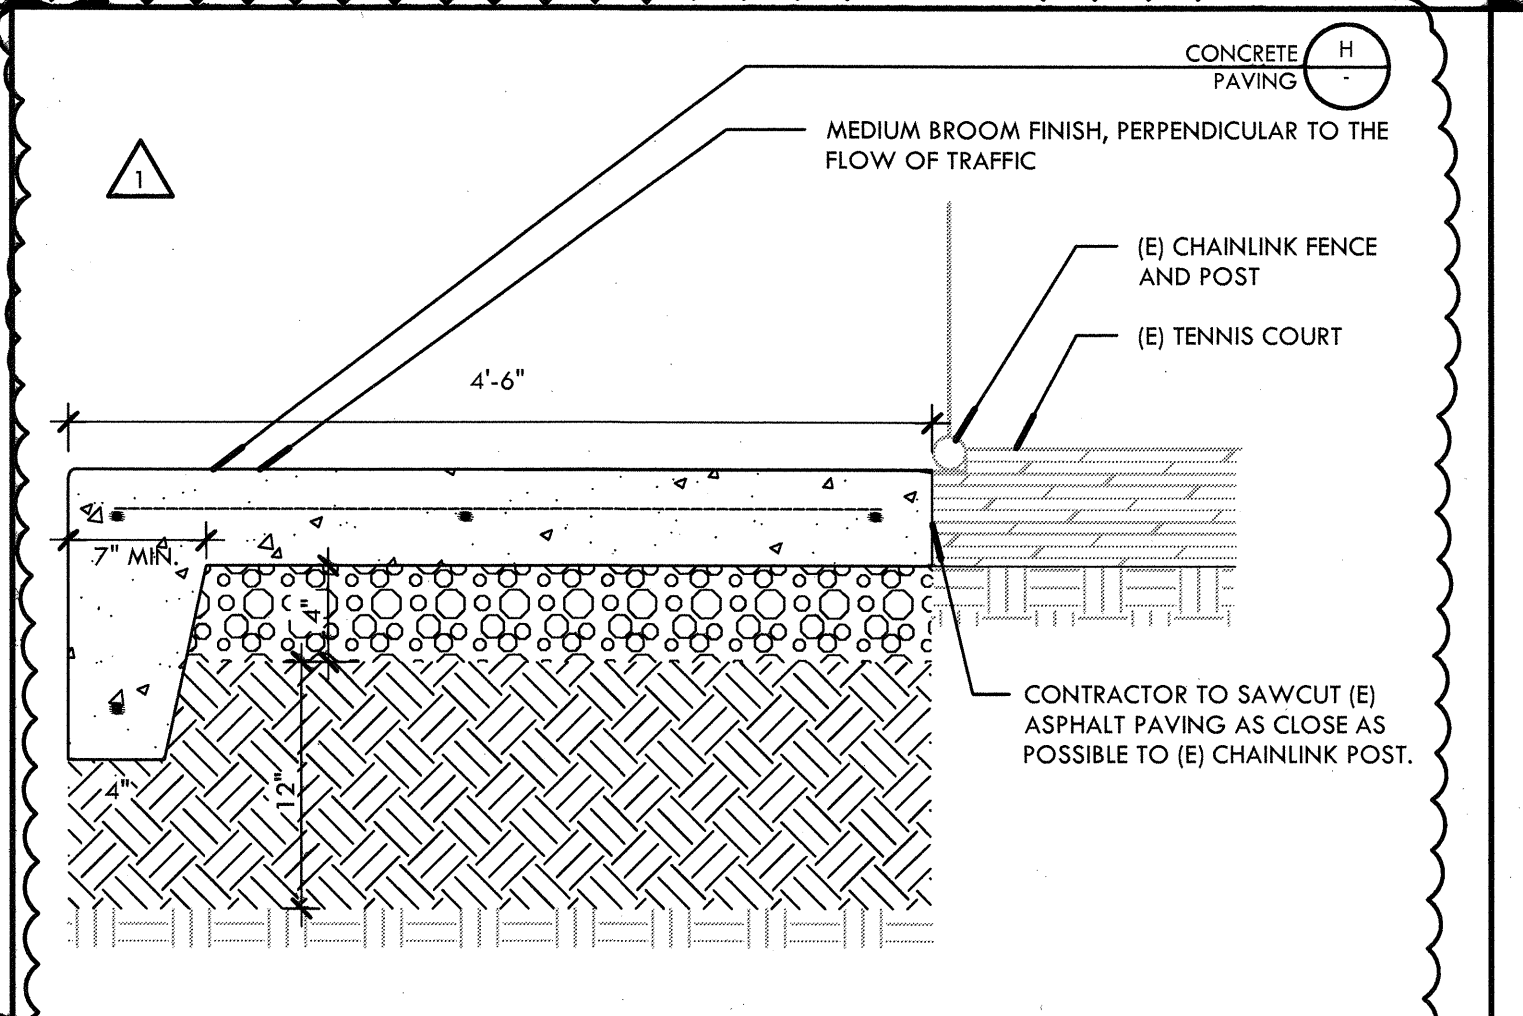

CONCRETE CONFORM NTS

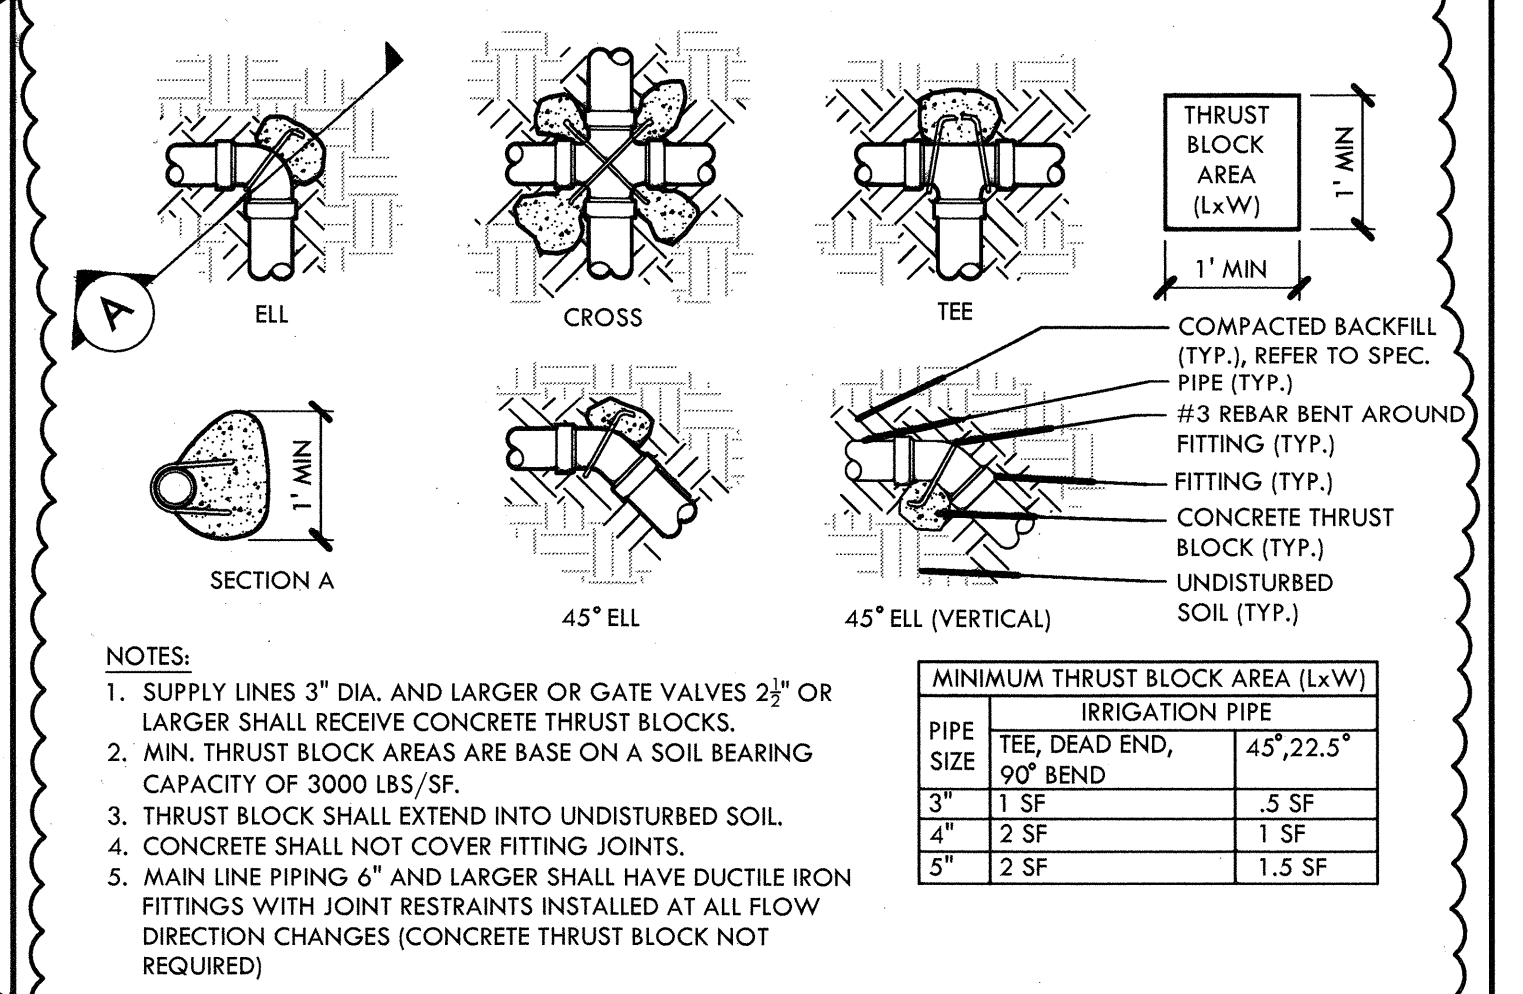

THRUST BLOCK NTS

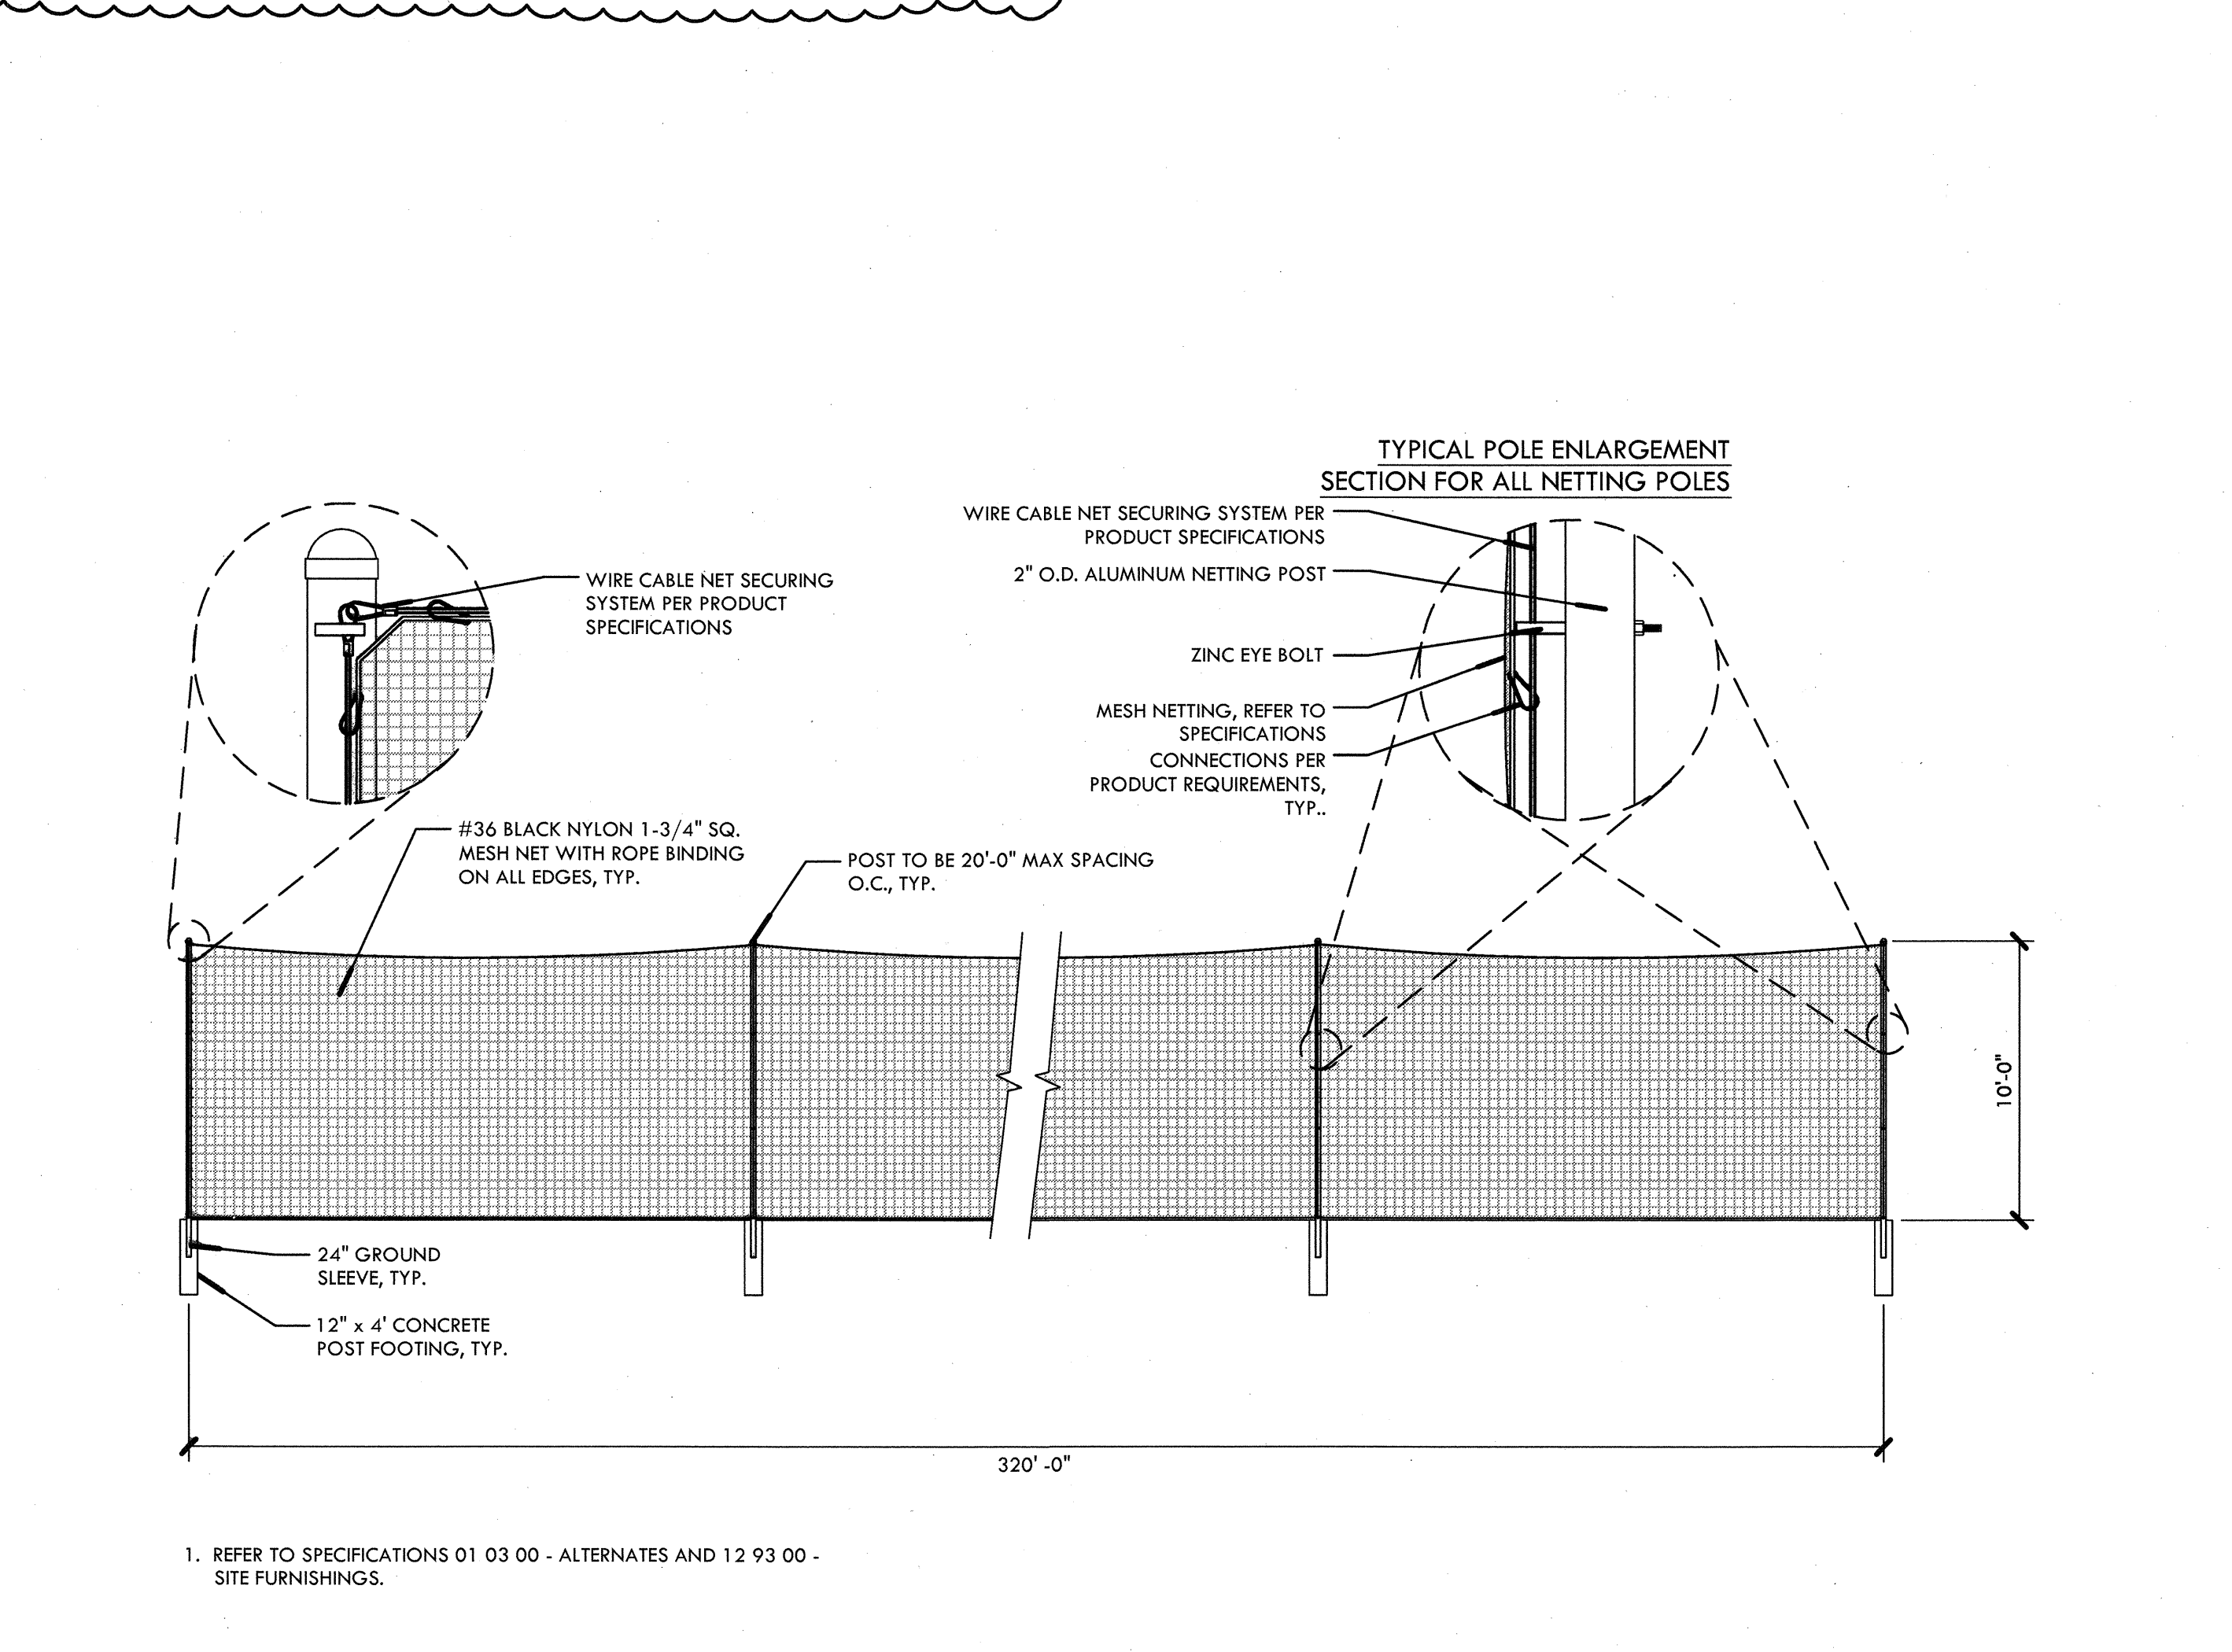

10' TALL NETTING - ALTERNATE "A" NTS

SUBMITTAL	DATE
90% SUBMITTAL	07/30/12
BID SUBMITTAL	08/21/12
CONFORM SET	09/24/12

NO.	REVISIONS	DATE

DRAWN BY VERDE	CHECKED BY DC
DATE ISSUED 08/21/12	SCALE AS NOTED
PROJ. NO. 1207300-1281	