DOOR SCHEDULE - BLDG 3

DOOR	TYPE	SIZE	DR	FR	RATE	DETAILS			HDW	REMARKS
						HEAD	JAMB	SILL		
3A	GATE-3	PR 6'-0" X HEIGHT VIF	STL	STL	NA	PER MFR	PER MFR	PER MFR	05	GATE SHALL MATCH (E) ADJACENT FENCE HEIGHT

DOOR TYPE LEGEND

GATE-3

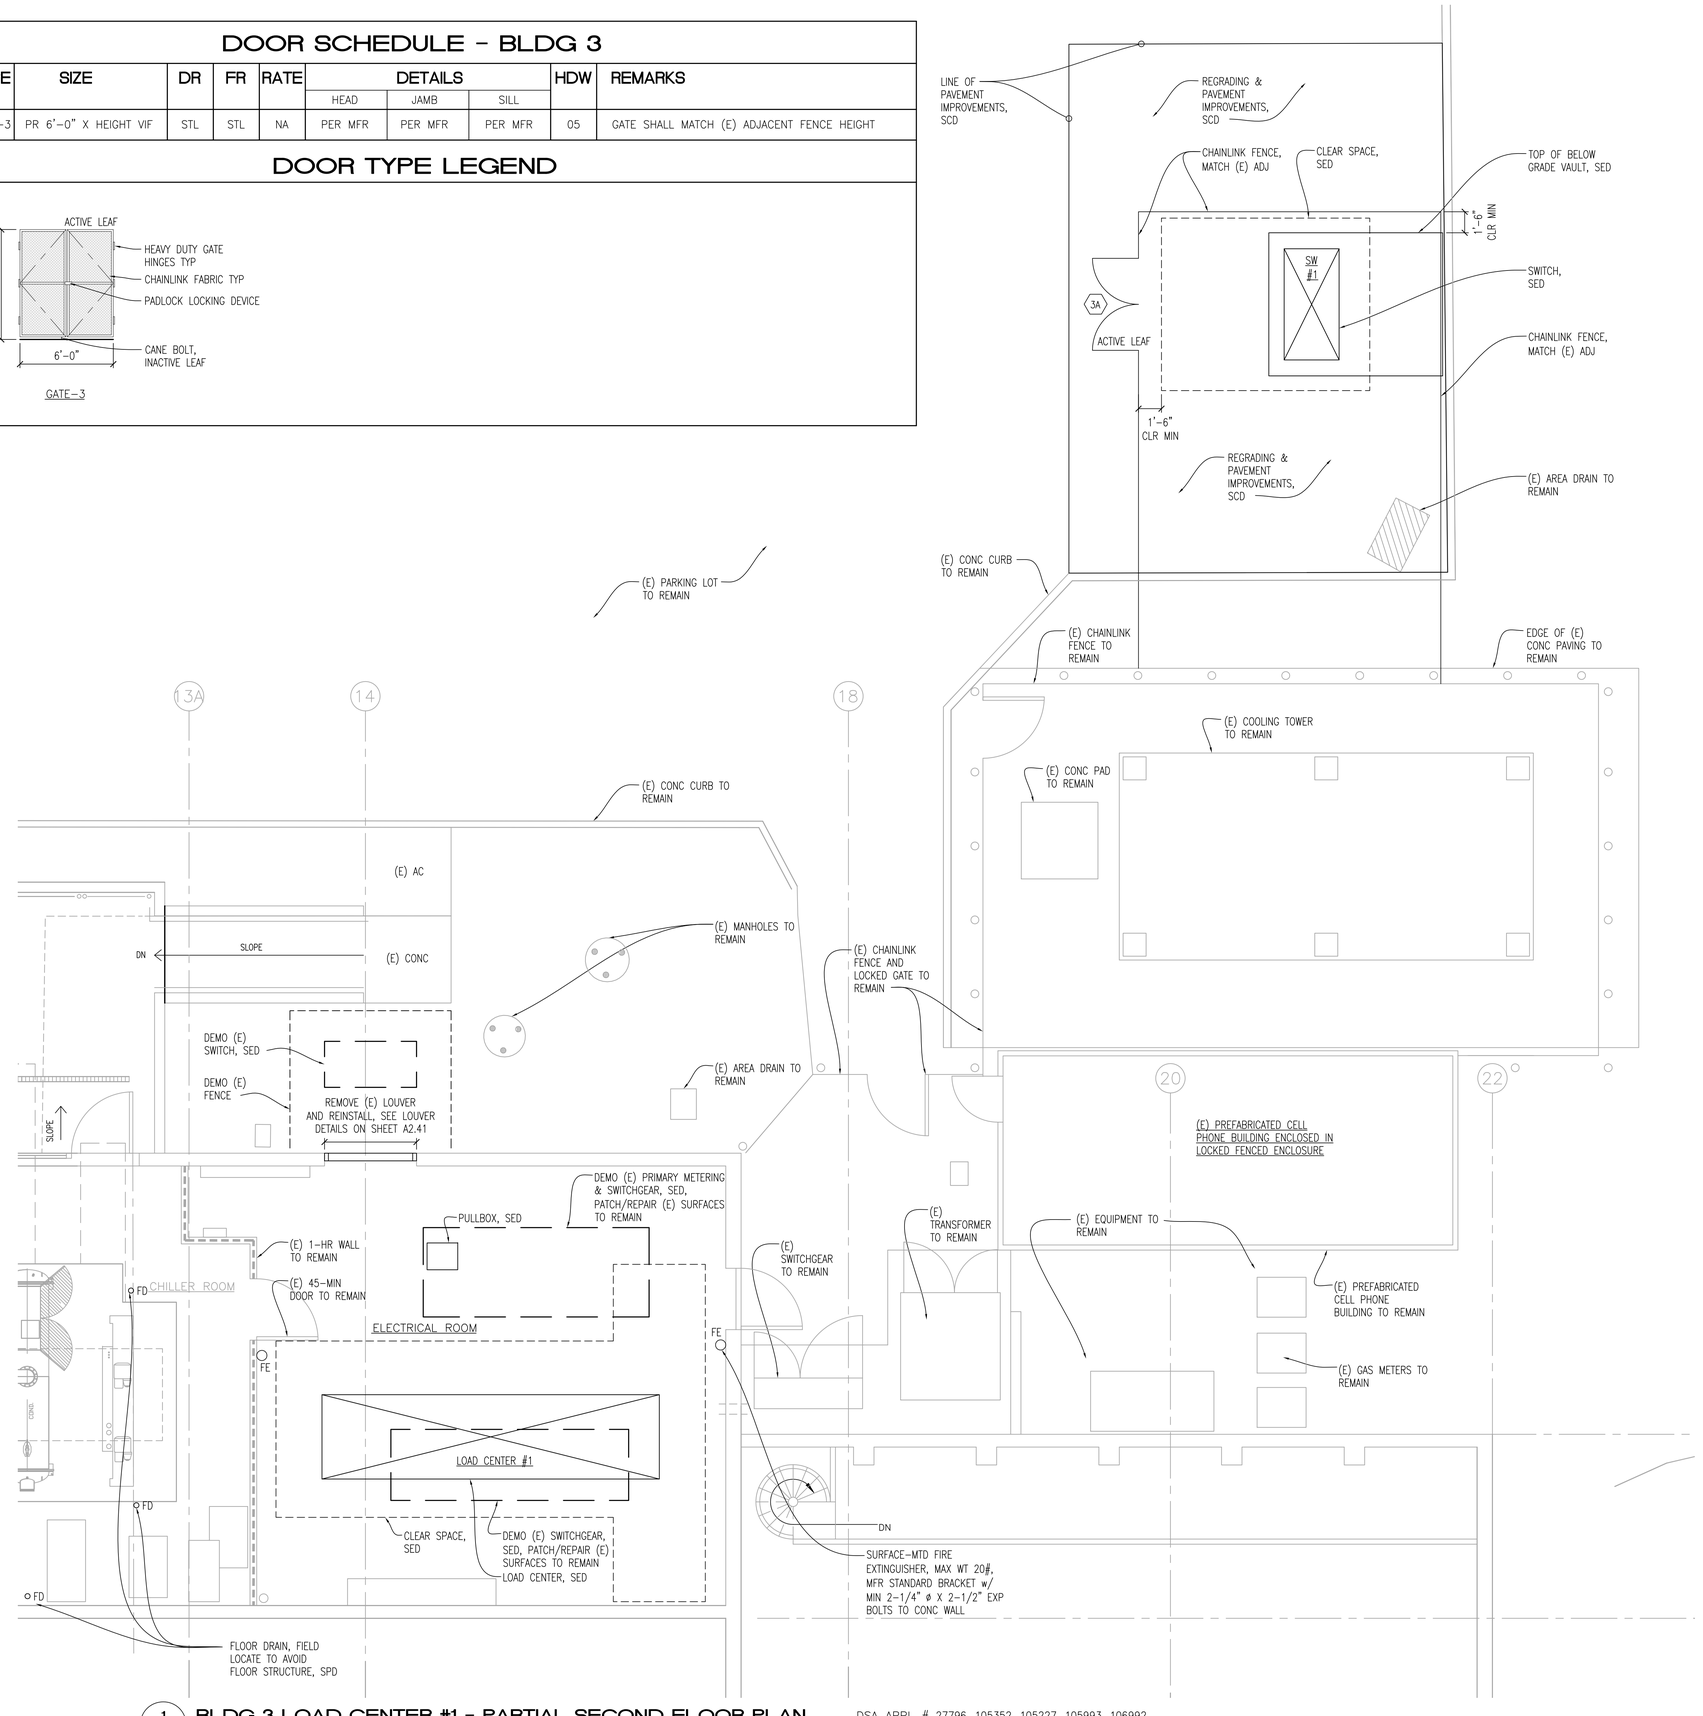

1 / A2.21 BLDG 3 LOAD CENTER #1 - PARTIAL SECOND FLOOR PLAN

DSA APPL # 27796, 105352, 105227, 105993, 106992

1/4" = 1'-0"

LEGEND

CHAINLINK FENCE

1-HR WALL

Reference North N

SEE A0.01 FOR KEY PLAN

noll & tam
architects and planners
729 Heinz Avenue
Berkeley, CA 94710
510.649.8295
fax 510.649.3008

IDENTIFICATION STAMP
DIVISION OF THE STATE ARCHITECT
APPLICATION NUMBER 01-111618
AC _____ FLS _____ SS _____
DATE

CALIFORNIA STATE FIRE MARSHAL APPROVED

APPROVAL OF THIS PLAN DOES NOT AUTHORIZE OR APPROVE ANY OMISSION OR DEVIATION FROM APPLICABLE REGULATIONS. FINAL APPROVAL IS SUBJECT TO FIELD INSPECTION. ONE SET OF APPROVED PLANS SHALL BE AVAILABLE ON THE PROJECT SITE AT ALL TIMES.

REVIEWED BY: _____ DATE:

CAÑADA COLLEGE

Electrical Infrastructure Replacement Project

4200 Farm Hill Blvd
Redwood City, CA 94061

LICENSED ARCHITECT
CHRISTOPHER NOLL
REN. 12/31/11
C15916
STATE OF CALIFORNIA

RECORD DRAWING

SHEET TITLE

Bldg 3 Load Center #1- Plan

REVISIONS

NO.	DATE	DESCRIPTION

DATE	July 9, 2012
DRAWN	TC/AL
CHECKED	MM
SCALE	1/4" = 1'-0"
JOB NO.	2921.01

SHEET NUMBER

A2.21