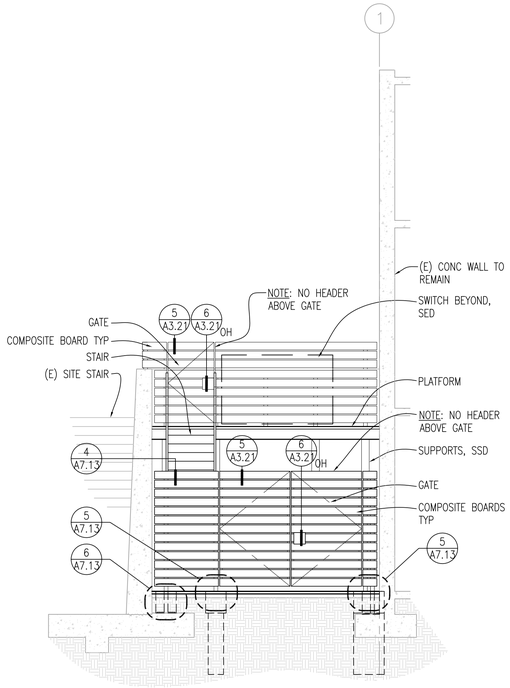

3 A3.21 BLDG 16 - EXTERIOR ELEVATION

1/4" = 1'-0"

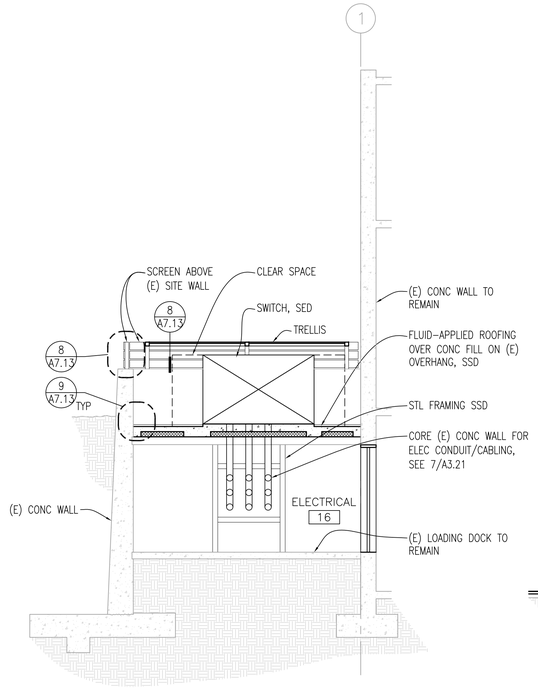

2 A3.21 BLDG 16 - SECTION

1/4" = 1'-0"

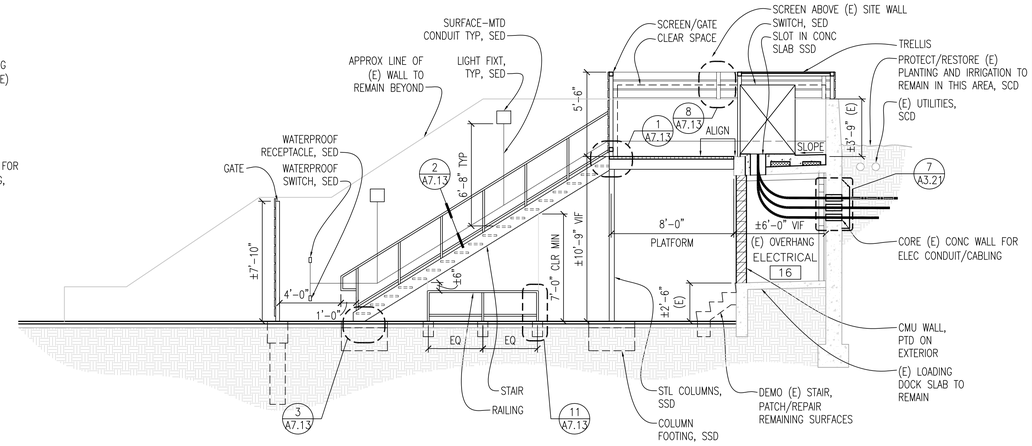

1 A3.21 BLDG 16 - SECTION

1/4" = 1'-0"

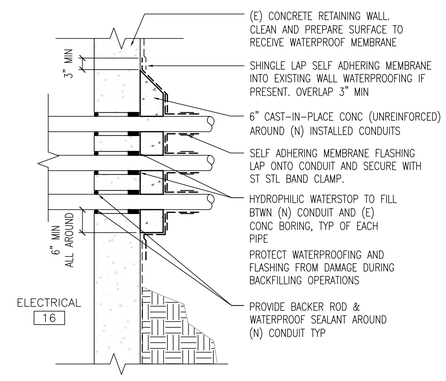

7 A3.21 WATERPROOFING @ ELECTRICAL ROOM 16

3/4" = 1'-0"

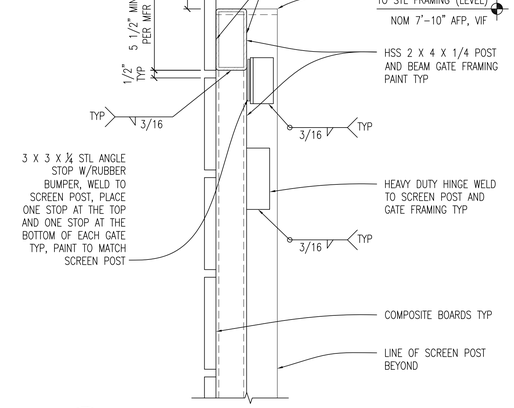

5 A3.21 TOP OF SCREEN GATE DETAIL

3" = 1'-0"

SHEET NOTES

1. PREPARE AND PAINT EXISTING CONCRETE WALLS ENCLOSING THE GROUND FLOOR AND FIRST FLOOR LEVELS OF THE SWITCH AREA TO THE HEIGHT OF THE TOP OF THE EXISTING LOADING DOCK WALLS. AT NORTH WALL, PAINT FULL LENGTH OF WALL, INCLUDING THE PORTION OUTSIDE THE SCREENED ENCLOSURE.

2. DISTRICT STANDARD COLORS AS SPECIFIED. COLORS TO MATCH EXISTING UON.

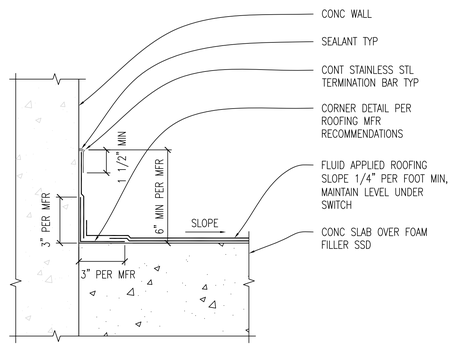

9 A3.21 FLUID APPLIED ROOFING DETAIL

3" = 1'-0"

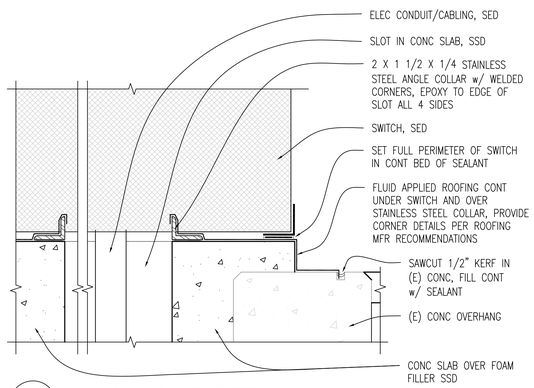

8 A3.21 SWITCH BASE DETAIL

3" = 1'-0"

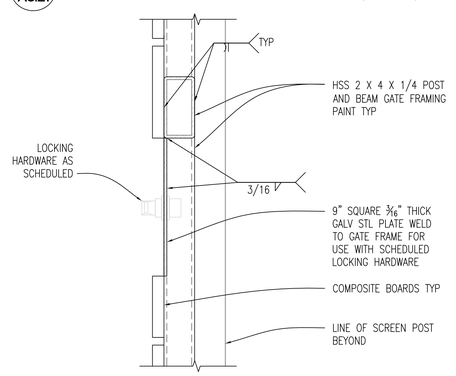

6 A3.21 SCREEN GATE DETAIL AT LOCKING HARDWARE

3" = 1'-0"

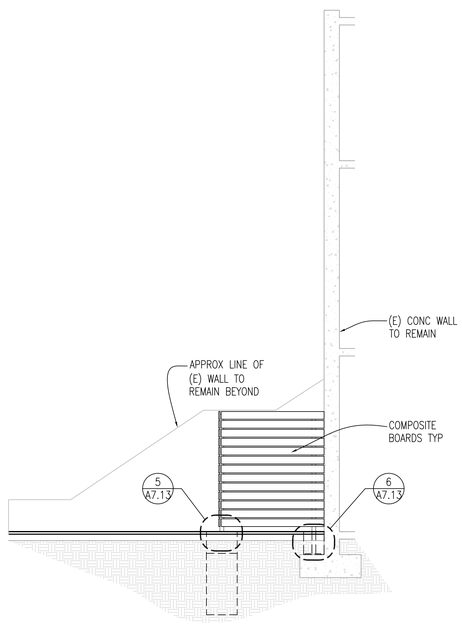

4 A3.21 BLDG 16 - EXTERIOR ELEVATION

1/4" = 1'-0"

noll & tam
architects and planners
729 Heinz Avenue
Berkeley, CA 94710
510.649.8295
fax 510.649.3008

IDENTIFICATION STAMP
DIVISION OF THE STATE ARCHITECT
APPLICATION NUMBER 01-111618
AC _____ FLS _____ SS _____
DATE

CALIFORNIA STATE FIRE MARSHAL APPROVED

APPROVAL OF THIS PLAN DOES NOT AUTHORIZE OR APPROVE ANY OMISSION OR DEVIATION FROM APPLICABLE REGULATIONS. FINAL APPROVAL IS SUBJECT TO FIELD INSPECTION. ONE SET OF APPROVED PLANS SHALL BE AVAILABLE ON THE PROJECT SITE AT ALL TIMES.

REVIEWED BY: _____ DATE:

CAÑADA COLLEGE

Electrical Infrastructure Replacement Project

4200 Farm Hill Blvd
Redwood City, CA 94061

LICENSED ARCHITECT
CHRISTOPHER NOLL
REN. 12/31/11
C15916
STATE OF CALIFORNIA

RECORD DRAWING

SHEET TITLE

Bldg 16- Sections, Ext Elev

REVISIONS

NO.	DATE	DESCRIPTION

DATE July 9, 2012
DRAWN TC/AL
CHECKED MM
SCALE 1/4" = 1'-0"
JOB NO. 2921.01

SHEET NUMBER

A3.21