


1 Underground Plumbing Plan - Level 1 South
SCALE: 1/8"=1'-0"


RECORD DOCUMENT
 DATE: October 15, 2010

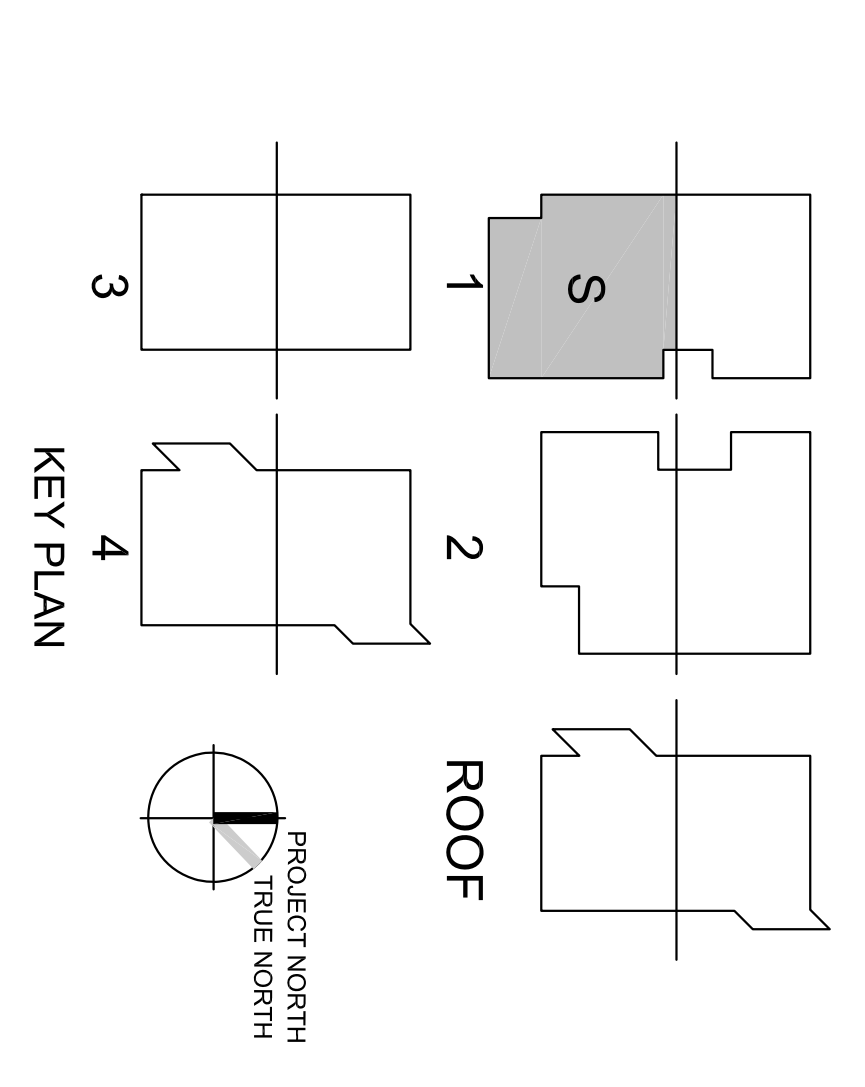

Revision	Description	Date
100%	Design Development	06/30/08
90%	Construction Documents	07/25/08
50%	Submittal	08/14/08
95%	Construction Documents	12/28/08
05A	Final	03/11/09


Revision	Description	Date

**College of San Mateo
Building 10N**

San Mateo, CA

Developed for
San Mateo County Community College District


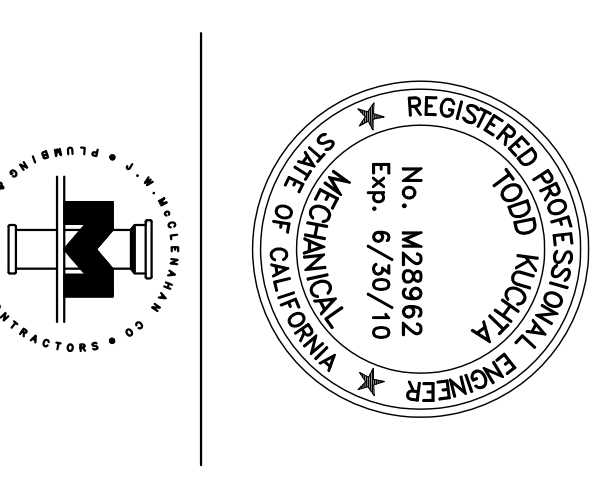


DATE	4-1-11
FILE NUMBER	41-C1
DESIGNATION	REGISTERED PROFESSIONAL ENGINEER
EXPIRES	6/30/10
STATE	CALIFORNIA
CLASSIFICATION	MECHANICAL
OFFICE	STATE OF CALIFORNIA
APPL. #	01-110095
EXPIRES	
FILE NUMBER	

McCarthy Building Companies, Inc.
 343 Serrano Ave., Suite 1410
 San Francisco, California 94104
 P 415 397-5151
 F 415 397-5999



P2.02.BG



**PLUMBING PLAN
FIRST FLOOR (S)
BELOW GROUND**

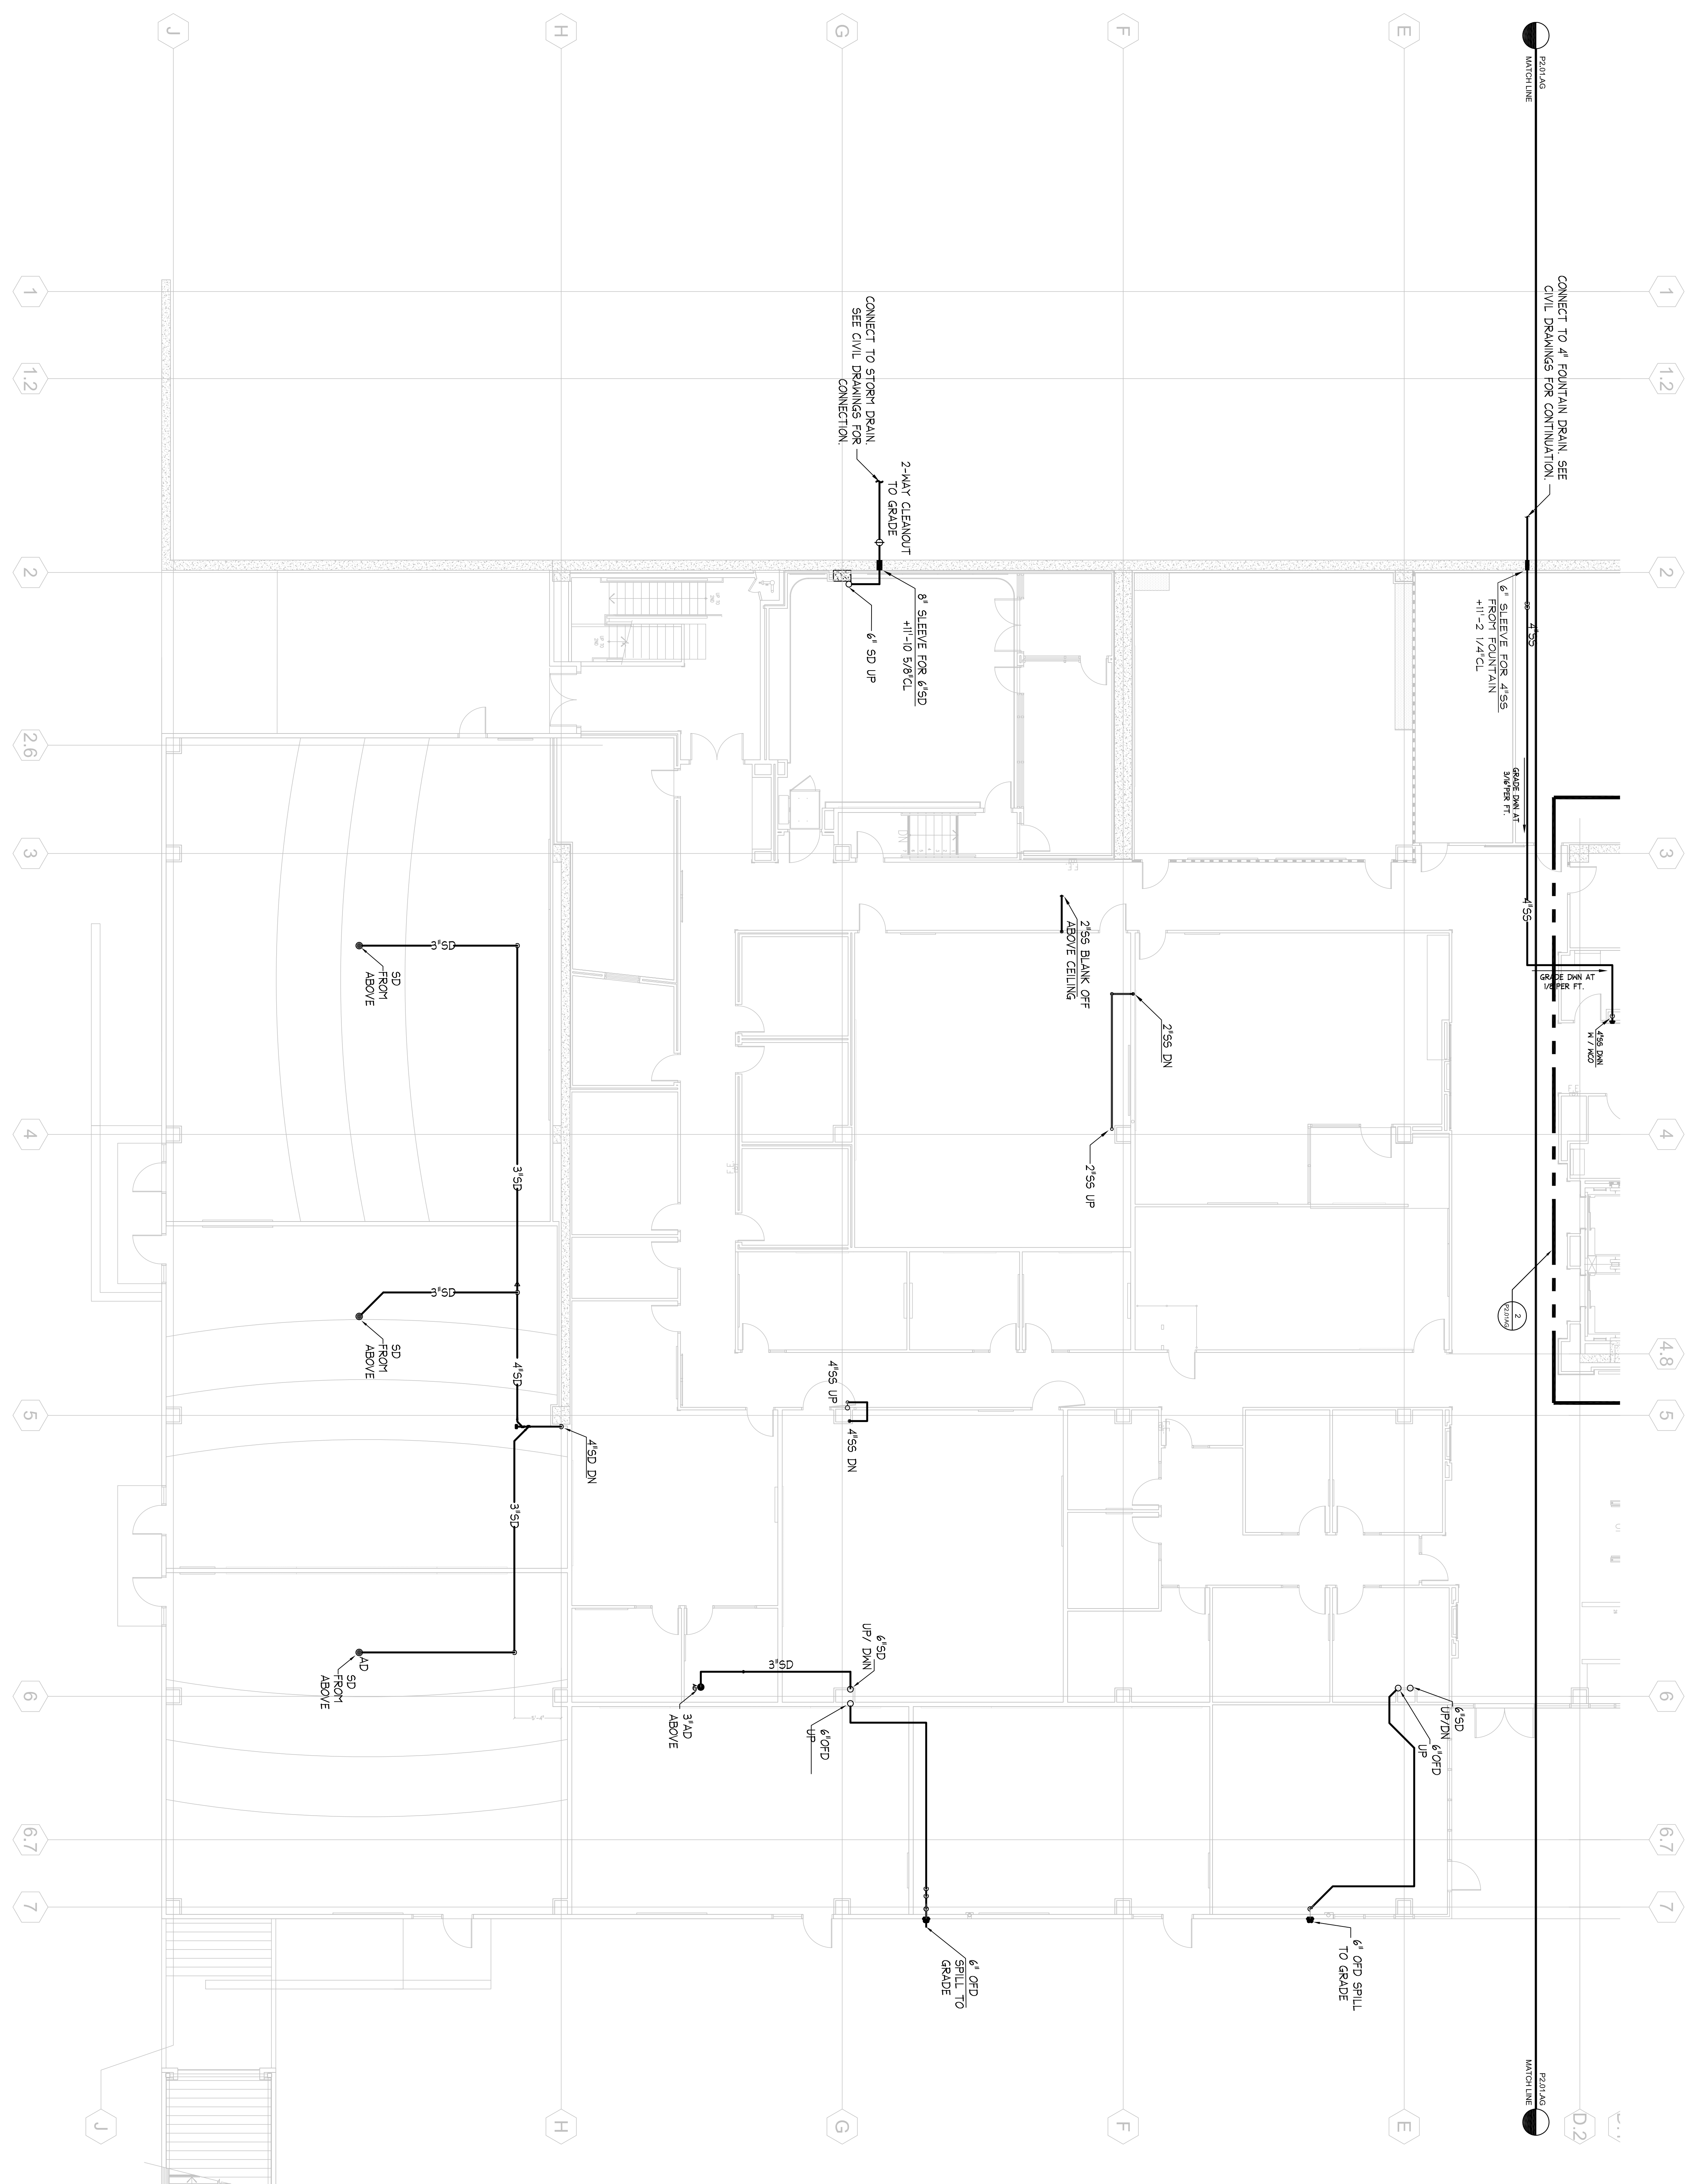

1 Above Ground Plumbing Plan - Level 1 South
SCALE: 1/8"=1'-0"

J.W. McCLENAHAN CO.

RECORD DOCUMENT
 DATE: October 15, 2010

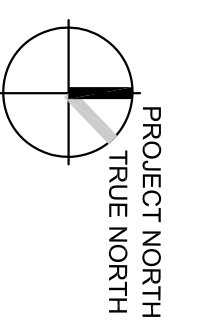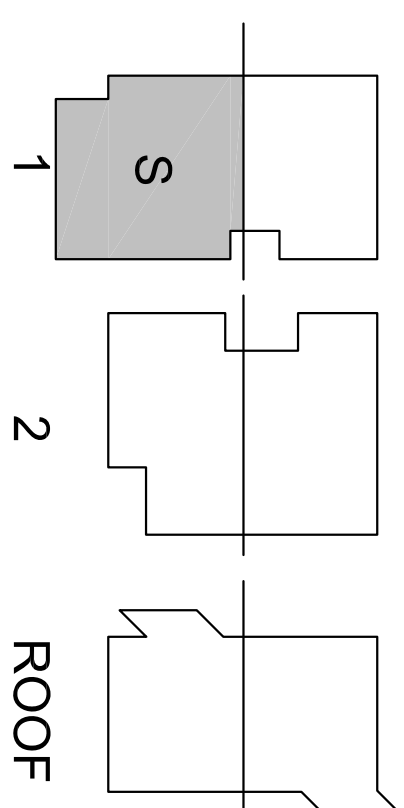

Revision	Description	Date
06/30/08	100% Design Development	
07/18/08	50% Construction Documents	
08/14/08	95% Construction Documents	
12/28/08	95% Construction Documents	
03/11/09	DSA Final	

Revision	Description	Date


Revision	Description	Date

College of San Mateo Building 10N

San Mateo, CA

Developed for
San Mateo County Community College District

J.W. McCLENAHAN CO.

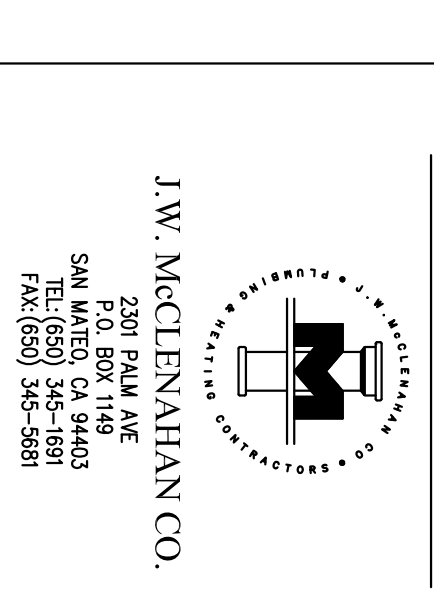

DATE: _____	FILE NUMBER: 41-C1
APPL. #.: 01-110095	

McCarthy Building Companies, Inc.
 343 California Street, 14th Floor
 San Francisco, California 94104
 P 415 397-5151
 F 415 397-5999




Revision	Description	Date

Revision	Description	Date


Revision	Description	Date

Job No.	27062201
Drawn	MAJOR 2008
Checked by	SCD
Scale	1/8" = 1'-0"
PLUMBING PLAN	
SECOND FLOOR (N)	

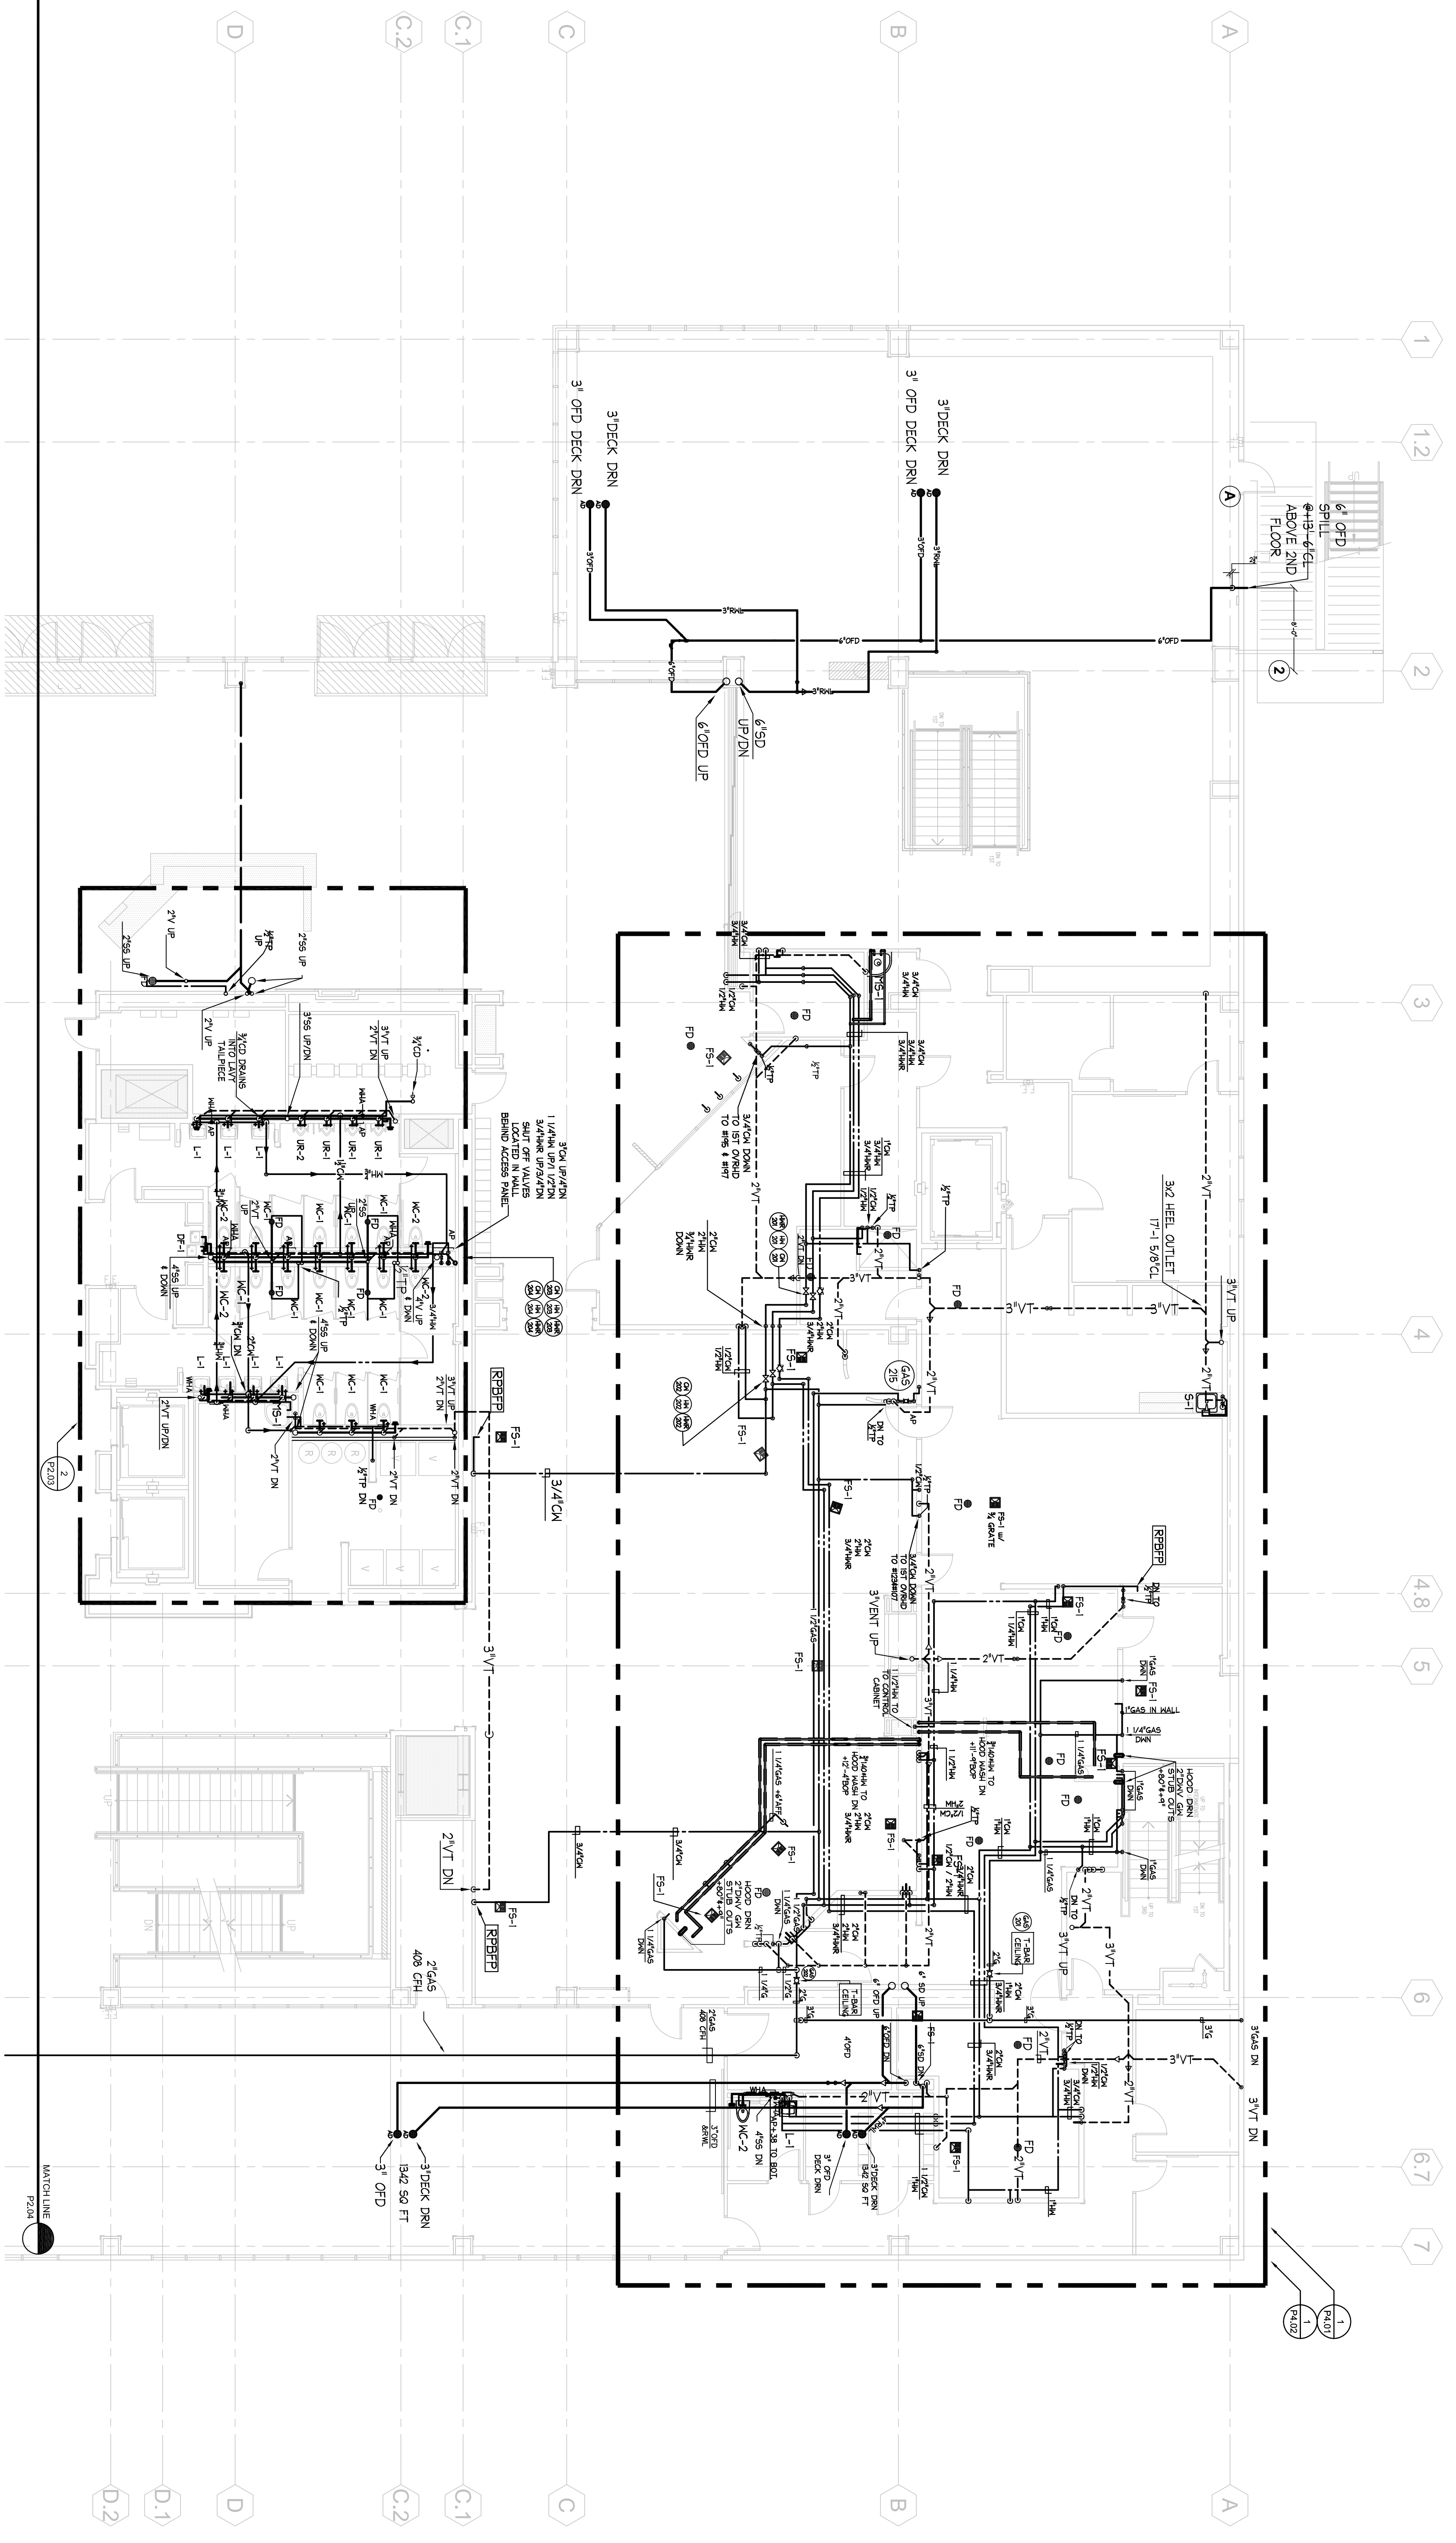



1 Plumbing Plan - Level 2 North
 P2.03 / SCALE: 1/8"=1'-0"

2 ENLARGED BATHROOM PLAN
 P2.03 / SCALE: 1/4"=1'-0"

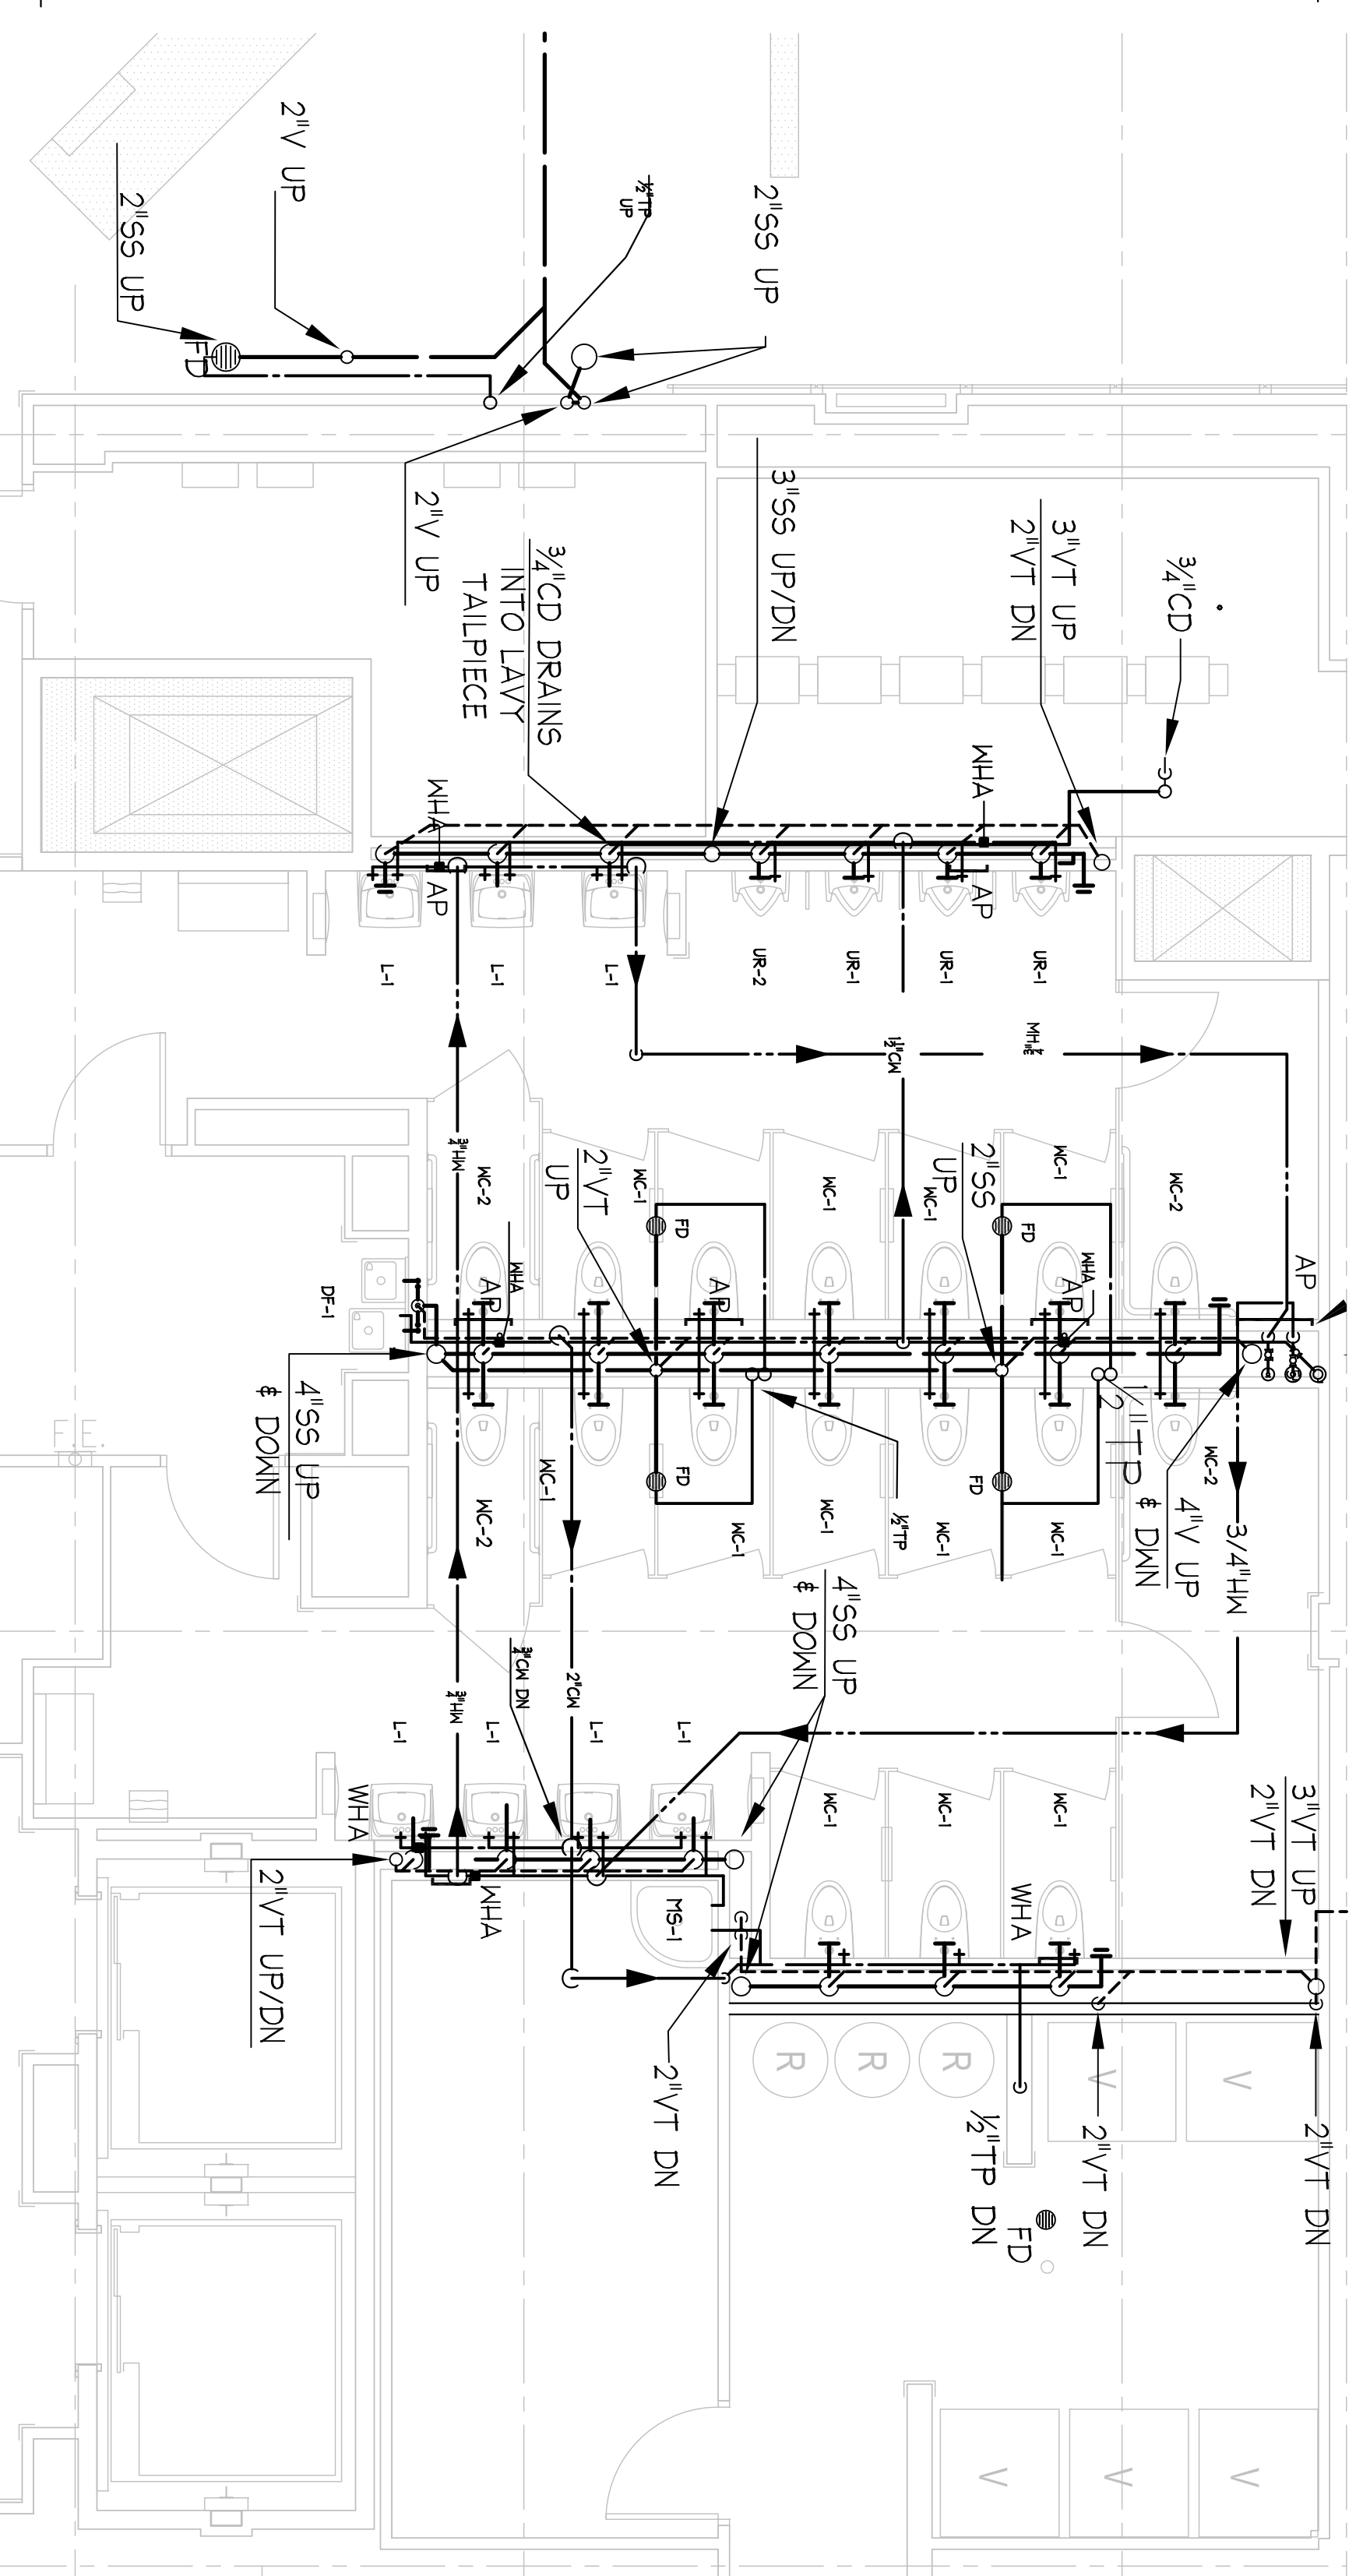

RECORD DOCUMENT
 DATE October 15, 2010

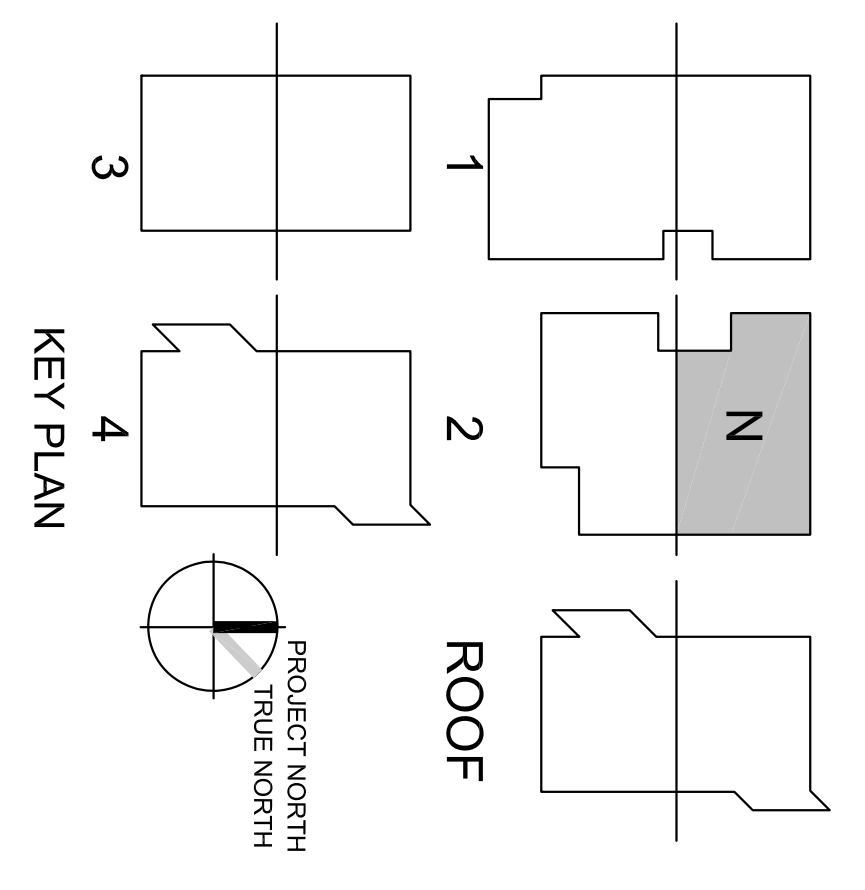


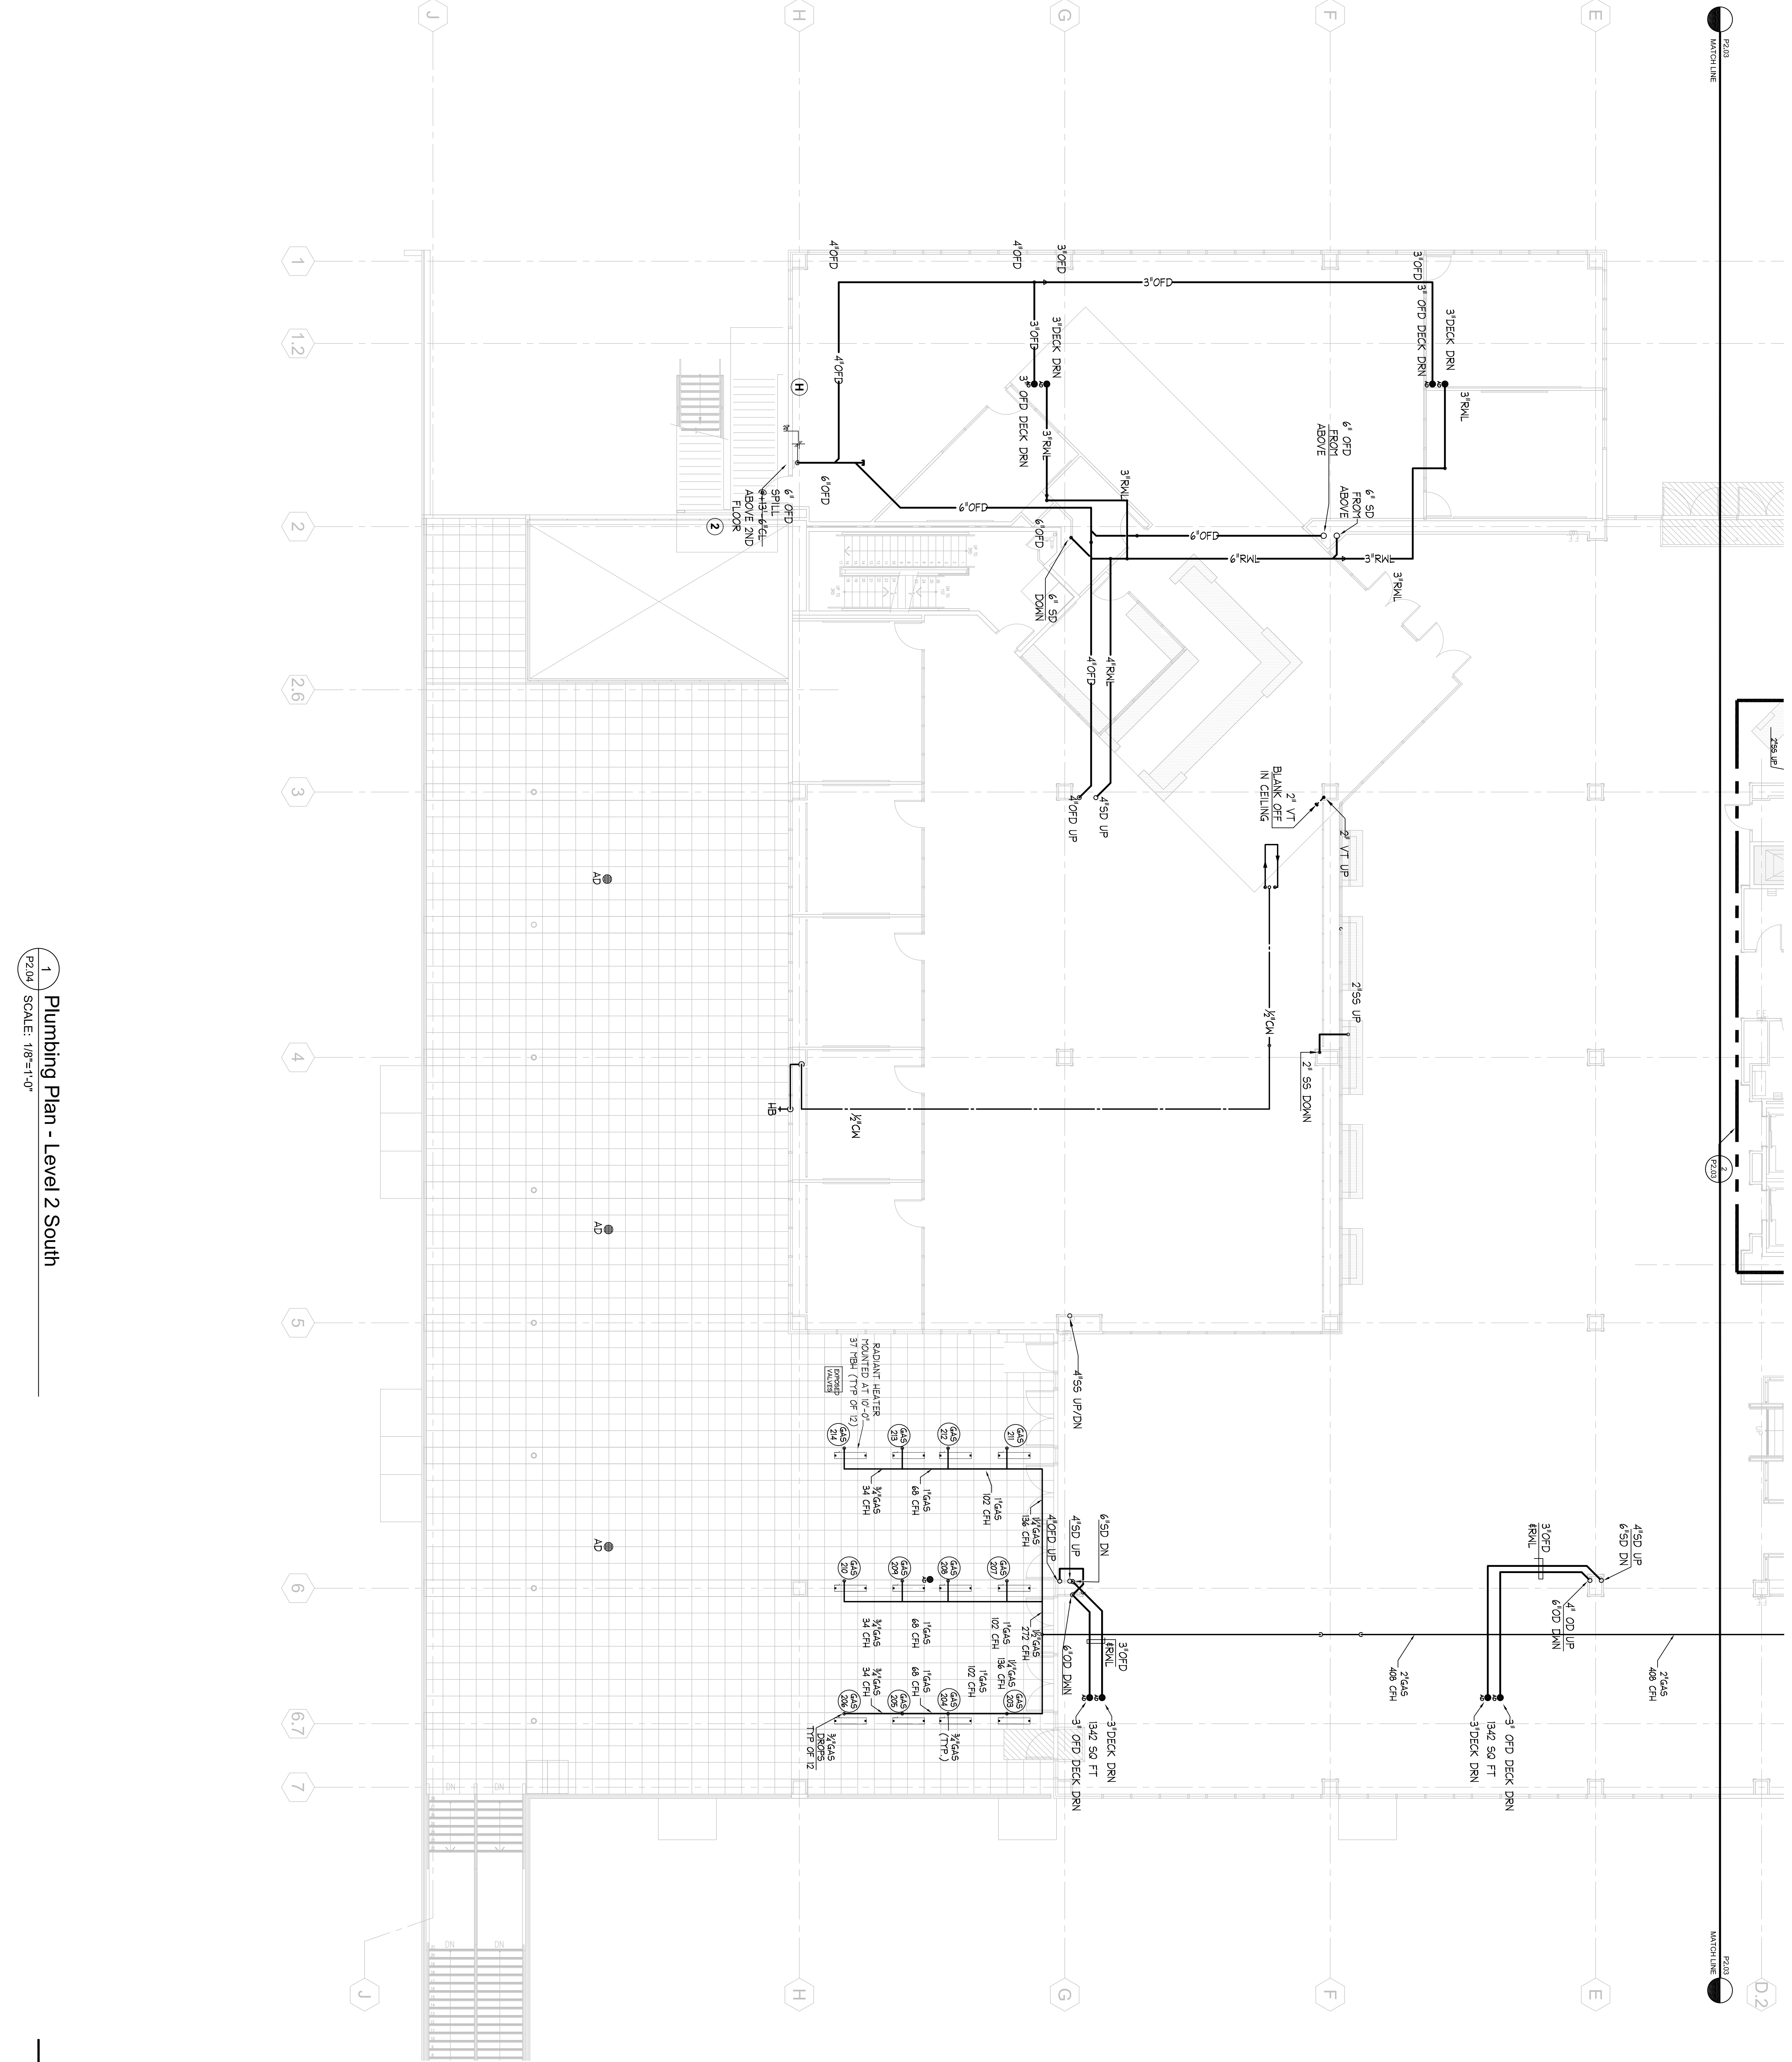

1 Plumbing Plan - Level 2 South
 P2.04 SCALE: 1/8"=1'-0"

J.W. McCLENNAHAN CO.
 2700 RAIL AVE
 SAN LUIS OBISPO, CA 94963
 TEL: (805) 345-5888
 FAX: (805) 345-5889

RECORD DOCUMENT
 DATE: October 15, 2010

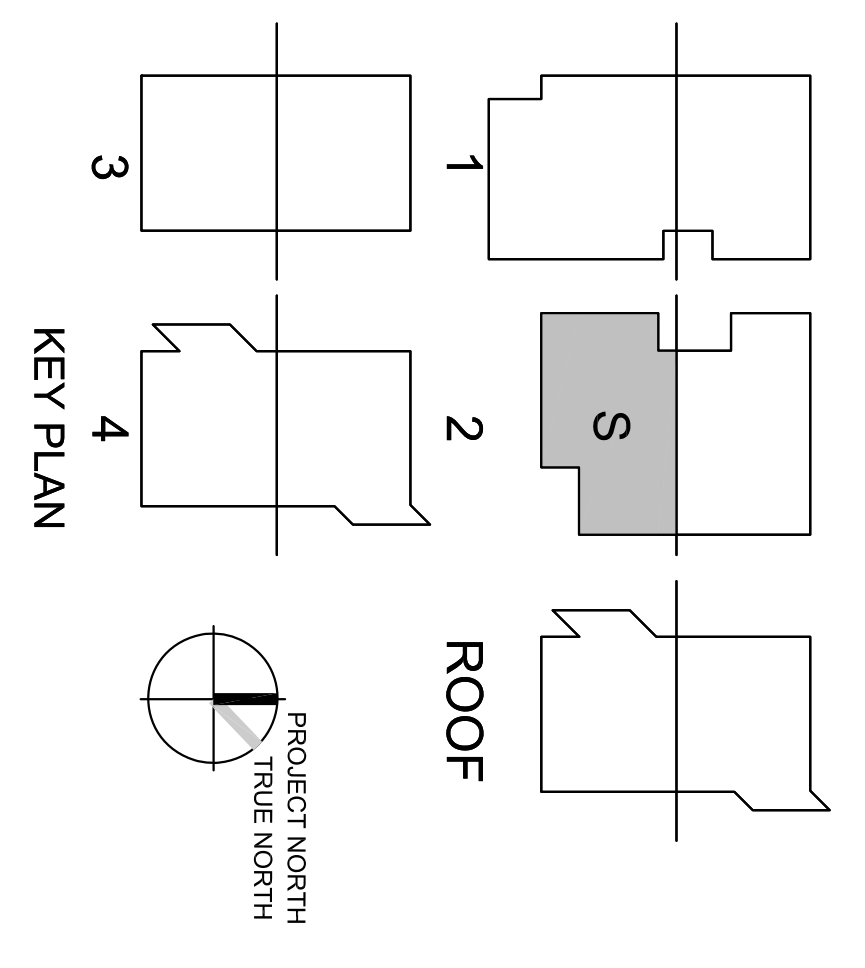


Revision Description	Date
100% Design Development	06/30/08
50% Construction Documents	07/18/08
95% Construction Documents	12/28/08
DSA Final	03/11/09

Revision Description	Date

College of San Mateo Building 10N
 San Mateo, CA
 Developed for
 San Mateo County Community College District




J.W. McCLENNAHAN CO.
 2700 RAIL AVE
 SAN LUIS OBISPO, CA 94963
 TEL: (805) 345-5888
 FAX: (805) 345-5889

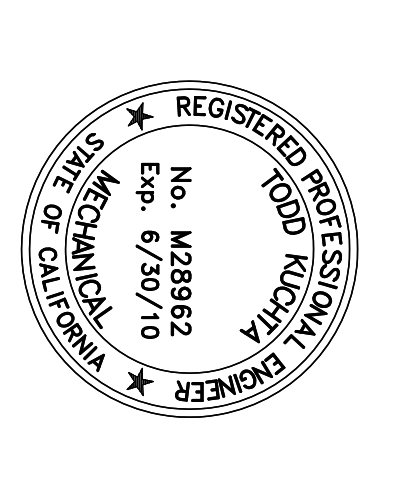


DATE	FILE NUMBER

McCarthy Building Companies, Inc.
 343 Serrano Street, 14th Floor
 San Francisco, California 94104
 P 415.397.5151
 F 415.397.5999



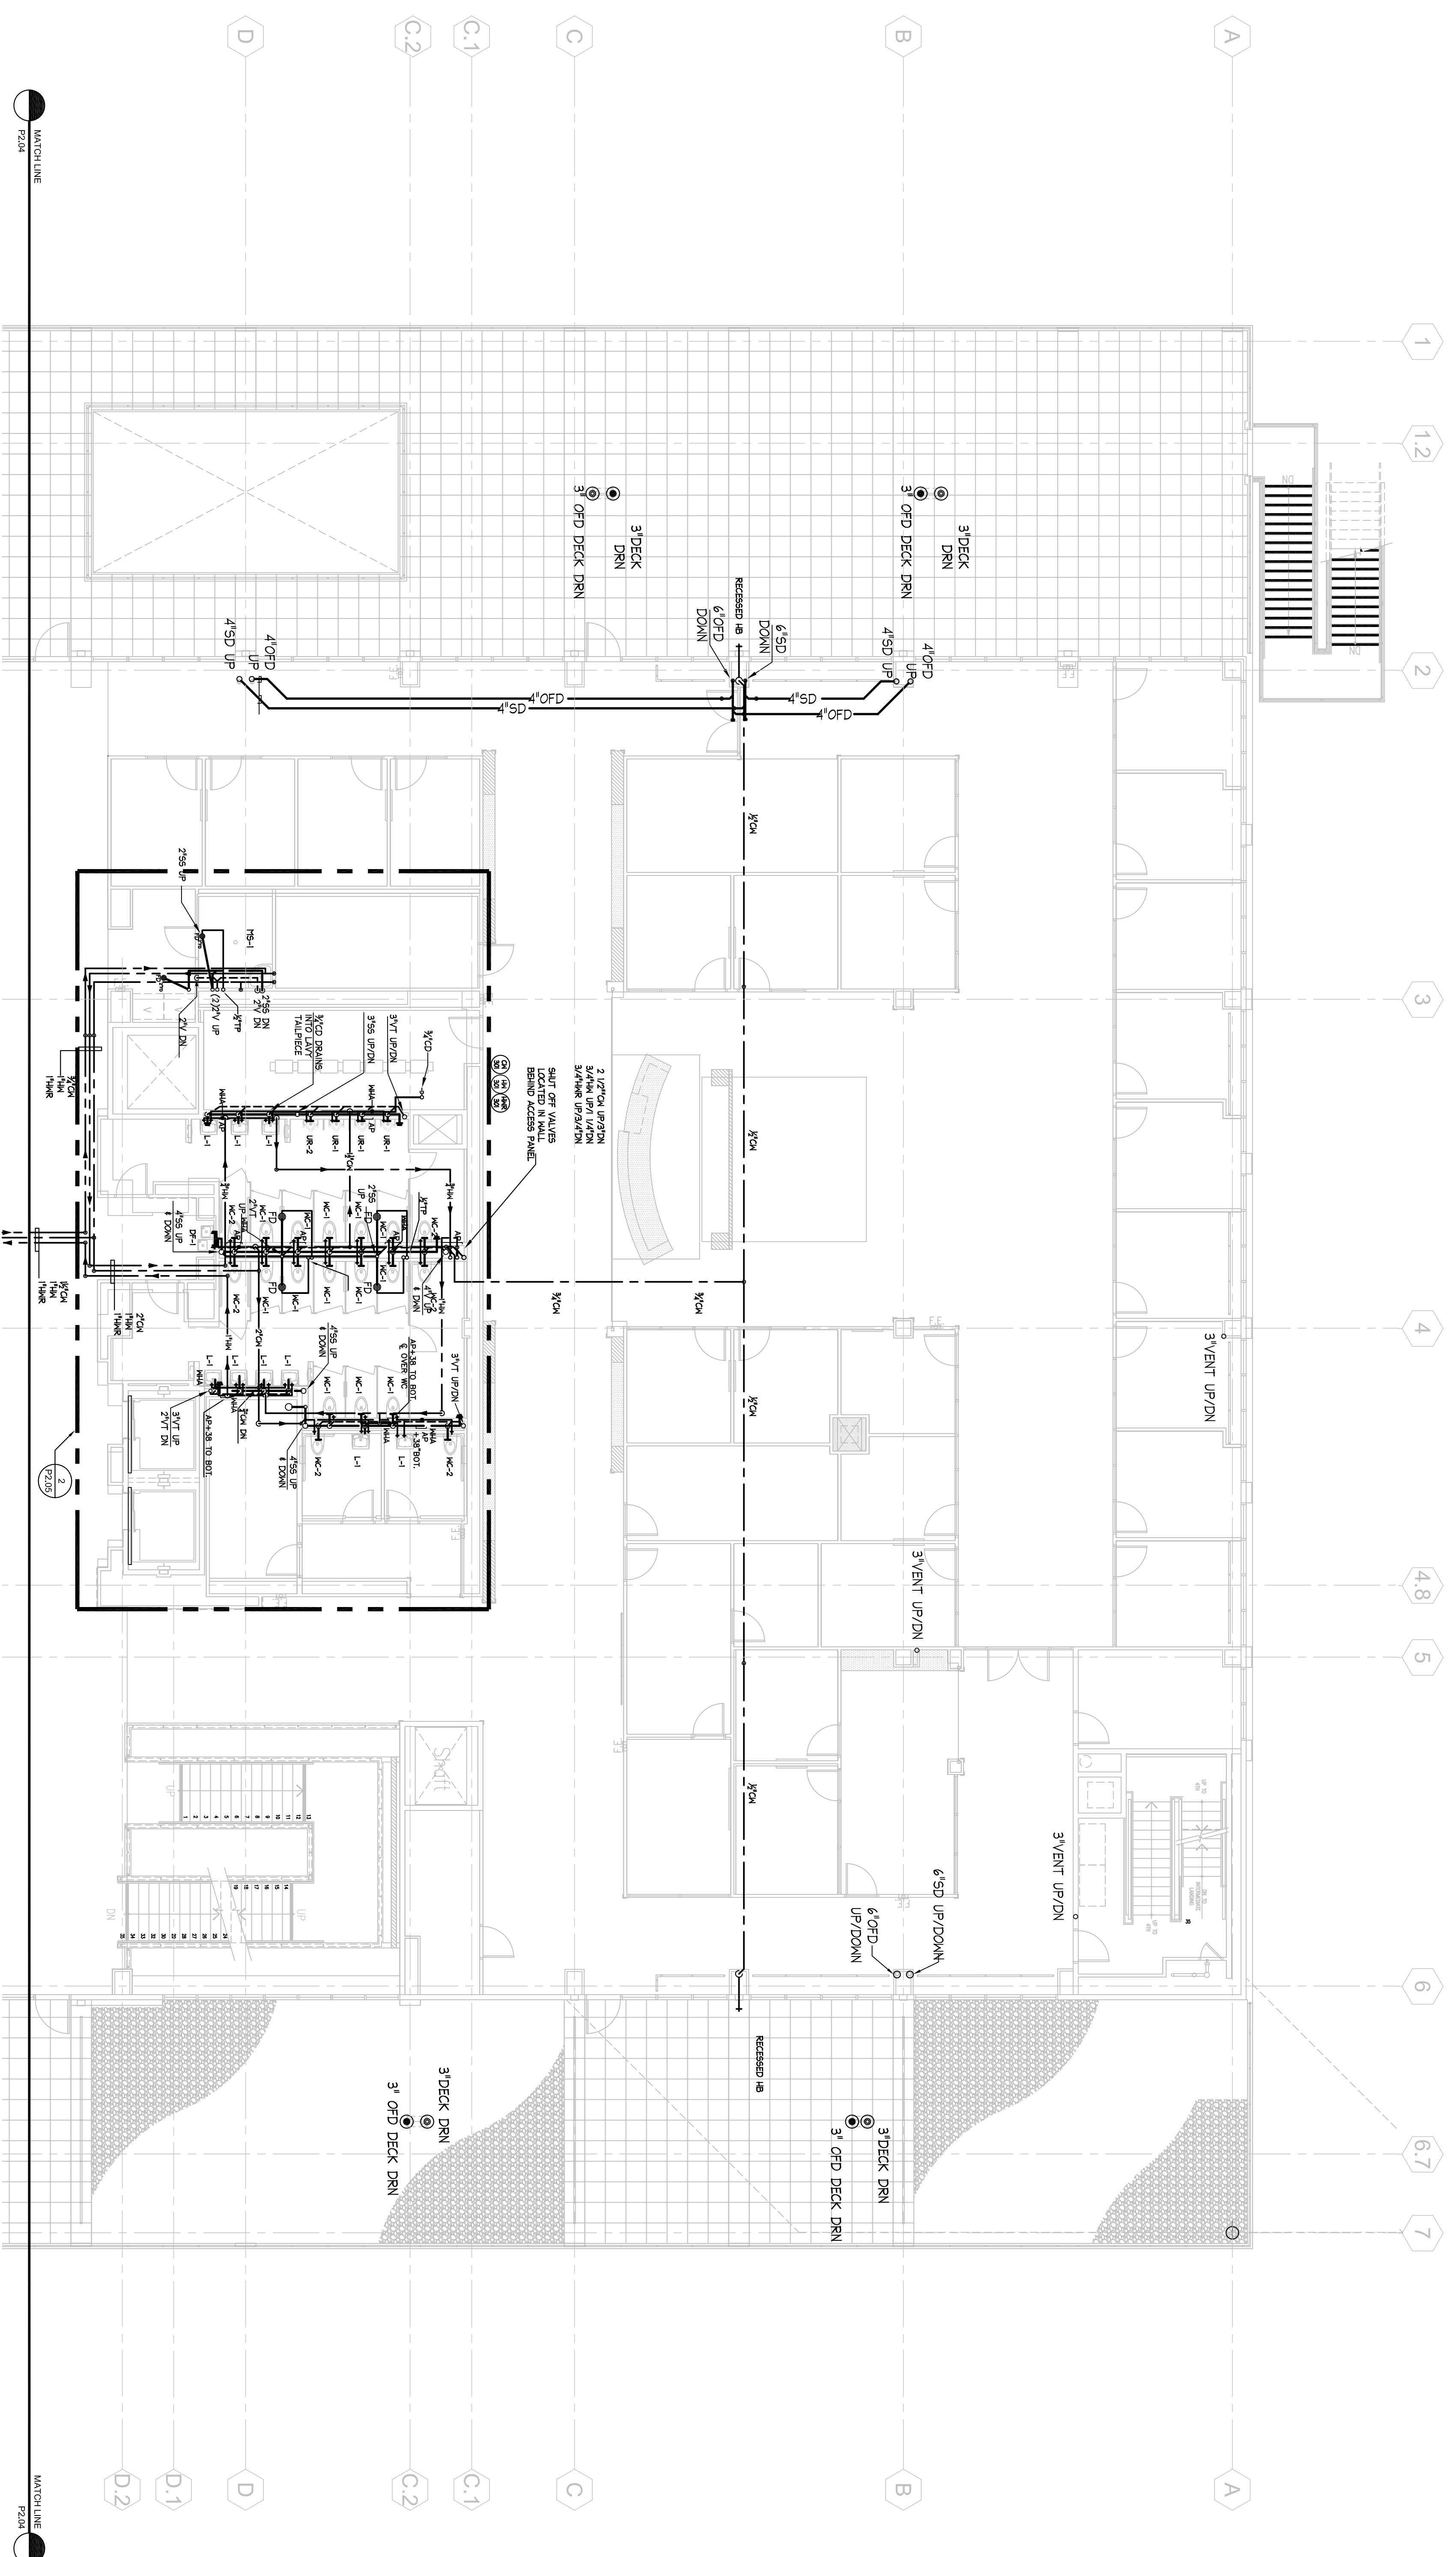


1 Plumbing Plan - Level 3 North
P2.05 SCALE: 1/8"=1'-0"

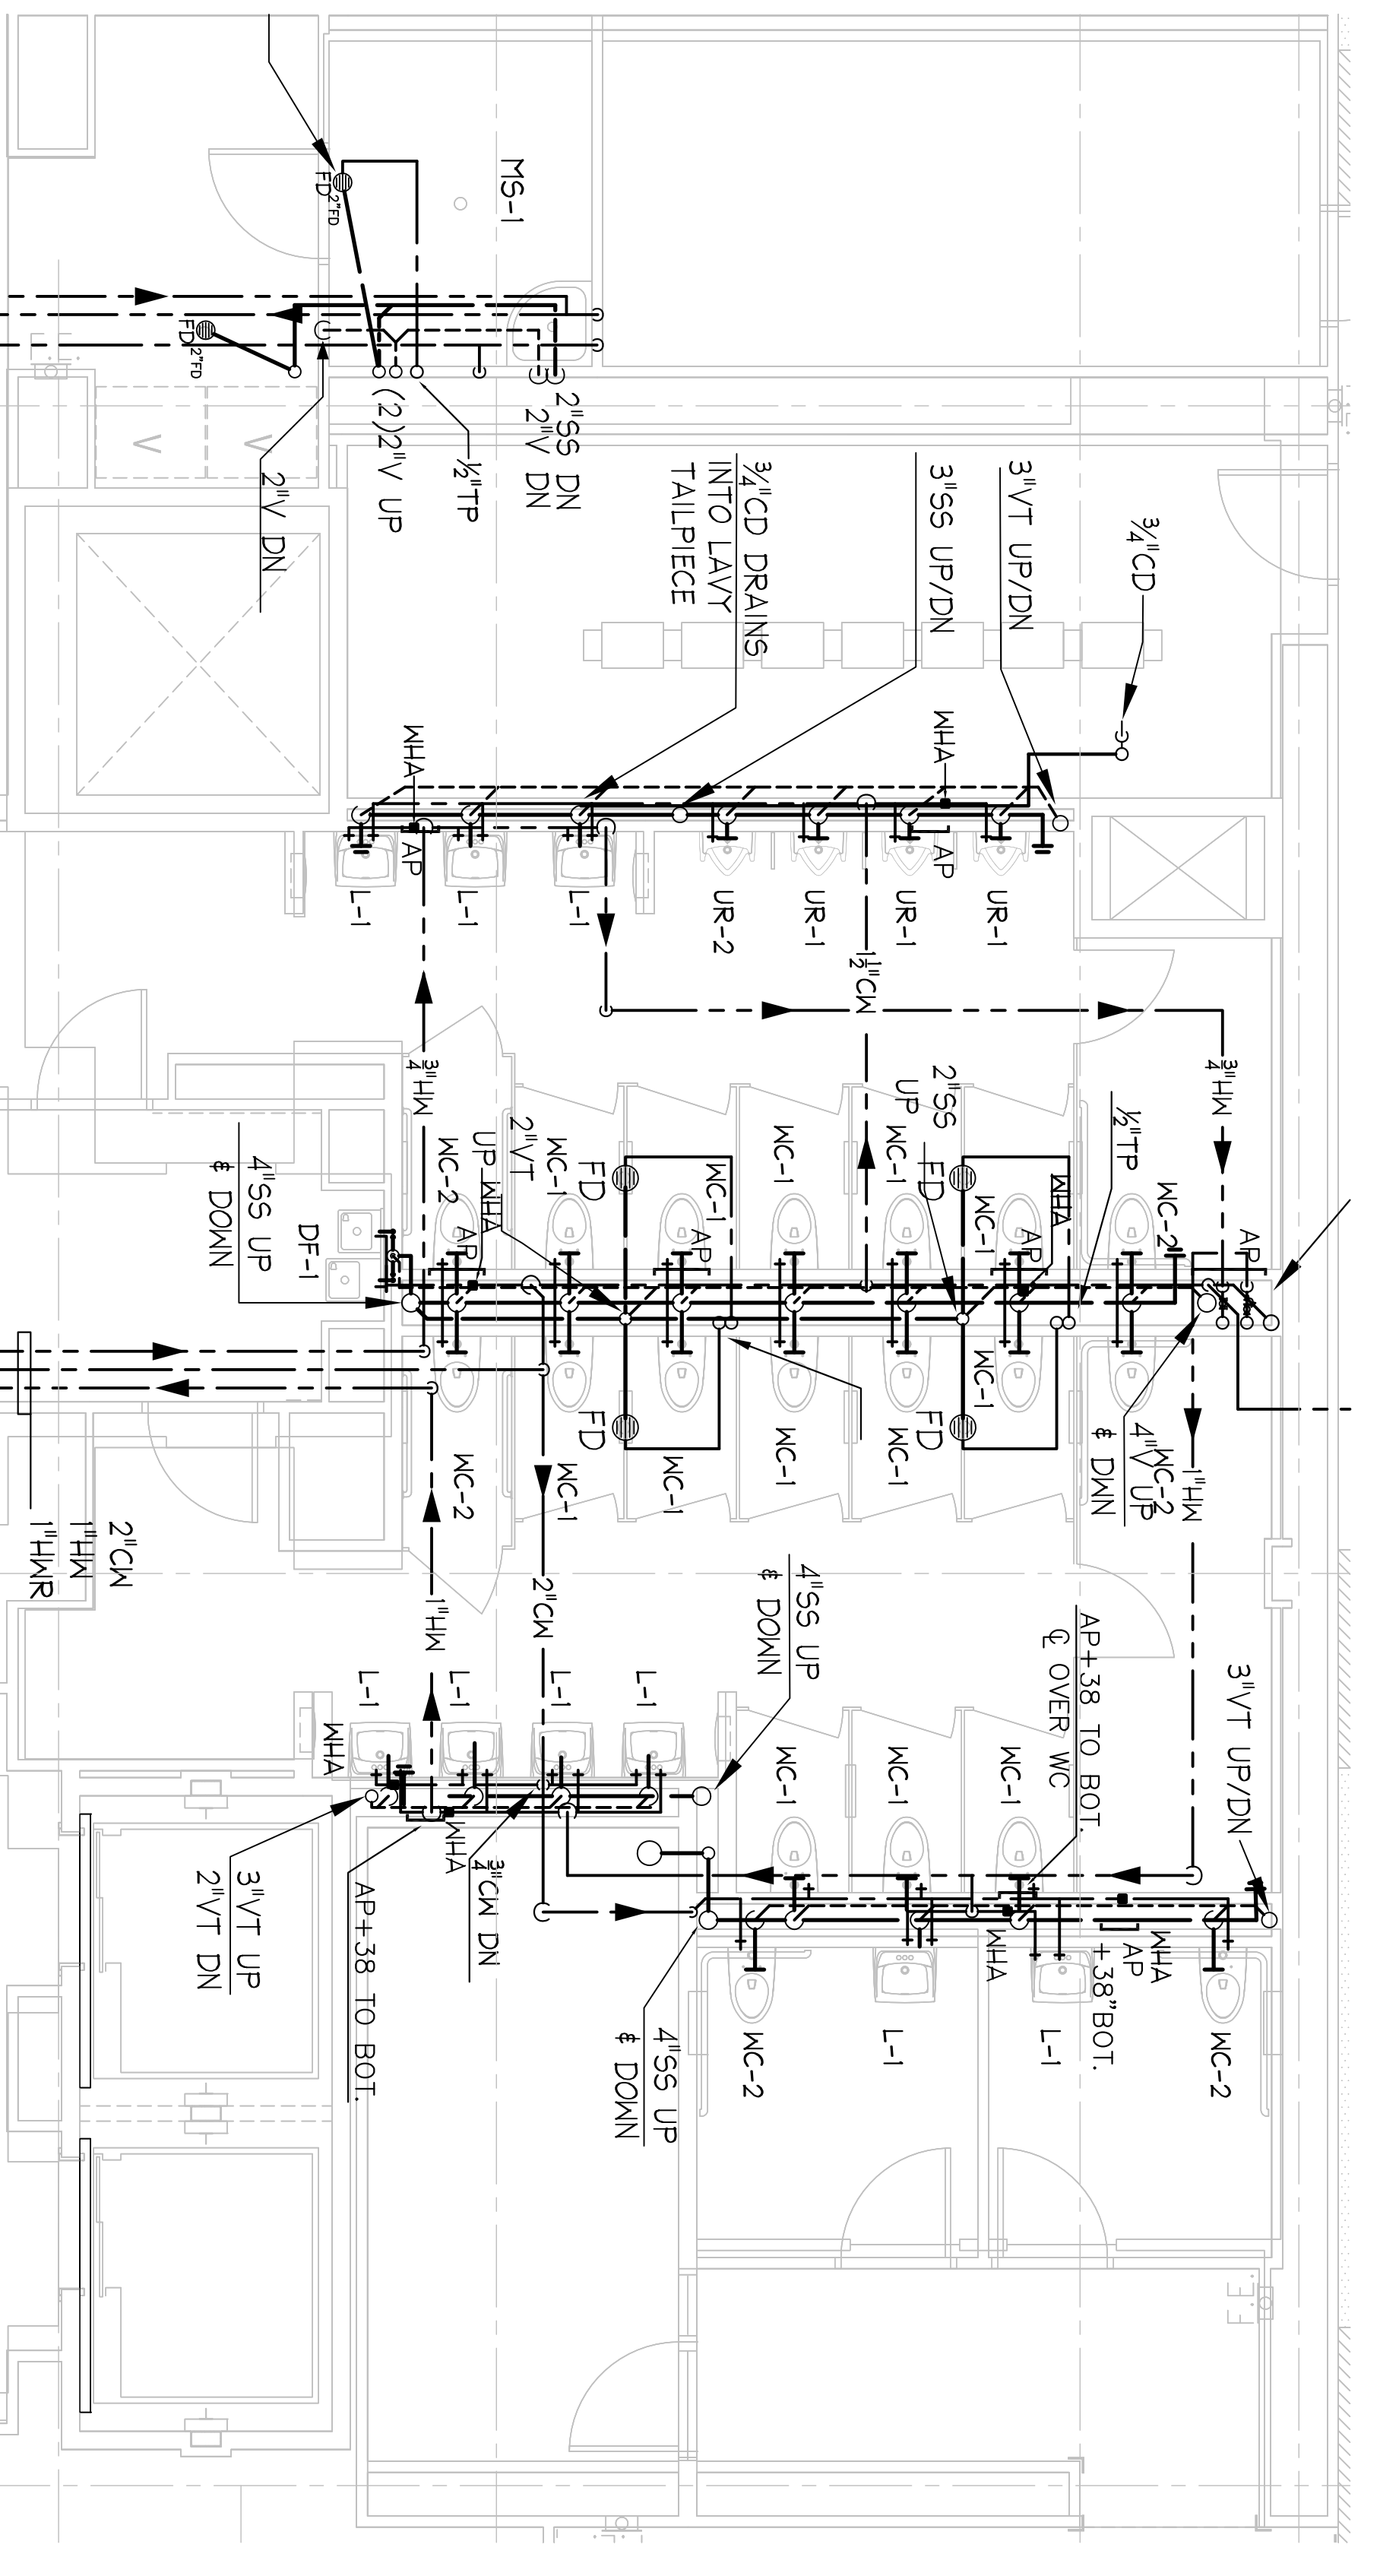

2 ENLARGED BATHROOM PLAN
P2.05 SCALE: 1/4"=1'-0"

J.W. McCLENNAHAN CO.
 2000 PAVAN DRIVE, SUITE 200
 SAN MATEO, CA 94403
 TEL: (650) 345-5888
 FAX: (650) 345-5889
 850 MARKET AVE
 SUITE 200
 SAN FRANCISCO, CA 94102
 TEL: (415) 397-5151
 FAX: (415) 397-5999

RECORD DOCUMENT
 DATE: October 15, 2010

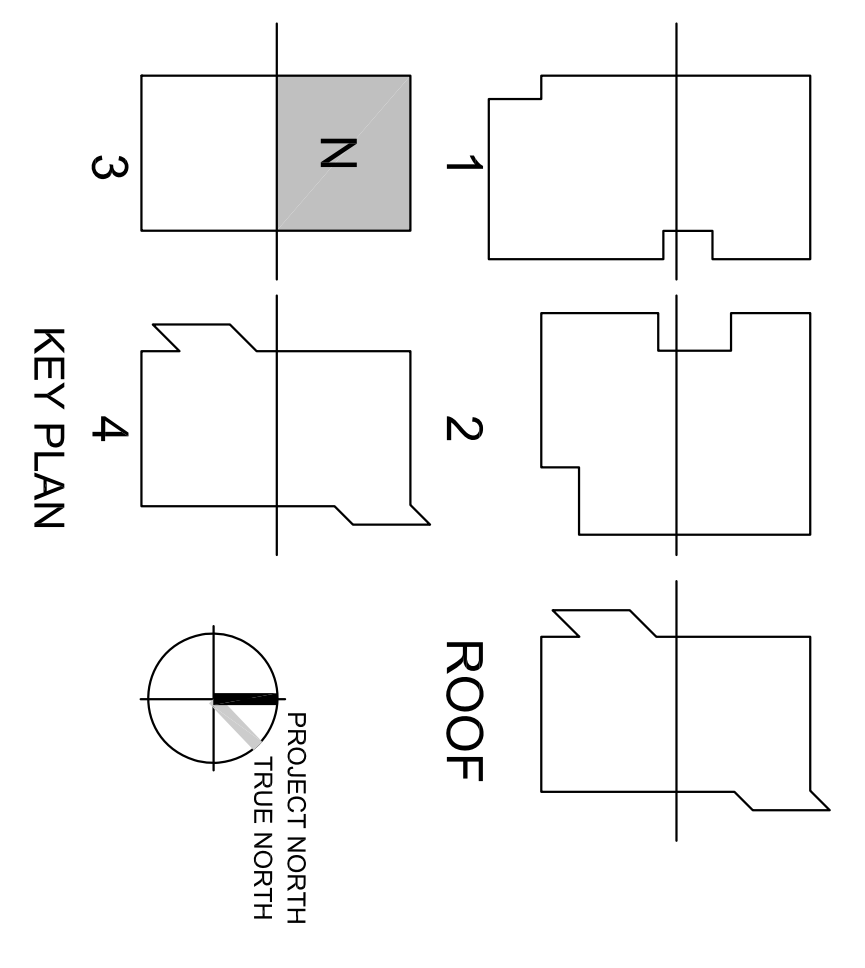

Revision	Description	Date
100%	Design Development	06/03/08
90%	Construction Documents	07/01/09
95%	Construction Documents	03/18/09
95%	Construction Documents	12/08/08
05A	Final	03/11/09


Revision	Description	Date

College of San Mateo
Building 10N

San Mateo, CA

Developed for
 San Mateo County Community College District

J.W. McCLENNAHAN CO.
 2000 PAVAN AVE
 SAN MATEO, CA 94403
 TEL: (650) 345-5888
 FAX: (650) 345-5889

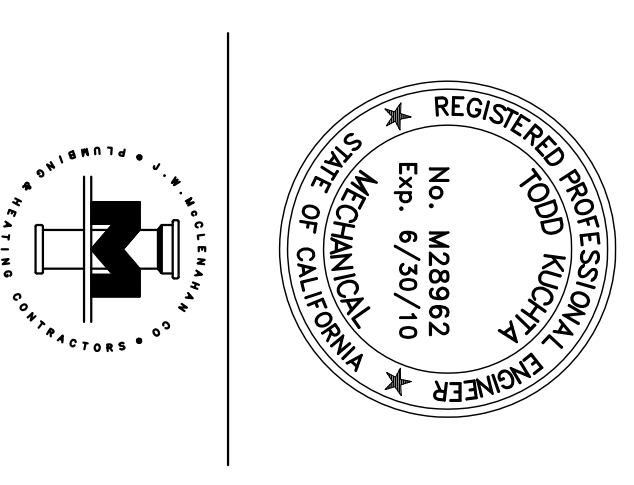


REGISTRATION STATE
 DIVISION OF THE STATE ASSISTANT
 ENGINEER OF MECHANICAL
 OFFICE OF REGISTRATION SERVICES

APPL. #: 01-110095

FILE NUMBER: 41-C1

McCarthy Building Companies, Inc.
 343 Serrano Street, 14th Floor
 San Francisco, California 94104
 P 415 397-5151
 F 415 397-5999



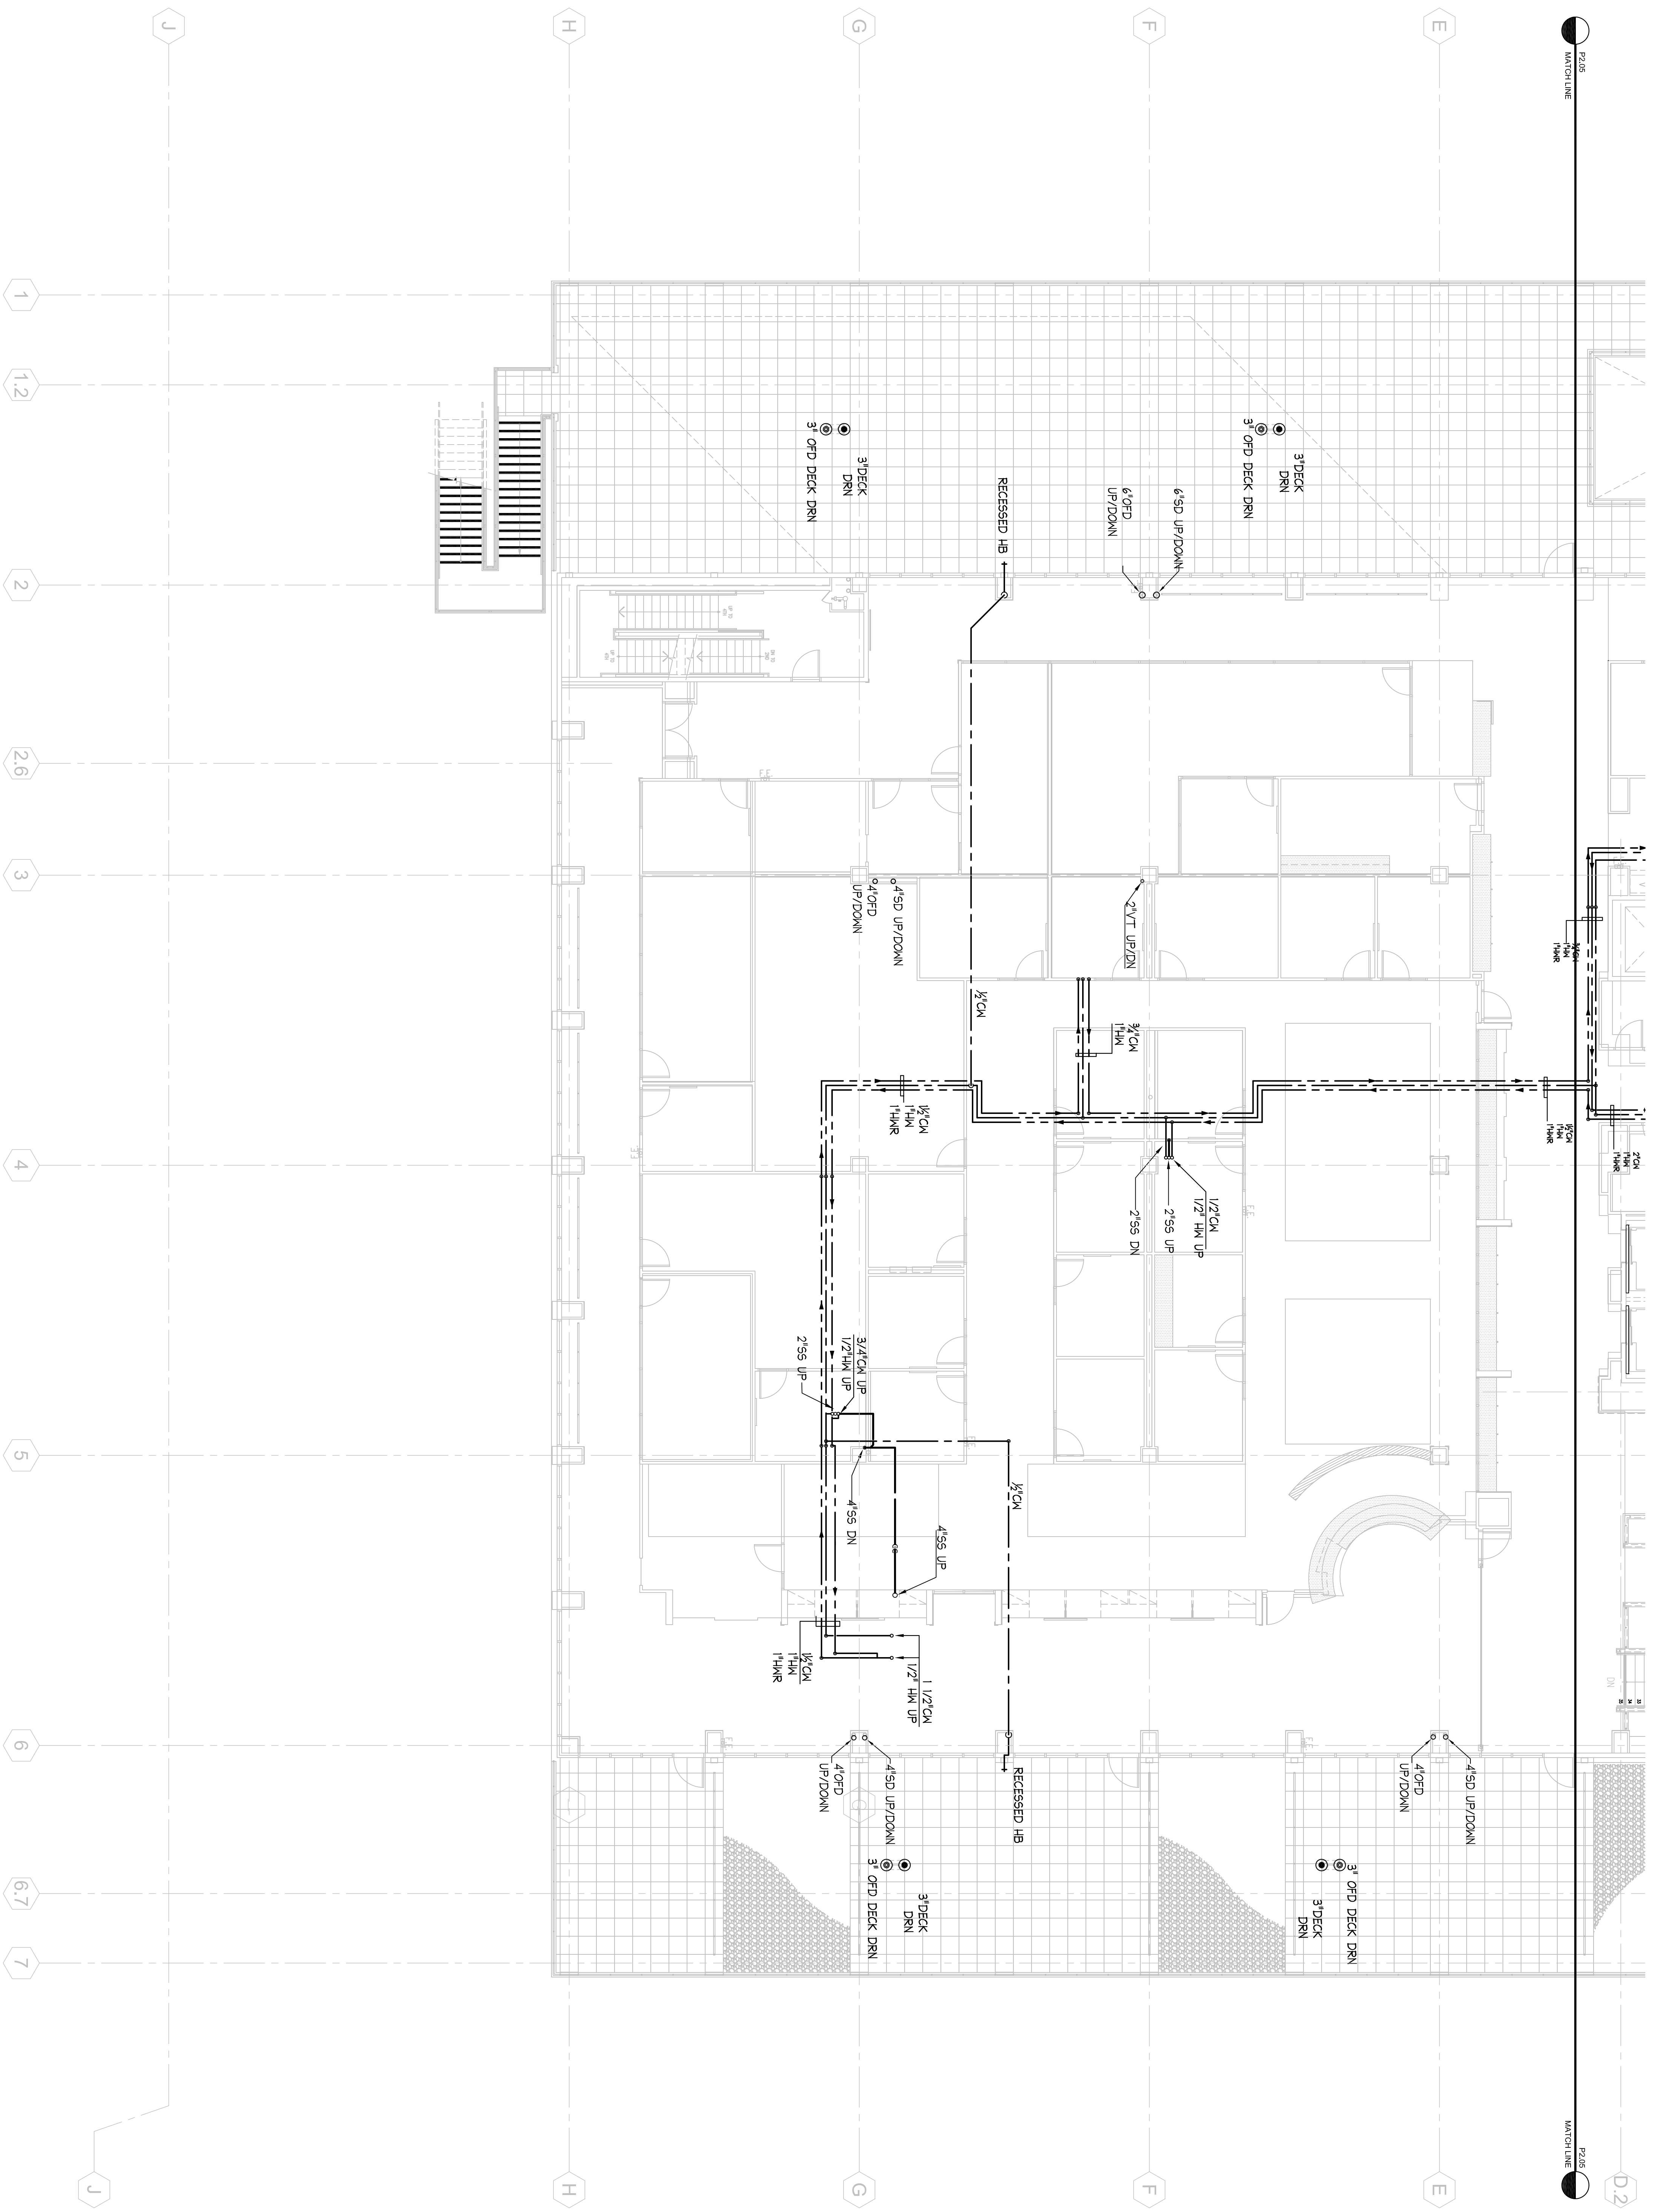

J.W. McCLENNAHAN CO.
 REGISTERED PROFESSIONAL ENGINEER
 MECHANICAL AND PLUMBING
 STATE OF CALIFORNIA
 No. M28962
 Exp. 6/30/10
 APRIL #. 01-110095
 FILE NUMBER: 41-C1

RECORD DOCUMENT
 DATE: October 15, 2010

Revision Description	Date
100% Design Development	06/01/08
50% Construction Documents	07/01/08
95% Construction Documents	08/18/08
95% Construction Documents	12/08/08
DSA Final	03/11/09


College of San Mateo Building 10N
 San Mateo, CA
 Developed for
 San Mateo County Community College District

J.W. McCLENNAHAN CO.
 2001 RIAL AVE
 SAN MATEO, CA 94403
 TEL: (650) 345-5888
 FAX: (650) 345-5889

McCarthy Building Companies, Inc.
 343 Serrano Street, 14th Floor
 San Francisco, California 94104
 P 415 397-5151
 F 415 397-5999




1 Plumbing Plan - Level 3 South
 P2.06 SCALE: 1/8"=1'-0"

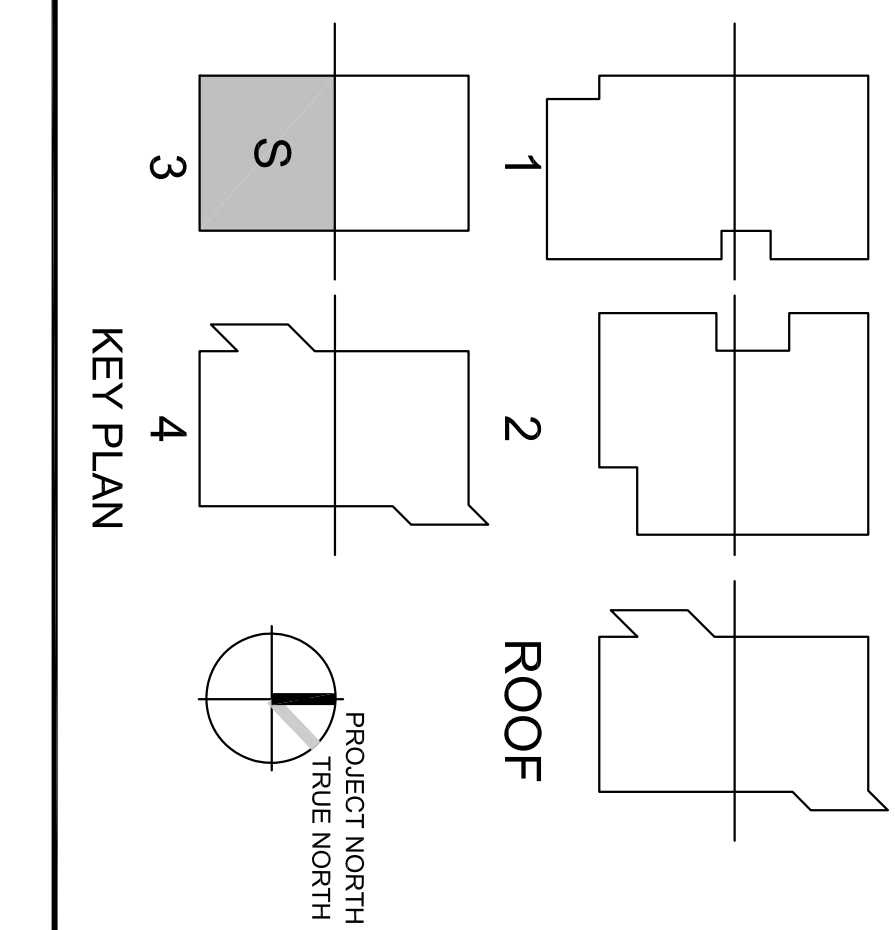

PLUMBING PLAN THIRD FLOOR (S)
 P2.06



1 Plumbing Plan - Level 4 North
P2.07 SCALE: 1/8"=1'-0"

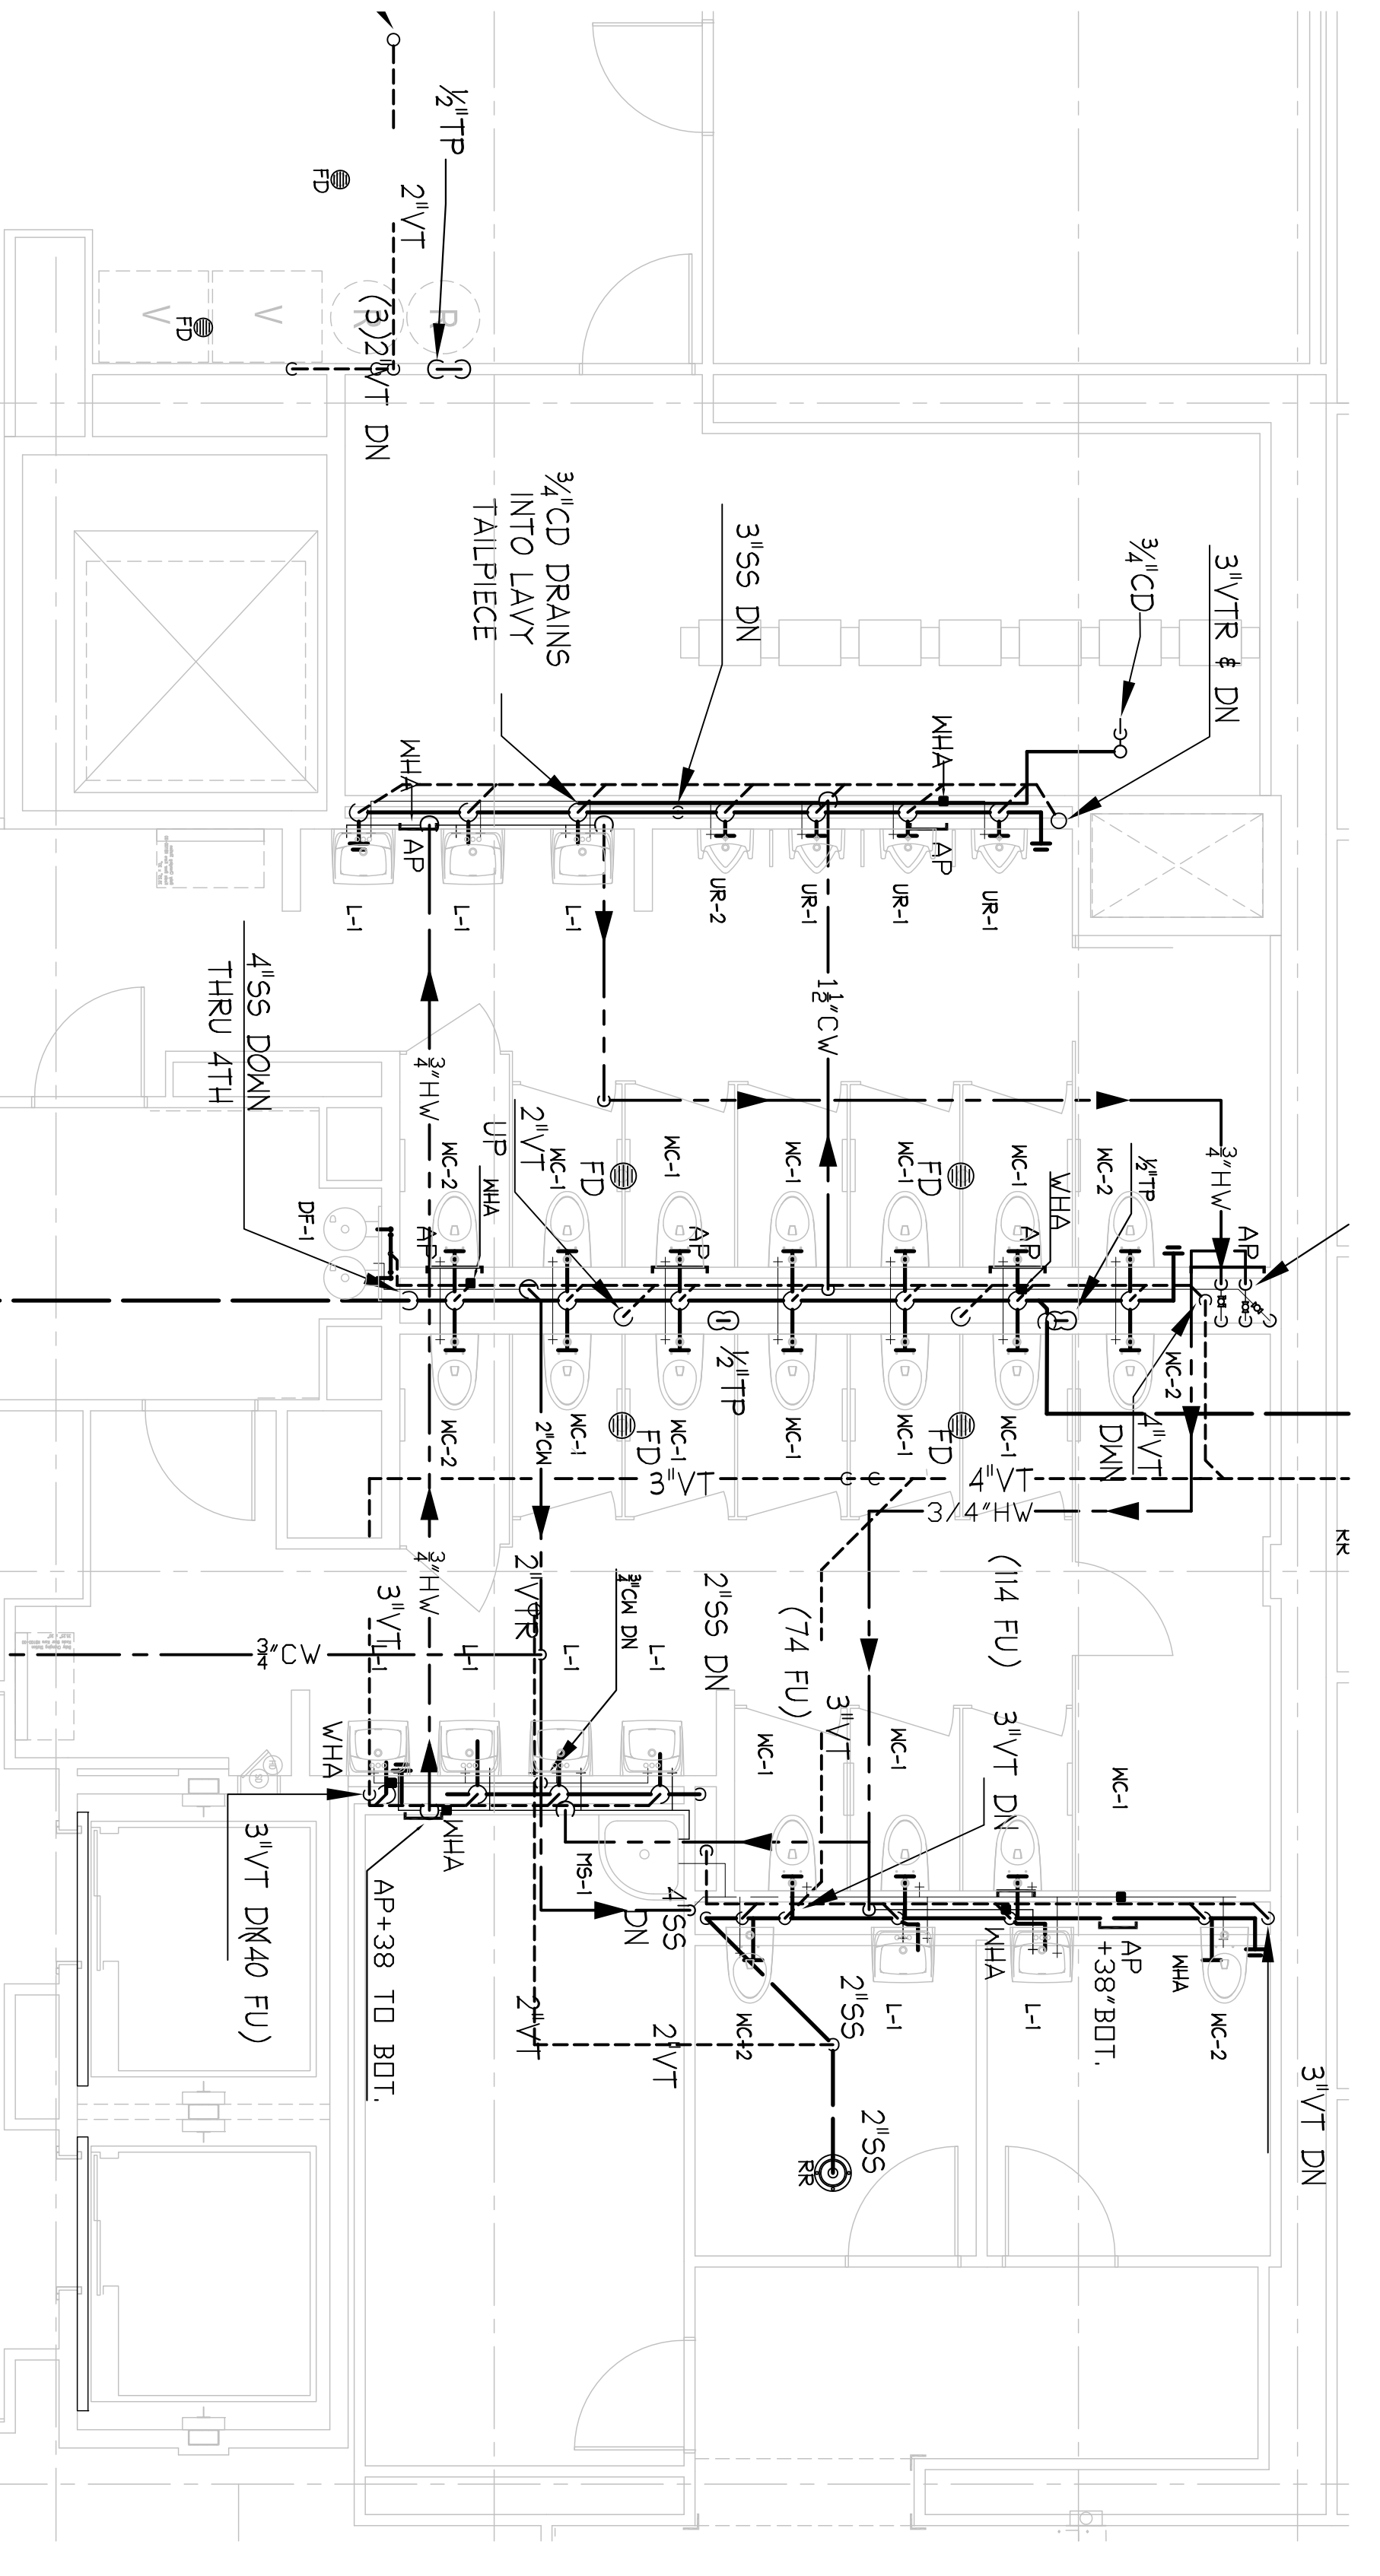


2 ENLARGED BATHROOM PLAN
P2.07 SCALE: 1/4"=1'-0"

J.W. McCLENNAHAN CO.


RECORD DOCUMENT
 DATE: October 15, 2010

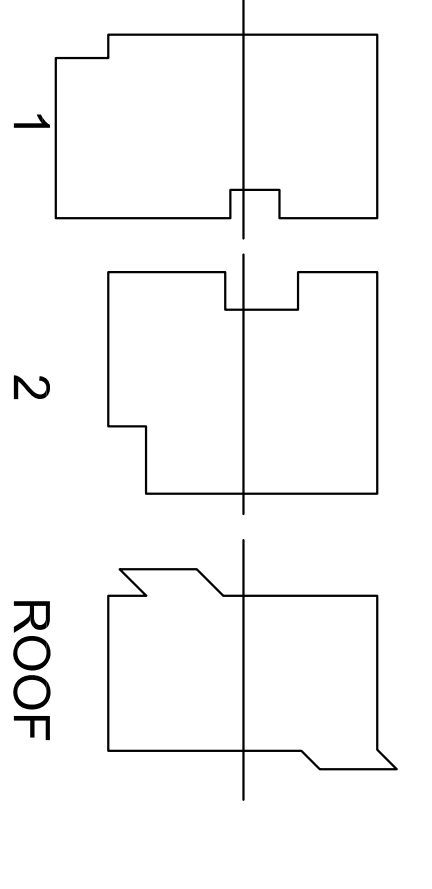

ROOF
PROJECT NORTH
TRUE NORTH

Revision	Description	Date

Revision	Description	Date

College of San Mateo
Building 10N

San Mateo, CA

Developed for
 San Mateo County Community College District


J.W. McCLENNAHAN CO.



 STATE OF CALIFORNIA
 MECHANICAL ENGINEERING
 No. M28962
 Exp. 6/30/10
 APRIL # 01-10095
 FILE NUMBER: 41-C1

McCarthy Building Companies, Inc.
 343 Serrano Street, 14th Floor
 San Francisco, California 94104
 P 415 397-5151
 F 415 397-5999



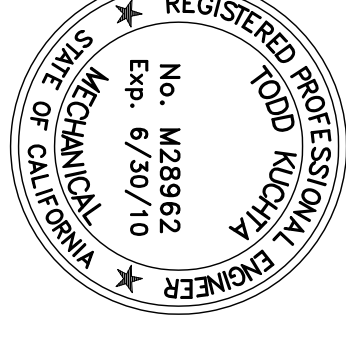

J.W. McCLELLANHAN CO.



College of San Mateo
Building 10N

San Mateo, CA

Developed for
San Mateo County Community College District


Revision	Description	Date

Revision	Description	Date

2008/2/21

PLUMBING PLAN
ROOF (N)

P2.09

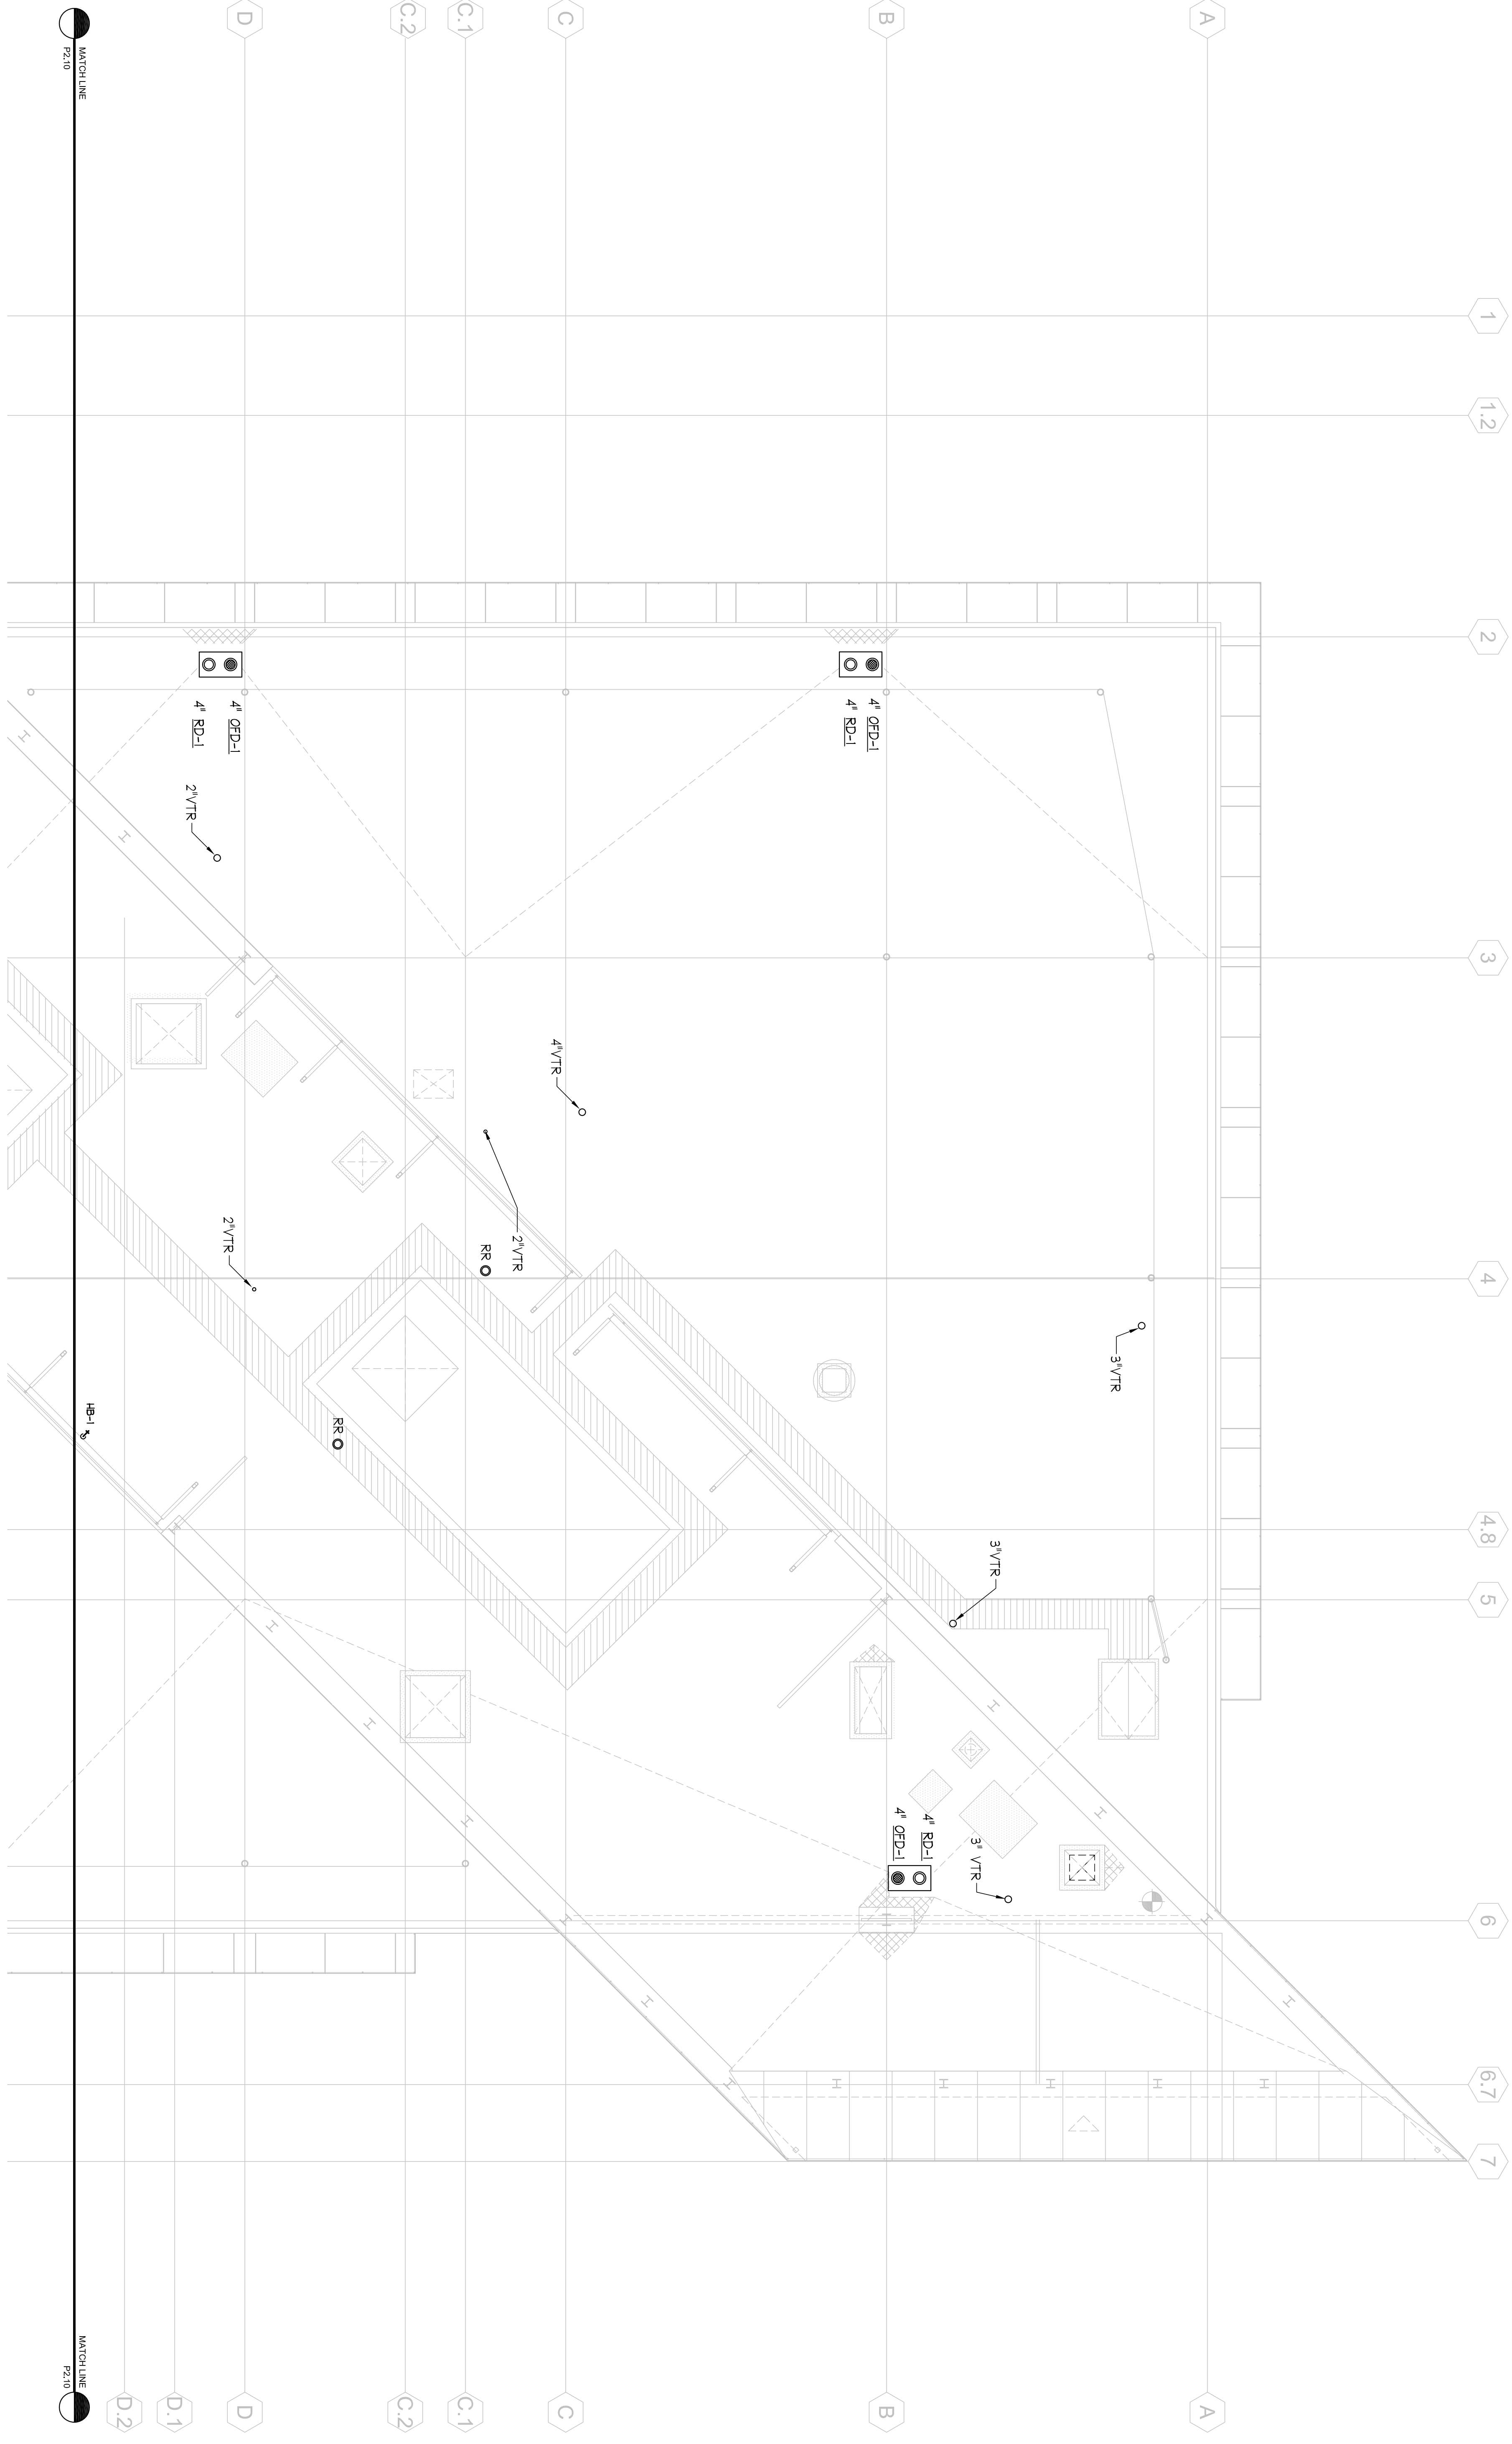


1 Plumbing Plan - Roof Level North
SCALE: 1/8"=1'-0"

J.W. McCLELLANHAN CO.
2001 PALM AVE
SAN LUIS OBISPO, CA 94943
TEL (805) 345-5888
FAX (805) 345-5888

890 AMBETTA WAY
SAN FRANCISCO, CA 94108
TEL (415) 397-5151
FAX (415) 397-5999

DATE October 15, 2010

RECORD DOCUMENT

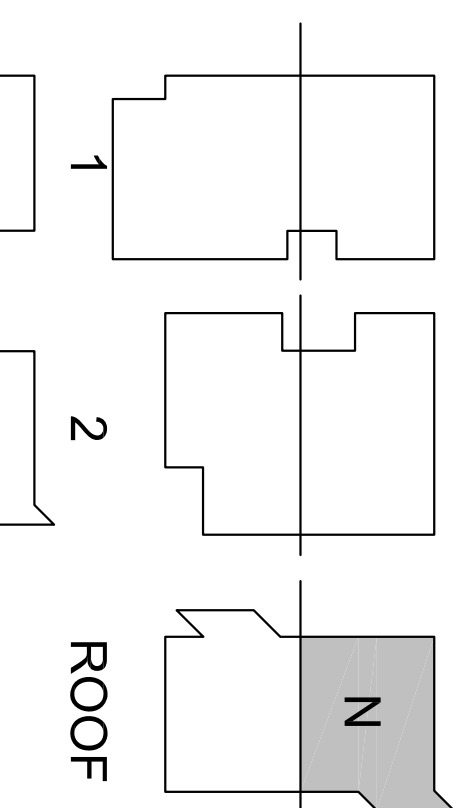


KEY PLAN

2008/2/21

PLUMBING PLAN
ROOF (N)

P2.09

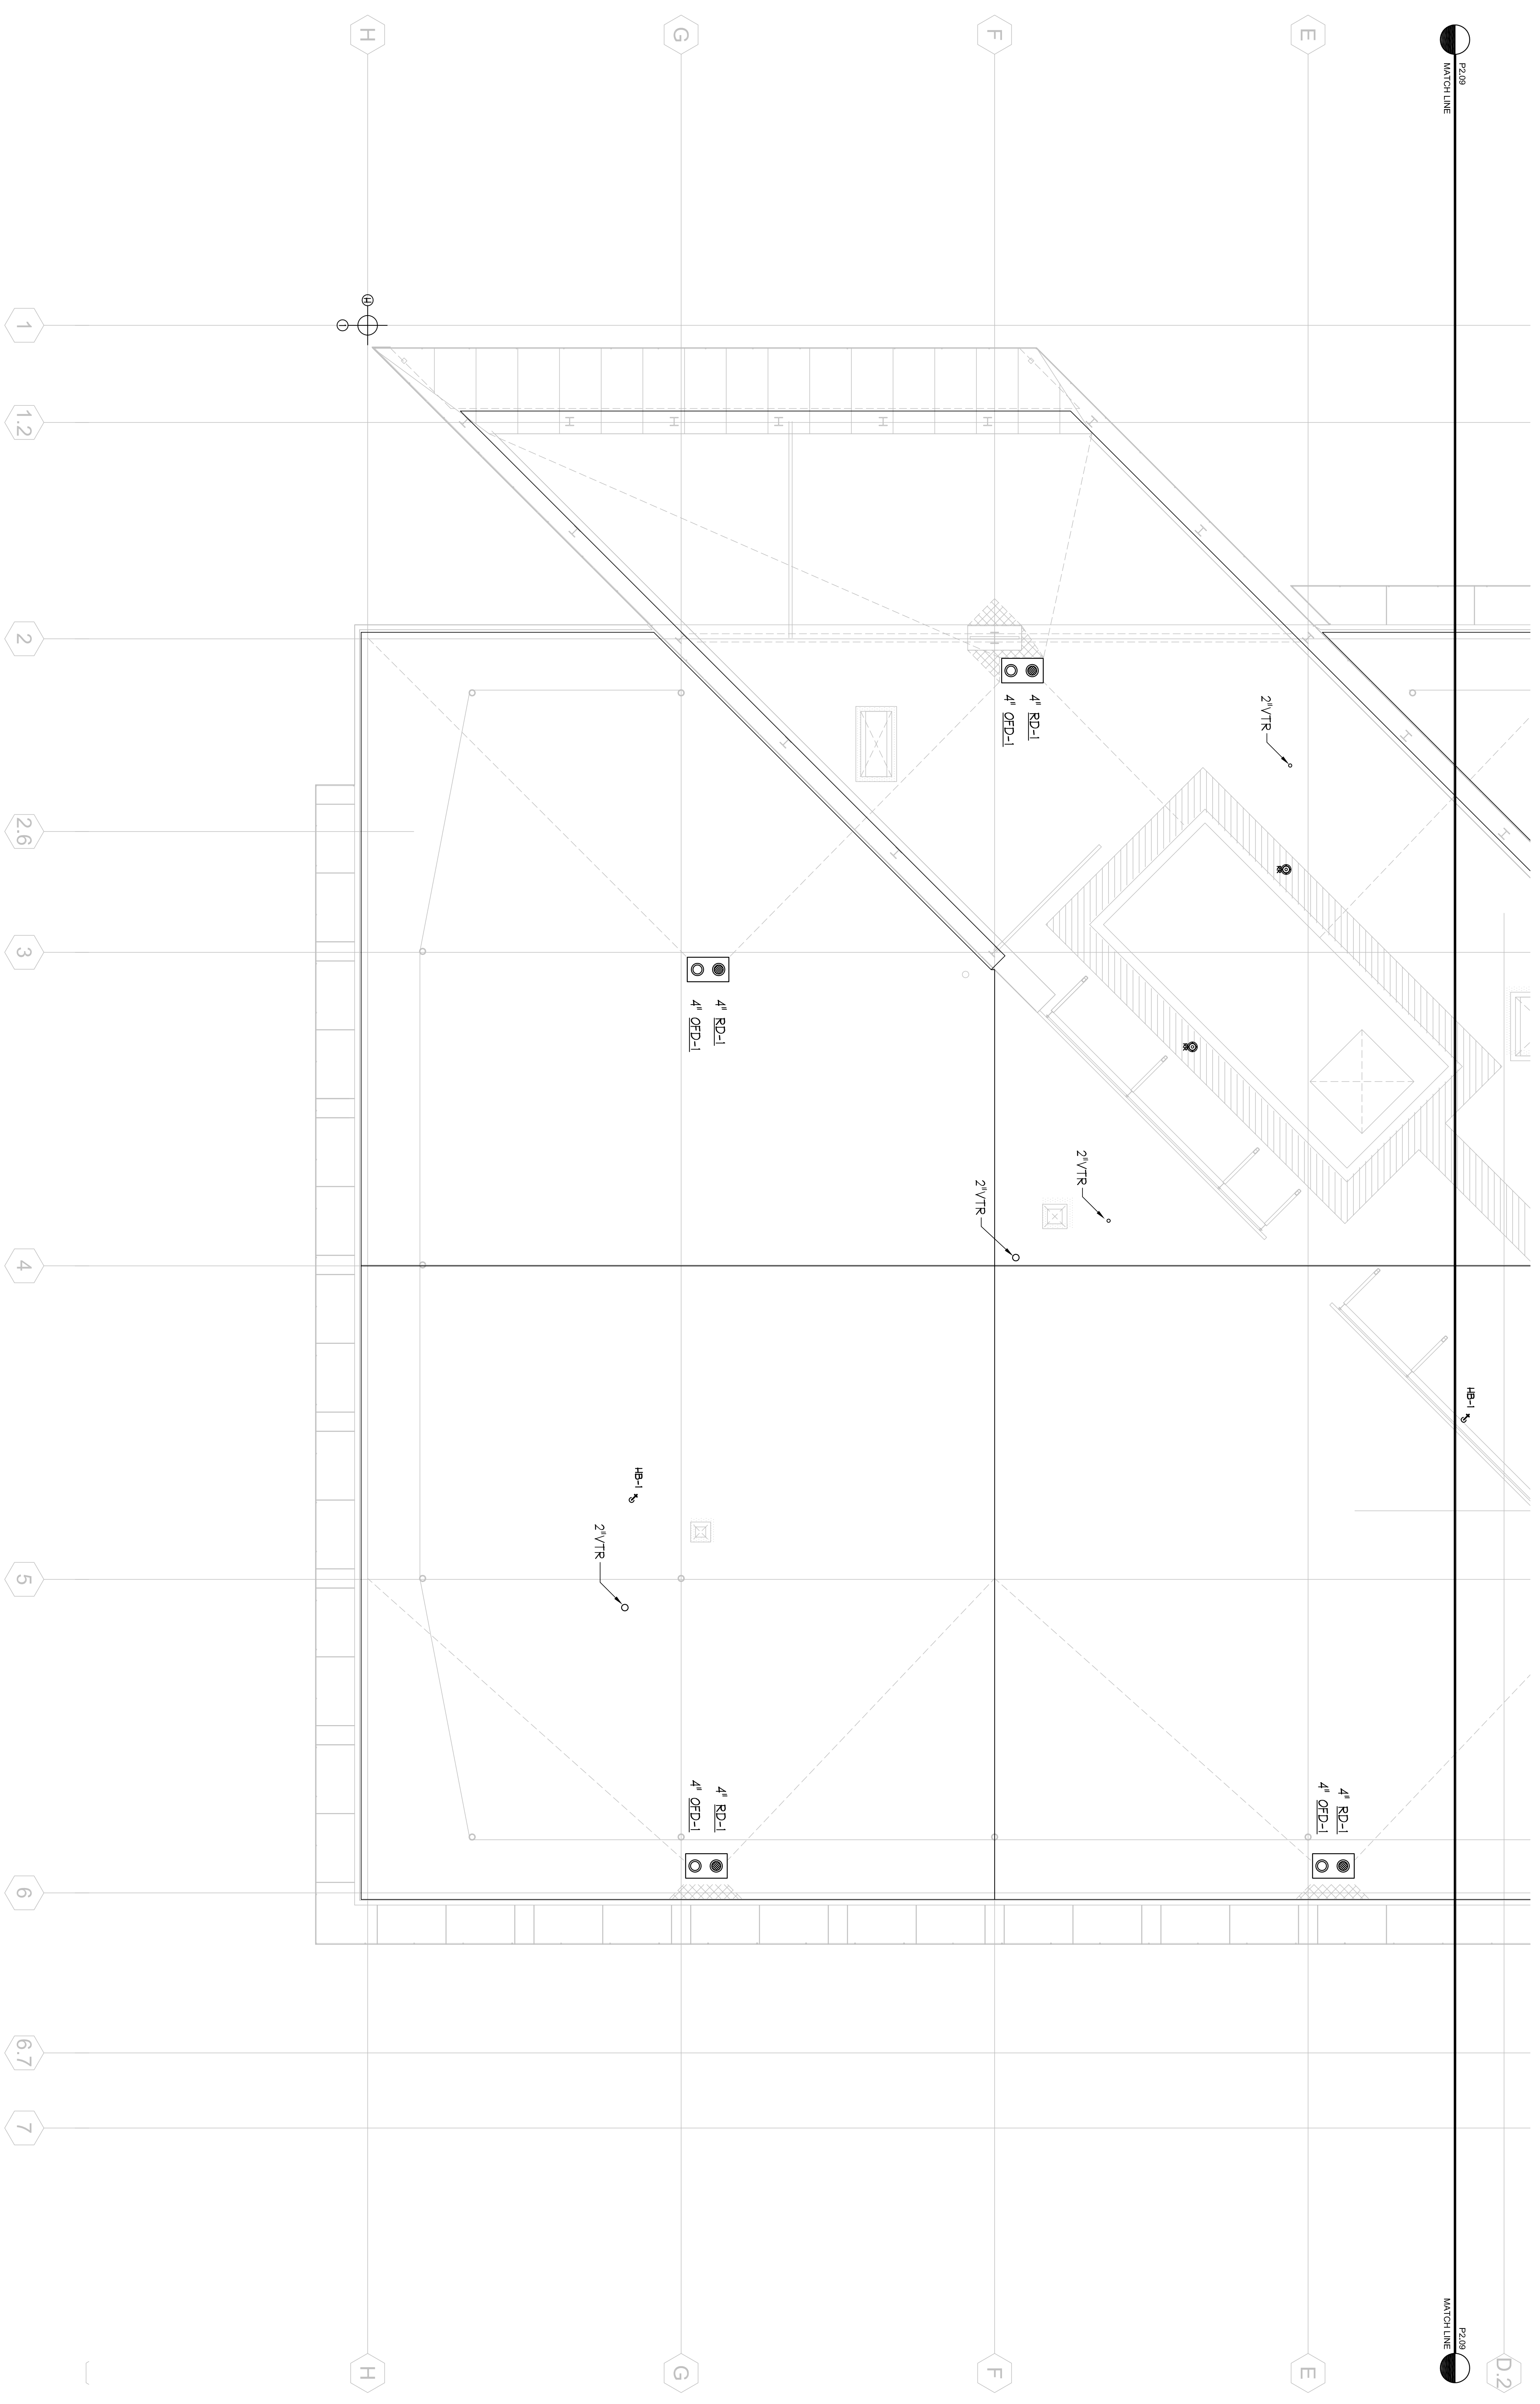


1 Plumbing Plan - Roof Level South
 P2.10 SCALE: 1/8"=1'-0"

J.W. McCLENNAHAN CO.
 2001 RAIL AVE
 SAN LUIS OBISPO, CA 94963
 TEL: (805) 345-5888
 FAX: (805) 345-5889

J.W. McCLENNAHAN CO.
 2001 RAIL AVE
 SAN LUIS OBISPO, CA 94963
 TEL: (805) 345-5888
 FAX: (805) 345-5889

RECORD DOCUMENT
 DATE: October 15, 2010

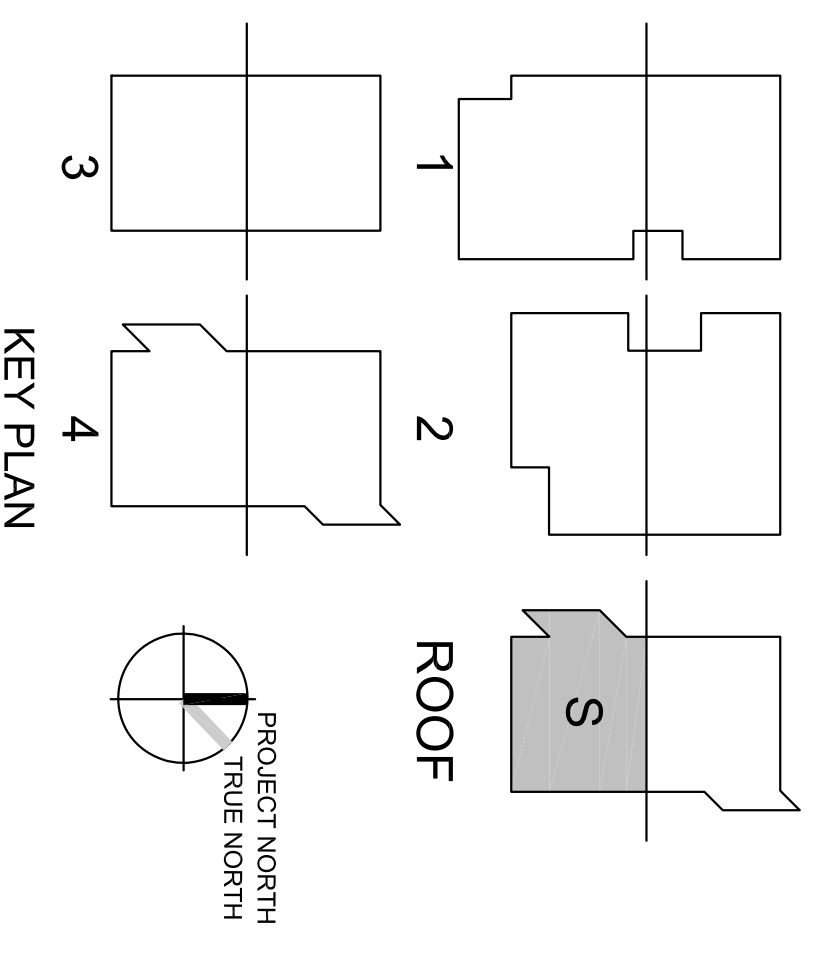

Revision	Description	Date
100%	Design Development	06/05/08
50%	Construction Documents	07/05/08
0%	Submittal	08/18/08
95%	Construction Documents	12/08/08
0%	Final	03/11/09

College of San Mateo Building 10N

San Mateo, CA

Developed for
 San Mateo County Community College District




J.W. McCLENNAHAN CO.
 2001 RAIL AVE
 SAN LUIS OBISPO, CA 94963
 TEL: (805) 345-5888
 FAX: (805) 345-5889


McCarthy Building Companies, Inc.
 343 San Francisco Street, 14th Floor
 San Francisco, California 94104
 P 415 397-5151
 F 415 397-5999



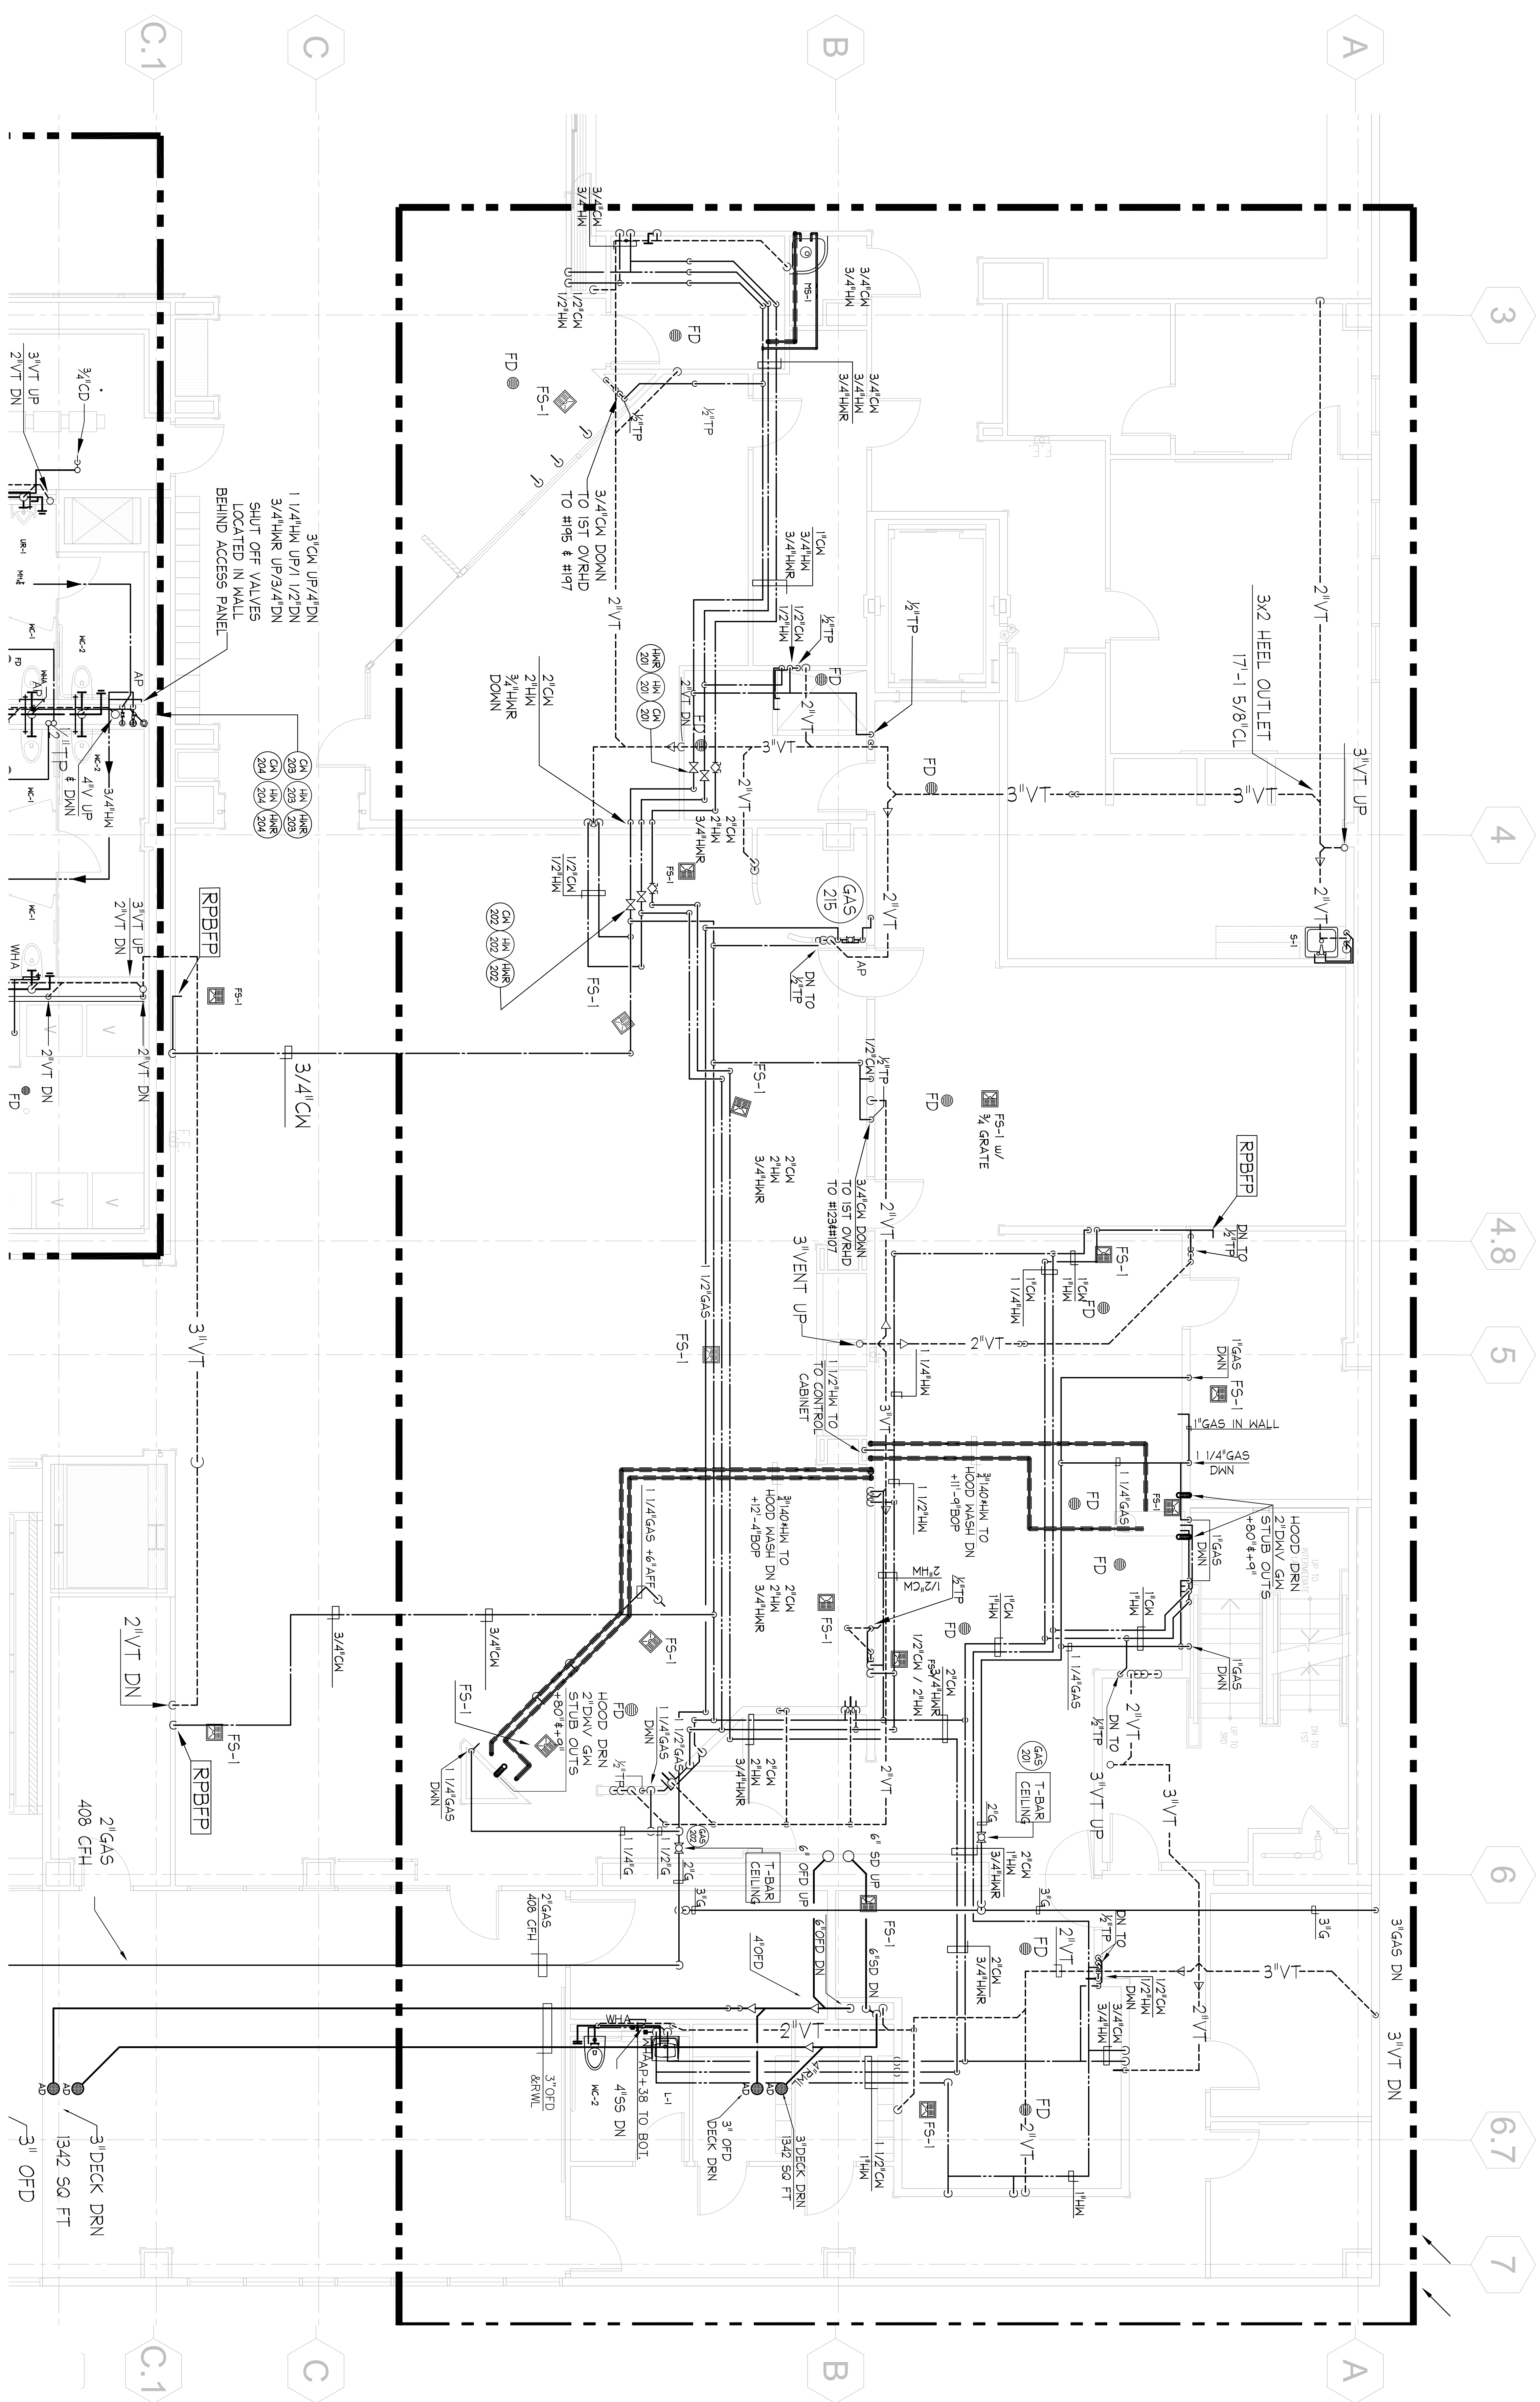


1 Enlarged Kitchen Pressure Piping Plan
SCALE: 1/4"=1'-0"

J.W. McCLENNAHAN CO.
225 N. Main St.
San Mateo, CA 94401
415.397.5151
FAX (415) 397-5888



RECORD DOCUMENT
DATE: October 15, 2010

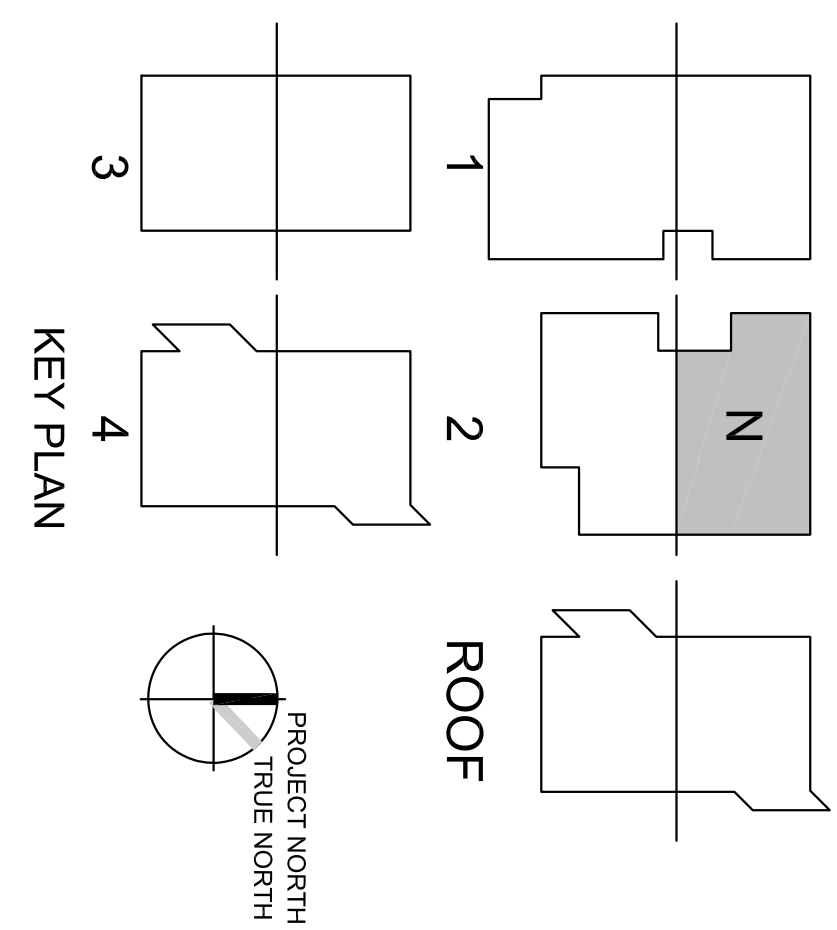

Revision	Description	Date
100%	Design Development	06/30/08
50%	Construction Documents	07/05/08
95%	Construction Documents	10/05/08
95%	Construction Documents	12/08/08
OSA Final		03/11/09


Revision	Description	Date

**College of San Mateo
Building 10N**

San Mateo, CA

Developed for
San Mateo County Community College District


J.W. McCLENNAHAN CO.
2200 FARM AVE
SAN MATEO, CA 94403
415.397.5151
FAX (415) 397-5888

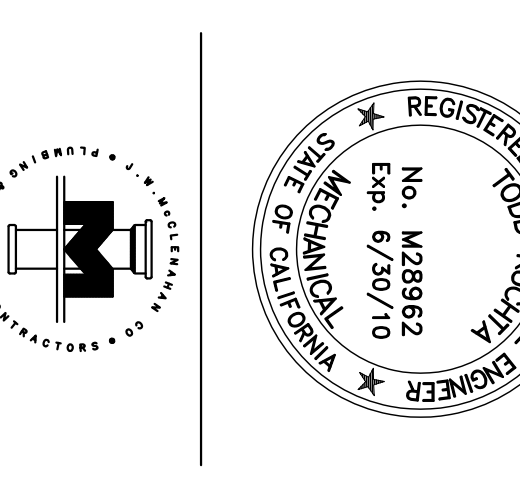

APR. #	01-110095
DATE	01-11-09
FILE NUMBER	41-C1


McCarthy Building Companies, Inc.
343 S. Bascom Ave., Suite 1414
San Francisco, California 94104
P 415.397.5151
F 415.397.5999



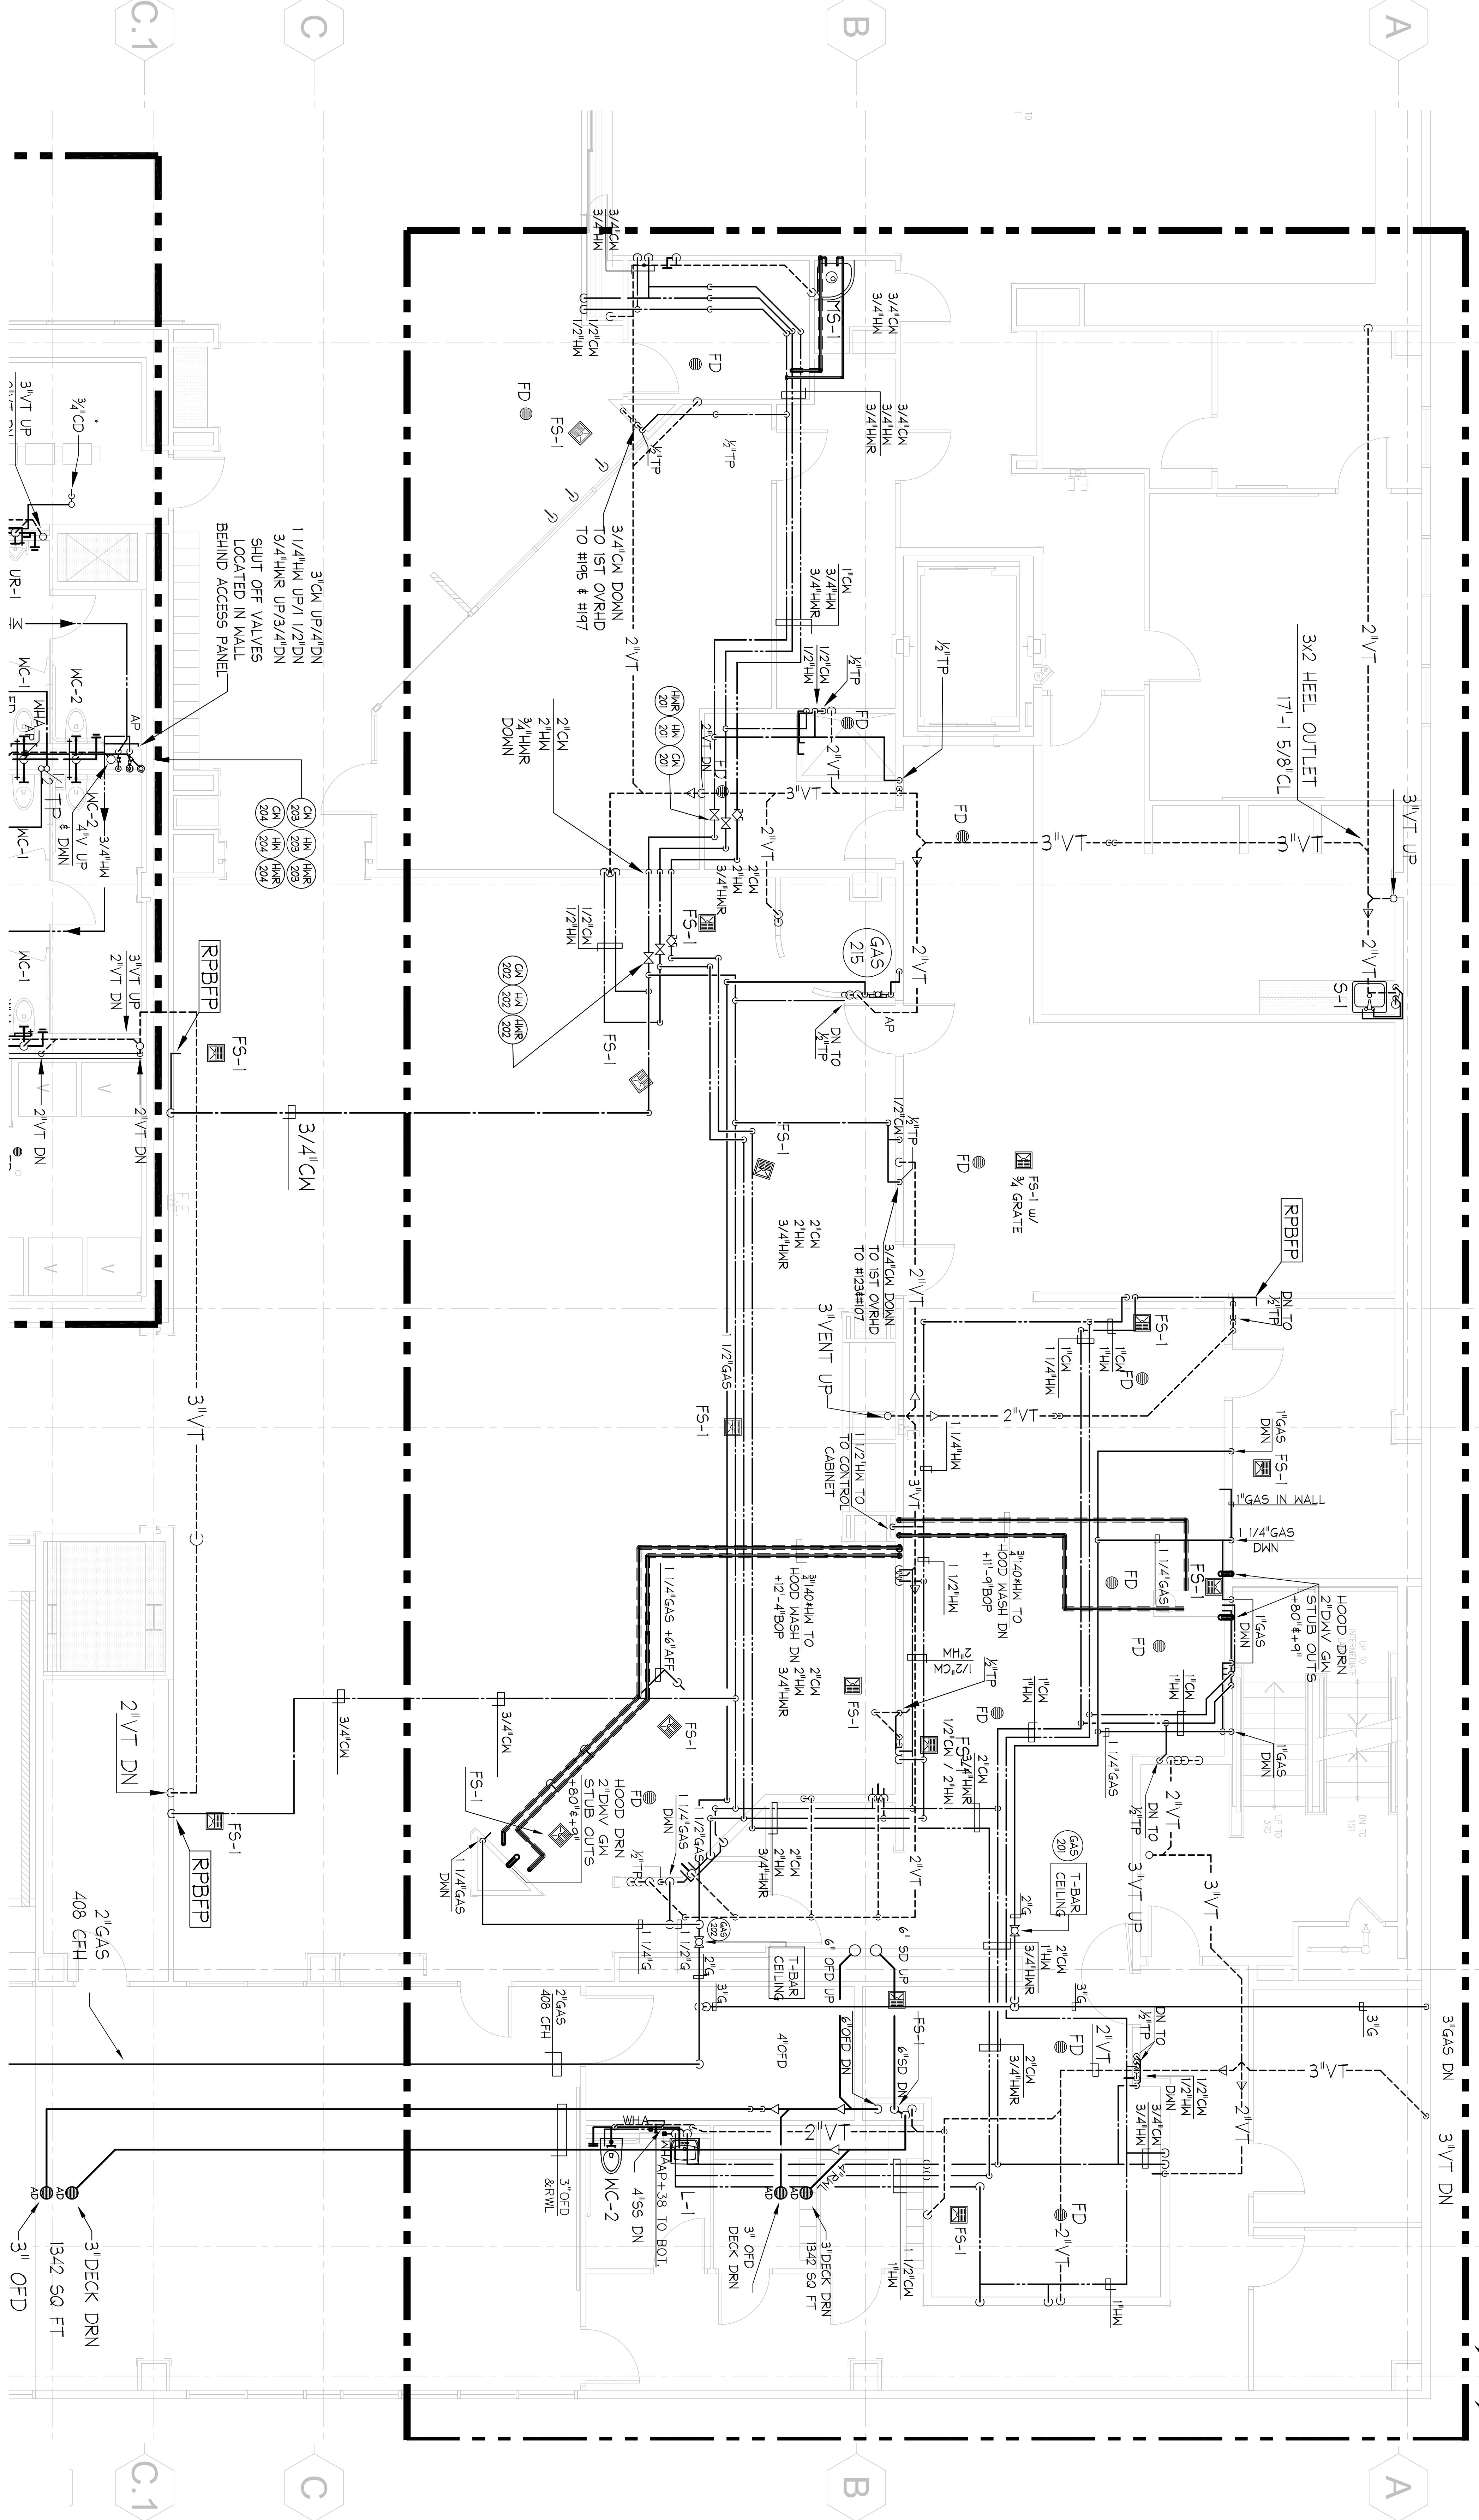

1 Enlarged Kitchen DWV Piping Plan
SCALE: 1/4"=1'-0"

J.W. McCLENNAHAN CO.
 2201 PALM AVE
 SAN LUIS OBISPO, CA 94963
 TEL: (805) 342-4888
 FAX: (805) 342-4889
RECORD DOCUMENT
 DATE: October 15, 2010

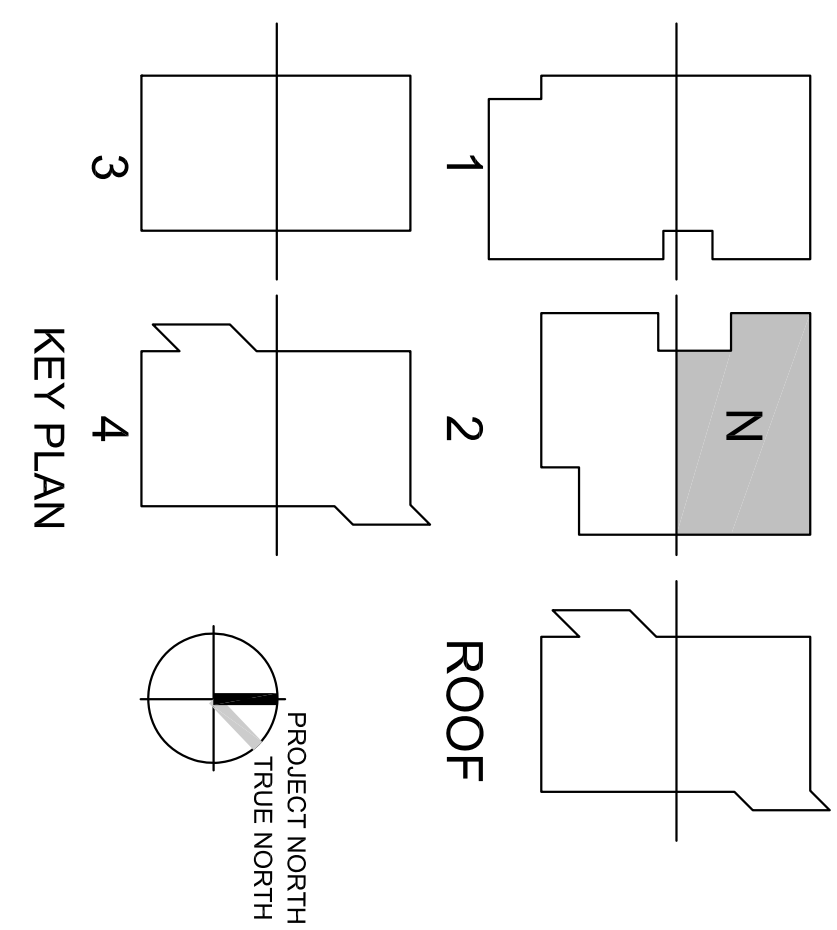


ROOF

Revision	Description	Date
06/30/08	100% Design Development	
07/05/08	50% Construction Documents	
08/14/08	95% Construction Documents	
12/08/08	95% Construction Documents	
03/11/09	DSA Final	

Revision	Description	Date

**College of San Mateo
 Building 10N**
 San Mateo, CA
 Developed for
 San Mateo County Community College District

J.W. McCLENNAHAN CO.
 2201 PALM AVE
 SAN LUIS OBISPO, CA 94963
 TEL: (805) 342-4888
 FAX: (805) 342-4889

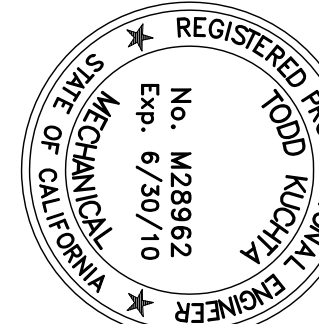

DATE	FILE NUMBER
41-C1	

McCarthy Building Companies, Inc.
 343 S. Bascom Ave., Suite 1410
 San Francisco, California 94104
 P 415 397-5151
 F 415 397-5999












College of San Mateo
 Building 10N
 San Mateo, CA
 Developed for
 San Mateo County Community College District

Revision Description	Date
100% Design Development	06/03/08
50% Construction Documents	08/05/08
95% Construction Documents	12/08/08
DSA Final	11/11/09




JOB NO.	2708/231
DATE	March 2008
Checked by	TK
Scale	NONE

Storm Riser Diagram
 DWV Riser Diagram
P4.03

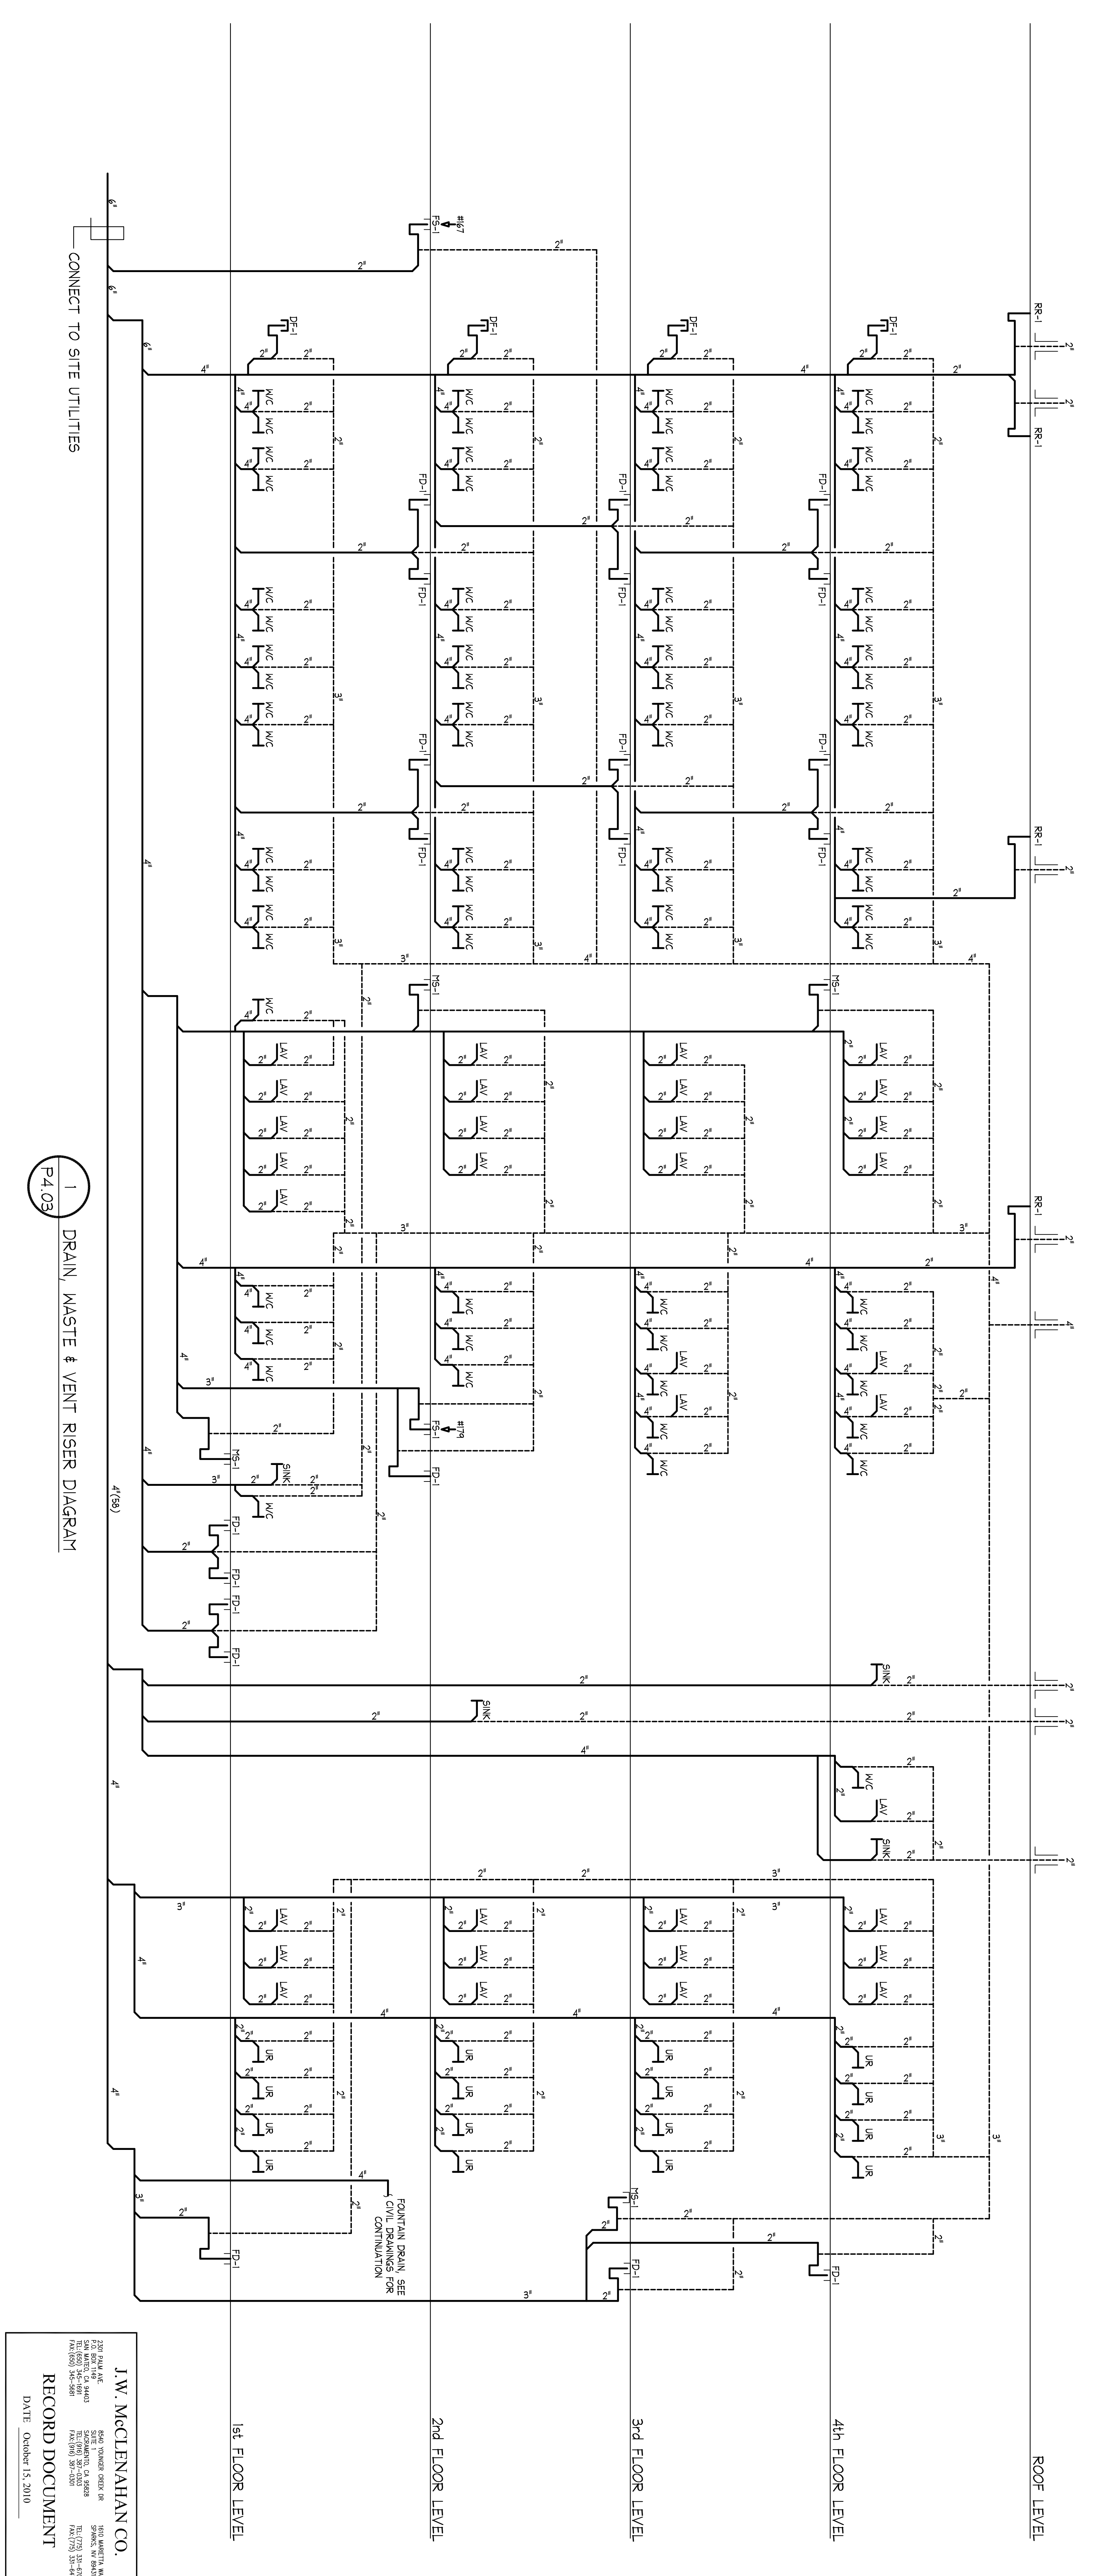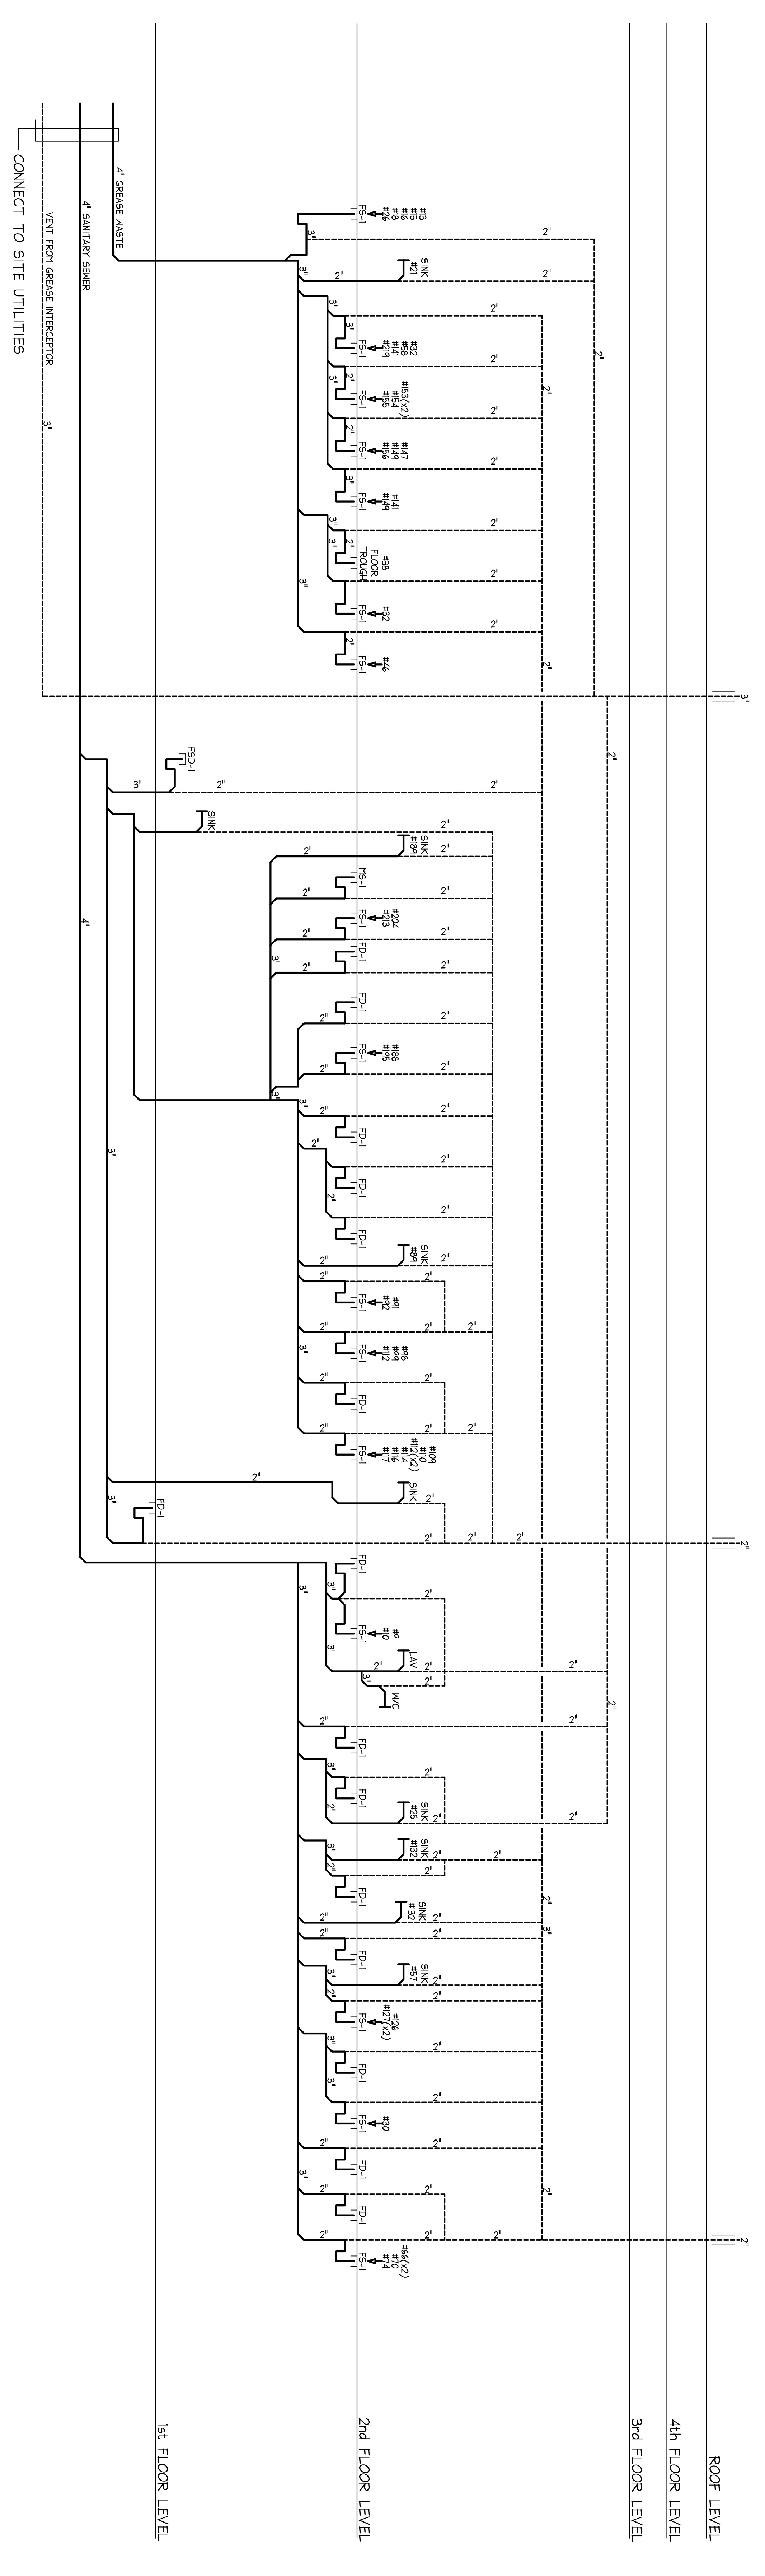


1 DRAIN, WASTE & VENT RISER DIAGRAM
 P4.03

 2001 PALM AVE
 FAX (650) 345-9881
 RECORD DOCUMENT
 DATE October 15, 2010

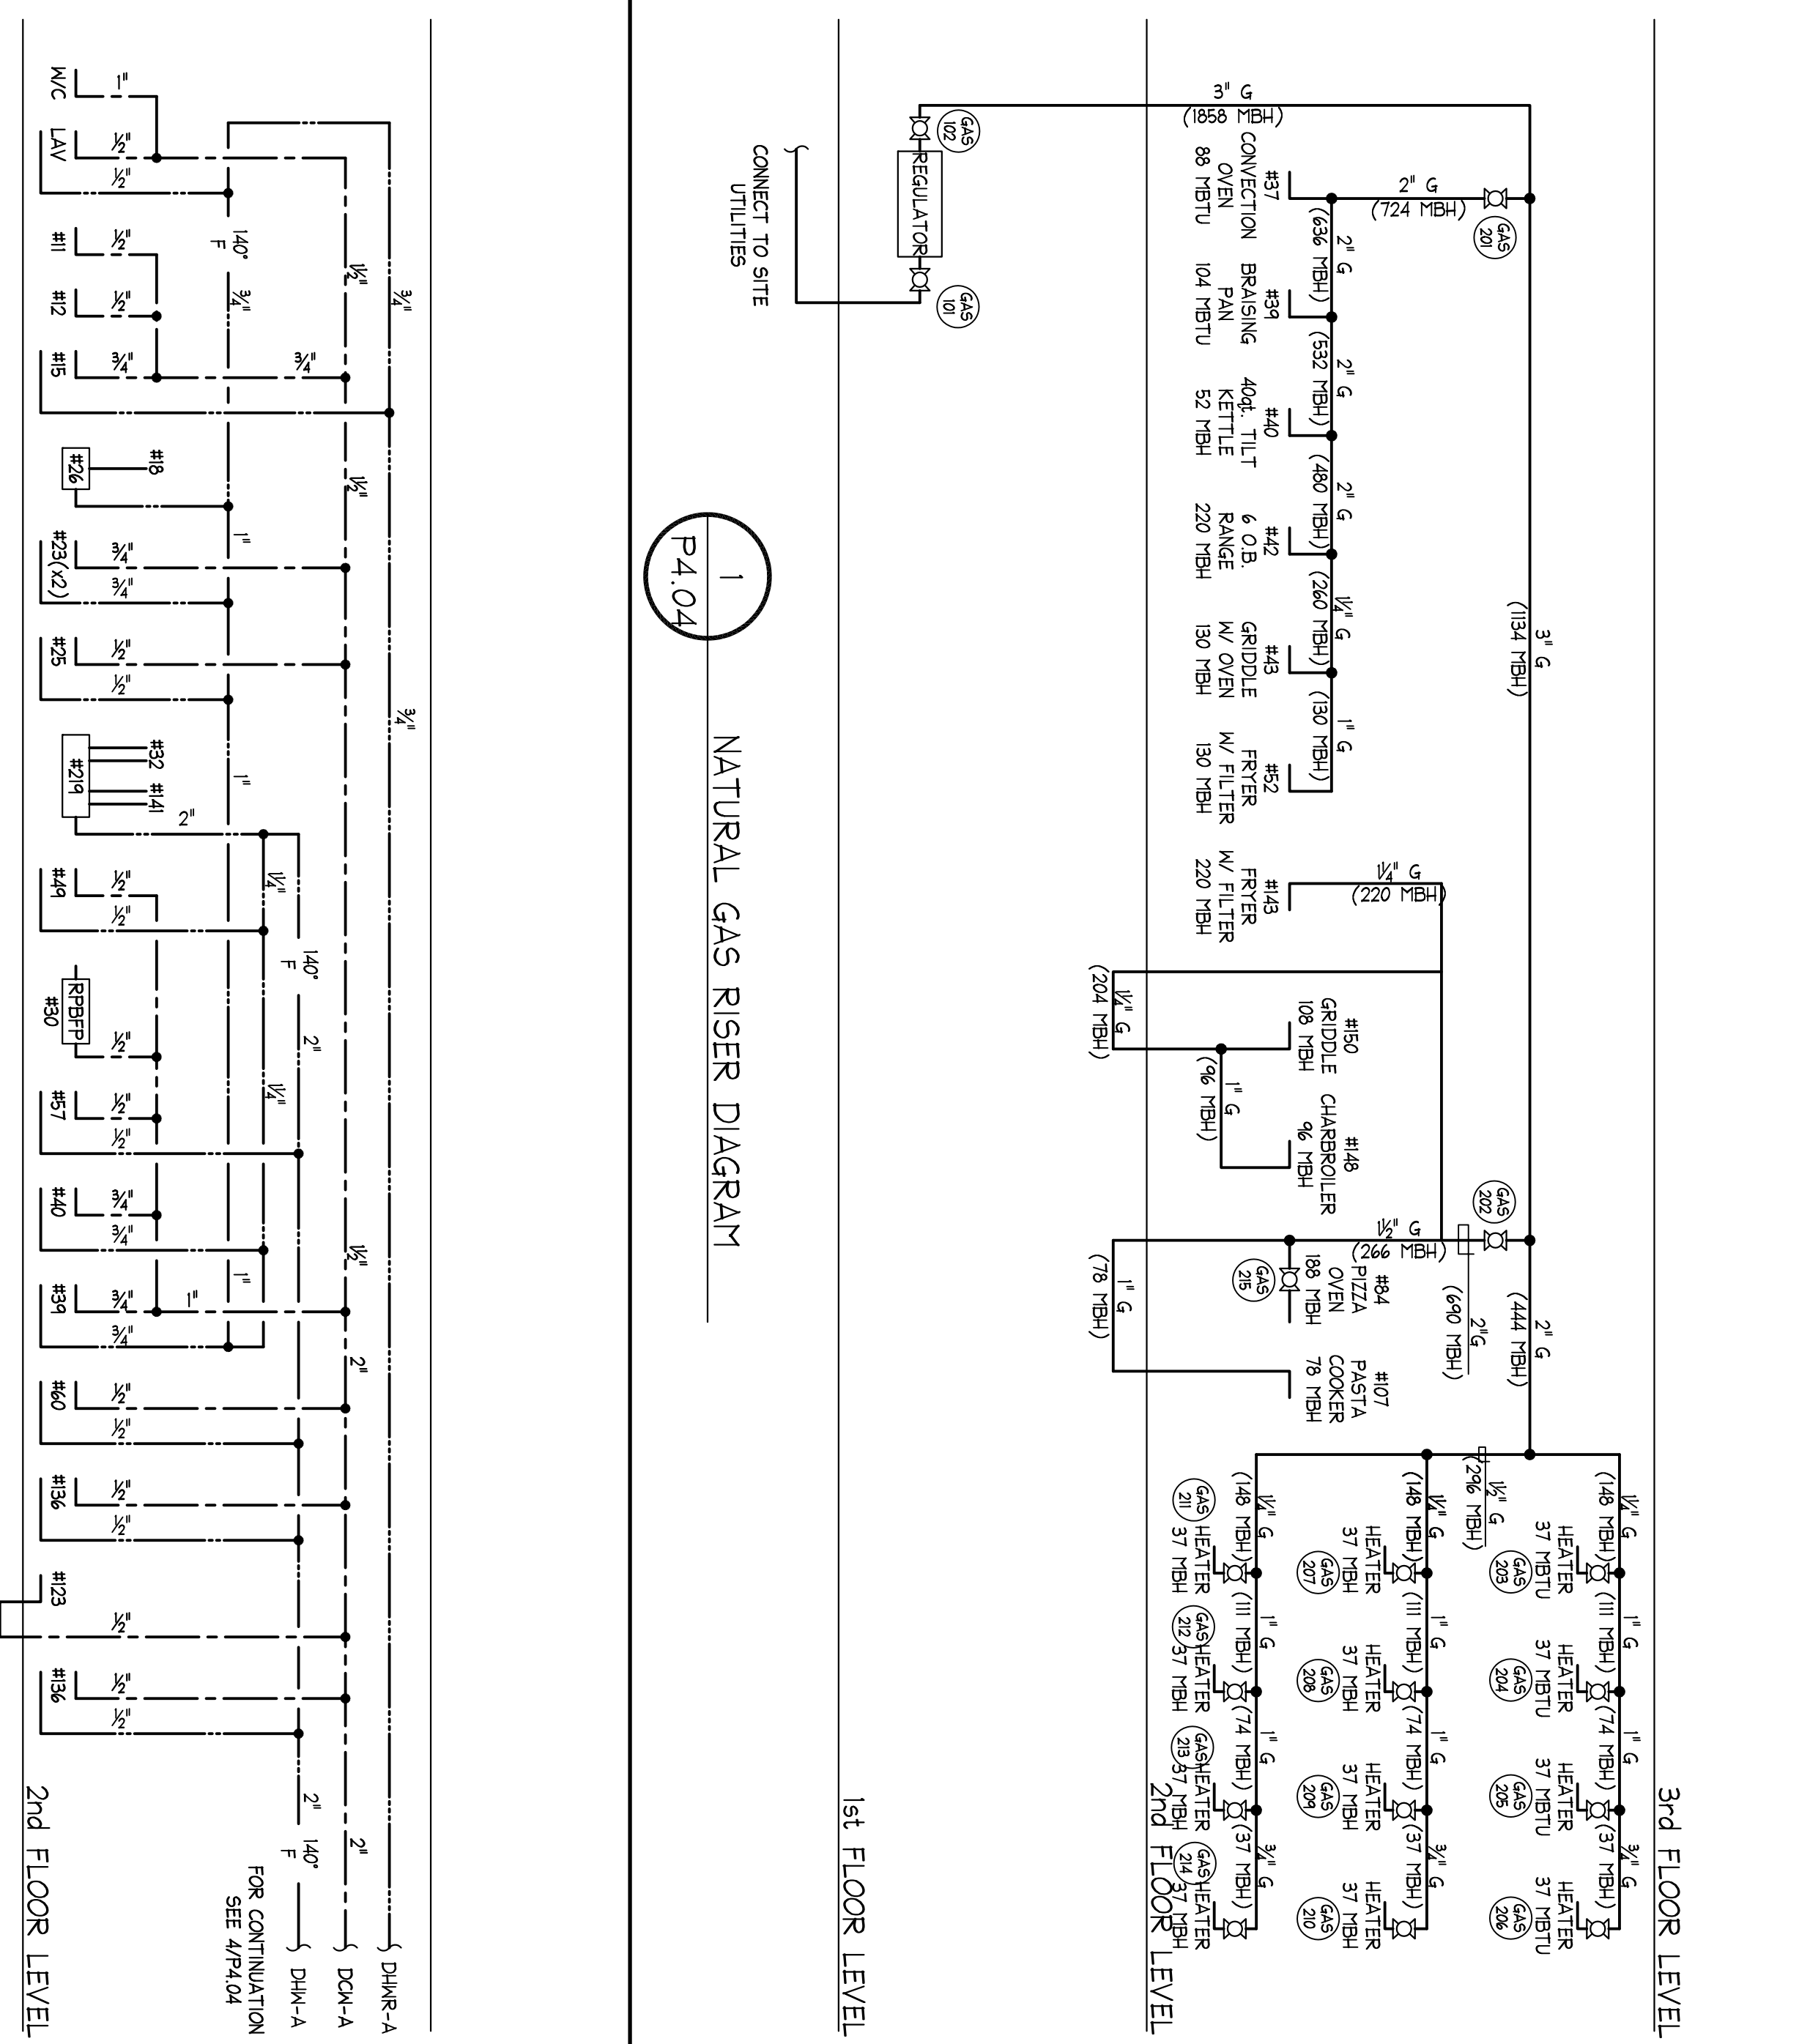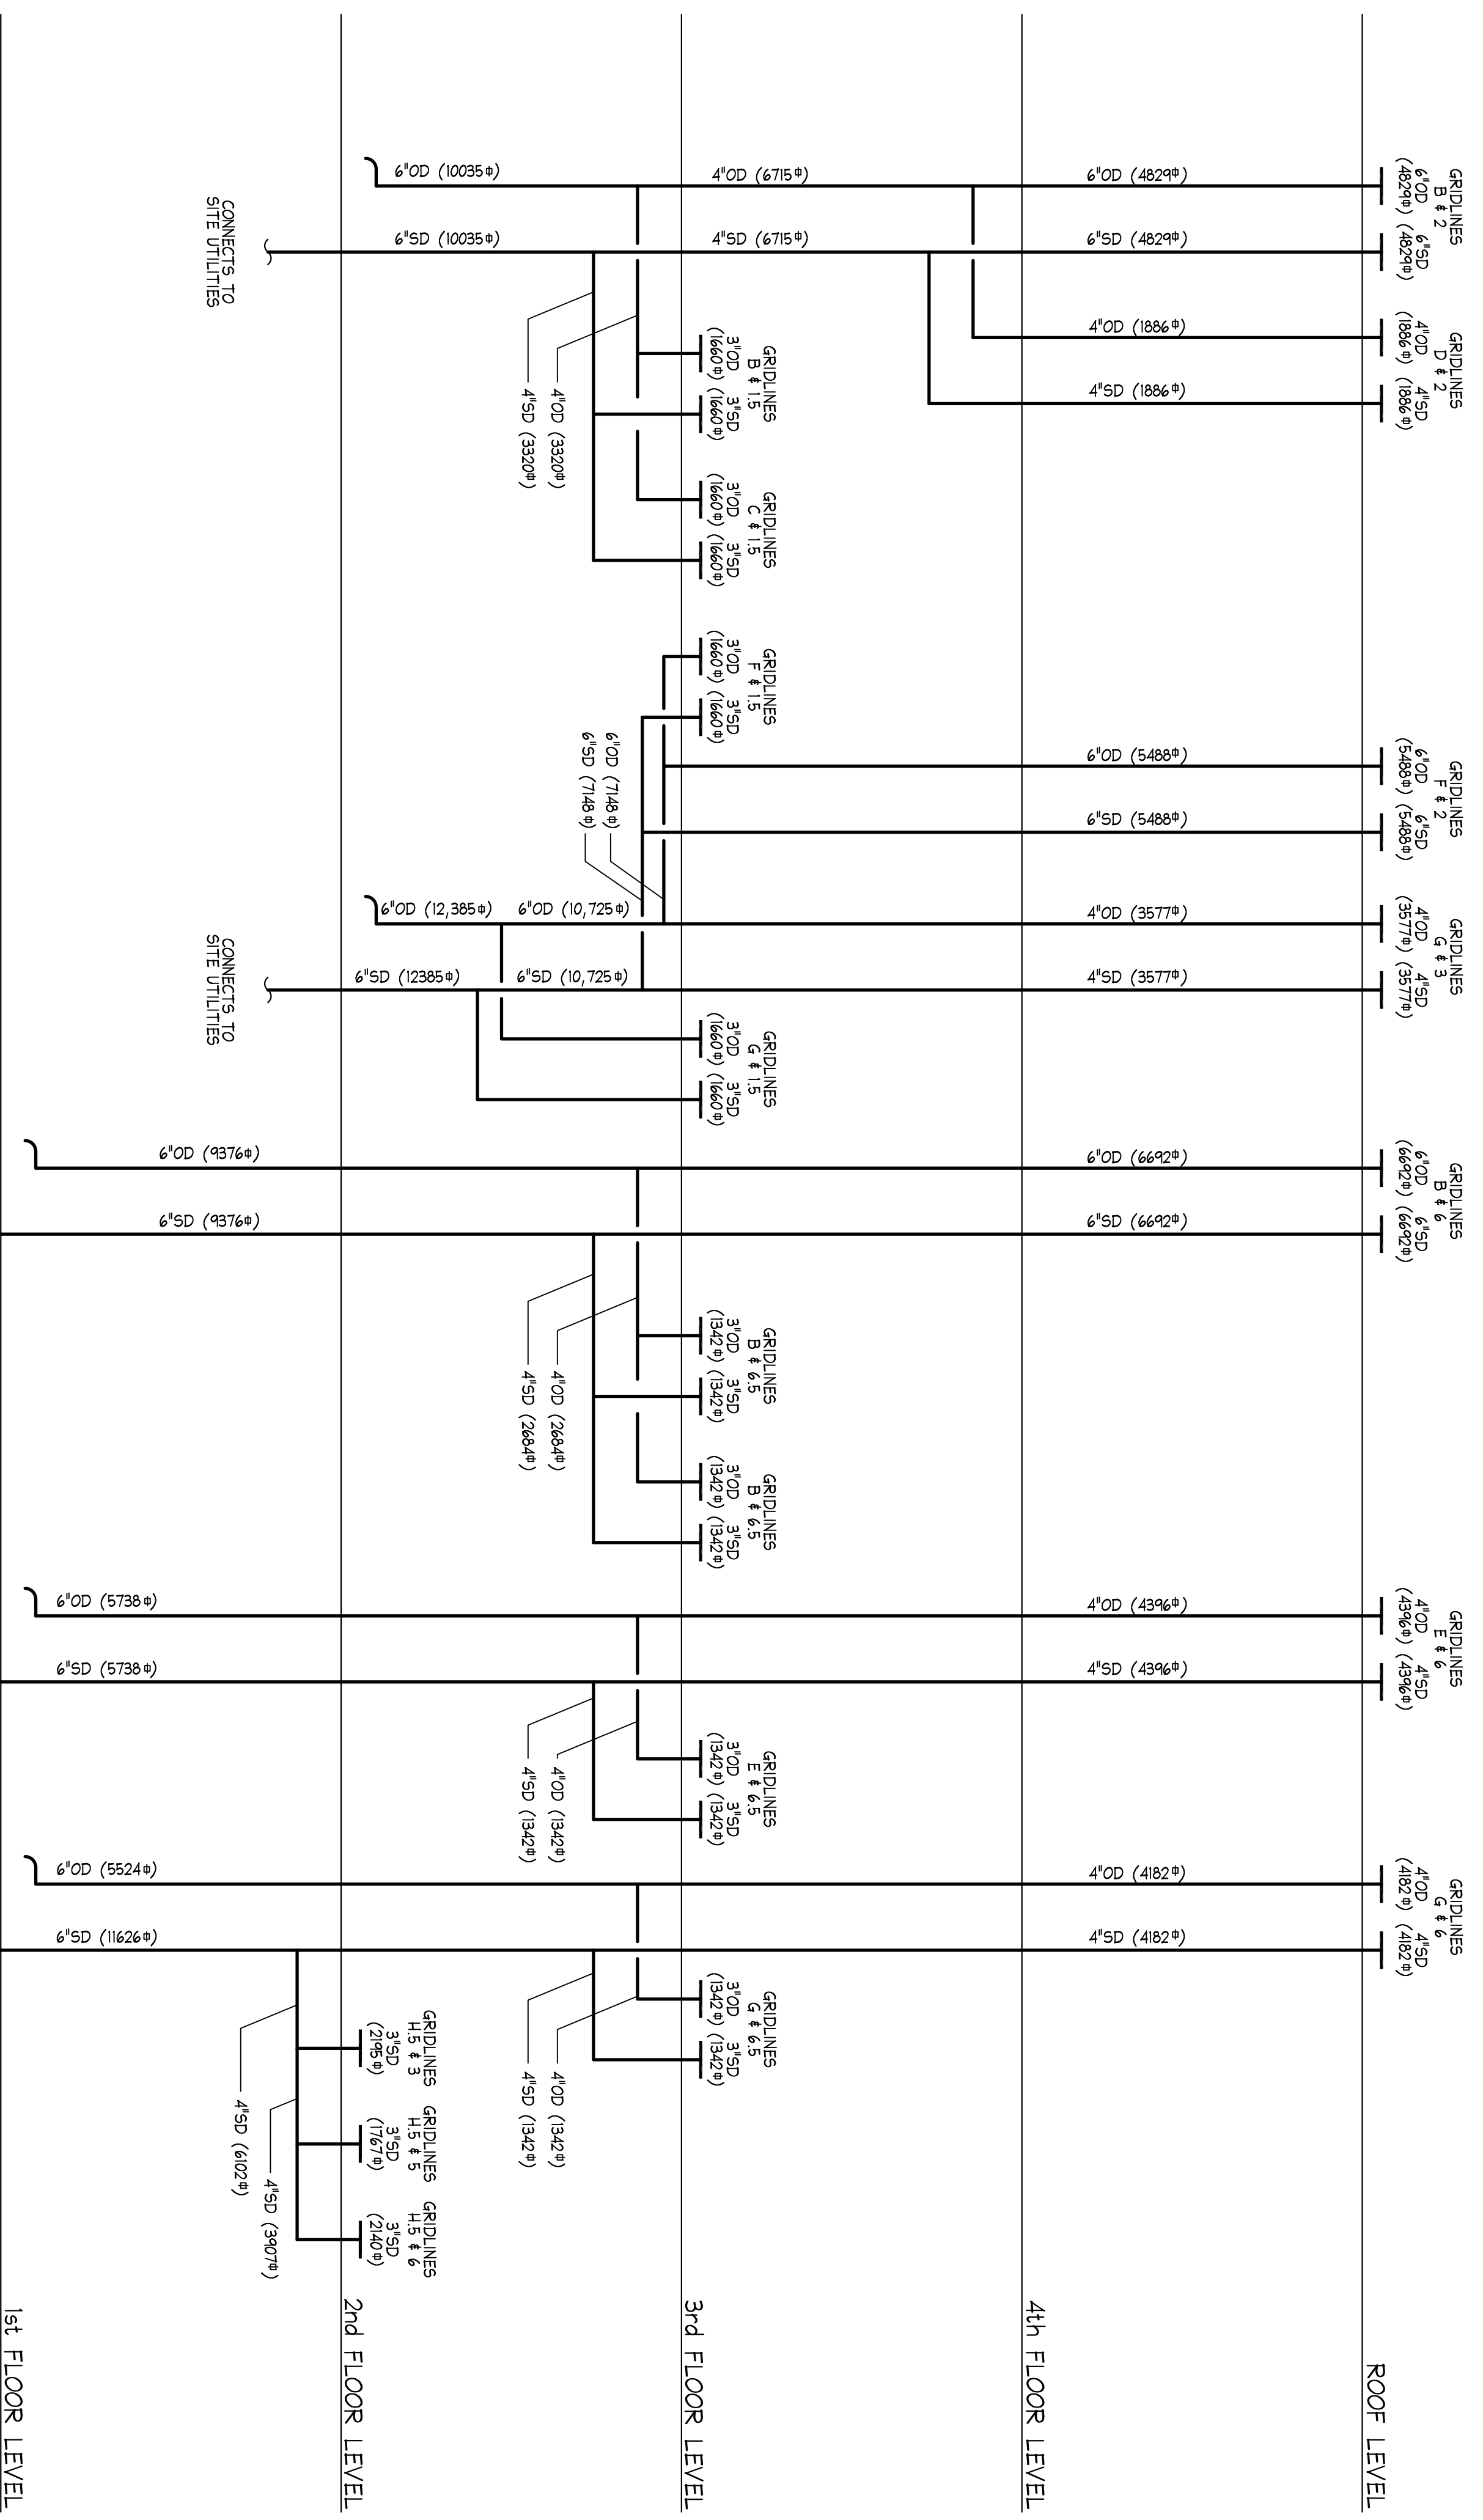

2 STORM AND OVERFLOW DRAIN RISER DIAGRAM

3 DOMESTIC WATER RISER DIAGRAM

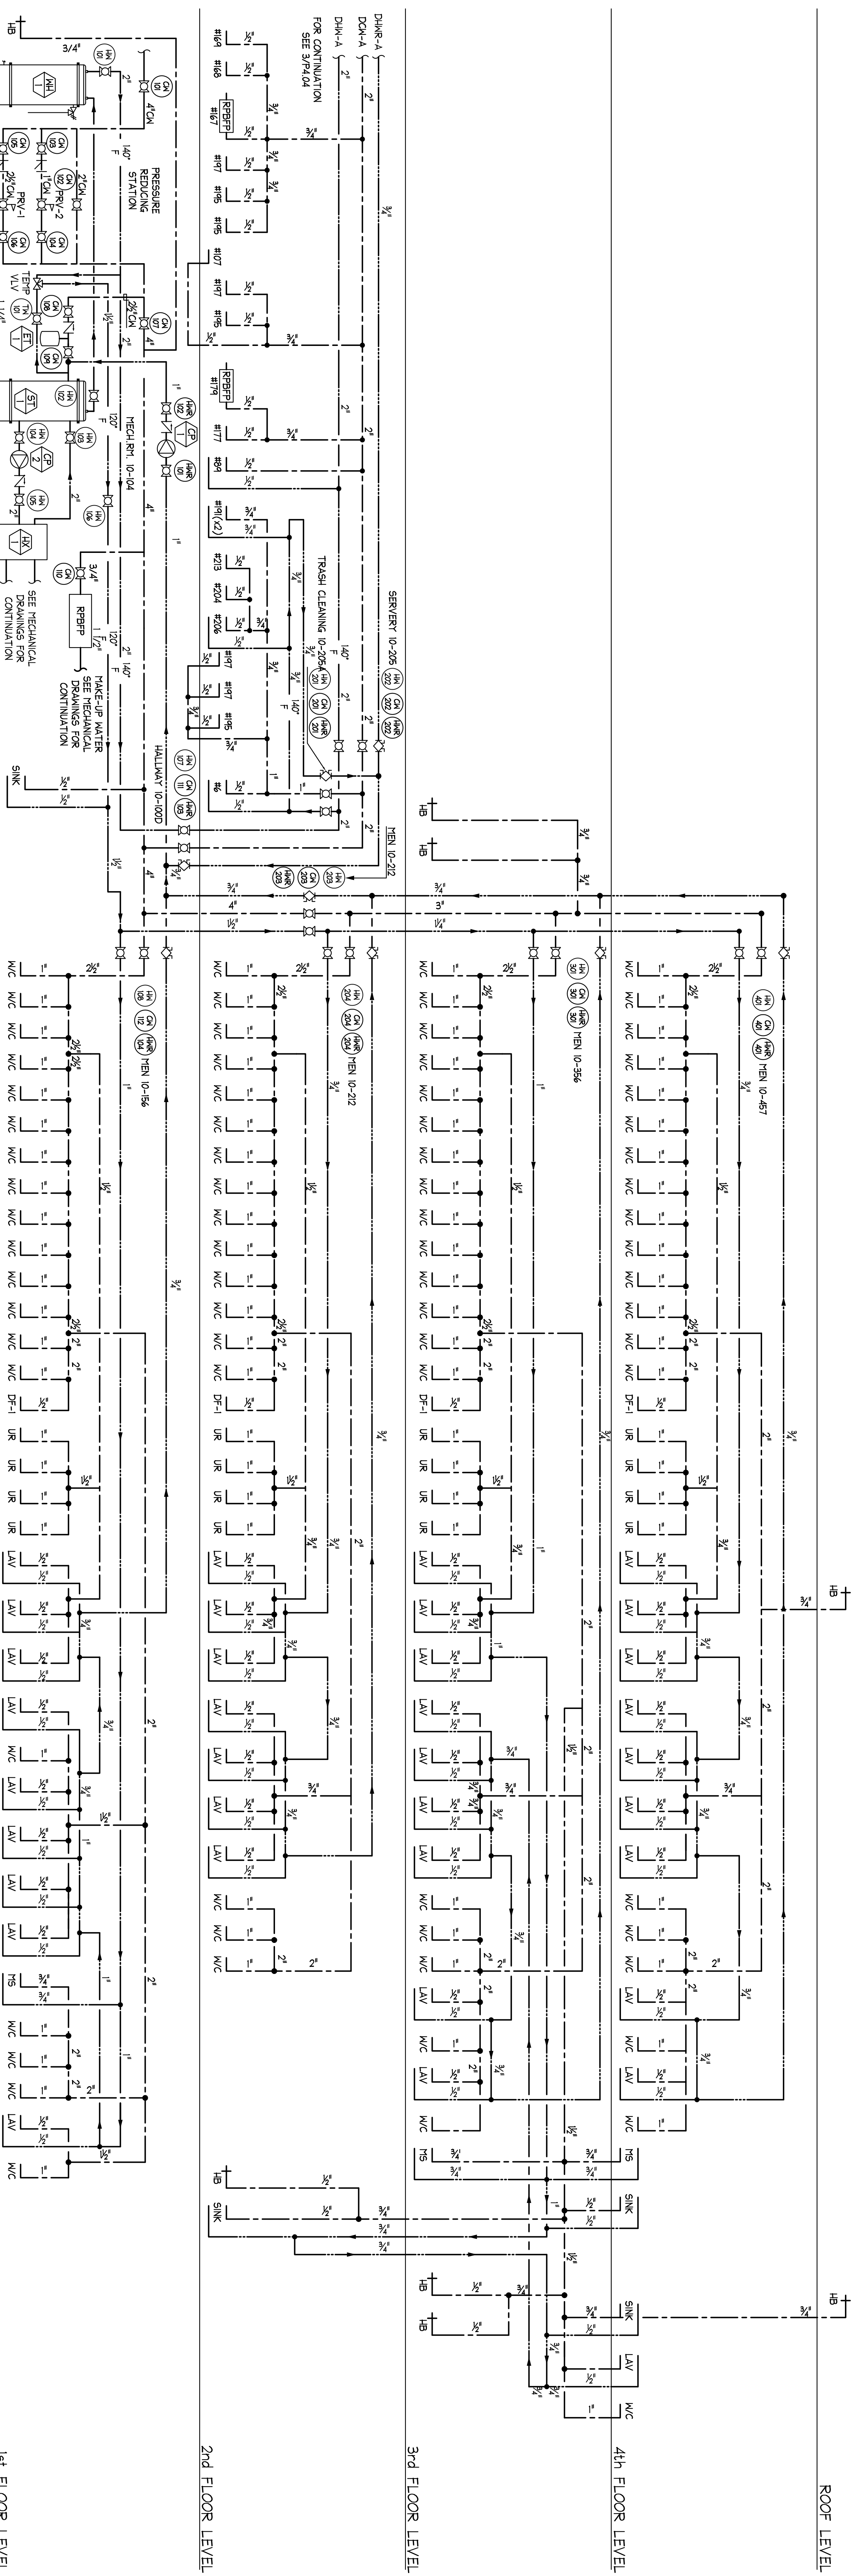

4 DOMESTIC WATER RISER DIAGRAM

J.W. McCLENNAHAN CO.
 2001 PALM AVE
 SAN MATEO, CA 94403
 TEL: (650) 331-4400
 FAX: (650) 331-4400

RECORD DOCUMENT
 DATE: October 15, 2010

Revision	Description	Date
06/05/08	100% Design Development	06/05/08
07/16/08	50% Construction Documents	07/16/08
08/14/08	90% Construction Documents	08/14/08
12/08/08	95% Construction Documents	12/08/08
03/11/09	DSA Final	03/11/09

Revision	Description	Date

Revision	Description	Date

College of San Mateo
 Building 10N

San Mateo, CA

Developed for
 San Mateo County Community College District


J.W. McCLENNAHAN CO.
 2001 PALM AVE
 SAN MATEO, CA 94403
 TEL: (650) 331-4400
 FAX: (650) 331-4400

REGISTERED PROFESSIONAL ENGINEER
 No. M28982
 Exp. 6/30/10
 STATE OF CALIFORNIA
 MECHANICAL ENGINEER


ENGINEERING FIRM
 APPL. F. 01-110095
 FILE NUMBER: 41-C1

McCarthy Building Companies, Inc.
 343 Serrano Ave., Suite 1414, Palo Alto
 San Francisco, California 94104
 P 415 397-5151
 F 415 397-5999


LPA
 KH
 MCCARTHY

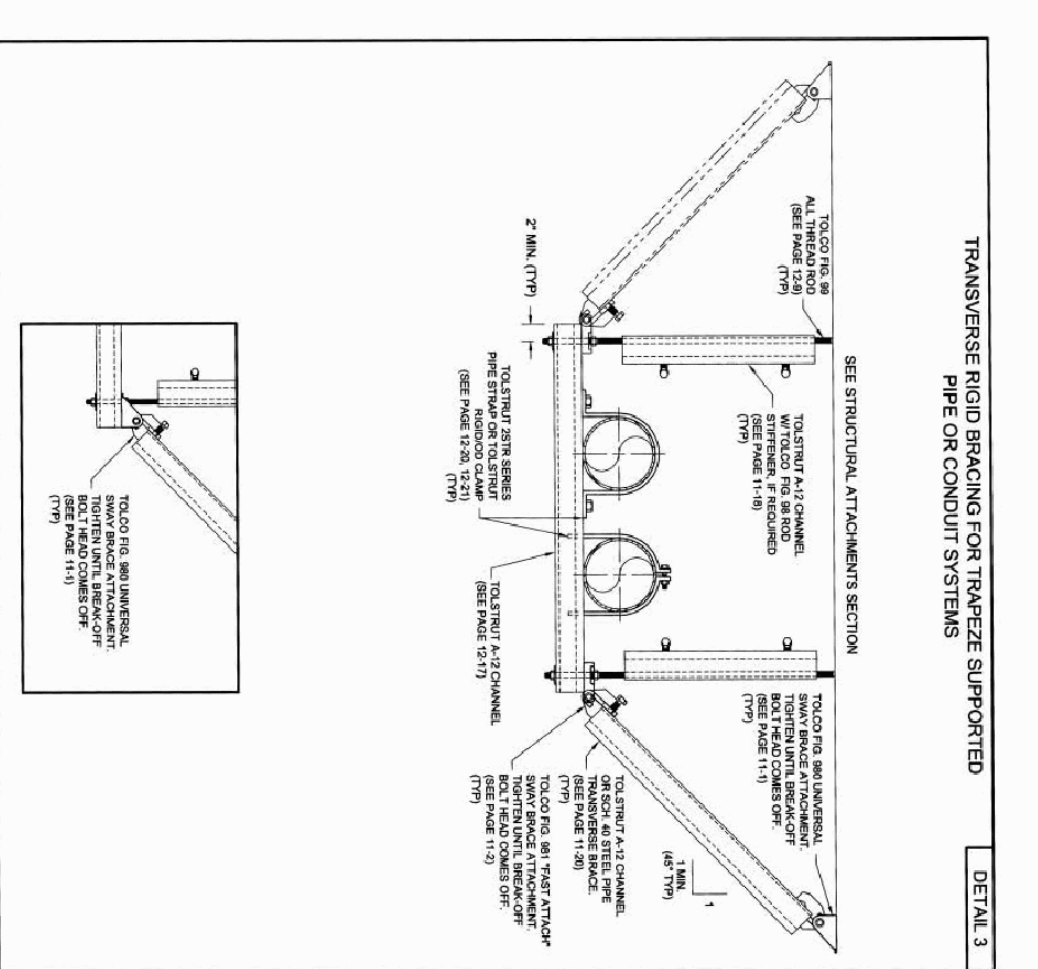


APPROVED
Fixed Equipment Anchorage
OPA-0300 July 21, 2003
DATE: July 21, 2003

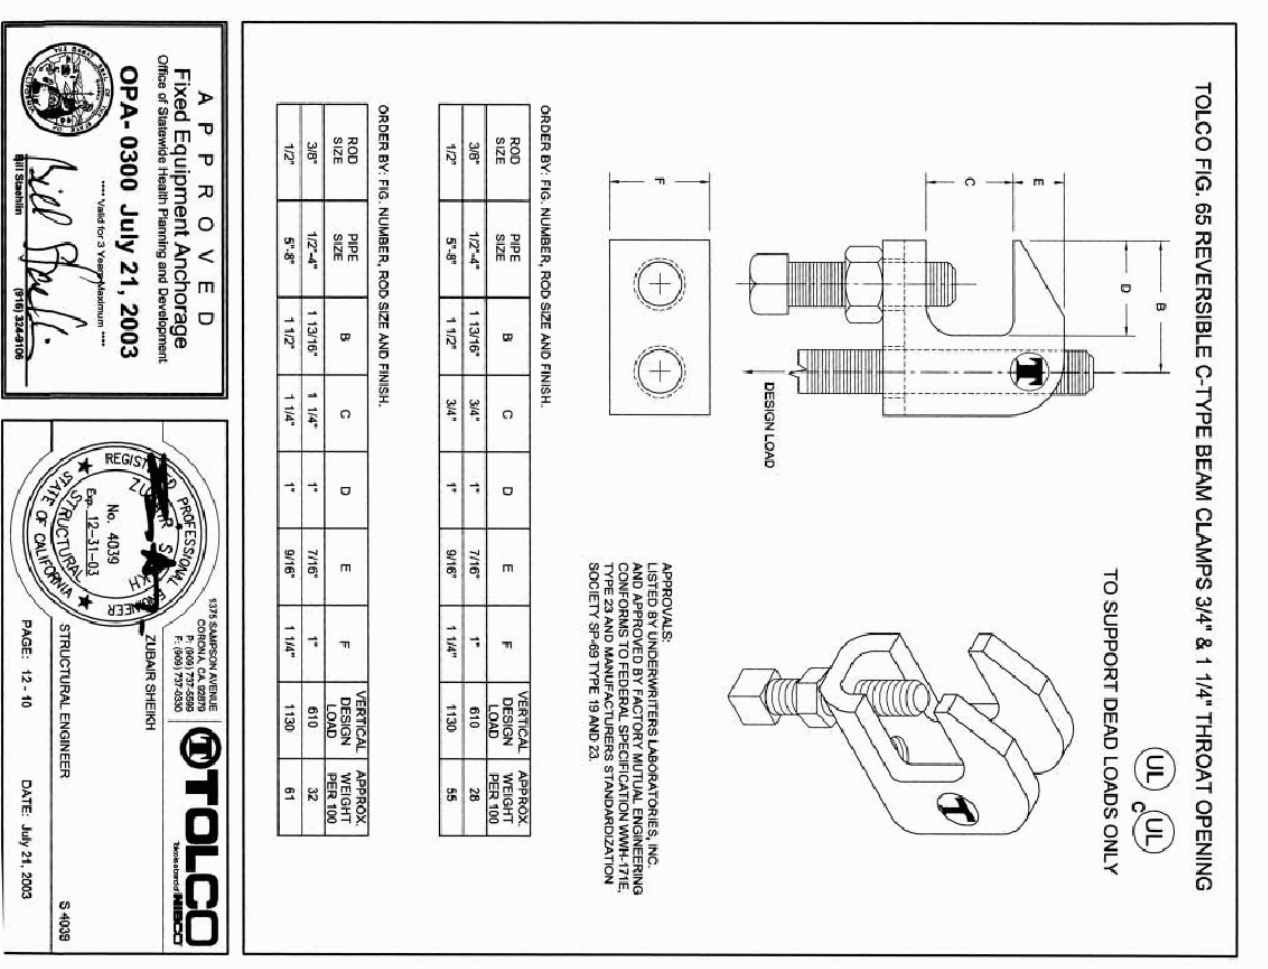


APPROVED
Fixed Equipment Anchorage
OPA-0300 July 21, 2003
DATE: July 21, 2003

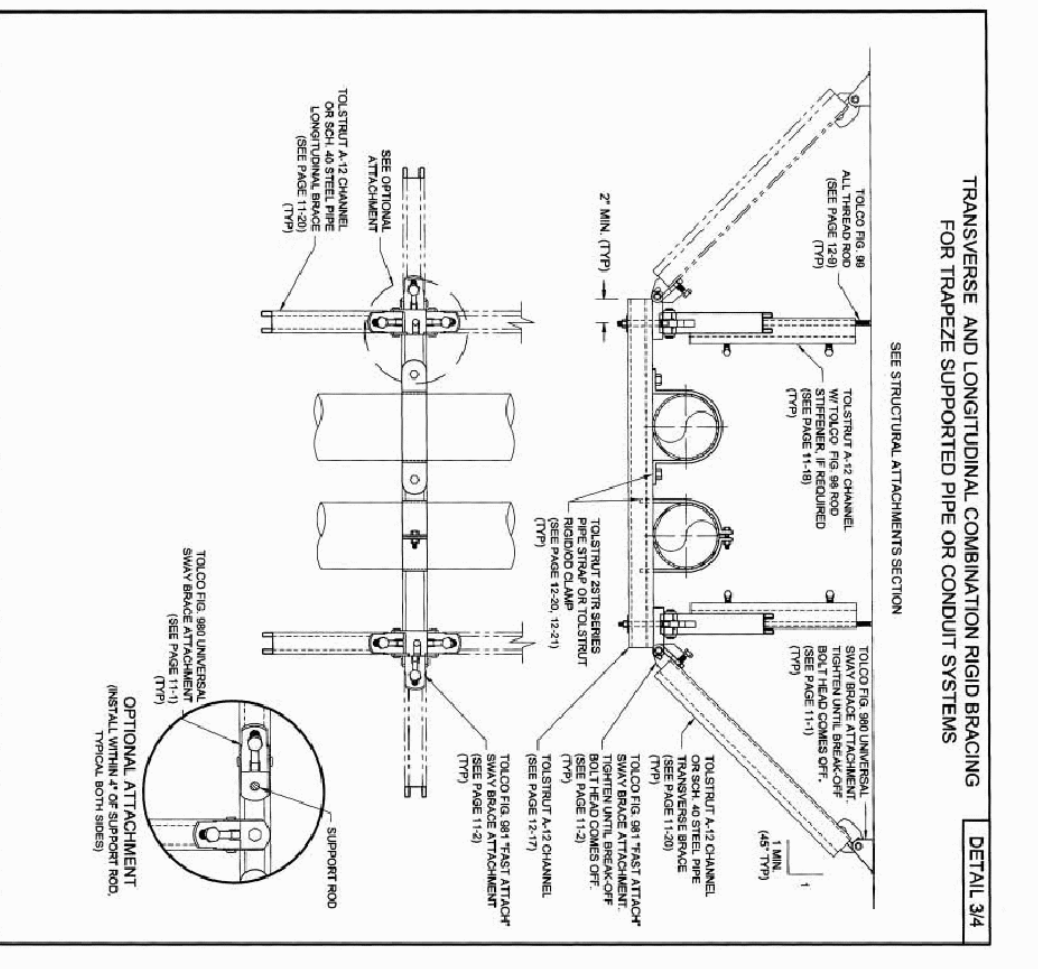


APPROVED
Fixed Equipment Anchorage
OPA-0300 July 21, 2003
DATE: July 21, 2003

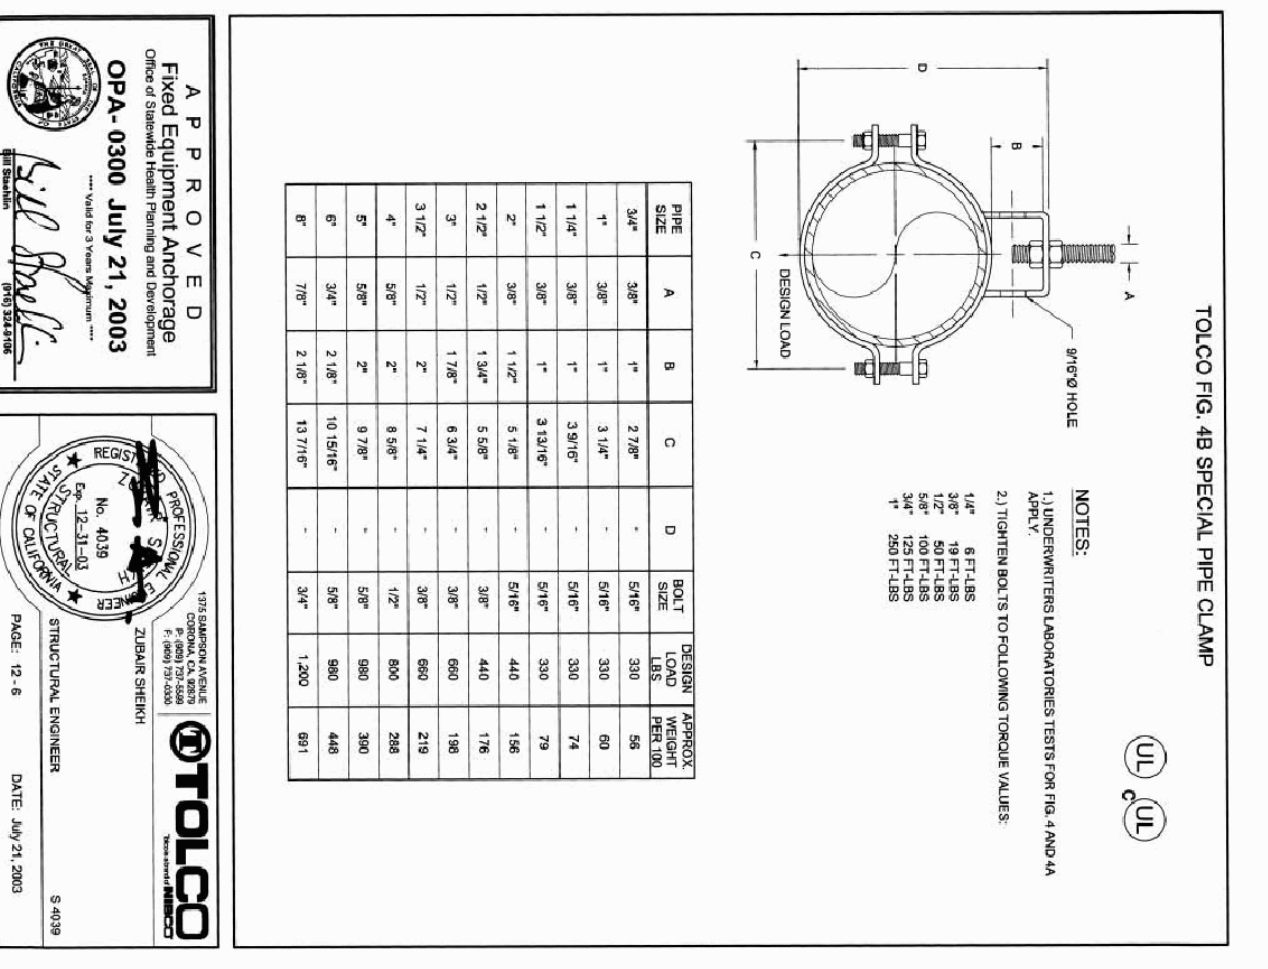


APPROVED
Fixed Equipment Anchorage
OPA-0300 July 21, 2003
DATE: July 21, 2003

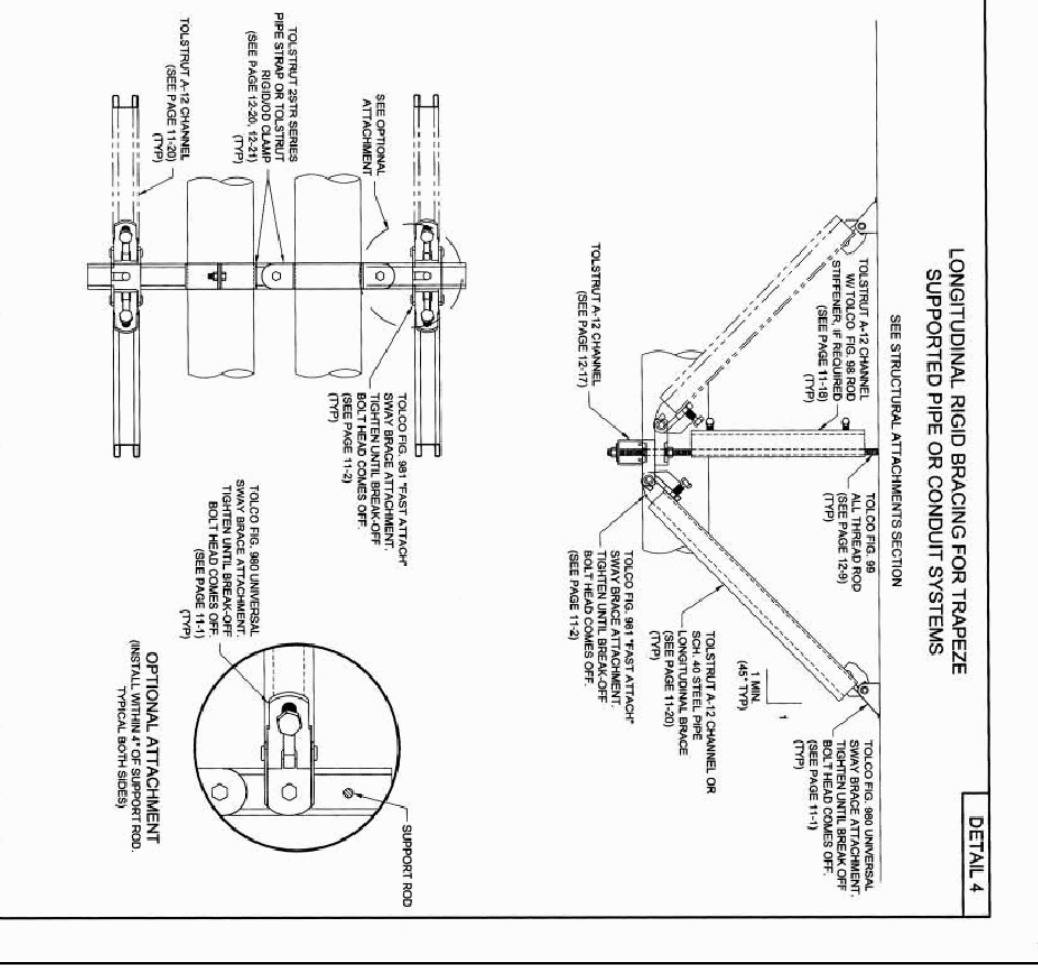


APPROVED
Fixed Equipment Anchorage
OPA-0300 July 21, 2003
DATE: July 21, 2003

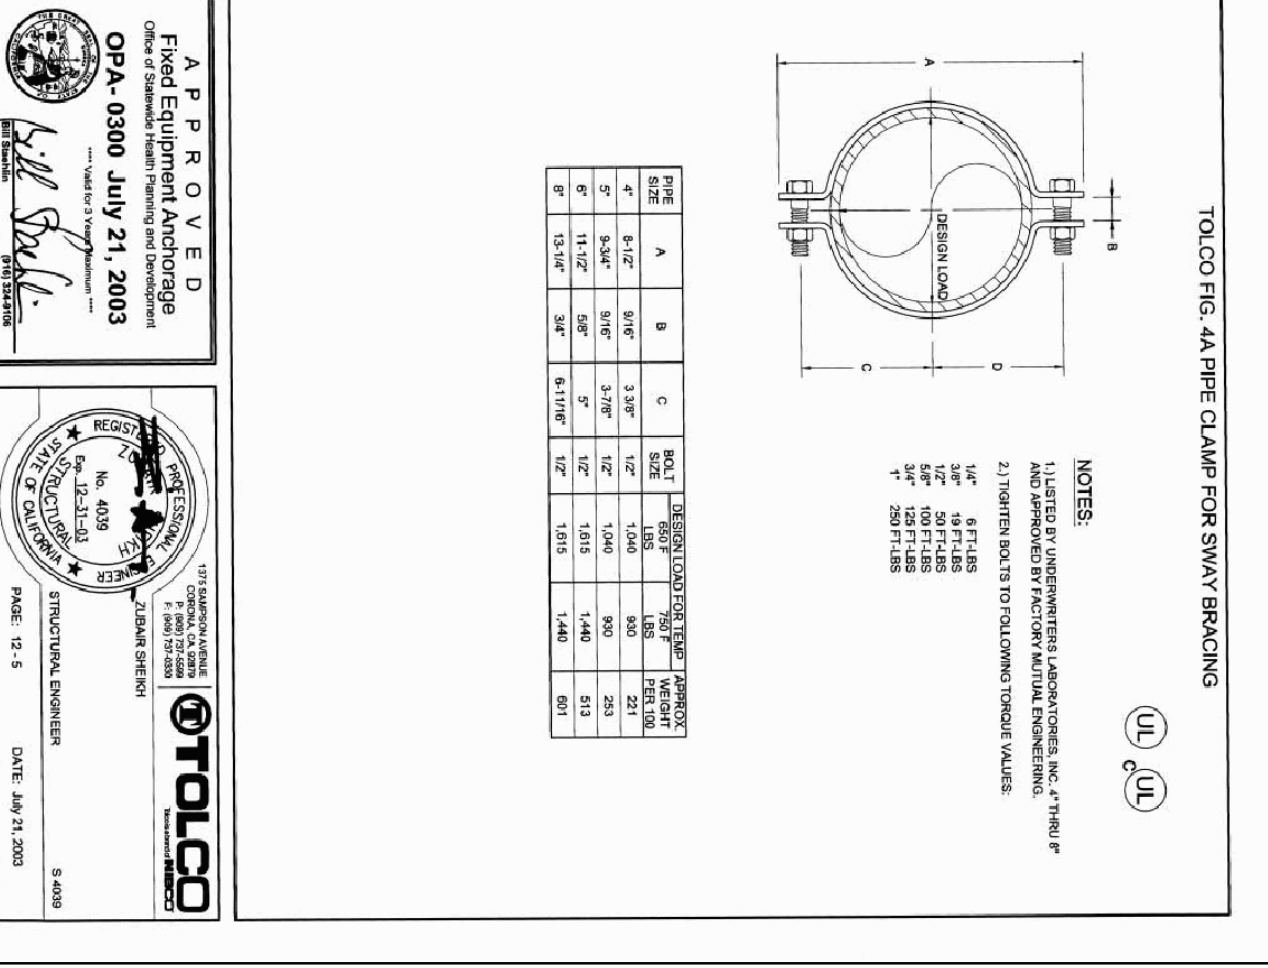


APPROVED
Fixed Equipment Anchorage
OPA-0300 July 21, 2003
DATE: July 21, 2003

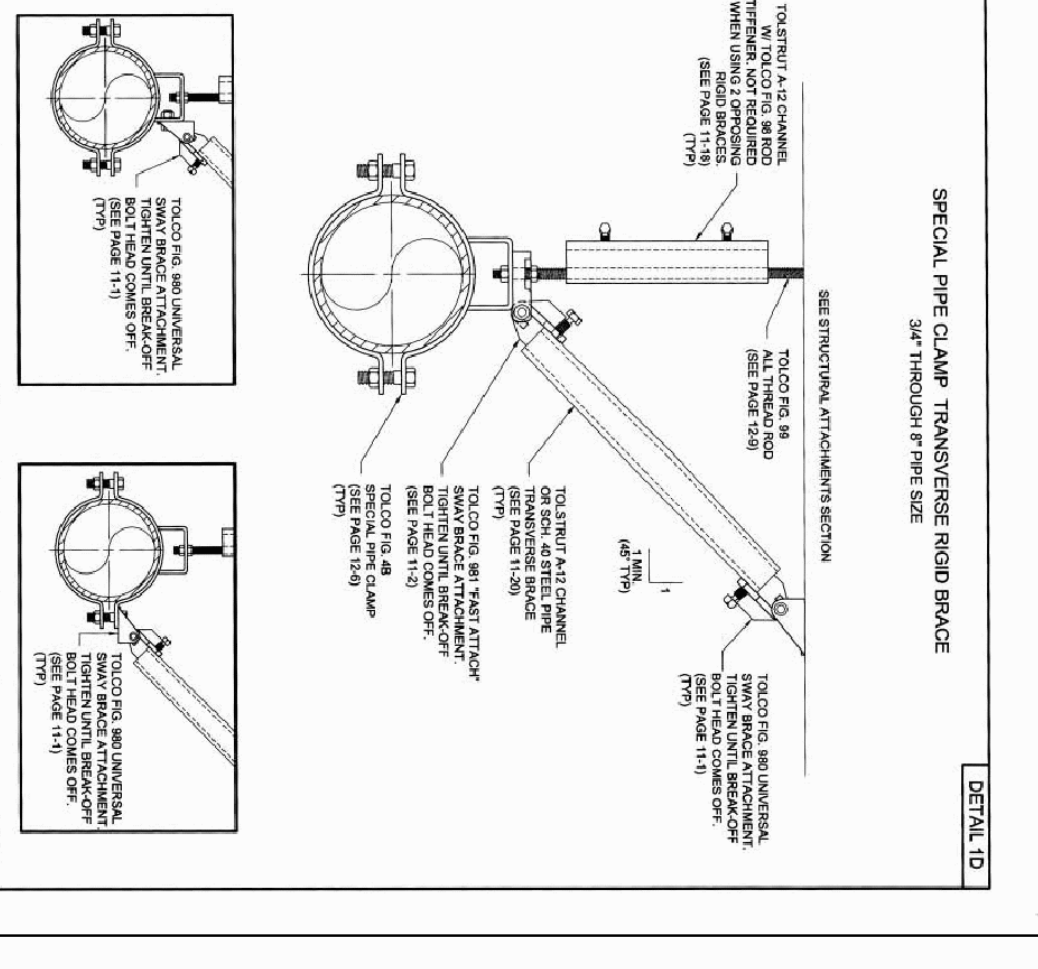


APPROVED
Fixed Equipment Anchorage
OPA-0300 July 21, 2003
DATE: July 21, 2003

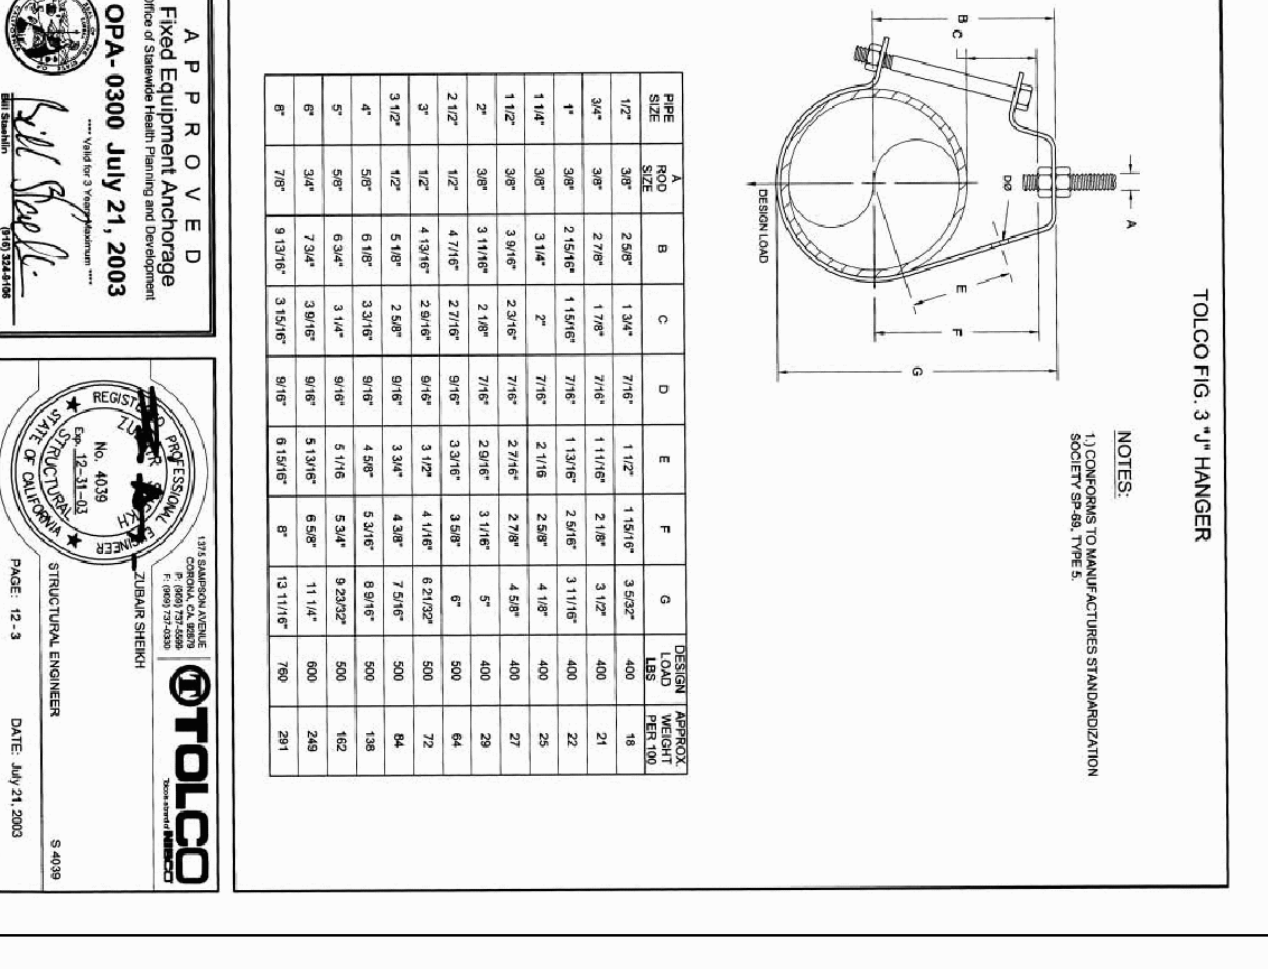


APPROVED
Fixed Equipment Anchorage
OPA-0300 July 21, 2003
DATE: July 21, 2003

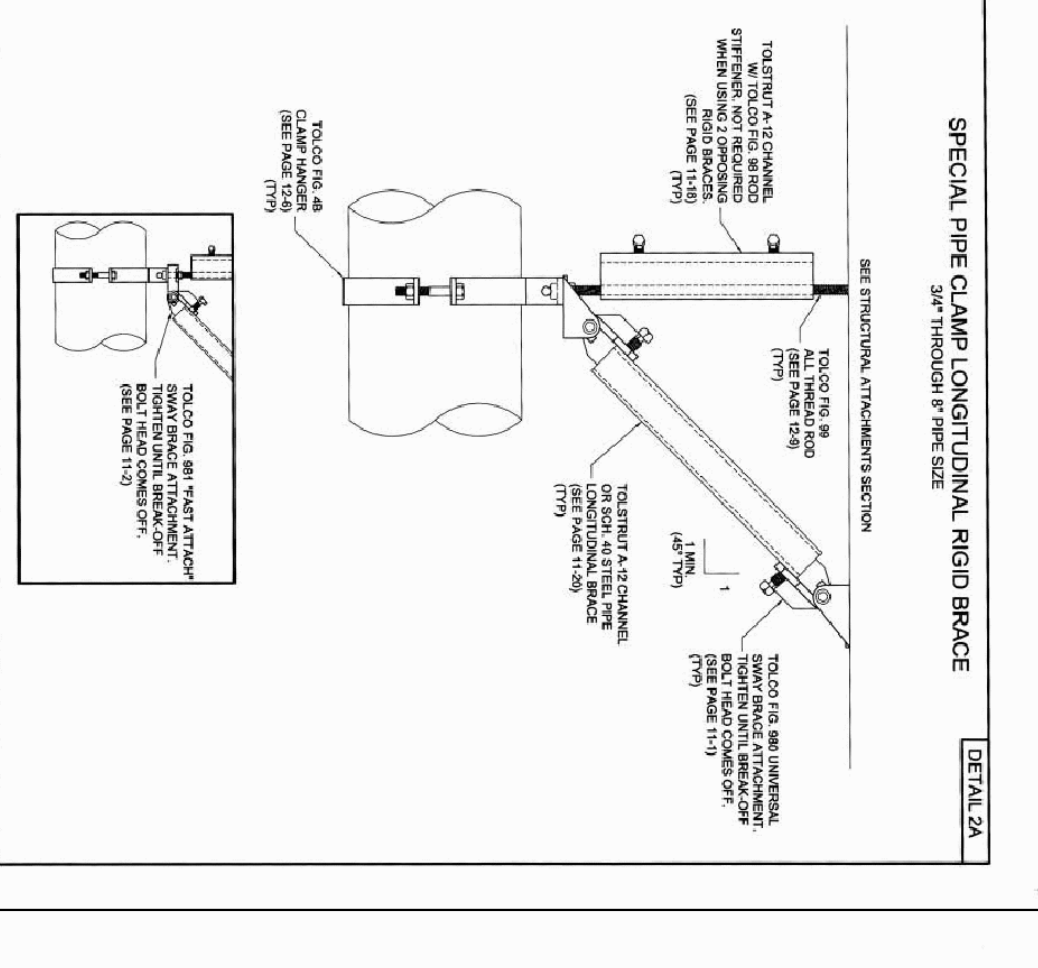


APPROVED
Fixed Equipment Anchorage
OPA-0300 July 21, 2003
DATE: July 21, 2003

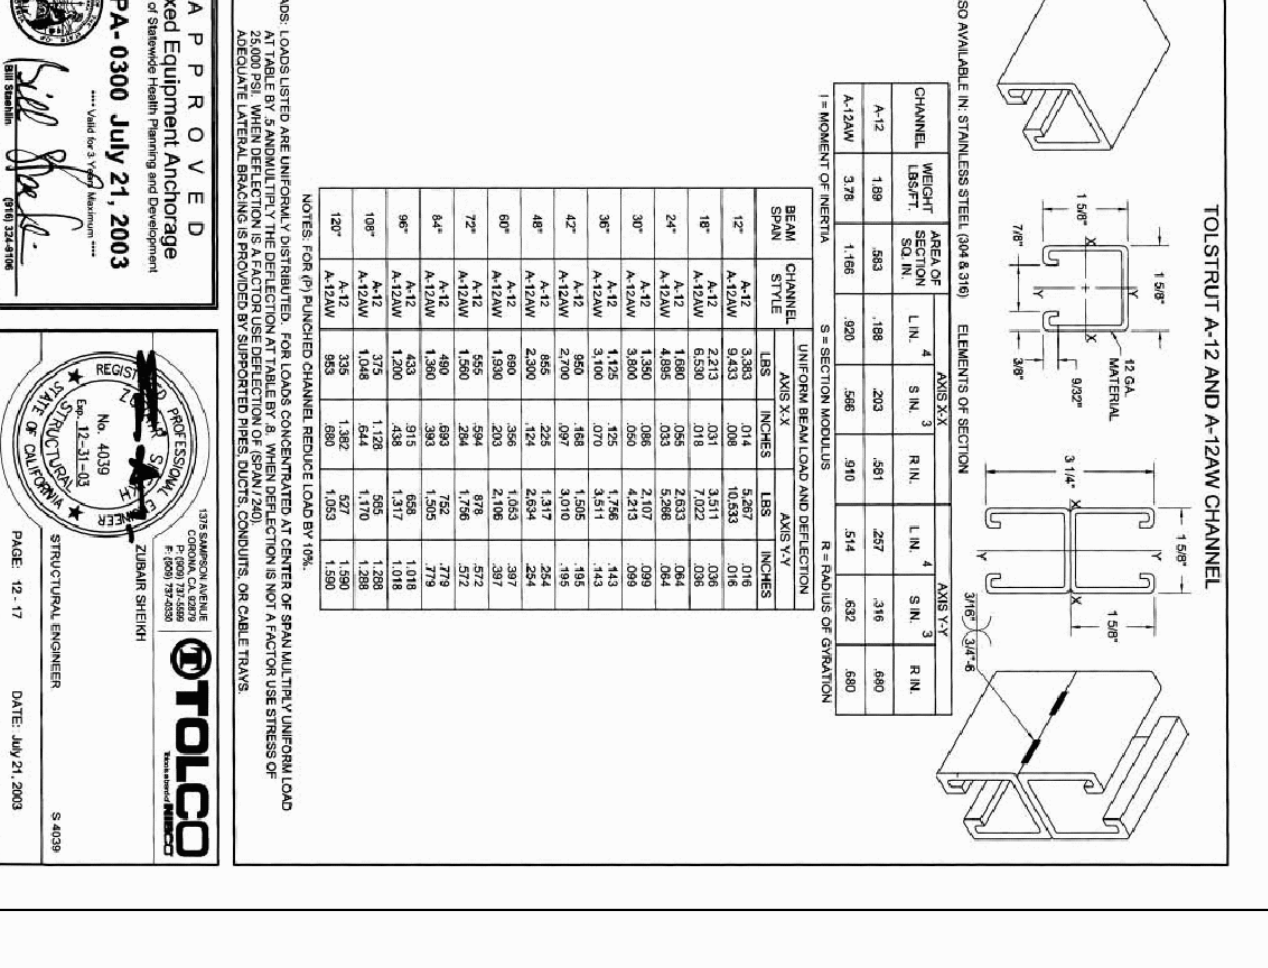


APPROVED
Fixed Equipment Anchorage
OPA-0300 July 21, 2003
DATE: July 21, 2003

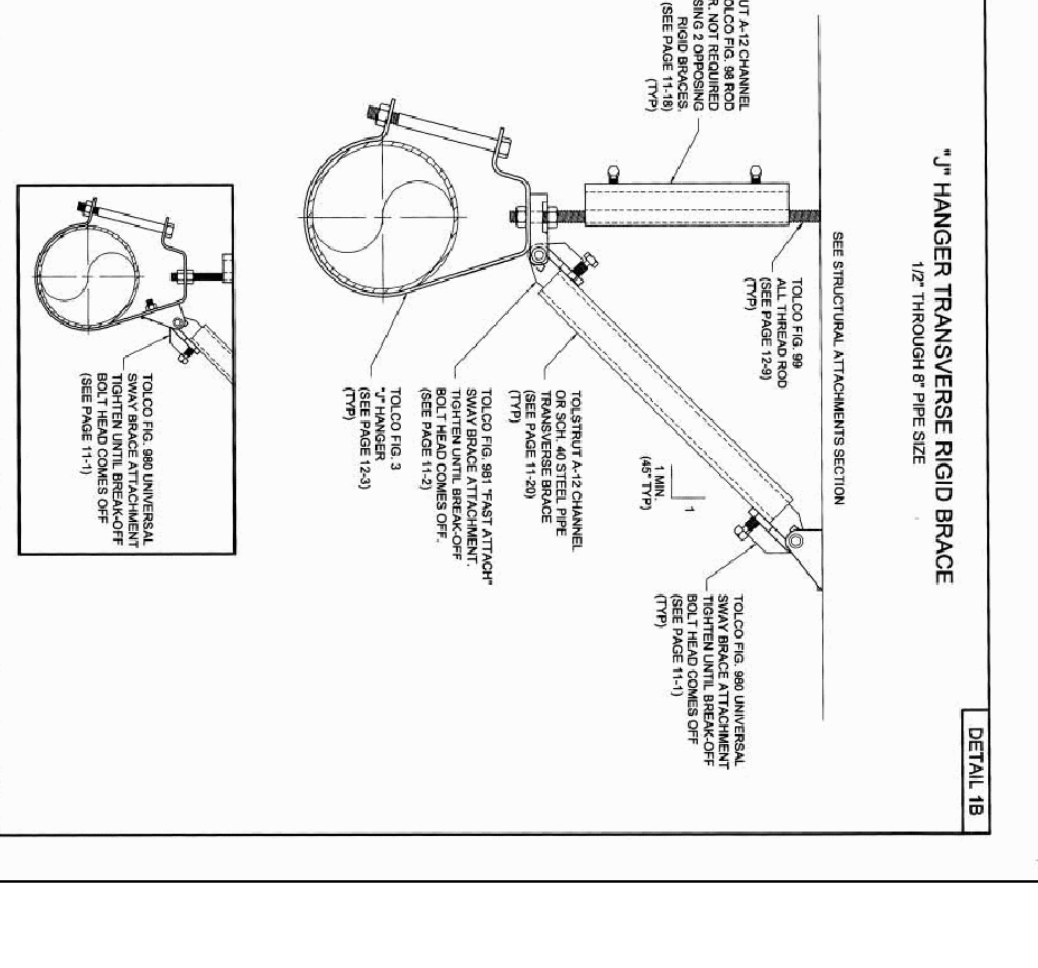


APPROVED
Fixed Equipment Anchorage
OPA-0300 July 21, 2003
DATE: July 21, 2003

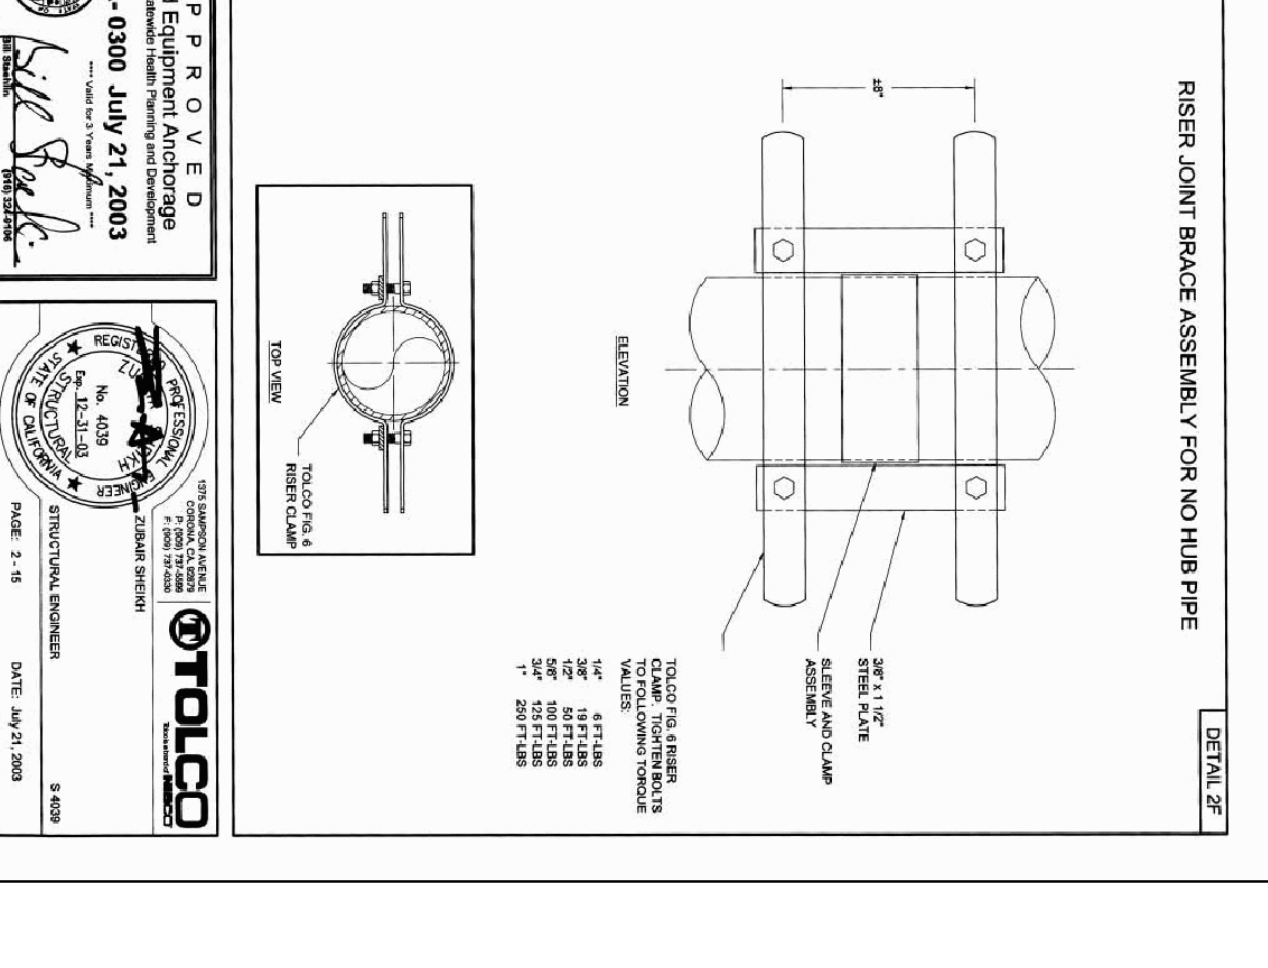


APPROVED
Fixed Equipment Anchorage
OPA-0300 July 21, 2003
DATE: July 21, 2003

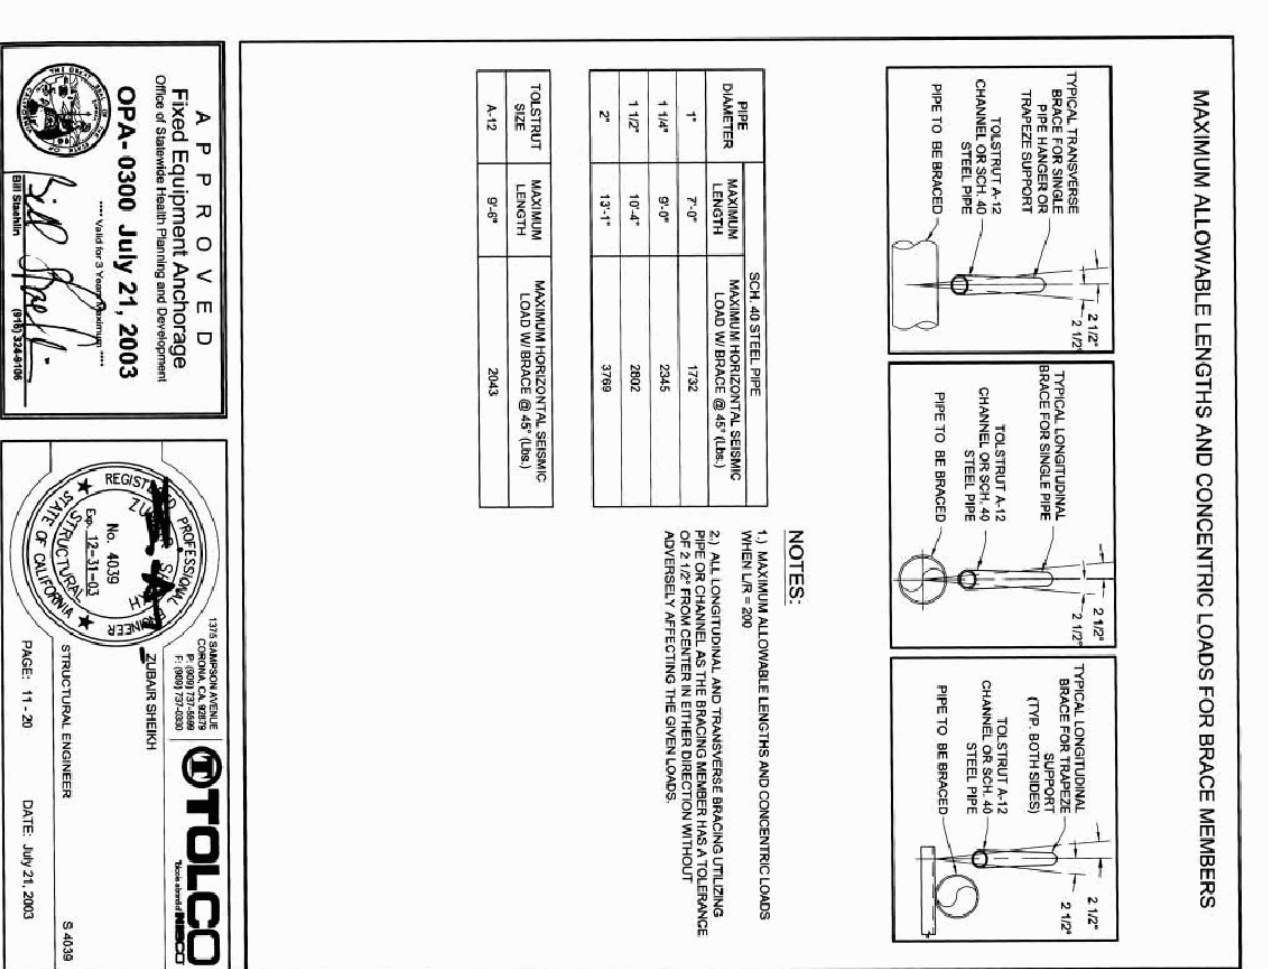


APPROVED
Fixed Equipment Anchorage
OPA-0300 July 21, 2003
DATE: July 21, 2003

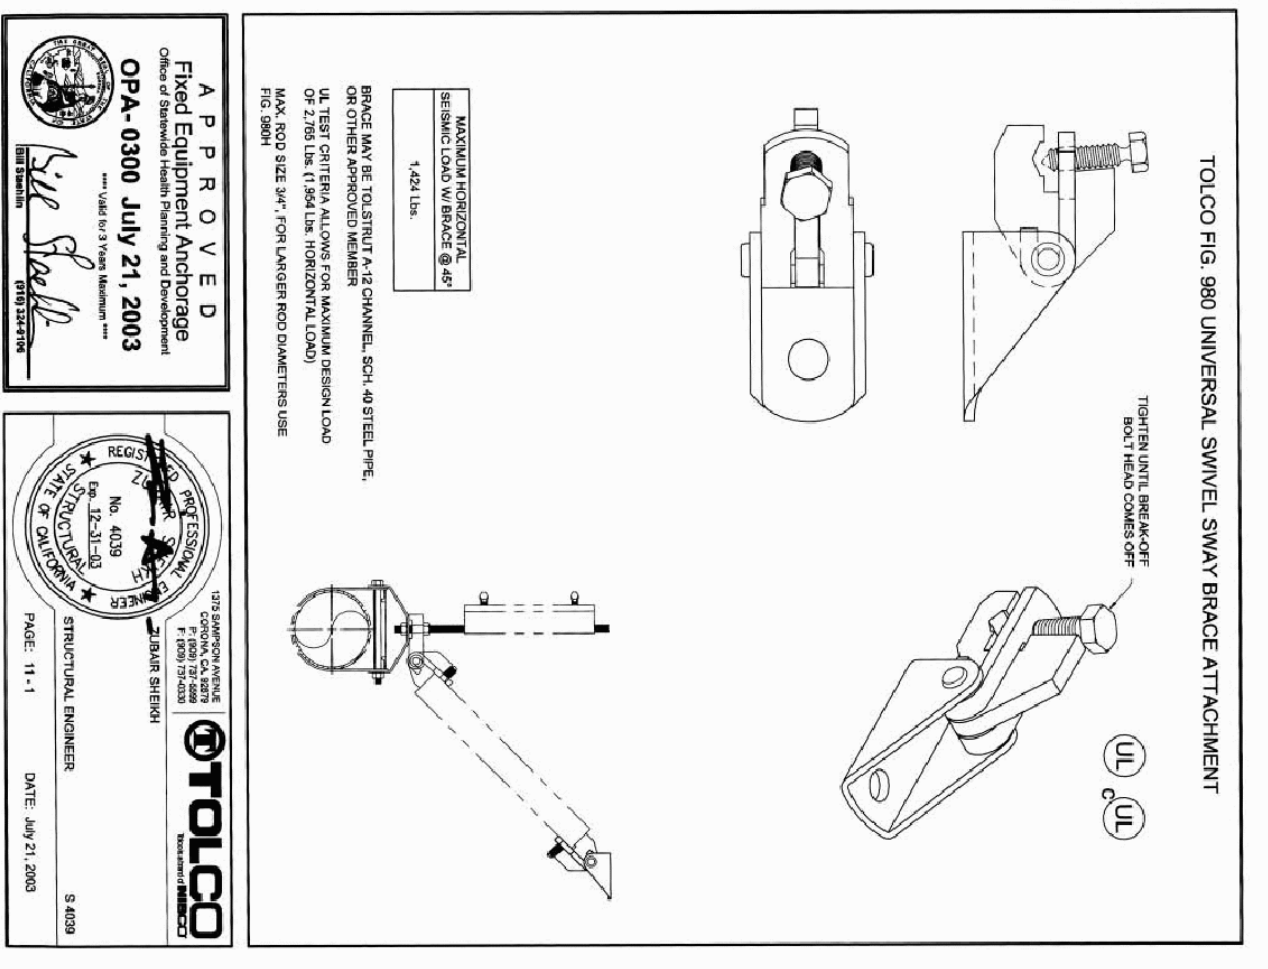


APPROVED
Fixed Equipment Anchorage
OPA-0300 July 21, 2003
DATE: July 21, 2003

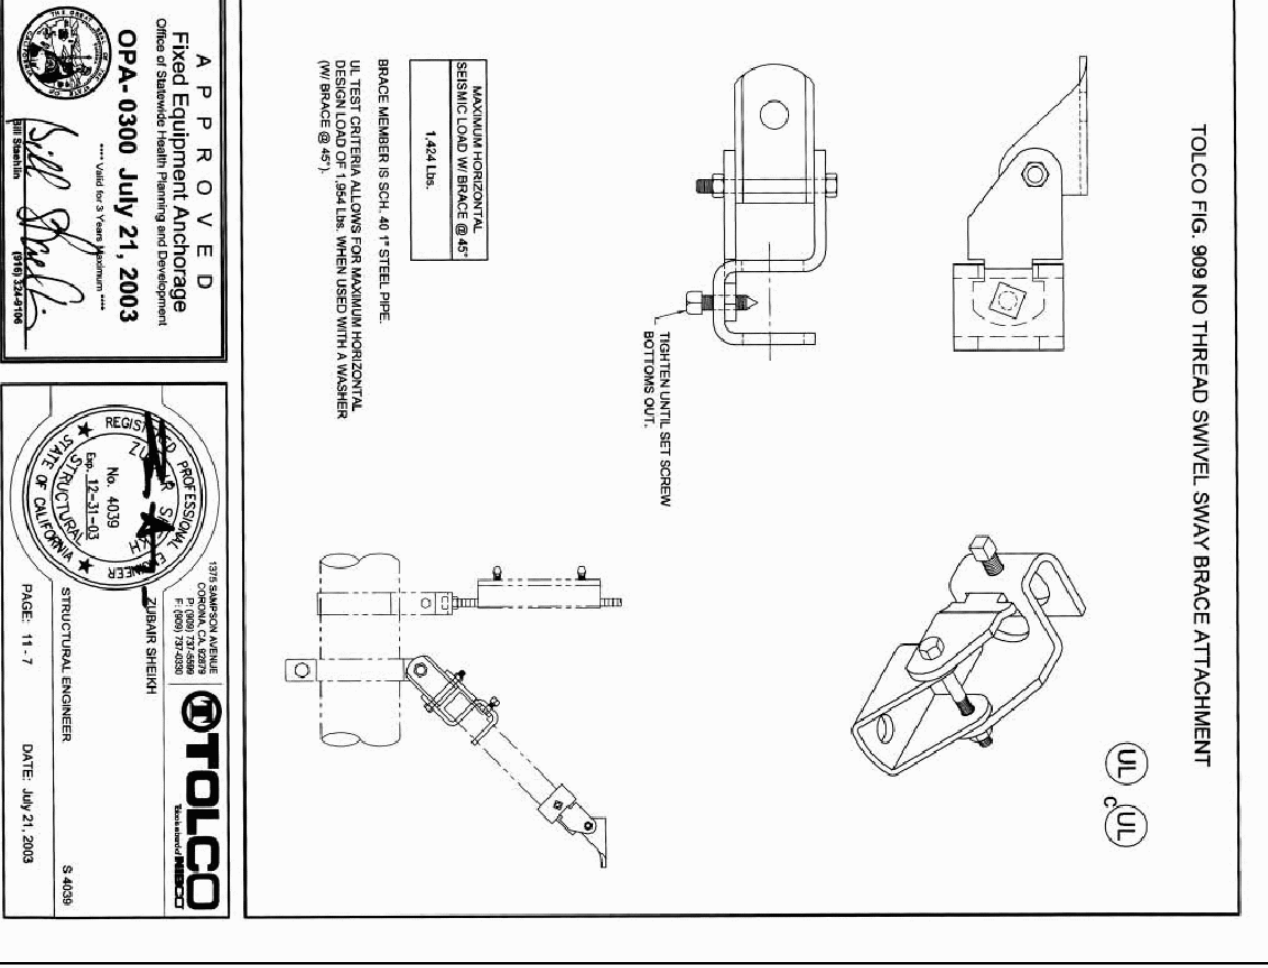


APPROVED
Fixed Equipment Anchorage
OPA-0300 July 21, 2003
DATE: July 21, 2003

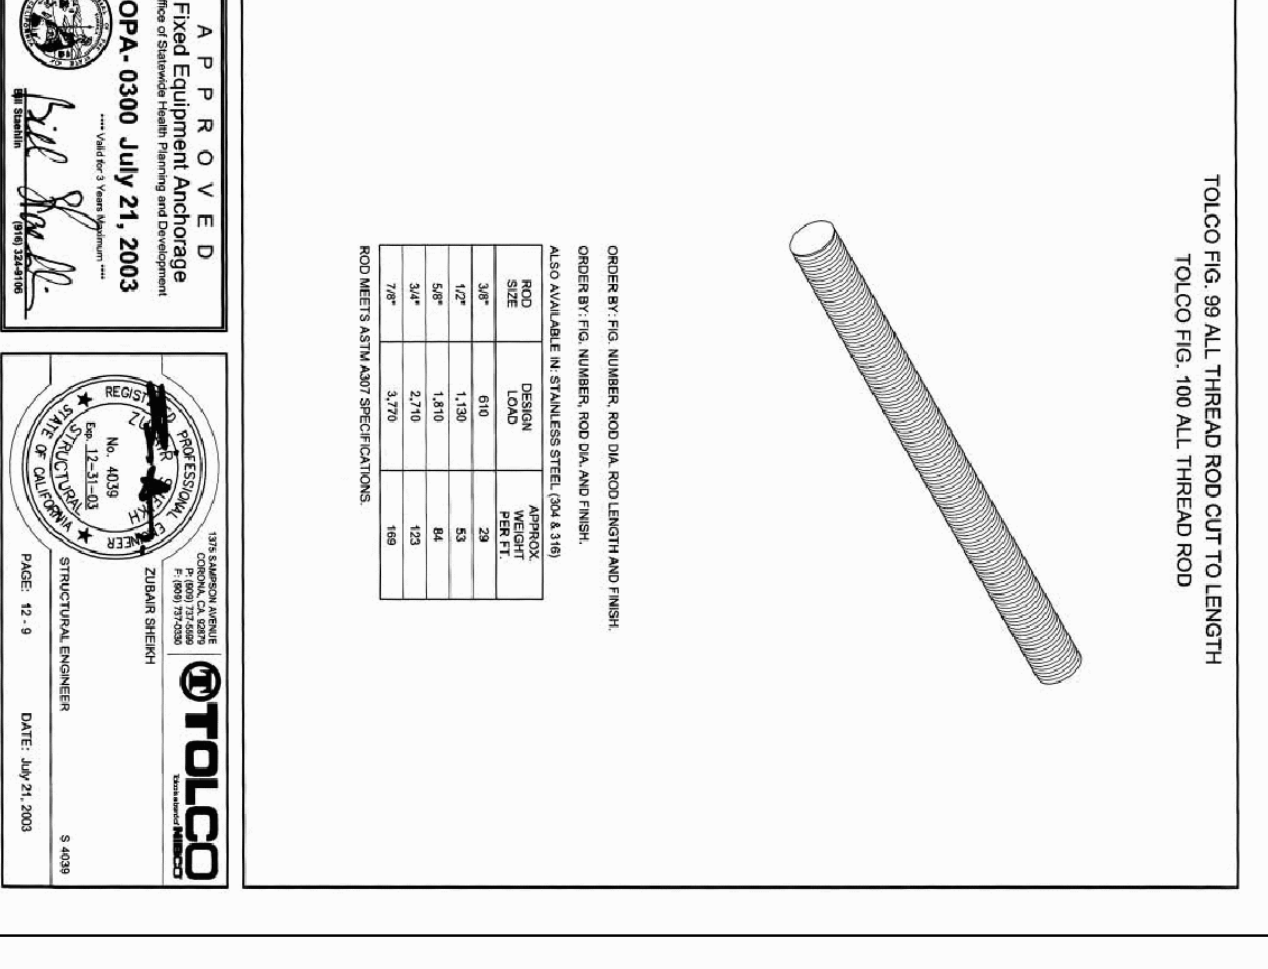


APPROVED
Fixed Equipment Anchorage
OPA-0300 July 21, 2003
DATE: July 21, 2003

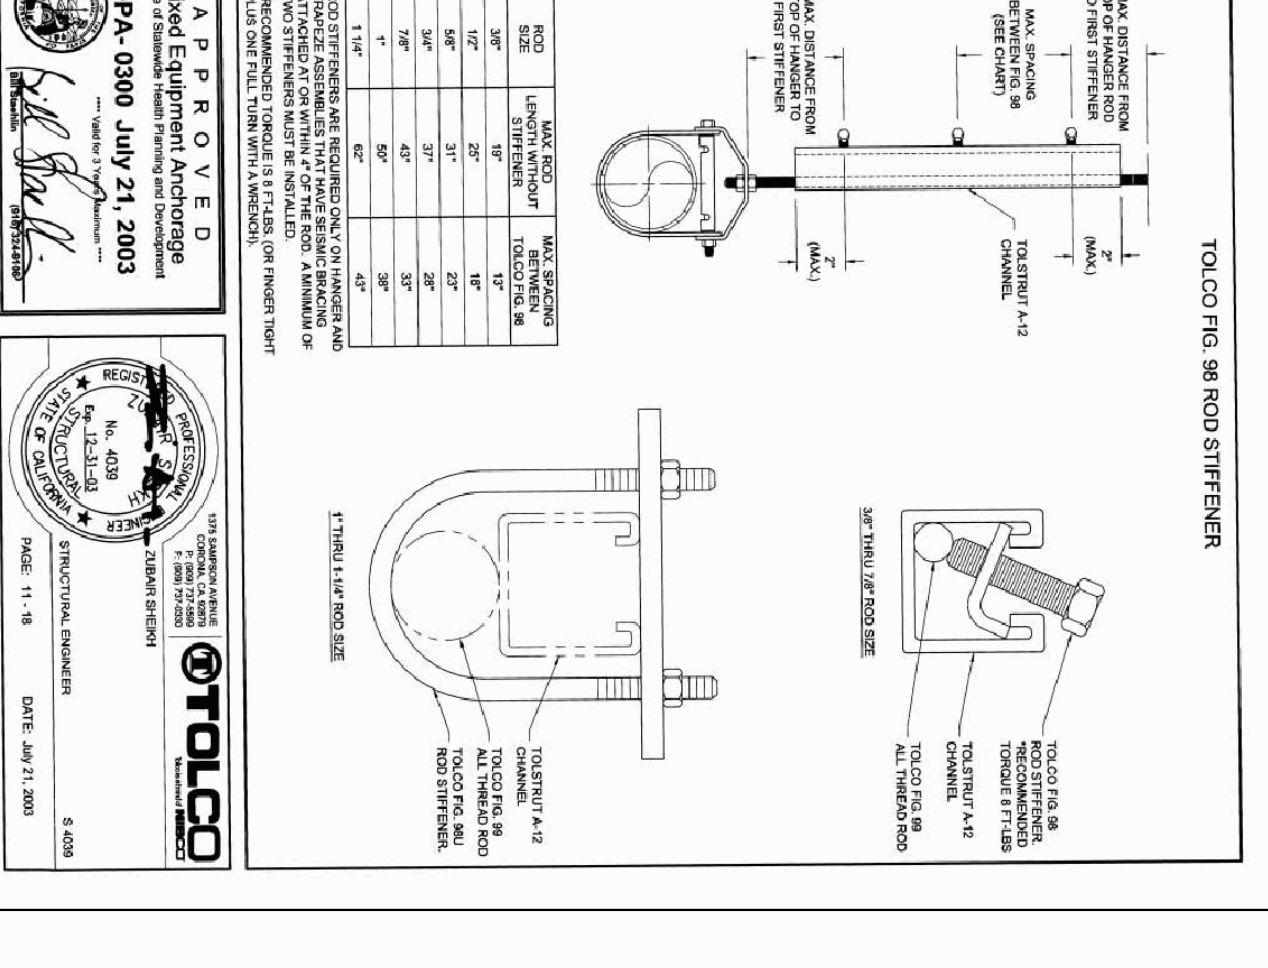


APPROVED
Fixed Equipment Anchorage
OPA-0300 July 21, 2003
DATE: July 21, 2003

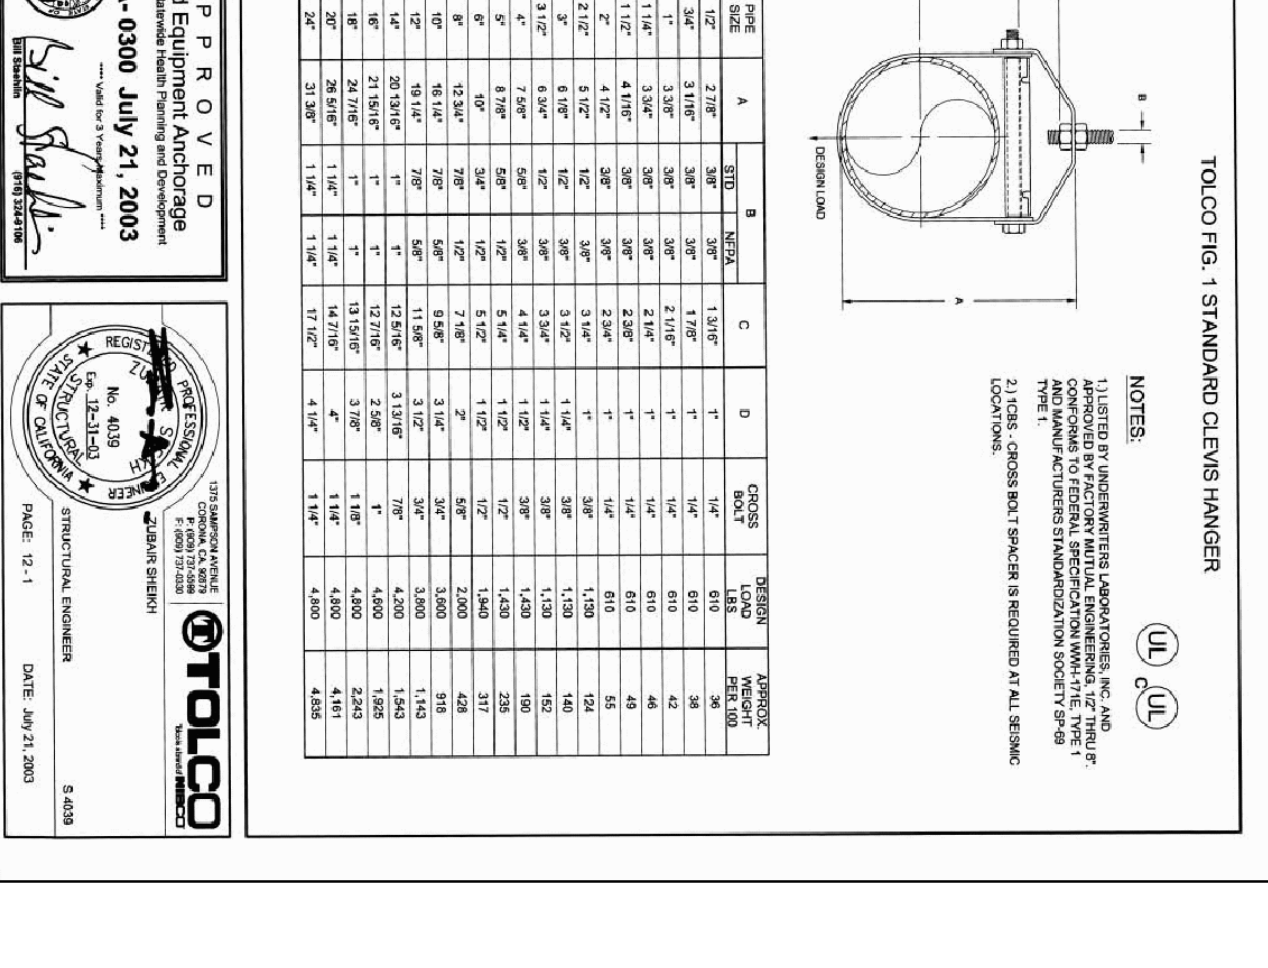


APPROVED
Fixed Equipment Anchorage
OPA-0300 July 21, 2003
DATE: July 21, 2003

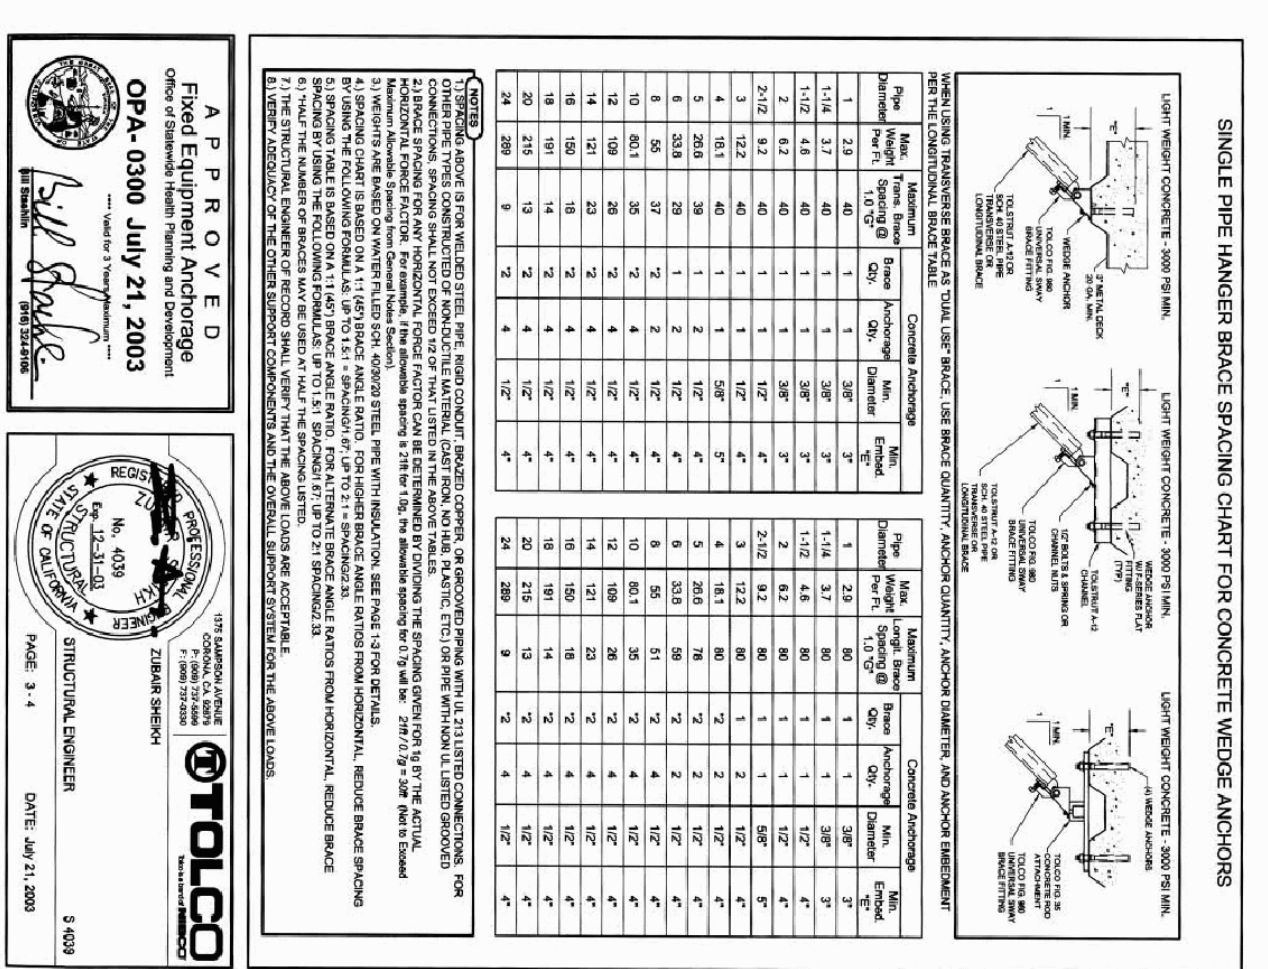


APPROVED
Fixed Equipment Anchorage
OPA-0300 July 21, 2003
DATE: July 21, 2003

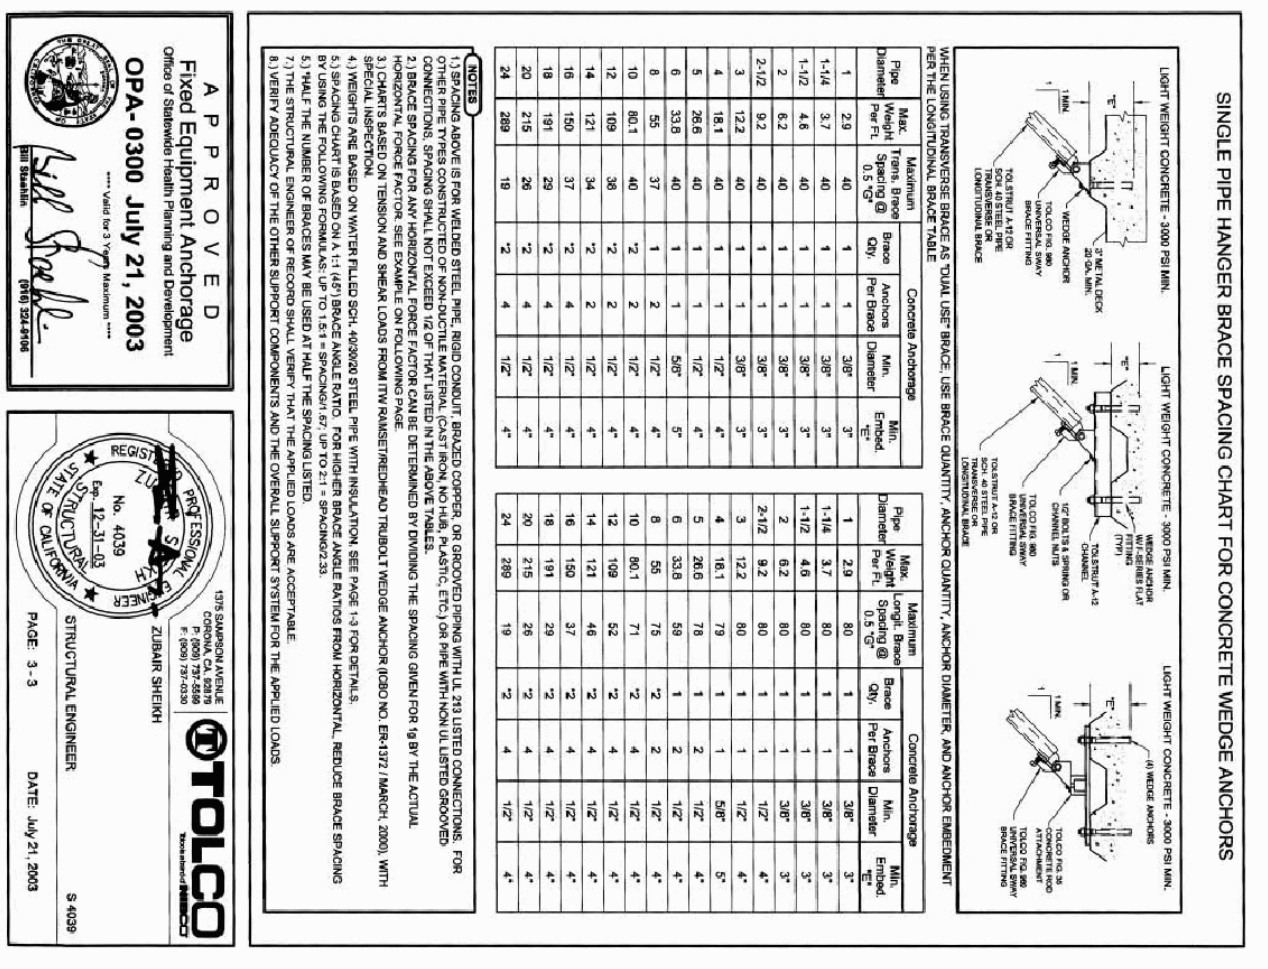


APPROVED
Fixed Equipment Anchorage
OPA-0300 July 21, 2003
DATE: July 21, 2003

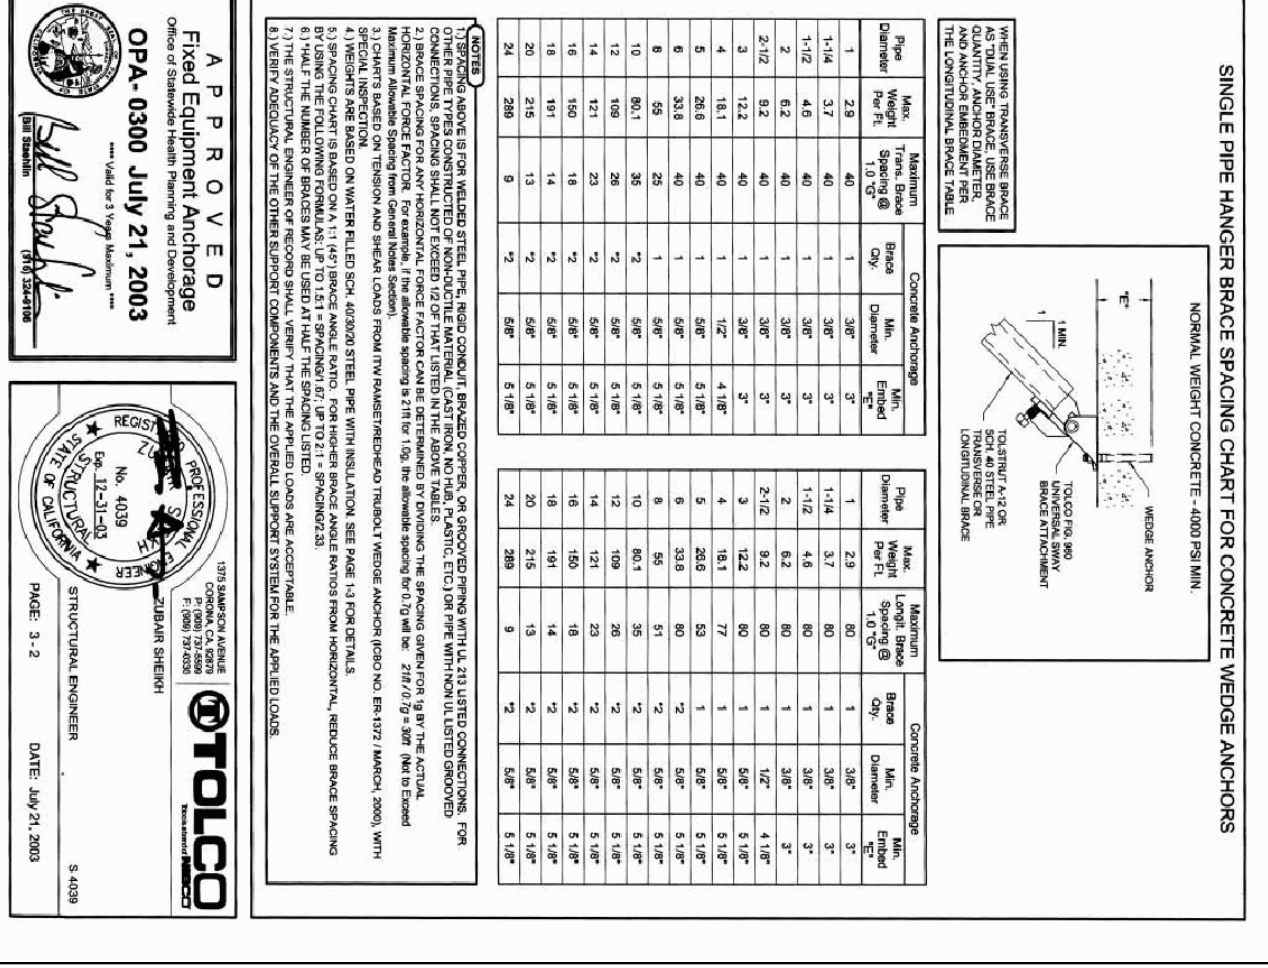


APPROVED
Fixed Equipment Anchorage
OPA-0300 July 21, 2003
DATE: July 21, 2003

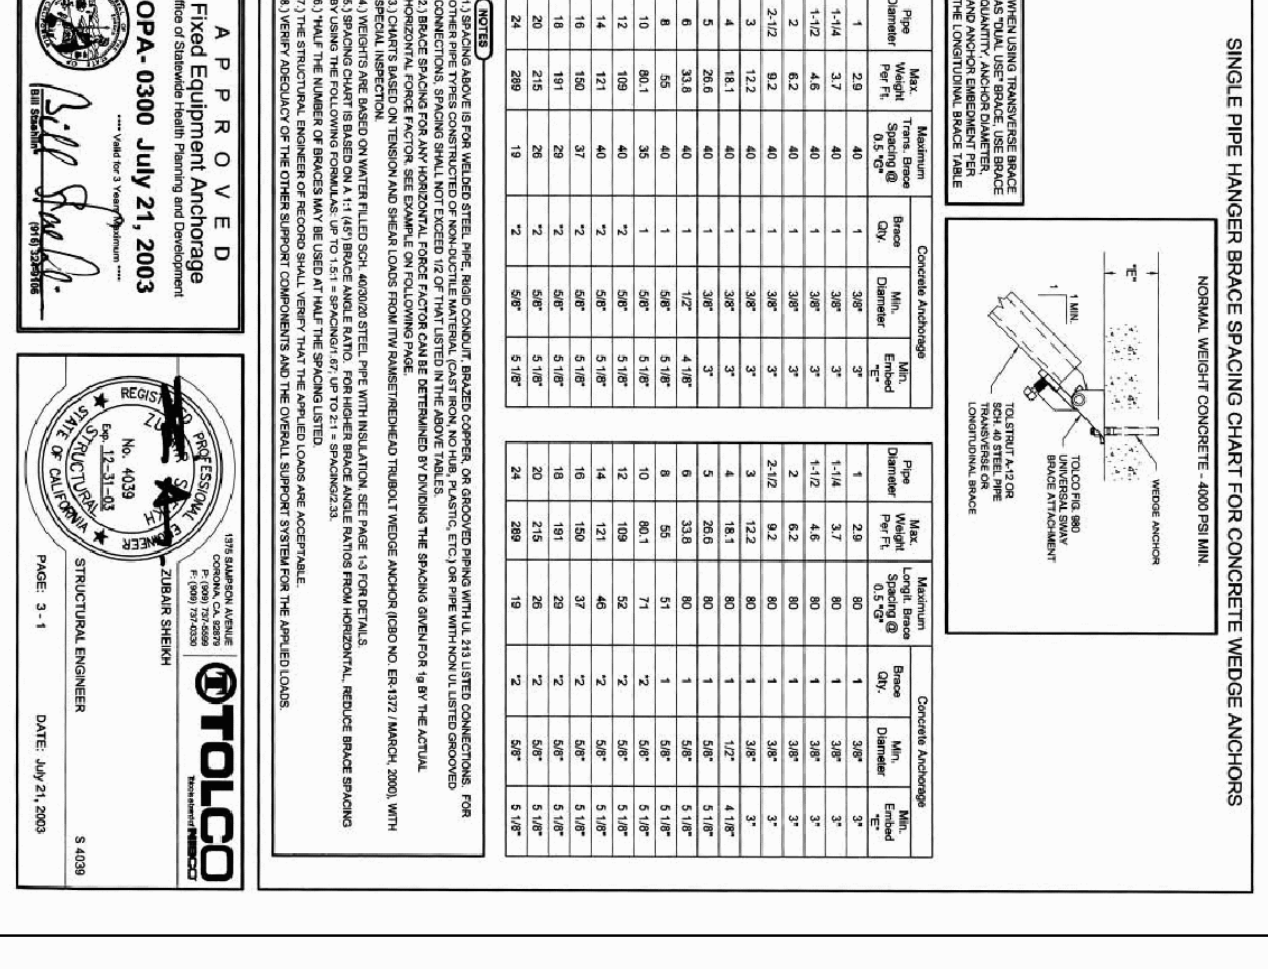

APPROVED
Fixed Equipment Anchorage
OPA-0300 July 21, 2003
DATE: July 21, 2003

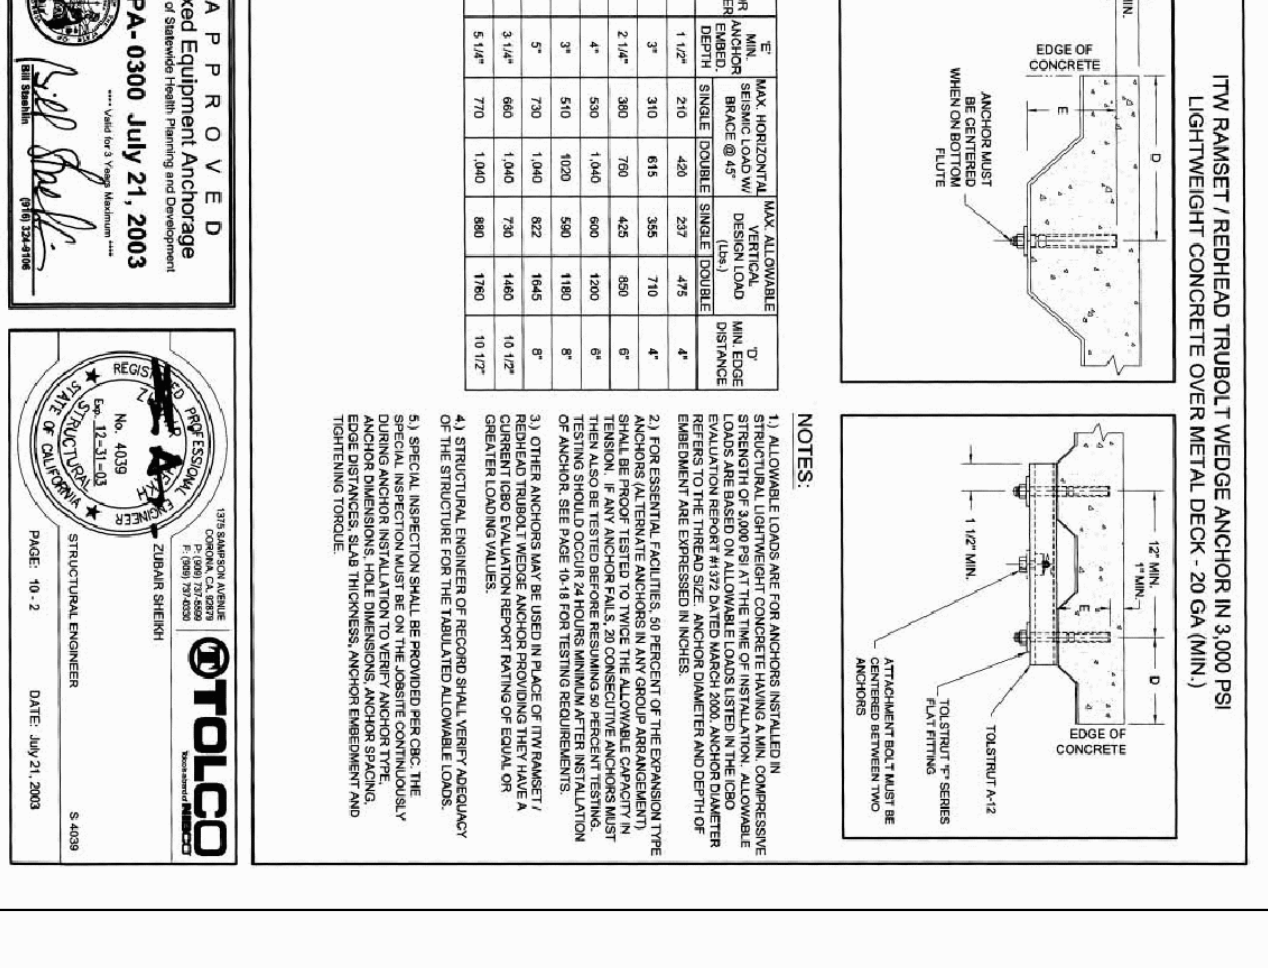

APPROVED
Fixed Equipment Anchorage
OPA-0300 July 21, 2003
DATE: July 21, 2003

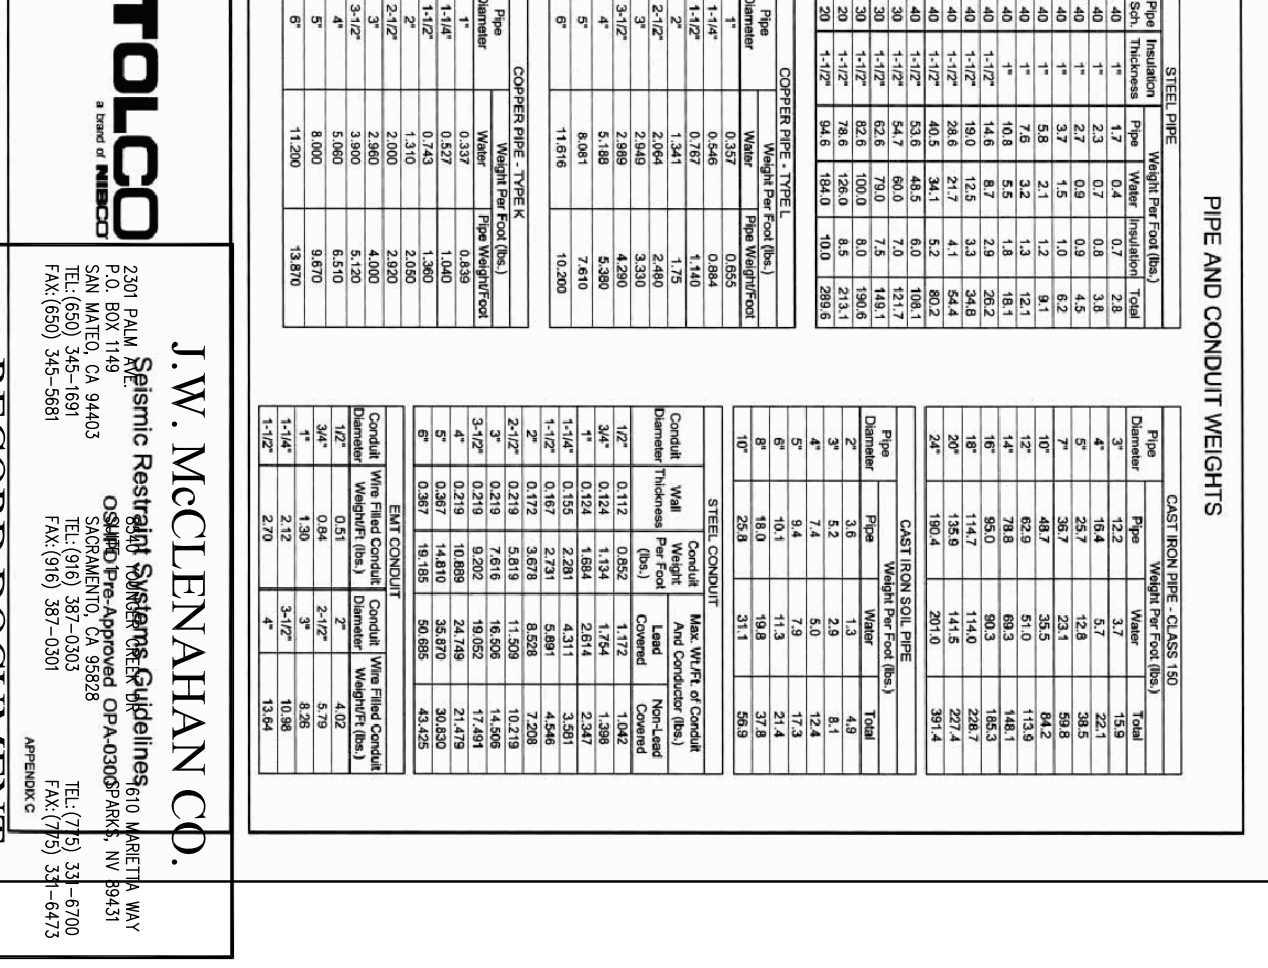

APPROVED
Fixed Equipment Anchorage
OPA-0300 July 21, 2003
DATE: July 21, 2003

McCarthy Building Companies, Inc.
343 Serrano Ave., Suite 148, Redwood City, CA 94061
P 415 397-5151
F 415 397-5999

REGISTERED PROFESSIONAL ENGINEER
No. W28982
Exp. 6/30/10
OFFICE: 01-110095
FILE NUMBER: 41-C1

J.W. McCLENNAN CO.

College of San Mateo Building 10N
San Mateo, CA
Developed for San Mateo County Community College District

J.W. McCLENNAN CO.

RECORD DOCUMENT
DATE: October 15, 2010

Plumbing Details
P9.01

Revision	Description	Date
08	100% Design Development	08/09/08

JOE NO. 2708227
DRAWN BY: MARY BOON
CHECKED BY: SCJ
SCALE: NRC

