


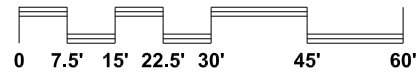
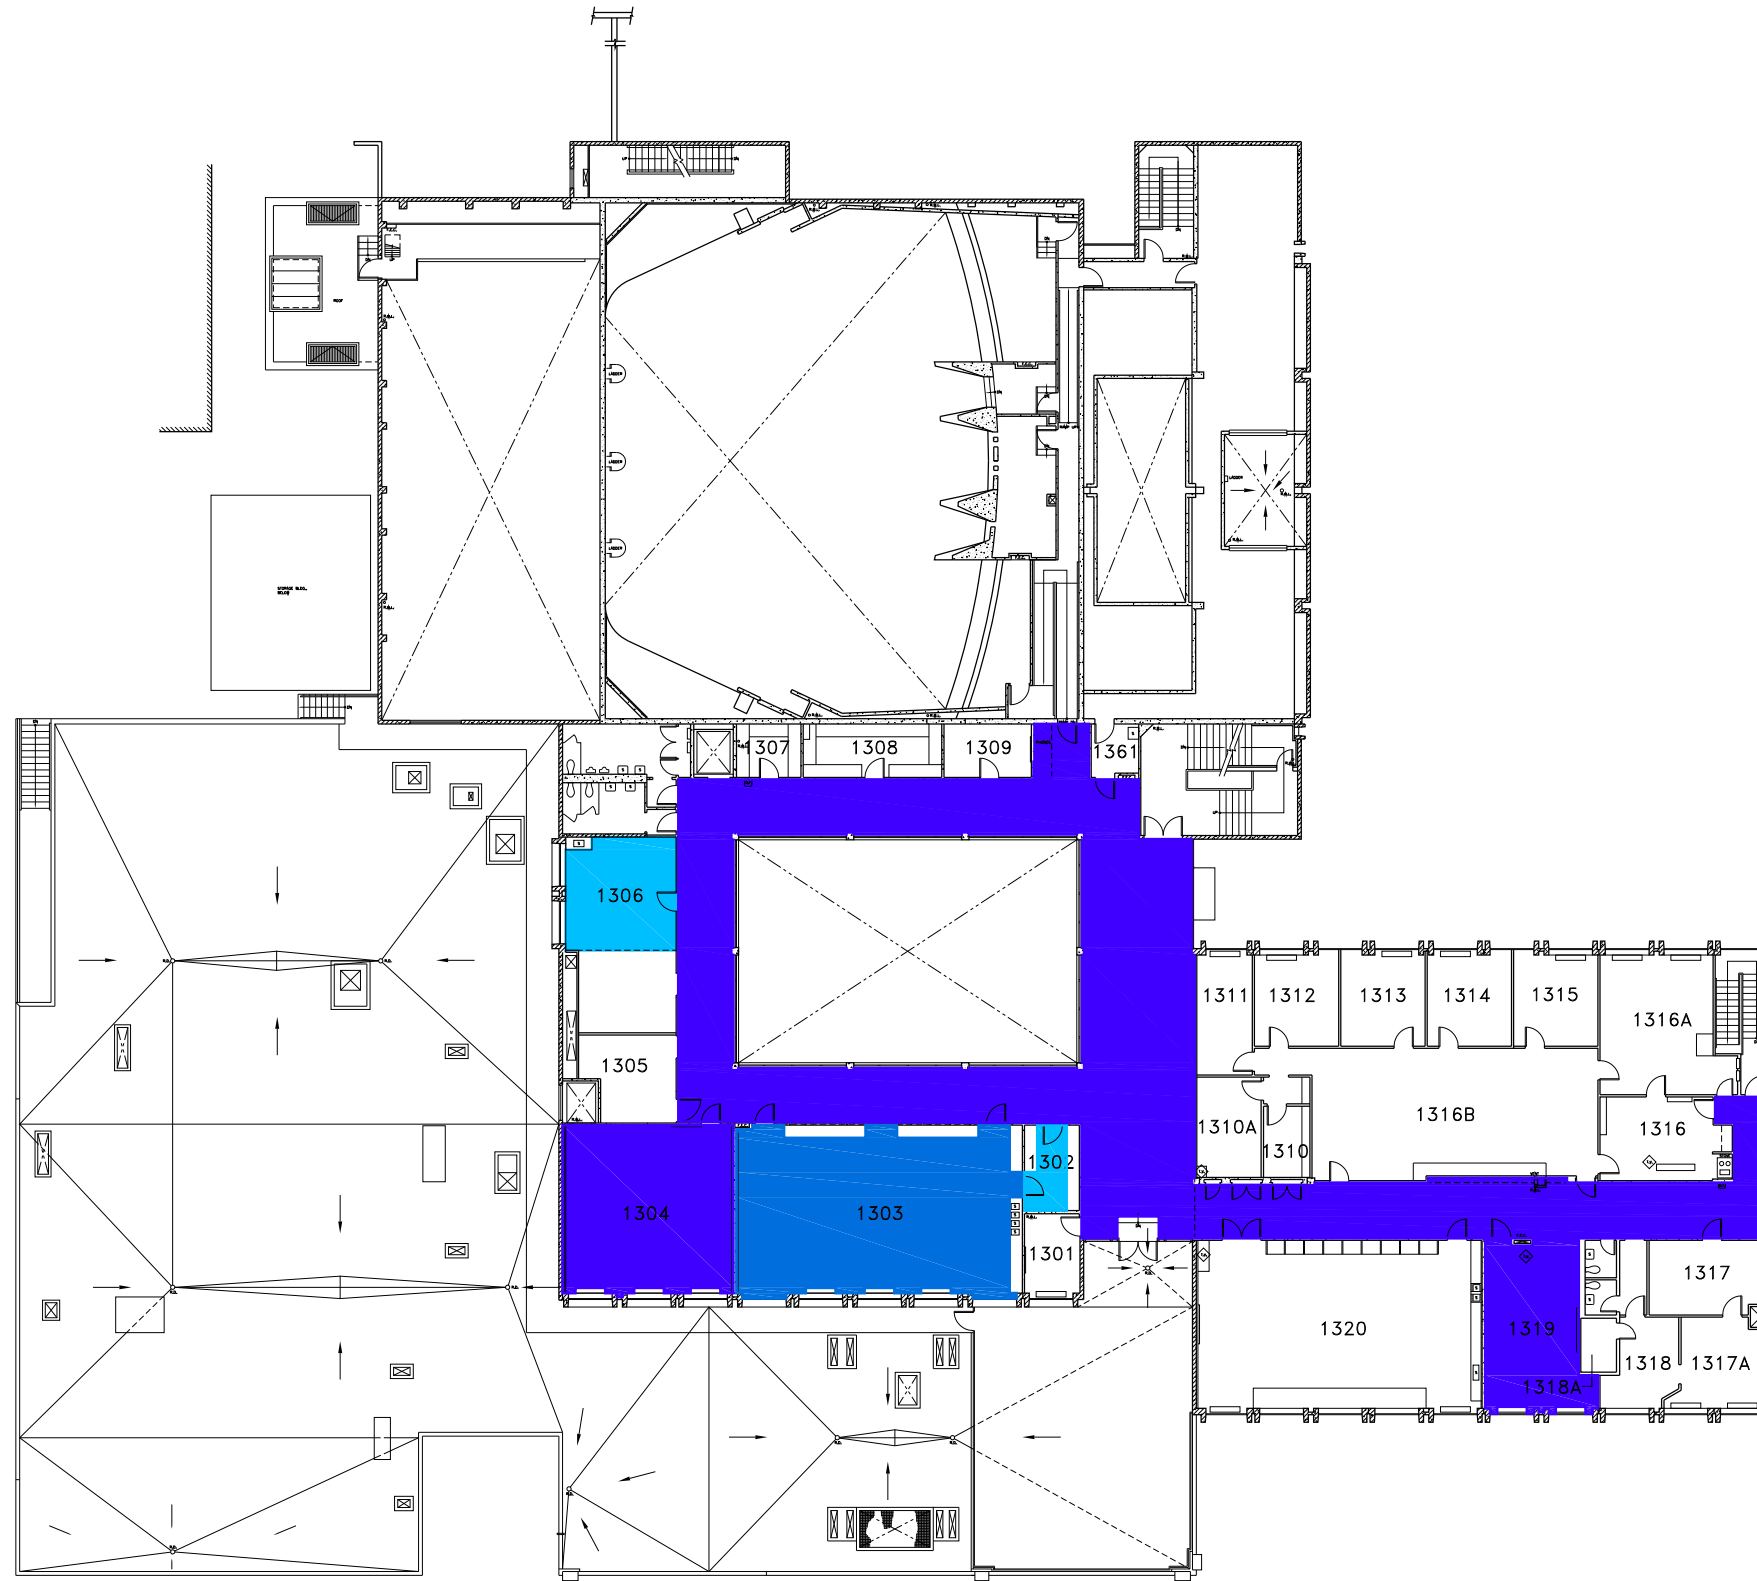
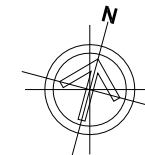


**Legend:**

-  CEILING CLEARED
-  CEILING CLEARED  
WALLS PAINTED
-  CEILING CLEARED  
FLOOR REPLACED  
WALLS PAINTED



THIRD FLOOR - FINE ARTS CENTER



**Skyline Community College - Building 1, Third Floor**  
**Field Survey of (E) Modifications - Sheet 3/3**  
**4/07/08**