


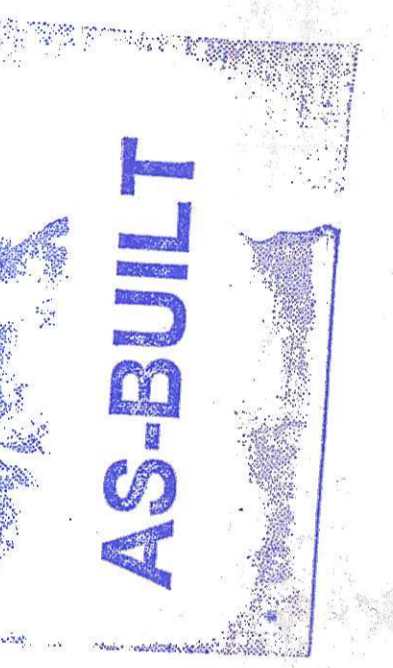


1 THIRD FLOOR LIGHTING PLAN
 1/8" = 1'-0"

2045
 A1-93
 EM 12-12
 EM A-20
 D-12
 142/200

1
 5
 11
 14
 16
 18
 20



exit sign
 RFI-152
 Rm-7302
 7310
 7320

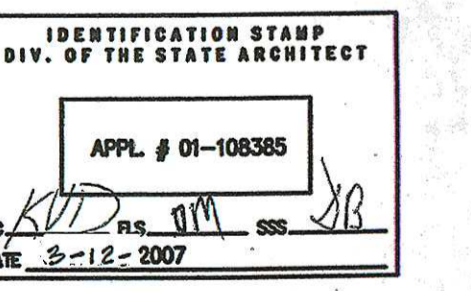

rev.	date	issue
02.27.07		DSA BACK CHECK
11.02.06		DSA SUBMITTAL
10.13.06		75% CD
09.12.06		40% PROGRESS

- SHEET NOTES**
- 1 PROVIDE AN ADDITIONAL UNSWITCHED HOT WIRE TO THE FIXTURE BATTERY PACK FOR VOLTAGE SENSING.
 - 2 ALL CIRCUITS SHALL BE CONNECTED TO PANEL "7L1" U.O.N.
 - 3 EXISTING CONDUIT IN STAIRWELL MAYBE REUSED AND EXTENDED TO NEW FIXTURE LOCATIONS SHOWN.

key plan

3rd FLOOR LIGHTS

STEINBERG ARCHITECTS

project no: 06015 date: 02.27.07
 MAMP VB
 1/8" = 1'-0" f . f . f
 THIRD FLOOR PLAN