Copyright 2005 Steinberg Architects All Rights Reserved - These Plans and/or Specifications are intended for the sole benefit of Steinberg Architect's client and may not be used, reused, copied, or reproduced in any form without the express written consent of Steinberg Architects.

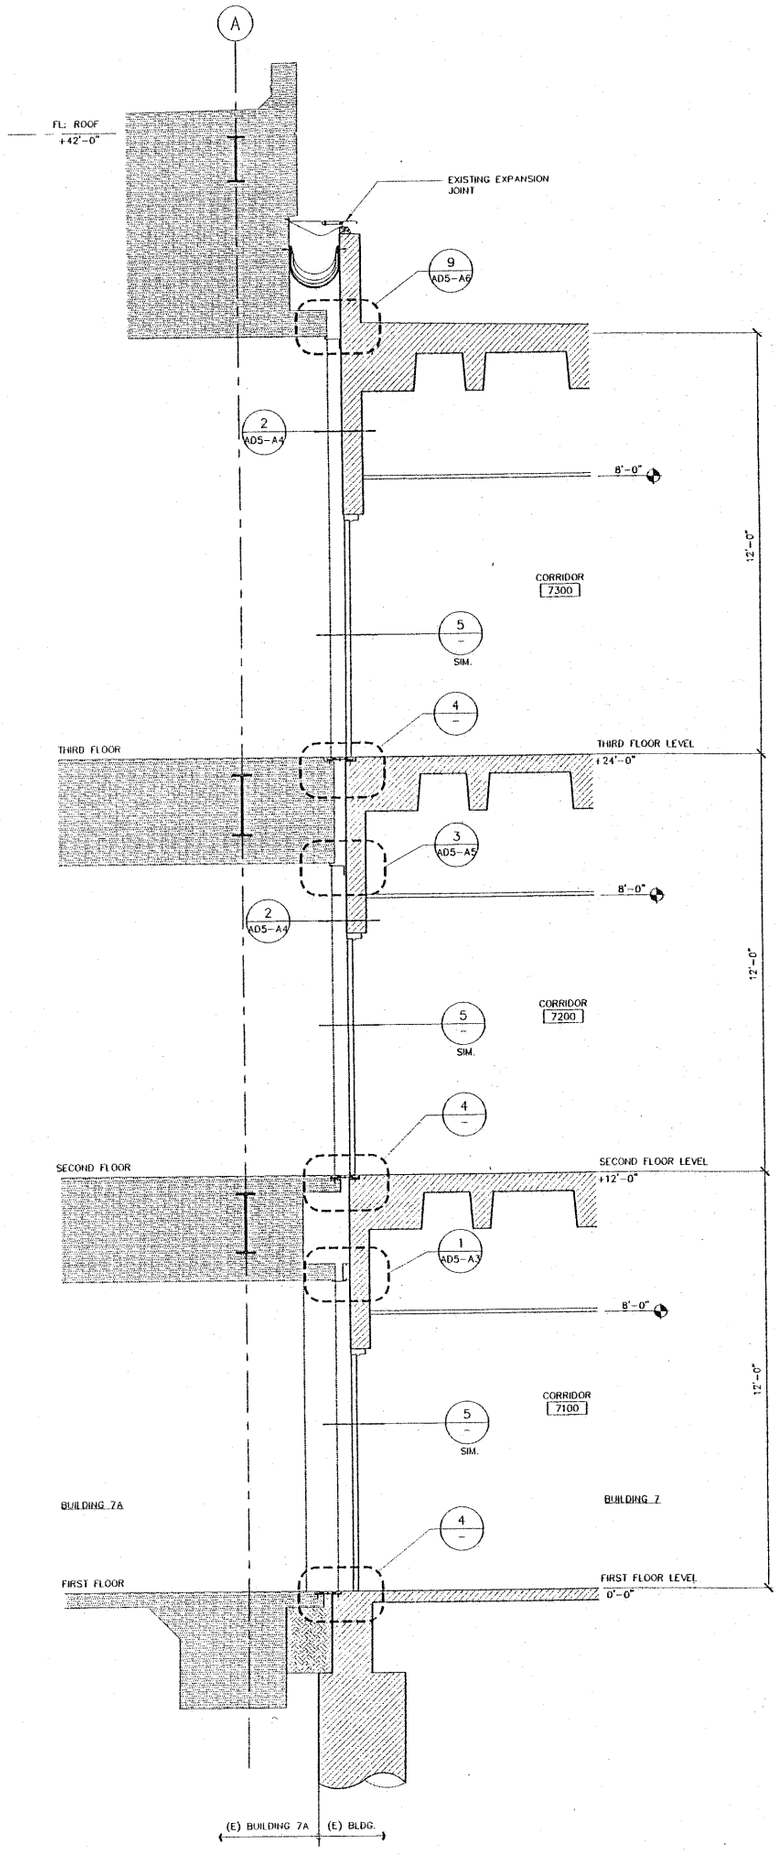

20 WALL SECTION

LICENSED ARCHITECT
ERNEST T. YAMANE
No. C 13447
REN. 12-31-07
STATE OF CALIFORNIA

STEINBERGARCHITECTS

project no:	06015	date:	5-25-07
drawn by:	RS	checked by:	
scale:	—	ref:	A8.01

WALL SECTION

AD5-A7

rev.	date	issue
AD05	5-25-07	

architect
Steinberg Architects
60 Pierce Avenue
San Jose CA 95110

SKYLINE COLLEGE
MODERNIZATION OF BUILDING 7
3300 College Drive, San Bruno CA
DSA File No. 41-C1/Appl. No. 01-108385

San Mateo Community College District
3401 CSM Drive
San Mateo CA