

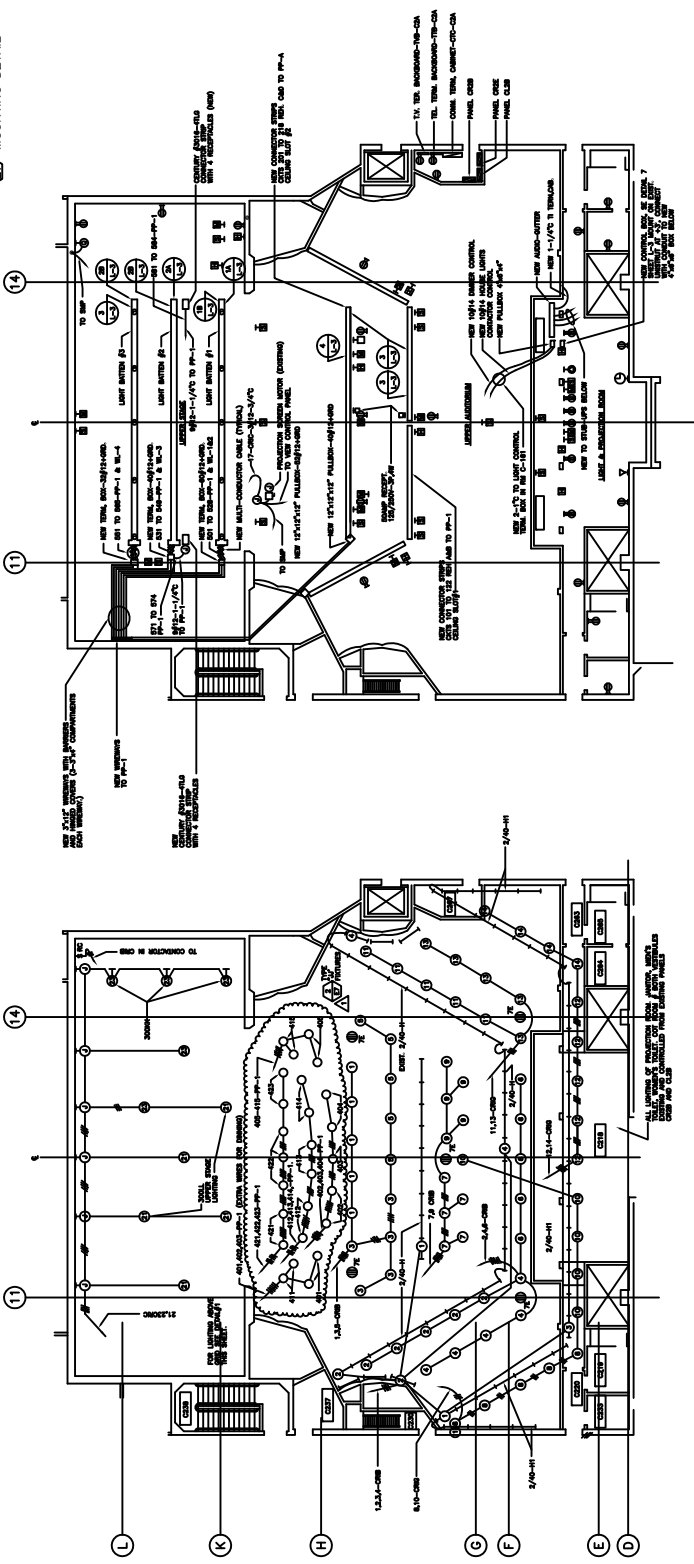




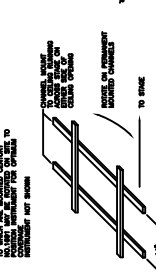


SECOND FLOOR PLAN-LIGHTING MISCELLANEOUS BUILDING "C" SCALE 1/8"=1'-0"

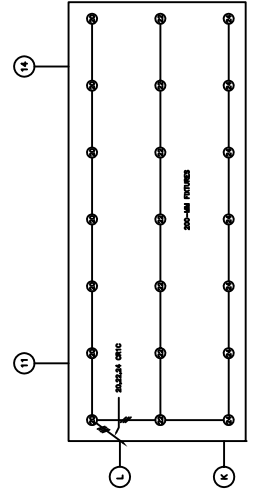

STAGE LIGHTING ABOVE GRID SCALE 1/8"=1'-0"

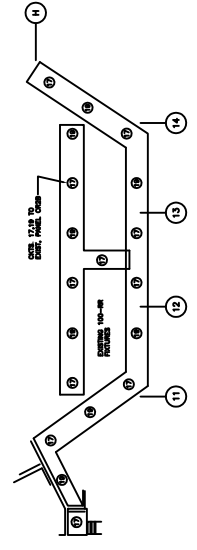

EXISTING PLAN OF CATWALK SCALE 1/8"=1'-0"

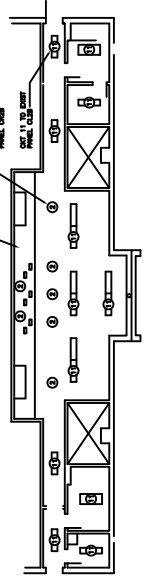

EXISTING SECOND FLOOR PLAN LIGHT & PROJECTION ROOM-LIGHTING SCALE 1/8"=1'-0"