



DEMOLITION SYMBOLS

- 1 TO BE REMOVED
- 2 TO REMAIN, PROTECT IN PLACE
- 3 TO BE RELOCATED. SALVAGED ITEMS TO BE STORED & INSTALLED UNDER DIRECTION OF ENGINEER.
- 4 ADJUST TO GRADE
- 5 GRIND OFF EXISTING STRIPING & PAVEMENT MARKINGS. SEE HORIZONTAL CONTROL SHEETS 4.01 TO 4.18 FOR PROPOSED STRIPING & PAVEMENT MARKINGS.
- 6 TO REMAIN, PROTECT IN PLACE. INSTALL BOLT-ON COVER.
- 7 TO BE REMOVED & RETURNED TO COLLEGE.

DEMOLITION LEGEND

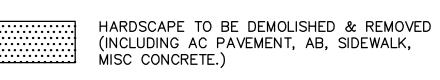

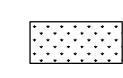

LANDSCAPE TO BE REMOVED

EXISTING UTILITY TO BE DEMOLISHED & REMOVED

""" EXISTING CURB TO BE DEMOLISHED & REMOVED

- - - - SAWCUT LINE

RECORD DRAWINGS

THESE RECORD DOCUMENTS HAVE BEEN PREPARED BASED ON INFORMATION

PROVIDED BY OTHERS. BKF ENGINEERS HAS NOT VERIFIED THE ACCURACY

INCORPORATED HEREIN AS A RESULT. BKF ENGINEERS DOES NOT ASSUME

DATE: JUNE 2011

AND/OR COMPLETENESS OF THIS INFORMATION AND SHALL NOT BE

ANY RESPONSIBILITY FOR THE FIELD MODIFICATIONS TO THE PLANS.

RESPONSIBLE FOR ANY ERRORS OR OMISSIONS THAT MAY BE

BY: BKF ENGINEERS

LIMITS OF DEMOLITION



Job. No. 02 APRIL 2009 Drawn by MD, JT 1"=20' **DEMOLITION** PLAN C3.02

McCarthy Building Companies, Inc. 343 Sansome Street, 14th Floor San Francisco, California 94104

255 SHORELINE DRIVE, SUITE 200 REDWOOD CITY, CA 94065 PHONE: (650) 482-6300 FAX: (650) 482-6399

No. C043971

IDENTIFICATION STAMP DIV. OF THE STATE ARCHITECT OFFICE OF REGULATION SERVICE

This and all other project documents and all ideas, aesthetics and designs incorporated therein are instruments of service. All project documents are the registered property of LPA, INC. (LPA) and cannot be lawfully used in whole or in part for any project or purpose except as described in the contractual agreement between McCarthy and the District. LPA hereby gives formal notice that any such project document use, reproduction or modification (misuse) is not only unlawful but automatically binds all parties involved with misuse to fully indemnify and defend LPA and LPA's Consultants to the maximum legal extent against all losses, demands, claims or liabilities arising directly or indirectly from project document misuse. Project documents describe design intent of work and are not a representation of as-built or existing conditions.


are not a representation of as—built or existing conditions.

LPA and LPA's Consultants make no representations concerning
the accuracy of documents and are not responsible for any
discrepancies between project documents and the existing
conditions.

APPL. #: 01-110097

FILE NUMBER:

P 415 | 364-1339 F 415 | 397-5999

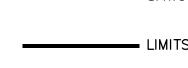

TREE TO BE REMOVED

