

RECORD DRAWINGS

THESE RECORD DOCUMENTS HAVE BEEN PREPARED BASED ON INFORMATION PROVIDED BY OTHERS. BKF ENGINEERS HAS NOT VERIFIED THE ACCURACY

INCORPORATED HEREIN AS A RESULT. BKF ENGINEERS DOES NOT ASSUME

DATE: JUNE 2011

AND/OR COMPLETENESS OF THIS INFORMATION AND SHALL NOT BE RESPONSIBLE FOR ANY ERRORS OR OMISSIONS THAT MAY BE


ANY RESPONSIBILITY FOR THE FIELD MODIFICATIONS TO THE PLANS.

BY: BKF ENGINEERS

McCarthy Building Companies, In 343 Sansome Street, 14th Floor San Francisco, California 94104 P 415 | 364-1339 F 415 | 397-5999





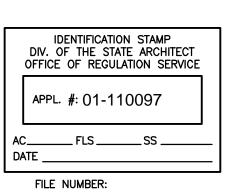



This and all other project documents and all ideas, aesthetics and designs incorporated therein are instruments of service. All project documents are the registered property of LPA, INC. (LPA) and cannot be lowfully used in whole or in part for any project or purpose except as described in the contractual agreement between McCarthy and the District. LPA hereby gives formal notice that any such project document use, reproduction or modification (misuse) is not only unlawful but automatically binds all parties involved with misuse to fully indemnify and defend LPA and LPA's Consultants to the maximum legal extent against all losses, demands, claims or liabilities arising directly or indirectly from project document misuse. Project documents describe design intent of work and are not a representation of as-built or existing conditions. LPA and LPA's Consultants make no representations concerning the accuracy of documents and are not responsible for any discrepancies between project documents and the existing conditions.

© Copyright 2008

Site Package ADD ALT #7-Gateway Elevator
San Mateo, CA

Developed for
San Mateo County Community College District

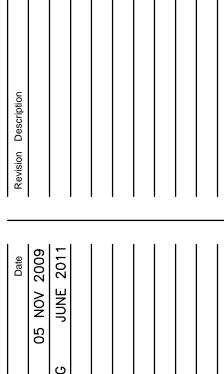

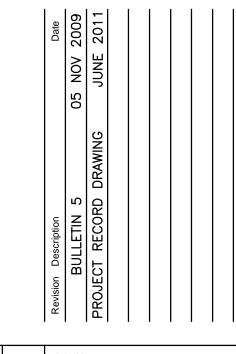

	Job. No.	27082.30
4	Date	02 July 2009
	Drawn by	MD, JT
	Checked by	RH
T	Scale	1"=20'
Z0	GRADING	
10	DRAINAGE	PLAN
- - 0		<u></u>
	20	Date Drawn by Checked by Scale GRADING DRAINAGE