

NOTES

1. SEE SHEETS C8.03 THROUGH C8.05 FOR UTILITY DETAILS.

RECORD DRAWINGS

THESE RECORD DOCUMENTS HAVE BEEN PREPARED BASED ON INFORMATION PROVIDED BY OTHERS. BKF ENGINEERS HAS NOT VERIFIED THE ACCURACY AND/OR COMPLETENESS OF THIS INFORMATION AND SHALL NOT BE RESPONSIBLE FOR ANY ERRORS OR OMISSIONS THAT MAY BE INCORPORATED HEREIN AS A RESULT. BKF ENGINEERS DOES NOT ASSUME


BY: BKF ENGINEERS DATE: JUNE 2011


ANY RESPONSIBILITY FOR THE FIELD MODIFICATIONS TO THE PLANS.

McCarthy Building Companies, Inc.
343 Sansome Street, 14th Floor
San Francisco, California 94104
P 415 | 364-1339
F 415 | 397-5999






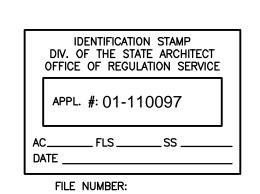

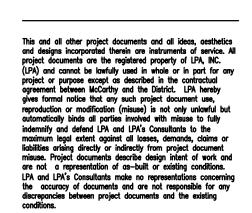

© Copyright 2008

Site Package
San Mateo, CA
Developed for
San Mateo County Community College District

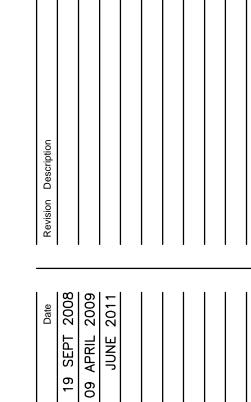

	Revision Description	DSA SUBMITTAL	DSA FINAL	PROJECT RECORD DRAW							
2	Job. No.						27082.				
	Date						02 APRIL 20				
	Drawn by						MD,				
	Checked by						F				
	Scale						1"=2				
)											

C6.02

Drawn by

Checked by

Scale

UTILITY

PLAN