




1. SEE SHEETS C8.03 THROUGH C8.05 FOR UTILITY DETAILS

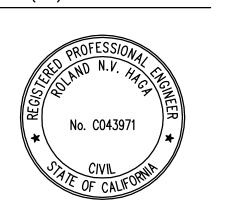


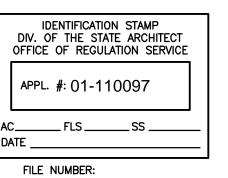





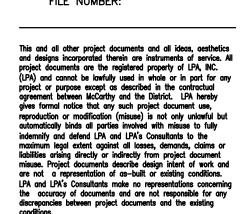

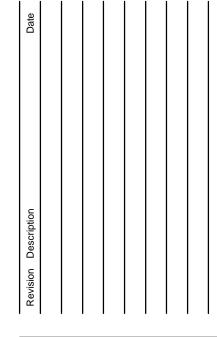

Date	2008	2009	2011		
	19 SEPT 2008	09 APRIL 2009	JUNE 2011		
Revision Description	DSA SUBMITTAL	DSA FINAL	PROJECT RECORD DRAWING		

		Revi					
		Job. No.		27082.30			
	40	Date 02 APRIL 200					
	4	Drawn by		MD, JT			
		Checked by	RH				
		Scale		1"=20'			
1		UT	ILITY				
#	- 1	P	LAN				
	0	C6.03					

DATE: JUNE 2011