






P 415 | 364-1339 F 415 | 397-5999

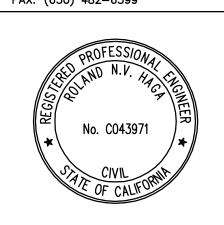

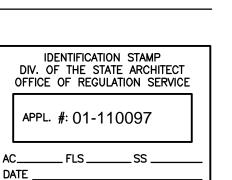



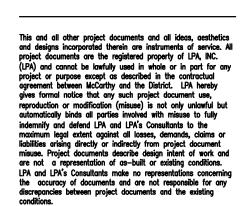


LPA and LPA's Consultants make no representations context the accuracy of documents and are not responsible for discrepancies between project documents and the existing conditions.

(C) Copyright 2008

FILE NUMBER:

San Mateo, CA
San Mateo CA

Developed for
San Mateo County Community College District

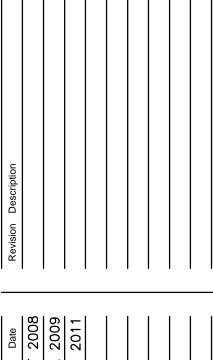

Revision Description

DSA SUBMITTAL

19 SEPT 2008

DSA FINAL

09 APRIL 2009

PROJECT RECORD DRAWING

JUNE 2011

	Job. No.	27082.30
40	Date	02 APRIL 2009
	Drawn by	MD, JT
	Checked by	RH
Ţ	Scale	1"=20'
	UTILITY	
- 6	PL/	AN
	<b>C6</b> .	10