


MCCarthy Building Companies, In

McCarthy Building Companies, Inc. 343 Sansome Street, 14th Floor San Francisco, California 94104 P 415 | 364-1339 F 415 | 397-5999





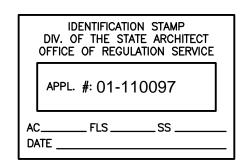

FILE NUMBER:


This and all other project documents and all ideas, aesthetics and designs incorporated therein are instruments of service. All project documents are the registered property of LPA, INC. (LPA) and cannot be lawfully used in whole or in part for any project or purpose except as described in the contractual agreement between McCarthy and the District. LPA hereby gives formal notice that any such project document use, reproduction or modification (misuse) is not only unlawful but automatically binds all parties involved with misuse to fully indemnify and defend LPA and LPA's Consultants to the maximum legal extent against all losses, demands, claims or liabilities arising directly or indirectly from project document misuse. Project documents describe design intent of work and are not a representation of as-built or existing conditions.


LPA and LPA's Consultants make no representations concerning the accuracy of documents and are not responsible for any discrepancies between project documents and the existing

© Copyright 2008

Site Package
San Mateo, CA

Developed for

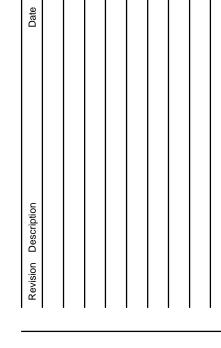

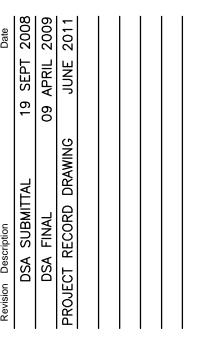

 Job. No.
 27082.30

 Date
 02 APRIL 2009

 Drawn by
 MD, JT

 Checked by
 RH

CONSTRUCTION DETAILS

AS SHOWN

C8.06