GENERAL

- 1. REFER TO SPECIFICATIONS FOR COMPLETE REQUIREMENTS. MORE STRINGENT REQUIREMENT CONTROLS WHERE INFORMATION SHOWN ON DRAWINGS AND IN SPECIFICATIONS ARE IN CONFLICT.
- 2. CONSTRUCTION SHALL BE IN ACCORDANCE WITH THE CALIFORNIA BUILDING CODE, 2007
- 3. DETAILS OF THE CONSTRUCTION NOT FULLY SHOWN OR NOTED ON THE DRAWINGS NOR CALLED FOR IN THE SPECIFICATIONS SHALL BE OF THE SAME SIZE AND CHARACTER AS FOR SIMILAR CONDITIONS WHICH ARE SHOWN AND NOTED.
- 4. THE WORD "TYPICAL" SHALL MEAN THAT THE INDICATED INFORMATION SHALL BE APPLIED TO ALL SIMILAR CONDITIONS WHETHER OR NOT THE INFORMATION IS SPECIFICALLY

REFERENCED, UNLESS OTHERWISE NOTED ON THE DRAWINGS.

- THE CONTRACTOR SHALL VERIFY ALL EXISTING CONDITIONS AND DIMENSIONS AT JOB SITE. THE CONTRACTOR SHALL COMPARE STRUCTURAL DRAWINGS WITH ARCHITECTURAL, CIVIL. LANDSCAPE, MECHANICAL, PLUMBING, AND ELECTRICAL DRAWINGS BEFORE COMMENCING WITH THE WORK AND SHALL NOTIFY THE ARCHITECT OF ANY DISCREPANCIES REQUIRING CLARIFICATION OR REVISION. DO NOT SCALE DRAWINGS.
- 6. ALL INFORMATION SHOWN ON THE DRAWINGS RELATIVE TO EXISTING CONDITIONS IS GIVEN AS THE BEST AVAILABLE KNOWLEDGE, BUT WITHOUT GUARANTEE OF ACCURACY. ACTUAL AS-BUILT CONDITIONS MAY BE DIFFERENT THAN RECORDED IN THE DRAWINGS. THE CONTRACTOR SHALL VERIFY ALL EXISTING CONDITIONS AND DIMENSIONS AT JOBSITE PRIOR TO PRODUCING SHOP DRAWINGS AND FABRICATING AND INSTALLING NEW WORK. WHERE ACTUAL CONDITIONS CONFLICT WITH THE DRAWINGS THEY SHALL BE REPORTED TO THE ARCHITECT SO THAT THE PROPER REVISIONS MAY BE MADE. MODIFICATION OF DETAILS OF CONSTRUCTION SHALL NOT BE MADE WITHOUT WRITTEN DIRECTION OF THE ARCHITECT.
- 7. THE CONTRACTOR SHALL BE SOLELY RESPONSIBLE FOR THE SAFETY AND PRESERVATION OF THE BUILDING AND CONTENTS DURING CONSTRUCTION, AND SHALL BE SOLELY RESPONSIBLE FOR PROVIDING A SAFE PLACE TO WORK. THE CONTRACTOR SHALL EXECUTE WORK TO ENSURE SAFETY OF PERSONS AND PROPERTY AGAINST DAMAGE BY FALLING DEBRIS AND OTHER HAZARDS IN CONNECTION WITH THIS WORK, AND SHALL PROVIDE ADEQUATE SHORING AND BRACING DURING ALL DEMOLITION AND CONSTRUCTION.
- 8. CONTRACTOR SHALL FIELD VERIFY ALL DIMENSIONS AND ELEVATIONS PRIOR TO FABRICATION AND CONSTRUCTION OF ANY NEW ELEMENTS.
- THE GENERAL CONTRACTOR IS RESPONSIBLE FOR DEVELOPING AND COORDINATING A SEQUENCE OF TEMPORARY BRACING, SHORING, DEMOLITION, AND NEW CONSTRUCTION. SHORING TO SUPPORT EXISTING CONSTRUCTION TO REMAIN SHALL ALSO BE THE RESPONSIBILITY OF THE CONTRACTOR. ALL SHORING AND TEMPORARY BRACING SHALL BE DESIGNED BY A STRUCTURAL ENGINEER REGISTERED IN THE STATE OF CALIFORNIA HIRED AND PAID BY THE CONTRACTOR.
- 10. SHOP DRAWINGS SHALL BE SUBMITTED FOR ALL FABRICATED ELEMENTS AND SHALL BE APPROVED BY THE ARCHITECT PRIOR TO FABRICATION.

DESIGN BASIS

THE DESIGN IS IN ACCORDANCE WITH THE CALIFORNIA BUILDING CODE, 2007 EDITION WITH DSA/OSHPD ANENDMENTS AND PROVIDES FOR THE FOLLOWING LOADS:

LIVE LOADS FOR POOL EQUIPMENT BUILDING


20 PSF

WIND LOADS FOR POOL EQUIPMENT BUILDING & SITE CONSTRUCTION

BASIC WIND SPEED = 85 MPH EXPOSURE C

lw = 1.0

SEISMIC LOADS FOR POOL EQUIPMENT BUILDING

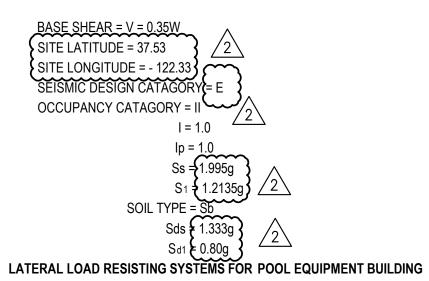

MASONRY BEARING SHEAR WALL

SPECIAL INSPECTION

THE SPECIAL INSPECTION REQUIREMENTS OF CHAPTER 17 OF THE CALIFORNIA BUILDING CODE

R = 5.0 $\Omega o = 2.5$

- APPLY TO THE FOLLOWING:
- STEEL CONSTRUCTION CONCRETE CONSTRUCTION
- MASONRY CONSTRUCTION BOLTS INSTALLED IN CONCRETE AND MASONRY
- METAL DECK SOIL

STRUCTURAL OBSERVATION

STRUCTURAL OBSERVATION FOR SEISMIC RESISTANCE SHALL BE PROVIDED IN ACCORDANCE WITH CBC SECTIONS 1705A AND 1707A. AT THE CONCLUSION OF THE STRUCTURAL WORK. THE OBSERVER SHALL SUBMIT A WRITTEN STATEMENT TO THE BUILDING OFFICIAL THAT THE SITE VISITS HAVE BEEN MADE AND IDENTIFY ANY REPORTED DEFICIENCIES THAT, TO THE BEST OF THE STRUCTURAL OBSERVER'S KNOWLEDGE, HAVE NOT BEEN RESOLVED.

GEOTECHNICAL INFORMATION

 FOR SITE CONSTRUCTION, THE OWNER'S GEOTHECHNICAL ENGINEER, CORNERSTONE EARTH GROUP, HAS PREPARED AN INVESTIGATION REPORT FOR USE ON THIS PROJECT, TITLE "COLLEGE OF SAN MATEO SITE WORK PACKAGE" (DATED MARCH 25, 2009


FOR THE POOL EQUIPMENT BUILDING, THE OWNER'S GEOTHECHNICAL ENGINEER, CORNERSTONE EARTH GROUP, HAS PREPARED AN INVESTIGATION REPORT FOR USE ON THIS PROJECT, TITLED: AQUATIC CENTER", DATED FEB. 2, 2009.

- 2. THE CONTRACTOR SHALL REVIEW AND UNDERSTAND THE INFORMATION CONTAINED IN THE REPORT, BUT SHALL NOT ASSUME THAT SUCH INFORMATION IS SUFFICIENT FOR THE CONTRACTOR'S PURPOSES.
- 3. THE CONTRACTOR SHALL BE FAMILIAR WITH THE GEOTECHNICAL CONDITIONS AT THE PROJECT SITE.
- 4. THE CONTRACTOR SHALL BE RESPONSIBLE TO OBTAIN GEOTECHNICAL STUDIES AND INFORMATION NECESSARY TO COMPLETE THE WORK.
- 5. THE CONTRACTOR SHALL OBTAIN THE SERVICES OF AN INDEPENDENT GEOTECHNICAL ENGINEER LICENSED IN THE STATE OF CALIFORNIA TO ANALYZE AVAILABLE INFORMATION AND TO MAKE ADDITIONAL INVESTIGATIONS AS NECESSARY TO COMPLETE THE WORK.

FOUNDATIONS

- REFER TO GENERAL NOTES SECTION TITLED "GEOTECHNICAL INFORMATION".
- 2. SLABS ON GRADE AND FOUNDATIONS SHALL BEAR ON APPROVED NATIVE SUBGRADE OR COMPACTED SOIL.
- 3. FOOTINGS AND GRADE BEAMS SHALL BE CAST IN NEAT TRENCHED EXCAVATIONS (1" MINIMUM WIDER THAN SCHEDULED). IF FOOTINGS CANNOT BE CAST IN TRENCHES, FORM FOOTINGS TO SCHEDULED DIMENSIONS.
- 4. BOTTOM OF FOOTINGS SHALL BE CALCULATED USING INFORMATION SHOWN ON THE DRAWINGS AND MAY BE REVISED BY THE GEOTECHNICAL ENGINEER TO ENSURE PROPER BEARING OF FOOTINGS INTO FIRM, APPROVED SOIL MATERIAL (UNDISTURBED NATURAL SOILS OR COMPACTED ENGINEERED FILL). TOP OF FOOTING DIMENSION FROM DATUM SHALL BE AS SHOWN ON PLANS.
- 5. COMPACTED NATURAL SOIL, FILL, AND BACKFILL IS TO BE UNIFORMLY COMPACTED WITH APPROVED COMPACTION EQUIPMENT. FILL MATERIAL AND OPERATIONS SHALL BE INSPECTED BY THE OWNER'S GEOTECHNICAL ENGINEER.
- WATER SHALL NOT BE ALLOWED TO STAND IN TRENCHES OR FORMS BEFORE OR AFTER CONCRETE IS PLACED, AND SHALL BE PUMPED OUT. IF BOTTOMS OF TRENCHES BECOME SOFTENED DUE TO RAIN OR OTHER WATER BEFORE FOOTINGS ARE CAST, THE CONTRACTOR SHALL EXCAVATE THE SOFTENED MATERIAL AND REPLACE WITH CONCRETE.

7. ALLOWABLE BEARING PRESSURES FOR SPREAD FOOTINGS: POOL EQUIPMENT BUILDING:

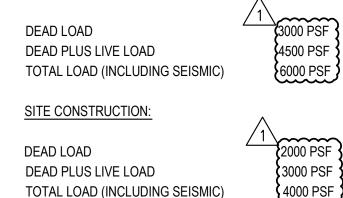

8. CANTILEVER RETAINING WALL DESIGN PRESSURE: ↑ 35 PCF (LEVEL BACKFILL) POOL EQUIPMENT BUILDING: 35 PCF (LEVEL BACKFILL)

SEISMIC INCREMENT SOIL PRESSURE: 13H (RECTANGULAR)

10. SPECIAL INSPECTION REQUIREMENTS APPLY TO FILL AND BACKFILL OPERATIONS FOOTING EXCAVATIONS SHALL BE INSPECTED AND APPROVED BY THE GEOTECHNICAL ENGINEER PRIOR TO PLACING REINFORCEMENT STEEL.

CONCRETE

1. ALL CONCRETE SHALL DEVELOP THE FOLLOWING COMPRESSIVE STRENGTHS AT 28 DAYS:

NORMAL WEIGHT CONCRETE 28 DAYS FOOTINGS, GRADE BEAMS 3000 PSI SLAB ON GRADE

2. REFER TO SPECIFICATIONS FOR CONCRETE CLASS DESIGNATIONS.

3. ALL EXPOSED CORNERS OR EDGES OF COLUMNS, PIERS, WALLS, BEAMS, ETC., SHALL BE FORMED WITH A 3/4" CHAMFER UNLESS OTHERWISE NOTED ON DRAWINGS.

4. CONSTRUCTION JOINTS SHALL BE LOCATED WHERE SHOWN AND, IF NOT SHOWN, WHERE DIRECTED BY THE ARCHITECT. THEY SHALL BE LOCATED SO AS TO LEAST IMPAIR THE STRENGTH OF THE STRUCTURE AND TO MINIMIZE SHRINKAGE. PROVIDE DOWELS AND KEYS AS DETAILED AND DIRECTED, AND THOROUGHLY CLEAN AND REMOVE LAITANCE FROM SURFACES BEFORE PROCEEDING WITH THE NEXT PLACEMENT.

CONTRACTOR SHALL SUBMIT CONSTRUCTION JOINT LAYOUT FOR REVIEW.

FOR DRIP EDGES, REGLETS, REVEALS, AND OTHER FEATURES NOT SHOWN ON THE STRUCTURAL DRAWINGS, SEE ARCHITECTURAL DRAWINGS.

METAL DECK

- SEE S7.1T FOR DECK PROFILES.
- 2. STEEL DECK SHALL BE WELDED TO ALL STRUCTURAL STEEL AND TO ADJACENT DECK SECTIONS IN ACCORDANCE WITH THE DECK WELDING SCHEDULE ON S7.1.
- 3. WELDING OF DECK SHALL BE IN ACCORDANCE WITH AWS STANDARDS AND PERFORMED BY WELDERS CERTIFIED FOR LIGHT-GAGE METALS.
- 4. PROVIDE VENTED DECK FOR ALL DECKS TO RECEIVE CONCRETE FILL UNLESS OTHERWISE NOTED. DECKS WITHOUT CONCRETE FILL SHALL NOT BE VENTED.

CONCRETE REINFORCEMENT

- 1. ALL CONCRETE SHALL BE REINFORCED. REINFORCEMENT SHALL BE NEW DEFORMED STEEL BARS, ASTM A615, GRADE 60.
- 2. ALL CONCRETE REINFORCEMENT DETAILS SHALL CONFORM TO ACI 315, "MANUAL OF
- STANDARD PRACTICE FOR DETAILING CONCRETE STRUCTURES".

3. CONCRETE COVER SHALL BE TO FACE OF BAR, MECHANICAL COUPLER, OR WELDED HEADED BAR AS FOLLOWS, UNLESS OTHERWISE NOTED ON DRAWINGS:

MINIMUM CONCRETE COVER CAST-IN-PLACE CONCRETE CAST AGAINST AND EXPOSED TO EARTH

EXPOSED TO EARTH OR WEATHER #5 AND SMALLER 1 ½" #6 AND LARGER NOT EXPOSED TO WEATHER OR IN CONTACT WITH EARTH SLABS, JOISTS 1 ½" 1 ½"

SLABS ON GRADE (8" THICK OR LESS)

COLUMNS, BEAMS

4. CONTRACTOR SHALL SUBMIT SHOP DRAWINGS OF REINFORCEMENT LAYOUTS AND DETAILS FOR REVIEW PRIOR TO FABRICATION. SHOW ALL PROPOSED SPLICE LOCATIONS. FABRICATE FROM APPROVED DRAWINGS ONLY.

MID-DEPTH

- 5. THE LENGTHS AND SPLICES OF REINFORCEMENT SHOWN ON DRAWINGS REPRESENT A SUGGESTED CONSTRUCTION JOINT LAYOUT. BAR SPLICES MAY BE DELETED AND CONTINUOUS REINFORCEMENT USED AT THE CONTRACTOR'S OPTION. LONG BARS OR BENT BARS SHOWN MAY BE SPLICED IF NECESSARY FOR PLACEMENT OR EASE OF CONSTRUCTION PROVIDED MINIMUM SCHEDULED LAP LENGTHS ARE FOLLOWED WITH APPROVAL FROM THE ARCHITECT. MECHANICAL COUPLERS SHALL BE USED WHERE SHOWN ON THE DRAWINGS AND MAY BE USED IN LIEU OF LAP SPLICES WITH APPROVAL FROM THE ARCHITECT.
- 6. PROVIDE DOWELS OR CONTINUOUS REINFORCEMENT BETWEEN ALL CONCRETE ELEMENTS, UNLESS OTHERWISE NOTED. IN GENERAL, BAR SPLICES SHALL BE MADE AT POINTS OF MINIMUM STRESS. IN FRAMED BEAMS AND SLABS, SPLICE TOP BARS AT MID-SPAN, BOTTOM BARS OVER SUPPORTS, UNLESS OTHERWISE NOTED. IN GRADE BEAMS SUPPORTED ON SOIL, SPLICE TOP BARS AT COLUMNS, BOTTOM BARS AT MID-SPAN BETWEEN COLUMNS, UNLESS OTHERWISE NOTED ON DRAWINGS. VERTICAL REINFORCEMENT FROM COLUMNS, PILASTERS, AND WALLS SHALL BE DOWELED TO SUPPORTING FOOTINGS WITH BARS OF SAME SIZE AND SPACING AS VERTICAL REINFORCEMENT UNLESS OTHERWISE NOTED ON DRAWINGS.
- 7. ALL SPLICES OF #8 AND LARGER REINFORCEMENT SHALL BE MADE USING TYPE II MECHANICAL COUPLERS, UNLESS OTHERWISE SHOWN. LAP SPLICES FOR #8 AND LARGER BARS SHALL NOT BE PERMITTED.
- 8. TYPE II MECHANICAL COUPLERS SHALL CONFORM TO DIMENSIONAL REQUIREMENTS SHOWN ON THE DRAWINGS. SO AS NOT TO REQUIRE SPECIAL STIRRUPS OR HOOPS. OR VIOLATE THE REQUIRED CLEAR COVER OF CONCRETE. HRC TYPE 510 XTENDER OR EQUAL (NO KNOWN EQUAL). MECHANICAL COUPLERS SHALL BE STAGGERED A MINIMUM OF 3'-0" FROM MECHANICAL COUPLERS ON ADJACENT BARS, UNLESS OTHERWISE NOTED ON DRAWINGS.
- 9. CONTRACTOR SHALL ORDER ADEQUATE ADDITIONAL UNITS OF REINFORCEMENT SPLICED WITH MECHANICAL COUPLERS AND ADEQUATE ADDITIONAL UNITS OF REINFORCEMENT TERMINATED WITH WELDED HEADED BARS TO FACILITATE THE MINIMUM TESTING REQUIREMENTS TO BE PERFORMED BY THE OWNER'S TESTING
- 10. THE OWNER'S TESTING AGENCY SHALL TENSION TEST ONE TYPE II MECHANICAL COUPLER FOR EACH ONE HUNDRED DEVICES UTILIZED ON PROJECT. ROUND UP TO NEXT HIGHEST 100 FOR INTERMEDIATE NUMBER OF DEVICES. AND TEST A MINIMUM OF TWO DEVICES. OWNER'S TESTING AGENCY SHALL TENSION TEST ONE WELDED HEADED BAR FOR EACH ONE HUNDRED DEVICES UTILIZED ON PROJECT. ROUND UP TO NEXT HIGHEST 100 FOR INTERMEDIATE NUMBERS AND TEST TWO DEVICES MINIMUM. FAILURE OF A DEVICE SHALL REQUIRE ADDITIONAL TESTS OF ONE IN TEN DEVICES OF THE SAME HEAT OF DEVICE. ADDITIONAL REINFORCEMENT REQUIRED DUE TO FAILED DEVICES SHALL BE AT THE EXPENSE OF THE CONTRACTOR.
- 11. THE OWNER'S TESTING AGENCY SHALL TORQUE TEST TEN PERCENT OF ALL IN-PLACE TYPE II MECHANICAL COUPLERS TO THE VALUES TABULATED ON THE DRAWINGS. IF ANY ONE TORQUE TEST FAILS, ALL TYPE II MECHANICAL COUPLERS INSTALLED THAT DAY SHALL BE TORQUE TESTED BY THE OWNER'S TESTING AGENCY. THE CONTRACTOR SHALL CORRECT ALL TYPE II MECHANICAL COUPLERS IDENTIFIED AS HAVING FAILED TORQUE TESTS AT NO ADDITIONAL COST TO THE OWNER. THE OWNER'S TESTING AGENCY SHALL RETEST ALL FAILED COUPLERS.

CONCRETE MASONRY UNITS

- 1. MINIMUM MASONRY COMPRESSIVE STRENGTH AT 28 DAYS, fm = 1,500 psi.
- 2. MASONRY MATERIALS SHALL CONFORM TO THE FOLLOWING U.O.N.: ASTM C90, GRADE N, LIGHTWEIGHT, HOLLOW CONCRETE MASONRY UNITS:

LOAD BEARING UNITS (MINIMUM COMPRESSIVE STRENGTH = (1,900 psi) **GROUT:** ASTM C476 (FILL ALL CELLS) (MINIMUM COMPRESSIVE STRENGTH = \(2,000 psi) \(\big) MORTAR: ASTM C270, TYPE S (MINIMUM COMPRESSIVE STRENGTH = (1,800 psi) ()

3. REINFORCING STEEL:

ASTM A706 REINFORCING TO BE WELDED: ALL OTHER REINFORCING: ASTM A615, GRADE 60 UBC STANDARD 21-10 JOINT REINFORCING:

- 4. REINFORCING BAR LAP SPLICES: 65 BAR DIAMETERS, UNLESS OTHERWISE NOTED. WHERE MULTIPLE BARS ARE LAPPED IN THE SAME CELL OR COURSE, STAGGER LAP SPLICES A MINIMUM OF 3 FEET.
- 5. FILL ALL CELLS WITH GROUT.
- S.L.D. FOR COURSING LAYOUT AND LOCATIONS OF CONSTRUCTION JOINTS IN CMU WALLS.
- FOR HIGH LIFT GROUTING MAX WALL HEIGHT IS 12 ' AND MAX GROUT LIFT IS 4'-0". IF BLOW-OUT SITUATION OCCURS, CONTRACTOR SHALL STOP THE WORK AND REPORT TO THE STRUCTURAL ENGINEER AND DSA FOR REMEDIAL CORRECTIVE ACTION. SEE SPECIFICATIONS FOR ADDITIONAL INFORMATION.

STRUCTURAL STEEL

1. STEEL MATERIALS SHALL CONFORM TO THE FOLLOWING

FABRICATE FROM APPROVED DRAWINGS ONLY.

W-SHAPES, WT-SHAPES ASTM A 992, GRADE 50 CHANNEL AND ANGLE SHAPES ASTM A 36 ASTM A 500, GRADE B RECTANGULAR HSS ASTM A 36 PLATES BASE PLATES ASTM A 36 **ANCHOR RODS** ASTM F 1554 GRADE 55 W/ S1 MACHINE BOLTS ASTM A 307

HIGH STRENGTH BOLTS ASTM A 325-N TYP. U.O.N., SC OR X AS INDICATED

2. ALL STRUCTURAL STEEL SHALL CONFORM TO AISC SPECIFICATIONS FOR THE DESIGN, FABRICATION, AND ERECTION OF STRUCTURAL STEEL FOR BUILDINGS.

3. CONTRACTOR SHALL SUBMIT SHOP DRAWINGS FOR REVIEW PRIOR TO FABRICATION.

4. ALL HIGH STRENGTH BOLTS SHALL BE SNUG TIGHT ONLY UNLESS OTHERWISE NOTED ON THE DRAWINGS AS SLIP CRITICAL (SC). ALL BOLTED CONNECTIONS NOTED AS SLIP

CRITICAL SHALL BE FULLY TENSIONED IN ACCORDANCE WITH THE SPECIFICATIONS.

5. WELDING SHALL ONLY BE PERFORMED BY CERTIFIED WELDERS. ALL WELDING SHALL CONFORM TO AWS SPECIFICATIONS. PROVIDE TEMPORARY BACK-UP PLATES OR WELDS AT ALL COMPLETE JOINT PENETRATION (CJP) WELD LOCATIONS AS REQUIRED; REMOVE PLATES AFTER CJP WELDING AND GRIND AREA SMOOTH WHERE EXPOSED.

6. WHERE FIELD WELDING IS SPECIFICALLY NOTED, THE DESIGNATION IS GIVEN AS A SUGGESTED CONSTRUCTION PROCEDURE ONLY. CONTRACTOR SHALL DETERMINE SUITABILITY OF SHOP OR FIELD WELDING FOR ALL CONDITIONS.

7. DO NOT CUT THROUGH ERECTED STEEL PLATES, BOLTS, ANGLES OR SHAPES WITHOUT PERMISSION OF THE ARCHITECT. WHERE STEEL WILL BE EXPOSED TO VIEW, ALL SLAG AND ROUGH EDGES SHALL BE MECHANICALLY REMOVED TO PROVIDE A SMOOTH EDGE AFTER CUTTING OR BORING. ALL SURFACES CUT BY THERMAL PROCESSES SHALL BE GROUND (1/32 INCH MIN.) TO BRIGHT METAL.

ALL SHOP AND FIELD WELDING SHALL BE INSPECTED BY THE OWNER'S TESTING AGENCY.

9. WHERE STRUCTURAL STEEL IS TO BE ATTACHED USING POST-INSTALLED ANCHORS, ANCHOR HOLES SHALL BE DRILLED PRIOR TO PREPARATION OF STEEL SHOP DRAWINGS AND FABRICATION. DRILLED HOLE LOCATIONS SHALL BE RECORDED AND TRANSFERRED USING TEMPLATES FOR THE PURPOSE OF ACCURATELY LOCATING HOLES IN STRUCTURAL STEEL.

10. SEE ARCHITECTURAL DRAWINGS FOR FINISHES AND SPECIFICATIONS FOR ADDITIONAL REQUIREMENTS FOR ARCHITECTURALLY EXPOSED STRUCTURAL STEEL (AESS).

RESIN ANCHORS AND DOWELS IN CONCRETE

DRILLED RESIN ANCHORS AND DOWELS SHALL BE INSTALLED IN ACCORDANCE WITH THE MANUFACTURER'S RECOMMENDATIONS.

MINIMUM ANCHOR OR DOWEL EMBEDMENT SHALL BE AS INDICATED IN THE

DRILLED RESIN ANCHORS AND DOWELS SHALL NOT BE USED TO RESIST VIBRATORY OR SHOCK (IMPACT) LOADS.

APPROPRIATE TABLES BELOW, UNLESS OTHERWISE INDICATED ON THE DRAWINGS.

ANCHORS SHALL BE ASTM A 36 ALL-THREAD ROD, EXCEPT AS NOTED OTHERWISE ON

THE DRAWINGS OR IN THE SPECIFICATIONS. DOWELS SHALL BE ASTM A 615 GRADE 60, EXCEPT AS NOTED OTHERWISE ON DRAWINGS OR IN THE SPECIFICATIONS.

THE OWNERS TESTING AGENCY SHALL PERFORM TENSION LOAD TESTS ON 10% OF ANCHORS AND DOWELS TO THE TEST VALUES INDICATED IN THE TABLES BELOW.

WHEN ANCHOR OR DOWEL FAILS A TENSION LOAD TEST, NOTIFY THE ARCHITECT IMMEDIATELY. REFER TO SPECIFICATIONS FOR REPLACEMENT AND RETESTING REQUIREMENTS. ABANDONED HOLES SHALL BE PATCHED.

ANCHORS AND DOWELS SPECIFICALLY NOTED ON THE DRAWINGS AS "NO TEST REQUIRED," DO NOT REQUIRE TENSION LOAD TESTS.

THE OWNER'S TESTING AGENCY SHALL DEVELOP AND UTILIZE AN EFFECTIVE METHOD FOR FIELD MARKING LOCATIONS OF ANCHOR AND DOWEL TESTS. THE TENSION LOAD TEST VALUES FOR ANCHORS ARE BASED ON 200% OF THE

MINIMUM ALLOWABLE TENSION LOAD REPORTED IN THE INTERNATIONAL CODE COUNCIL EVALUATION SERVICES (ICC-ES) TGEST REPORTS FOR THE MANUFACTURERS LISTED IN THE SPECIFICATIONS FOR 2,000 PSI CONCRETE. THE TENSION LOAD TEST VALUES FOR DOWELS IN CONCRETE ARE BASED ON 90% OF THE SPECIFIED YEILD STRENGTH OF THE DOWEL.

RESIN ANCHORS INSTALLED IN EXISTING NORMAL WEIGHT CONCRETE

(ANCHOR DIAMETER	MINIMUM EMBEDMENT	TENSION TEST LOAD (Pounds)
	3/8"	3 3/8"	2,580
	1/2"	4 1/2"	6,210
{	5/8"	5 5/8"	8,200
/	3/4"	6 3/4"	8,720
>	7/8"	7 7/8"	14,710
(1"	9"	15,870
	1 1//"	10"	20 080

RESIN DOWELS INSTALLED IN EXISTING NORMAL WEIGHT CONCRETE

BA	AR SIZE	MINIMUM EMBEDMENT	TENSION TEST LOAD (Pounds)
	#3	4"	5,860
	#4	6"	10,808
	#5	7 1/2"	14,740
	#6	9"	23,760
	#7	10"	32,400
	#8	12"	42,650
	#9	13"	54,000

ABBREVIATIONS

AND

∖ .B.	ANCHOR BOLT	1100
ABV.	ABOVE	I.F.
ALT.	ALTERNATE	JT.
λ.R.	ANCHOR ROD	LLH
BLW.	BELOW	LLV
BM.	BEAM	
3.N.	BOUNDARY NAILING	L.S.
		MAX.
3.0.	BOTTOM OF	MB
3.O.S.	BOTTOM OF STEEL	MIN.
BOTT.	BOTTOM	(N)
BRG.	BEARING	N/A
3.S.	BACK SIDE	N.I.C.
BTW/	BETWEEN	N.S.
C.B.F.	CONCENTRIC BRACED	N.T.S.
	FRAME	O.C.
C.I.P.	CAST-IN-PLACE	
C.J.	CONSTRUCTION JOINT	O.F.
CJP	COMPLETE PENETRATION	O.H.
-	JOINT	OP'G OR (
C.L.	CENTERLINE	O.S.B.
CLR.	CLEAR	PDF
C.M.U.	CONCRETE MASONRY UNIT	1 51
CONC.	CONCRETE	PJP
CONN.	CONNECTION	DI
CONT.	CONTINUOUS	PL.
CTR'D.	CENTERED	PLY. or P.\
D.B.A.	DEFORMED BAR ANCHOR	P.T.
		R.D.
DBL.	DOUBLE	REINF.
DET.	DETAIL	
DIA. OR Ø	DIAMETER	REQ.
=		R.O.
DIAG.	DIAGONAL	S.A.D.
DN.	DOWN	S.A.D.
WG.	DRAWING(S)	S.B.
DWL.	DOWEL	S.C.D.
A.	EACH	SECT.
.F.	EACH FACE	S.E.D.
L. or ELEV.	ELEVATION	J.E.D.
EQ.	EQUAL	SHT.
S.	EACH SIDE	SIM.
E.W.	EACH WAY	S.J.
DN.	FOUNDATION	
F.F.	FINISH FLOOR	S.L.D.
·IN.	FINISH	
LG.	FLANGE	S.M.D.
ELR.	FLOOR	S.P.D.
E.O.C.	FACE OF CONCRETE	SPECS.
		SQ.
F.O.W.	FACE OF WALL	S.R.
RMG.	FRAMING	STAGG'D.
F.S.	FAR SIDE	STD.
TG.	FOOTING	STIFF.
GALV.	GALVANIZED	STL.
G.B.	GRADE BEAM	SYMM.
SR.	GRADE	SIM.
l. or HORIZ.	HORIZONTAL	T&B
I.S.	HEADED STUD	T.O.F.F.
		T.O.F.
		T.O.C.
		T.O.S.
		T.O.W.
		TYP.

LEGEND

< >

HIGH STRENGTH BOLT HOLLOW STRUCTURAL SHAPE INSIDE FACE

JOINT

MAXIMUM

MINIMUM

NEAR SIDE

NOT TO SCALE

ON CENTER

OPENING

OUTSIDE FACE

OPPOSITE HAND

POWDER DRIVEN

FASTENER

PLATE

PLYWOOD

PARTIAL JOINT

PENETRATION

POST-TENSION OR

RESIN DOWEL

REQUIRED

DRAWINGS

SECTION

DRAWINGS

SHEET(S)

SEISMIC JOINT

SEE LANDSCAPE

ARCHITECTURAL

SEE MECHANICAL

SPECIFICATIONS

SEISMIC RESISTING

SEE PLUMBING DRAWINGS

DRAWINGS

SQUARE

STAGGERED

STANDARD

STIFFENER

SYMMETRICAL

TOP AND BOTTOM

TOP OF FOOTING

TOP OF CONCRETE

UNLESS OTHERWISE

TOP OF STEEL

TOP OF WALL

VERIFY IN FIELD

TYPICAL

VERTICAL

WITH

TOP OF FOOTING, GRADE BEAM, OR MAT SLAB

INDICATES SLOPE. ARROWHEAD

POINTS TO LOWER ELEVATION.

DEPRESSED SLAB TYPE, SEE

GROUT

C.M.U.

INDICATES CONCRETE

COLUMN CONNECTION

HEADED STUD LAYOUT

FULL-DEPTH STIFFENER

- METAL DECK TYPE (NO FILL)

TOP OF BEAM ELEVATION WITH

SLAB ON GRADE

GRADE BEAM

TOP OF SLAB, WALL, ETC. ELEVATION

SIMPLE BEAM TO BEAM AND BEAM TO

DOUBLE ROW BOLTING CONNECTION

RESPECT TO TYPICAL TOP OF STEEL ELEVATION

- POSITIVE OR UPWARD CAMBER AT MID-SPAN

ELEVATION WITH RESPECT TO TOP OF FINISHED

WITHOUT

WORK POINT

U.O.N.

V.I.F.

(V) or VERT.

TOP OF FINISHED FLOOR

STEEL

SIMILAR

SIMILAR

REINFORCEMENT

ROUGH OPENING

SOLID BLOCKING

SEE ELECTRICAL

SEE ARCHITECTURAL

SEE CIVIL DRAWINGS

PRESSURE TREATED

ORIENTED STRAND BOARD


NEW


LONG LEG HORIZONTAL LONG LEG VERTICAL LAG SCREW McCarthy Building Companies, Inc. MACHINE BOLT 343 Sansome Street, 14th Floor San Francisco, California 94104 P 415 | 364-1339 NOT APPLICABLE F 415 397-5999 NOT IN CONTRACT

> FORELL/ELSESSER ENGINEERS, INC. Structural Engineers 160 Pine Street · San Francisco, CA. 94111

Phone: (415) 837-0700 · Fax: (415) 837-0800 www.forell.com Job No.: 06-091.004 OFFICE OF REGULATION SERVICE **APPL.** #: 01-110097 _____ FLS ______ SS . FILE NUMBER:

This and all other project documents and all ideas, aesthetics and designs incorporated therein are instruments of service. Al roject documents are the registered property of LPA, INC. (LPA) and cannot be lawfully used in whole or in part for any project or purpose except as described in the contractual agreement between McCarthy and the District. LPA hereby gives formal notice that any such project document use, eproduction or modification (misuse) is not only unlawful but utomatically binds all parties involved with misuse to fully indemnify and defend LPA and LPA's Consultants to the maximum legal extent agginst all losses, demands, claims o liabilities arising directly or indirectly from project document misuse. Project documents describe design intent of work and are not a representation of as-built or existing conditions. LPA and LPA's Consultants make no representations concerning the accuracy of documents and are not responsible for any iscrepancies between project documents and the existing C Copyright 2008

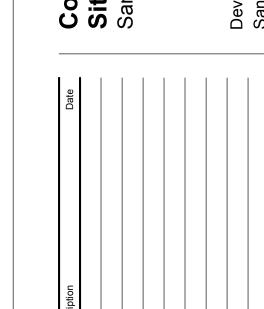

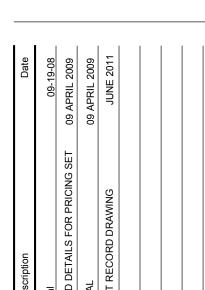

09 APRIL 2009 NO SCALE **GENERAL NOTES**

AND LEGEND

ABBREVIATIONS