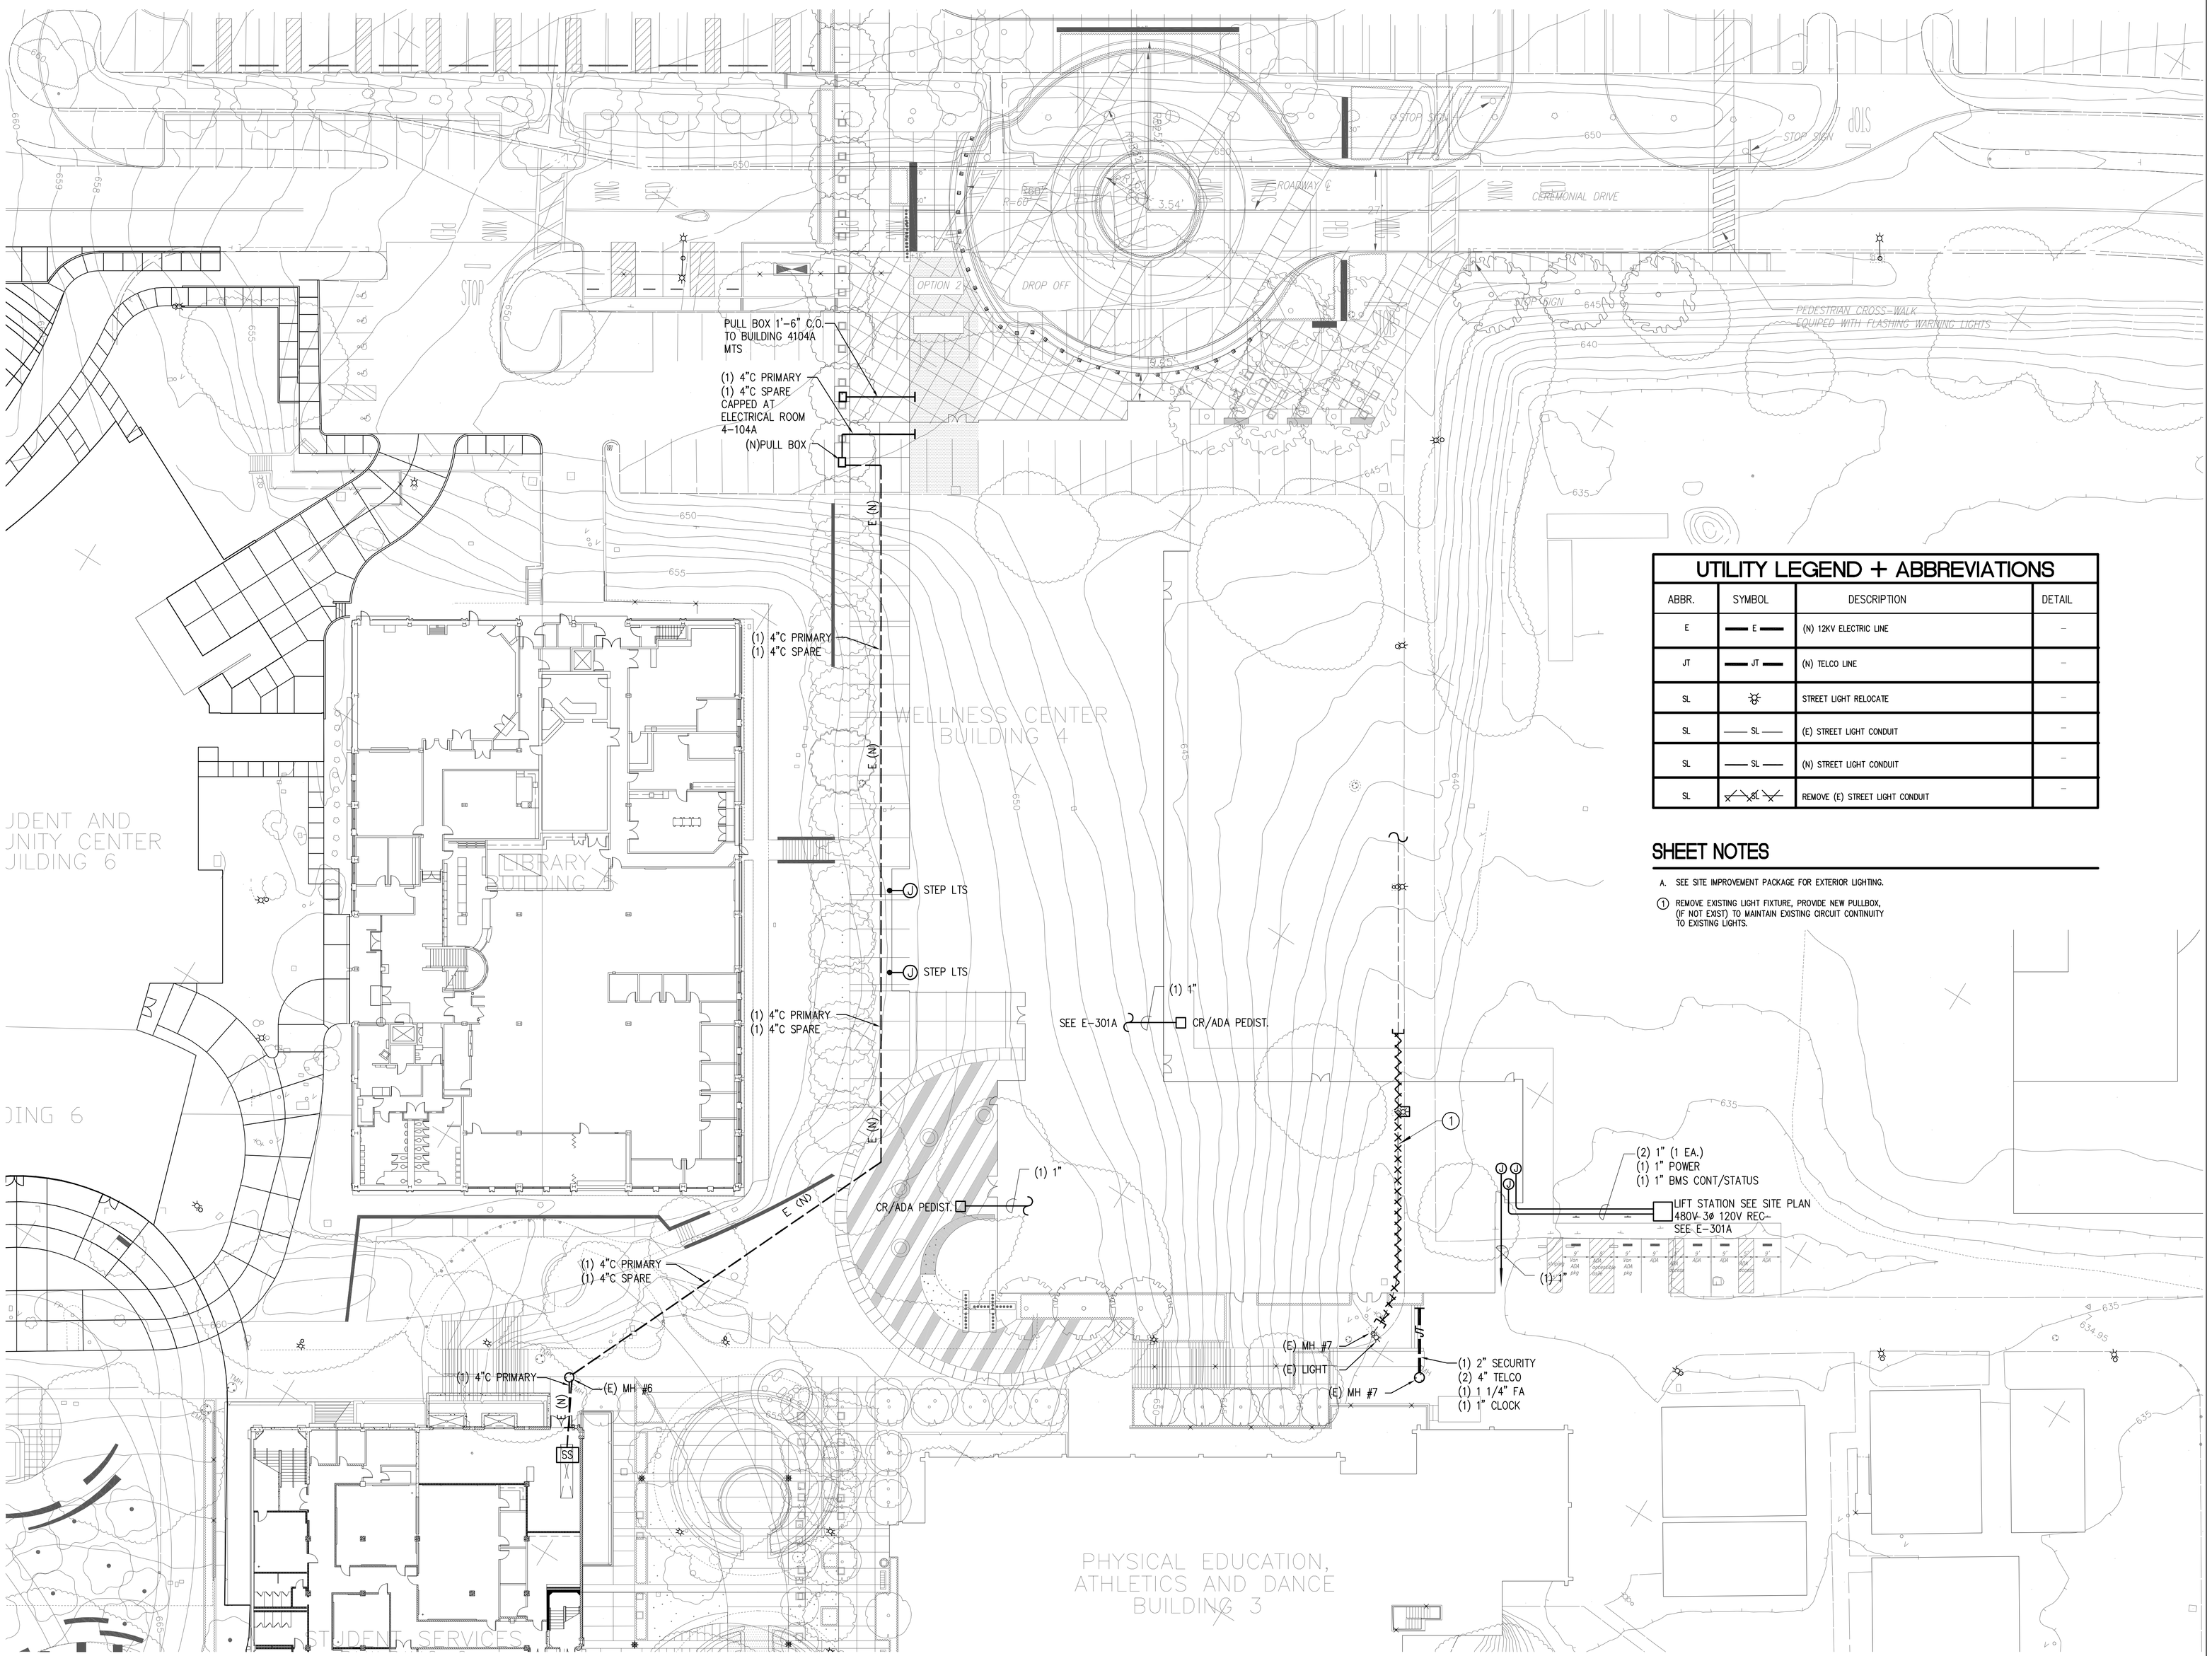


## ELECTRICAL SITE PLAN

SCALE: 1"=20'-0"

1

## UTILITY LEGEND + ABBREVIATIONS

| ABBR. | SYMBOL | DESCRIPTION | DETAIL |
|---|---|---|---|
| E | E | (N) 12KV ELECTRIC LINE | – |
| JT | JT | (N) TELCO LINE | – |
| SL | | STREET LIGHT RELOCATE | – |
| SL | SL | (E) STREET LIGHT CONDUIT | – |
| SL | SL | (N) STREET LIGHT CONDUIT | – |
| SL | SL | REMOVE (E) STREET LIGHT CONDUIT | – |

## SHEET NOTES

A. SEE SITE IMPROVEMENT PACKAGE FOR EXTERIOR LIGHTING.

1. REMOVE EXISTING LIGHT FIXTURE, PROVIDE NEW PULLBOX, (IF NOT EXIST) TO MAINTAIN EXISTING CIRCUIT CONTINUTY TO EXISTING LIGHTS.

All drawings and written material appearing herein constitute original and unpublished work of the Architect/Engineer and may not be duplicated, used or disclosed without consent of Architect/Engineer.

If this drawing is not 30"x42", then the drawing has been revised from its original size. Noted scales must be adjusted. This line should be equal to one inch

WRNS
501 SECOND STREET
4TH FLOOR, STE. 402
SAN FRANCISCO
CALIFORNIA 94107
415.489.2224 TEL
415.888.9100 FAX
WWW.WRNSSTUDIO.COM

Steinberg Architects

Hensel Phelps Construction Co.

DECKER ELECTRIC
147 Bacon Street
South San Francisco, CA 94080
Phone (650) 635-1390
Decker Electric Co., Inc.
Electrical Contractors
LIC. NO. 3779 C-10

RANDALL LAMB
Engineers - Mechanical, Electrical, Communications, Lighting Design
SAN DIEGO-SAN FRANCISCO
208 Utah Street, Suite 410 (415) 512-9771
San Francisco, California 94103 Fax (415) 512-9940

| NO. | ISSUES/REVISIONS | DATE |
|---|---|---|
| | 100% SCHEMATIC DESIGN | 04/28/08 |
| | 50% DESIGN DEVELOPMENT SUBMITTAL | 06/13/08 |
| | 100% DESIGN DEVELOPMENT SUBMITTAL | 07/28/08 |
| | DSA INCREMENT #2: 80% REVIEW | 10/10/08 |
| | DSA INCREMENT #2: STRUCTURE & GFRC PANELS | 11/11/08 |
| | DSA INCREMENT #3 50% REVIEW | 11/11/08 |
| | INTERNAL 90% REVIEW INCREMENT 3 | 12/23/08 |
| | DSA INCREMENT #3: TENANT IMPROVEMENT AND ROOFING SYSTEM | 02/09/09 |
| | DSA INCREMENT #3: HPCC REVIEW | 04/30/09 |
| | DSA INCREMENT #3: BACKCHECK | 05/12/09 |
| | ISSUED TO FIELD | 08/12/09 |
| | RECORD DRAWINGS | 12/27/10 |
| | R/FP B4-046 | 01/25/11 |
| | RECORD DRAWINGS REV 1 | 04/19/11 |
| | RECORD DRAWINGS REV 2 | 06/15/11 |
| | RECORD DRAWINGS REV 3 | 06/22/11 |

DIVISION OF THE STATE ARCHITECT
APPL # 01-110117
FILE # 41-C1
AC ____ FLS ____
SSS ____ DATE ____
IDENTIFICATION STAMP

Increment 3

# SKYLINE COLLEGE

SAN MATEO COUNTY COMMUNITY COLLEGE DISTRICT

## CIP2 DESIGN-BUILD PROJECT BUILDING 4 INCREMENT 3

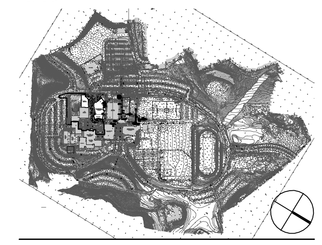

PROJECT NO.: SF10570.00 DRAWN BY: IB
DATE: 04/28/08 CHECKED BY: AJS
SCALE: 1"=20'-0"

SHEET TITLE:

## ELECTRICAL SITE PLAN

SHEET NO:

E-200