


SKY FMC - ELBCT SITE E.I.1
DRAFT AS-BUILTS

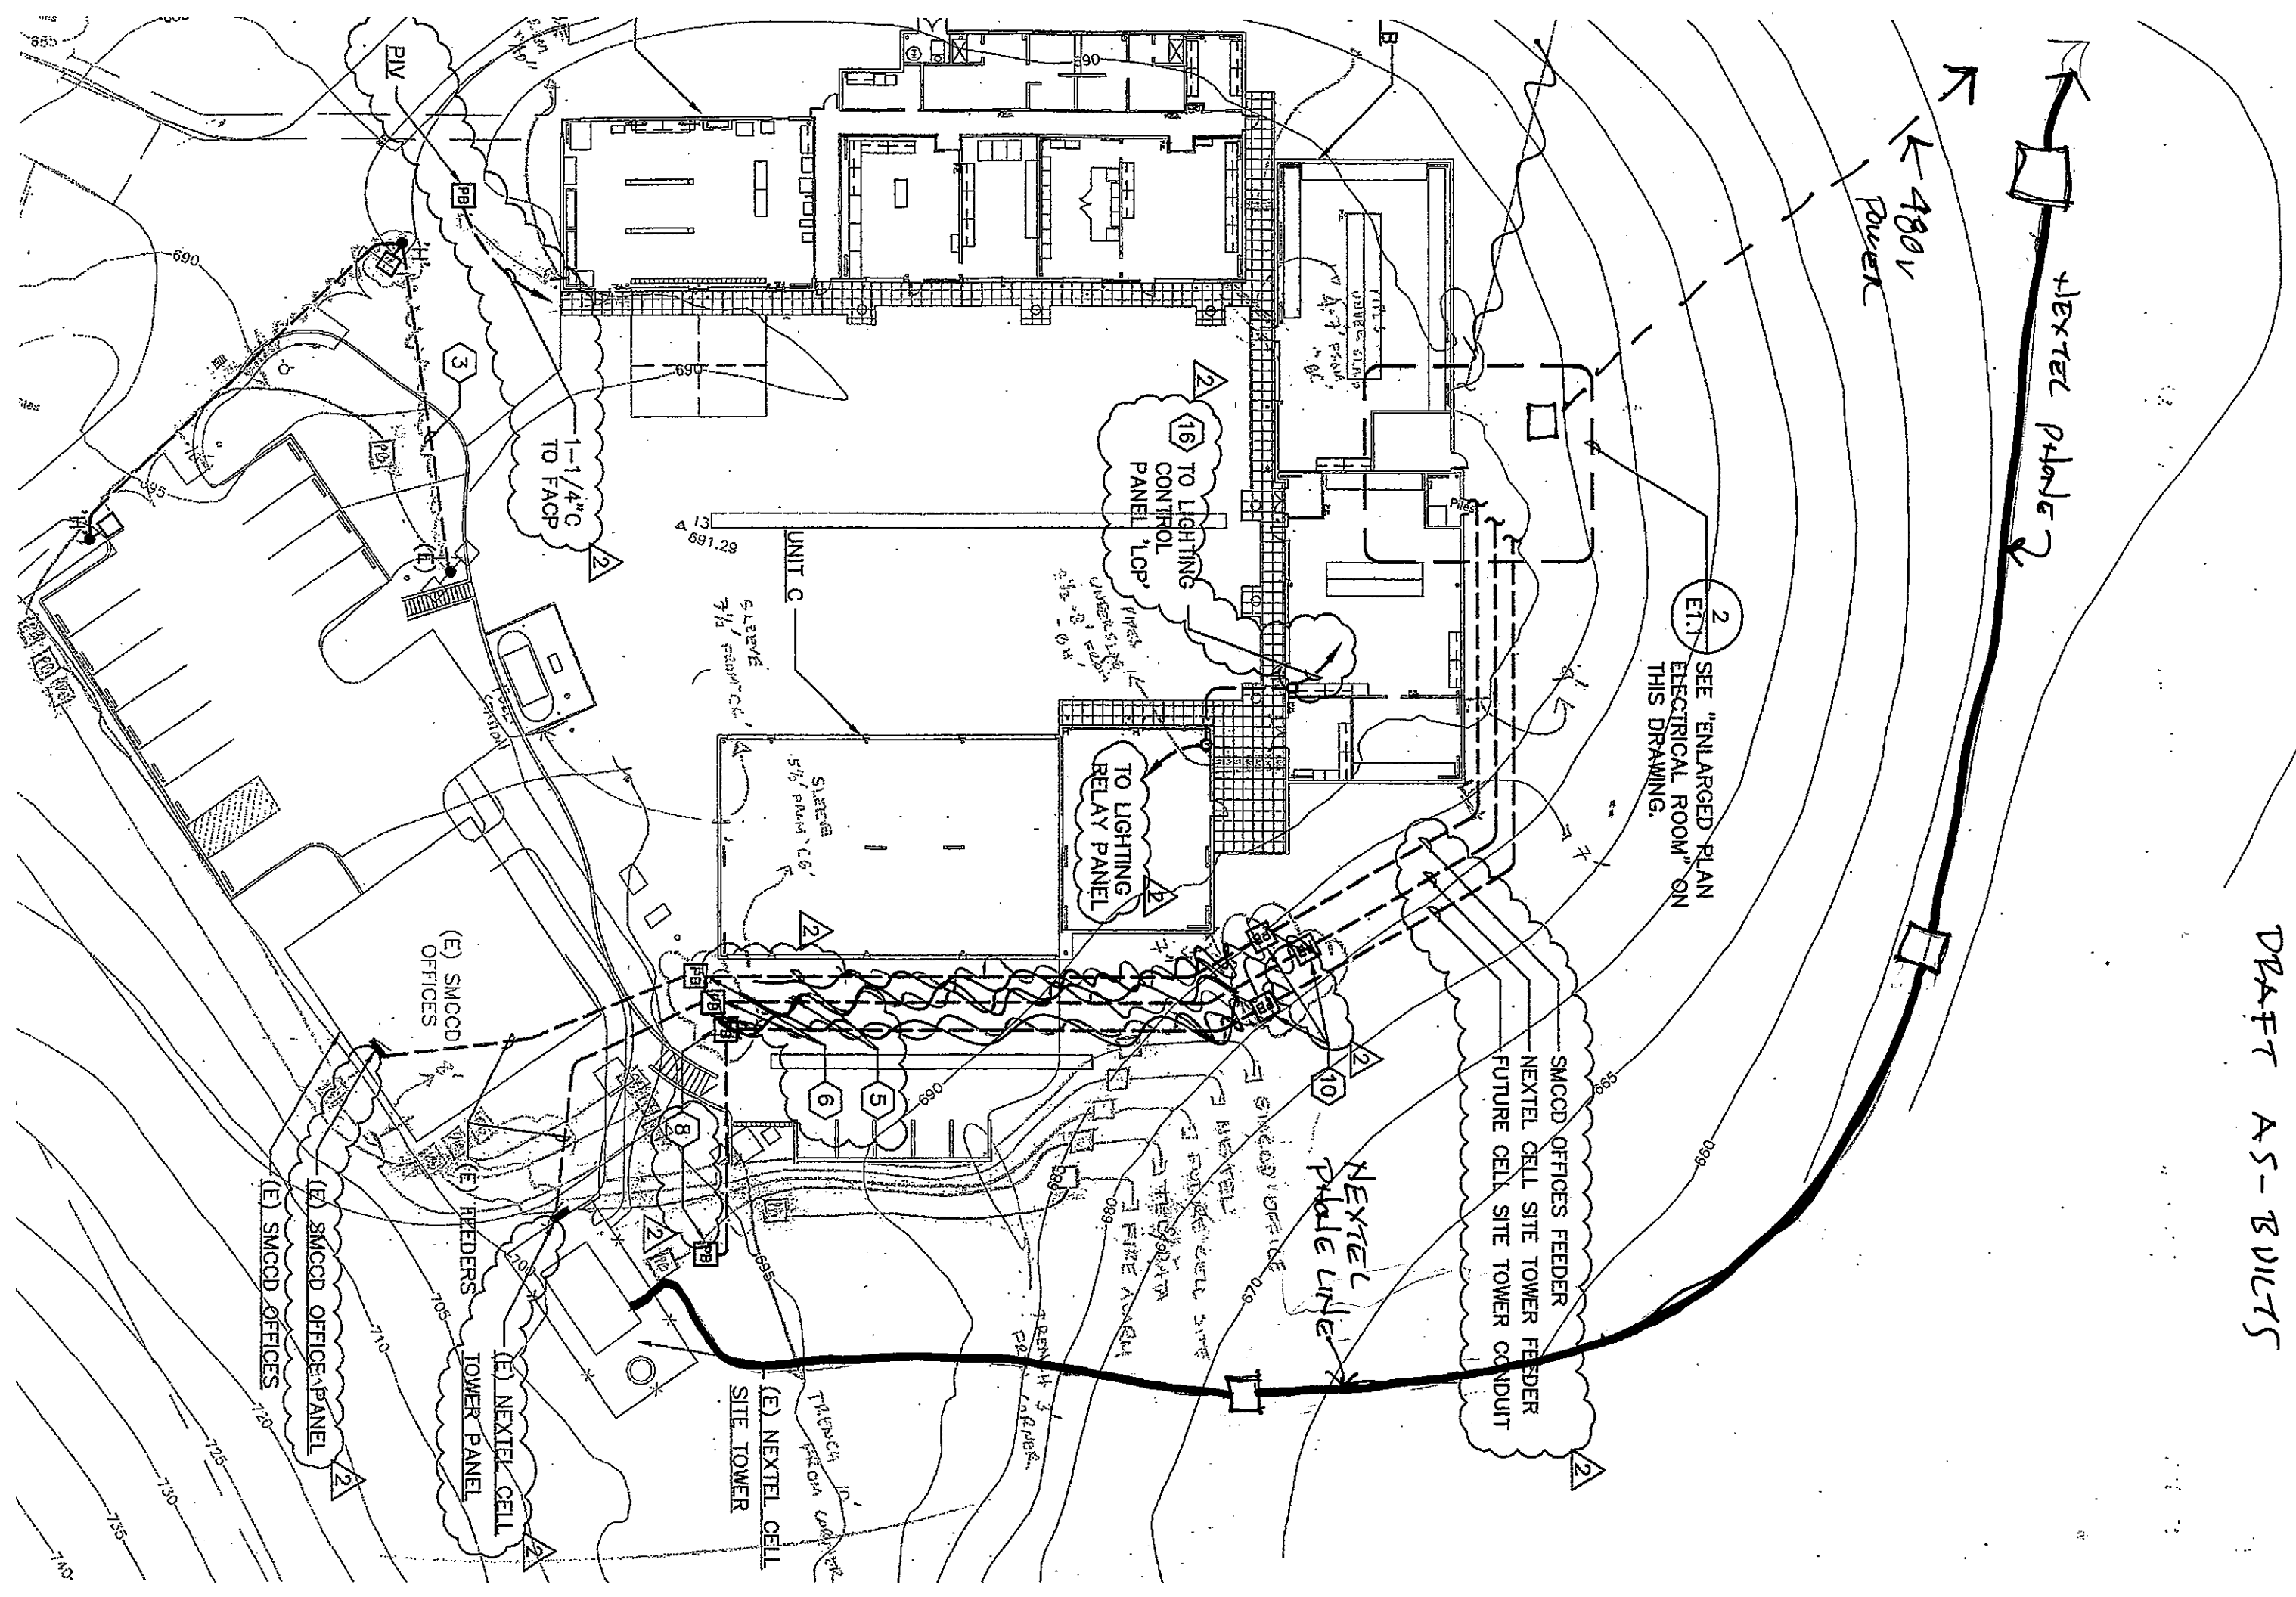

2 SEE "ENLARGED PLAN ELECTRICAL ROOM" ON THIS DRAWING.

SMCCD OFFICES FEEDER
NEXTEL CELL SITE TOWER FEEDER
FUTURE CELL SITE TOWER CONDUIT

NEXTEL
PHONE LINE

TO LIGHTING
RELAY PANEL

16 TO LIGHTING
CONTROL PANEL 'LCP'

1-1/4" C
TO FACP

(E) SMCCD OFFICES
(E) SMCCD OFFICES PANEL
(E) SMCCD OFFICES
(E) NEXTEL CELL TOWER PANEL
(E) NEXTEL CELL TOWER PANEL
(E) NEXTEL CELL TOWER PANEL

685
690
695
700
705
710
715
720
725
730
735
740