



split units for computer/tele rooms

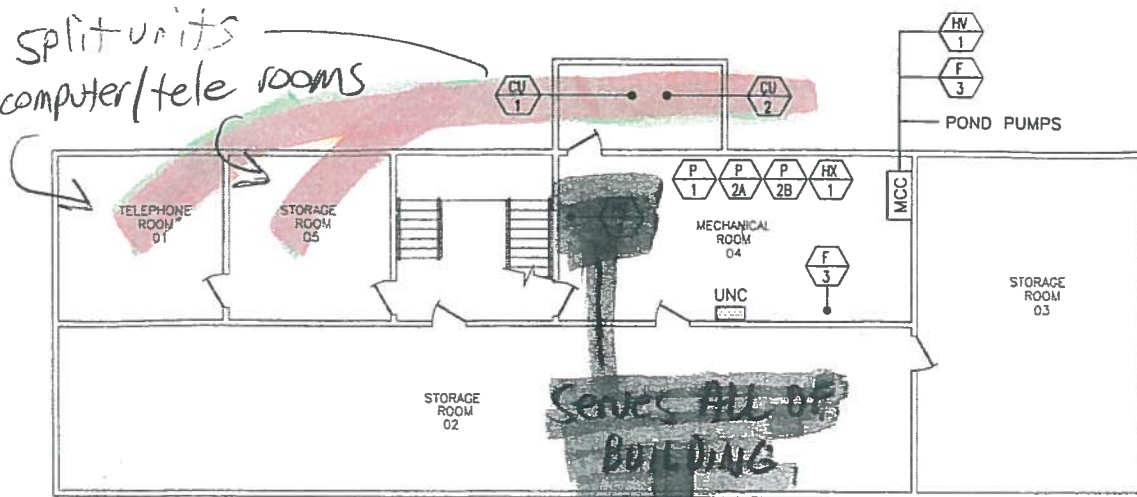


BUILDING 1 ADMINISTRATION BASEMENT
SCALE: NTS

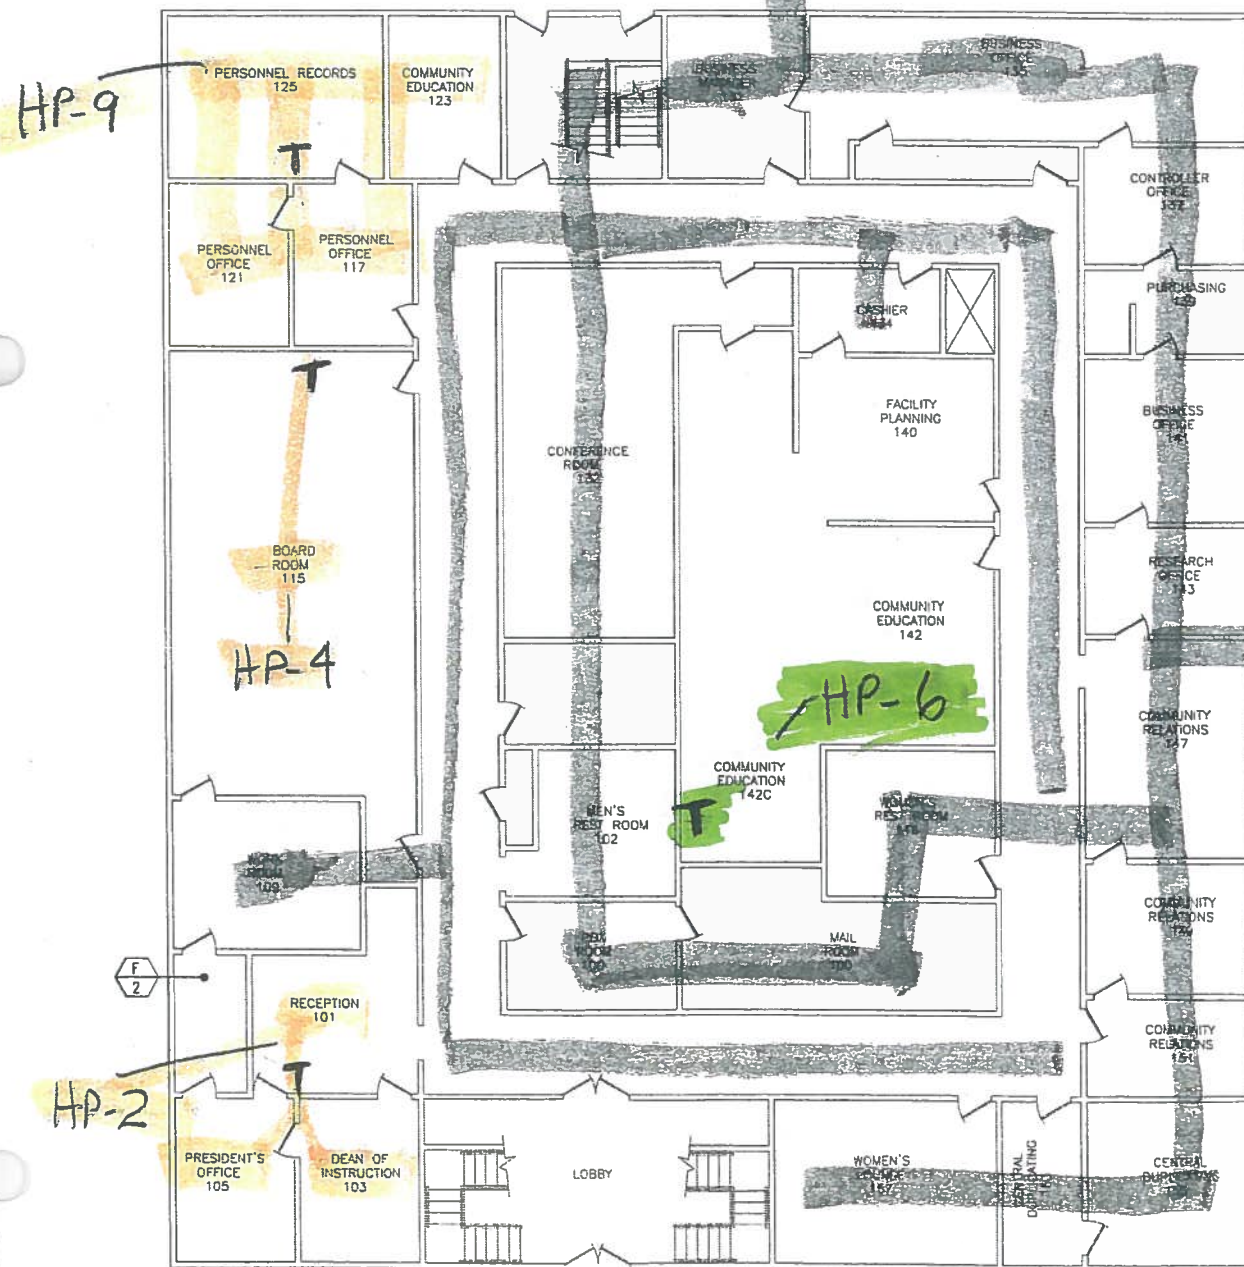

BUILDING 1 ADMINISTRATION FIRST FLOOR
SCALE: NTS

Heat pumps on roof serve individual rooms (will be commissioned, only)

NOTE:
EQUIPMENT ON ROOF:
9 UNITS HP 1 THRU HP 9
2 UNITS F 1A AND F 1B

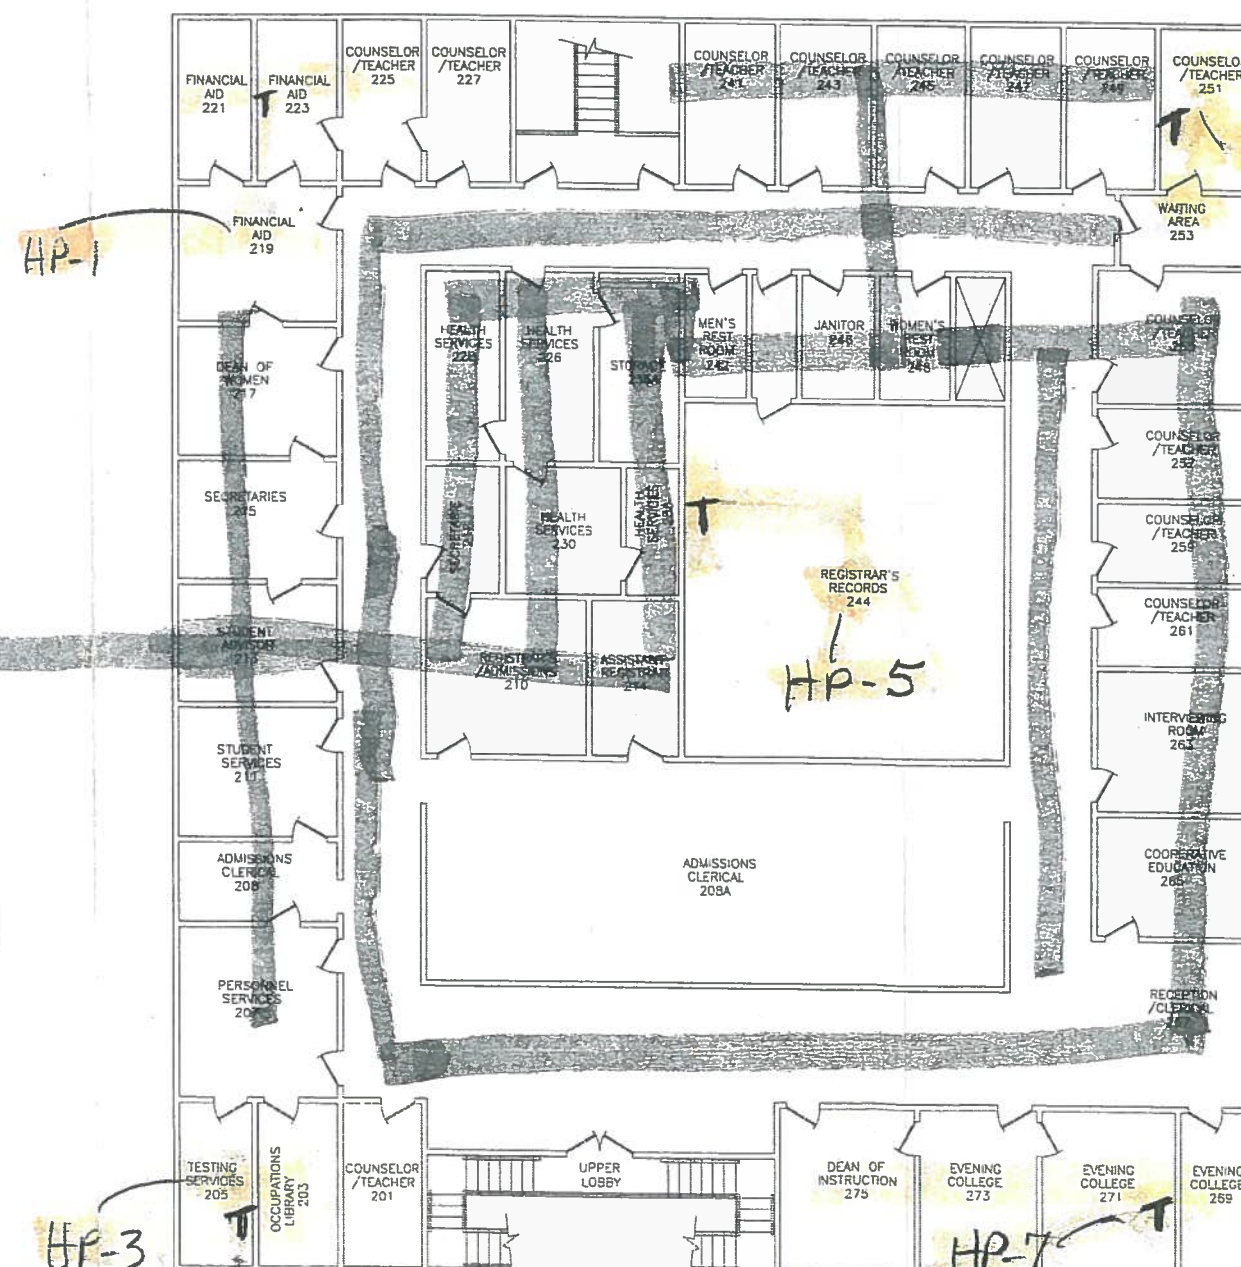

BUILDING 1 ADMINISTRATION SECOND FLOOR
SCALE: NTS

file: F:\2000\San... 11 1323\AutoCad Files\ems\acrm\E-1 06\05\03

REV	BY	DATE
1	APP	05/22/02
2	MD	05/22/02
3	MD	05/22/02
ChevronTexaco
Chevron Energy Solutions Company, a division of Chevron U.S.A. Inc.
345 California Street, 32nd Floor, San Francisco, CA 94104-2624
Tel 415 733 4500 Fax 415 733 4550

ADMINISTRATION BUILDING
FLOOR PLANS
EMS EQUIPMENT LOCATIONS

COLLEGE OF SAN MATEO
ChevronTexaco JOB #1323
SAN MATEO, CALIFORNIA

EMS-1