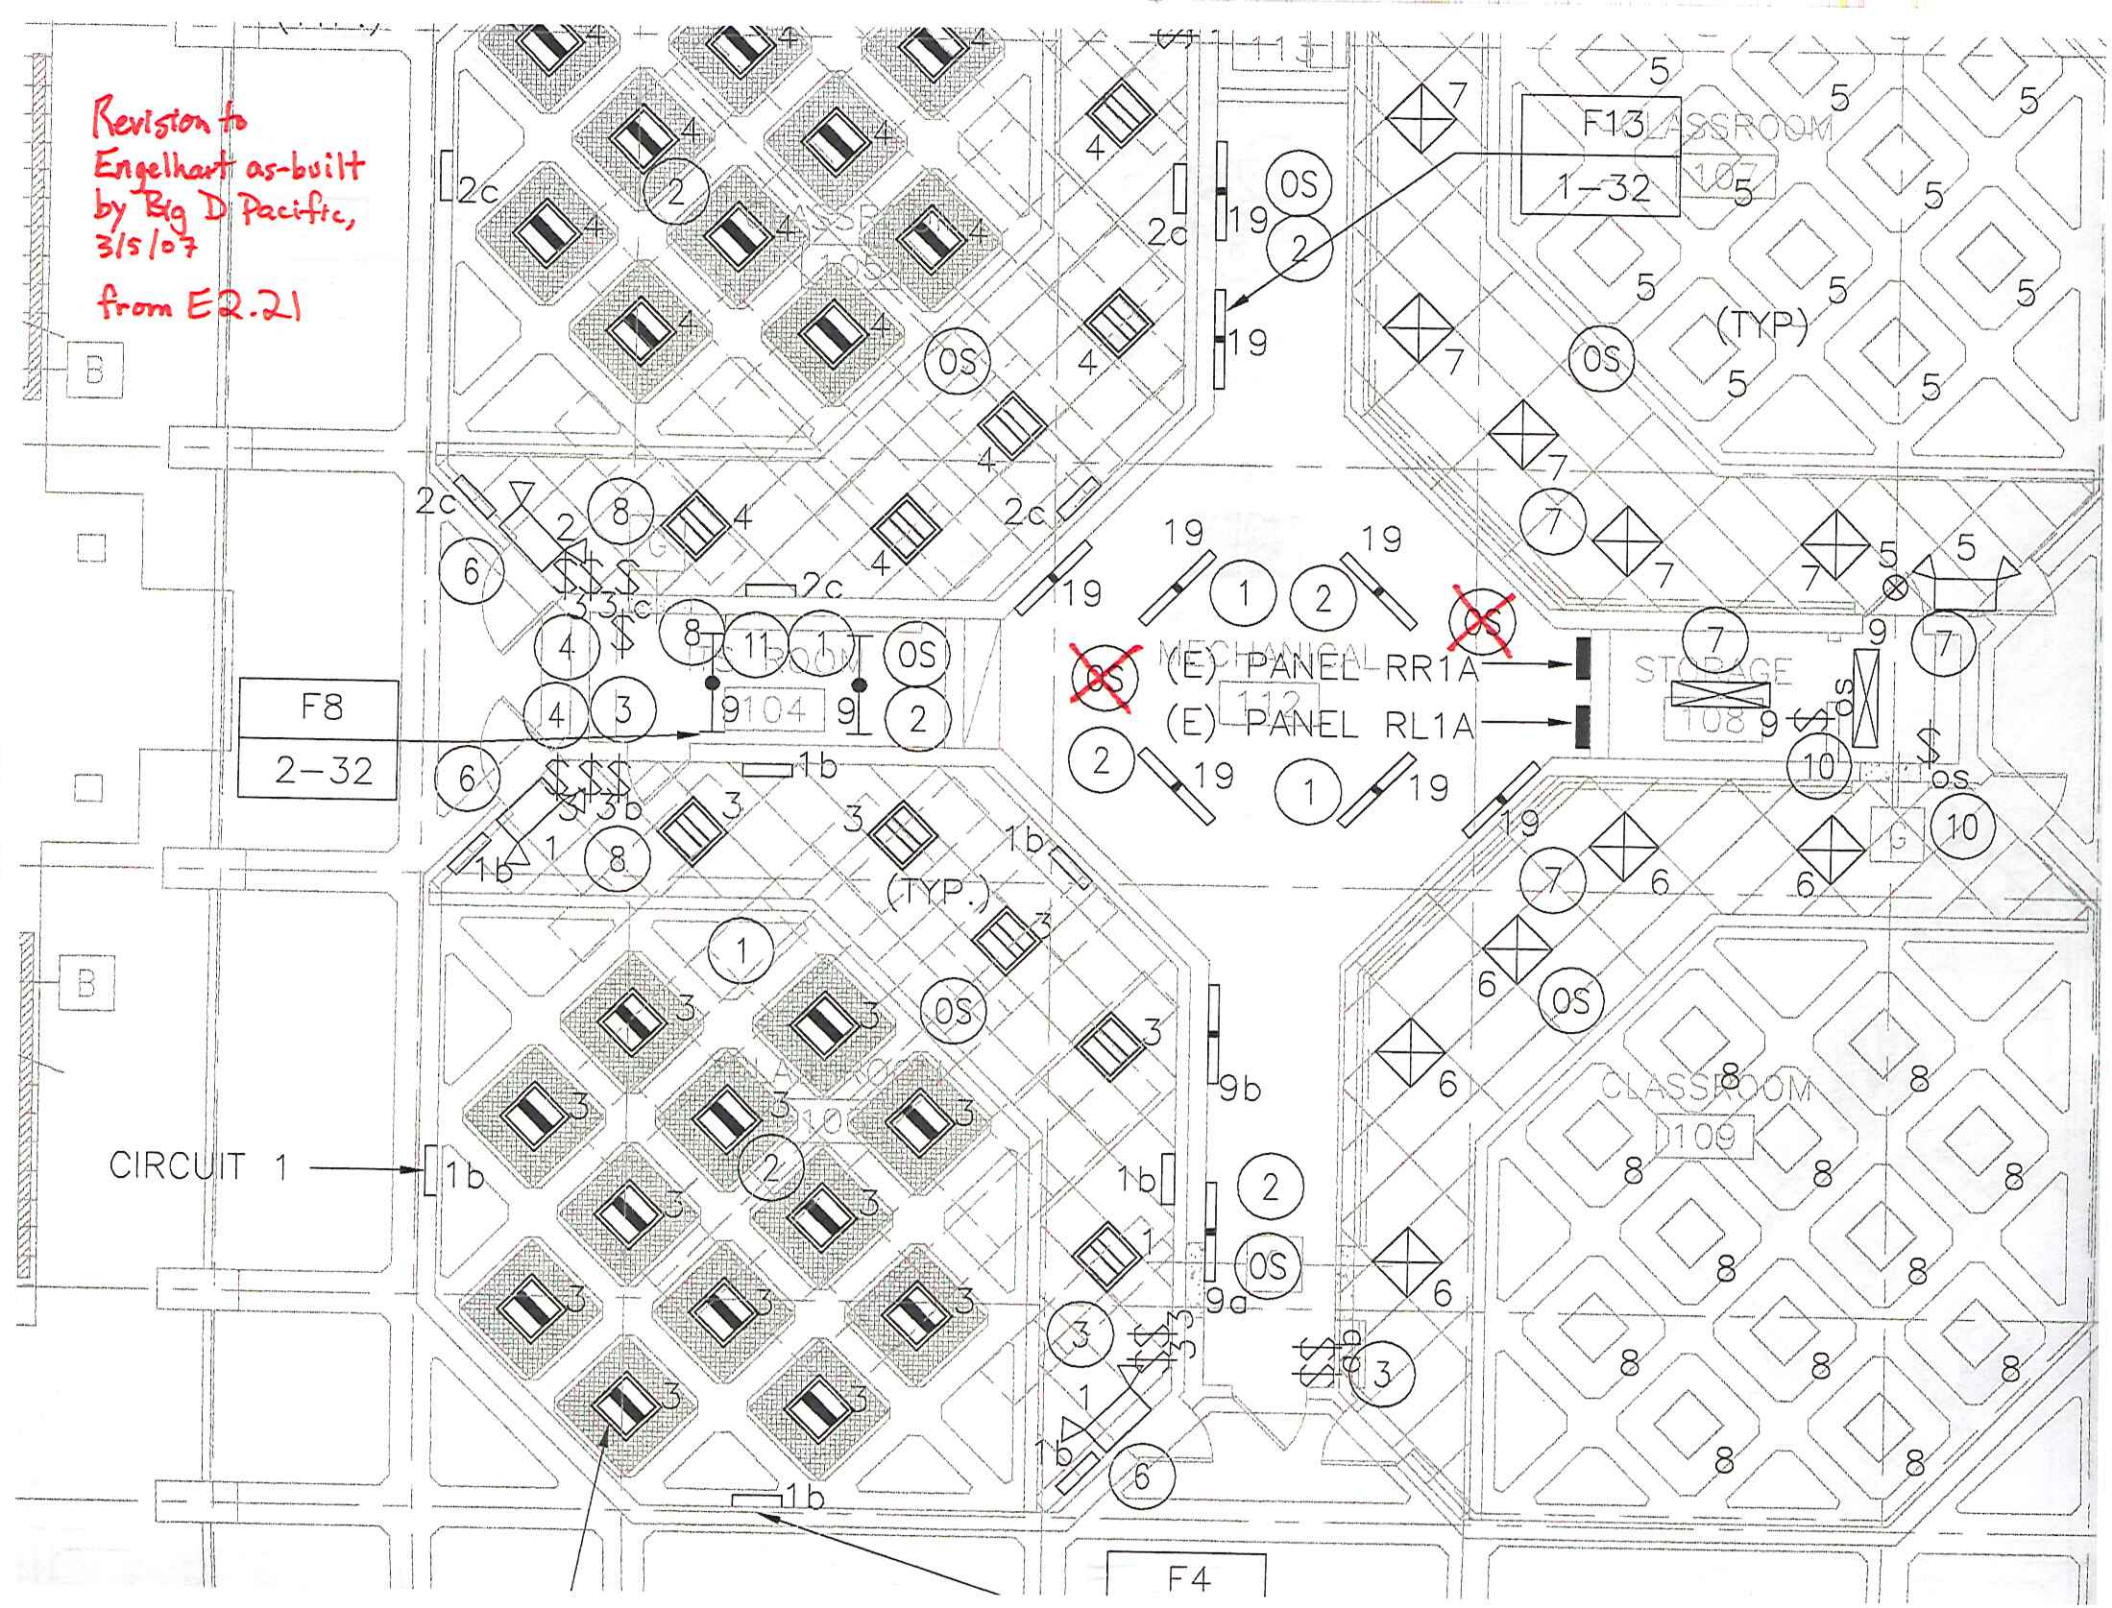
Revision to
Engelhart as-built
by Big D Pacific,
3/5/07
from E2.21
F8
2-32
F13
1-32
(E) PANEL RR1A
(E) PANEL RL1A
CIRCUIT 1
F4
CLASSROOM
D109
(TYP.)
(TYP)
MECHANICAL
112
STORAGE
108
B