


BCA The **DOOR MODIFICATION** Revision: RFP: 57

architecture planning interiors
Project Name: CANADA COLLEGE - BUILDINGS 5 & 6 RENOVATIONS
SAN MATEO COUNTY COMMUNITY COLLEGE DISTRICT
4200 FARM HILL BOULEVARD
REDWOOD CITY, CA 94061
FILE NO. 43-C1 APPL. 01-110074

Date: 08/20/10
Scale: AS NOTED
Project Number: 8703

Drawing Number: 57
ASK-27A

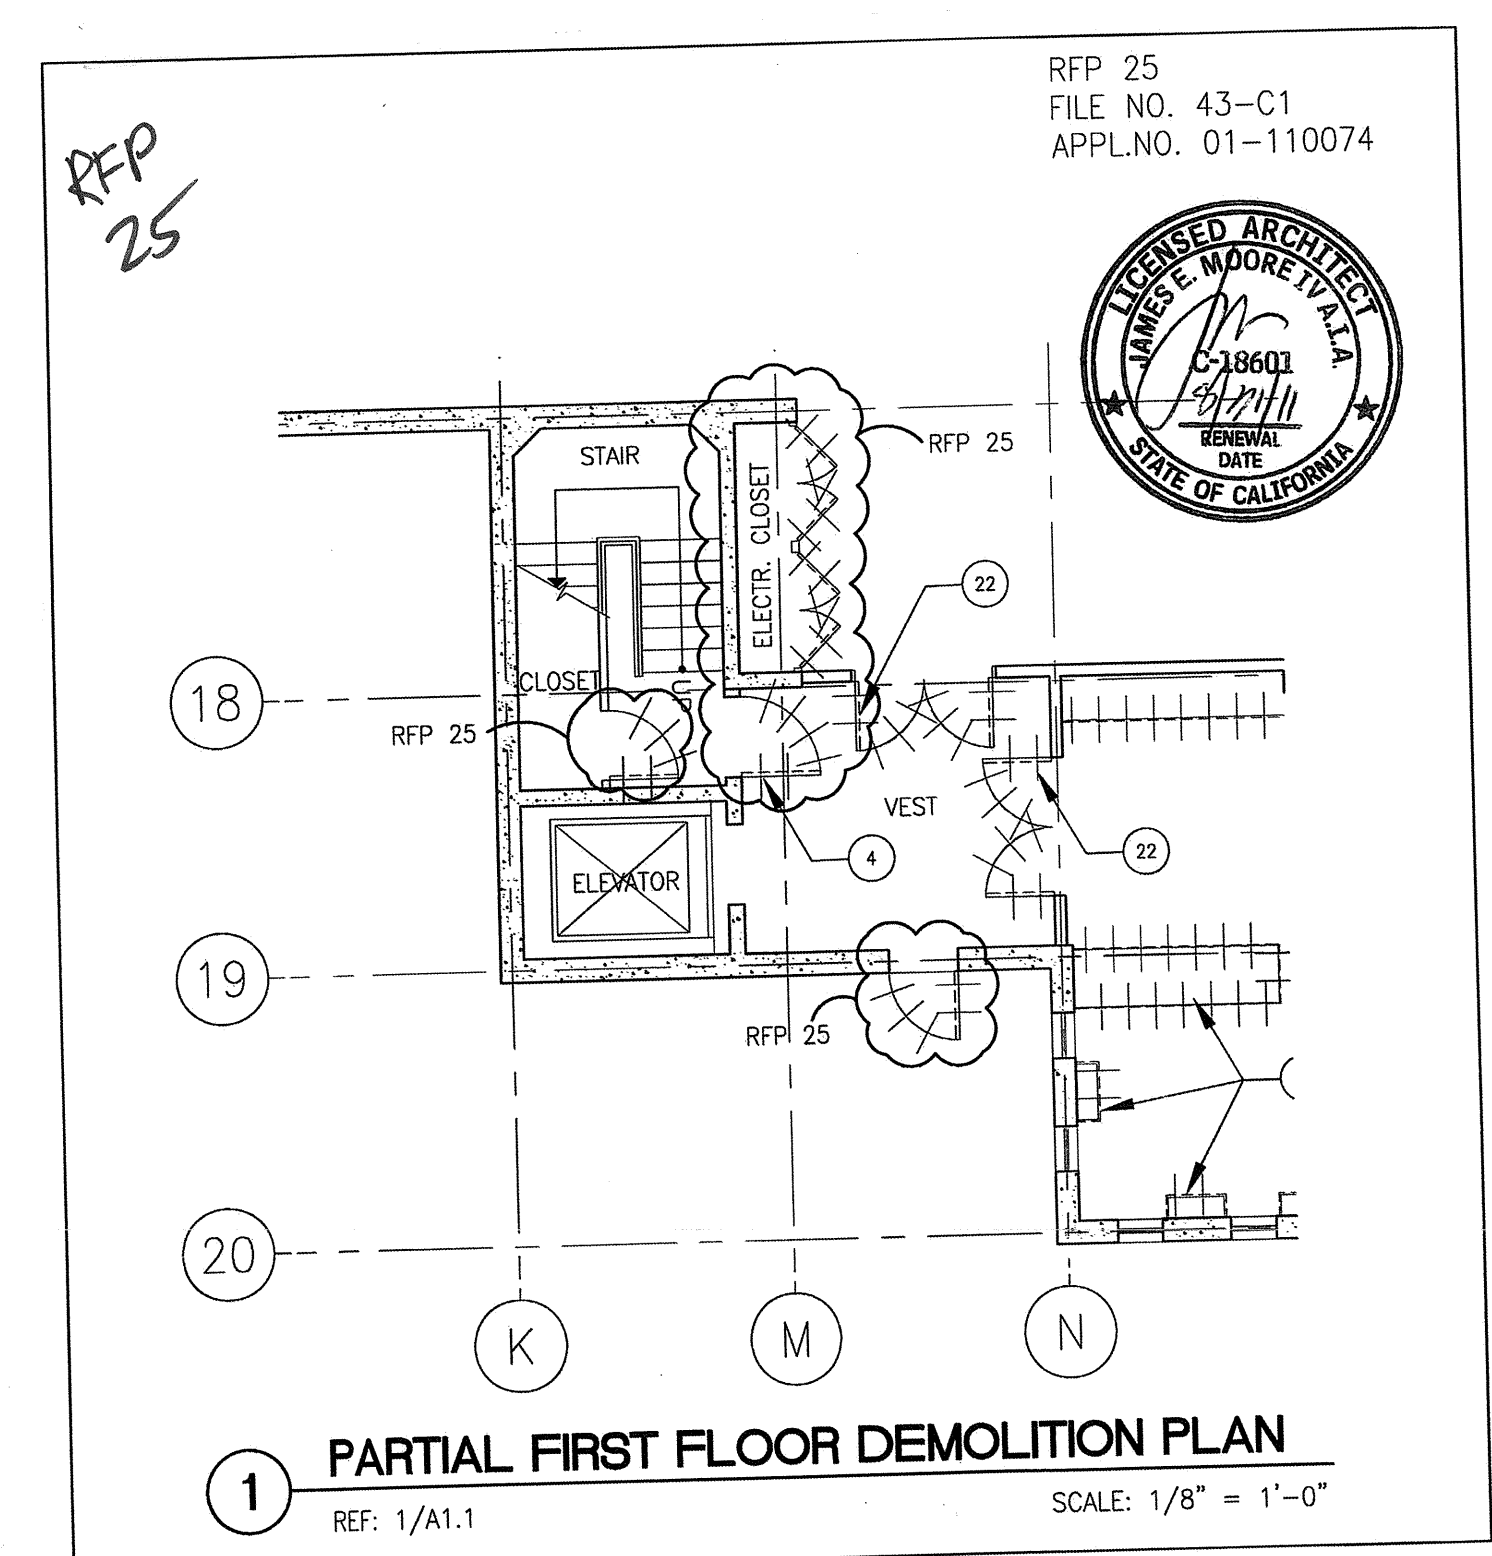

BCA The **NEW DOORS** Revision: RFP: 25

architecture planning interiors
Project Name: CANADA COLLEGE - BUILDINGS 5 & 6 RENOVATIONS
SAN MATEO COUNTY COMMUNITY COLLEGE DISTRICT
4200 FARM HILL BOULEVARD
REDWOOD CITY, CA 94061
FILE NO. 43-C1 APPL. 01-110074

Date: 08/20/10
Scale: AS NOTED
Project Number: 8703

Drawing Number: 25
ASK-14A